

工程指示 / 要求簡箋 ENGINEER INSTRUCTIONS (E.I.)

工程指示編號:	EI-7760	修改版本:	-
	HK-0852		
工程編號:	J 853	工程名稱:	延坪道
收件人:	生統 / 阿全	發件人:	Joe Chan
工程項目:	Row A 鋁板更正拆圖	日期:	13/05/2024

<input checked="" type="checkbox"/> 原合約工程包	<input type="checkbox"/> 原合約工程加 / 減賬 QT-	<input type="checkbox"/> 新工程報價 QT-
--	--	------------------------------------

信件批核號碼/圖紙參考編號:	批核模具圖紙編號:
客戶指示附件:	管理內部批簽署:

<input type="checkbox"/> 初步鋁料 B.M.	<input type="checkbox"/> 加工拆圖, 然後生產	<input type="checkbox"/> 尺寸表
<input type="checkbox"/> 正式鋁料 B.M.	<input type="checkbox"/> 技術上資料/指示	<input type="checkbox"/> 報價
<input type="checkbox"/> 配件 B.M.	<input type="checkbox"/> 樣辦或貨品說明書	<input type="checkbox"/> 分判合約
<input type="checkbox"/> 其他:		

內容: 有關 EI 7503, EI 7528 (外牆鋁板), 地盤安裝反映鋁板與工地狀況不符, 需按實際情況更正加工圖, 請安排相關拆圖.

完成上列要求日期: ASAP ASAP

國內

<input type="checkbox"/> 生產技術總監	<input type="checkbox"/> 連附件	<input type="checkbox"/> 技術部	<input type="checkbox"/> 連附件	<input type="checkbox"/> 生產部	<input type="checkbox"/> 連附件
<input type="checkbox"/> 採購部	<input type="checkbox"/> 連附件	<input checked="" type="checkbox"/> 生產統籌部	<input checked="" type="checkbox"/> 連附件	<input type="checkbox"/> 報關組	<input type="checkbox"/> 連附件
<input type="checkbox"/> 質檢部	<input type="checkbox"/> 連附件	<input type="checkbox"/> 會計部	<input type="checkbox"/> 連附件	<input type="checkbox"/> 機械設計部	<input type="checkbox"/> 連附件
<input type="checkbox"/> 香港辦	<input type="checkbox"/> 連附件	<input type="checkbox"/> 其他:			

香港

<input type="checkbox"/> 行政部	<input type="checkbox"/> 連附件	<input type="checkbox"/> 會計部	<input type="checkbox"/> 連附件	<input type="checkbox"/> 統籌部	<input type="checkbox"/> 連附件	<input type="checkbox"/> 工程部	<input type="checkbox"/> 連附件
<input type="checkbox"/> 採購部	<input type="checkbox"/> 連附件	<input type="checkbox"/> QS部	<input type="checkbox"/> 連附件	<input type="checkbox"/> 地盤管理	<input type="checkbox"/> 連附件	<input type="checkbox"/> 維修部	<input type="checkbox"/> 連附件

*發件人簽署:		*組別成員批核簽署:	
傳遞編號:	HK0852/24	項目經理簽署:	

B.D. REF :
 CLIENT : SHIMAO GROUP HOLDINGS LIMITED
 ARCHITECT : WONG TUNG & PARTNERS LIMITED
 MAIN CONTRACTOR : 協興建築有限公司
 HIP HING CONSTRUCTION CO. LTD


STRUCTURAL ENGINEER :
 CMA C.M WONG & ASSOCIATES LTD
 黃志明建築工程師有限公司

FAÇADE CONSULTANT :
 MEINHARDT

NOTE :
 1. ALL DIMENSIONS ARE IN mm.
 2. ALL ELEVATIONS ARE VIEWED FROM OUTSIDE.
 3. ALL DIMENSIONS TO BE VERIFIED ON SITE BEFORE FABRICATION.
 LEGEND :
 (X1) DETAIL MARK NO.
 (X2) REFER SHEET NO.
 1. F.F.L. -- FINISHED FLOOR LEVEL
 2. S.F.L. -- STRUCTURAL FLOOR LEVEL
 3. (R) -- REVERSED DETAIL
 R.C. STRUCTURAL ELEMENT
 C.O.L. / BEAM / SLAB
 IS (UNDER SEPARATED SUBMISSION)

D	24/7/2024	GENERAL REVISED
C	24/7/2023	GENERAL REVISED
B	5/7/2023	GENERAL REVISED
A	31/7/2023	GENERAL REVISED
NO	DATE	REVISION

JOB NO. : J-853
 PROJECT : PROPOSED RESIDENTIAL DEVELOPMENT AT N.K.I.L. 6542 YIN PING ROAD KOMLOON
 TITLE : PART ELEVATION FOR HOUSE ALUM. CLADDING HOUSE TYPE A & A1
 DATE : 10-08-23
 DRAWN BY : ASING
 CHECKED BY :
 SCALE : 1:60 (A1)
 DWG NO. : JB53-S0-HAL-3001
 REV. : D

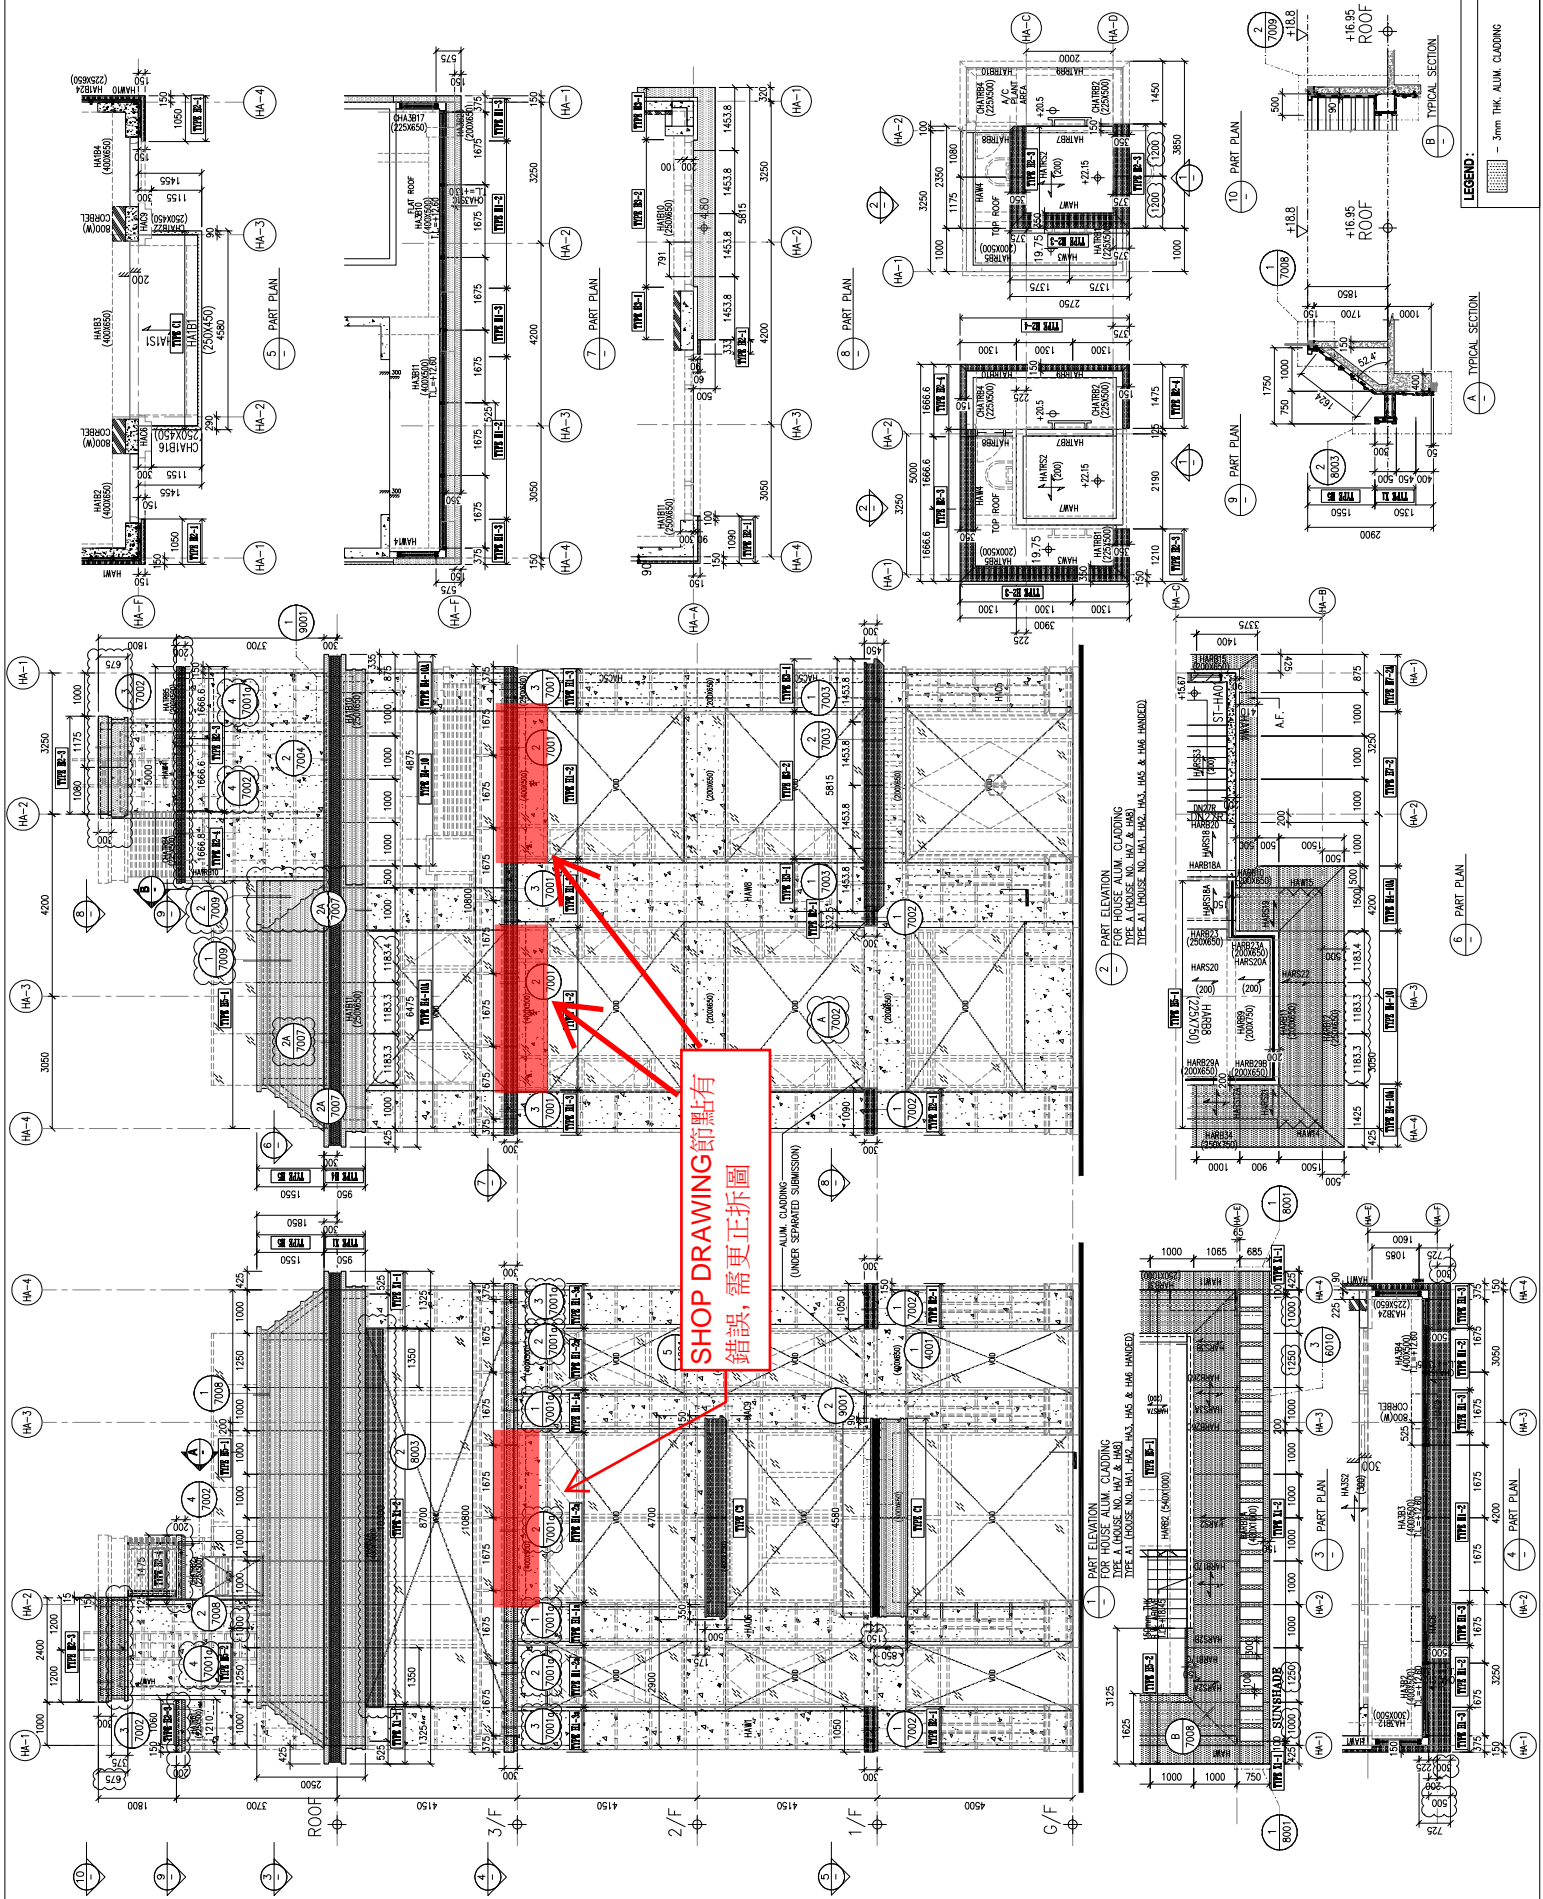

LEGEND :
 - 3mm THK. ALUM. CLADDING

TYPICAL SECTION A
 TYPICAL SECTION B

PART ELEVATION FOR HOUSE ALUM. CLADDING TYPE A (HOUSE NO. HA7 & HA8)
 TYPE A1 (HOUSE NO. HA1, HA2, HA3, HA5 & HA6 HANDED)

PART ELEVATION FOR HOUSE ALUM. CLADDING TYPE A (HOUSE NO. HA7 & HA8)
 TYPE A1 (HOUSE NO. HA1, HA2, HA3, HA5 & HA6 HANDED)



UNITED MTDI 美特銘實有限公司
 MIDORI ALUMINIUM FABRICATOR LTD.
 Units 6-8, Sunray Industrial Centre, 1/F
 810 Cha Kwo Ling Road, Kowloon
 Tel: 23489211-4 Fax: (852) 2727866

B.D. REF :
 CLIENT : SHIMAO GROUP HOLDINGS LIMITED
 ARCHITECT : WONG TUNG & PARTNERS LIMITED
 MAIN CONTRACTOR : 協興建築有限公司
 HP HING CONSTRUCTION CO LTD
 STRUCTURAL ENGINEER : CMA C M WONG & ASSOCIATES LTD
 黃志明建築工程師有限公司
 FACADE CONSULTANT : MEINHARDT

NOTE:
 1. ALL DIMENSIONS ARE IN mm.
 2. ALL ELEVATIONS ARE VIEWED FROM OUTSIDE.
 3. ALL DIMENSIONS TO BE VERIFIED ON SITE BEFORE FABRICATION.
 LEGEND:
 (X1) DETAIL MARK NO.
 (X2) REFER SHEET NO.
 1. F.F.L. -- FINISHED FLOOR LEVEL
 2. S.F.L. -- STRUCTURAL FLOOR LEVEL
 3. (R) -- REVERSED DETAIL
 R.C. STRUCTURAL ELEMENT
 COL. / BEAM / SLAB
 IS (UNDER SEPARATED SUBMISSION)

D	24/7/2024	GENERAL REVISION
C	24/7/2023	GENERAL REVISION
B	5/10/2023	GENERAL REVISION
A	31/7/2023	GENERAL REVISION
NO	DATE	REVISION

JOB NO. : J-853
 PROJECT : PROPOSED RESIDENTIAL DEVELOPMENT AT N.K.I.L. 6542
 YIN PING ROAD KOWLOON
 TITLE : PART ELEVATION FOR HOUSE ALUM. CLADDING HOUSE TYPE A1
 SCALE : 1:60 (A1)
 DRAWN BY : Asing
 CHECKED BY :
 MIDY ALUMINIUM FABRICATOR LTD.
 Units 6-8, Sunray Industrial Centre, 1/F
 162-2488211-4 Fax: (852) 2727666
 DWG NO. : J853-S0-HAL-3003 REV. : D

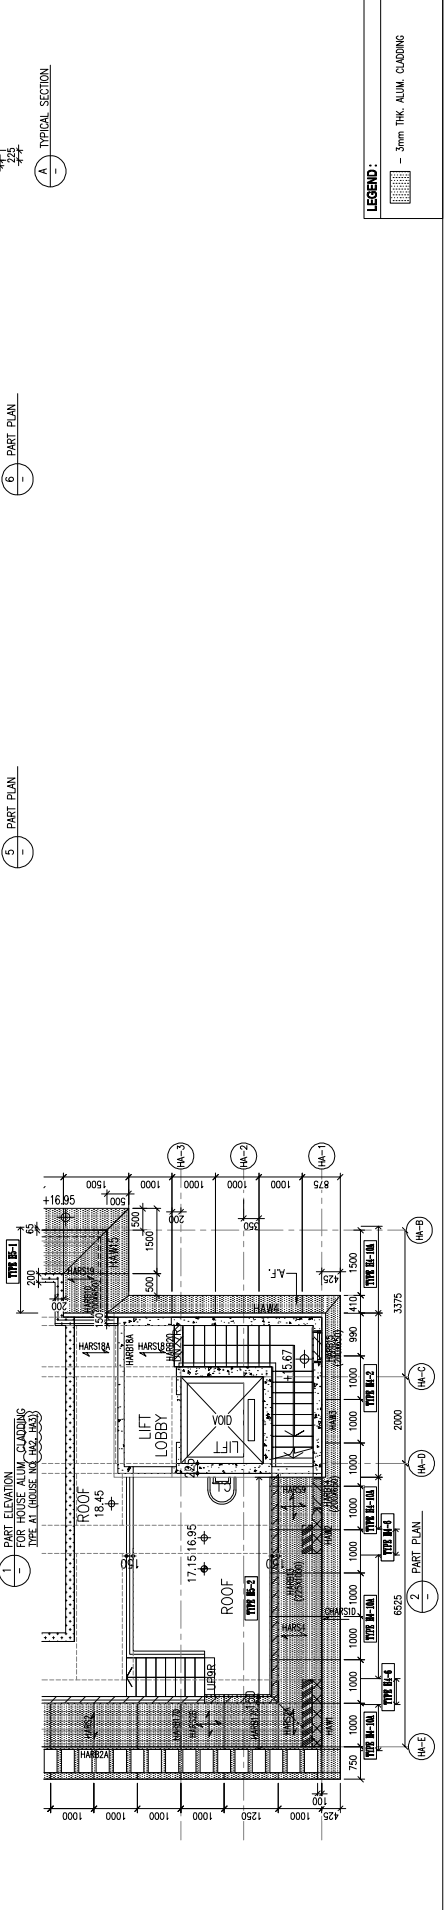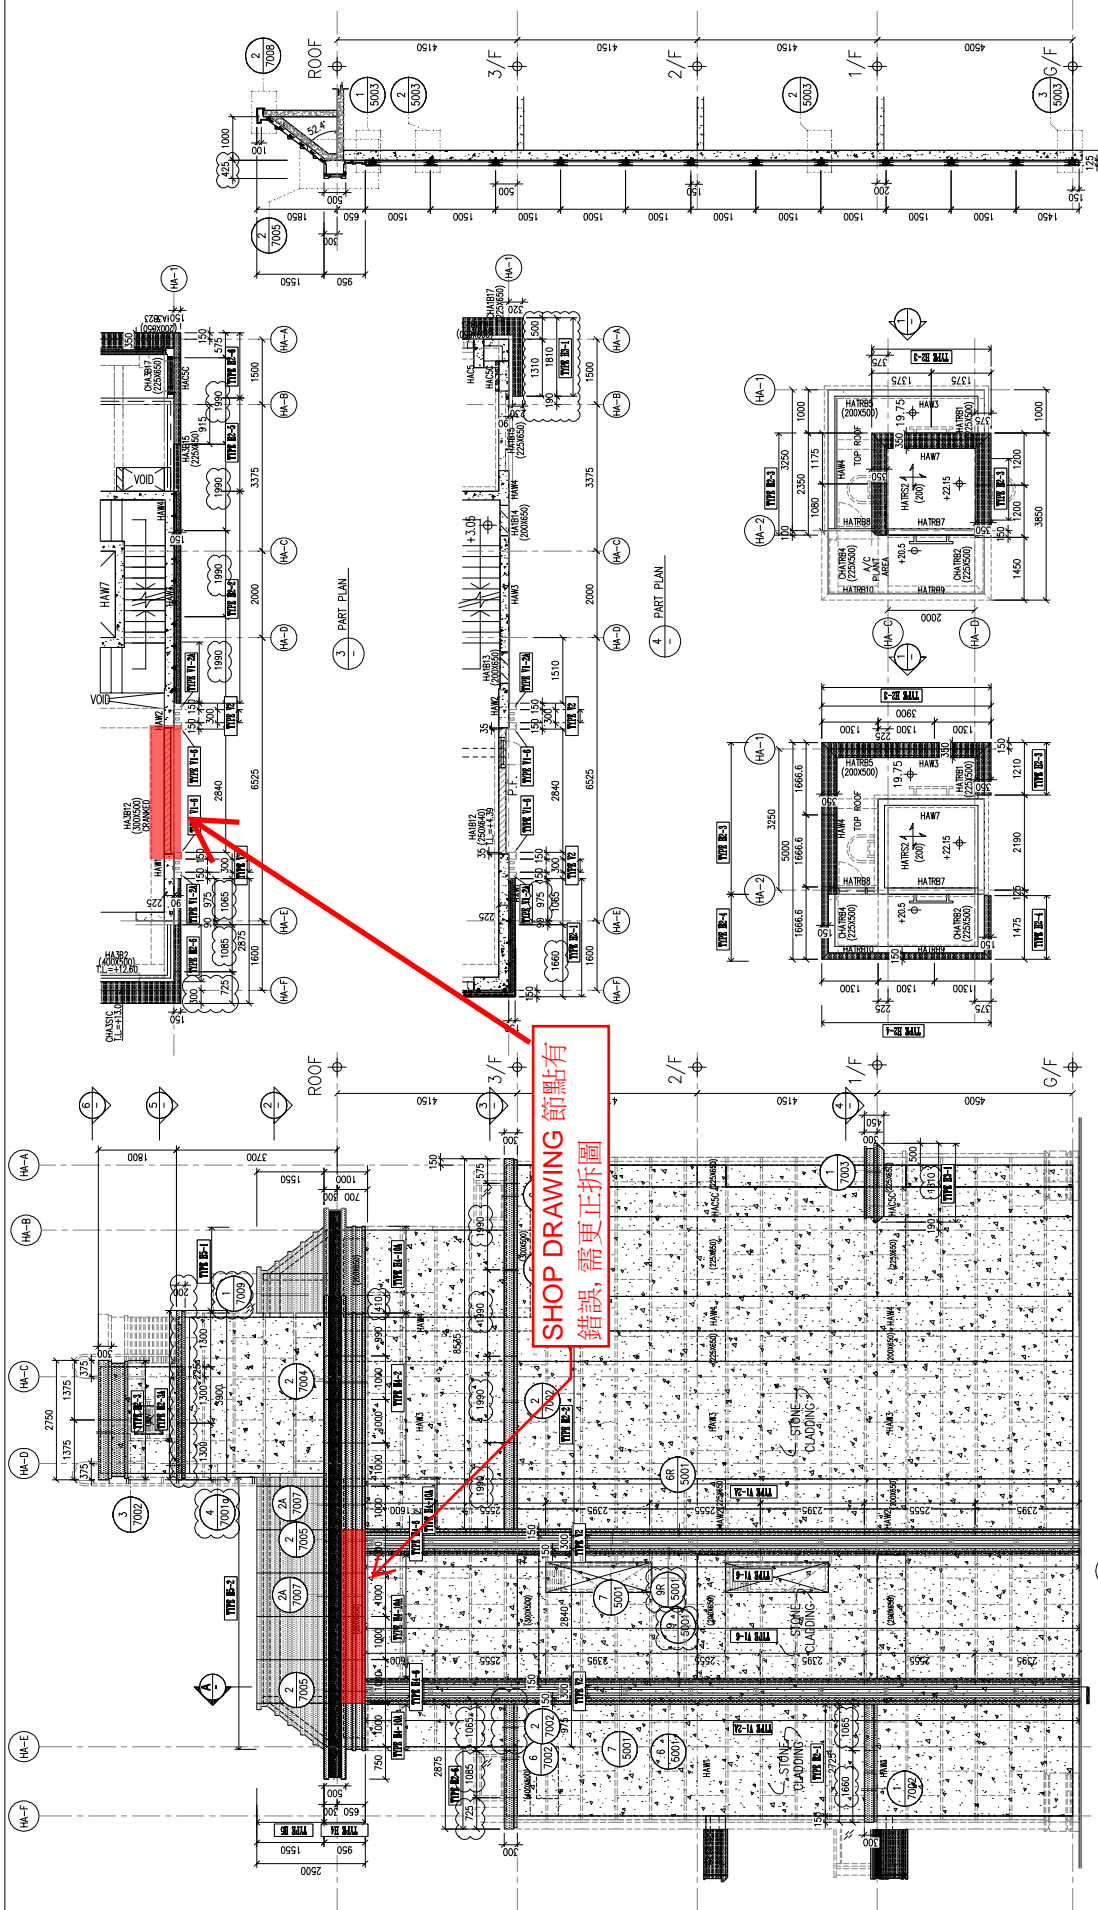


LEGEND:
 - 3mm THK. ALUM. CLADDING

B.D. REF :
 CLIENT : SHIMAO GROUP HOLDINGS LIMITED
 ARCHITECT : WONG TUNG & PARTNERS LIMITED
 MAIN CONTRACTOR : 協興建築有限公司
 HP HING CONSTRUCTION CO LTD
 STRUCTURAL ENGINEER : CMA C M WONG & ASSOCIATES LTD
 黃志明建築工程師有限公司
 FACADE CONSULTANT : MEINHARDT

NOTE:
 1. ALL DIMENSIONS ARE IN mm.
 2. ALL ELEVATIONS ARE VIEWED FROM OUTSIDE.
 3. ALL DIMENSIONS TO BE VERIFIED ON SITE BEFORE FABRICATION.
 LEGEND:
 (X1) DETAIL MARK NO.
 (X2) REFER SHEET NO.
 1. F.F.L. -- FINISHED FLOOR LEVEL
 2. S.F.L. -- STRUCTURAL FLOOR LEVEL
 3. (R) -- REVERSED DETAIL
 R.C. STRUCTURAL ELEMENT
 COL. / BEAM / SLAB
 IS (UNDER SEPARATED SUBMISSION)


D	24/7/2024	GENERAL REVISED
C	24/7/2023	GENERAL REVISED
B	5/7/2023	GENERAL REVISED
A	31/7/2023	GENERAL REVISED
NO	DATE	REVISION

JOB NO. : J-853
 PROJECT : PROPOSED RESIDENTIAL DEVELOPMENT AT N.K.I.L. 6542
 YIN PING ROAD
 KOMLOON
 TITLE : PART ELEVATION FOR HOUSE ALUM. CLADDING HOUSE TYPE A & A1
 DATE : 10-08-23
 SCALE : 1:60 (A1)
 DRAWN BY : Aising
 CHECKED BY :
 UNIT : 1:60 (A1)
 DRAWN BY : Aising
 CHECKED BY :
 UNIT : 1:60 (A1)
 MIDY ALUMINIUM FABRICATOR LTD.
 Units 6-8, Sunray Industrial Centre, 1/F
 810 Cha Kwo Ling Road, Kowloon
 Tel: 2388211-4 Fax: (852) 2727866
 DWG NO. : J853-S0-HAL-3004 REV. : D

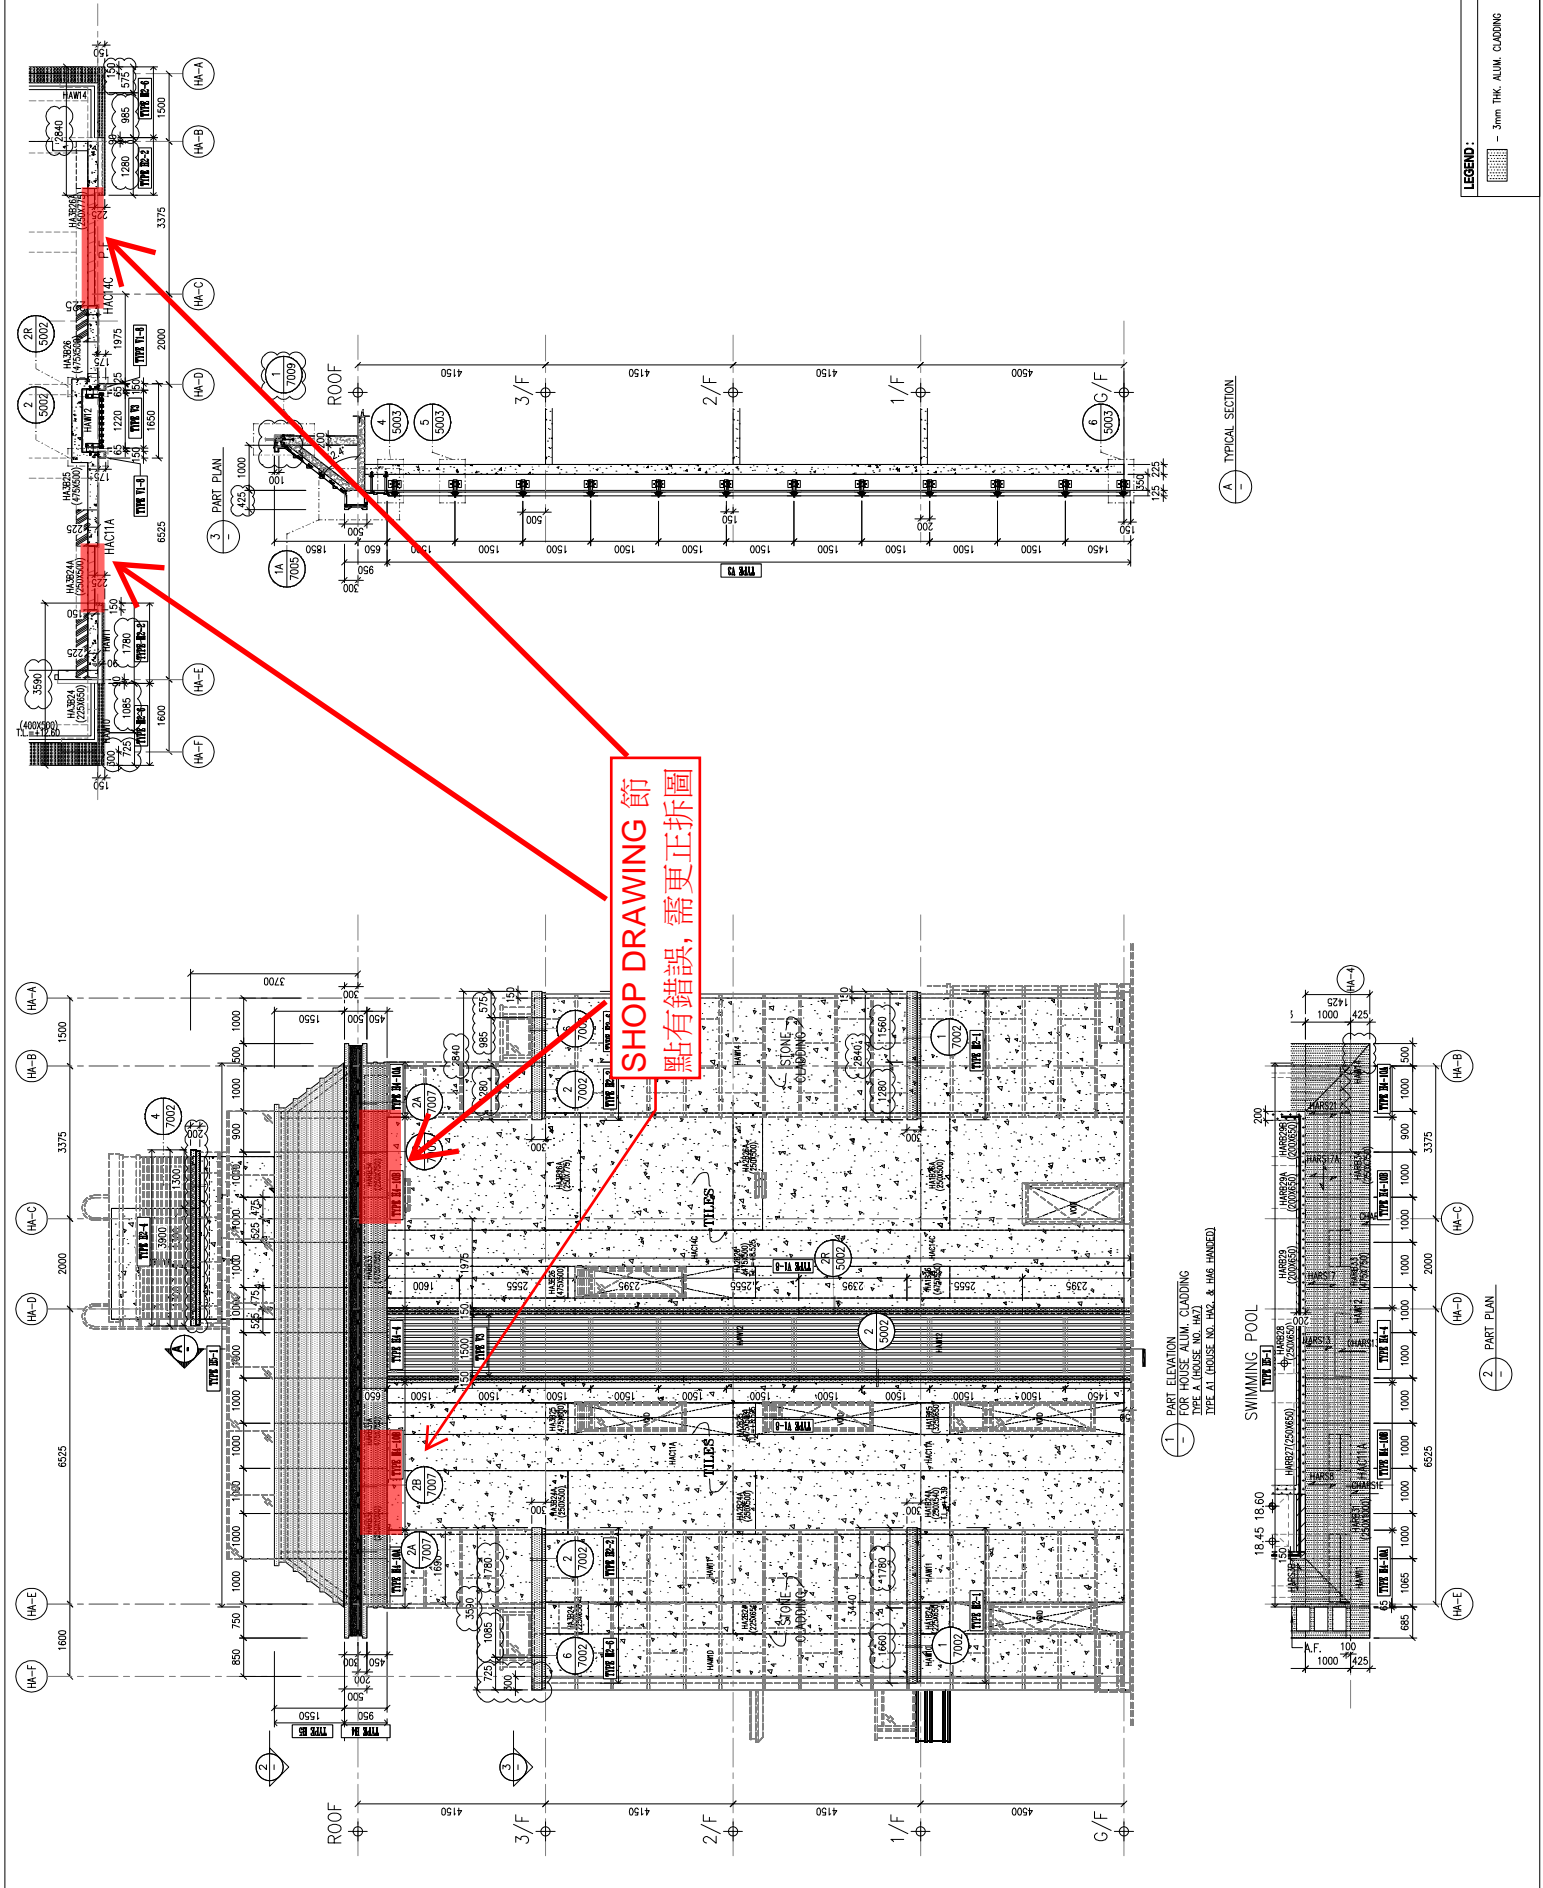

LEGEND:
 [Symbol] = 3mm THK. ALUM. CLADDING



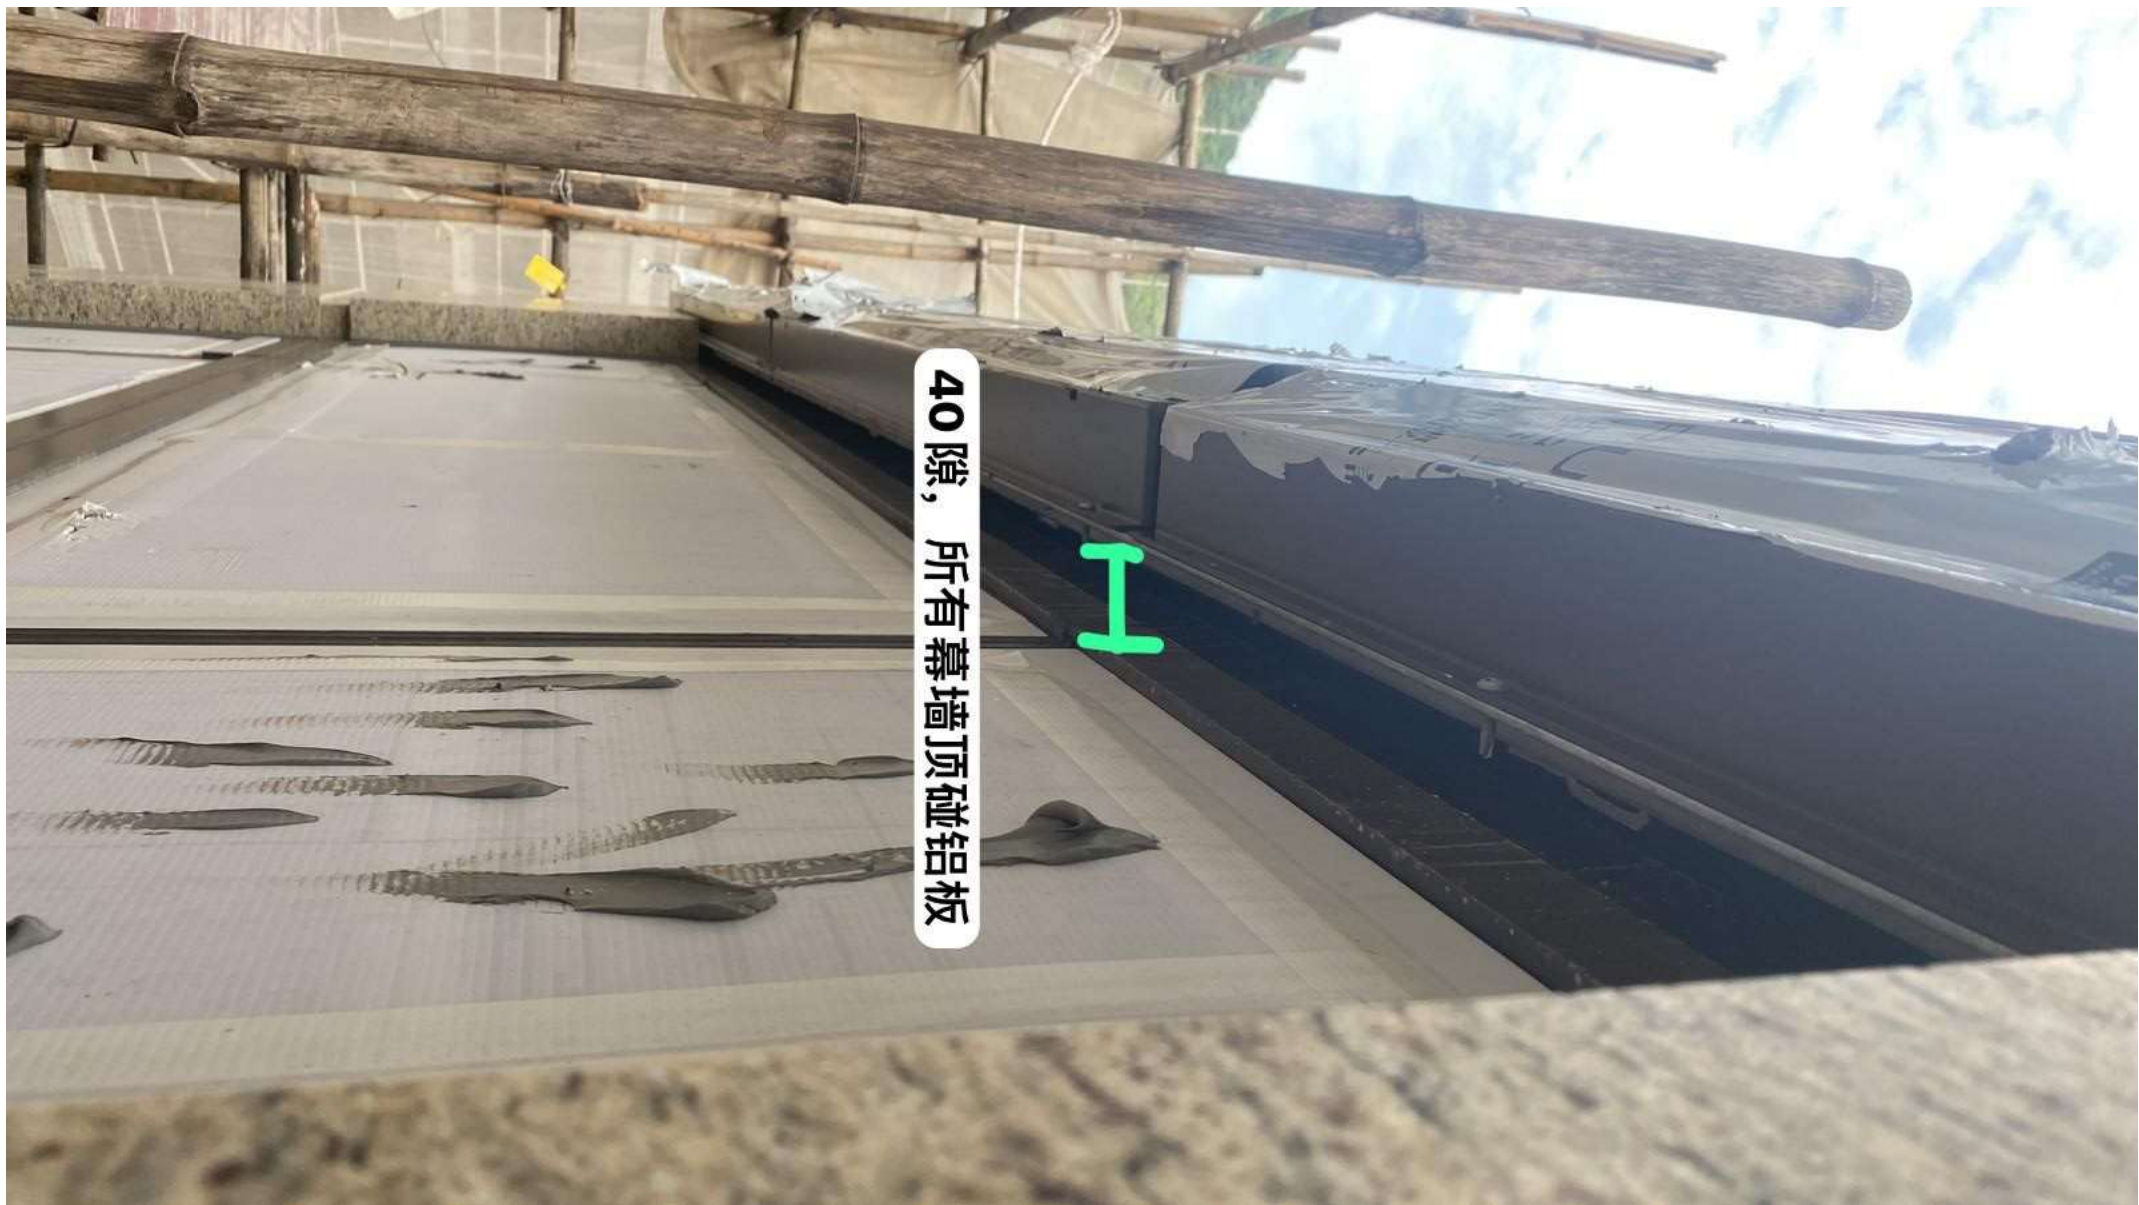

40 隙，所有幕墙顶碰铝板