



工程指示 / 要求簡箋 ENGINEER INSTRUCTIONS(E.I.)

工程指示編號:	EI- 8045	B	修改版本:	- B
	HK- 1337			
工程編號:	J 853	工程名稱:	延坪道 (第2期)	
收件人:	生統/	發件人:	Jingo	
工程項目:	Feature wall 飾線 鋁料加工圖修改		日期:	17/7/2024

Part 6

<input type="checkbox"/> 原合約工程包	<input type="checkbox"/> 原合約工程加 / 減賬 QT-	<input type="checkbox"/> 新工程報價 QT-
---------------------------------	--	------------------------------------

信件批核號碼/圖紙參考編號:	批核模具圖紙編號:
客戶指示附件:	管理內部批簽署:

<input type="checkbox"/> 初步鋁料 B.M.	<input type="checkbox"/> 加工拆圖, 然後生產	<input type="checkbox"/> 尺寸表
<input type="checkbox"/> 正式鋁料 B.M.	<input type="checkbox"/> 技術上資料/指示	<input type="checkbox"/> 報價
<input type="checkbox"/> 配件 B.M.	<input type="checkbox"/> 樣辦或貨品說明書	<input type="checkbox"/> 分判合約
<input type="checkbox"/> 其他:		

內容:

完成上列要求日期: 24/7/2024

國內

<input type="checkbox"/> 生產技術總監	<input type="checkbox"/> 連附件	<input type="checkbox"/> 技術部	<input type="checkbox"/> 連附件	<input type="checkbox"/> 生產部	<input type="checkbox"/> 連附件
<input type="checkbox"/> 採購部	<input type="checkbox"/> 連附件	<input checked="" type="checkbox"/> 生產統籌部	<input checked="" type="checkbox"/> 連附件	<input type="checkbox"/> 報關組	<input type="checkbox"/> 連附件
<input type="checkbox"/> 質檢部	<input type="checkbox"/> 連附件	<input type="checkbox"/> 會計部	<input type="checkbox"/> 連附件	<input type="checkbox"/> 機械設計部	<input type="checkbox"/> 連附件
<input type="checkbox"/> 香港辦	<input type="checkbox"/> 連附件	<input type="checkbox"/> 其他:			

香港

<input type="checkbox"/> 行政部	<input type="checkbox"/> 連附件	<input type="checkbox"/> 會計部	<input type="checkbox"/> 連附件	<input type="checkbox"/> 統籌部	<input type="checkbox"/> 連附件	<input type="checkbox"/> 工程部	<input type="checkbox"/> 連附件
<input type="checkbox"/> 採購部	<input type="checkbox"/> 連附件	<input type="checkbox"/> QS部	<input type="checkbox"/> 連附件	<input type="checkbox"/> 地盤管理	<input type="checkbox"/> 連附件	<input type="checkbox"/> 維修部	<input type="checkbox"/> 連附件

*發件人簽署:	*組別成員批核簽署:
傳遞編號:	項目經理簽署:

圖則登記表
DRAWING REGISTER


		接收日期 Receiving Date (適用於客戶圖則)						
工程名稱 Project Title:	J-853香港廷坪路							
	FEATURE WALL(Phase 2)拆圖	月						
工程編號 Project No: J-853		日						
分發予 Distributed To		發出日期 Issued Date						
		年	24	24				
		月	07	07				
		日	10	17				
圖則編號 Drg. No.	圖則名稱 Drawing Title	編號 Revi						
J853-FW-3014F	位置圖	-						
J853-FW-3016F	位置圖	-						
J853-FW-3024F	位置圖	-						
J853-FW-3025F	位置圖	-						
J853-FW-3032F	位置圖	-						
J853-FW-3033F	位置圖	-						
P2-UN-C01A	鋁料組裝圖	-						
P2-UN-C01B	鋁料組裝圖	-	A					
P2-UN-C01C	鋁料組裝圖	-	A					
P2-UN-C01D	鋁料組裝圖	-						
P2-UN-C01E	鋁料組裝圖	-						
P2-UN-Z01F	鋁料組裝圖	-	A					
P2-UN-Z01G	鋁料組裝圖	-	A					
P2-UN-L01H	鋁料組裝圖	-						
P2-UN-L01J	鋁料組裝圖	-						
P2-UN-L01K	鋁料組裝圖	-						
P2-UN-K01L	鋁料組裝圖	-						
P2-UN-K01M	鋁料組裝圖	-						
P2-UN-K01N	鋁料組裝圖	-						
P2-UN-K01P	鋁料組裝圖	-						
P2-UN-ZL02	鋁料組裝圖	-						
P2-UN-C03A	鋁料組裝圖	-	A					
P2-UN-C03B	鋁料組裝圖	-						
P2-UN-C03C	鋁料組裝圖	-						
P2-UN-C03D	鋁料組裝圖	-						
P2-UN-C03E	鋁料組裝圖	-						
P2-UN-L03F	鋁料組裝圖	-						
P2-UN-L03G	鋁料組裝圖	-						
P2-UN-K03H	鋁料組裝圖	-						
P2-UN-K03J	鋁料組裝圖	-						
P2-UN-K03K	鋁料組裝圖	-						
P2-UN-C04A	鋁料組裝圖	-						
P2-UN-C04B	鋁料組裝圖	-						

AW-YB-C21	鋁料組裝圖	-																		
AW-YB-C24	鋁料組裝圖	-																		
AL-21	鋁料加工圖	-																		
AL-21R	鋁料加工圖	-																		
AL-22	鋁料加工圖	-																		
AL-22R	鋁料加工圖	-																		
AL-C24	鋁料加工圖	-																		
AL-C24R	鋁料加工圖	-																		
ML-C21	鋁料加工圖	-																		
ML-C21a	鋁料加工圖	-																		
P2-AL-C31	鋁料加工圖	-																		
P2-AL-C32	鋁料加工圖	-																		

PROJECT: YIN PING ROAD KOWLOON FEATURE WALL (PHASE 2)

REV.	DESCRIBED DATE	Dim. A	Dim. B	Dim. C	Dim. D	Dim. E	Dim. F	Dim. G	Dim. H	QTY.	Inv. Code	COATING	MATERIAL 格栅组装图	COLOUR	MARK. NO.	QTY.
-										3			ASSEMBLE ON PARTS			

序号	编号	数量
①	P2-AL-C03B	7
②	P2-AL-C04B	7
③	P2-AL-C02	7
④	P2-AP-C02B	1
⑤	P2-AL-C01	7
⑥	P2-AP-C01	4

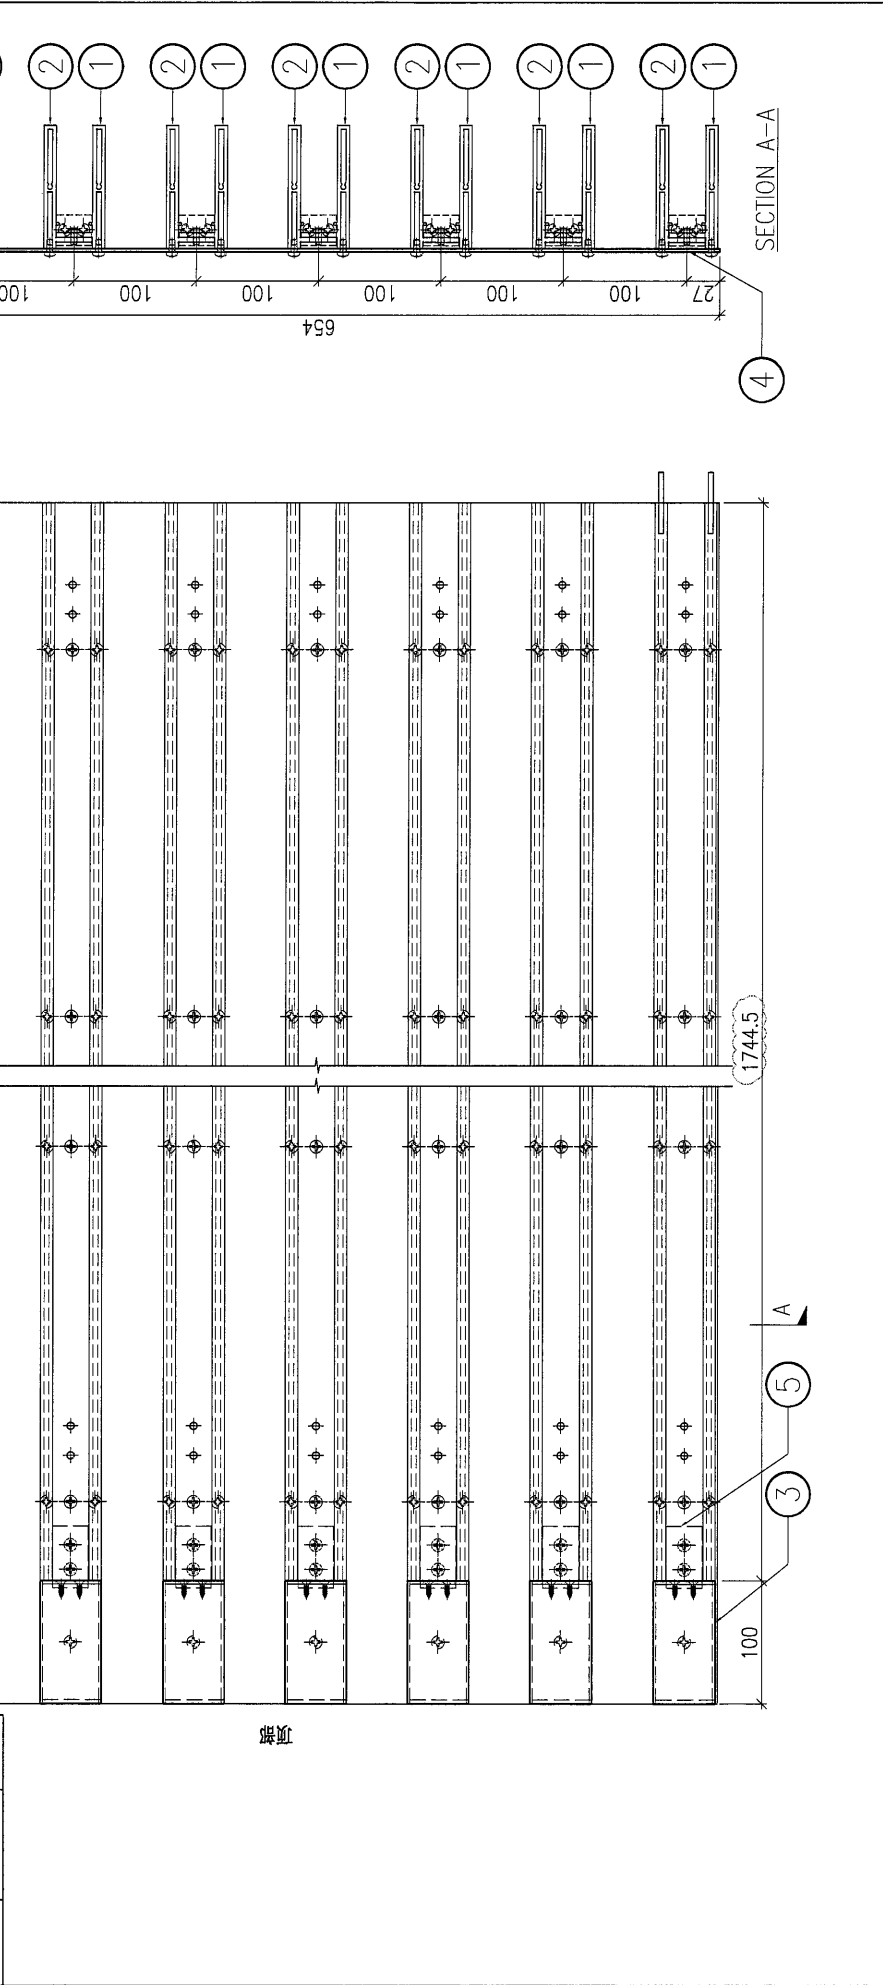

DWG. NO. P2-UN-C01B
 REV. A
 SCALE -
 DATE 10-07-2024
 DRAWN BY -
 APPROVED BY -

注: 地盘用


注: 用于C区域

竣工

PROJECT: YIN PING ROAD KOWLOON FEATURE WALL (PHASE 2)

REV.	REVISED DRAW BY	PART NUMBER	Dim. A	Dim. B	Dim. C	Dim. D	Dim. E	Dim. F	Dim. G	Dim. H	QTY.	Inv. Code	COATING	MATERIAL	ASSEMBLE ON PARTS	MARK. NO.	QTY.
-	-	P2-UN-C01C	-	-	-	-	-	-	-	-	1	-	-	格柵組裝圖	-	-	-

序号	编号	数量
①	P2-AL-C03C	7
②	P2-AL-C04C	7
③	P2-AL-C02	7
④	P2-AP-C02C	1
⑤	P2-AL-C01	7
⑥	P2-AP-C01	4

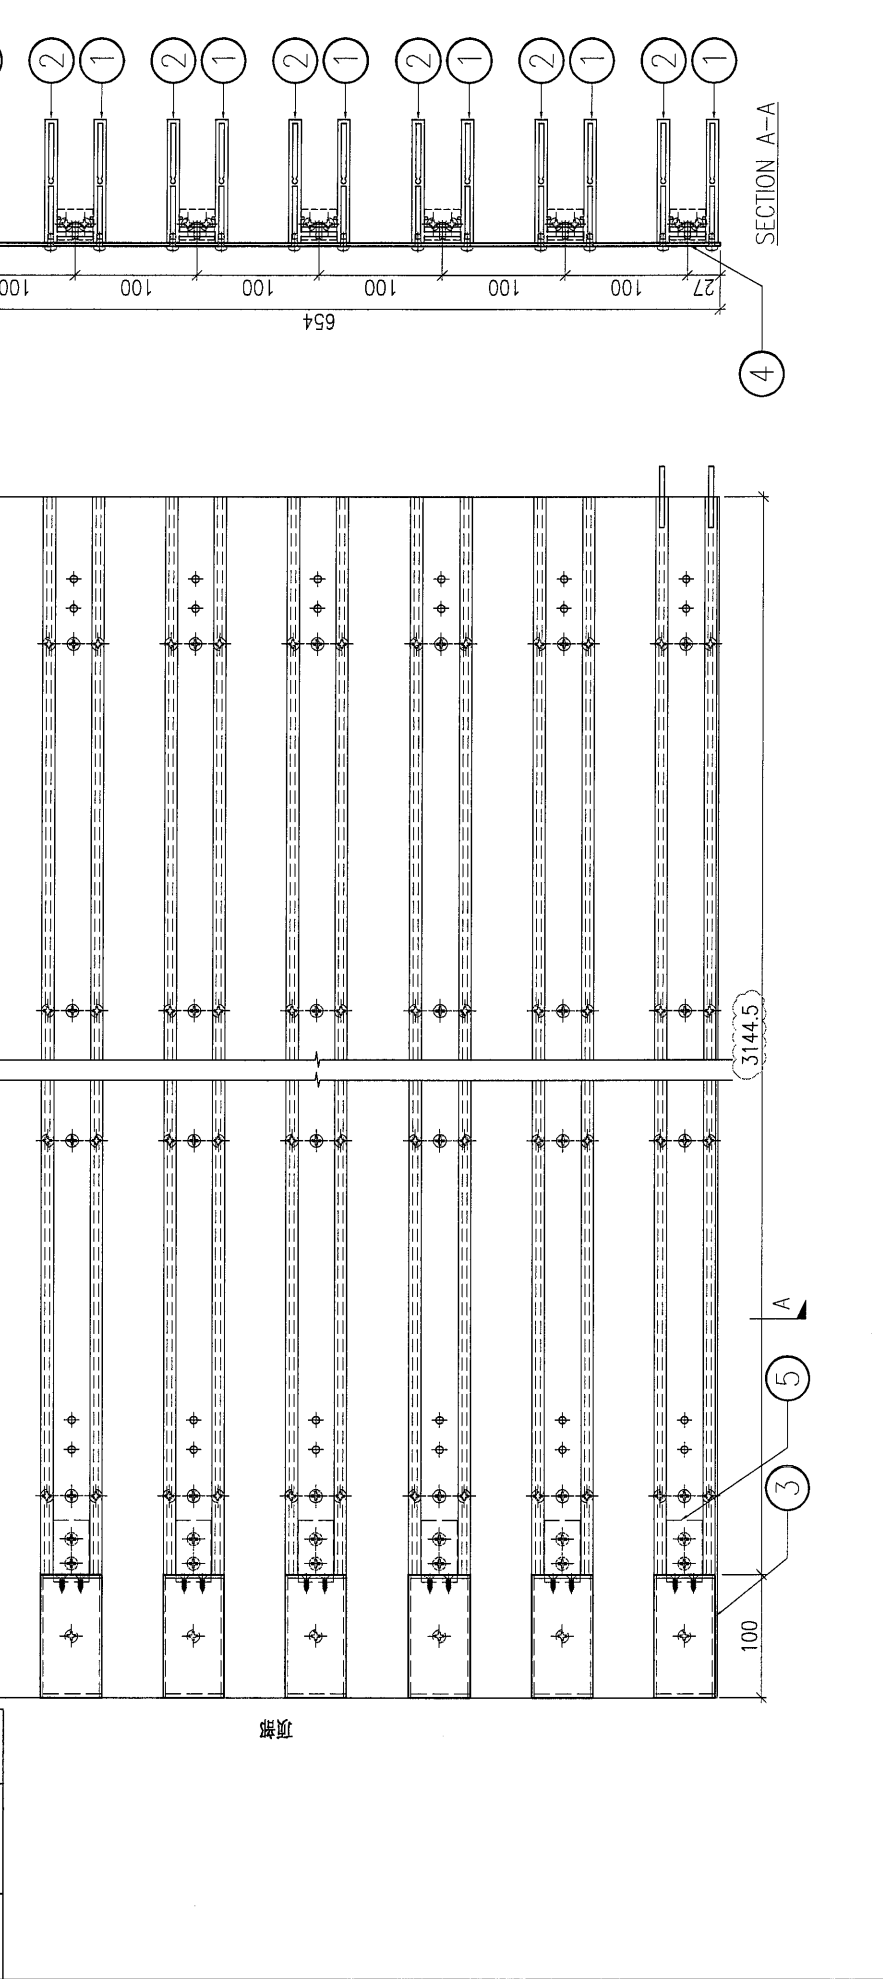


DWG. NO.	P2-UN-C01C	REV.	A	SCALE	-	DATE	10-07-2024	DRAWN BY	-	APPROVED BY	-
----------	------------	------	---	-------	---	------	------------	----------	---	-------------	---

PROJECT: YIN PING ROAD KOWLOON FEATURE WALL (PHASE 2)

MARK. NO.	COLOUR	COATING	MATERIAL	格栅组装图							QTY.
				ASSEMBLE ON PARTS							
				注: 用于 Z 区域							

REV.	CHECKED BY	PART NUMBER	Dim. A	Dim. B	Dim. C	Dim. D	Dim. E	Dim. F	Dim. G	Dim. H	QTY.	Inv. Code
--		P2-UN-Z01F									2	

序号	编号	数量
①	P2-AL-C03F	7
②	P2-AL-C04F	7
③	P2-AL-C02	7
④	P2-AP-C02F	1
⑤	P2-AL-C01	7
⑥	P2-AP-C01	4

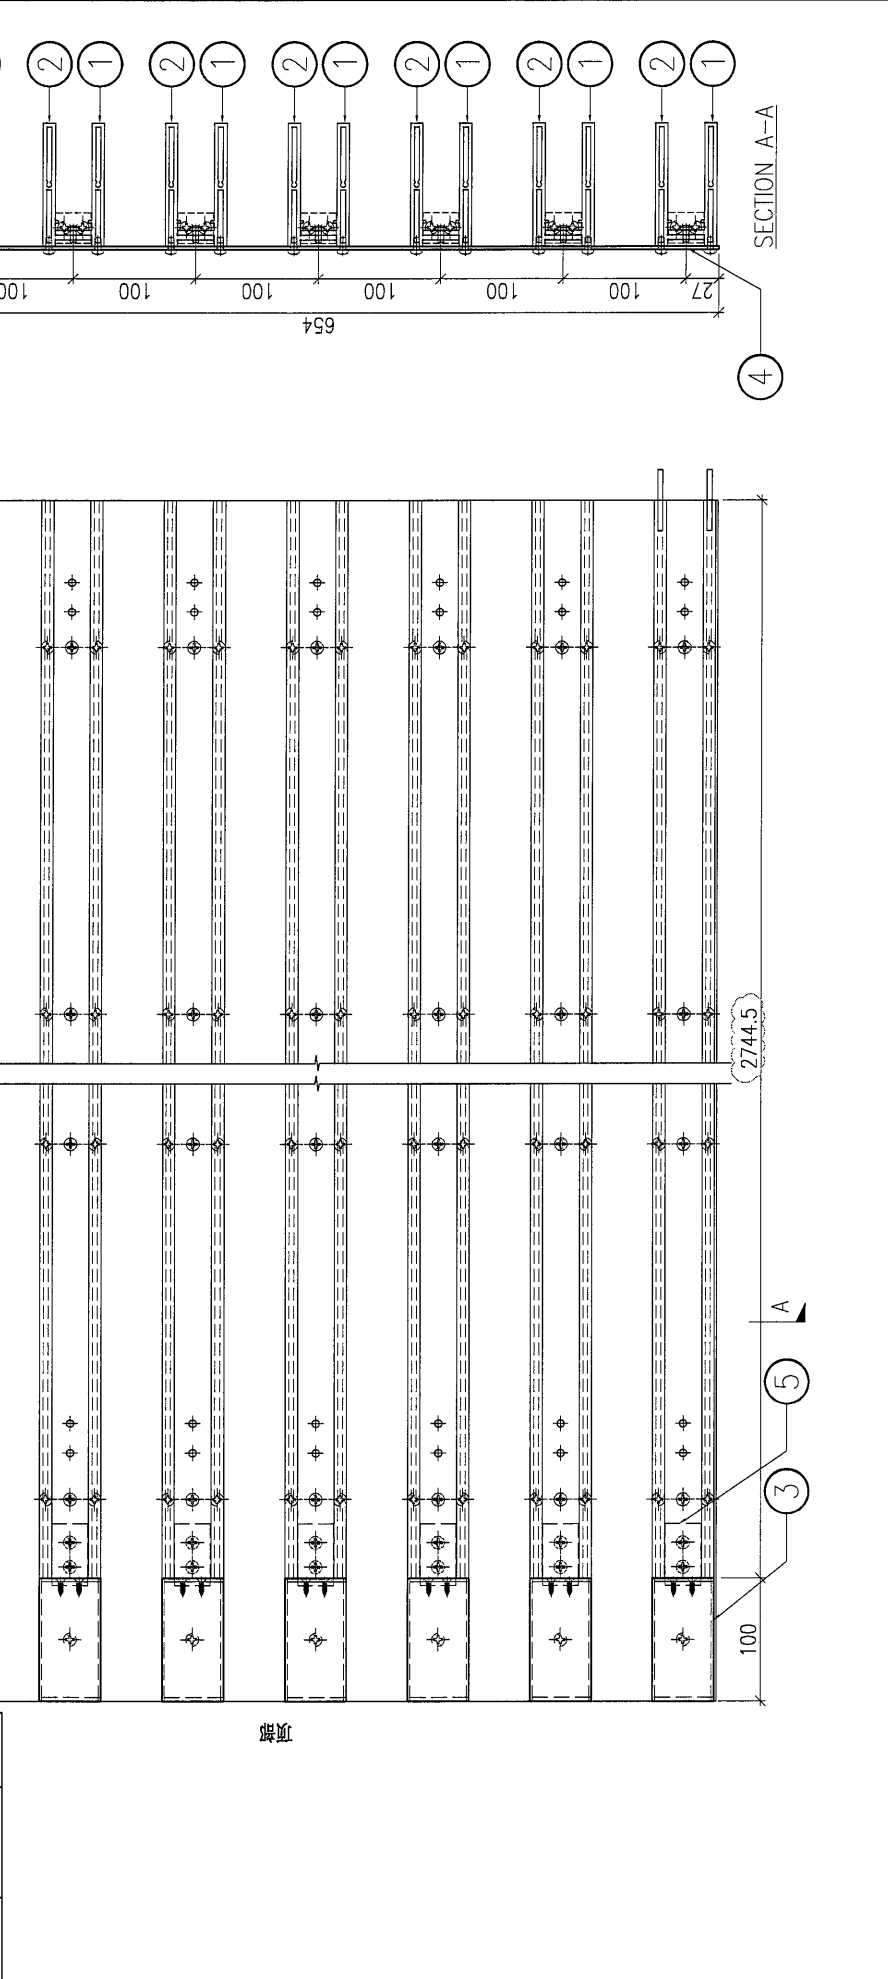


DWG. NO.	REV.	SCALE	DATE	DRAWN BY	APPROVED BY
P2-UN-Z01F	A		10-07-2024		

PROJECT: YIN PING ROAD KOWLOON FEATURE WALL (PHASE 2)

REV.	CHANGED BY	Dim. A	Dim. B	Dim. C	Dim. D	Dim. E	Dim. F	Dim. G	Dim. H	QTY.	Inv. Code	ASSEMBLE ON PARTS	MARK. NO.	COLOUR	QTY.
-	-	-	-	-	-	-	-	-	-	4	-	-	-	-	-

序号	编号	数量
①	P2-AL-003G	7
②	P2-AL-004G	7
③	P2-AL-002	7
④	P2-AP-002G	1
⑤	P2-AL-001	7
⑥	P2-AP-001	4

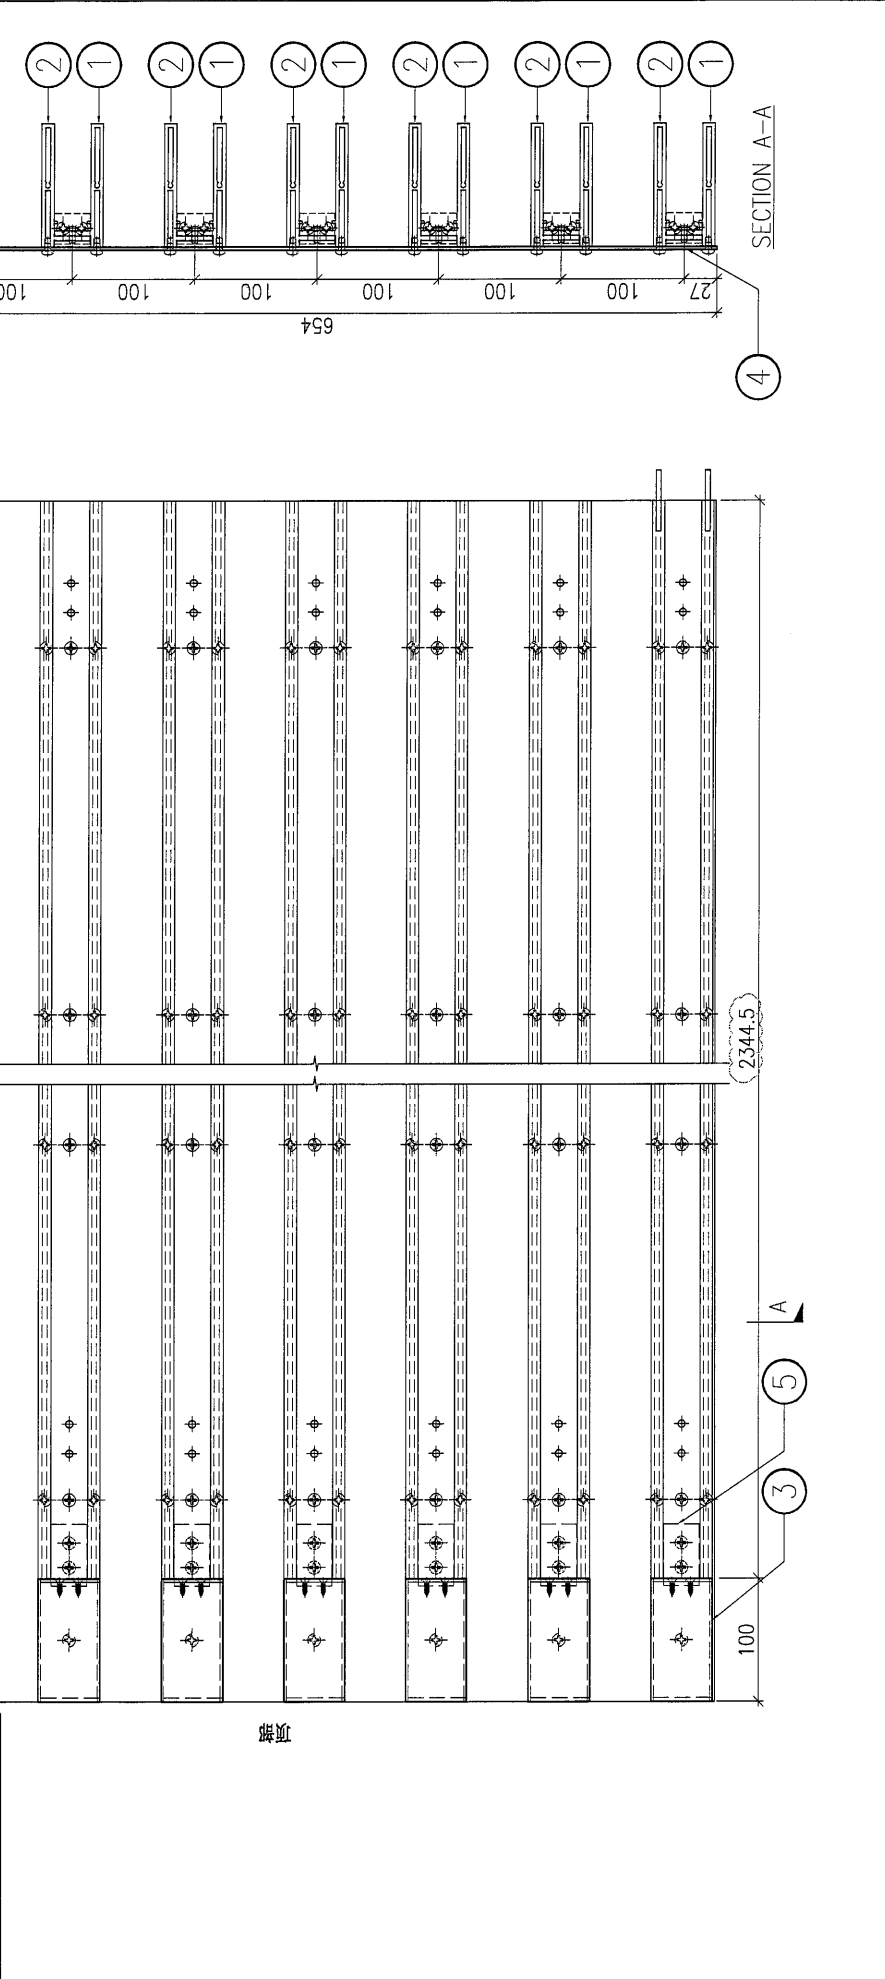

DWG. NO.	REV.	SCALE	DATE	DRAWN BY	APPROVED BY
P2-UN-Z01G	A	-	10-07-2024	-	-

PROJECT: YIN PING ROAD KOWLOON FEATURE WALL (PHASE 2)

MATERIAL: 格栅组装图


COATING: -

MARK. NO.: -

QTY.: -

REV.	CHANGED BY	Dim. A	Dim. B	Dim. C	Dim. D	Dim. E	Dim. F	Dim. G	Dim. H	QTY.	Inv. Code	ASSEMBLE ON PARTS
-	-	-	-	-	-	-	-	-	-	5	-	注: 用于 C 区域

序号	编号	数量
①	P2-AL-C07A	7
②	P2-AL-C08A	7
③	P2-AL-C02	14
④	P2-AP-C04A	1
⑤	P2-AL-C01	14

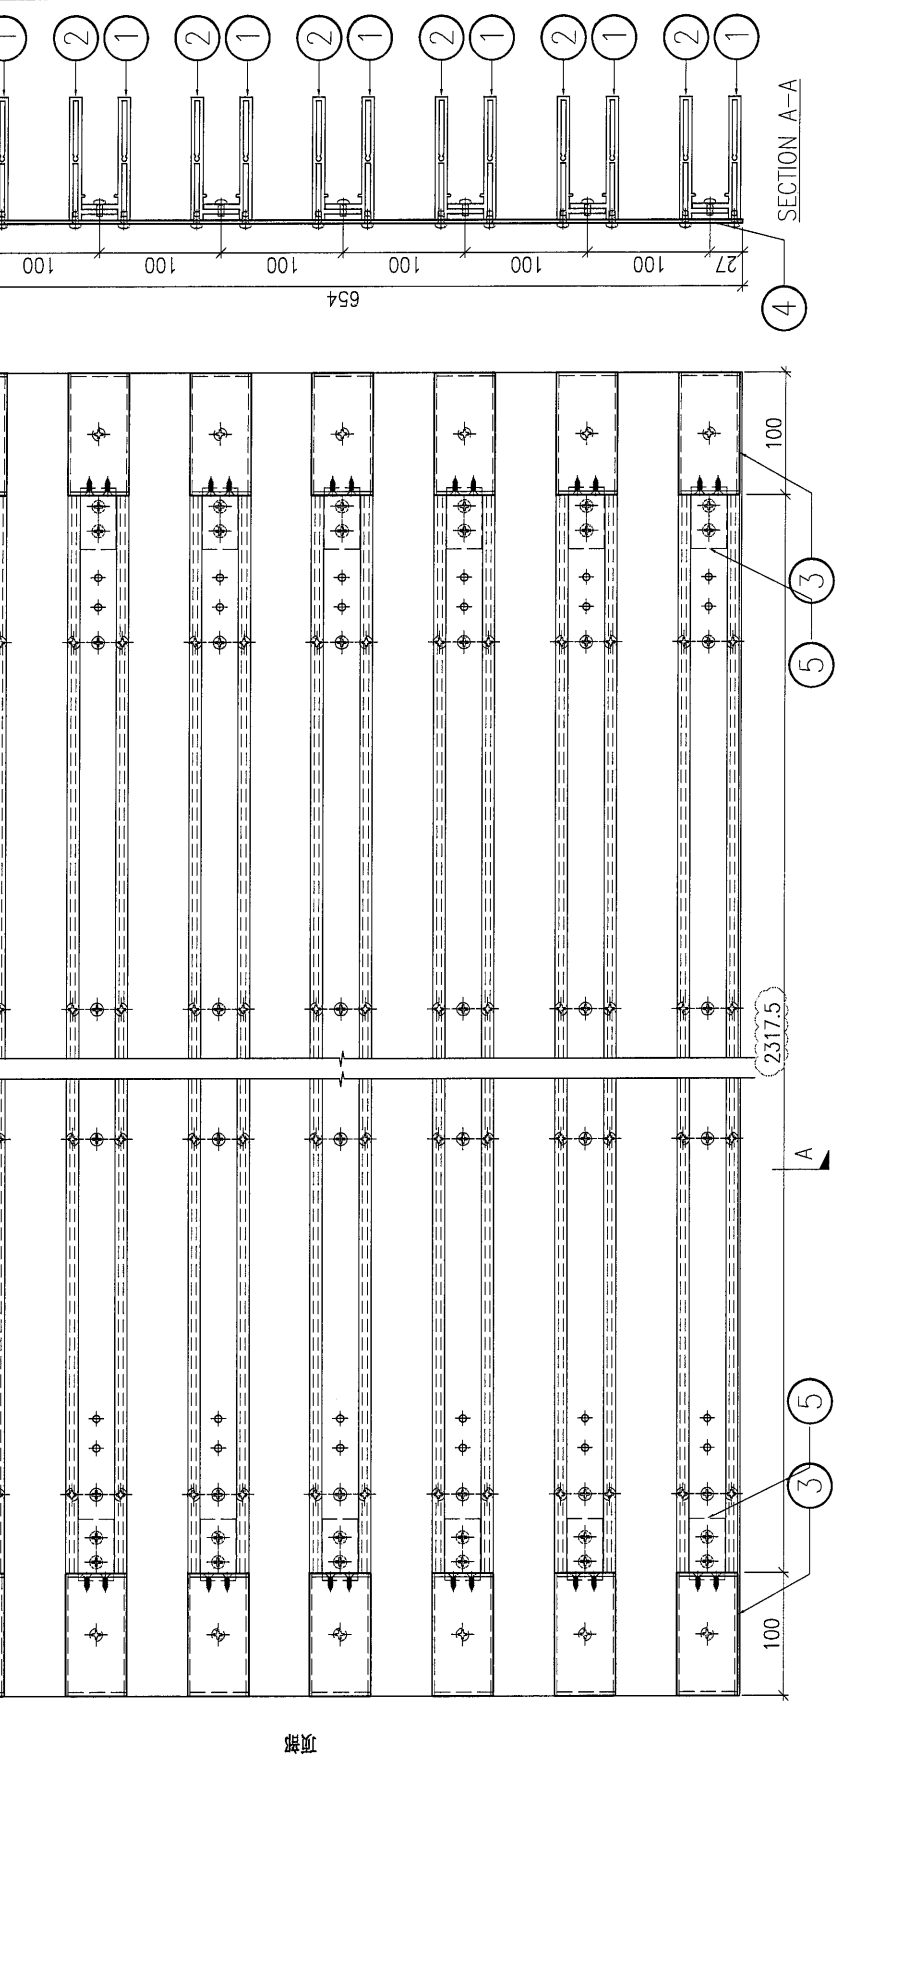


DWG. NO.	REV.	SCALE	DATE	DRAWN BY	APPROVED BY
P2-UN-C03A	A	-	10-07-2024	-	-

PROJECT: YIN PING ROAD KOWLOON FEATURE WALL (PHASE 2)

MARK. NO.	COLOUR	COATING	MATERIAL	格柵組裝圖	QTY.
-	-	-	ASSEMBLE ON PARTS	注: 用于 C 区域	-

Rev.	Checked Date	Part Number	Dim. A	Dim. B	Dim. C	Dim. D	Dim. E	Dim. F	Dim. G	Dim. H	QTY.	Inv. Code
-		P2-UN-C06	-	-	-	-	-	-	-	-	1	

序号	编号	数量
①	P2-AL-C07M	4
②	P2-AL-C08M	4
③	P2-AL-C02	14
④	P2-AP-C07	1
⑤	P2-AL-C01	14
⑥	P2-AL-C07L	3
⑦	P2-AL-C08L	3

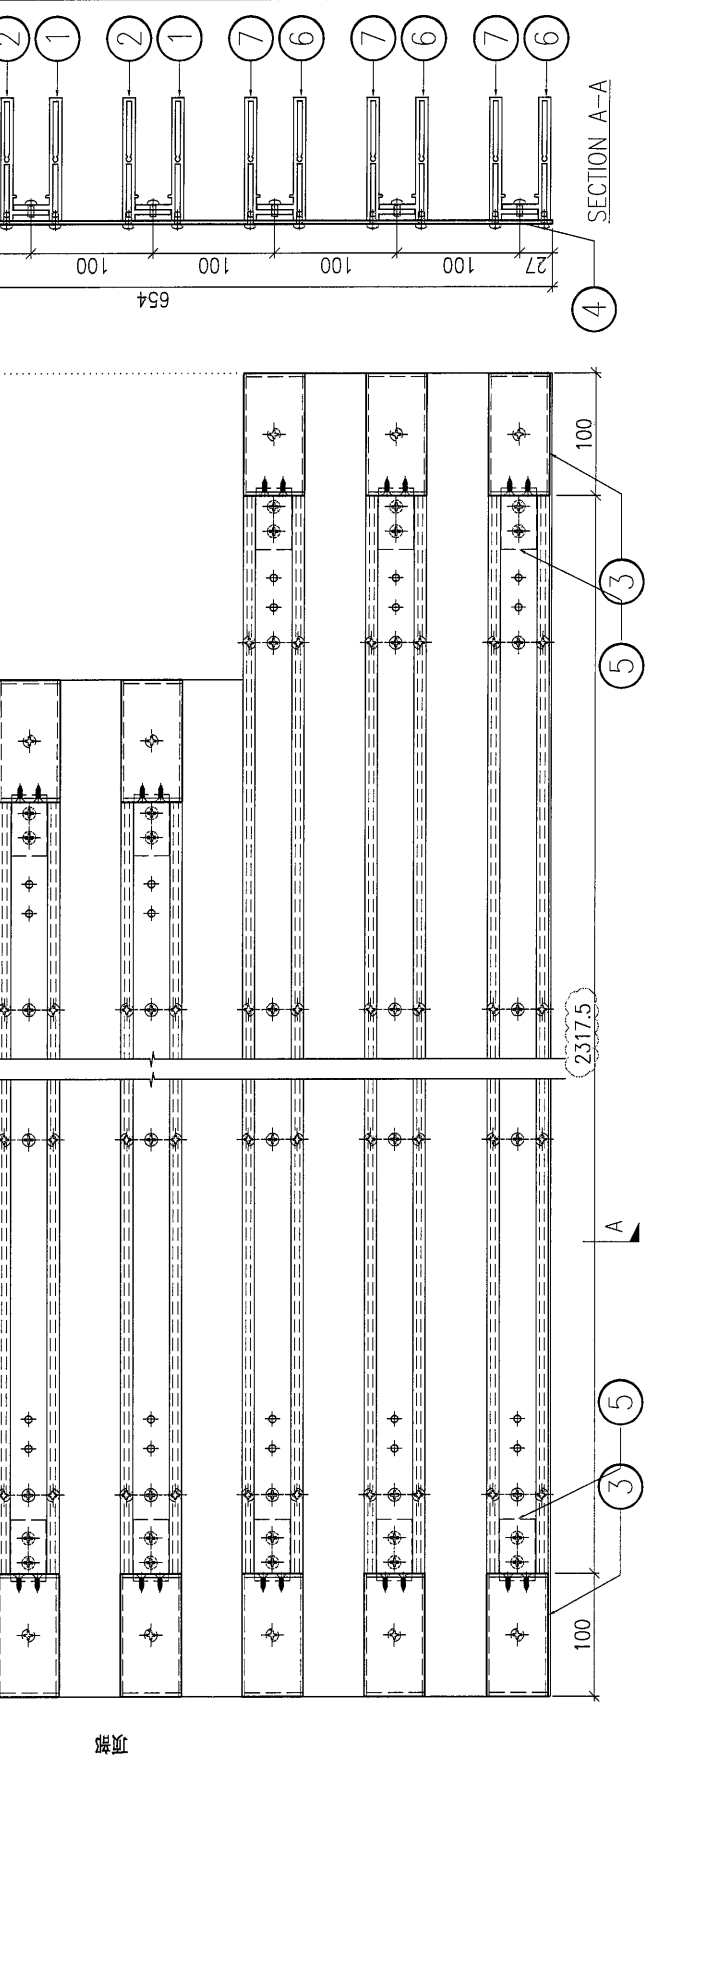

DWG. NO.	REV.	SCALE	DATE	DRAWN BY	APPROVED BY
P2-UN-C06	A	-	10-07-2024	-	-

PROJECT

YIN PING ROAD KOWLOON
FEATURE WALL (PHASE 2)

MATERIAL

格栅组装图

COATING

COLOUR

MARK. NO.

QTY.


REV.	CHECKED DATE	PART NUMBER	Dim. A	Dim. B	Dim. C	Dim. D	Dim. E	Dim. F	Dim. G	Dim. H	QTY.	Inv. Code
-		P2-UN-C07	-	-	-	-	-	-	-	-	1	

序号	编号	数量
①	P2-AL-C07A	6
②	P2-AL-C08A	6
③	P2-AL-C02	12
④	P2-AP-C08	1
⑤	P2-AL-C01	12

ASSEMBLE ON PARTS

注: 用于 C 区域

注: 地盘用

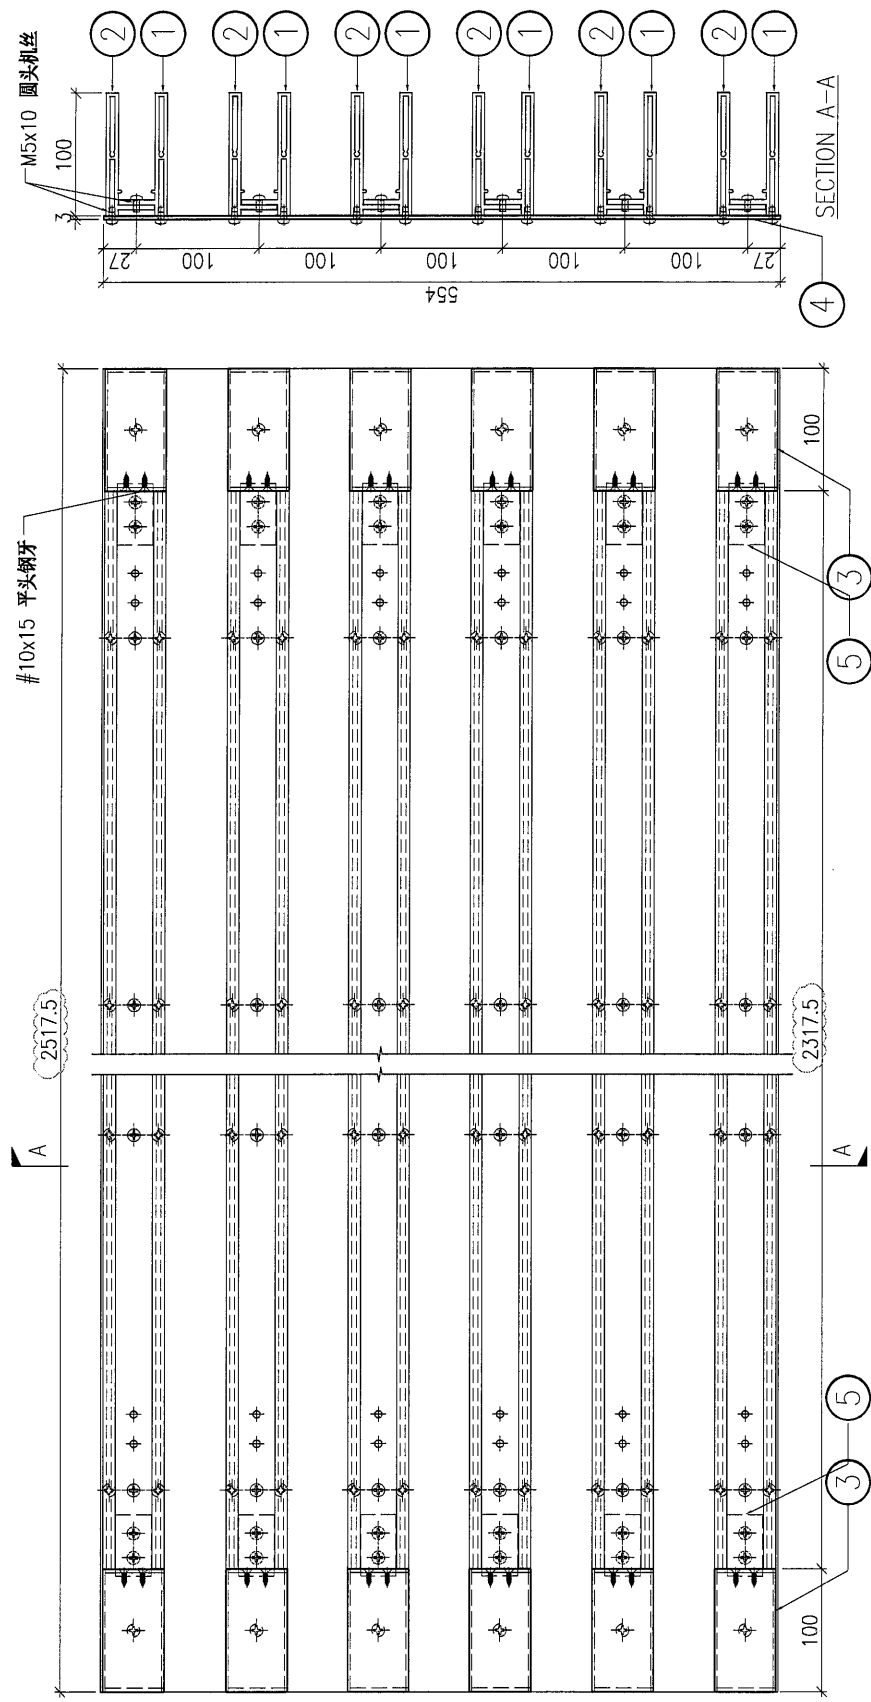

备注

DWG. NO.

P2-UN-C07

REV.

A

SCALE

DATE
10-07-2024

DRAWN BY

APPROVED BY

PROJECT

YIN PING ROAD KOWLOON
FEATURE WALL (PHASE 2)

MATERIAL

格栅组装图

COATING

COLOUR


MARK. NO.

QTY.

注: 地盘用

REV.	CHECKED BY	Dim. A	Dim. B	Dim. C	Dim. D	Dim. E	Dim. F	Dim. G	Dim. H	QTY.	Inv. Code	ASSEMBLE ON PARTS
-	-	-	-	-	-	-	-	-	-	2	-	-

序号	编号	数量
①	P2-AL-H03B	7
②	P2-AL-H04B	7
③	P2-AL-H02	7
④	P2-AP-H02B	1
⑤	P2-AL-H01	7
⑥	P2-AP-H01	4

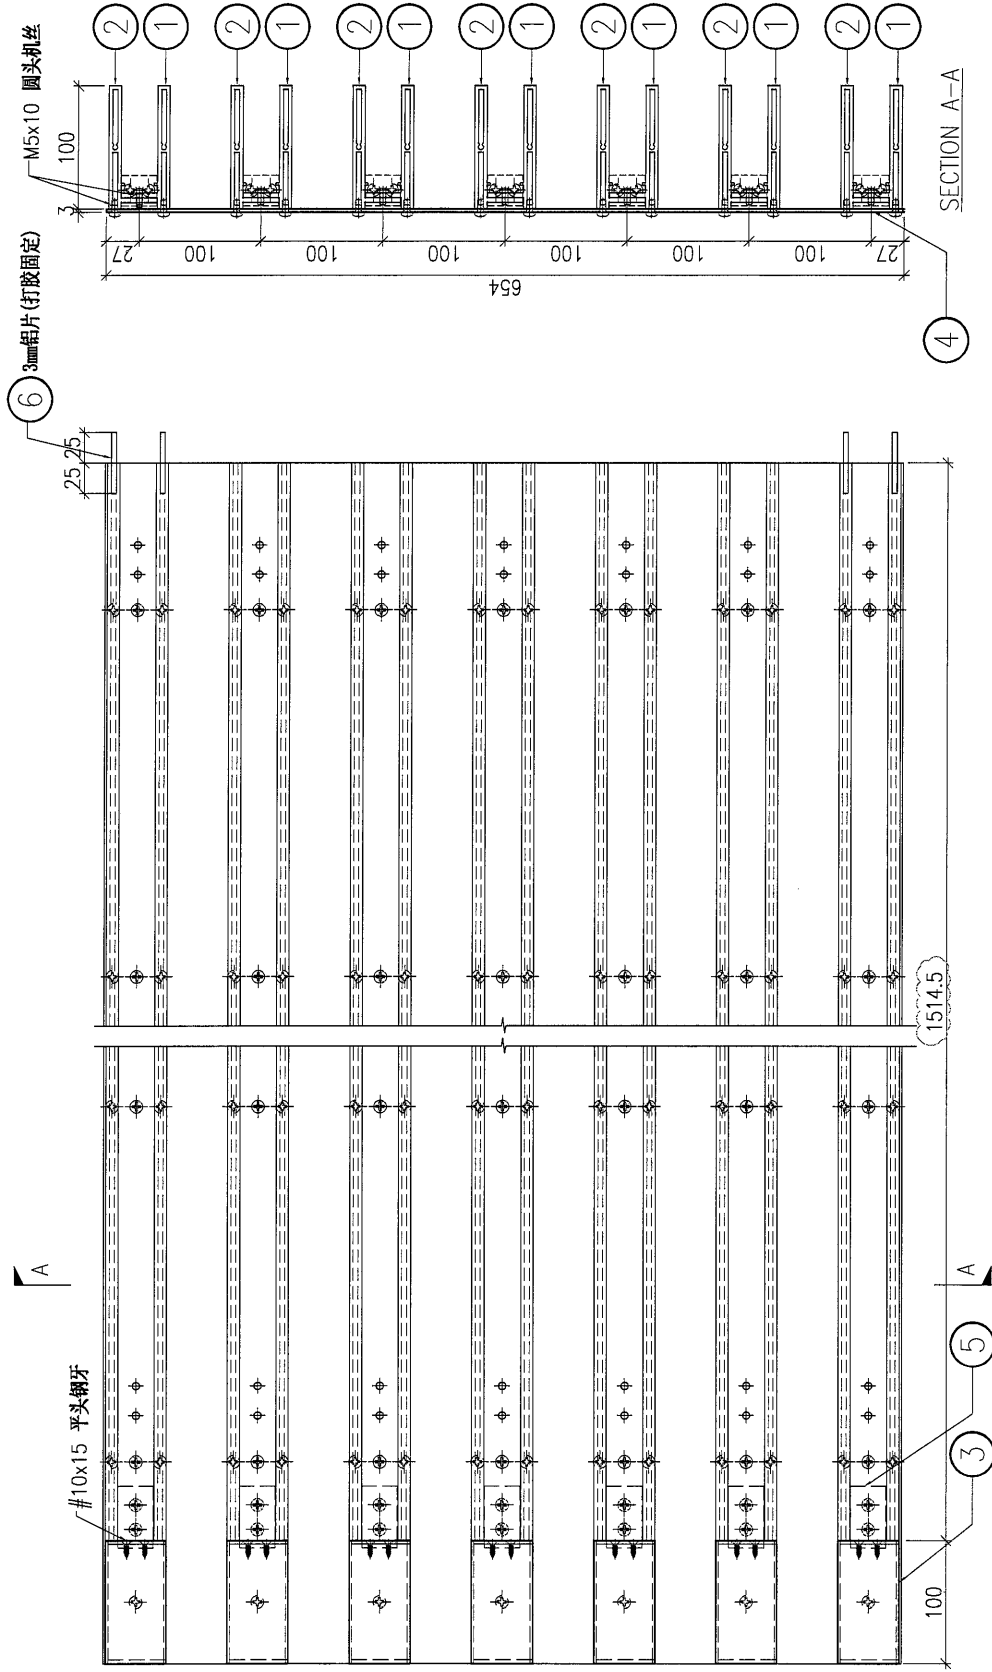

警告

DWG. NO.

P2-UN-H02

REV.

A

SCALE

DATE
08-07-2024

DRAWN BY

APPROVED BY

PROJECT: YIN PING ROAD KOWLOON FEATURE WALL (PHASE 2)

MATERIAL: 格栅组装图

COLOUR: -


MARK. NO.: -

QTY.: -

REV.	DESCRIPTION	Dim. A	Dim. B	Dim. C	Dim. D	Dim. E	Dim. F	Dim. G	Dim. H	QTY.	Inv. Code	ASSEMBLE ON PARTS
-	-	-	-	-	-	-	-	-	-	1	-	-

注: 地盘用

序号	编号	数量
①	P2-AL-H03C	7
②	P2-AL-H04C	7
③	P2-AL-H02	7
④	P2-AP-H02C	1
⑤	P2-AL-H01	7
⑥	P2-AP-H01	4

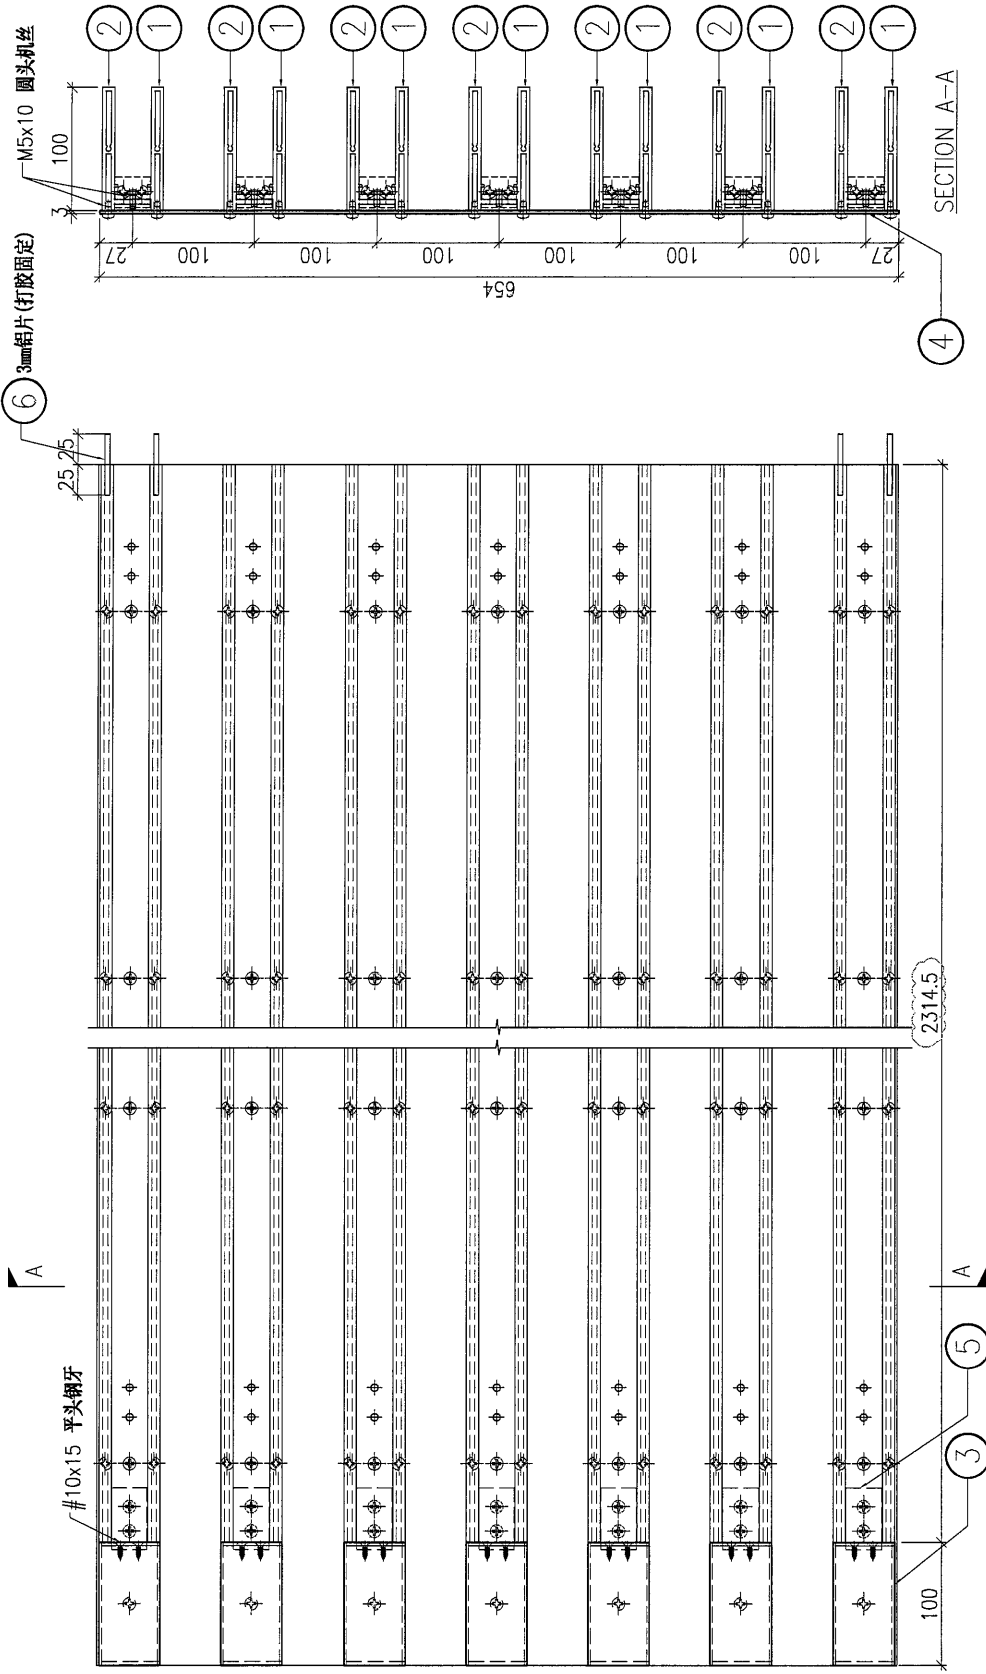

DWG. NO.: P2-UN-H03

REV.: A

SCALE: -

DATE: 08-07-2024

DRAWN BY: -

APPROVED BY: -

PROJECT

YIN PING ROAD KOWLOON
FEATURE WALL (PHASE 2)

MATERIAL

格栅组装图

COATING

COLOUR

MARK. NO.

QTY.

REV.

CHECKED
BAR BY

PART NUMBER

Dim. A

Dim. B

Dim. C

Dim. D

Dim. E

Dim. F

Dim. G

Dim. H

QTY.

Inv. Code

ASSEMBLE ON PARTS

注: 地盘用

注: 地盘用


注: 地盘用

注: 地盘用

序号	编号	数量
①	P2-AL-H03D	7
②	P2-AL-H04D	7
③	P2-AL-H02	7
④	P2-AP-H02D	1
⑤	P2-AL-H01	7
⑥	P2-AP-H01	4

A

#10x15 平头钢牙

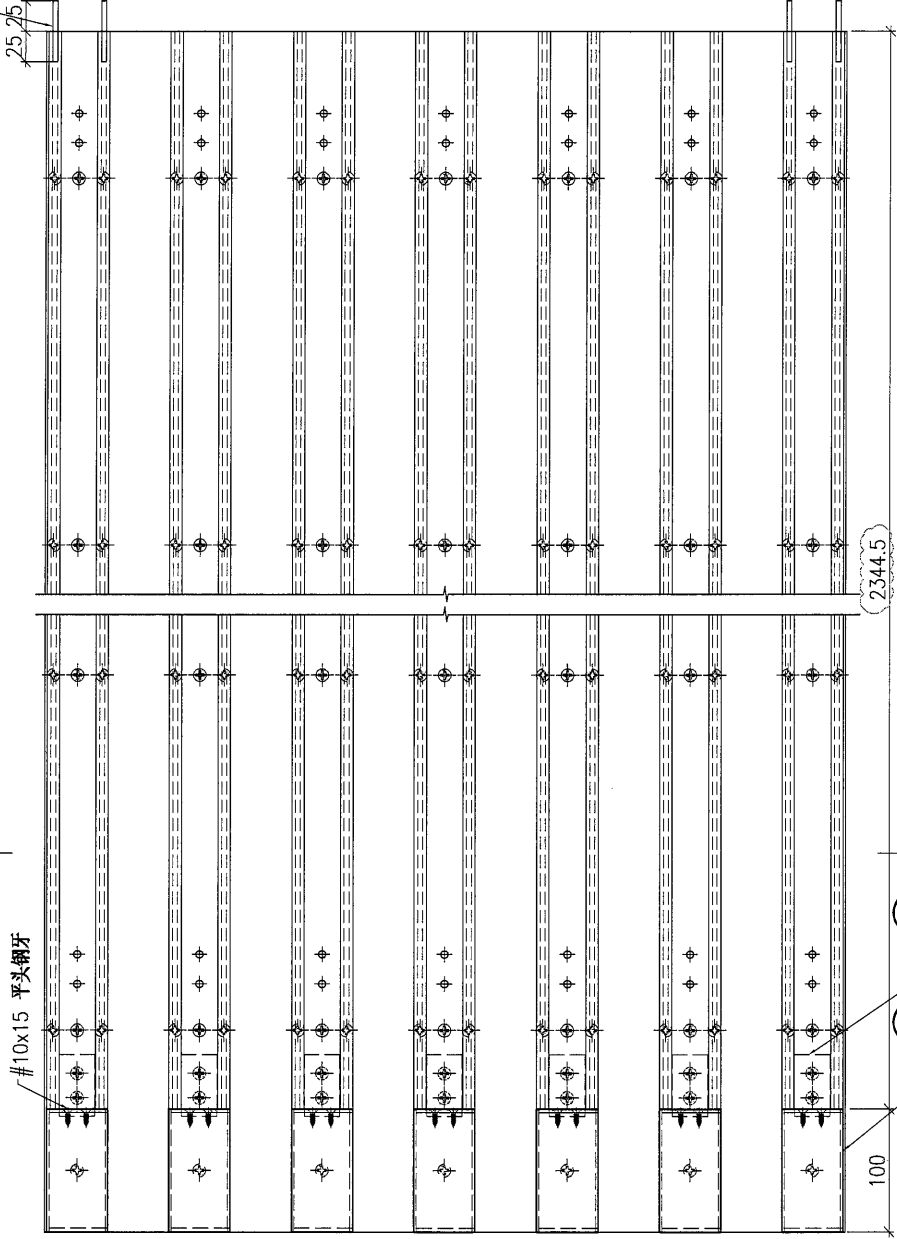

竖管

⑥ 3mm铝片 (打胶固定)

25.25

M5x10 圆头机丝

7

100

27

100

100

2344.5

100

100

⑤

③

④

SECTION A-A

DWG. NO.

P2-UN-H04

REV.

A

SCALE

DATE
08-07-2024

DRAWN BY

APPROVED BY

PROJECT

YIN PING ROAD KOWLOON
FEATURE WALL (PHASE 2)

MATERIAL

格栅组装图

COATING

COLOUR

MARK. NO.

QTY.

注: 地盘用

ASSEMBLE ON PARTS
注: 用于 A 区域

Inv. Code

QTY.

1

Dim. H

Dim. G

Dim. F

Dim. E

Dim. D

Dim. C

Dim. B

Dim. A

PART NUMBER

P2-UN-H07

P2-UN-H07

序号 数量


① P2-AL-H09 7

② P2-AL-H10 7

③ P2-AL-H02 14

④ P2-AP-H05 1

⑤ P2-AL-H01 14

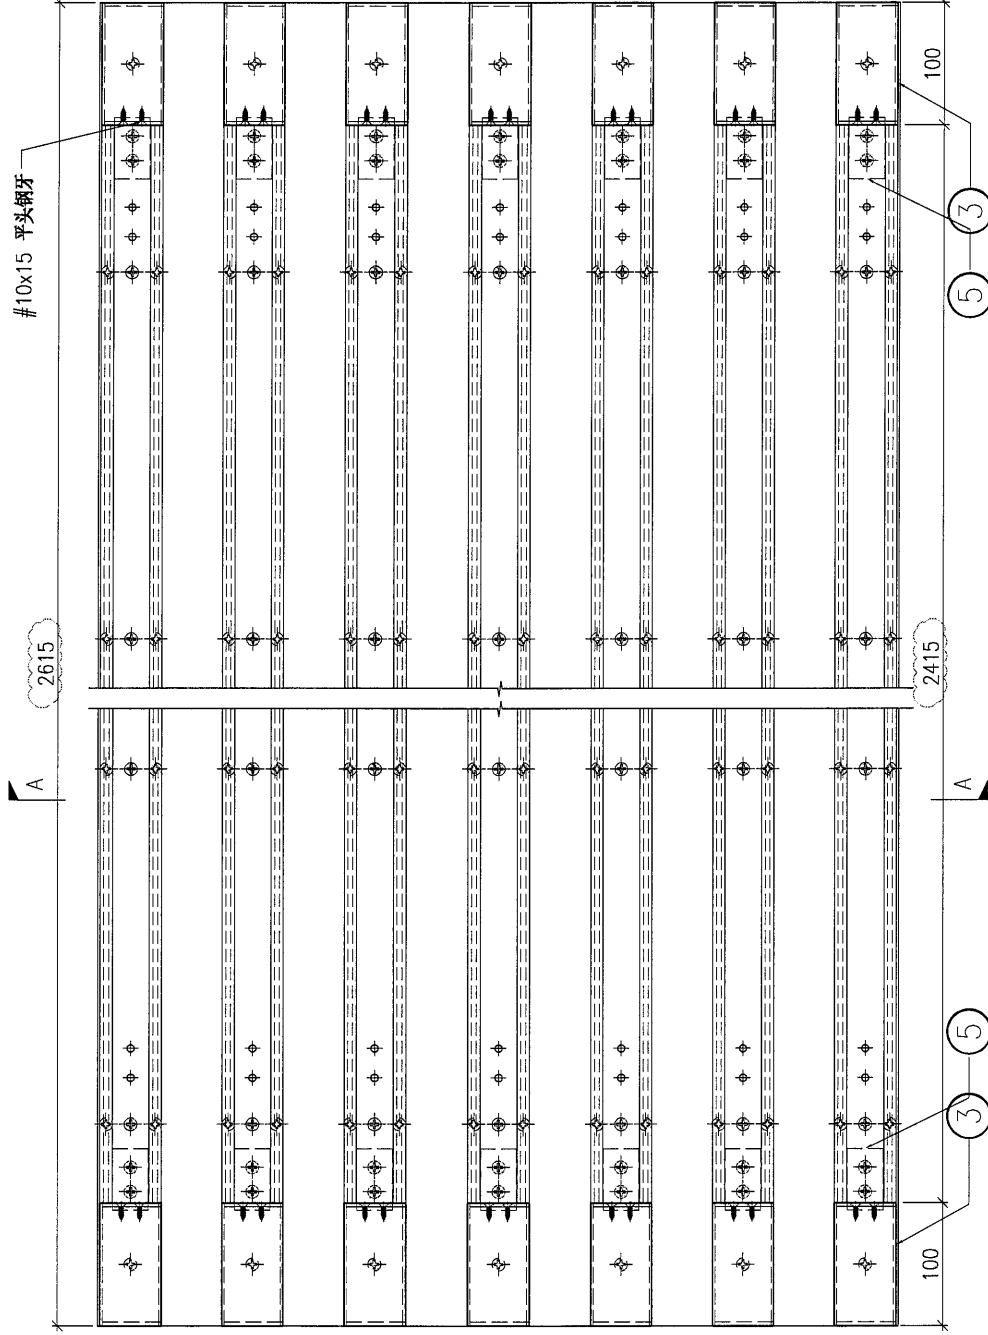

数量

DWG. NO.

P2-UN-H07

REV.

A

SCALE



DATE
08-07-2024

DRAWN BY

APPROVED BY

PROJECT: YIN PING ROAD KOWLOON FEATURE WALL (PHASE 2) MATERIAL: 铝型材 (X86425) COATING: PVF2 COLOUR: JMQ218640(SS-03) MARK. NO.: - QTY.: -

REV.	CHECKED DATE	PART NUMBER	Dim. A	Dim. B	Dim. C	Dim. D	Dim. E	Dim. F	Dim. G	Dim. H	QTY.	Inv. Code	ASSEMBLE ON PARTS	工厂用
-		P2-AL-C04A	2294.5	8X@270c/c	3X@650c/c	145	50				42			
-		P2-AL-C04B	1744.5	6X@265c/c	2X@700c/c	190	60				21			
-		P2-AL-C04C	3144.5	1X@265c/c	4X@700c/c	190	135				7			
-		P2-AL-C04D	1934.5	6X@300c/c	2X@750c/c	130	60				49			
-		P2-AL-C04E	2284.5	8X@270c/c	3X@650c/c	130	50				7			
-		P2-AL-C04F	2744.5	0X@260c/c	3X@750c/c	190	60				14			
-		P2-AL-C04G	2344.5	8X@275c/c	3X@650c/c	190	60				28			
-		P2-AL-C04H	1705	5X@300c/c	2X@750c/c	90	50				14			
-		P2-AL-C04J	805	2X@300c/c	1X@600c/c	90	50				21			
-		P2-AL-C04K	1134.5	4X@250c/c	1X@750c/c	90	50				28			
-		P2-AL-C04L	2345	8X@280c/c	3X@700c/c	90	50				14			
-		P2-AL-C04M	2375	8X@280c/c	3X@700c/c	90	50				14			
-		P2-AL-C04N	985	3X@300c/c	1X@700c/c	90	50				14			
-		P2-AL-C04P	2405	8X@280c/c	3X@700c/c	90	50				21			

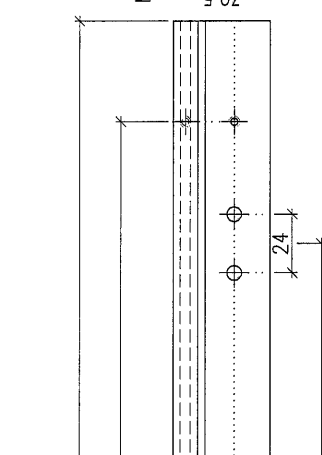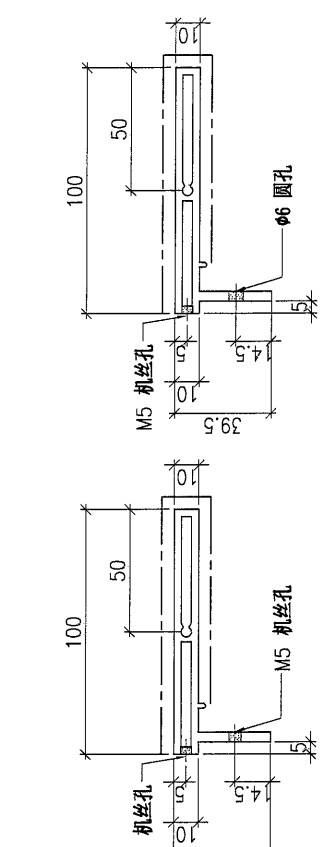

DWG. NO. P2-AL-C04	REV. A	SCALE -	DATE 21-06-2024	DRAWN BY -	APPROVED BY -
--------------------	--------	---------	-----------------	------------	---------------

PROJECT: YIN PING ROAD KOWLOON FEATURE WALL (PHASE 2)

MATERIAL: 铝型材 (X86424)


COATING: PVF2

COLOUR: JM0218640(SS-03)

MARK. NO.: -

QTY.: -

REV.	CHECKED DATE (D)	PART NUMBER	Dim. A	Dim. B	Dim. C	Dim. D	Dim. E	Dim. F	Dim. G	Dim. H	QTY.	Inv. Code	ASSEMBLE ON PARTS	注: 工厂用
-		P2-AL-C07A	2317.5	7XØ300c/c	190	3XØ650c/c	100				41			
-		P2-AL-C07B	1401.5	5XØ260c/c	144.5	3XØ600c/c	50				21			
-		P2-AL-C07C	2180	8XØ260c/c	130	3XØ650c/c	50				14			
-		P2-AL-C07D	1780	5XØ300c/c	130	2XØ750c/c	90				7			
-		P2-AL-C07E	1835	6XØ285c/c	130	2XØ750c/c	60				28			
-		P2-AL-C07F	825	2XØ300c/c	90	1XØ600c/c	50				14			
-		P2-AL-C07G	1135	3XØ300c/c	90	2XØ450c/c	50				21			
-		P2-AL-C07H	2005	7XØ270c/c	90	3XØ600c/c	50				14			
-		P2-AL-C07J	2115	7XØ280c/c	90	3XØ600c/c	50				14			
-		P2-AL-C07K	2845	9XØ300c/c	90	4XØ650c/c	50				14			
-		P2-AL-C07L	2317.5	8XØ265c/c	190	2XØ750c/c	50				3			
-		P2-AL-C07M	1852.5	6XØ265c/c	190	2XØ750c/c	50				4			

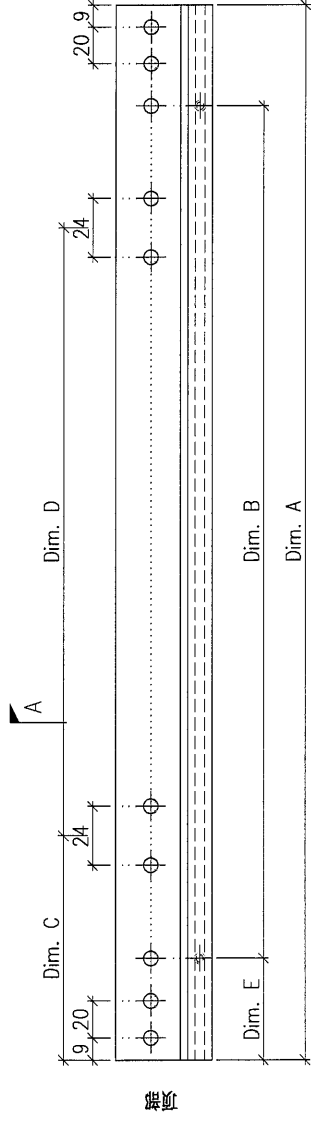

DWG. NO.: P2-AL-C07

REV.: A

SCALE: -

DATE: 21-06-2024


DRAWN BY: -

APPROVED BY: -

PROJECT: YIN PING ROAD KOWLOON FEATURE WALL (PHASE 2) MATERIAL: 铝型材 (X86425) COATING: PVF2 COLOUR: JM0218640(SS-03) MARK. NO.: - QTY.: -

REV.	CHECKED DATE BY	PART NUMBER	Dim. A	Dim. B	Dim. C	Dim. D	Dim. E	Dim. F	Dim. G	Dim. H	QTY.	Inv. Code	ASSEMBLE ON PARTS
-		P2-AL-H04A	2343.5	8X@280c/c	3X@650c/c	189	50				49		
-		P2-AL-H04B	1514.5	5X@280c/c	2X@550c/c	190	65				14		
-		P2-AL-H04C	2314.5	8X@275c/c	3X@650c/c	190	60				7		
-		P2-AL-H04D	2344.5	8X@280c/c	3X@650c/c	190	60				42		

A B

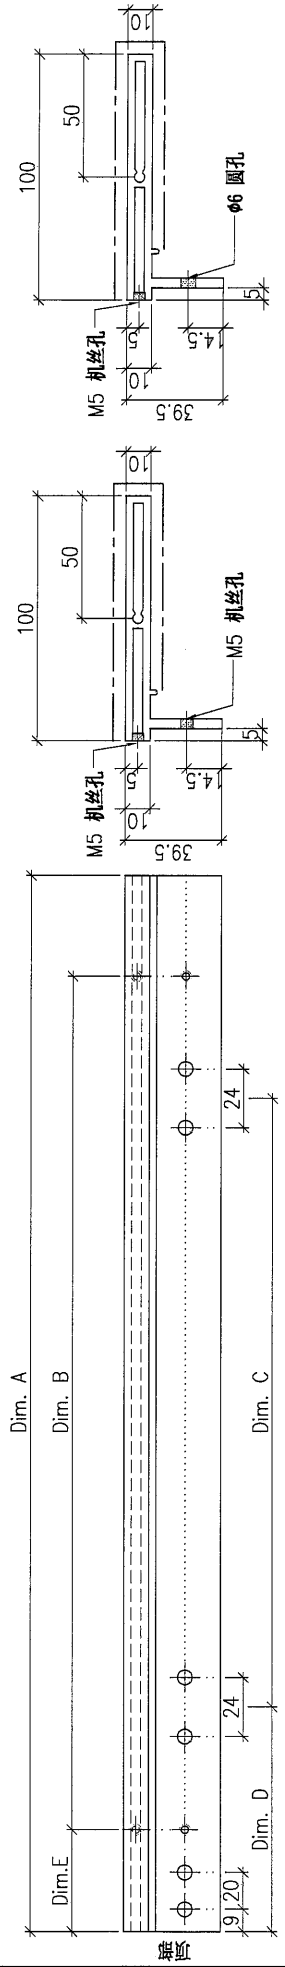


SECTION A-A

SECTION B-B

DWG. NO. P2-AL-H04	REV. A	SCALE -	DATE 08-07-2024	DRAWN BY -	APPROVED BY -
--------------------	--------	---------	-----------------	------------	---------------

PROJECT: YIN PING ROAD KOWLOON FEATURE WALL (PHASE 2) MATERIAL: 铝型材 (X86424) COATING: PVF2 COLOUR: JMQ218640(SS-03) MARK. NO. - QTY. -


REV.	DESCRIPTION / PART NO.	Dim. A	Dim. B	Dim. C	Dim. D	Dim. E	Dim. F	Dim. G	Dim. H	QTY.	Inv. Code	ASSEMBLE ON PARTS	工厂用
-	P2-AL-H07	1419.5	5X@260c/c	244.5	1X@750c/c	59.5				28			

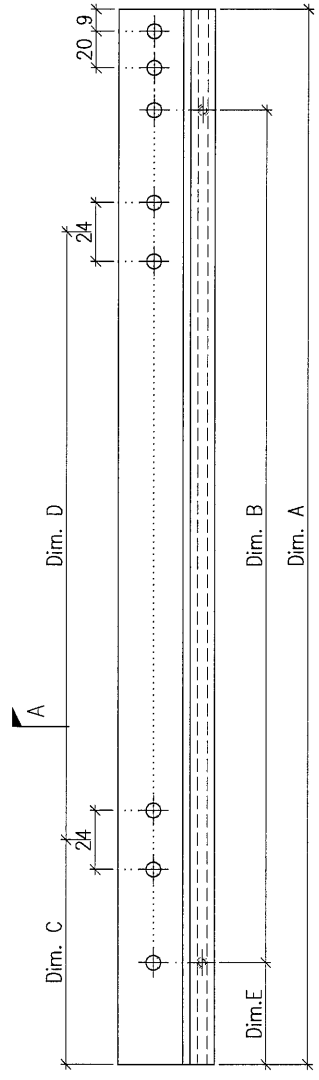

DWG. NO. P2-AL-H07	REV. -	SCALE -	DATE 08-07-2024	DRAWN BY -	APPROVED BY -
--------------------	--------	---------	-----------------	------------	---------------

PROJECT		YIN PING ROAD KOWLOON FEATURE WALL (PHASE 2)		MATERIAL		铝型材 (X86425)		COATING		PVF2		COLOUR		JM218640(SS-03)		MARK. NO.		-		QTY.		-	
---------	--	--	--	----------	--	--------------	--	---------	--	------	--	--------	--	-----------------	--	-----------	--	---	--	------	--	---	--



REV.	CHANGED BY	PART NUMBER	Dim. A	Dim. B	Dim. C	Dim. D	Dim. E	Dim. F	Dim. G	Dim. H	QTY.	Inv. Code	ASSEMBLE ON PARTS										
-		P2-AL-H08	1419.5	5X@260c/c	244.5	1X@750c/c	59.5				28			注: 工厂用									

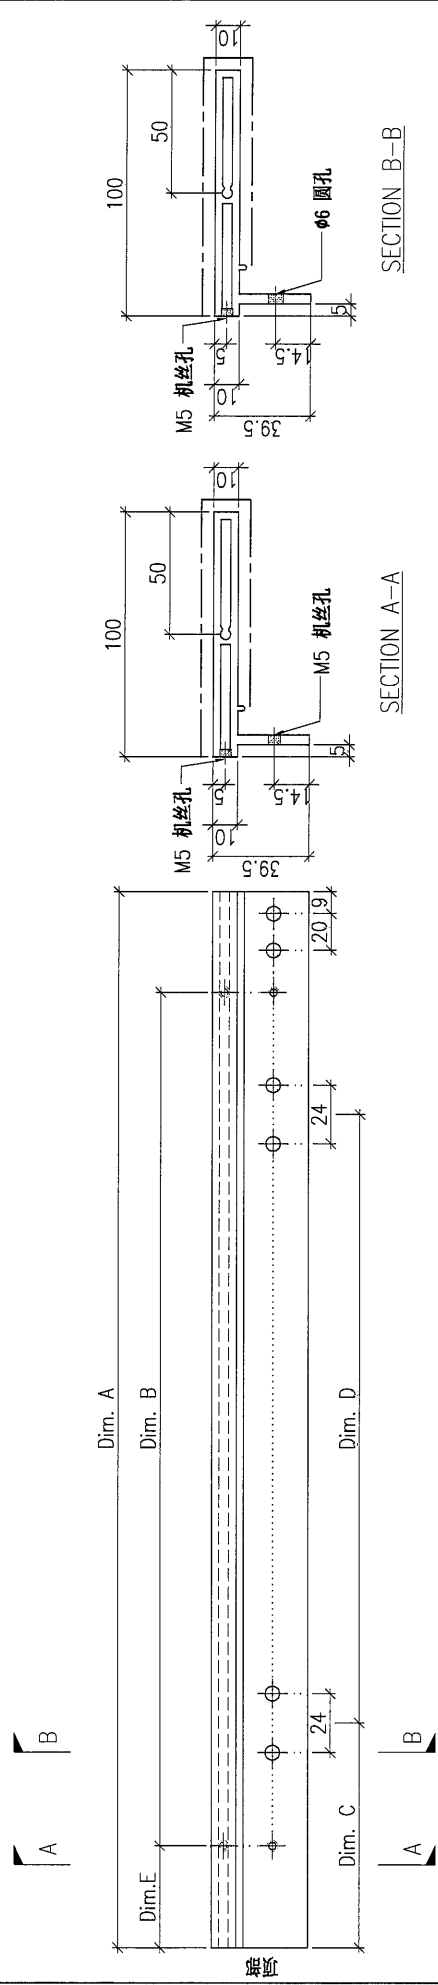

DWG. NO.		P2-AL-H08		REV.		-		SCALE		-		DATE		08-07-2024		DRAWN BY		-		APPROVED BY		-	
----------	--	-----------	--	------	--	---	--	-------	--	---	--	------	--	------------	--	----------	--	---	--	-------------	--	---	--

PROJECT		YIN PING ROAD KOWLOON FEATURE WALL (PHASE 2)		MATERIAL		铝型材 (X86424)		COATING		PVF2		COLOUR		JM0218640(SS-03)		MARK. NO.		-		QTY.		-	
---------	--	--	--	----------	--	--------------	--	---------	--	------	--	--------	--	------------------	--	-----------	--	---	--	------	--	---	--

REV.	CHECKED BY	PART NUMBER	Dim. A	Dim. B	Dim. C	Dim. D	Dim. E	Dim. F	Dim. G	Dim. H	QTY.	Inv. Code	ASSEMBLE ON PARTS									
-		P2-AL-H09	2415	8X@275c/c	190	3X@650c/c	80				7		注: 工厂用									

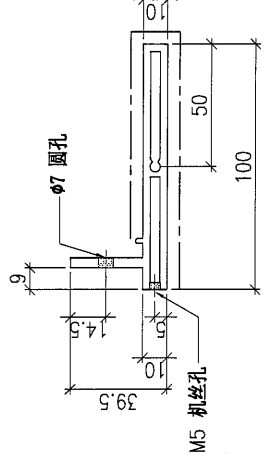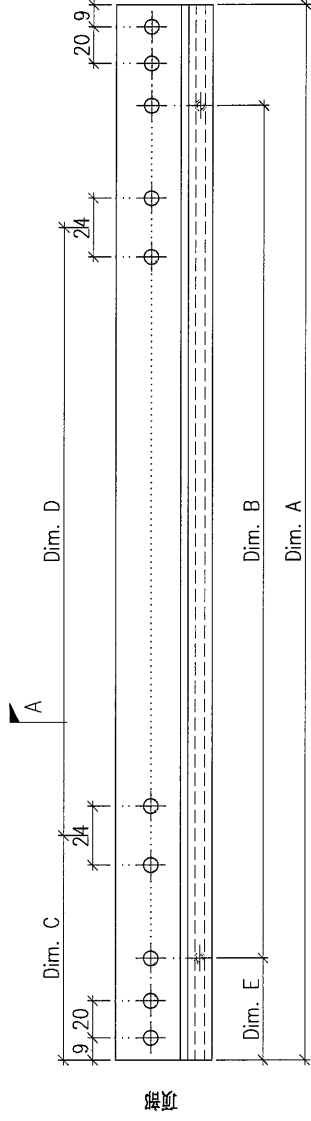


DWG. NO.		P2-AL-H09		REV.		A		SCALE		-		DATE		08-07-2024		DRAWN BY		-		APPROVED BY		-	
----------	--	-----------	--	------	--	---	--	-------	--	---	--	------	--	------------	--	----------	--	---	--	-------------	--	---	--

PROJECT: YIN PING ROAD KOWLOON FEATURE WALL (PHASE 2) MATERIAL: 铝型材 (X86425) COLOUR: JMQ218640(SS-03) MARK. NO. - QTY. -

REV.	CHECKED/DATE	PART NUMBER	Dim. A	Dim. B	Dim. C	Dim. D	Dim. E	Dim. F	Dim. G	Dim. H	QTY.	Inv. Code	COATING	ASSEMBLE ON PARTS
-		P2-AL-H10	2415	8X@275c/c	190	3X@650c/c	80				7		PVF2	ASSEMBLE ON PARTS

注: 工厂用

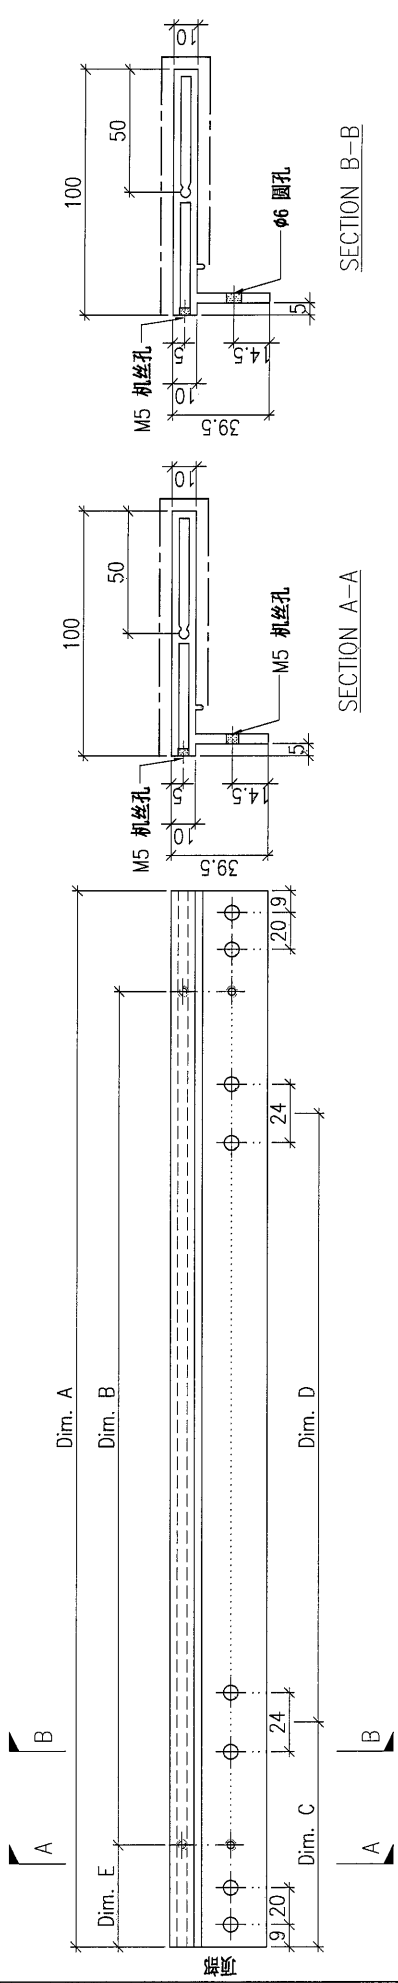

DWG. NO.	REV.	SCALE	DATE	DRAWN BY	APPROVED BY
P2-AL-H10	A	-	08-07-2024	-	-