

工程指示 / 要求簡箋 ENGINEER INSTRUCTIONS (E.I.)

工程指示編號:	EI-8092	修改版本:	C
	HK-1834		
工程編號:	J 853	工程名稱:	延坪道
收件人:	生統	發件人:	Joe Chan
工程項目:	Feature Wall (Part 7) 地盤用鋁板.	日期:	9/10/2024

<input checked="" type="checkbox"/> 原合約工程包	<input type="checkbox"/> 原合約工程加 / 減賬 QT-	<input type="checkbox"/> 新工程報價 QT-
--	--	------------------------------------

信件批核號碼/圖紙參考編號:	批核模具圖紙編號:
客戶指示附件:	管理內部批簽署:

<input type="checkbox"/> 初步鋁料 B.M.	<input type="checkbox"/> 加工拆圖, 然後生產	<input type="checkbox"/> 尺寸表
<input type="checkbox"/> 正式鋁料 B.M.	<input type="checkbox"/> 技術上資料/指示	<input type="checkbox"/> 報價
<input type="checkbox"/> 配件 B.M.	<input type="checkbox"/> 樣辦或貨品說明書	<input type="checkbox"/> 分判合約
<input type="checkbox"/> 其他:		

內容: 漏拆圖工件鋁板, 補回相關鋁板.
FW-X104 & FW-X204.




完成上列要求日期: 20/10/2024 ASAP


國內

<input type="checkbox"/> 生產技術總監	<input type="checkbox"/> 連附件	<input type="checkbox"/> 技術部	<input type="checkbox"/> 連附件	<input type="checkbox"/> 生產部	<input type="checkbox"/> 連附件
<input type="checkbox"/> 採購部	<input type="checkbox"/> 連附件	<input checked="" type="checkbox"/> 生產統籌部	<input checked="" type="checkbox"/> 連附件	<input type="checkbox"/> 報關組	<input type="checkbox"/> 連附件
<input type="checkbox"/> 質檢部	<input type="checkbox"/> 連附件	<input type="checkbox"/> 會計部	<input type="checkbox"/> 連附件	<input type="checkbox"/> 機械設計部	<input type="checkbox"/> 連附件
<input type="checkbox"/> 香港辦	<input type="checkbox"/> 連附件	<input type="checkbox"/> 其他:			


香港

<input type="checkbox"/> 行政部	<input type="checkbox"/> 連附件	<input type="checkbox"/> 會計部	<input type="checkbox"/> 連附件	<input type="checkbox"/> 統籌部	<input type="checkbox"/> 連附件	<input type="checkbox"/> 工程部	<input type="checkbox"/> 連附件
<input type="checkbox"/> 採購部	<input type="checkbox"/> 連附件	<input type="checkbox"/> QS部	<input type="checkbox"/> 連附件	<input checked="" type="checkbox"/> 地盤管理	<input checked="" type="checkbox"/> 連附件	<input type="checkbox"/> 維修部	<input type="checkbox"/> 連附件

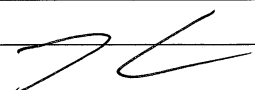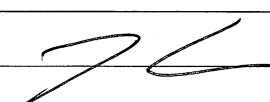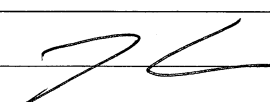*發件人簽署:  *組別成員批核簽署: 
傳遞編號: HK1834/24 項目經理簽署: 

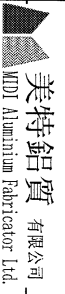		美特鋁質有限公司 MIDI Aluminium Fabricator Ltd.	工程號: J-853	計算: ming	日期: 2024.07.22	送呈: JOE						
地盤用鋁板B.M.表 (part 7)		項目類別: 特征牆 (2区)	地盤名稱: 廷坪路	核對:	日期: 2024.10.07	副本:						
BI編號:	修改內容	鋁板名稱	顏色	實用	後備	總數	總重量	單位展開面積	總展開面積	單位V.F.	總V.F.	圖紙編號
								平方米	平方米	平方米	平方米	
								343.982		總重量: 2796.57		
			A/C Code:									
1	FW-D50	3mm 厚鋁板	EC-DG-D334232-ZD1 (SS-01)	14	0	14	86.671	0.761	10.661	0.761	10.661	
2	FW-D51	3mm 厚鋁板	EC-DG-D334232-ZD1 (SS-01)	14	0	14	40.161	0.353	4.940	0.353	4.940	
3	FW-D52	3mm 厚鋁板	EC-DG-D334232-ZD1 (SS-01)	14	0	14	20.110	0.177	2.474	0.177	2.474	
4	FW-D53	3mm 厚鋁板	EC-DG-D334232-ZD1 (SS-01)	10	0	10	60.067	0.739	7.388	0.739	7.388	
5	FW-D54	3mm 厚鋁板	EC-DG-D334232-ZD1 (SS-01)	10	0	10	28.084	0.345	3.454	0.345	3.454	
6	FW-D55	3mm 厚鋁板	EC-DG-D334232-ZD1 (SS-01)	10	0	10	14.451	0.178	1.777	0.178	1.777	
7	FW-D56L	3mm 厚鋁板	EC-DG-D334232-ZD1 (SS-01)	1	0	1	1.450	0.178	0.178	0.178	0.178	
8	FW-D56R	3mm 厚鋁板	EC-DG-D334232-ZD1 (SS-01)	1	0	1	1.450	0.178	0.178	0.178	0.178	
9	FW-D70	3mm 厚鋁板	EC-DG-D334232-ZD1 (SS-01)	14	0	14	96.437	0.847	11.862	0.847	11.862	
10	FW-D71	3mm 厚鋁板	EC-DG-D334232-ZD1 (SS-01)	14	0	14	40.161	0.353	4.940	0.353	4.940	
11	FW-D72	3mm 厚鋁板	EC-DG-D334232-ZD1 (SS-01)	14	0	14	20.110	0.177	2.474	0.177	2.474	
12	FW-D73	3mm 厚鋁板	EC-DG-D334232-ZD1 (SS-01)	10	0	10	66.835	0.822	8.221	0.822	8.221	
13	FW-D74	3mm 厚鋁板	EC-DG-D334232-ZD1 (SS-01)	10	0	10	28.084	0.345	3.454	0.345	3.454	
14	FW-D75	3mm 厚鋁板	EC-DG-D334232-ZD1 (SS-01)	10	0	10	14.451	0.178	1.777	0.178	1.777	
15	FW-D76L	3mm 厚鋁板	EC-DG-D334232-ZD1 (SS-01)	1	0	1	1.555	0.191	0.191	0.191	0.191	
16	FW-D76R	3mm 厚鋁板	EC-DG-D334232-ZD1 (SS-01)	1	0	1	1.555	0.191	0.191	0.191	0.191	
17	FW-D111	3mm 厚鋁板	EC-DG-D334232-ZD1 (SS-01)	1	0	1	7.075	0.870	0.870	0.870	0.870	
18	FW-D112	3mm 厚鋁板	EC-DG-D334232-ZD1 (SS-01)	1	0	1	7.075	0.870	0.870	0.870	0.870	
19	FW-D113	3mm 厚鋁板	EC-DG-D334232-ZD1 (SS-01)	7	0	7	49.528	0.870	6.092	0.870	6.092	
20	FW-D211	3mm 厚鋁板	EC-DG-D334232-ZD1 (SS-01)	1	0	1	2.555	0.314	0.314	0.314	0.314	
21	FW-D212	3mm 厚鋁板	EC-DG-D334232-ZD1 (SS-01)	1	0	1	2.555	0.314	0.314	0.314	0.314	
22	FW-D213	3mm 厚鋁板	EC-DG-D334232-ZD1 (SS-01)	7	0	7	17.887	0.314	2.200	0.314	2.200	
23	FW-D311	3mm 厚鋁板	EC-DG-D334232-ZD1 (SS-01)	1	0	1	7.075	0.870	0.870	0.870	0.870	
24	FW-D312	3mm 厚鋁板	EC-DG-D334232-ZD1 (SS-01)	1	0	1	7.075	0.870	0.870	0.870	0.870	
25	FW-D313	3mm 厚鋁板	EC-DG-D334232-ZD1 (SS-01)	7	0	7	49.528	0.870	6.092	0.870	6.092	
26	FW-M101	3mm 厚鋁板	EC-DG-D334232-ZD1 (SS-01)	2	0	1	7.599	0.935	0.935	0.935	0.935	
27	FW-M102	3mm 厚鋁板	EC-DG-D334232-ZD1 (SS-01)	1	0	1	7.599	0.935	0.935	0.935	0.935	
28	FW-M103	3mm 厚鋁板	EC-DG-D334232-ZD1 (SS-01)	1	0	1	8.425	1.036	1.036	1.036	1.036	
29	FW-M104	3mm 厚鋁板	EC-DG-D334232-ZD1 (SS-01)	1	0	1	7.599	0.935	0.935	0.935	0.935	
29A	FW-X104	3mm 厚鋁板	EC-DG-D334232-ZD1 (SS-01)	1	0	1	7.599	0.935	0.935	0.935	0.935	新增編號

美特鋁質有限公司 MDI Aluminium Fabricator Ltd		工程號: J-853	計算: ming	日期: 2024.07.22	送呈:	JOE							
地盤用鋁板B.M.表 (part 7)		地盤名稱: 廷坪路	核對:	日期: 2024.10.07	副本:								
項目類別: 特征牆(2区)		批准:	日期:	總重量: 2796.57									
B編號:		修改版次:	A/C Code:	343.982									
序號	修改內容	鋁板圖號	鋁板名稱	顏色	實用	後備	總數	總重量	343.982		圖紙編號		
									單件展開面積	總展開面積		單件V.F.	總V.F.
									平方米	平方米			
31		FW-M106	3mm厚鋁板	EC-DG-D334232-ZD1 (SS-01)	9	0	9	68.393	0.935	8.412	0.935	8.412	
32		FW-V106	3mm厚鋁板	EC-DG-D334232-ZD1 (SS-01)	14	0	14	106.390	0.935	13.086	0.935	13.086	
33		FW-X106	3mm厚鋁板	EC-DG-D334232-ZD1 (SS-01)	5	0	5	37.996	0.935	4.674	0.935	4.674	
34		FW-M107	3mm厚鋁板	EC-DG-D334232-ZD1 (SS-01)	1	0	1	8.425	1.036	1.036	1.036	1.036	
35		FW-X107	3mm厚鋁板	EC-DG-D334232-ZD1 (SS-01)	1	0	1	8.425	1.036	1.036	1.036	1.036	
36		FW-M108	3mm厚鋁板	EC-DG-D334232-ZD1 (SS-01)	1	0	1	8.425	1.036	1.036	1.036	1.036	
37		FW-X108	3mm厚鋁板	EC-DG-D334232-ZD1 (SS-01)	2	0	2	16.851	1.036	2.073	1.036	2.073	
38		FW-M109	3mm厚鋁板	EC-DG-D334232-ZD1 (SS-01)	2	0	2	15.199	0.935	1.869	0.935	1.869	
39		FW-X109	3mm厚鋁板	EC-DG-D334232-ZD1 (SS-01)	2	0	2	15.199	0.935	1.869	0.935	1.869	
40		FW-M110	3mm厚鋁板	EC-DG-D334232-ZD1 (SS-01)	1	0	1	7.599	0.935	0.935	0.935	0.935	
41		FW-V110	3mm厚鋁板	EC-DG-D334232-ZD1 (SS-01)	1	0	1	7.599	0.935	0.935	0.935	0.935	
42		FW-X110	3mm厚鋁板	EC-DG-D334232-ZD1 (SS-01)	1	0	1	7.599	0.935	0.935	0.935	0.935	
43		FW-V114	3mm厚鋁板	EC-DG-D334232-ZD1 (SS-01)	2	0	2	15.199	0.935	1.869	0.935	1.869	
44		FW-V115	3mm厚鋁板	EC-DG-D334232-ZD1 (SS-01)	2	0	2	15.199	0.935	1.869	0.935	1.869	
45		FW-V116	3mm厚鋁板	EC-DG-D334232-ZD1 (SS-01)	2	0	2	15.612	0.960	1.920	0.960	1.920	
46		FW-V117	3mm厚鋁板	EC-DG-D334232-ZD1 (SS-01)	2	0	2	15.612	0.960	1.920	0.960	1.920	
47		FW-V118	3mm厚鋁板	EC-DG-D334232-ZD1 (SS-01)	6	0	6	45.596	0.935	5.608	0.935	5.608	
48		FW-V119	3mm厚鋁板	EC-DG-D334232-ZD1 (SS-01)	1	0	1	7.599	0.935	0.935	0.935	0.935	
49		FW-V120	3mm厚鋁板	EC-DG-D334232-ZD1 (SS-01)	1	0	1	7.599	0.935	0.935	0.935	0.935	
50		FW-M201	3mm厚鋁板	EC-DG-D334232-ZD1 (SS-01)	2	0	2	9.963	0.613	1.225	0.613	1.225	
51		FW-M202	3mm厚鋁板	EC-DG-D334232-ZD1 (SS-01)	1	0	1	5.225	0.643	0.643	0.643	0.643	
52		FW-M203	3mm厚鋁板	EC-DG-D334232-ZD1 (SS-01)	1	0	1	5.523	0.679	0.679	0.679	0.679	
53		FW-M204	3mm厚鋁板	EC-DG-D334232-ZD1 (SS-01)	1	0	1	5.523	0.679	0.679	0.679	0.679	
53A		FW-X204	3mm厚鋁板	EC-DG-D334232-ZD1 (SS-01)	1	0	1	5.523	0.679	0.679	0.679	0.679	新增編號
55		FW-M206	3mm厚鋁板	EC-DG-D334232-ZD1 (SS-01)	9	0	9	44.833	0.613	5.514	0.613	5.514	
56		FW-V206	3mm厚鋁板	EC-DG-D334232-ZD1 (SS-01)	14	0	14	69.740	0.613	8.578	0.613	8.578	
57		FW-X206	3mm厚鋁板	EC-DG-D334232-ZD1 (SS-01)	5	0	5	24.907	0.613	3.064	0.613	3.064	
58		FW-M207	3mm厚鋁板	EC-DG-D334232-ZD1 (SS-01)	1	0	1	5.767	0.709	0.709	0.709	0.709	
59		FW-X207	3mm厚鋁板	EC-DG-D334232-ZD1 (SS-01)	1	0	1	5.767	0.709	0.709	0.709	0.709	
60		FW-M208	3mm厚鋁板	EC-DG-D334232-ZD1 (SS-01)	1	0	1	5.279	0.649	0.649	0.649	0.649	

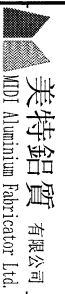

美特鋁質有限公司
Mei Te Aluminium Fabricator Ltd.

地盤用鋁板B.M.表 (part 7)

工程號: J-853	計算: ming	日期: 2024.07.22	送呈: JOE
地盤名稱: 延坪路	核對:	日期: 2024.10.07	副本:
項目類別: 特征牆(2区)	批准:		
B/C Code: A/C			

序號	修改內容	鋁板圖號	鋁板名稱	顏色	實用	後備	總數	總重量	343.982		總重量: 2796.57	圖紙編號	
									單件展開面積	總展開面積			單件V.F.
									平方米		平方米		
61		FW-X208	3mm厚鋁板	EC-DG-D334232-ZD1 (SS-01)	2	0	2	10.558	0.649	1.299	0.649	1.299	
62		FW-M209	3mm厚鋁板	EC-DG-D334232-ZD1 (SS-01)	2	0	2	9.963	0.613	1.225	0.613	1.225	
63		FW-X209	3mm厚鋁板	EC-DG-D334232-ZD1 (SS-01)	2	0	2	9.963	0.613	1.225	0.613	1.225	
64		FW-M210	3mm厚鋁板	EC-DG-D334232-ZD1 (SS-01)	1	0	1	4.981	0.613	0.613	0.613	0.613	
65		FW-V210	3mm厚鋁板	EC-DG-D334232-ZD1 (SS-01)	1	0	1	4.981	0.613	0.613	0.613	0.613	
66		FW-X210	3mm厚鋁板	EC-DG-D334232-ZD1 (SS-01)	1	0	1	4.981	0.613	0.613	0.613	0.613	
67		FW-V214	3mm厚鋁板	EC-DG-D334232-ZD1 (SS-01)	2	0	2	9.963	0.613	1.225	0.613	1.225	
68		FW-V215	3mm厚鋁板	EC-DG-D334232-ZD1 (SS-01)	2	0	2	9.963	0.613	1.225	0.613	1.225	
69		FW-V216	3mm厚鋁板	EC-DG-D334232-ZD1 (SS-01)	2	0	2	10.450	0.643	1.285	0.643	1.285	
70		FW-V217	3mm厚鋁板	EC-DG-D334232-ZD1 (SS-01)	2	0	2	10.450	0.643	1.285	0.643	1.285	
71		FW-V218	3mm厚鋁板	EC-DG-D334232-ZD1 (SS-01)	6	0	6	29.076	0.596	3.576	0.596	3.576	
72		AP-X130	3mm厚鋁板	EC-DG-D334232-ZD1 (SS-01)	34	0	34	484.181	1.752	59.555	1.752	59.555	
73		AP-X131	3mm厚鋁板	EC-DG-D334232-ZD1 (SS-01)	17	0	17	314.235	2.274	38.651	2.274	38.651	
74		AP-X132	3mm厚鋁板	EC-DG-D334232-ZD1 (SS-01)	2	0	2	40.289	2.478	4.956	2.478	4.956	
75		AP-X133	3mm厚鋁板	EC-DG-D334232-ZD1 (SS-01)	1	0	1	26.148	3.216	3.216	3.216	3.216	
76		AP-X134	3mm厚鋁板	EC-DG-D334232-ZD1 (SS-01)	2	0	2	40.289	2.478	4.956	2.478	4.956	
77		AP-X135	3mm厚鋁板	EC-DG-D334232-ZD1 (SS-01)	1	0	1	26.148	3.216	3.216	3.216	3.216	
78		AP-X136	3mm厚鋁板	EC-DG-D334232-ZD1 (SS-01)	15	0	15	176.177	1.445	21.670	1.445	21.670	
79		AP-X137	3mm厚鋁板	EC-DG-D334232-ZD1 (SS-01)	5	0	5	92.422	2.274	11.368	2.274	11.368	
80		AP-X138	3mm厚鋁板	EC-DG-D334232-ZD1 (SS-01)	6	0	6	99.687	2.044	12.262	2.044	12.262	
81		AP-X139	3mm厚鋁板	EC-DG-D334232-ZD1 (SS-01)	2	0	2	52.295	3.216	6.432	3.216	6.432	
總計:					0		381	2797	74	344	74	344	

PROJECT
YIN PING ROAD KOWLOON
FEATURE WALL (PHASE 2)

MATERIAL
3mm鋁板

COATING
PVF2


COLOUR
EC-DG-D334232-ZD1(SS-01)

MARK. NO.
-

QTY.
-

注：地盤用


REV.	CHECKED BY	PART NUMBER	Dim. A	Dim. B	Dim. C	Dim. D	Dim. E	Dim. F	Dim. G	Dim. H	QTY.	Inv. Code	ASSEMBLE ON PARTS
-	-	FW-M104	-	-	-	-	-	-	-	-	1	-	-
-	-	FW-X104	-	-	-	-	-	-	-	-	1	-	-

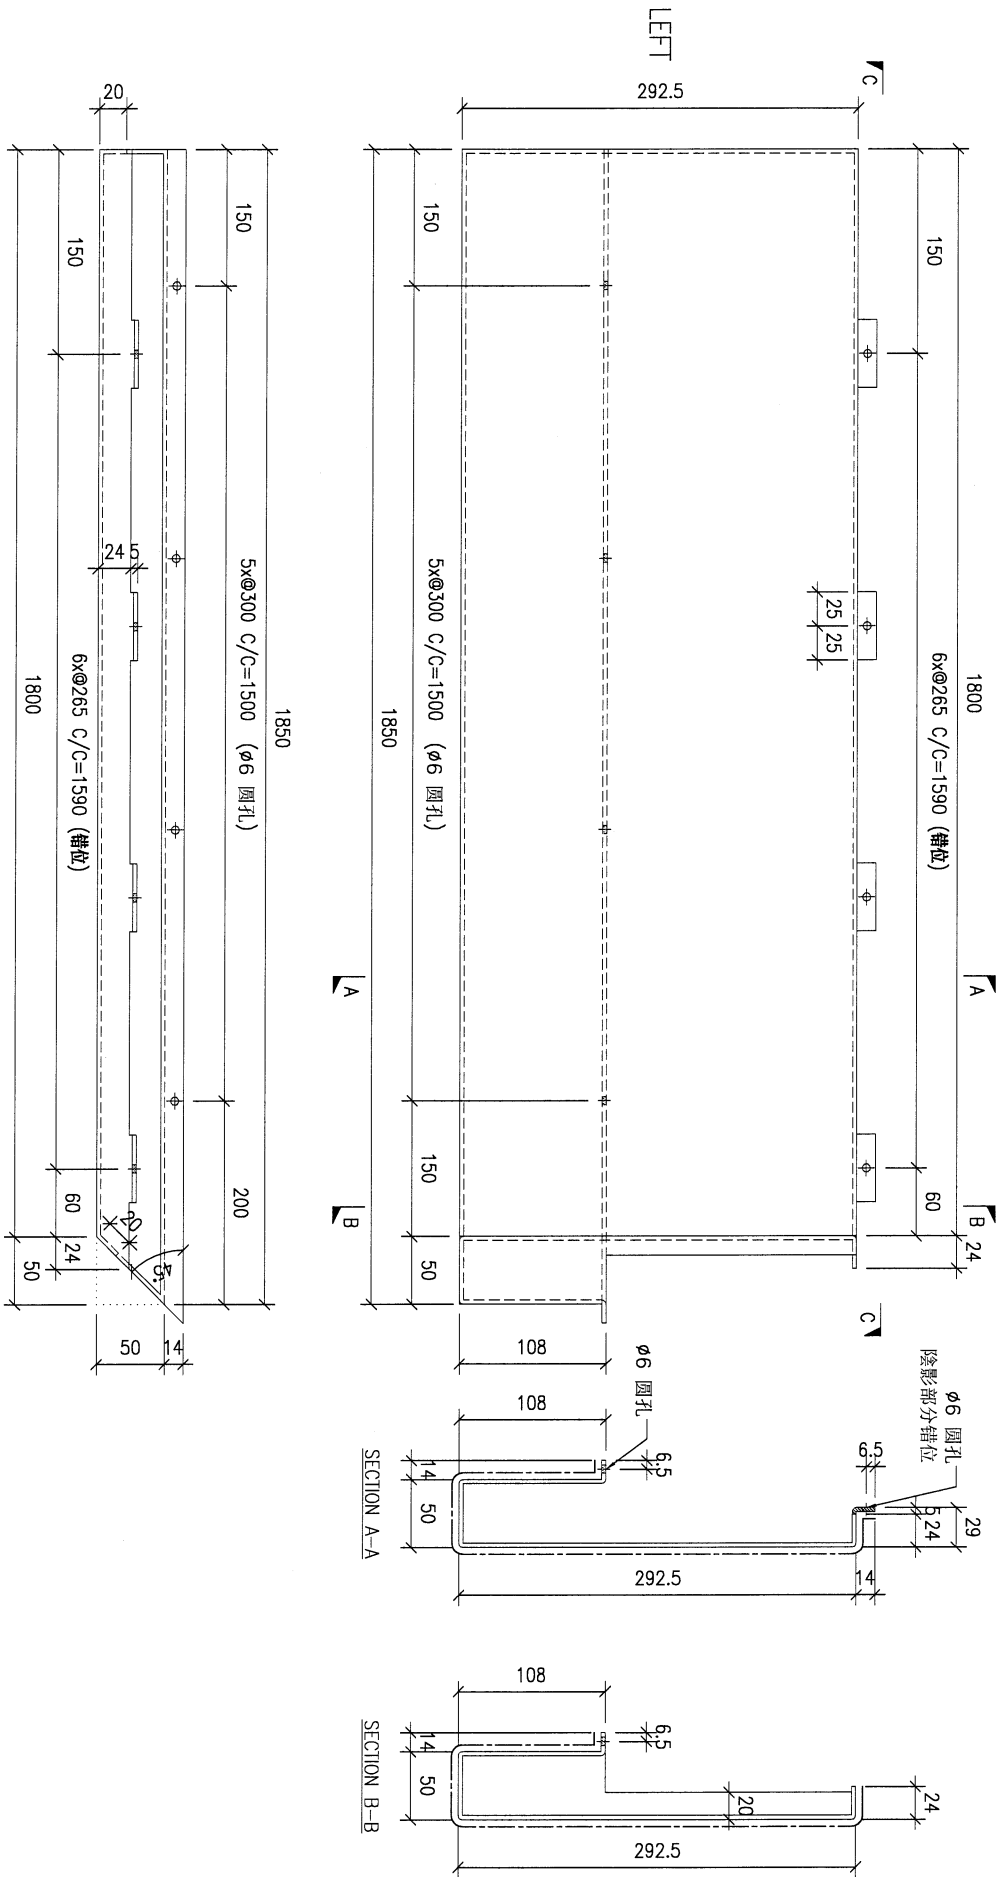

DWG. NO.	FW-M104	REV.	-	SCALE	-	DATE	11-07-2024	DRAWN BY	-	APPROVED BY	-
----------	---------	------	---	-------	---	------	------------	----------	---	-------------	---

DWG NO.: J853-SD-FW-3018G.1


FEATURE WALL 铝板立面图

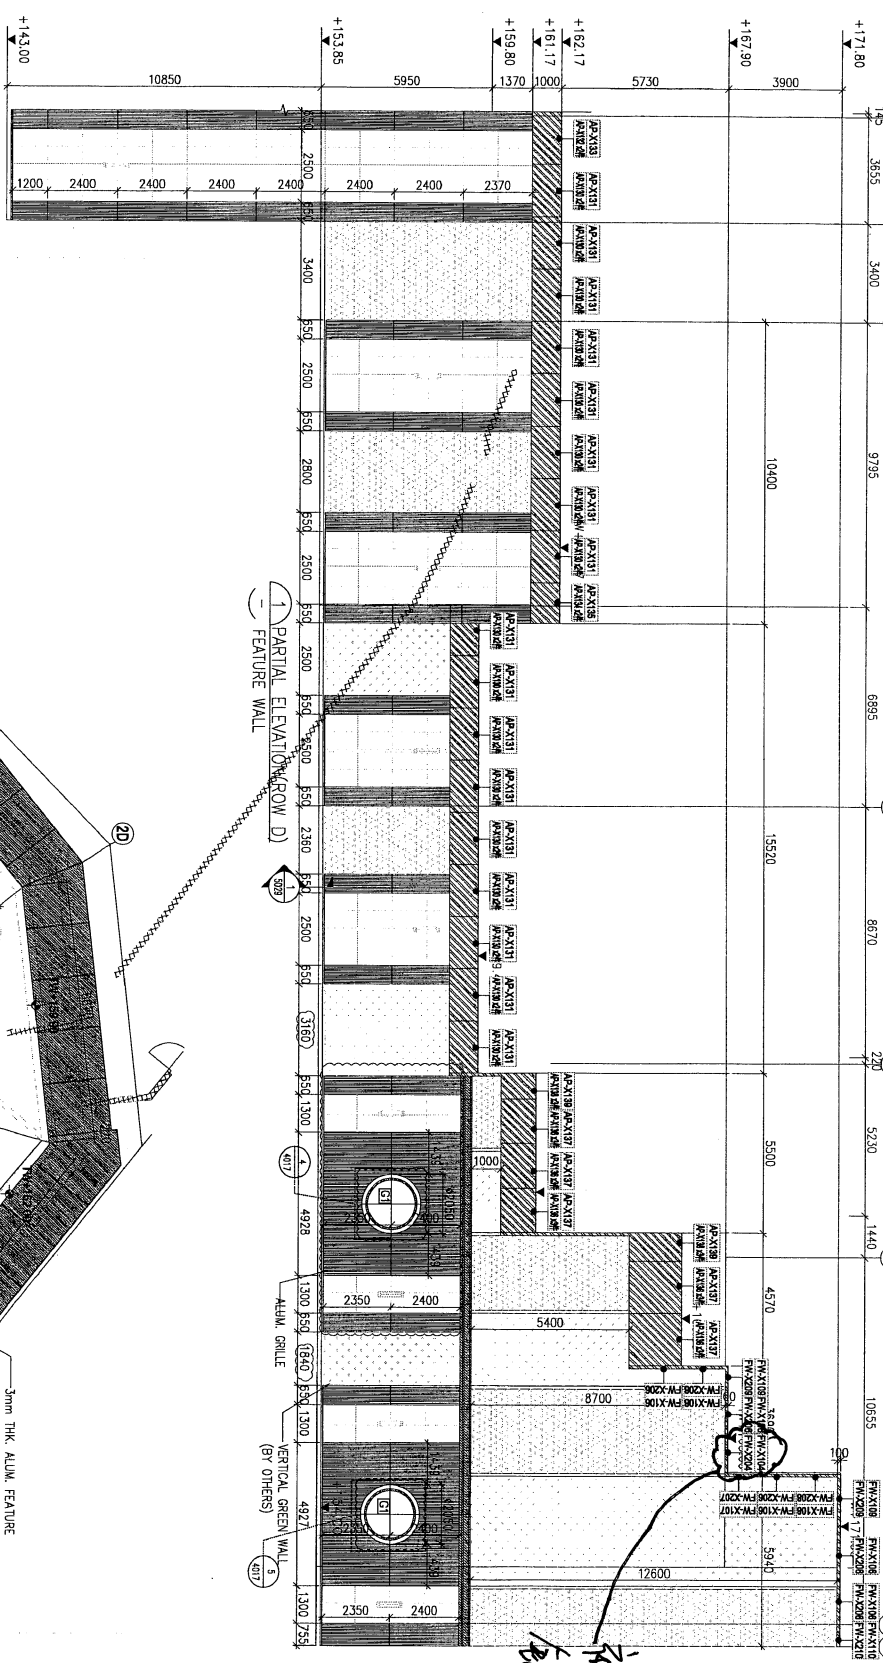


LEGEND:

 3mm THK ALUM. GRILLE

 6mm THK LAMINATED TEMPERED GLASS WITH SILK PRINTING

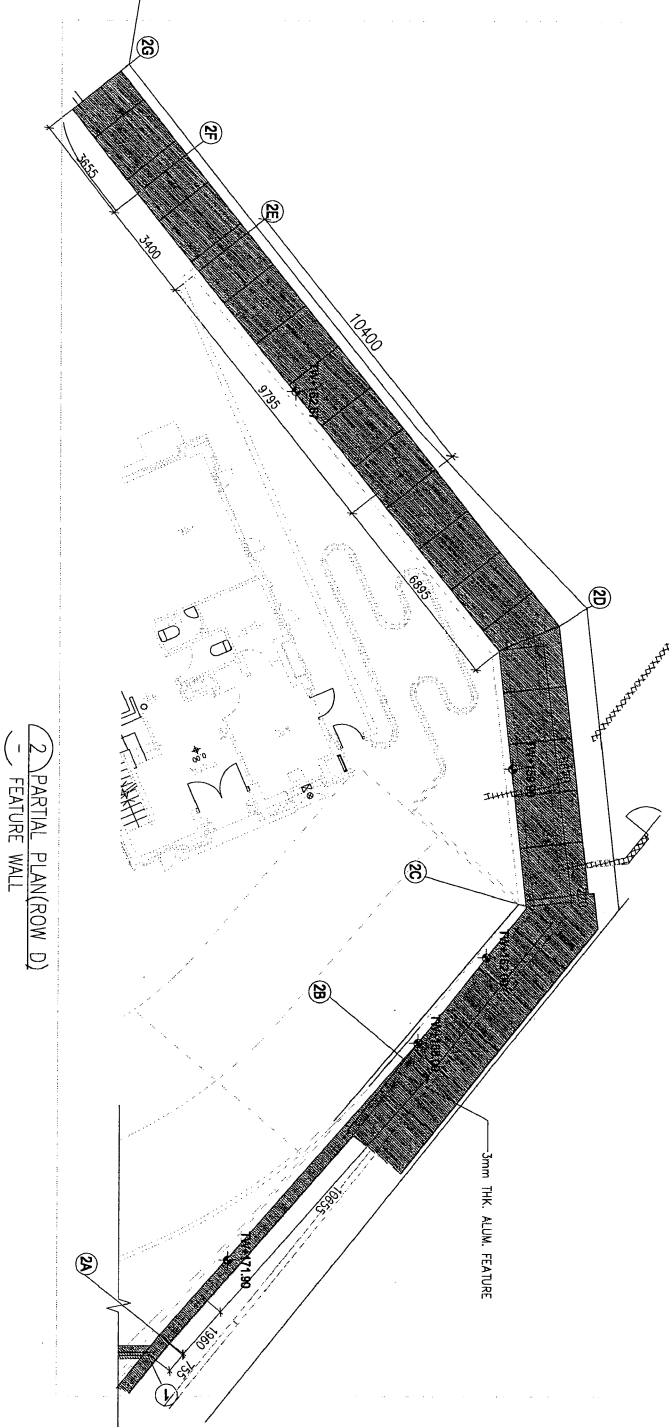

2 PARTIAL PLAN (ROW D) FEATURE WALL

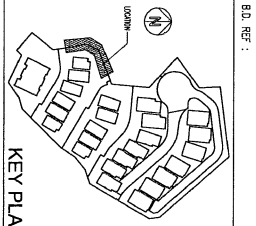

KEY PLAN

CLIENT :
SHIMAO GROUP HOLDINGS LIMITED

ARCHITECT :
WONG TUNG & PARTNERS LIMITED

MAIN CONTRACTOR :
怡興建築有限公司
HP HING CONSTRUCTION CO LTD

STRUCTURAL ENGINEER :
C M WONG & ASSOCIATES LTD
 黃志輝建築工程師有限公司

FAÇADE CONSULTANT :
WEN-YARDT

NOTE:
 1. ALL DIMENSIONS ARE IN mm.
 2. ALL ELEVATIONS ARE VIEWED FROM OUTSIDE BEFORE FABRICATION.
 3. ALL DIMENSIONS TO BE VERIFIED ON SITE.

LEGEND:

 SI - DETAIL MARK NO.

 1 - REFER SHEET NO.
 1. F.F.L. -- FINISHED FLOOR LEVEL.
 2. S.F.L. -- STRUCTURAL FLOOR LEVEL.
 3. R.F.L. -- REINFORCED DETAIL.

TITLE :
 PARTIAL ELEVATION & PLAN OF
 FEATURE WALL (PHASE 2)

PROJECT :
 PROPOSED RESIDENTIAL
 DEVELOPMENT AT NIKILL, 6542
 YUN PING ROAD
 KOWLOON

DATE :
 30-APR-24
 SCALE : 1:150 (A3)

DRAWN BY : LHR
 CHECKED BY :
黃偉強
MIDI ASSOCIATES
 Suite 6-8, Sunny Industrial Centre, 1/F
 910 Chee Kwee Ling Road, Kowloon
 Tel: 24382114 Fax: 243272788
 DWG NO.: J853-SD-FW-3018 REV: C