



工程指示 / 要求簡箋 ENGINEER INSTRUCTIONS(E.I.)

工程指示編號:	EI- 8199 A	修改版本:	- A
	HK- 1524		
工程編號:	J 853	工程名稱:	延坪道 (第2期)
收件人:	生統	發件人:	Jingo
工程項目:	Feature Wall 飾線 廠用鋁板加工圖 修改 低位	日期:	17/8/2024

<input type="checkbox"/> 原合約工程包	<input type="checkbox"/> 原合約工程加 / 減賬 QT-	<input type="checkbox"/> 新工程報價 QT-
---------------------------------	--	------------------------------------

信件批核號碼/圖紙參考編號:	批核模具圖紙編號:
客戶指示附件:	管理內部批簽署:

<input type="checkbox"/> 初步鋁料 B.M.	<input type="checkbox"/> 加工拆圖, 然後生產	<input type="checkbox"/> 尺寸表
<input type="checkbox"/> 正式鋁料 B.M.	<input type="checkbox"/> 技術上資料/指示	<input type="checkbox"/> 報價
<input type="checkbox"/> 配件 B.M.	<input type="checkbox"/> 樣辦或貨品說明書	<input type="checkbox"/> 分判合約
<input type="checkbox"/> 其他:		

內容: 低位鋁板

完成上列要求日期: 28/8/2024

國內

<input type="checkbox"/> 生產技術總監	<input type="checkbox"/> 連附件	<input type="checkbox"/> 技術部	<input type="checkbox"/> 連附件	<input type="checkbox"/> 生產部	<input type="checkbox"/> 連附件
<input type="checkbox"/> 採購部	<input type="checkbox"/> 連附件	<input checked="" type="checkbox"/> 生產統籌部	<input checked="" type="checkbox"/> 連附件	<input type="checkbox"/> 報關組	<input type="checkbox"/> 連附件
<input type="checkbox"/> 質檢部	<input type="checkbox"/> 連附件	<input type="checkbox"/> 會計部	<input type="checkbox"/> 連附件	<input type="checkbox"/> 機械設計部	<input type="checkbox"/> 連附件
<input type="checkbox"/> 香港辦	<input type="checkbox"/> 連附件	<input type="checkbox"/> 其他:			

香港

<input type="checkbox"/> 行政部	<input type="checkbox"/> 連附件	<input type="checkbox"/> 會計部	<input type="checkbox"/> 連附件	<input type="checkbox"/> 統籌部	<input type="checkbox"/> 連附件	<input type="checkbox"/> 工程部	<input type="checkbox"/> 連附件
<input type="checkbox"/> 採購部	<input type="checkbox"/> 連附件	<input type="checkbox"/> QS部	<input type="checkbox"/> 連附件	<input type="checkbox"/> 地盤管理	<input type="checkbox"/> 連附件	<input type="checkbox"/> 維修部	<input type="checkbox"/> 連附件

*發件人簽署:	*組別成員批核簽署:
傳遞編號:	項目經理簽署:


PROJECT: YIN PING ROAD KOWLOON FEATURE WALL (PHASE 2)

REV.	CHECKED (DATE)	PART NUMBER	Dim. A	Dim. B	Dim. C	Dim. D	Dim. E	Dim. F	Dim. G	Dim. H	QTY.	Inv. Code	ASSEMBLE ON PARTS	COLOUR EC-DG-D334232-ZD1(SS-01)	MARK. NO. -	QTY. -
-		P2-AP-EF154	-	-	-	-	-	-	-	-	1					

MATERIAL: 3mm 铝板

COATING: PVF2

注: 工厂用

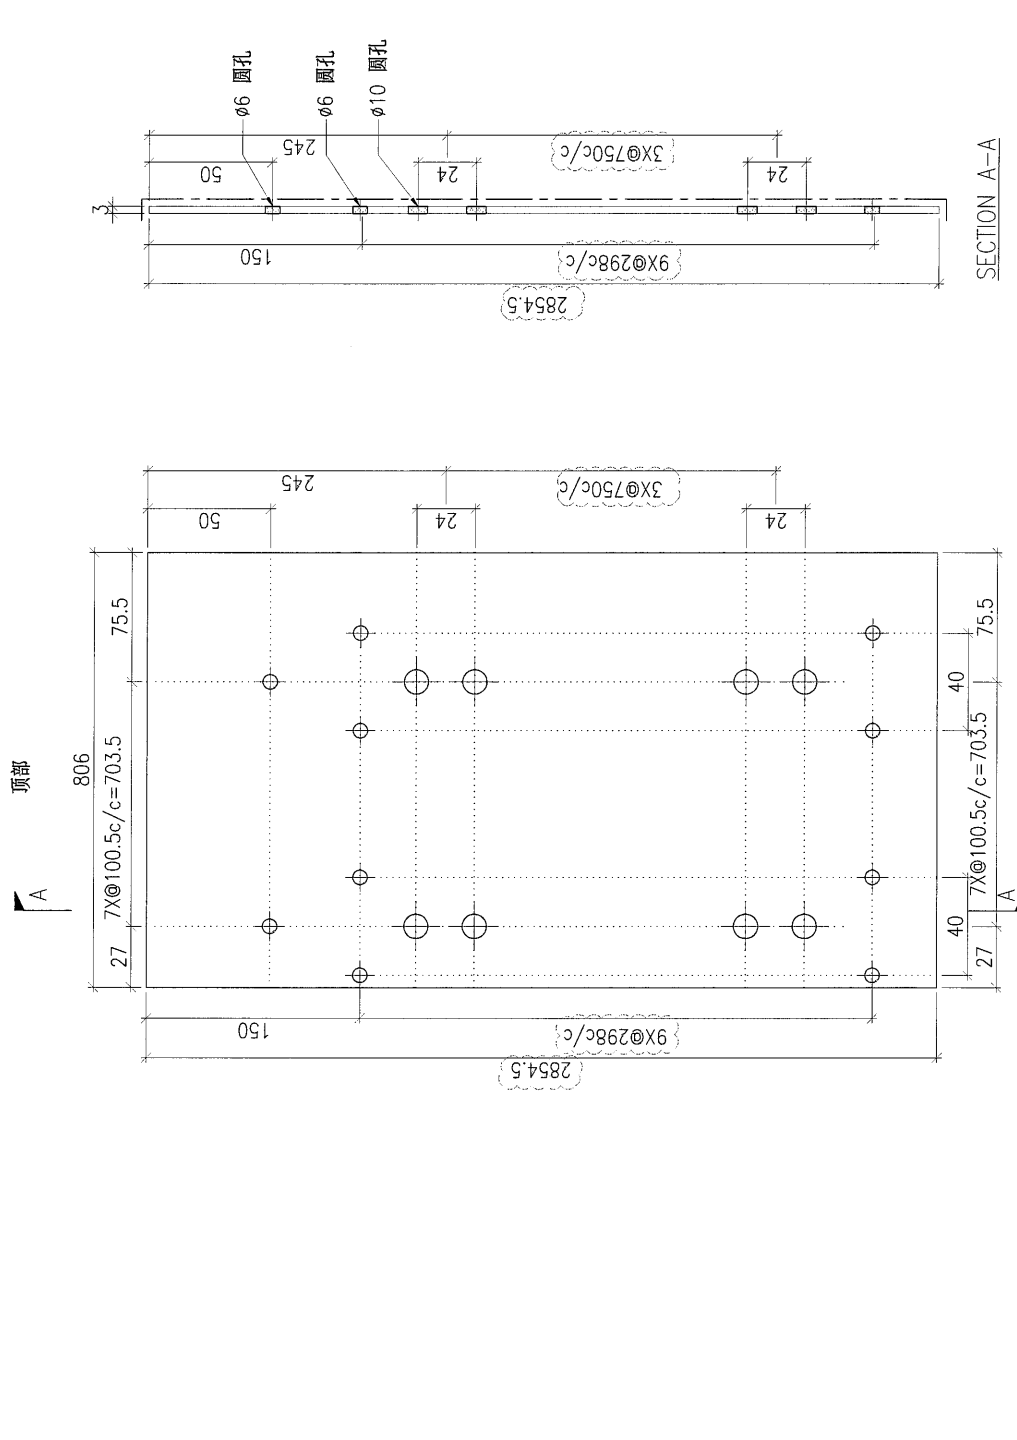

DWG. NO.	REV.	SCALE	DATE	DRAWN BY	APPROVED BY
P2-AP-EF154	A	-	13-06-2024	-	-

PROJECT: YIN PING ROAD KOWLOON FEATURE WALL (PHASE 2)

REV.	DESCRIPTION	Dim. A	Dim. B	Dim. C	Dim. D	Dim. E	Dim. F	Dim. G	Dim. H	QTY.	Inv. Code
-	P2-AP-EF155	-	-	-	-	-	-	-	-	1	

MATERIAL: 3mm 铝板

COATING: PVF2


COLOUR: EC-DG-D334232-ZD1(SS-01)

MARK. NO.:

QTY.:

ASSEMBLE ON PARTS

注: 工厂用

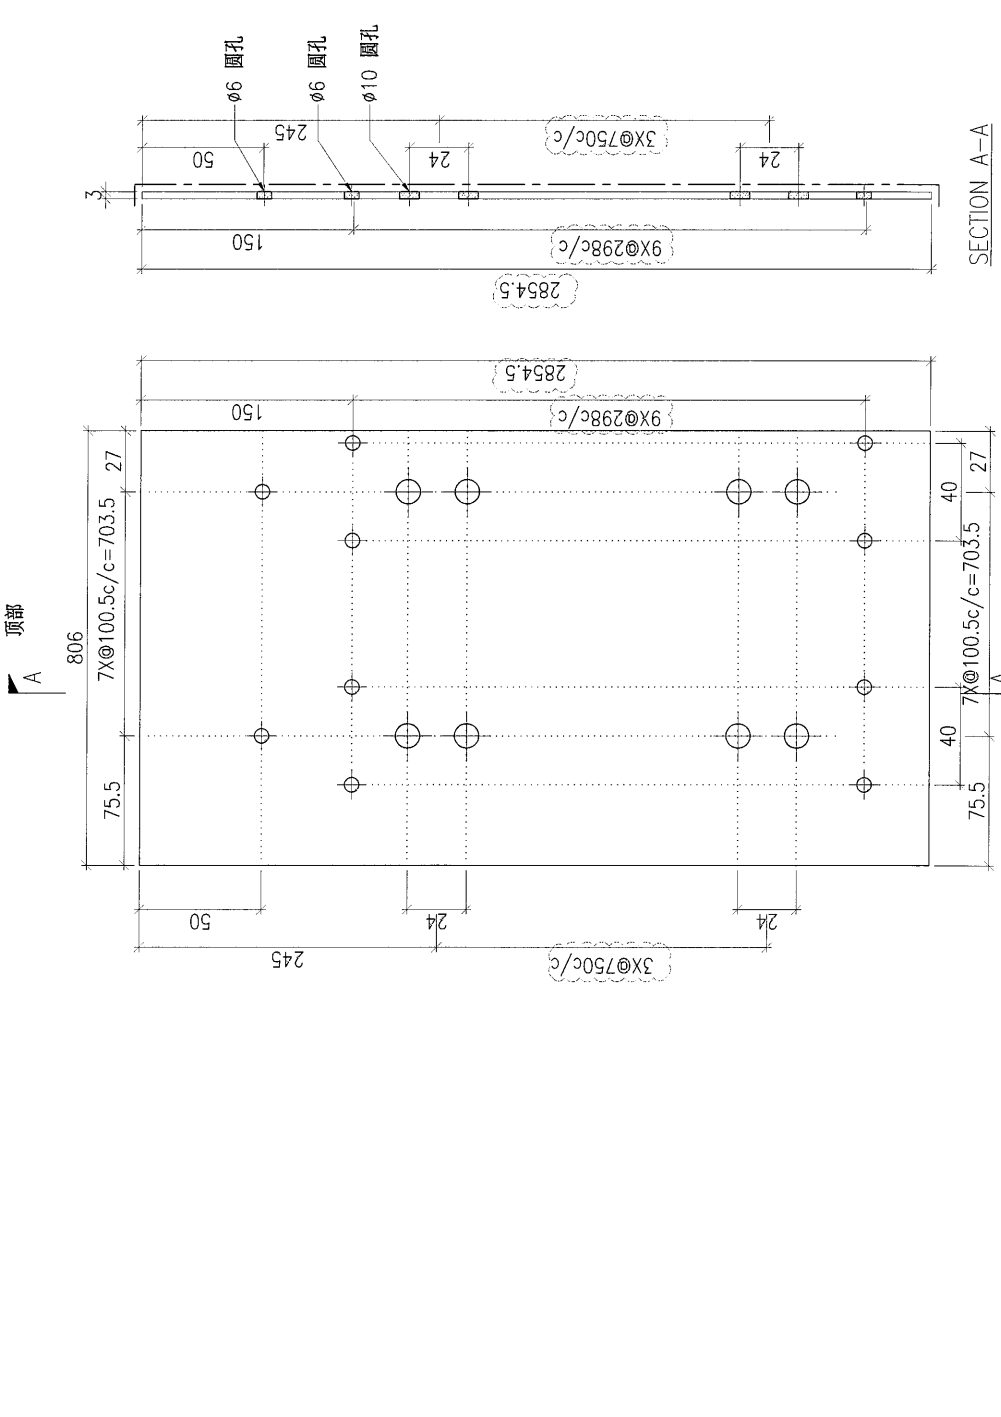

DWG. NO.:	P2-AP-EF155	REV.:	A	SCALE:	-	DATE:	13-06-2024	DRAWN BY:	-	APPROVED BY:	-
-----------	-------------	-------	---	--------	---	-------	------------	-----------	---	--------------	---

PROJECT: YIN PING ROAD KOWLOON FEATURE WALL (PHASE 2)

MATERIAL: 3mm 铝板

COATING: PVF2


COLOUR: EC-DG-D334232-ZD1(SS-01)

MARK. NO.: -

QTY.: -

REV.	CHECKED DATE	PART NUMBER	Dim. A	Dim. B	Dim. C	Dim. D	Dim. E	Dim. F	Dim. G	Dim. H	QTY.	Inv. Code	ASSEMBLE ON PARTS	QTY.
-	-	P2-AP-EF156	-	-	-	-	-	-	-	-	1	-	ASSEMBLE ON PARTS	-

注: 工厂用

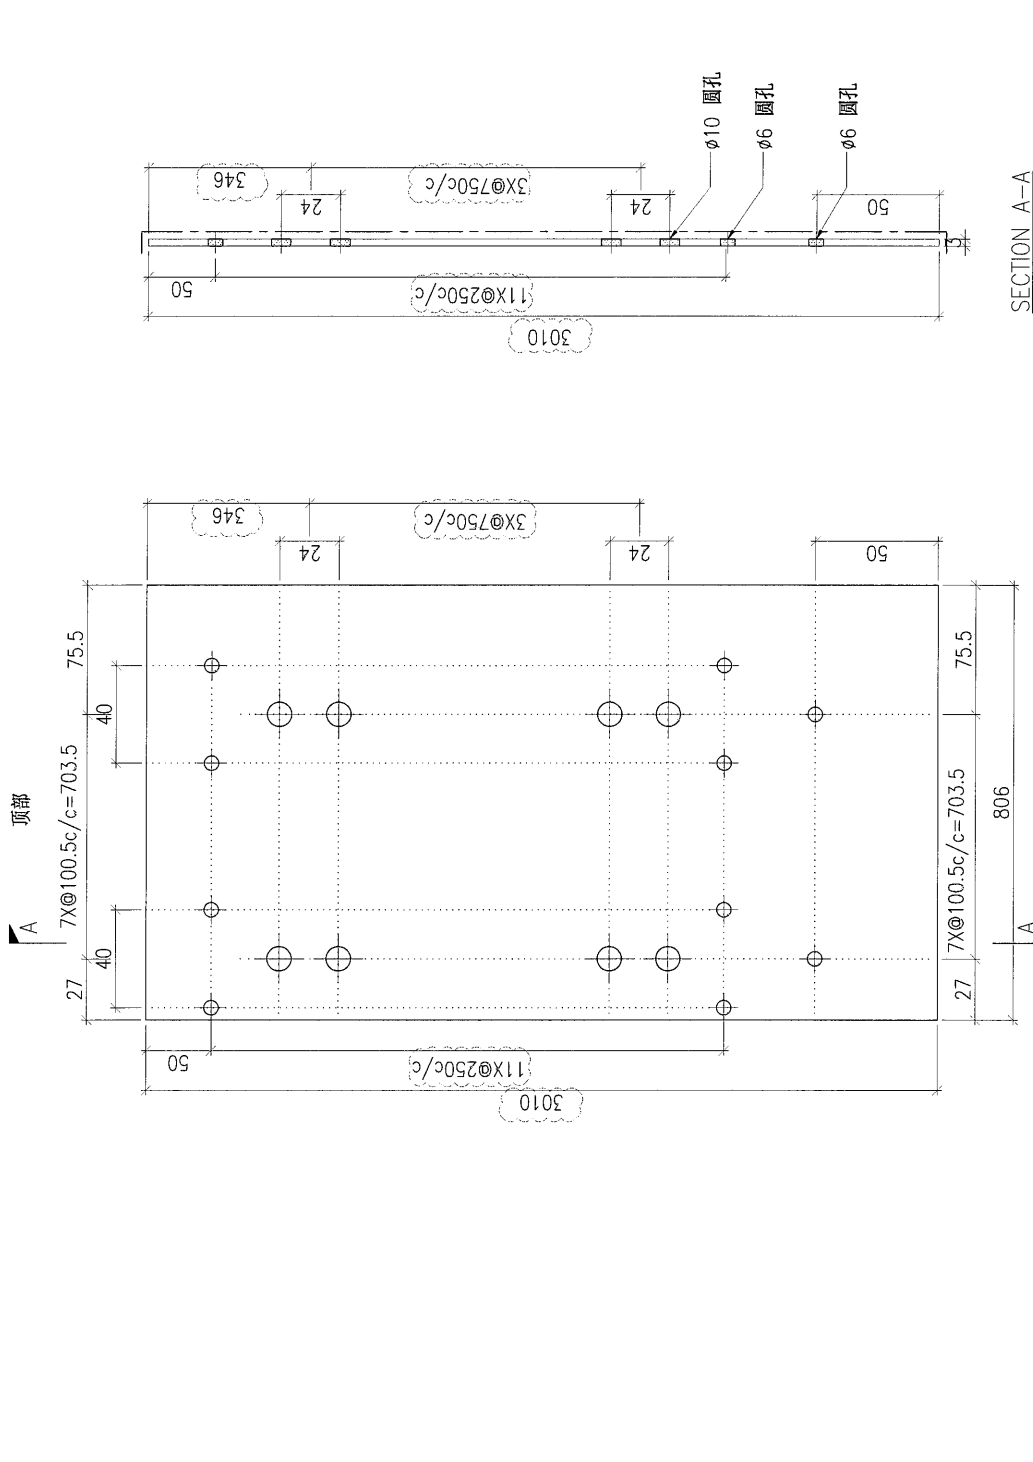


SECTION A-A

DWG. NO.	P2-AP-EF156	REV.	A	SCALE	-	DATE	13-06-2024	DRAWN BY	-	APPROVED BY	-
----------	-------------	------	---	-------	---	------	------------	----------	---	-------------	---

PROJECT: YIN PING ROAD KOWLOON FEATURE WALL (PHASE 2)


REV.	CHECKED BY	PART NUMBER	Dim. A	Dim. B	Dim. C	Dim. D	Dim. E	Dim. F	Dim. G	Dim. H	QTY.	Inv. Code	COLOUR	MARK. NO.	QTY.
-		P2-AP-EF157	-	-	-	-	-	-	-	-	1		EC-DG-D334232-ZD1(SS-01)	-	-
MATERIAL: 3mm 铝板												COATING: PVF2	ASSEMBLE ON PARTS	注: 工厂用	

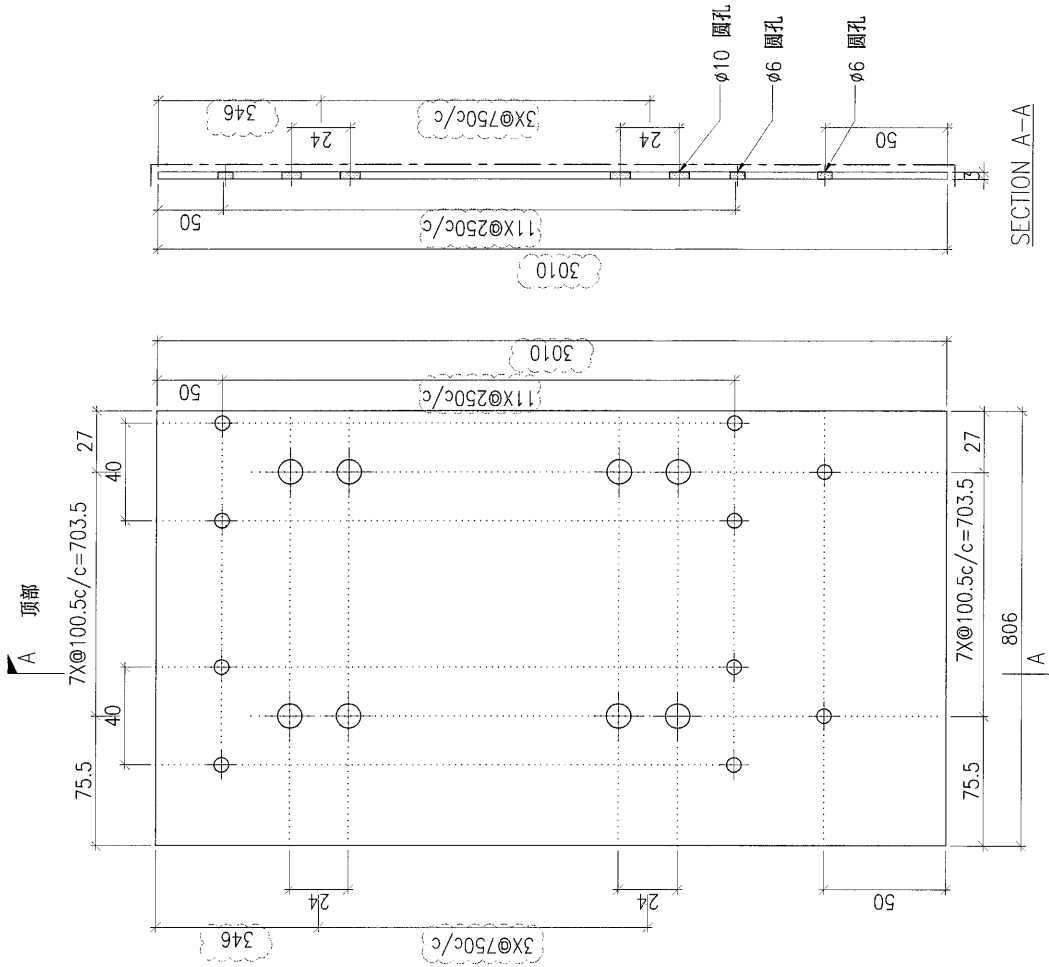

DWG. NO.	REV.	SCALE	DATE	DRAWN BY	APPROVED BY
P2-AP-EF157	A	-	13-06-2024	-	-

PROJECT: YIN PING ROAD KOWLOON FEATURE WALL (PHASE 2)

REV.	CHECKED BY	PART NUMBER	Dim. A	Dim. B	Dim. C	Dim. D	Dim. E	Dim. F	Dim. G	Dim. H	QTY.	Inv. Code	COATING	COLOUR	MARK. NO.	QTY.
-		P2-AP-EF158	-	-	-	-	-	-	-	-	1		PVF2	EC-DG-D334232-ZD1(SS-01)	-	-
													ASSEMBLE ON PARTS			
注: 工厂用																

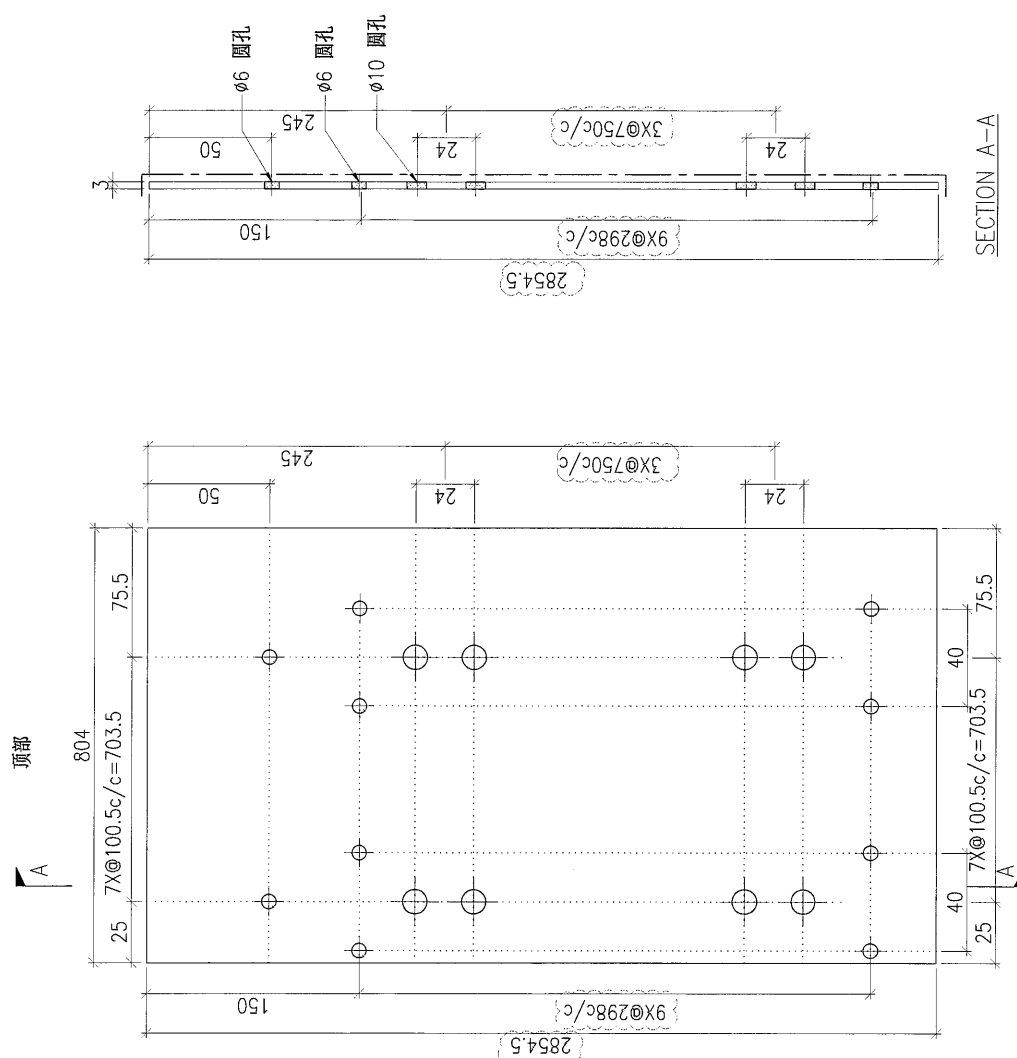

DWG. NO.	REV.	SCALE	DATE	DRAWN BY	APPROVED BY
P2-AP-EF158	A	-	13-06-2024	-	-

PROJECT: YIN PING ROAD KOWLOON FEATURE WALL (PHASE 2)

REV.	CHANGED BY	PART NUMBER	Dim. A	Dim. B	Dim. C	Dim. D	Dim. E	Dim. F	Dim. G	Dim. H	QTY.	Inv. Code
-		P2-AP-EF159	-	-	-	-	-	-	-	-	1	

MATERIAL: 3mm 铝板

COATING: PVF2


COLOUR: EC-DG-D334232-ZD1(SS-01)

MARK. NO.:

QTY.:

ASSEMBLE ON PARTS

注: 工厂用

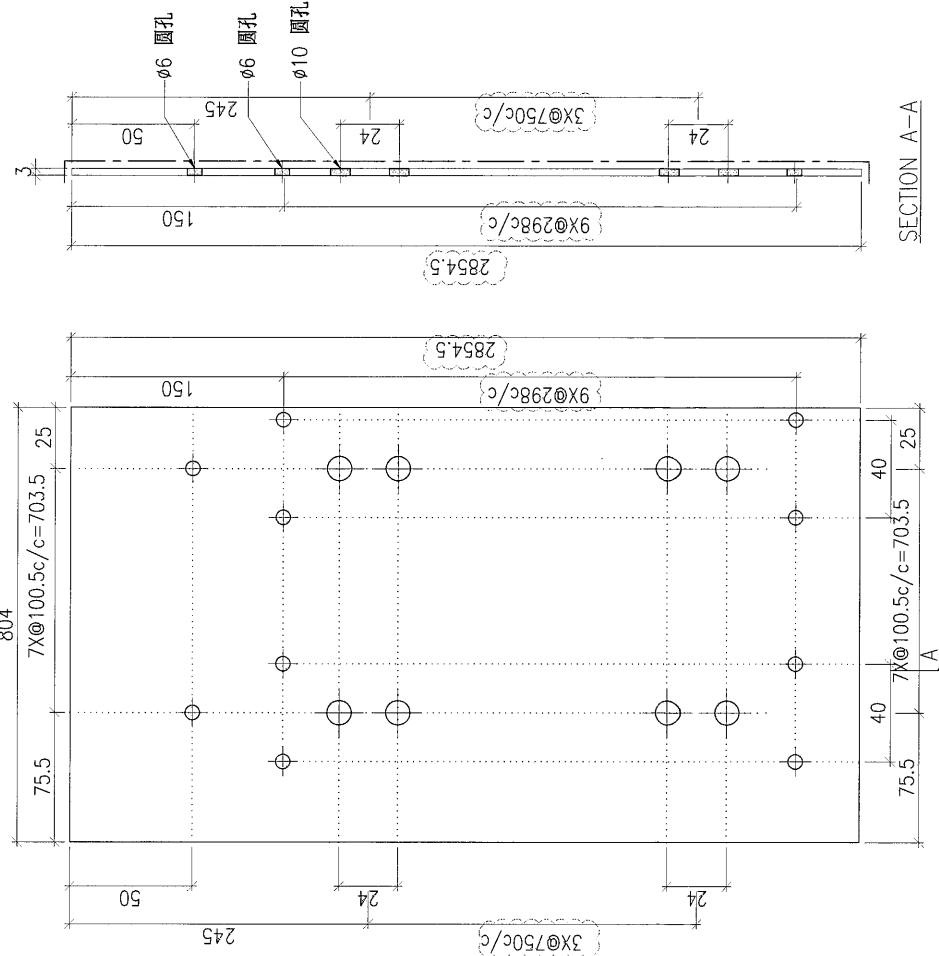

DWG. NO.:	REV.:	SCALE:	DATE:	DRAWN BY:	APPROVED BY:
P2-AP-EF159	A	-	13-06-2024	-	-


PROJECT: YIN PING ROAD KOWLOON FEATURE WALL (PHASE 2)

MARK. NO.	COLOUR	COATING	MATERIAL	QTY.	Inv. Code
-	EC-DG-D334232-ZD1(SS-01)	PVF2	3mm 铝板	1	
ASSEMBLE ON PARTS					

REV.	CHECKED	DATE	Dim. A	Dim. B	Dim. C	Dim. D	Dim. E	Dim. F	Dim. G	Dim. H	QTY.
-			-	-	-	-	-	-	-	-	1

QTY. -


注: 工厂用

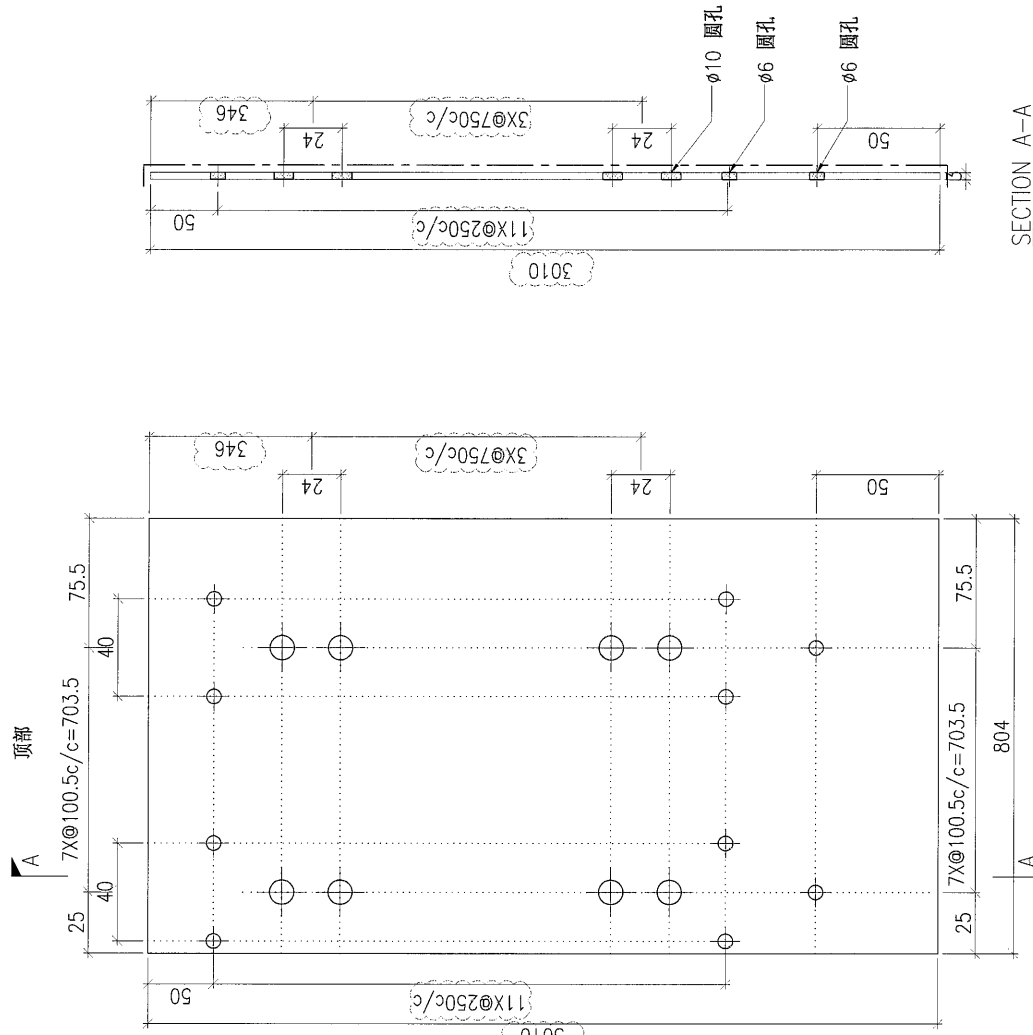

DWG. NO.	REV.	SCALE	DATE	DRAWN BY	APPROVED BY
P2-AP-EF160	A	-	13-06-2024	-	-

PROJECT		YIN PING ROAD KOWLOON FEATURE WALL (PHASE 2)										COLOUR	MARK. NO.	QTY.	
		3mm 铝板										EC-DG-D334232-ZD1(SS-01)	-	-	
MATERIAL		COATING										ASSEMBLE ON PARTS			
3mm 铝板		PVF2													
REV.	CHANGED BY	PART NUMBER	Dim. A	Dim. B	Dim. C	Dim. D	Dim. E	Dim. F	Dim. G	Dim. H	QTY.	Inv. Code			
-		P2-AP-EF161	-	-	-	-	-	-	-	-	1				


注: 工厂用												
--------	--	--	--	--	--	--	--	--	--	--	--	--

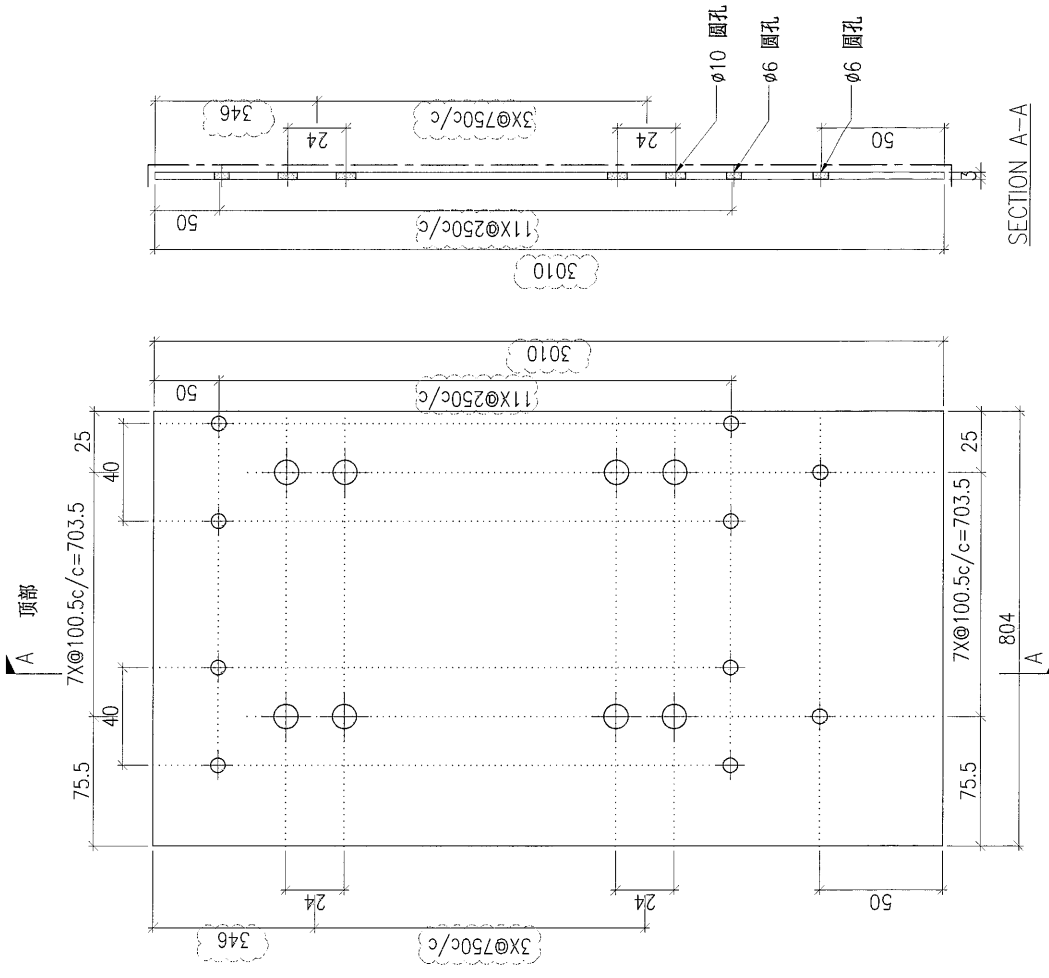

DWG. NO.	REV.	SCALE	DATE	DRAWN BY	APPROVED BY
P2-AP-EF161	A	-	13-06-2024	-	-

PROJECT: YIN PING ROAD KOWLOON FEATURE WALL (PHASE 2)

REV.	CHECKED BY	PART NUMBER	Dim. A	Dim. B	Dim. C	Dim. D	Dim. E	Dim. F	Dim. G	Dim. H	QTY.	Inv. Code	COATING	COLOUR	MARK. NO.	QTY.
-		P2-AP-EF170	-	-	-	-	-	-	-	-	1		PVF2	EC-DG-D334232-ZD1(SS-01)	-	-
注: 工厂用																
注: 工地复尺																

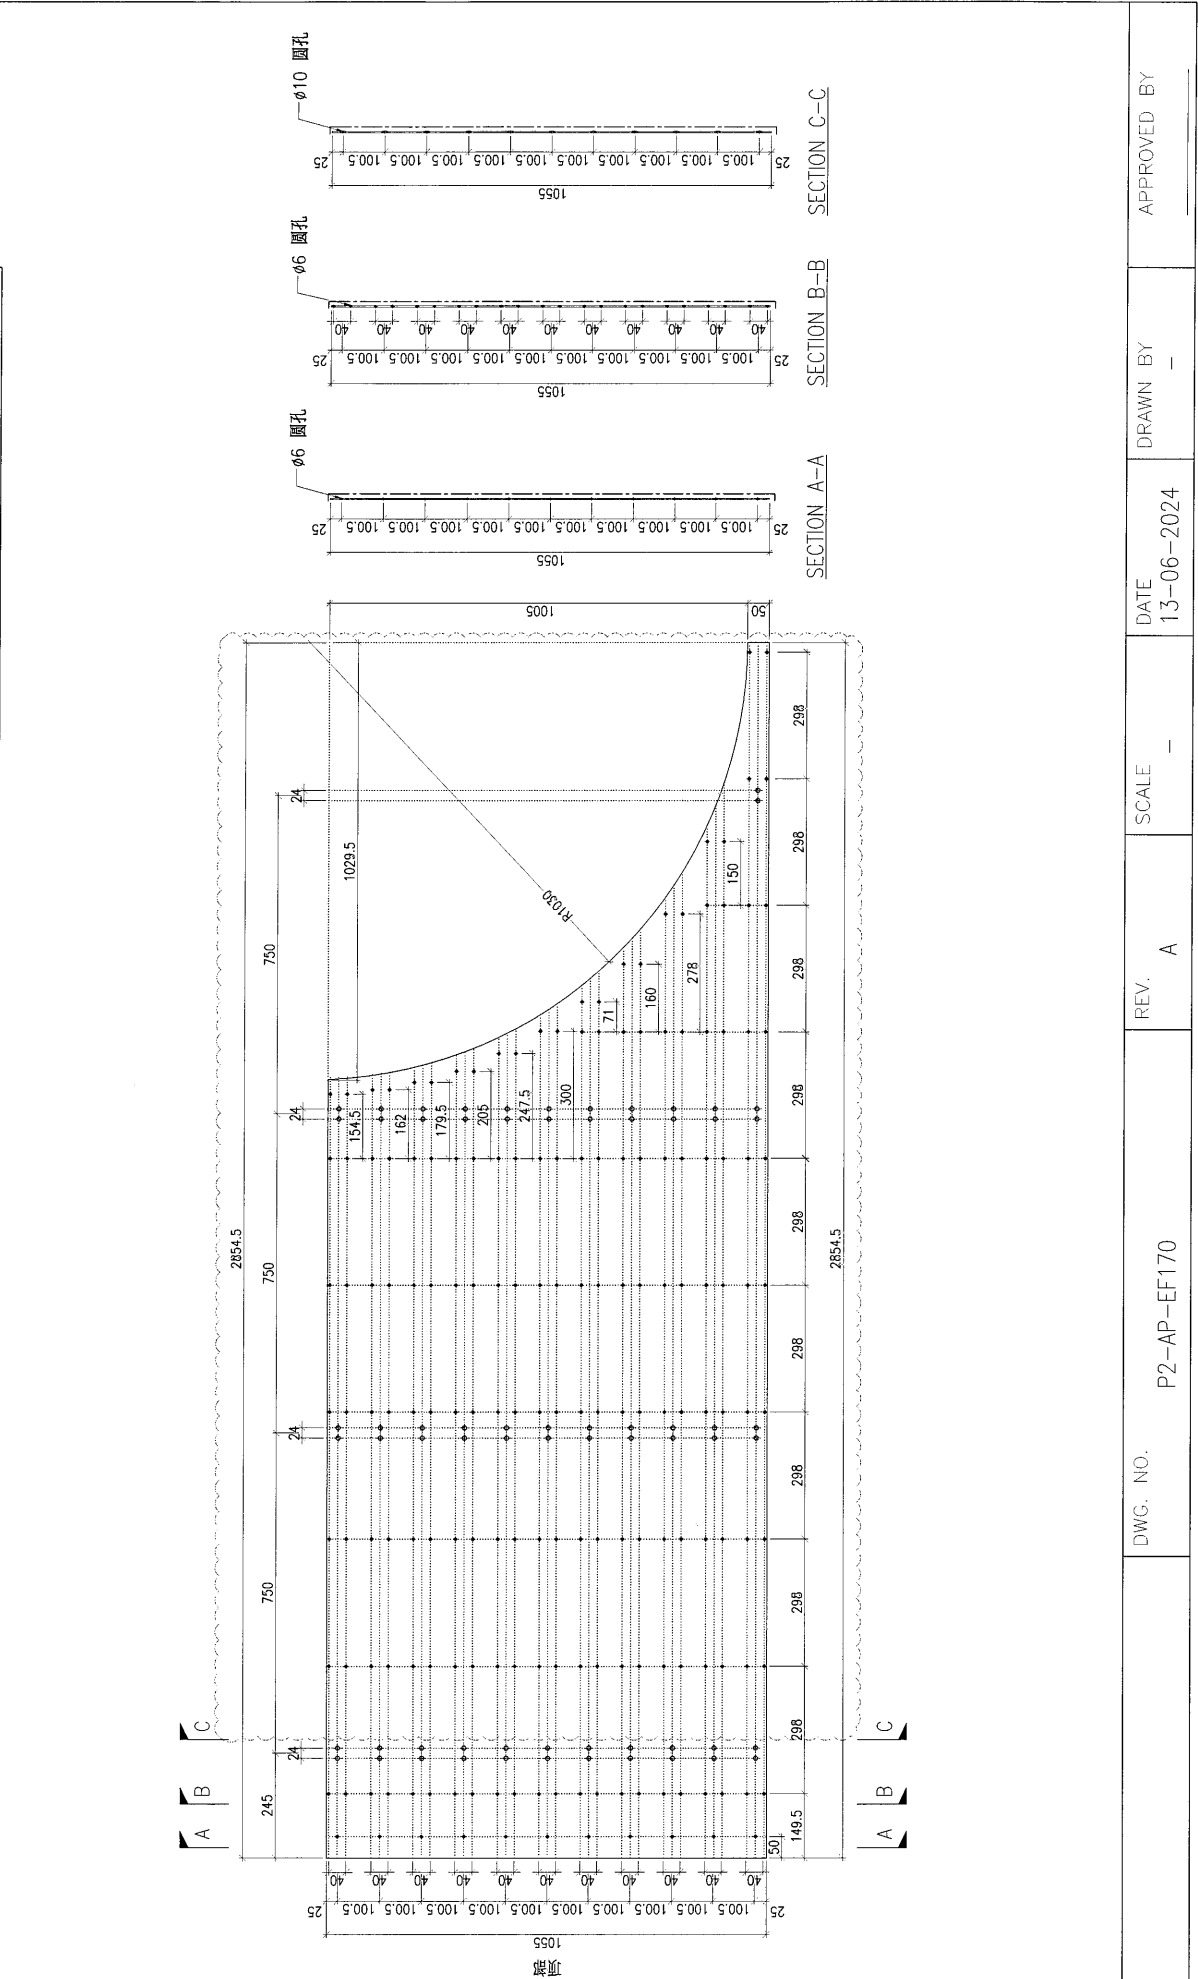


DWG. NO.	REV.	SCALE	DATE	DRAWN BY	APPROVED BY
P2-AP-EF170	A	-	13-06-2024	-	-

PROJECT		YIN PING ROAD KOWLOON FEATURE WALL (PHASE 2)				MATERIAL				3mm 铝板		COATING		PVF2		COLOUR		EC-DG-D334232-ZD1(SS-01)		MARK. NO.		-		QTY.		-	
REV.	CHECKED DATE	Dim. A	Dim. B	Dim. C	Dim. D	Dim. E	Dim. F	Dim. G	Dim. H	QTY.	Inv. Code	ASSEMBLE ON PARTS															
-		-	-	-	-	-	-	-	-	1																	

注: 工厂用


注: 工地复尺

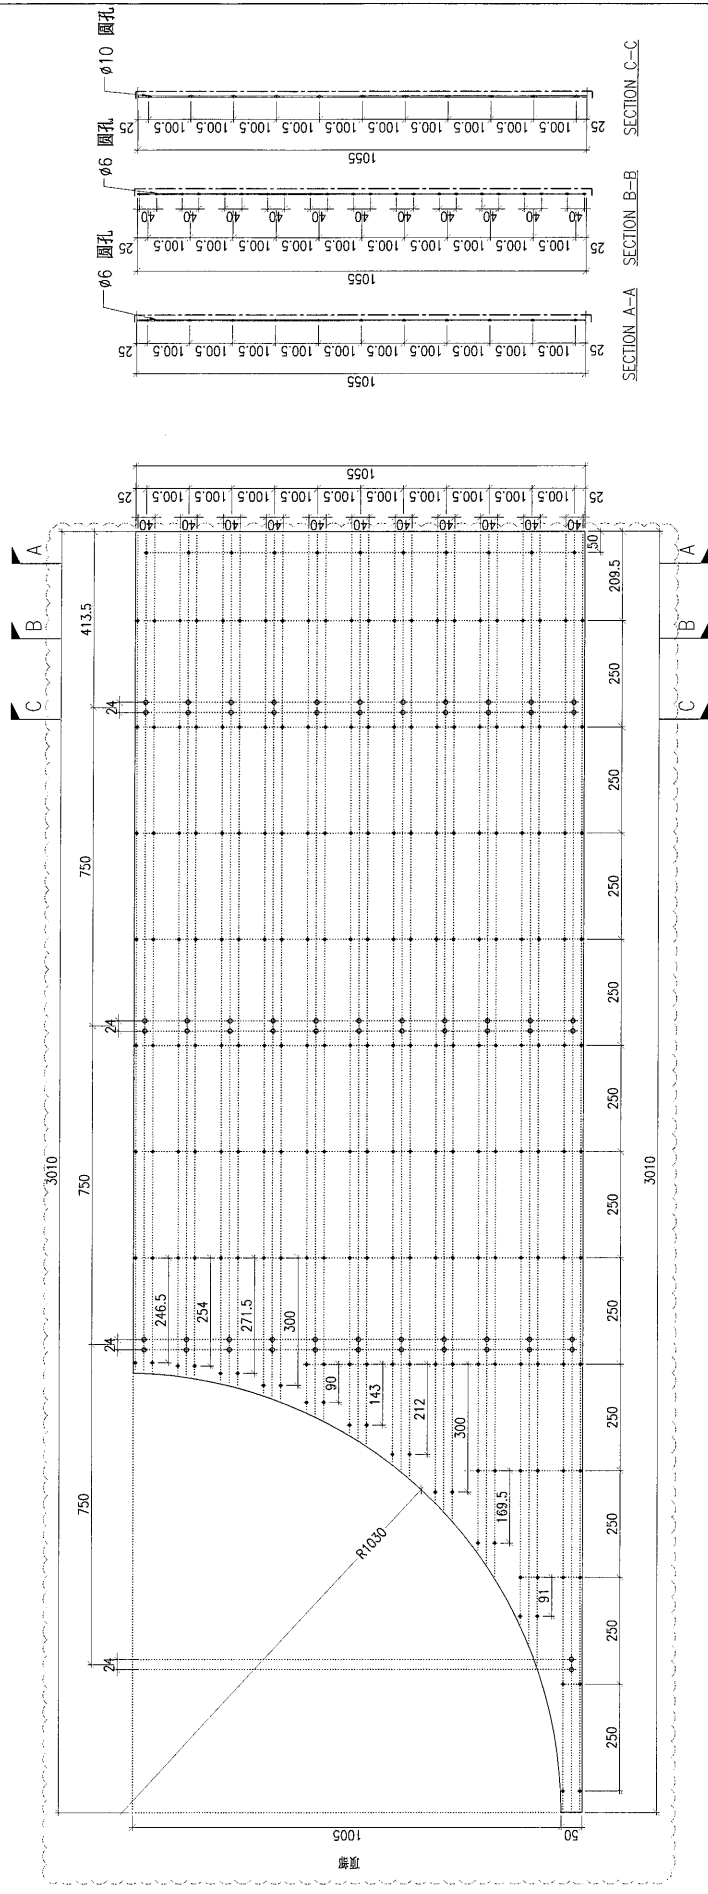

DWG. NO.	P2-AP-EF172	REV.	A	SCALE	-	DATE	13-06-2024	DRAWN BY	-	APPROVED BY	-
----------	-------------	------	---	-------	---	------	------------	----------	---	-------------	---

PROJECT		YIN PING ROAD KOWLOON FEATURE WALL (PHASE 2)				MATERIAL				COATING				COLOUR		MARK. NO.		QTY.	
		3mm 铝板				PVF2				EC-DG-D334232-ZD1(SS-01)									

REV.	CHECKED DATE BY	PART NUMBER	Dim. A	Dim. B	Dim. C	Dim. D	Dim. E	Dim. F	Dim. G	Dim. H	QTY.	Inv. Code	ASSEMBLE ON PARTS						
-		P2-AP-EF173	-	-	-	-	-	-	-	-	1		注: 工厂用						
													注: 工地复尺						

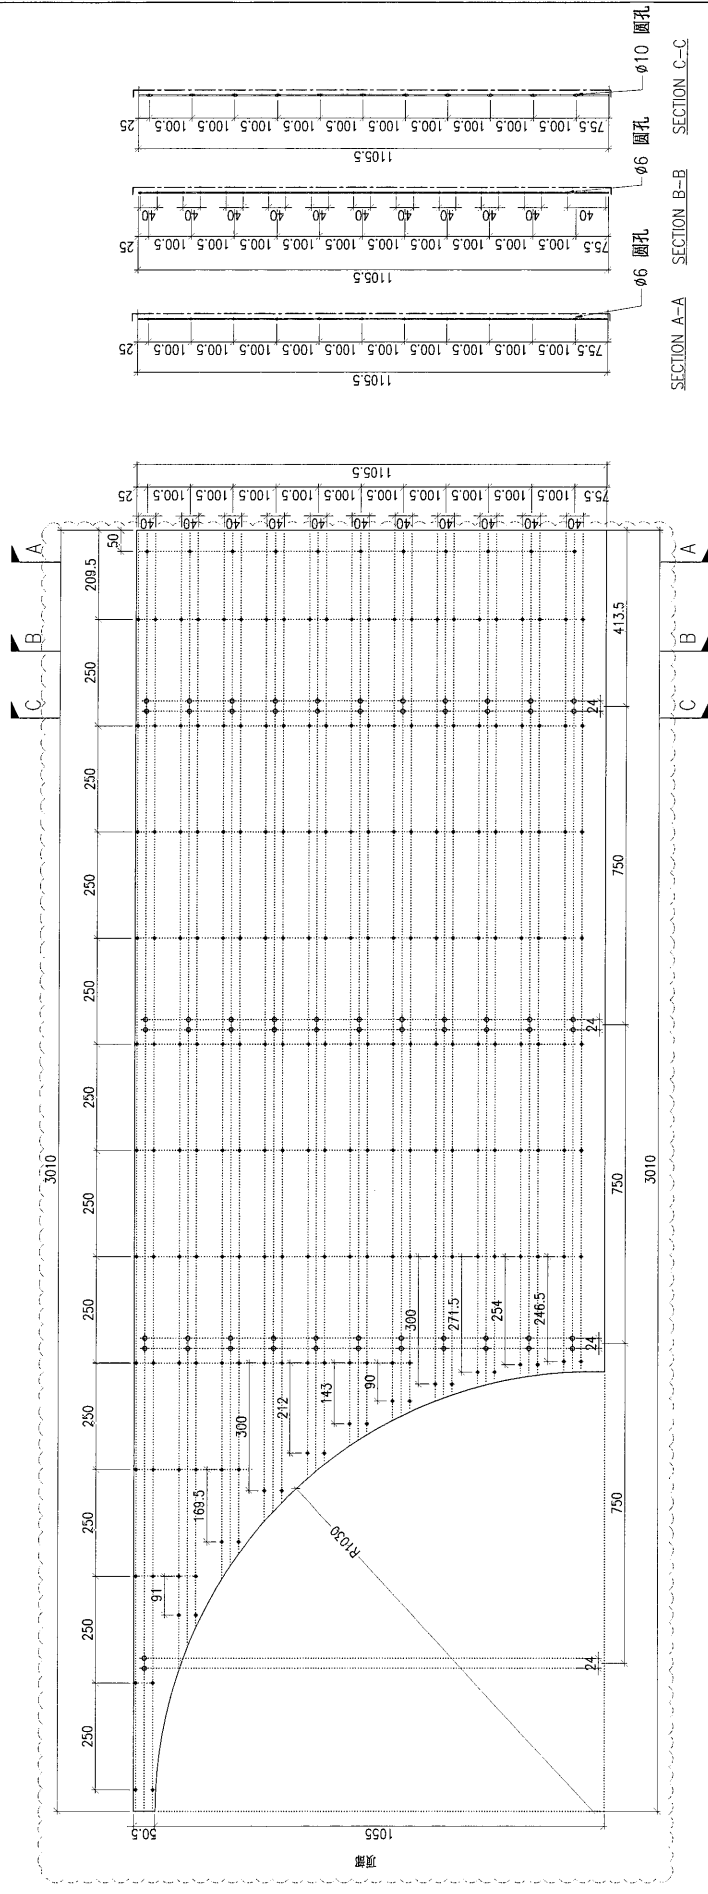

DWG. NO.	P2-AP-EF173	REV.	A	SCALE	-	DATE	13-06-2024	DRAWN BY	-	APPROVED BY	-
----------	-------------	------	---	-------	---	------	------------	----------	---	-------------	---