

工程指示 / 要求簡箋 ENGINEER INSTRUCTIONS(E.I.)

工程指示編號:	EI- 8332	修改版本:	-
	HK- /		
工程編號:	J 853	工程名稱:	延坪道
收件人:	阿基.	發件人:	Joe Chan
工程項目:	J853 屋仔各項增補之螺絲配件	日期:	16/9/2024

<input type="checkbox"/> 原合約工程包	<input type="checkbox"/> 原合約工程加 / 減賬 QT-	<input type="checkbox"/> 新工程報價 QT-
---------------------------------	--	------------------------------------

信件批核號碼/圖紙參考編號:	批核模具圖紙編號:
客戶指示附件:	管理內部批簽署:

<input type="checkbox"/> 初步鋁料 B.M.	<input type="checkbox"/> 加工拆圖, 然後生產	<input type="checkbox"/> 尺寸表
<input type="checkbox"/> 正式鋁料 B.M.	<input type="checkbox"/> 技術上資料/指示	<input type="checkbox"/> 報價
<input type="checkbox"/> 配件 B.M.	<input type="checkbox"/> 樣辦或貨品說明書	<input type="checkbox"/> 分判合約
<input type="checkbox"/> 其他:		

內容: 請依附件資料, 訂購配件, 送地盤.

完成上列要求日期: 23/9/2024 ASAP.

國內


<input type="checkbox"/> 生產技術總監	<input type="checkbox"/> 連附件	<input type="checkbox"/> 技術部	<input type="checkbox"/> 連附件	<input type="checkbox"/> 生產部	<input type="checkbox"/> 連附件
<input type="checkbox"/> 採購部	<input type="checkbox"/> 連附件	<input type="checkbox"/> 生產統籌部	<input type="checkbox"/> 連附件	<input type="checkbox"/> 報關組	<input type="checkbox"/> 連附件
<input type="checkbox"/> 質檢部	<input type="checkbox"/> 連附件	<input type="checkbox"/> 會計部	<input type="checkbox"/> 連附件	<input type="checkbox"/> 機械設計部	<input type="checkbox"/> 連附件
<input type="checkbox"/> 香港辦	<input type="checkbox"/> 連附件	<input type="checkbox"/> 其他:			

香港

<input type="checkbox"/> 行政部	<input type="checkbox"/> 連附件	<input type="checkbox"/> 會計部	<input type="checkbox"/> 連附件	<input type="checkbox"/> 統籌部	<input type="checkbox"/> 連附件	<input type="checkbox"/> 工程部	<input type="checkbox"/> 連附件
<input type="checkbox"/> 採購部	<input type="checkbox"/> 連附件	<input type="checkbox"/> QS部	<input type="checkbox"/> 連附件	<input checked="" type="checkbox"/> 地盤管理	<input checked="" type="checkbox"/> 連附件	<input type="checkbox"/> 維修部	<input type="checkbox"/> 連附件

炳哥

*發件人簽署:		*組別成員批核簽署:	
傳遞編號:		項目經理簽署:	

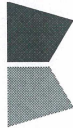

美特鋁質有限公司
MIDI Aluminium Fabricator Ltd.

地盤用配件B.M.表

BM編號:

工程號:	J-853	計算:	JOE	日期:		送呈:	
地盤名稱:	香港延坪道(第二期別墅)	核對:		日期:		副本:	
項目類別:	各項增補配件	批准:		日期:		版本:	
A/C Code:							


序號	修改標示	加工圖号	配件编号	配件名稱	顏色	實用	後備	總數	單位	備註
1				Ø5.5 x 25 圓頭自攻螺絲	S. S.	17610	800	18410	粒	
2				DG791防水胶	古銅色	3500	175	3675	支	
3				HST3-R M10x90mm ANCHOR BOLT (每粒配1平介, 1彈介)	S. S.	3522	176	3698	套	
4				HST3-R M10x110mm ANCHOR BOLT (每粒配1平介, 1彈介)	S. S.	480		480	套	補回已出地盤數量

補回 EI 6945 未有計算之配件.

HOUSE 各項未出之螺絲配件明細

項目	位置	物料	數量
屋仔外牆鋁板，飾線	各屋仔企向疏子，鋁板 未有計BM	M10拉爆	3032
		Ø5.5x25圓自	15160
		DC791古銅膠	3000
		M10拉爆	490
		Ø5.5x25圓自	2450
	ROW A 天上天位置，補畫之鋁板	DC791古銅膠	500

計BIM時未有畫上
需補回圖件

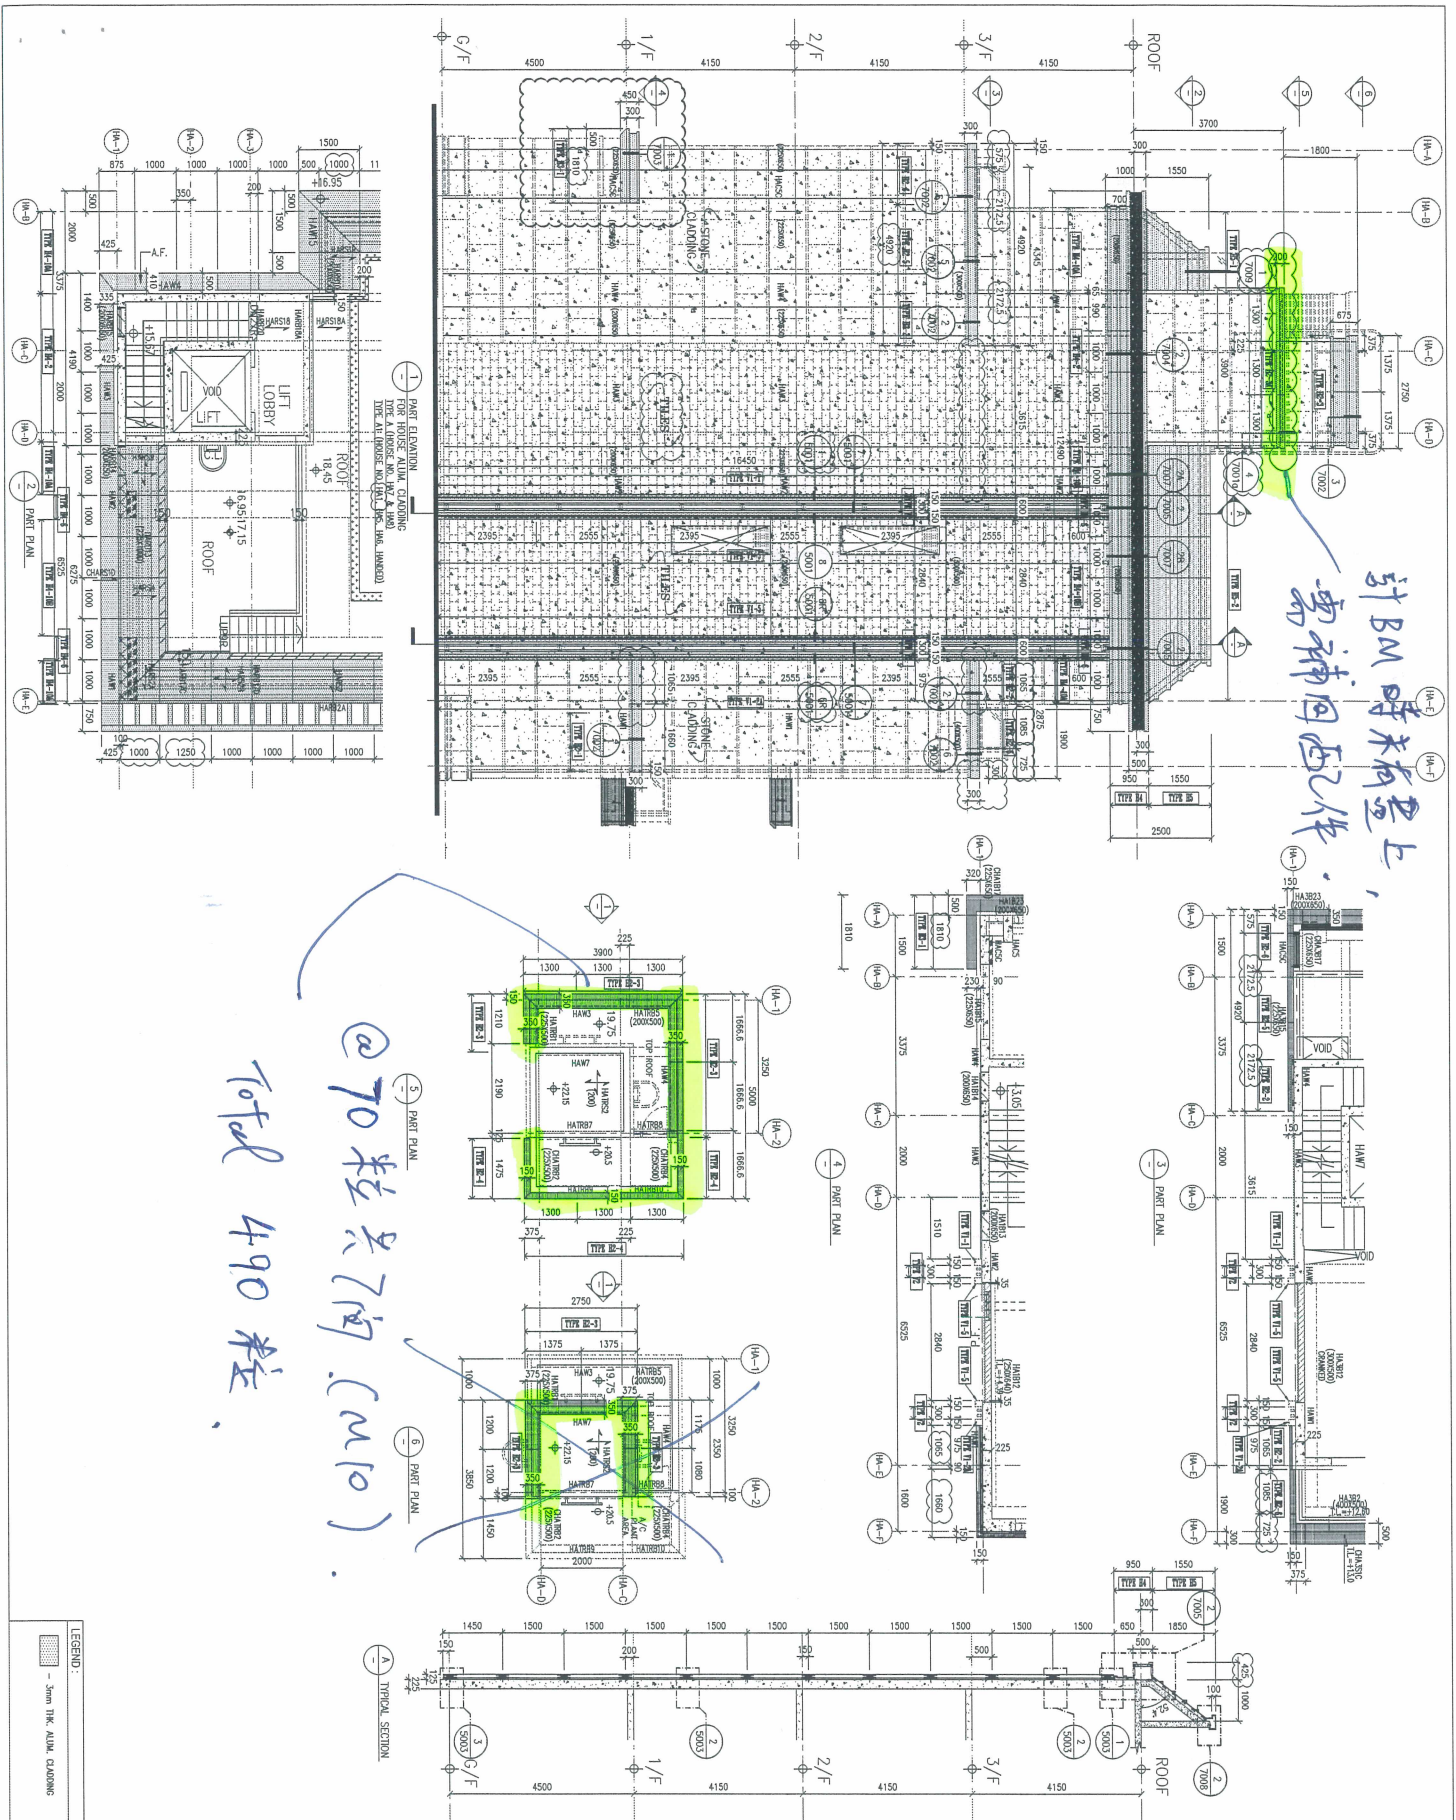

總共 490 粒
@ 70 粒 共 7 間 (M10)

<p>B.O. REF :</p>	
<p>CLIENT : SHIMAO GROUP HOLDINGS LIMITED</p>	
<p>ARCHITECT : YONG TUNG & PARTNERS LIMITED</p>	
<p>MAIN CONTRACTOR : 協興建築有限公司 HIP HING CONSTRUCTION CO. LTD</p>	
<p>STRUCTURAL ENGINEERS : C.M. WONG & ASSOCIATES LTD 黃志明建築工程師有限公司</p>	
<p>FAÇADE CONSULTANT : WEINYARDT</p>	
<p>NOTE : 1. ALL DIMENSIONS ARE IN MM. 2. ALL DIMENSIONS ARE MEASURED FROM OUTSIDE. 3. ALL DIMENSIONS TO BE CHECKED ON SITE BEFORE FABRICATION.</p>	
<p>LEGEND : ○ DETAIL MARK NO. □ REFER SHEET NO.</p>	
<p>1. F.F.L. --- FINISHED FLOOR LEVEL. 2. S.F.L. --- STRUCTURAL FLOOR LEVEL. 3. R.F. --- REINFORCED DETAIL. R.C. STRUCTURAL ELEMENT CONC. / BEAM / SLAB IS (UNDER SPANNING SUBMISSION)</p>	
<p>JOB NO. : J-853</p>	
<p>PROJECT : PROPOSED RESIDENTIAL DEVELOPMENT AT N.K.I.L. 6542 YIN PING ROAD KOWLOON</p>	
<p>TITLE : PART ELEVATION FOR HOUSE ALUM. CLADDING HOUSE TYPE A & A1</p>	
<p>DATE : 10-08-23 SCALE : 1:80 (A1)</p>	
<p>DRAWN BY : Jading CHECKED BY :</p>	
<p>UNIT 6-8, Sunny Industrial Centre, 1/F, 610 Chee Kwo Ling Road, Kowloon Tel: 23498271-4 Fax: (852) 27277665 DWG NO. : J853-SD-14A-3002</p>	
<p>REV : 0</p>	

Row A (共 7 间, 16m 高)

@ 2 H=600 企飾 @ 1000/c 共 2 粒, @ 1500/c 共 2 粒
@ 1 KPD @ 1500/c 共 4 粒, @ 1000/c 共 2 粒 } 每屋 176 粒
Total = 1232 粒

Row B (共 7 间, 11.2m 高)

@ 2 H=600 企飾 @ 1000/c 共 2 粒, @ 1500/c 共 2 粒
@ 1 KPD @ 1500/c 共 4 粒, @ 1000/c 共 2 粒 } 每屋 122 粒
Total = 854 粒

Row C & D (共 11 间, 11.2m 高)

@ 1 H=600 企飾 @ 1000/c 共 2 粒, @ 1500/c 共 2 粒
@ 1 KPD @ 1500/c 共 4 粒, @ 1000/c 共 2 粒 } 每屋 86 粒
Total = 946 粒

共 3032 粒

55x25 自攻: 约 15160 粒 (约拉爆数 5 倍)

DC 791 舌膠: 3000 粒

