

工程指示 / 要求簡箋 ENGINEER INSTRUCTIONS(E.I.)

工程指示編號:	EI-8506	修改版本:	-
	HK- /		
工程編號:	J 853	工程名稱:	延坪道
收件人:	Maggie Lor	發件人:	Joe Chan
工程項目:	花園欄河補張璃	日期:	31/10/2024

<input type="checkbox"/> 原合約工程包	<input type="checkbox"/> 原合約工程加 / 減賬 QT-	<input type="checkbox"/> 新工程報價 QT-
---------------------------------	--	------------------------------------

信件批核號碼/圖紙參考編號:	批核模具圖紙編號:
客戶指示附件:	管理內部批簽署:

<input type="checkbox"/> 初步鋁料 B.M.	<input type="checkbox"/> 加工拆圖, 然後生產	<input type="checkbox"/> 尺寸表
<input type="checkbox"/> 正式鋁料 B.M.	<input type="checkbox"/> 技術上資料/指示	<input type="checkbox"/> 報價
<input type="checkbox"/> 配件 B.M.	<input type="checkbox"/> 樣辦或貨品說明書	<input type="checkbox"/> 分判合約
<input type="checkbox"/> 其他:		

內容: 請依附件資料, 生產玻璃, 送地盤.
 - 按 BSEN 14179-1:2016 標準熱浸.
 - 請一批過出貨.

完成上列要求日期: 25/11/2024


國內

<input type="checkbox"/> 生產技術總監	<input type="checkbox"/> 連附件	<input type="checkbox"/> 技術部	<input type="checkbox"/> 連附件	<input type="checkbox"/> 生產部	<input type="checkbox"/> 連附件
<input type="checkbox"/> 採購部	<input type="checkbox"/> 連附件	<input type="checkbox"/> 生產統籌部	<input type="checkbox"/> 連附件	<input type="checkbox"/> 報關組	<input type="checkbox"/> 連附件
<input type="checkbox"/> 質檢部	<input type="checkbox"/> 連附件	<input type="checkbox"/> 會計部	<input type="checkbox"/> 連附件	<input type="checkbox"/> 機械設計部	<input type="checkbox"/> 連附件
<input type="checkbox"/> 香港辦	<input type="checkbox"/> 連附件	<input type="checkbox"/> 其他:			

香港


<input type="checkbox"/> 行政部	<input type="checkbox"/> 連附件	<input type="checkbox"/> 會計部	<input type="checkbox"/> 連附件	<input type="checkbox"/> 統籌部	<input type="checkbox"/> 連附件	<input type="checkbox"/> 工程部	<input type="checkbox"/> 連附件
<input type="checkbox"/> 採購部	<input type="checkbox"/> 連附件	<input type="checkbox"/> QS部	<input type="checkbox"/> 連附件	<input checked="" type="checkbox"/> 地盤管理	<input type="checkbox"/> 連附件	<input type="checkbox"/> 維修部	<input type="checkbox"/> 連附件

*發件人簽署:		*組別成員批核簽署:	
傳遞編號:		項目經理簽署:	

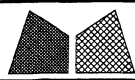


美特铝质有限公司
MIDI Aluminium Fabricator Ltd.


版本号		采用	工厂	地盘	√	名称	玻璃加工图	批准	-	数量	-		
日期		颜色	-			材料	GL3:15 T+1.52PBV+15 T	单件面积(m ²)	-	长度	-	宽度	-
工程号	J853	制图	J.L.	15/03/24	物料号	详见玻璃BM表							
地盘	香港延坪路	复核	-	-	图号	J853-GB-GL3-500							

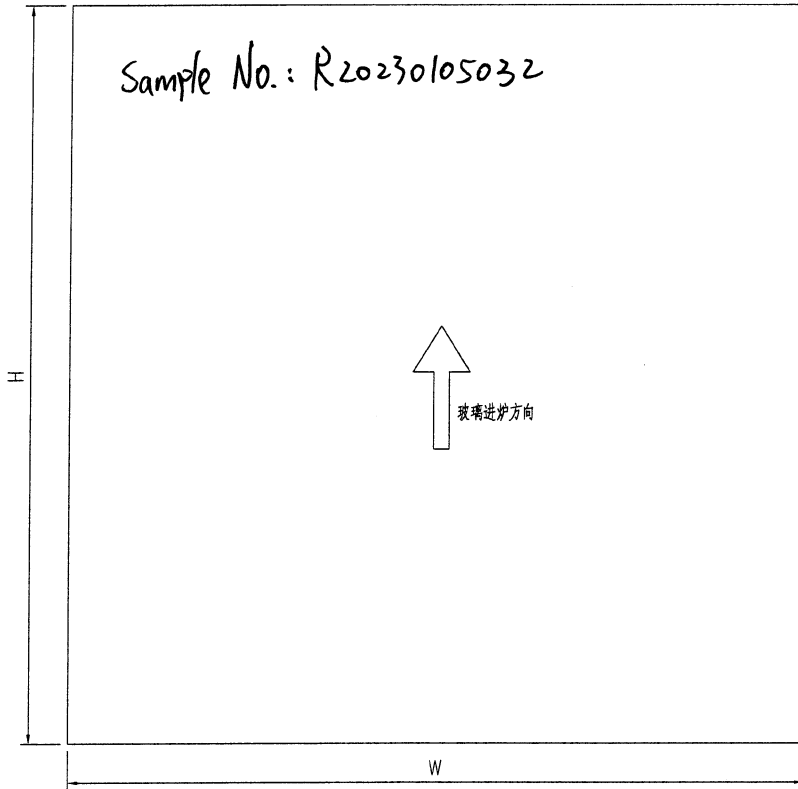

顶

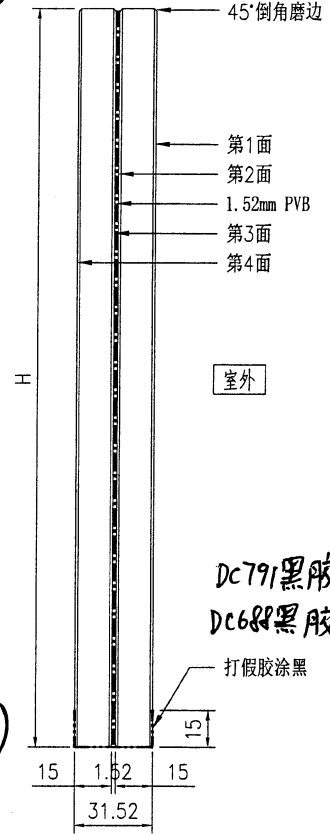

底

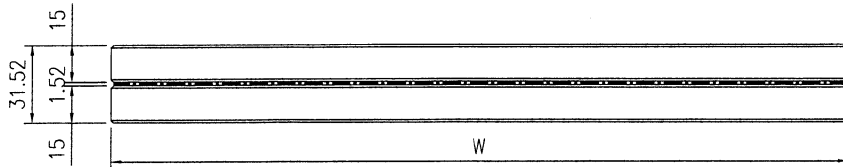

技术说明:

1.玻璃为: GL3:15mm THK. CLEAR TEMPERED + 1.52mm THK. (PVB) + 15mm THK. CLEAR TEMPERED LAMINATED GLASS

2.色号为: _____, Low-e膜在第 _____ 面;


3.中空铝隔条, 两面涂丁基胶涂抹均匀, 内层为铝框本色, 玻璃四周1x45°机磨边;

4.玻璃密封胶采用: _____, 胶深符合相应规范要求;

5.中空玻璃应符合《中空玻璃》GB1194-2002国家标准, 并按《玻璃幕墙工程质量检验标准》JGJ/T139-2001进行质量检验;

6.玻璃出厂前必须粘好相应编号及内外标签, 玻璃单边长度超过2m, 所有全钢化玻璃需要热浸处理;

7.玻璃钢化波纹方向平行分布; 图中标注尺寸单位为mm, 进炉方向与滚轮垂直。

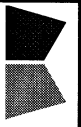

美特鋁質有限公司
MIDI Aluminium Fabricator Ltd.





地盘用玻璃B.M.表

BM編號:

工程號:	J-853	計算:	JOE	日期:		送呈:	
地盘名稱:	香港延坪道(第二期別墅)	核對:	JOE	日期:		副本:	
項目類別:	花園欄河補玻璃	批准:		日期:		版本:	
A/C Code:		總數量:	2	總面積 (m ²):	1.76		


序號	修改標示	加工圖号	玻璃编号	玻璃名稱	厚度 (mm)	玻璃尺寸		數量 (塊)	面積 (m ²)		備註	
						寬度W (mm)	高度H (mm)		單件	總面積		
1		J853-GB-GL3-001	J853-GB-GL3-500-01	GL3:15mm THK. CLEAR TEMPERED + 1.52mm THK. (PVB) + 15mm THK. CLEAR TEMPERED LAMINATED GLASS	31.52	1120	790	1	0.88	0.88	用於HA8花園欄河	
2		J853-GB-GL3-001	J853-GB-GL3-500-02			1105	790	1	0.87	0.87		用於HCl花園欄河
3												
4												
5												
6												
7												
8												
9												
10												
11												
						總合計:	2		1.76			

- 加工注意事項:
- 1). 本表中所有玻璃對角線尺寸偏差要求不超過正負2mm.
 - 2). 本表中所有玻璃要求粗磨邊處理並倒棱角.
 - 3). 本表中玻璃要求粗磨邊處理並倒棱角, 欄河玻璃頂底要精磨邊, 而所有玻璃之入爐方向需保持一致.
 - 4). 本表中不同種類玻璃參照玻璃加工圖加工.
 - 5). 本表中所有強化玻璃均需HEAT SOAK TEST.
 - 6). 本表中所有玻璃均需注明室內外面及其玻璃編號, 以便識別.

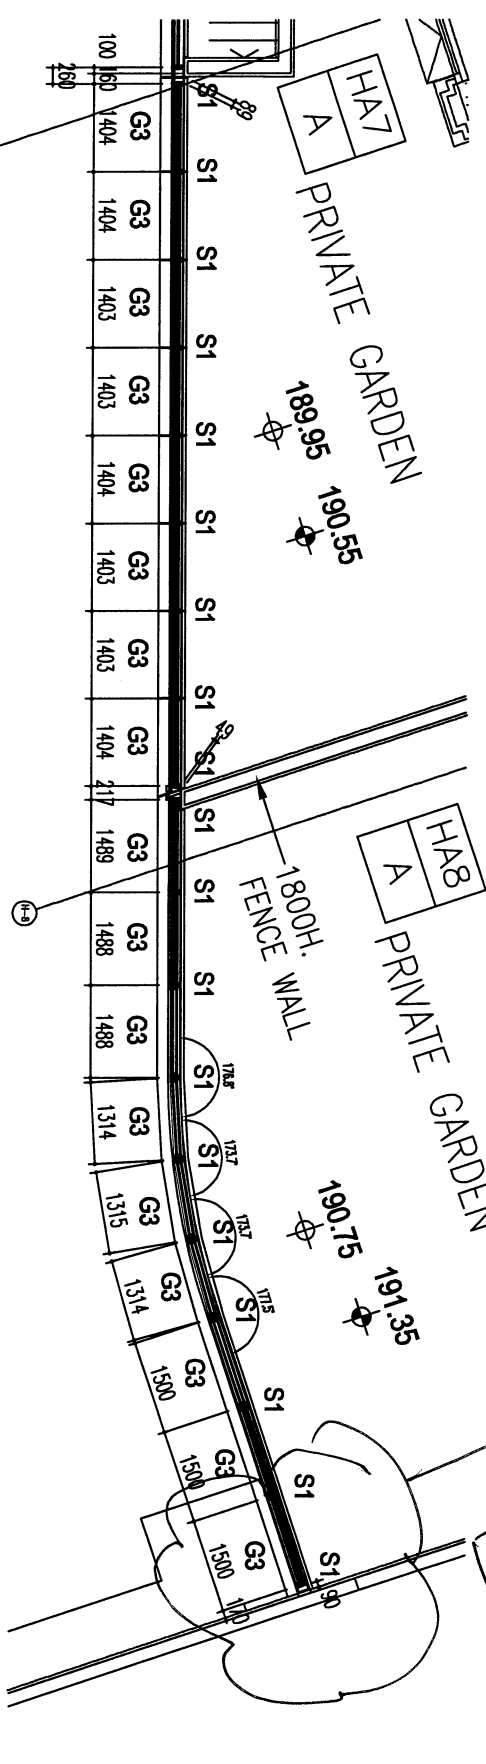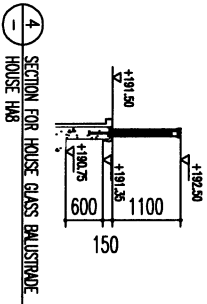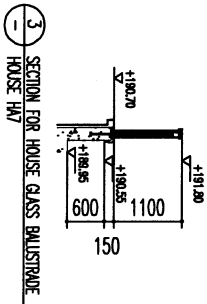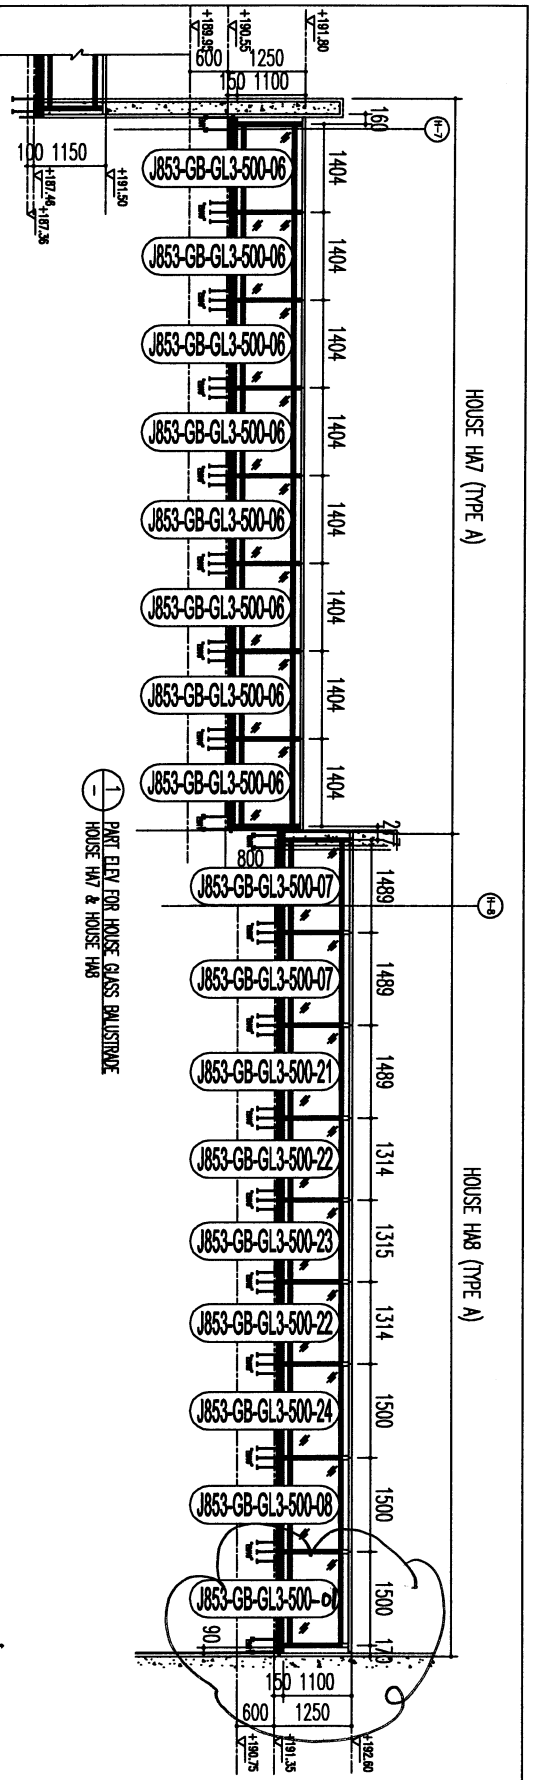


CLIENT: SHIMAO GROUP HOLDINGS LIMITED		MAIN CONTRACTOR: HIP HING CONSTRUCTION CO LTD		STRUCTURAL ENGINEER: CMA CHAI WONG & ASSOCIATES LTD		FRAME CONSULTANT: MENYARD			
ARCHITECT: SHIMAO GROUP HOLDINGS LIMITED		PROJECT: PROPOSED RESIDENTIAL DEVELOPMENT AT N.K.L.L. 6542 YIN PING ROAD KOWLOON		JOB NO.: J-953		DATE: 20-MAY-23			
TITLE: PART ELEV AND PART PLAN FOR HOUSE GLASS BALUSTRADE (ROW A) (4)		SCALE: 1:80 (A3)		DRAWN BY: YI		CHECKED BY: YI			
REVISIONS: 1. ALL DIMENSIONS ARE IN MM. 2. ALL DIMENSIONS TO FACE UNLESS SPECIFIED OTHERWISE. 3. ALL DIMENSIONS TO BE VERIFIED ON SITE BEFORE FABRICATION.		LEGEND: 1. F.F.L. - FINISHED FLOOR LEVEL. 2. S.F.L. - STRUCTURAL FLOOR LEVEL. 3. R.E. - REVERSED LEVEL.		GLASS: 1. 15MM THK. CLEAR TEMPERED GLASS. 2. 15MM THK. CLEAR TEMPERED GLASS WITH THERMOPLASTIC INTERLAYER. 3. 100x3mm THK. GALV. PLAT BRG. 4. 20x20mm THK. GALV. CHANNEL. 5. 20x20mm THK. GALV. ANGLE. 6. 20x20mm THK. GALV. ANGLE. 7. 20x20mm THK. GALV. ANGLE. 8. 20x20mm THK. GALV. ANGLE. 9. 20x20mm THK. GALV. ANGLE. 10. 20x20mm THK. GALV. ANGLE.		REVISIONS SUBJECT TO MAIN CONTRACTOR: 1. 11-01-2024 2. 01-04-2024		DATE: 20-MAY-23	
UNITED ENGINEERING CONSULTANTS LTD. 610 Cheong Cheong Road, Kowloon Tel: (852) 2777 7777 Fax: (852) 2777 7799		SHIMAO GROUP HOLDINGS LIMITED 610 Cheong Cheong Road, Kowloon Tel: (852) 2777 7777 Fax: (852) 2777 7799		SHIMAO GROUP HOLDINGS LIMITED 610 Cheong Cheong Road, Kowloon Tel: (852) 2777 7777 Fax: (852) 2777 7799		SHIMAO GROUP HOLDINGS LIMITED 610 Cheong Cheong Road, Kowloon Tel: (852) 2777 7777 Fax: (852) 2777 7799			


HC2 補比玻璃

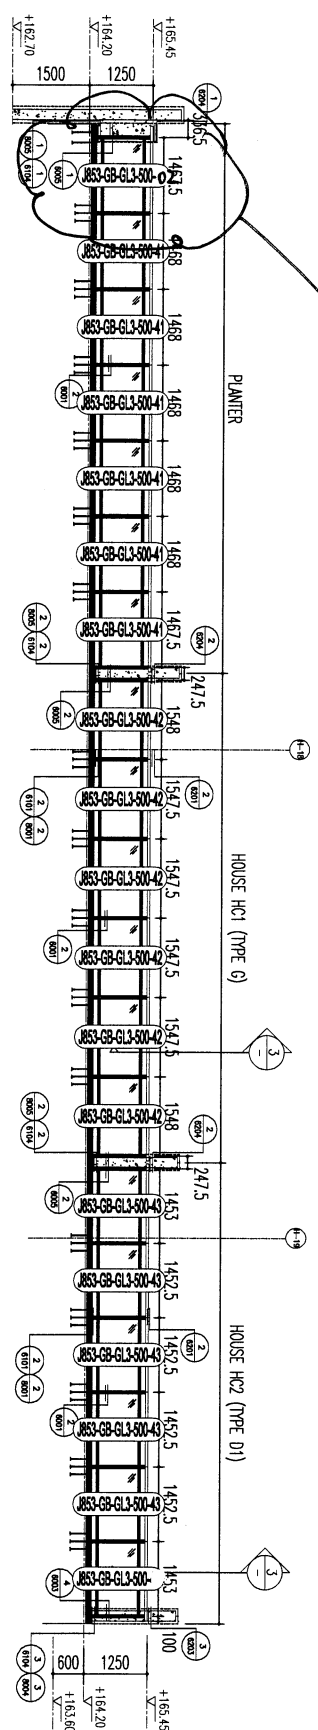

1 PART ELEV FOR HOUSE GLASS BALUSTRADE
HOUSE HC1 & HOUSE HC2

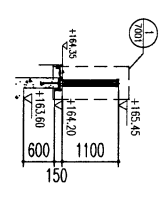

3 SECTION FOR HOUSE GLASS BALUSTRADE
PLANTER & HOUSE HC1 & HOUSE HC2

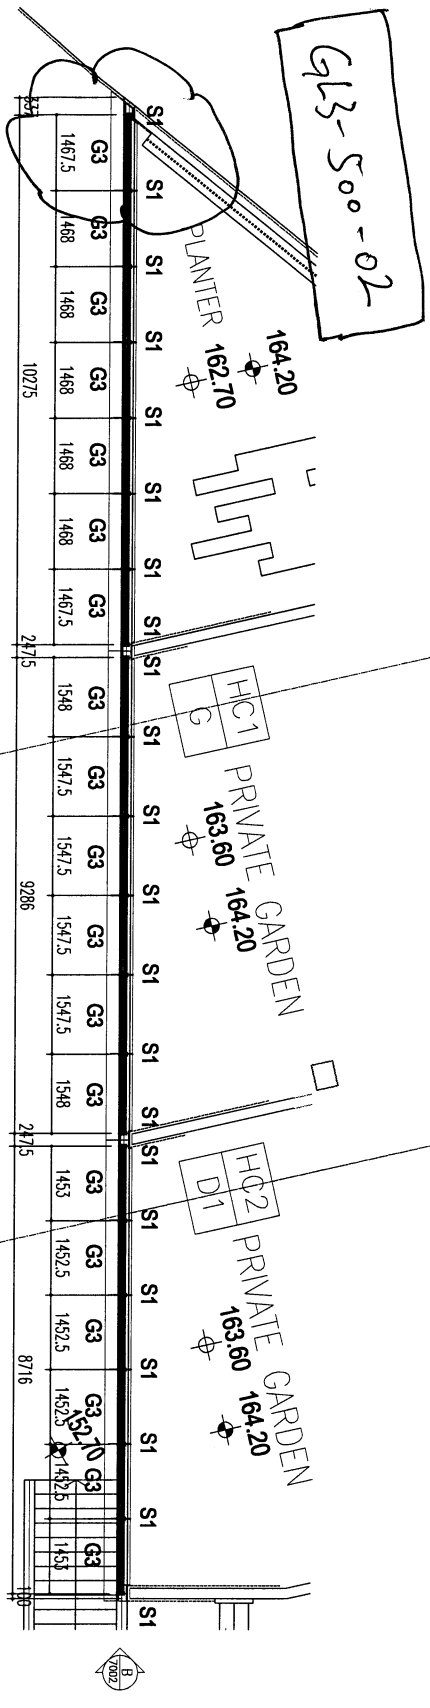

2 PART PLAN FOR HOUSE GLASS BALUSTRADE
HOUSE HC1 & HOUSE HC2

BA REF :

CLIENT :
SHIMAO GROUP HOLDINGS LIMITED

ARCHITECT :
WTF
WORKING TIME & PARTNERS LIMITED

MAIN CONTRACTOR :
協興建築有限公司
HIP HING CONSTRUCTION CO LTD

STRUCTURAL ENGINEER :
CMA
C M WONG & ASSOCIATES LTD
黃志明建築工程師有限公司

FAÇADE CONSULTANT:
NEUNHARDT

NOTE:
1. DIMENSIONS ARE IN MM.
2. ALL DIMENSIONS ARE VIEWED FROM OUTSIDE.
3. ALL DIMENSIONS TO BE VIEWED ON SITE BEFORE FABRICATION.

LEGEND:
 (X) DETAIL MARK NO.
 (REF) REFER SHEET NO.
 1. FEEL.—FINISHED FLOOR LEVEL.
 2. SEL.—STRUCTURAL FLOOR LEVEL.
 3. (R)—REVERSED LEVEL.

GL3: 15mm THK CLEAR TEMPERED GLASS
 1: 1520x90 +15mm THK CLEAR T-SPACER
 S1: 100x50x5 THK GALV. STEEL SQUARE
 S2: 80x40x5mm THK GALV. CHANNEL
 S6: (CUT FROM 120x60x5mm THK GALV. R.H.S.)
 S8: (CUT FROM 40x40x5mm THK GALV. ANGLE)
 S7: 40x25x5mm THK GALV. ANGLE
 S5: 75x40x5mm THK GALV. ANGLE
 S8: 75x40x5mm THK GALV. ANGLE
 S8: (CUT FROM 75x40x5mm THK GALV. ANGLE)

JOB NO. : J-853

PROJECT :
PROPOSED RESIDENTIAL DEVELOPMENT AT N.KILL, 65/42 YIN PING ROAD KOWLOON

TITLE :
PART ELEV and PART PLAN FOR HOUSE GLASS BALUSTRADE
GLASS MARKING DWG

DATE : 20-MAY-23 SCALE : 1:80 (A3)

DRAWN BY : YI CHECKED BY :

美特銘實有限公司
METAL MARKING & FABRICATION LTD
Unit 8-B, Sanyang Industrial Building, 17/F, 610 Chee Kwoi Road, Kowloon
Tel: 23489211-4 Fax: (852) 27777855
DWG NO. : J853-09-GL-5301 REV. : -