

工程指示 / 要求簡箋(E.I.)

工程指示編號: EI/ 4100 /21 修改版次:
 工程編號: J853 工程名稱: 延坪道住宅項目
 工程項目: PMU單元件廠用玻璃
 收件人: Maggie Lo 發件人: Joe Chan 日期: 1/12/2021

要求提供 / 確認 事項:

- | | | |
|------------------------------------|-------------------------------------|-------------------------------|
| <input type="checkbox"/> 初步鋁料 B.M. | <input type="checkbox"/> 加工拆圖, 然後生產 | <input type="checkbox"/> 尺寸表 |
| <input type="checkbox"/> 正式鋁料 B.M. | <input type="checkbox"/> 技術上資料 / 指示 | <input type="checkbox"/> 報價 |
| <input type="checkbox"/> 配件 B.M. | <input type="checkbox"/> 樣辦或貨品說明書 | <input type="checkbox"/> 分判合約 |
| <input type="checkbox"/> 其他: _____ | | |

內容:

請依附件資料, 生產玻璃, 送美特廠。
 - 請按 BS-EN 14179-1:2016 標準做 Heat-Soak Test

請在 7/1/2021 前完成上列要求。

附有關圖紙 / 文件:

119頁

以上項目為:

- 原合約工程包 原合約工程加 / 減賬 新工程報價

原因: -

分發東莞各部門:

- () 生產技術總監 連附件 () 技術部 連附件 () 生產部 連附件 () 機械設計部 連附件
 () 採購部 連附件 (✓) 生產統籌部 連附件 梅, TRACY
 () 質檢部 連附件 () 會計部 連附件 () 報關組 連附件 () 其他 _____ 連附件

分發香港各部門:

- () 行政部 連附件 () 會計部 連附件 () 統籌部 連附件 () 工程部地盤科文 連附件
 () 採購部 連附件 () QS 部 連附件 () 維修部 連附件 () 其他 _____ 連附件

傳遞編號:

HK 2194 /21

發件人簽署:

項目經理簽署:

	工程號:	J853	計算:	謝曉云	日期:	2021.11.19	送呈:	胡哥	計算參考數值/ 所屬位置分格
	地盤名稱:	九龍延坪道	核對:	謝永林	日期:	2021.11.22	副本:		
應用玻璃B.M.表	項目類別:		批准:				A/C Code:		
B.M.編號:	修改版本:	總計上玻璃面積 (平方米):		88.022					

序號	修改內容	玻璃圖號	顏色與類型	厚度 (mm)	玻璃尺寸		數量	總面積 (平方米)	使用位置	加工參考	分屬類型	分格1	分格高度	備註
					寬度 (W mm)	高度 (H mm)								
1		G1-P101	G1	34	2220.5	2487.0	2	11.045	PMU	G1	梗窗	2325.0	2542.5	轉角1
2		G1-P102	G1	34	2341.0	2487.0	2	11.644	PMU	G1	梗窗	2375.0	2542.5	
3		G1-P103	G1	34	1966.0	2487.0	2	9.779	PMU	G1	梗窗	2000.0	2542.5	
4		G1-P104	G1	34	2368.5	2487.0	2	11.781	PMU	G1	梗窗	2402.5	2542.5	
5		G1-P1	G1	34	1193.5	657.0	2	1.568	PMU	G1	梗窗	1315.0	712.5	轉角2
6		G1-P2	G1	34	966.0	657.0	4	2.539	PMU	G1	梗窗	1000.0	712.5	
7		G1-P3	G1	34	751.0	657.0	2	0.987	PMU	G1	梗窗	785.0	712.5	
8		G2-P1	G2	32	1179.0	1777.0	2	4.190	PMU	G2-P1	TH	1315.0	1830.0	轉角2
9		G2-P2	G2	32	938.0	1777.0	4	6.667	PMU	G2	TH	1000.0	1830.0	
10		G2-P3	G2	32	723.0	1777.0	2	2.570	PMU	G2	SHL	785.0	1830.0	
11		G4-P101	G4	12	2220.5	903.0	2	4.010	PMU	G4	梗窗	2325.0	957.5	轉角1
13		G4-P102	G4	12	2341.0	903.0	2	4.228	PMU	G4	梗窗	2375.0	957.5	
14		G4-P103	G4	12	1966.0	903.0	2	3.551	PMU	G4	梗窗	2000.0	957.5	
16		G4-P104	G4	12	2368.5	903.0	2	4.278	PMU	G4	梗窗	2402.5	957.5	
12		G4-P1	G4	12	1193.5	903.0	2	2.155	PMU	G4	梗窗	1315.0	957.5	轉角2
15		G4-P2	G4	12	966.0	903.0	4	3.489	PMU	G4	梗窗	1000.0	957.5	
17		G4-P3	G4	12	751.0	903.0	2	1.356	PMU	G4	梗窗	785.0	957.5	
18		G5-P1	G5	12	1098.0	297.5	2	0.653	PMU	G5	欄河	1315.0	297.5	轉角2
19		G5-P2	G5	12	930.0	297.5	4	1.107	PMU	G5	欄河	1000.0	297.5	
20		G5-P3	G5	12	715.0	297.5	2	0.425	PMU	G5	欄河	785.0	297.5	
							合計	48	88.022					

1) 本表中玻璃採用三鑫公司產玻璃，樣板代號亦為三鑫產品代號。

2) 本表中所有玻璃對角線尺寸偏差要求不超過負2mm。

3) 本表中玻璃要求粗磨邊處理並倒角，欄河玻璃頂底要精磨邊，而所有玻璃之入爐方向需保持一致。


4) 本表中所有玻璃成品均需做雙面保護，用透明靜電膠紙加四周一寸PK白膠紙做雙面加固保護處理。


5) 本表中所有玻璃成品均需注明室內外及其玻璃編號/使用位置/樓層，以便識別。

加工注意事項
玻璃類型描述：



- (G1) 10mm (Heat Strengthened)+12mm Air +12mm (Tempered) IGTU (10mm FDNB0-54T#2 + 12A + 12mm Clear) Sample No.: D21031911
- (G2) 10mm (Heat Strengthened)+12mm Air +10mm (Tempered) IGTU (10mm FDNB0-54T#2 + 12A + 10mm Clear) Sample No.: D21031909
- (G4) 12mm Clear (Heat Strengthened) with CST154 (12mm Clear #2 SSC-50T) Sample No.: D21032005
- (G5) 12mm Clear Tempered Glass (12mm Clear) Sample No.: D21032007

2


 美特鋁質有限公司 MIDI Aluminium Fabricator Ltd.				類別	物料號		
修改				制圖 謝曉云	2021.11.19	圖號 G1	
日期				復核 謝永林	2021.11.22	數量 見BOM表	
				批准		位置 見BOM表	

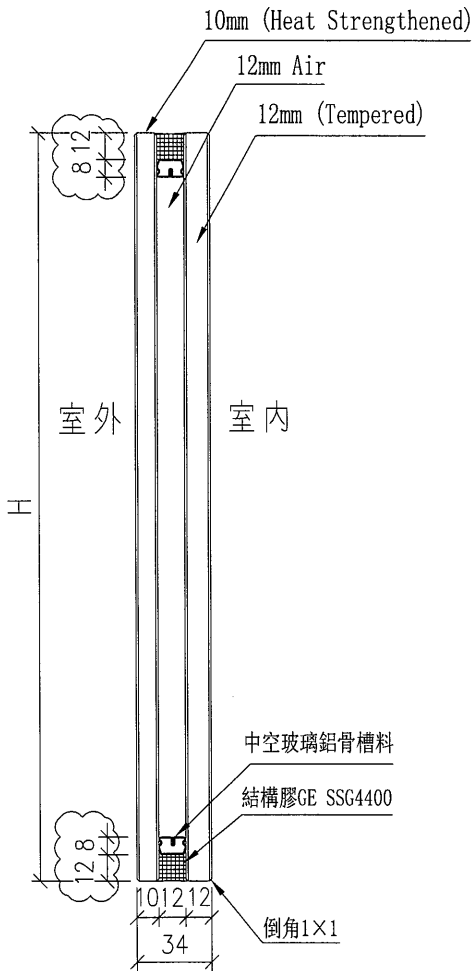


頂

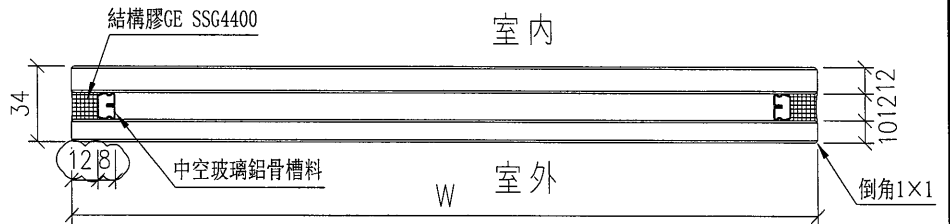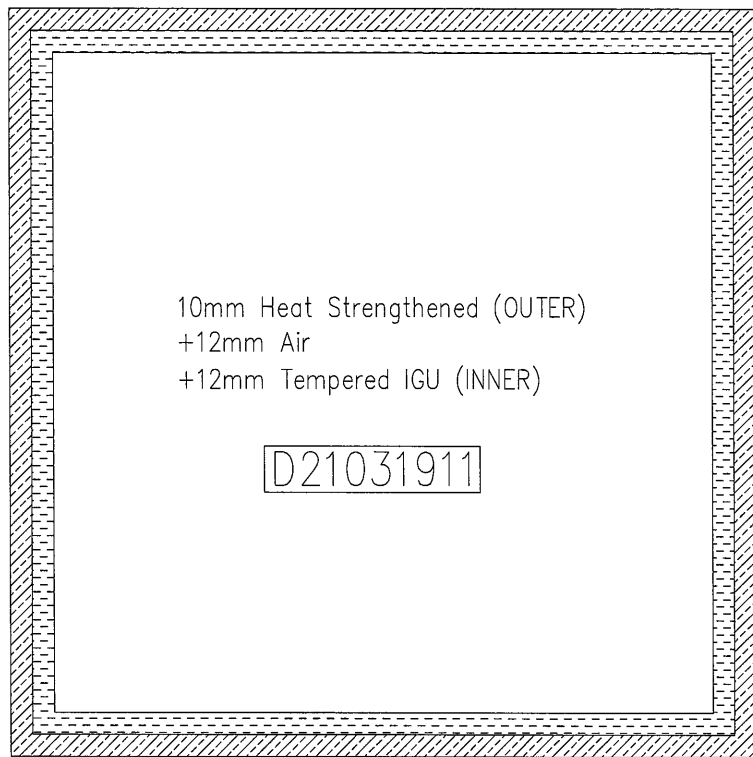


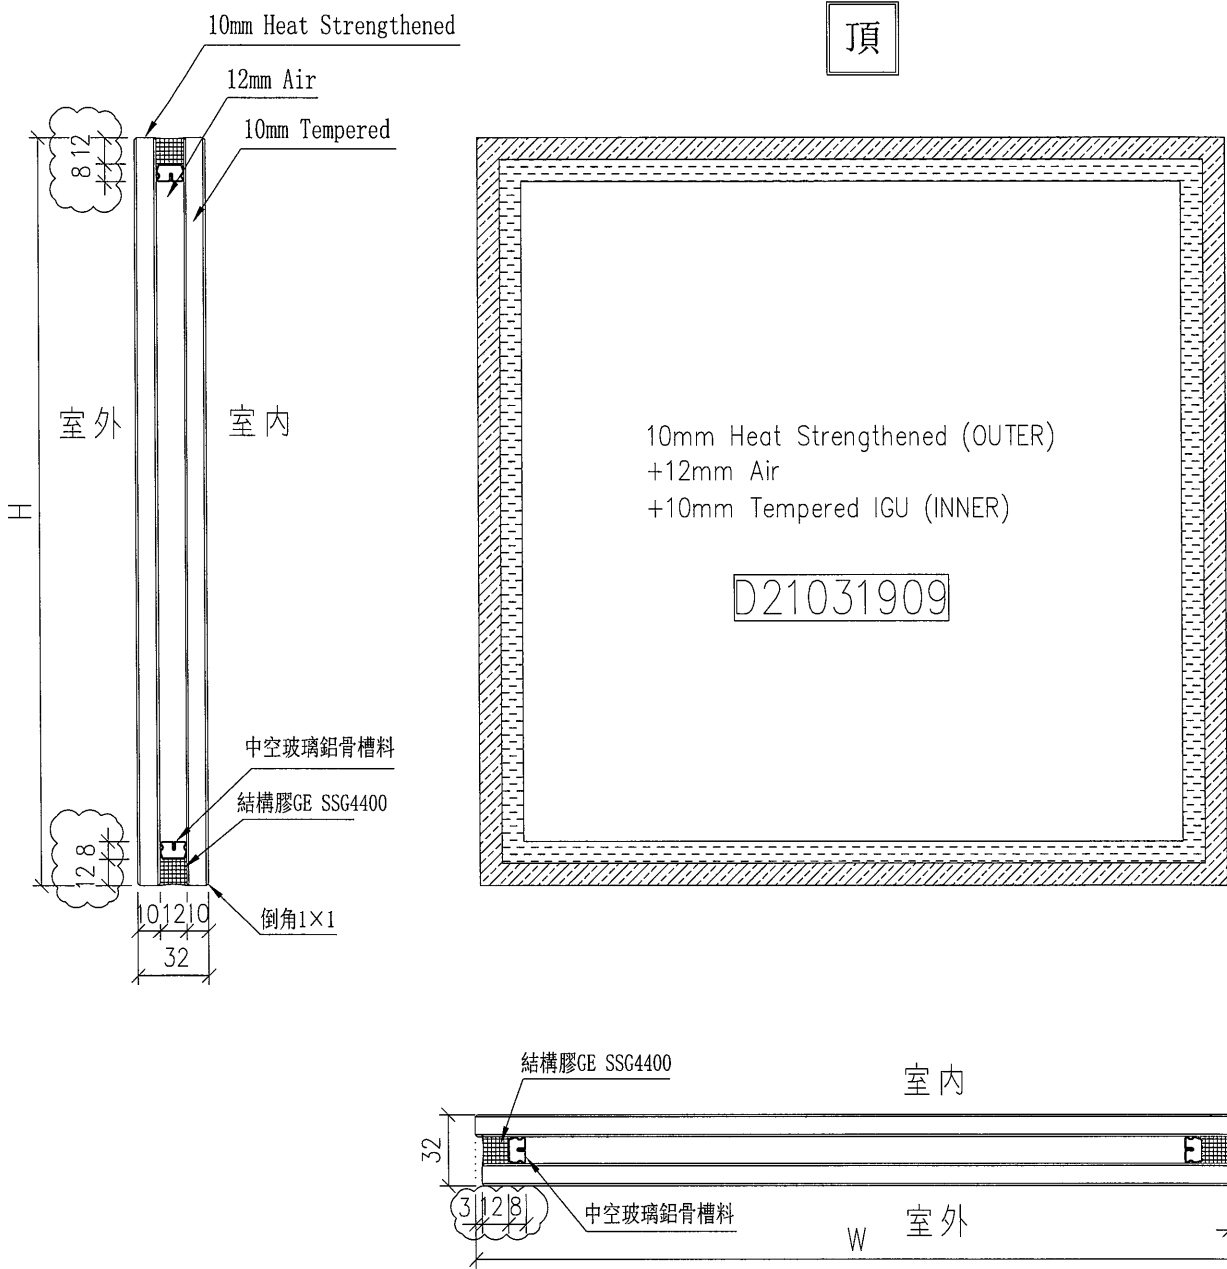
工程號	J-853	地盤	九龍延坪道	附 件
名稱	玻璃加工圖 (大梗窗玻璃+小梗窗玻璃)		採用	
材料			地盤	
顏色	10mm FDNB0-54T#2+12A+12mm Clear		工廠	

 美特鋁質有限公司 MIDI Aluminium Fabricator Ltd.				類別	物料號			
修改				制圖	謝曉云	2021.11.19	圖號	G2-P1
日期				復核	謝永林	2021.11.22	數量	見BOM表
				批准			位置	見BOM表

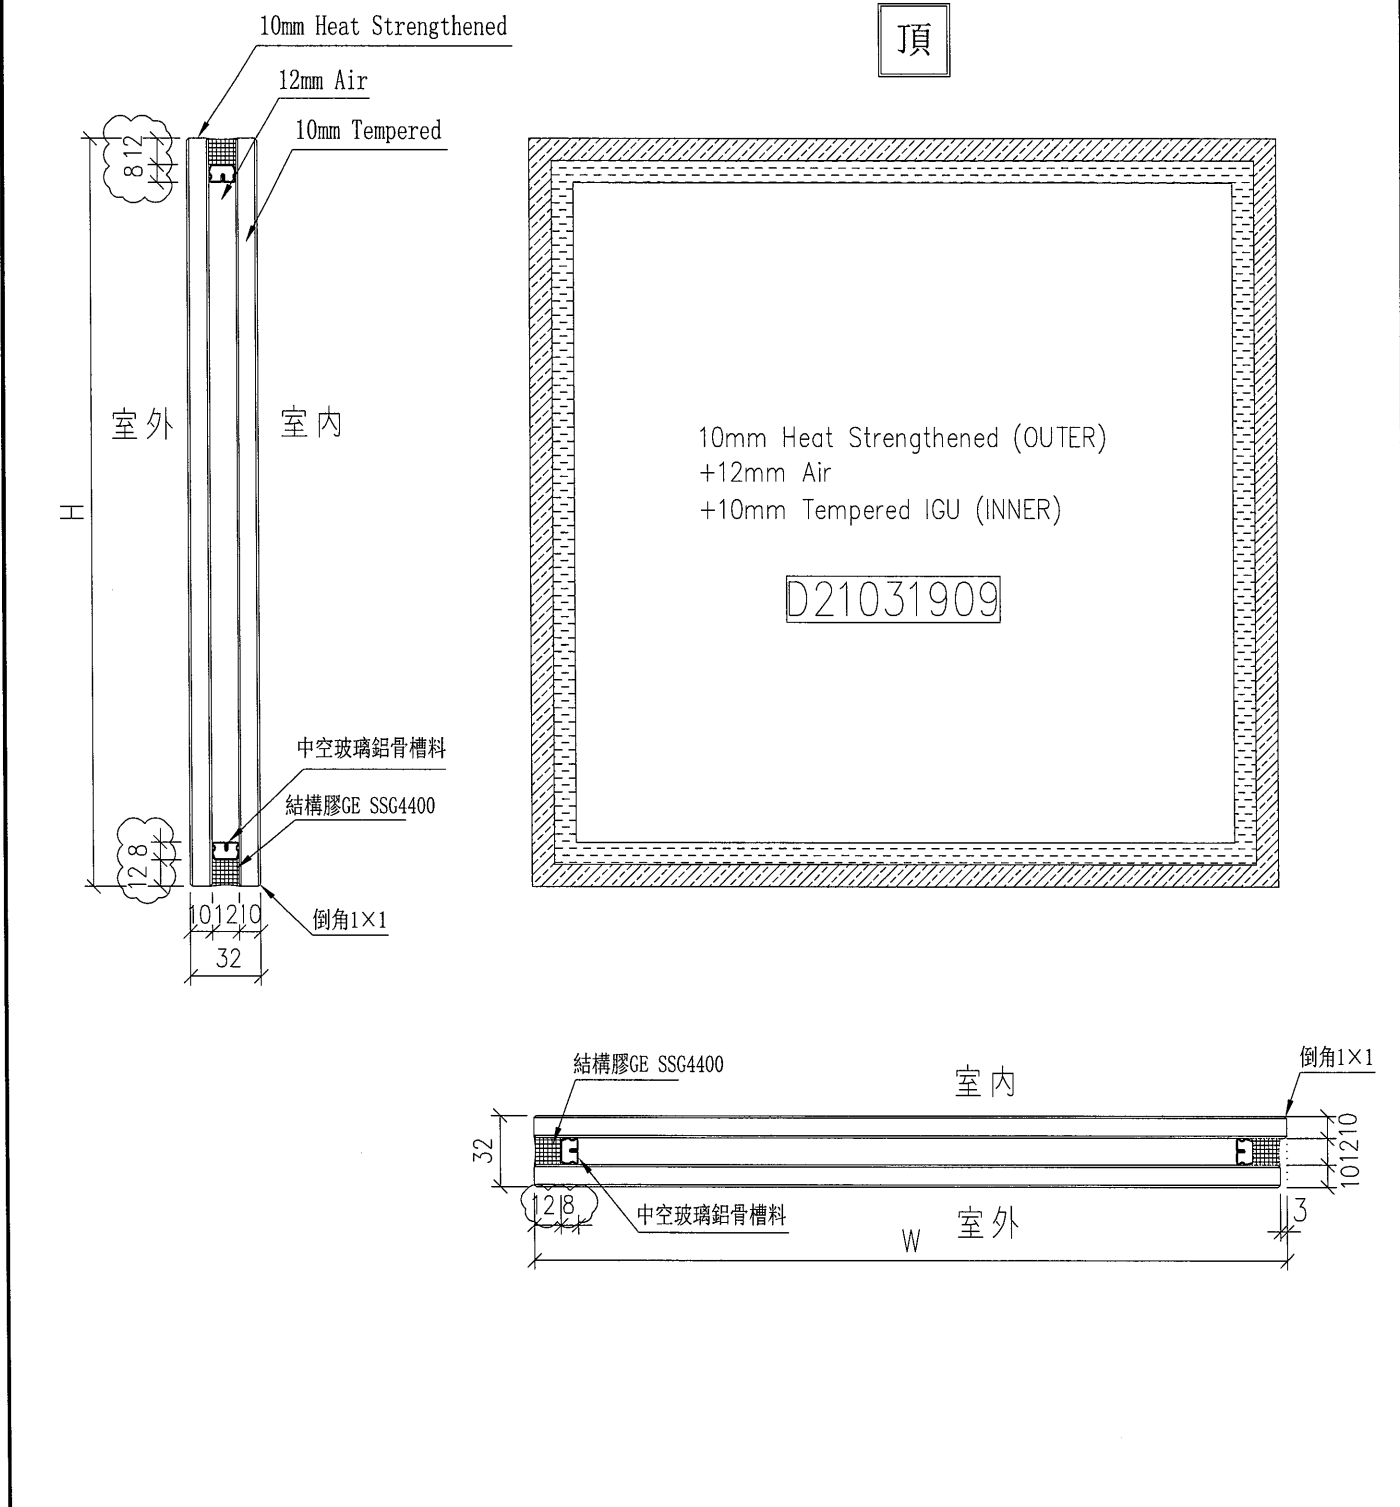


工程號	J-853	地盤	九龍延坪道	附件
名稱	玻璃加工圖 (生窗轉角玻璃)		採用	
材料			地盤	
顏色	10mm FDNB0-54T#2+12A+10mm Clear		工廠	

 美特鋁質有限公司 MIDI Aluminium Fabricator Ltd.				類別	物料號			
修改				制圖	謝曉云	2021.11.19	圖號	G2
日期				復核	謝永林	2021.11.22	數量	見BOM表
				批准			位置	見BOM表




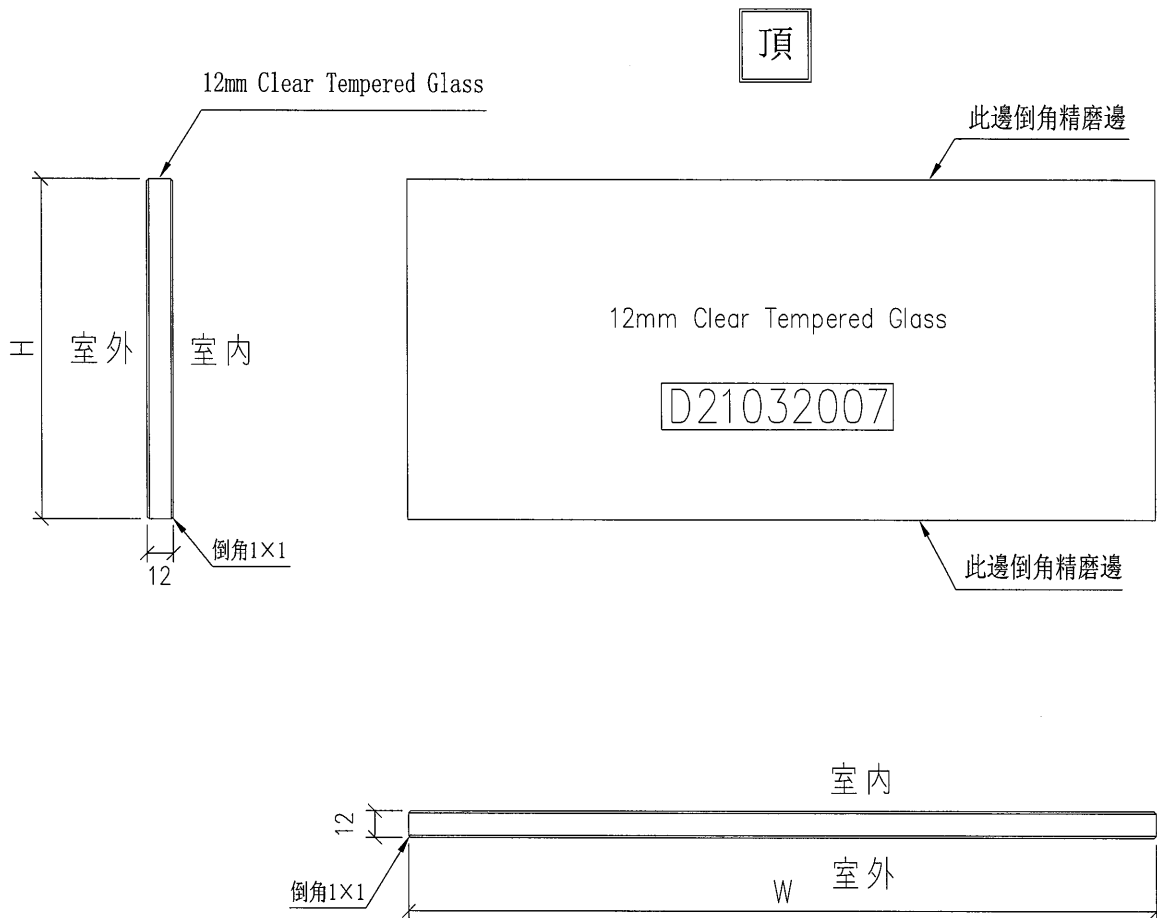
工程號	J-853	地盤	九龍延坪道	附 件
名稱	玻璃加工圖 (生窗玻璃)		採用	
材料			地盤	
顏色	10mm FDNB0-54T#2+12A+10mm Clear		工廠	

 美特鋁質有限公司 MIDI Aluminium Fabricator Ltd.				類別	物料號			
				制圖	謝曉云	2021.11.19	圖號	G4
修改				復核	謝永林	2021.11.22	數量	見BOM表
日期				批准			位置	見BOM表

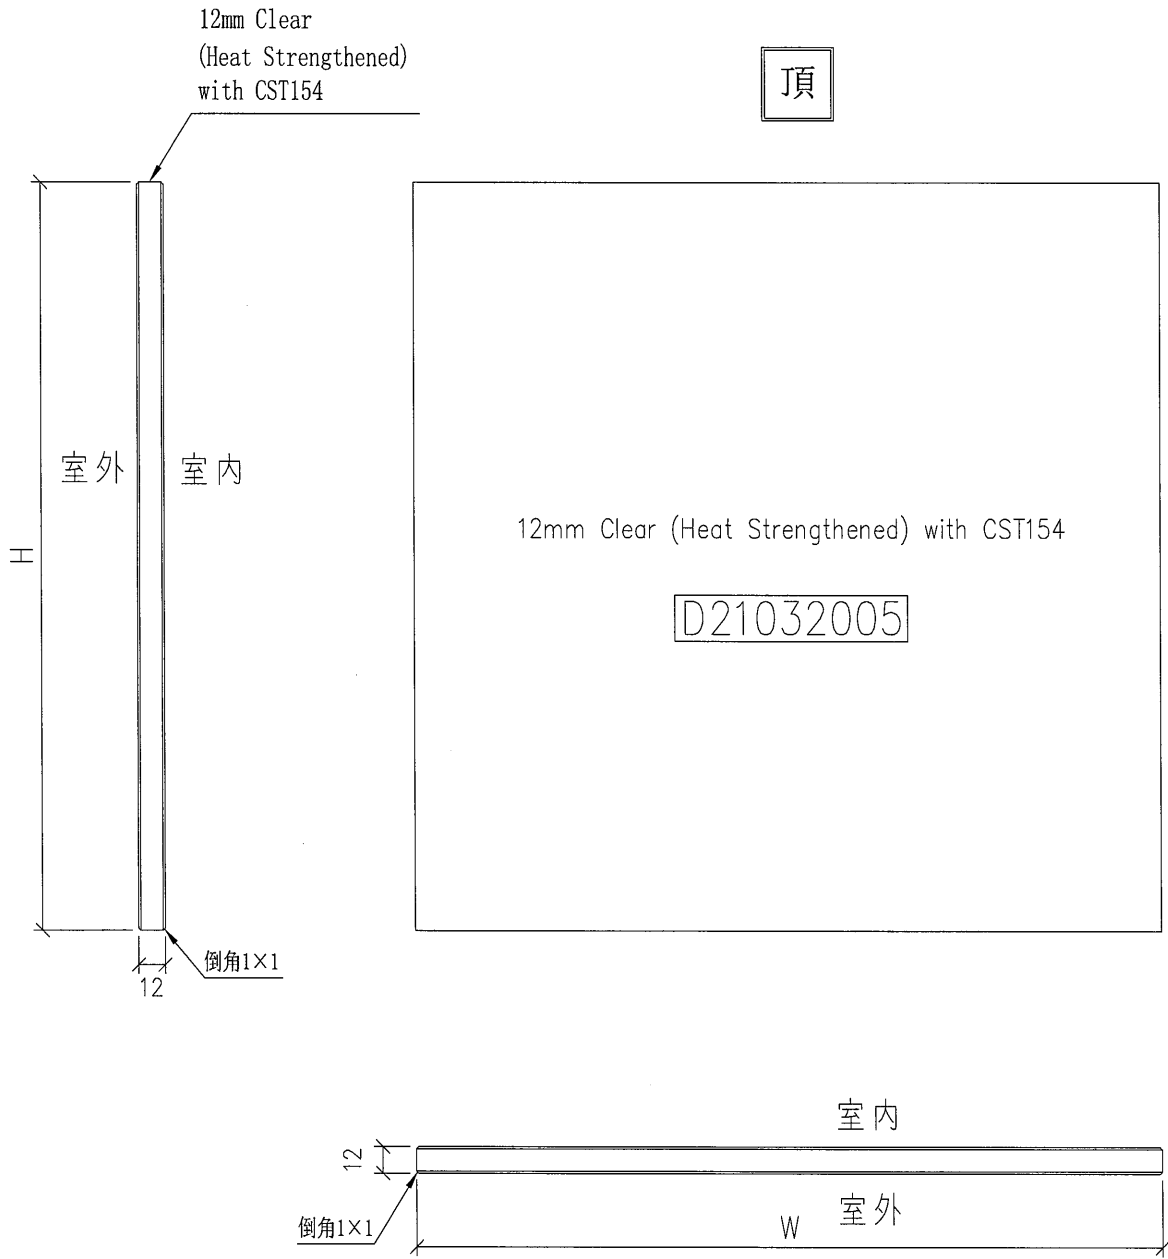


工程號	J-853	地盤	九龍延坪道	附件
名稱	玻璃加工圖 (背板位玻璃)		採用	
材料			地盤	
顏色	12mm Clear #2 SSC-50T		工廠	

 美特鋁質有限公司 MIDI Aluminium Fabricator Ltd.				類別		物料號		
修改				制圖	謝曉云	2021.11.19	圖號	G5
日期				復核	謝永林	2021.11.22	數量	見BOM表
				批准			位置	見BOM表



工程號	J-853	地盤	九龍延坪道	附 件
名稱	玻璃加工圖 (攔河玻璃)		採用	
材料		地盤		
顏色	12mm Clear	工廠		

8

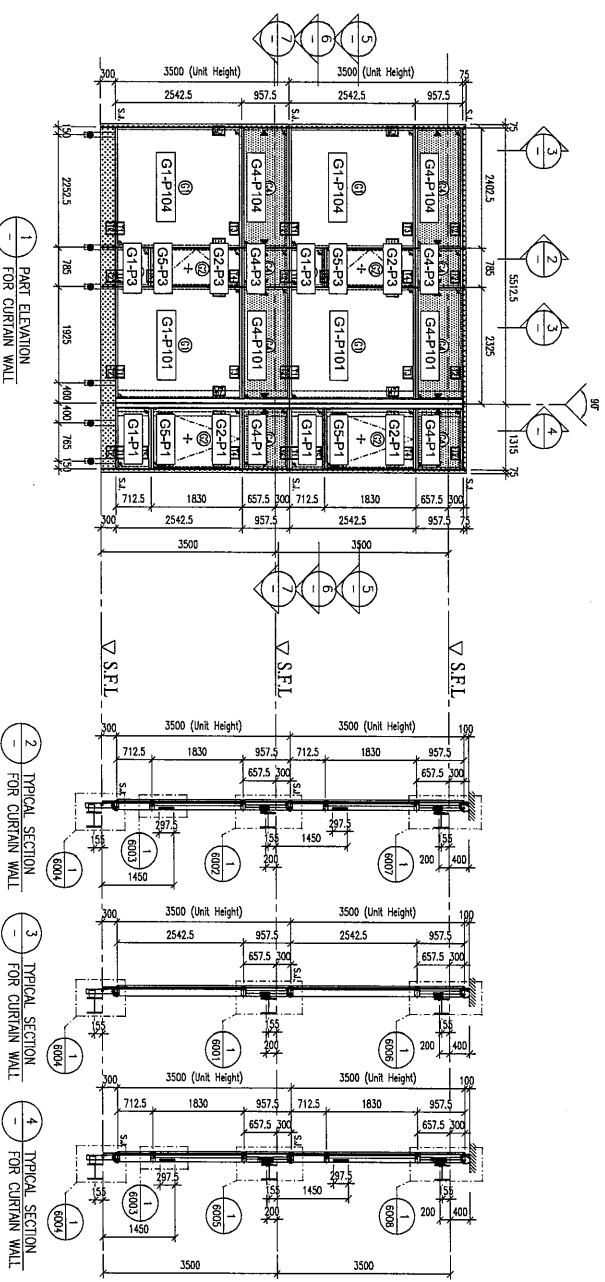

TEST CHAMBER 1

- LEGEND:**
- ① 10mm HEAT STRENGTHENED GLASS (OUTER)
 - ② 10mm HEAT STRENGTHENED GLASS (INNER)
 - ③ 10mm HEAT STRENGTHENED GLASS (OUTER CLEAR GLASS (INNER))
 - ④ 10mm HEAT STRENGTHENED GLASS (OUTER CLEAR GLASS (INNER))
 - ⑤ 12mm THK. HEAT STRENGTHENED GLASS (INNER)
 - ⑥ 12mm THK. CLEAR TEMPERED GLASS (SPANDREL GLASS)
 - ⑦ 3mm THK. ALUM. CLADDING
 - S.L. STICK ONIT (WIND LOAD)
 - ALUM. EXTRUSION DE. NO. (INTERNAL PROTECTIVE BARBER)
 - ALUM. EXTRUSION DE. NO. + 2mm THK. ALUM. BACKGON (SPANDREL GLASS)
 - SUPPORT POINT (WIND LOAD + DEAD LOAD)
 - SUPPORT POINT (WIND LOAD)

PROJECT : PROPOSED RESIDENTIAL DEVELOPMENT AT N.K.I.L. 6542 YIN PING ROAD KOWLOON

TITLE : PART ELEVATION OF PERFORMANCE TEST FOR CURTAIN WALL

DATE : 24-Nov-21 **SCALE :** 1:50 (A1)

DRAWN BY : J.H.R. **CHECKED BY :** -

CLIENT : SHIMAO GROUP HOLDINGS LIMITED

ARCHITECT : WY ARCHITECTS & PLANNERS LIMITED

MAIN CONTRACTOR : 瑞興建築有限公司 C.M. WONG & ASSOCIATES LTD HIP HING CONSTRUCTION CO. LTD

STRUCTURAL ENGINEER : C.M. WONG & ASSOCIATES LTD 黃志明建築工程師有限公司

FAÇADE CONSULTANT : NEUNHARDT

NOTE :





- ALL DIMENSIONS ARE IN MM.
- ALL DIMENSIONS ARE VIEWED FROM OUTSIDE.
- ALL DIMENSIONS TO BE VERIFIED ON SITE BEFORE FABRICATION.

LEGEND :

- ① DETAIL MARK NO.
- ② REEFER SHEET NO.
- 1. F.F.L. --- FINISHED FLOOR LEVEL
- 2. S.F.L. --- STRUCTURAL FLOOR LEVEL
- 3. --- HANDED DETAIL

UNIT : -

WY ARCHITECTS & PLANNERS LIMITED
 Unit 6-B, Sunny Industrial Centre, 1/F
 503, 504, 505, 999, 1000

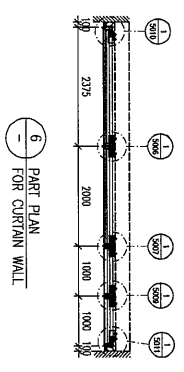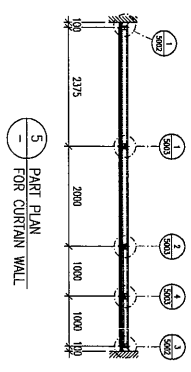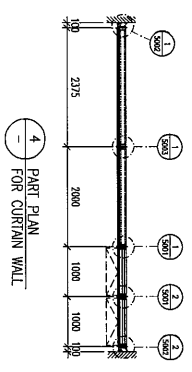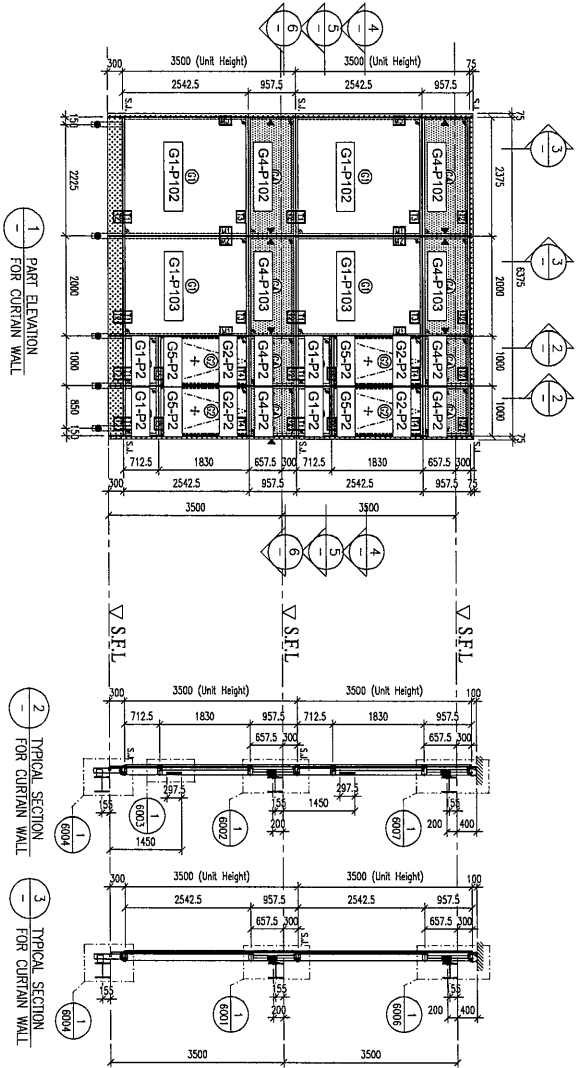

TEST CHAMBER 2

LEGEND:

- ① 10mm HEAT STRENGTHENED GLASS (OUTER CLEAR GLASS (INNER))
- ② 10mm HEAT STRENGTHENED GLASS (INNER CLEAR GLASS (OUTER))
- ③ 12mm THK. HEAT STRENGTHENED GLASS & 2mm THK. ALUM. BACKING (SPANDREL GLASS) (INTERNAL PROTECTIVE BARRIER)
- ④ 3mm THK. ALUM. CLADDING
- S.L. - STACK JOINT (WIND LOAD)
- ▲ - ALUM. EXTENSION DIE NO.
- ▲ - SUPPORT POINT (WIND LOAD + DEAD LOAD)
- - SUPPORT POINT (WIND LOAD)

NOTE:

1. ALL DIMENSIONS ARE IN mm.
2. ALL ELEVATIONS ARE VIEWED FROM OUTSIDE BEFORE FABRICATION.
3. ALL DIMENSIONS TO BE VERIFIED ON SITE.

LEGEND:

- ① - DETAIL MARK NO.
- ② - REFER SHEET NO.
- 1. F.F.L. - FINISHED FLOOR LEVEL
- 2. S.F.L. - STRUCTURAL FLOOR LEVEL
- 3. ④ - HANDED DIMENSION

PROJECT: PROPOSED RESIDENTIAL DEVELOPMENT AT NAKIL, 6542 TAN FANG ROAD, KOWLOON

TITLE: PART ELEVATION OF PERFORMANCE TEST FOR CURTAIN WALL

DATE: 24-Nov-21 **SCALE:** 1:50 (A1)

DRAWN BY: LHR **CHECKED BY:** -

CLIENT: SHIMAO GROUP HOLDINGS LIMITED

MAIN CONTRACTOR: 協興建築有限公司
HP HING CONSTRUCTION CO LTD

STRUCTURAL ENGINEER: C M WONG & ASSOCIATES LTD
黃志剛建築工程師有限公司

ARCHITECT: WY WING TUNG ARCHITECTS LIMITED

FAÇADE CONSULTANT: MENHARDT

DATE: 24-Nov-21 **SCALE:** 1:50 (A1)

DRAWN BY: LHR **CHECKED BY:** -

PROJECT: PROPOSED RESIDENTIAL DEVELOPMENT AT NAKIL, 6542 TAN FANG ROAD, KOWLOON

TITLE: PART ELEVATION OF PERFORMANCE TEST FOR CURTAIN WALL

DATE: 24-Nov-21 **SCALE:** 1:50 (A1)

DRAWN BY: LHR **CHECKED BY:** -

CLIENT: SHIMAO GROUP HOLDINGS LIMITED

MAIN CONTRACTOR: 協興建築有限公司
HP HING CONSTRUCTION CO LTD

STRUCTURAL ENGINEER: C M WONG & ASSOCIATES LTD
黃志剛建築工程師有限公司

ARCHITECT: WY WING TUNG ARCHITECTS LIMITED

FAÇADE CONSULTANT: MENHARDT

DATE: 24-Nov-21 **SCALE:** 1:50 (A1)

DRAWN BY: LHR **CHECKED BY:** -

PROJECT: PROPOSED RESIDENTIAL DEVELOPMENT AT NAKIL, 6542 TAN FANG ROAD, KOWLOON

TITLE: PART ELEVATION OF PERFORMANCE TEST FOR CURTAIN WALL

DATE: 24-Nov-21 **SCALE:** 1:50 (A1)

DRAWN BY: LHR **CHECKED BY:** -

CLIENT: SHIMAO GROUP HOLDINGS LIMITED

MAIN CONTRACTOR: 協興建築有限公司
HP HING CONSTRUCTION CO LTD

STRUCTURAL ENGINEER: C M WONG & ASSOCIATES LTD
黃志剛建築工程師有限公司

ARCHITECT: WY WING TUNG ARCHITECTS LIMITED

FAÇADE CONSULTANT: MENHARDT