

工程指示 / 要求簡箋 ENGINEER INSTRUCTIONS(E.I.)

工程指示編號:	EI- 4308	修改版本:	E
	HK- 1374		
工程編號:	J 853	工程名稱:	大窩坪 (延坪道)
收件人:	Maggie Lor	發件人:	Edwin Ho
工程項目:	T5露臺欄河地盤用鐵件修改	日期:	19/08/2022

☐ 原合約工程包	☐ 原合約工程加 / 減賬 QT-	☐ 新工程報價 QT-
---------------------------------	--	------------------------------------

信件批核號碼/圖紙參考編號:	批核模具圖紙編號:
客戶指示附件:	管理內部批簽署:

☐ 初步鋁料 B.M.	☐ 加工拆圖, 然後生產	☐ 尺寸表
☐ 正式鋁料 B.M.	☐ 技術上資料/指示	☐ 報價
☐ 配件 B.M.	☐ 樣辦或貨品說明書	☐ 分判合約
☐ 其他:		

內容: 煩請依附件資料修改、新增、減少及暫時Hold起T5露台欄河用鐵件。
完成上列要求日期: 16/09/2022

國內

☐ 生產技術總監	☐ 連附件	☐ 技術部	☐ 連附件	☐ 生產部	☐ 連附件
☐ 採購部	☐ 連附件	☒ 生產統籌部	☒ 連附件	☐ 報關組	☐ 連附件
☐ 質檢部	☐ 連附件	☐ 會計部	☐ 連附件	☐ 機械設計部	☐ 連附件
☒ 香港辦	☒ 連附件	☐ 其他:			

☐ 行政部	☐ 連附件	☐ 會計部	☐ 連附件	☐ 統籌部	☐ 連附件	☒ 工程部	☒ 連附件
☐ 採購部	☐ 連附件	☐ QS部	☐ 連附件	☐ 地盤管理	☐ 連附件	☐ 維修部	☐ 連附件

*發件人簽署: Edwin Ho	*組別成員批核簽署:
傳遞編號:	項目經理簽署:

①

美特鋁質有限公司 MIDI Aluminium Fabricator Ltd.				工程號： J853		計算：		CJM	日期：	12/1/2022	送呈：		
BM編號：				地盤名稱：		核對：		實用	後備	總數	單位 件	總重量 KG	備註
				錦上路/延平道		核對：							
項目類別：				T5欄河;UP,BAL地盤用鋼件		修改：						總重量(kg): 30366.8	
序號	修改標示	配件圖號	物料編號	配件名稱	顏色	實用	後備	總數	單位	單件重量	總重量	備註	
1		51-M01-GMU01	51-M01-GMU01	80*20*1153mm鋼巴	熱浸鋅	280	14	294	件	14.482	4257.614		
2		51-M01-GMU02	51-M01-GMU02	80*20*1153mm鋼巴	熱浸鋅	128	7	135	件	14.482	1955.027		
3		51-M01-GTR01	51-M01-GTR01	80*10*250mm鋼巴	熱浸鋅	10	0	10	件	1.570	15.700		
4		51-M01-GTR02	51-M01-GTR02	80*10*1330mm鋼巴	熱浸鋅	10	0	10	件	8.352	83.524		
5			52-M01-GTR02	80*10*1330mm鋼巴	熱浸鋅	7	0	7	件	8.352	58.467		
6			53-M01-GTR02	80*10*1280mm鋼巴	熱浸鋅	9	0	9	件	8.038	72.346		
7			56-M01-GTR02	80*10*1280mm鋼巴	熱浸鋅	13	0	13	件	8.038	104.499		
8		51-M01-GTR03	51-M01-GTR03	80*10*915mm鋼巴	熱浸鋅	10	0	10	件	5.746	57.462		
9			54-M01-GTR03	80*10*1000mm鋼巴	熱浸鋅	11	0	11	件	6.280	69.080		
10		52-M01-GTR01	52-M01-GTR01	80*10*945mm鋼巴	熱浸鋅	7	0	7	件	5.935	41.542		
11			53-M01-GTR01	80*10*915mm鋼巴	熱浸鋅	9	0	9	件	5.746	51.716		
12			55-M01-GTR01	80*10*490mm鋼巴	熱浸鋅	13	0	13	件	3.077	40.004		
13			56-M01-GTR01	80*10*940mm鋼巴	熱浸鋅	13	0	13	件	5.903	76.742		
14		52-M01-GTR03	52-M01-GTR03	80*10*250mm鋼巴	熱浸鋅	7	1	8	件	1.570	12.560		
15			53-M01-GTR03	80*10*230mm鋼巴	熱浸鋅	9	1	10	件	1.444	14.444		
16			56-M01-GTR03	80*10*250mm鋼巴	熱浸鋅	13	1	14	件	1.570	21.980		
17			54-M01-GTR01	80*10*365mm鋼巴	熱浸鋅	11	0	11	件	2.292	25.214		
18		54-M01-GTR02	54-M01-GTR02	80*10*1230mm鋼巴	熱浸鋅	11	0	11	件	7.724	84.968		
19		55-M01-GTR02	55-M01-GTR02	80*10*1383.6mm鋼巴	熱浸鋅	13	0	13	件	8.689	112.957		
20		55-M01-GTR03	55-M01-GTR03	80*10*344.1mm鋼巴	熱浸鋅	13	0	13	件	2.161	28.092		
21		51-N01-GTR01	51-N01-GTR01	40*40*4mm角鋼	熱浸鋅	10	0	10	件	4.825	48.246		
22			54-N01-GTR01	40*40*4mm角鋼	熱浸鋅	11	0	11	件	2.916	32.077		

2

美特鋁質有限公司 MIDI Aluminium Fabricator Ltd.			工程號： 地盤名稱：		J853 錦上路/延平道	計算： 核對：	CJM	日期：	12/1/2022	送呈： 副本：		
BM編號：			項目類別：		T5欄河;UP,BAL地盤用鋼件			修改：	總重量(kg): 30366.8			
序號	修改標示	配件圖號	物料編號	配件名稱	顏色	實用	後備	總數	單位 件	單件重量 KG	總重量	備註
23		51-N01-GTR02	51-N01-GTR02	40*40*4mm角鋼	熱浸鋅	10	0	10	件	3.657	36.572	
24			52-N01-GTR02	40*40*4mm角鋼	熱浸鋅	7	0	7	件	3.657	25.601	
25			53-N01-GTR02	40*40*4mm角鋼	熱浸鋅	10	0	10	件	3.536	35.361	
26			54-N01-GTR02	40*40*4mm角鋼	熱浸鋅	11	0	11	件	3.536	38.897	
27			56-N01-GTR02	40*40*4mm角鋼	熱浸鋅	13	0	13	件	3.415	44.395	
28		51-N01-GTR03	51-N01-GTR03	40*40*4mm角鋼	熱浸鋅	10	0	10	件	2.458	24.583	
29			54-N01-GTR03	40*40*4mm角鋼	熱浸鋅	11	0	11	件	2.616	28.773	
30		52-N01-GTR01	52-N01-GTR01	40*40*4mm角鋼	熱浸鋅	7	1	8	件	2.458	19.667	
31			53-N01-GTR01	40*40*4mm角鋼	熱浸鋅	10	1	11	件	2.531	27.841	
32			55-N01-GTR01	40*40*4mm角鋼	熱浸鋅	13	0	13	件	1.429	18.577	
33		52-N01-GTR03	56-N01-GTR01	40*40*4mm角鋼	熱浸鋅	13	3	16	件	2.519	40.302	
34			52-N01-GTR03	40*40*4mm角鋼	熱浸鋅	7	0	7	件	0.848	5.934	
35			53-N01-GTR03	40*40*4mm角鋼	熱浸鋅	10	0	10	件	0.799	7.993	
36		55-N01-GTR02	56-N01-GTR03	40*40*4mm角鋼	熱浸鋅	13	0	13	件	0.848	11.020	
37			55-N01-GTR02	40*40*4mm角鋼	熱浸鋅	13	0	13	件	3.502	45.529	
38		55-N01-GTR03	55-N01-GTR03	40*40*4mm角鋼	熱浸鋅	13	0	13	件	0.641	8.331	
39			51-P01-GTR01	40*40*4mm角鋼	熱浸鋅	10	0	10	件	4.330	43.301	
40		51-P01-GTR01	54-P01-GTR01	40*40*4mm角鋼	熱浸鋅	11	0	11	件	5.836	64.198	
41			51-P01-GTR02	40*40*4mm角鋼	熱浸鋅	10	0	10	件	18.827	188.265	
42		51-P01-GTR02	52-P01-GTR02	40*40*4mm角鋼	熱浸鋅	7	0	7	件	18.827	131.786	
43			53-P01-GTR02	40*40*4mm角鋼	熱浸鋅	10	0	10	件	18.199	181.990	
44			54-P01-GTR02	40*40*4mm角鋼	熱浸鋅	11	0	11	件	17.571	193.285	

3

美特鋁質有限公司 MIDI Aluminium Fabricator Ltd.			工程號： 地盤名稱：		J853 錦上路/延平道	計算： 核對：	CJM	日期：	12/1/2022	送呈： 副本：		
BM編號：			項目類別：		T5欄河;UP,BAL地盤用鋼件			修改：	總重量(kg): 30366.8			
序號	修改標示	配件圖號	物料編號	配件名稱	顏色	實用	後備	總數	單位	單件重量	總重量	備註
45		51-P01-GTR03	56-P01-GTR02	40*40*4mm角鋼	熱浸鋅	13	0	13	件	18.199	236.586	
46			51-P01-GTR03	125*75*8mm角鋼	熱浸鋅	10	0	10	件	12.677	126.765	
47			54-P01-GTR03	125*75*8mm角鋼	熱浸鋅	11	0	11	件	13.492	148.416	
48		52-P01-GTR01	52-P01-GTR01	125*75*8mm角鋼	熱浸鋅	7	0	7	件	12.677	88.736	
49			53-P01-GTR01	125*75*8mm角鋼	熱浸鋅	10	0	10	件	13.053	130.530	
50			55-P01-GTR01	125*75*8mm角鋼	熱浸鋅	13	0	13	件	7.342	95.450	
51		52-P01-GTR03	56-P01-GTR01	125*75*8mm角鋼	熱浸鋅	13	0	13	件	12.990	168.874	
52			52-P01-GTR03	125*75*8mm角鋼	熱浸鋅	7	2	9	件	4.330	38.971	
53			53-P01-GTR03	125*75*8mm角鋼	熱浸鋅	10	2	12	件	4.079	48.949	
54		55-P01-GTR02	56-P01-GTR03	125*75*8mm角鋼	熱浸鋅	13	2	15	件	4.330	64.951	
55			55-P01-GTR02	125*75*8mm角鋼	熱浸鋅	13	2	15	件	18.109	271.629	
56			55-P01-GTR03	125*75*8mm角鋼	熱浸鋅	13	2	15	件	3.379	50.681	
57		51-BA01-GMU01	51-BA01-GMU01	100*40*989mm鋼巴	熱浸鋅	167	8	175	件	31.369	5489.505	
58			51-BA01-GMU02	100*40*989mm鋼巴	熱浸鋅	167	8	175	件	31.369	5489.505	
59			51-BA01-GMU03	100*40*989mm鋼巴	熱浸鋅	28	1	29	件	31.369	909.689	
60		51-BA01-GTR01	51-BA01-GTR01	100*15鋼巴	熱浸鋅	10	0	10	件	16.862	168.618	
61			52-BA01-GTR01	100*15鋼巴	熱浸鋅	8	0	8	件	6.794	54.353	
62			53-BA01-GTR01	100*15鋼巴	熱浸鋅	10	0	10	件	7.866	78.657	
63		51-BA01-GTR02	54-BA01-GTR01	100*15鋼巴	熱浸鋅	8	0	8	件	15.814	126.511	
64			51-BA01-GTR02	100*15鋼巴	熱浸鋅	10	0	10	件	28.678	286.780	
65			53-BA01-GTR02	100*15鋼巴	熱浸鋅	10	0	10	件	21.902	219.015	
66			55-BA01-GTR02	100*15鋼巴	熱浸鋅	4	0	4	件	28.672	114.689	

4

美特鋁質有限公司 MIDI Aluminium Fabricator Ltd.			工程號： J853		計算： 核對：		CJM	日期：	12/1/2022	送呈： 副本：		
BM編號：			地盤名稱：		錦上路/延平道		項目類別：		T5欄河;UP,BAL地盤用鋼件		修改：	總重量(kg): 30366.8
序號	修改標示	配件圖號	物料編號	配件名稱	顏色	實用	後備	總數	單位	單件重量	總重量	備註
67		51-BA01-GTR03	51-BA01-GTR03	100*15鋼巴	熱浸鋅	10	0	10	件	10.774	107.741	
68			52-BA01-GTR03	100*15鋼巴	熱浸鋅	8	0	8	件	6.794	54.353	
69			53-BA01-GTR03	100*15鋼巴	熱浸鋅	10	0	10	件	16.874	168.736	
70			55-BA01-GTR03	100*15鋼巴	熱浸鋅	4	0	4	件	16.874	67.494	
71			56-BA01-GTR02	100*15鋼巴	熱浸鋅	4	0	4	件	8.737	34.948	
72		51-BA01-GTR03	57-BA01-GTR02	100*15鋼巴	熱浸鋅	13	0	13	件	29.814	387.586	
73			57-BA01-GTR03	100*15鋼巴	熱浸鋅	13	0	13	件	29.814	387.586	
74	Hold		52-BA01-GTR02	100*15鋼巴	熱浸鋅	8	0	8	件	87.547	700.377	Hold
75	Hold		54-BA01-GTR02	100*15鋼巴	熱浸鋅	8	0	8	件	47.512	380.097	Hold
76			54-BA01-GTR03	100*15鋼巴	熱浸鋅	8	0	8	件	4.451	35.608	
77		51-BA01-GTR01	55-BA01-GTR01	100*15鋼巴	熱浸鋅	4	0	4	件	4.451	17.804	
78			56-BA01-GTR01	100*15鋼巴	熱浸鋅	4	0	4	件	31.592	126.369	
79			57-BA01-GTR01	100*15鋼巴	熱浸鋅	13	0	13	件	3.156	41.024	
80			57-BA01-GTR01R	100*15鋼巴	熱浸鋅	13	0	13	件	3.156	41.024	
81			51-BB01-GTR01	51-BB01-GTR01	125*75*8mm角鋼	熱浸鋅	10	0	10	件	19.140	191.403
82		52-BB01-GTR01		125*75*8mm角鋼	熱浸鋅	8	0	8	件	8.409	67.273	
83		53-BB01-GTR01		125*75*8mm角鋼	熱浸鋅	10	0	10	件	9.539	95.388	
84		54-BB01-GTR01		125*75*8mm角鋼	熱浸鋅	8	0	8	件	18.011	144.085	
85		55-BB01-GTR01		125*75*8mm角鋼	熱浸鋅	4	0	4	件	5.773	23.094	
86		51-BB01-GTR01	56-BB01-GTR01	125*75*8mm角鋼	熱浸鋅	4	0	4	件	34.829	139.316	
87			57-BB01-GTR01	125*75*8mm角鋼	熱浸鋅	13	0	13	件	4.518	58.739	
88			51-BB01-GTR02	125*75*8mm角鋼	熱浸鋅	10	0	10	件	32.633	326.326	

5

美特鋁質有限公司 MIDI Aluminium Fabricator Ltd.				工程號： J853		計算：		CJM	日期：	12/1/2022	送呈：	
				地盤名稱：		核對：			日期：		副本：	
BM編號：				項目類別：		T5欄河;UP,BAL地盤用鋼件			修改：		總重量(kg): 30366.8	
序號	修改標示	配件圖號	物料編號	配件名稱	顏色	實用	後備	總數	單位	單件重量	總重量	備註
89		51-BB01-GTR02	53-BB01-GTR02	125*75*8mm角鋼	熱浸鋅	10	0	10	件	25.416	254.158	
90			54-BB01-GTR02	125*75*8mm角鋼	熱浸鋅	8	0	8	件	52.714	421.714	
91			55-BB01-GTR02	125*75*8mm角鋼	熱浸鋅	4	0	4	件	33.637	134.547	
92			57-BB01-GTR02	125*75*8mm角鋼	熱浸鋅	13	0	13	件	69.031	897.397	
93		51-BB01-GTR03	51-BB01-GTR03	125*75*8mm角鋼	熱浸鋅	10	0	10	件	9.539	95.388	
94			52-BB01-GTR04	125*75*8mm角鋼	熱浸鋅	8	0	8	件	8.409	67.273	
95			53-BB01-GTR03	125*75*8mm角鋼	熱浸鋅	10	0	10	件	19.140	191.403	
96			54-BB01-GTR03	125*75*8mm角鋼	熱浸鋅	8	0	8	件	5.773	46.188	
97		51-BB01-GTR03	55-BB01-GTR03	125*75*8mm角鋼	熱浸鋅	4	0	4	件	19.140	76.561	
98			56-BB01-GTR02	125*75*8mm角鋼	熱浸鋅	4	0	4	件	10.480	41.920	
99			57-BB01-GTR03	125*75*8mm角鋼	熱浸鋅	13	0	13	件	4.518	58.739	
100			57-BB01-GTR04	125*75*8mm角鋼	熱浸鋅	13	0	13	件	4.518	58.739	
101		52-BB01-GTR03	52-BB01-GTR02	125*75*8mm角鋼	熱浸鋅	8	0	8	件	47.694	381.550	
102			52-BB01-GTR03	125*75*8mm角鋼	熱浸鋅	8	0	8	件	47.694	381.550	
103			GS01-AK01	50*50*6角鋼	熱浸鋅	816	41	857	件	0.210	179.970	
104			GS01-AK02	50*50*5角鋼	熱浸鋅	392	20	412	件	0.300	123.600	
105		GS01-AK03	GS01-AK03	50*50*6角鋼	熱浸鋅	724	37	761	件	0.240	182.640	
106		XX-01	XX-01	50*50*5角鋼	熱浸鋅	25	0	25	件	11.310	282.750	定位用(循環使用)
107												
108												
							總計	3822	件		30366.8	

[illegible][illegible]

7




美特鋁質 有限公司
MIDI Aluminium Fabricator Ltd.

工程號

J-853

地盤

錦上路/延平道

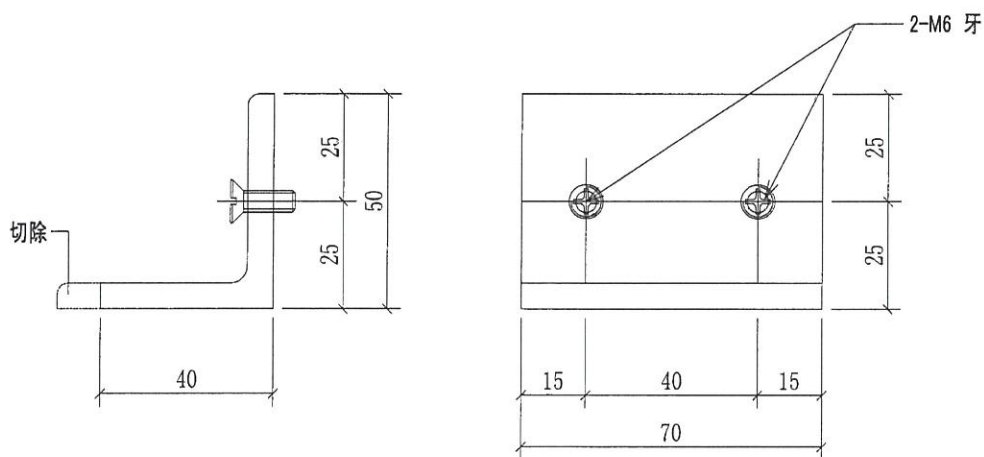

序號	物料編號	數量	使用位置	樓層
01	GS01-AK01	108	UP-4501	T5/(6/F-16/F)
02	GS01-AK01	84	UP-4502	T5/(17F-23/F)
03	GS01-AK01	108	UP-4503	T5/(6/F-16/F)
04	GS01-AK01	56	UP-4504	T5/(11F-16/F)
05	GS01-AK01	98	UP-4504	T5/(17F-23/F)
06	GS01-AK01	182	UP-4505	T5/(11F-26/F)
07	GS01-AK01	156	UP-4506	T5/(11F-26/F)
		792		

名稱	擱河UP用鍍鋅角碼	制圖	CJM	2021.12.22	修改			
材料	50x50x6mm 鍍鋅角鋼(材質:SJ275)	復核	SHUI	2021.12.25	日期			
顏色		批准			圖號	GS01-AK01		

8






美特鋁質 有限公司
MIDI Aluminium Fabricator Ltd.

工程號

J-853

地盤

錦上路/延平道

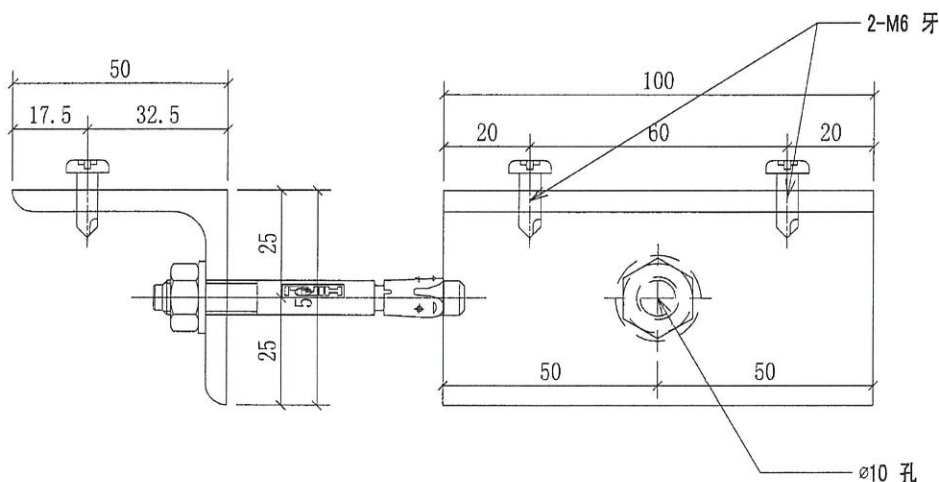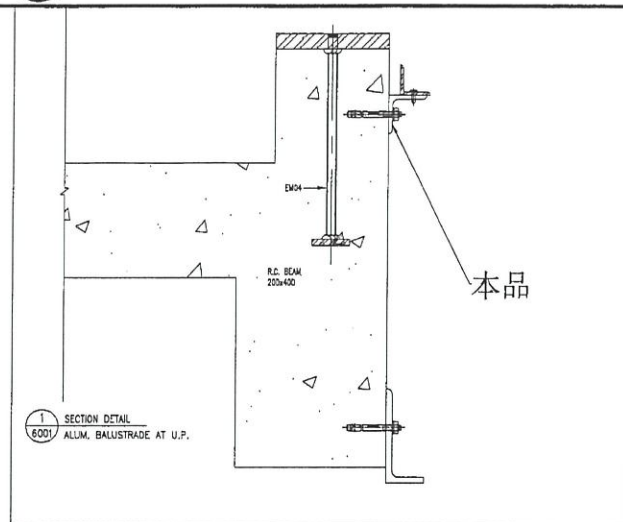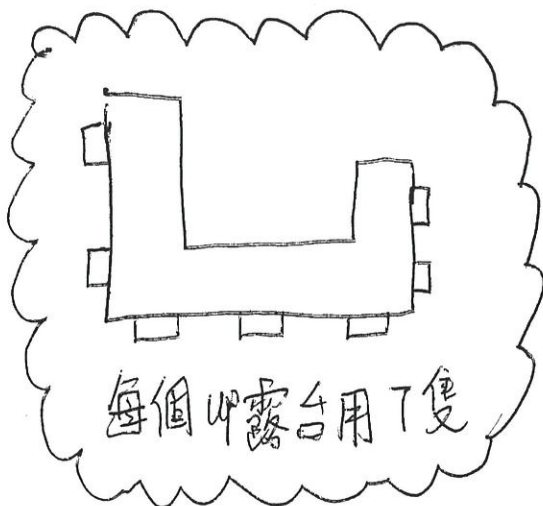

序號	物料編號	數量	使用位置	樓層
01	GS01-AK02	54	UP-4501	T5/(6/F-16/F)
02	GS01-AK02	42	UP-4502	T5/(17F-23/F)
03	GS01-AK02	54	UP-4503	T5/(6/F-16/F)
04	GS01-AK02	24	UP-4504	T5/(11F-16/F)
05	GS01-AK02	42	UP-4504	T5/(17F-23/F)
06	GS01-AK02	78	UP-4505	T5/(11F-26/F)
07	GS01-AK02	78	UP-4506	T5/(11F-26/F)
		372		

名稱	欄河UP用鍍鋅角碼	制圖	CJM	2021.12.22	修改			
材料	50x50x5mm 鍍鋅角鋼(材質:SJ275)	復核	SHUI	2021.12.25	日期			
顏色		批准			圖號	GS01-AK02		



美特鋁質 有限公司

MIDI Aluminium Fabricator Ltd.


工程號

J-853

地盤

錦上路／延平道

廠中

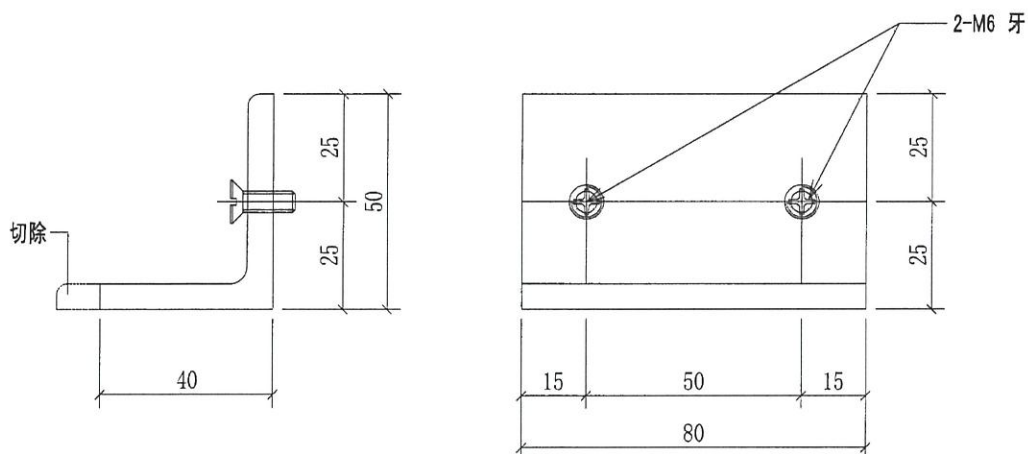




序號	物料編號	數量	使用位置	樓層
01	GS01-AK03	108	BAL-4501	T5/(6/F-16/F)
02	GS01-AK03	128	BAL-4502	T5/(17F-25/F)
03	GS01-AK03	108	BAL-4503	T5/(6/F-16/F)
04	GS01-AK03	112	BAL-4504	T5/(17F-25/F)
05	GS01-AK03	48	BAL-4505	T5/(11F-16/F)
06	GS01-AK03	40	BAL-4506	T5/(11F-16/F)
07	GS01-AK03	156	BAL-4507	T5/(11F-26/F)
		765		

名稱	攔河BAL用鍍鋅角碼	制圖	CJM	2021.12.22	修改			
材料	50x50x6mm 鍍鋅角鋼(材質: SJ275)	復核	SHUI	2021.12.25	日期			
顏色		批準			圖號	GS01-AK03		



美特鋁質 有限公司
MIDI Aluminium Fabricator Ltd.

工程號	J-853	地盤	錦上路/延平道
-----	-------	----	---------

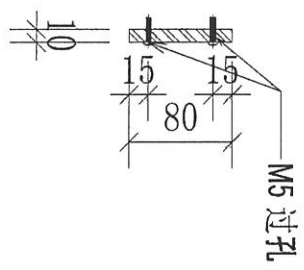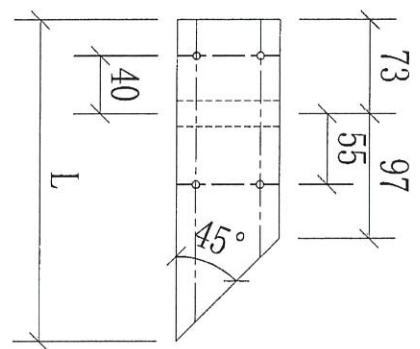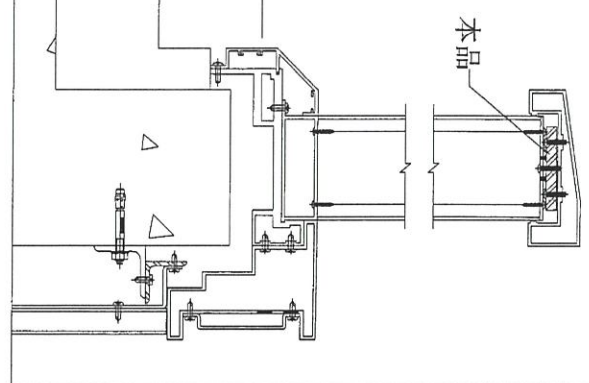

序號	物料編號	數量	L:	L1:	M:	A:	使用位置	樓層
01	51-M01-GTR01	10	250	✓			UP-4501	T5/(5/F-15/F)

名稱	擱河UP銅橫樑(扁巴)	制圖	CJM	2021.12.22	修改			
材料	80x10mm 鍍鋅鋼巴(材質:SJ275)	復核	SHUI	2021.12.25	日期			
顏色		批准			圖號	51-M01-GTR01		

13





美特鋁質 有限公司
MIDI Aluminium Fabricator Ltd.

工程號

J-853

地盤

錦上路/延平道

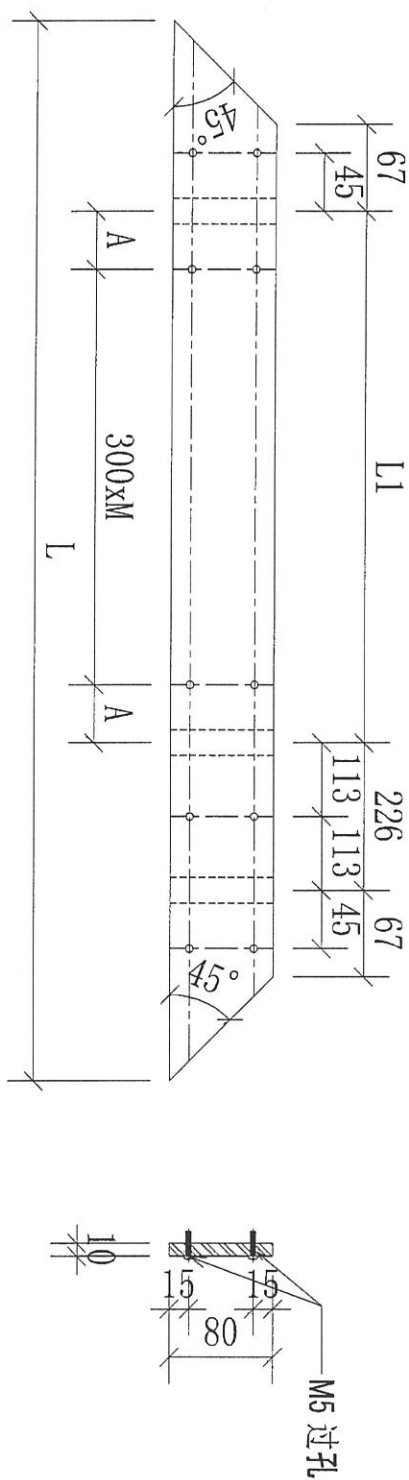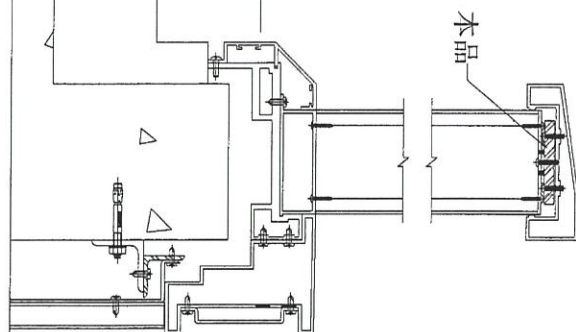



序號	物料編號	數量	L:	L1:	M:	A:	使用位置	樓層
01	51-M01-GTR02	9	1330	810	2	105	UP-4501	T5/(7/F-16/F)
02	52-M01-GTR02	7	1330	810	2	105	UP-4502	T5/(17F-23/F)
03	53-M01-GTR02	9	1280	740	2	70	UP-4503	T5/(7/F-16/F)
04	56-M01-GTR02	13	1280	740	2	70	UP-4503	T5/(11F-26/F)

名稱	擱河UP 鋁橫樑 (扁巴)	制圖	CJM	2021.12.22	修改		
材料	80x10mm 鍍鋅鋼巴 (材質: SJ275)	復核	SHUI	2021.12.25	日期		
顏色		批准			圖號	51-M01-GTR02	



美特鋁質 有限公司
MIDI Aluminium Fabricator Ltd.

工程號 J-853 地盤 錦上路/延平道

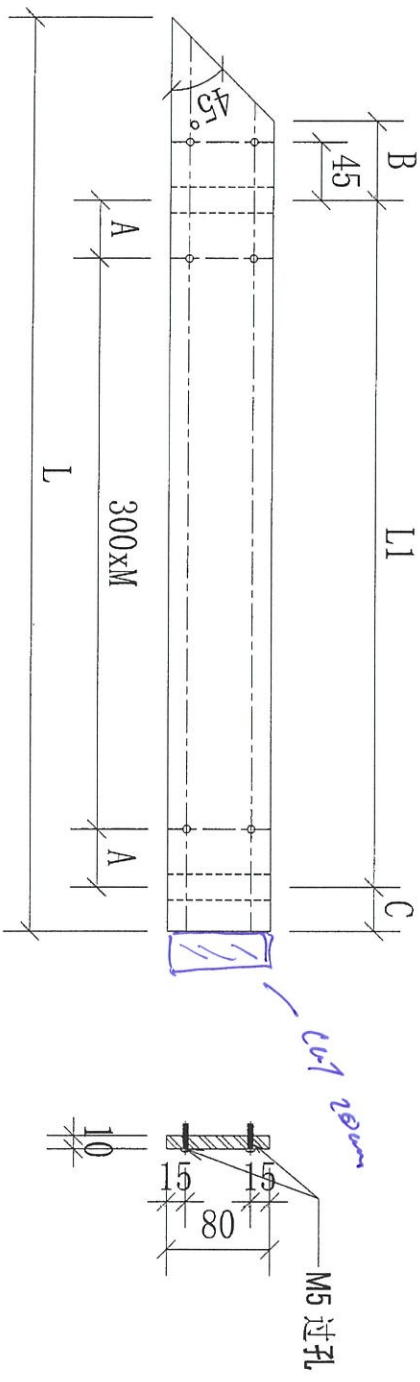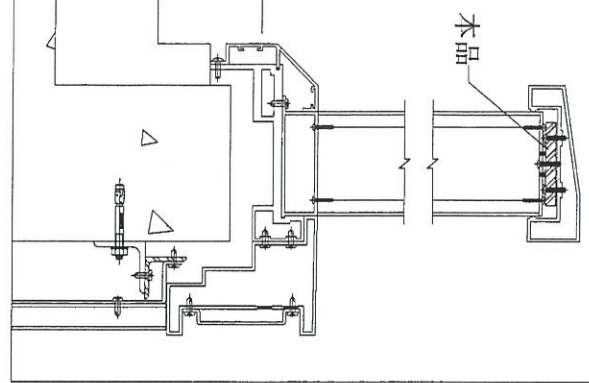

序號	物料編號	數量	L:	L1:	M:	N:	A:	B:	C:	使用位置	樓層
01	51-M01-GTR03	4	915	740	300	2	70	61	34	UP-4501	T5/(5/F-16/F)
02	54-M01-GTR03	4	1000	775	300	2	87.5	68	52	UP-4504	T5/(6/F-16/F)
03	54-M01-GTR03	7	1000	775	300	2	87.5	68	52	UP-4504	T5/(17F-23/F)

名稱	擱河UP 鋼橫樑(扁巴)	制圖	CJM	2021.12.22	修改		
材料	80x10mm 鍍鋅鋼巴(材質: SJ275)	復核	SHUI	2021.12.25	日期		
顏色		批准			圖號	51-M01-GTR03	



錦上路／延平道



9/12/2020




名稱	攔河UP鋼橫梁(扁巴)	制圖	CJM	2021.12.22	修改			
材料	80x10mm 鍍鋅鋼巴(材質: SJ275)	復核	SHUI	2021.12.25	日期			
顏色		批准			圖號	52-M01-GTR01		

16



美特鋁質 有限公司
MIDI Aluminium Fabricator Ltd.

工程號 J-853 地盤 錦上路/延平道

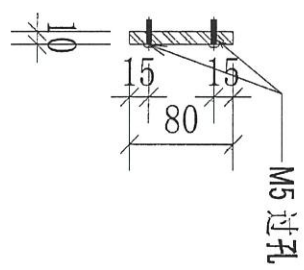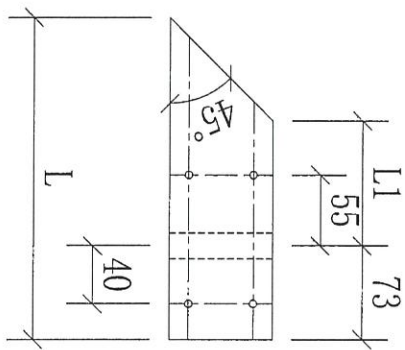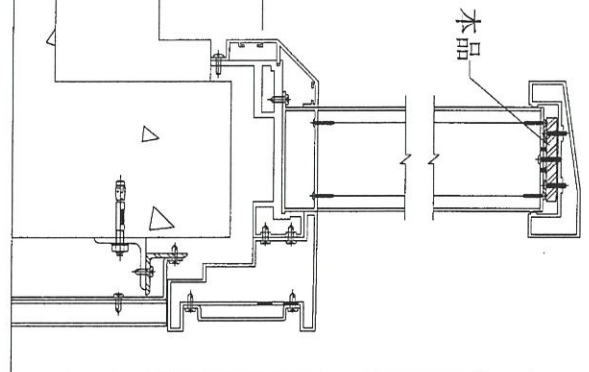




序號	物料編號	數量	L:	L1:	M:	A:	使用位置	樓層
01	52-M01-GTR03	7	250	97			UP-4502	T5/(17F-23/F)
02	53-M01-GTR03	10	230	77			UP-4503	T5/(5/F-16/F)
03	56-M01-GTR03	13	250	97			UP-4506	T5/(11/F-26/F)

名稱	欄河UP鋼橫樑(扁巴)	制圖	CJM	2021.12.22	修改		
材料	80x10mm 鍍鋅鋼巴(材質: SJ275)	復核	SHUI	2021.12.25	日期		
顏色		批准			圖號	52-M01-GTR03	



美特鋁質 有限公司
MIDI Aluminium Fabricator Ltd.

工程號	J-853	地盤	錦上路/延平道
-----	-------	----	---------

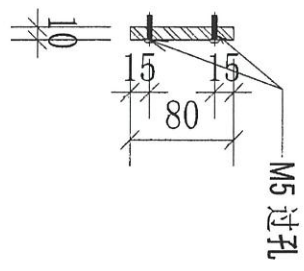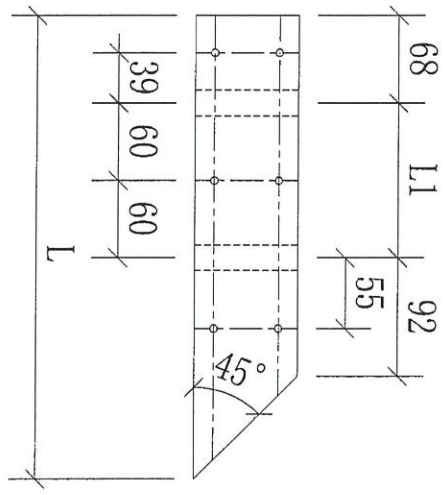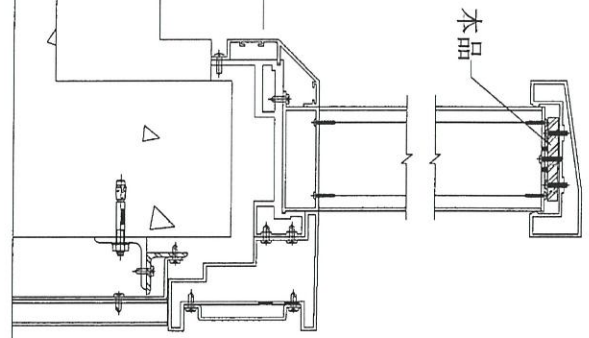



序號	物料編號	數量	L:	L1:	M:	A:	使用位置	樓層
01	54-M01-GTR01	4	365	120			UP-4504	T5/(11F-16/F)
02	54-M01-GTR01	7	365	120			UP-4504	T5/(17F-23/F)

名稱	欄河UP 鋁橫樑 (扁巴)	制圖	CJM	2021.12.22	修改			
材料	80x10mm 鍍鋅鋼巴 (材質: SJ275)	復核	SHUI	2021.12.25	日期			
顏色		批准			圖號	54-M01-GTR01		



美特鋁質 有限公司
MIDI Aluminium Fabricator Ltd.

工程號	J-853	地盤	錦上路/延平道
-----	-------	----	---------

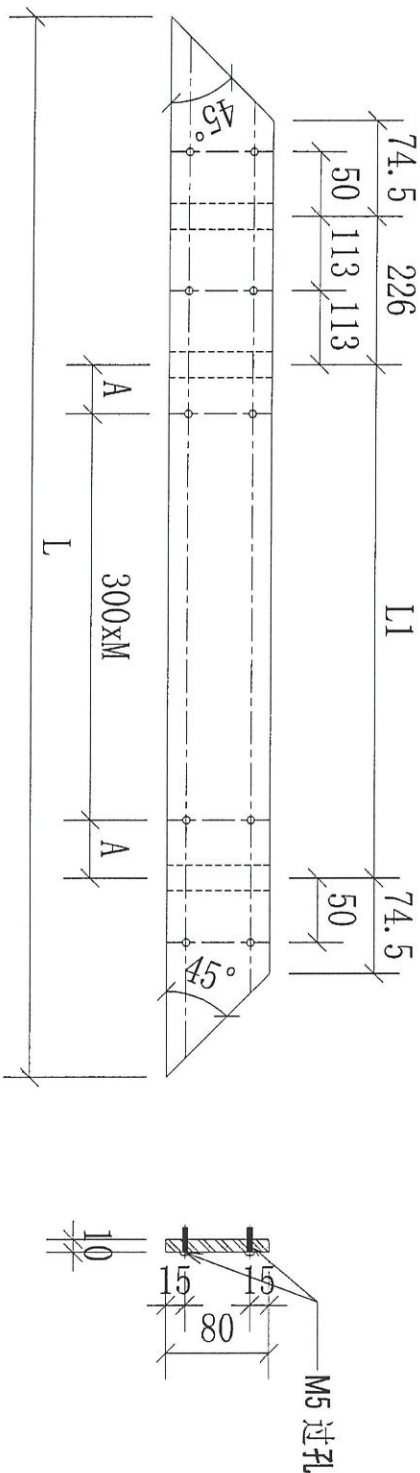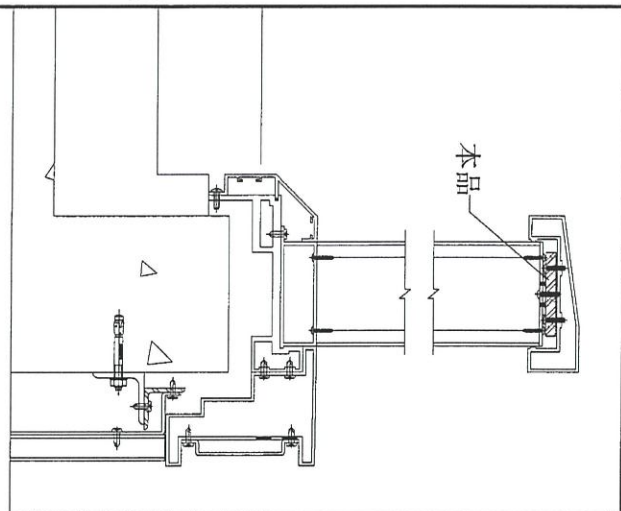

序號	物料編號	數量	L:	L1:	M:	A:	使用位置	樓層
01	54-M01-GTR02	4	1230	695	2	47.5	UP-4504	T5/(11/F-16/F)
02	54-M01-GTR02	7	1230	695	2	47.5	UP-4504	T5/(17F-23/F)




名稱	擱河UP 鋁橫樑(扁巴)	制圖	CJM	2021.12.22	修改			
材料	80x10mm 鍍鋅鋼巴(材質: SJ275)	復核	SHUI	2021.12.25	日期			
顏色		批準			圖號	54-M01-GTR02		

19



美特鋁質 有限公司
MIDI Aluminium Fabricator Ltd.

工程號	J-853	地盤	錦上路/延平道
-----	-------	----	---------

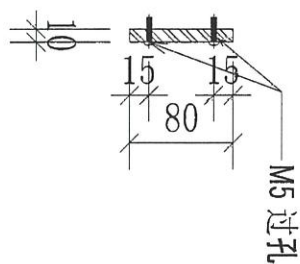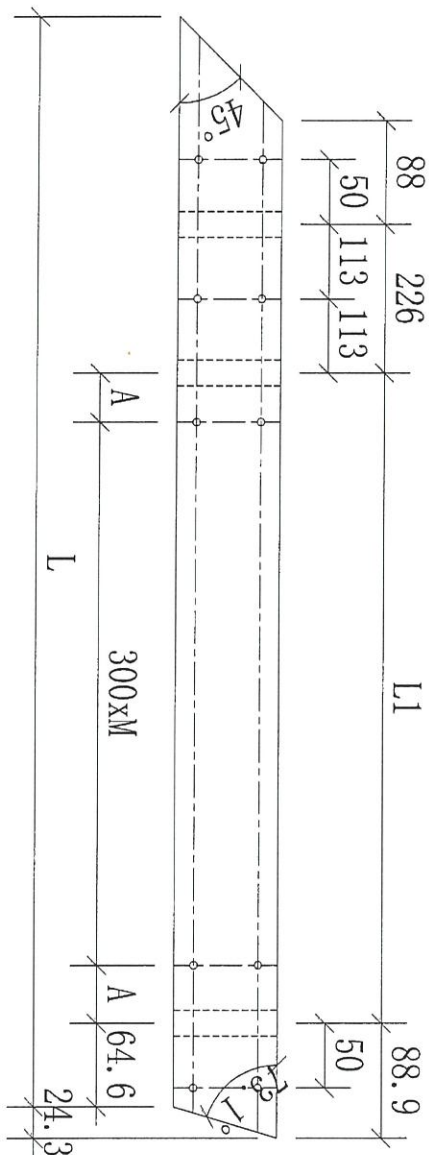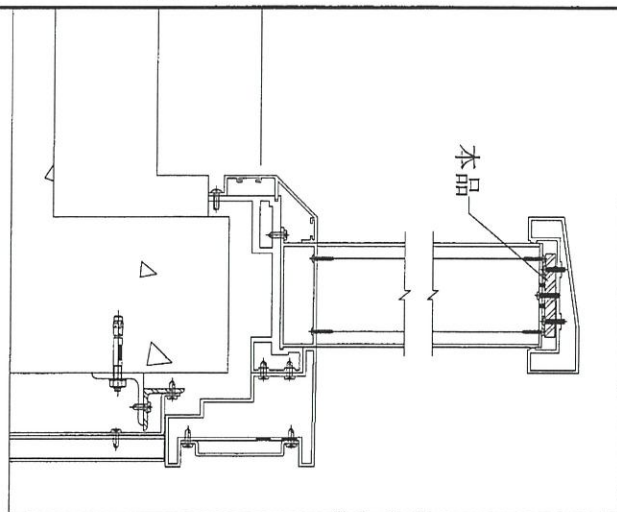




序號	物料編號	數量	L:	L1:	M:	A:	使用位置	樓層
01	55-M01-GTR02	13	1383.6	925	2	162.5	UP-4505	T5/(11/F-26/F)

名稱	擲河UP 銅橫樑(扁巴)	制圖	CJM	2021.12.22	修改			
材料	80x10mm 鍍鋅鋼巴 (材質: SJ275)	復核	SHUI	2021.12.25	日期			
顏色		批准			圖號	55-M01-GTR02		



美特鋁質 有限公司
MIDI Aluminium Fabricator Ltd.

工程號	J-853	地盤	錦上路/延平道
-----	-------	----	---------

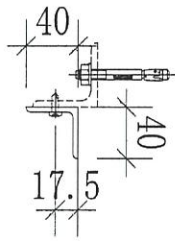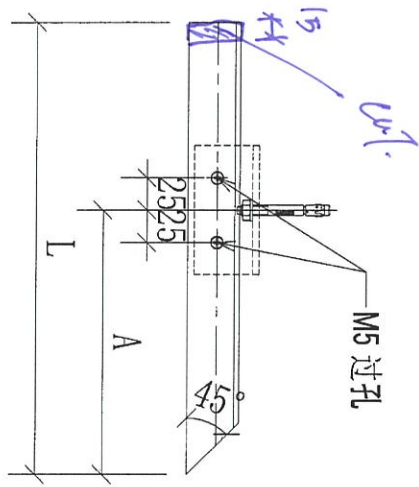
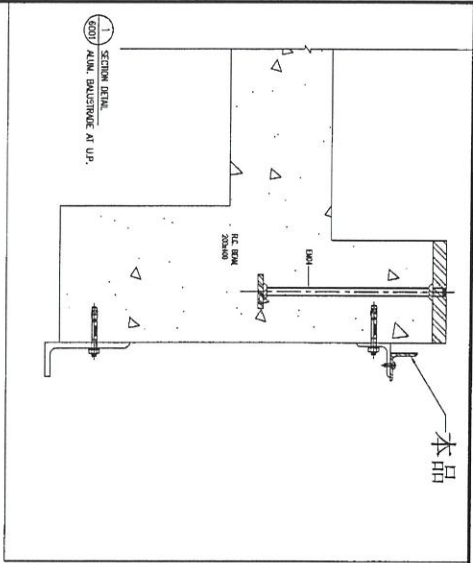


序號	物料編號	數量	L:	L1:	M:	A:	使用位置	樓層
01	51-N01-GTR01	10	350	335		205	UP-4501	T5/(5/F-16/F)
02	54-N01-GTR01	4	460	445		255	UP-4504	T5/(11F-26/F)
03	54-N01-GTR01	7	460	445		255	UP-4504	T5/(17F-23/F)

名稱	欄河UP 鋼橫樑(等邊角鋼)	制圖	CJM	2021.12.22	修改			
材料	40x40x4mm 鍍鋅角鋼(材質:SJ275)	復核	SHUI	2021.12.25	日期			
顏色		批准			圖號	51-N01-GTR01		

美特鋁質 有限公司
MIDI Aluminium Fabricator Ltd.

工程號 J-853 地盤 錦上路/延平道

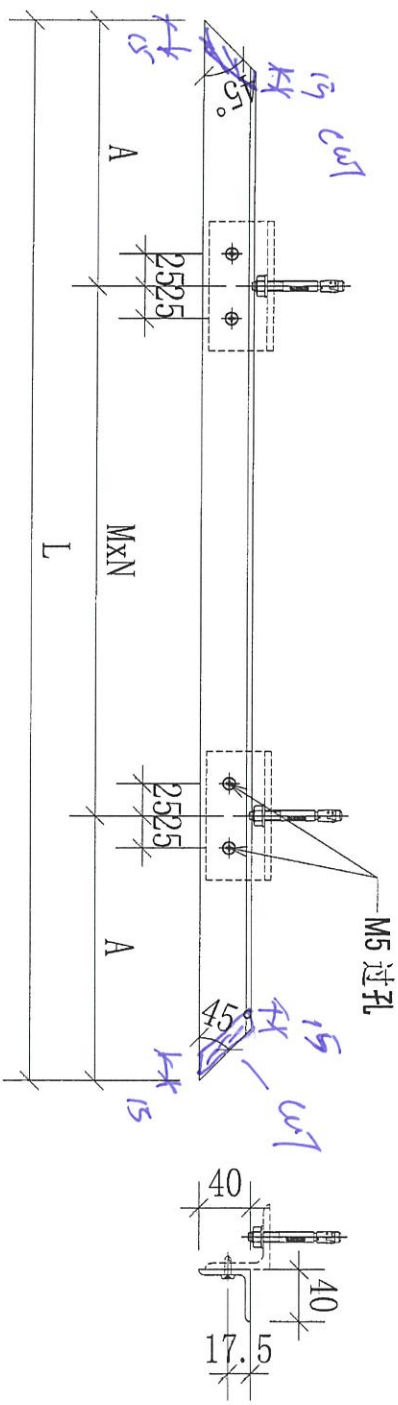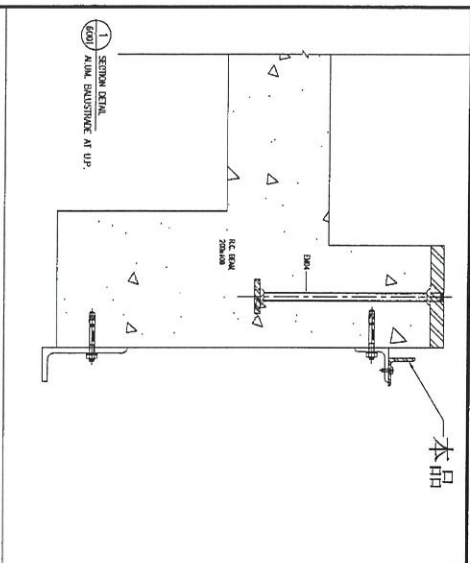




序號	物料編號	數量	L:	L1:	M:	N:	A:	使用位置	樓層
01	51-N01-GTR02	10	1510-30		550	2	205	UP-4501	T5/(5/F-16/F)
02	52-N01-GTR02	7	1510-30		550	2	205	UP-4502	T5/(17F-23/F)
03	53-N01-GTR02	10	1460-30		525	2	205	UP-4503	T5/(5/F-16/F)
04	54-N01-GTR02	4	1410-30		500	2	205	UP-4504	T5/(11F-26/F)
05	54-N01-GTR02	7	1410-30		500	2	205	UP-4504	T5/(17F-23/F)
06	56-N01-GTR02	13	1460-30		525	2	205	UP-4506	T5/(11F-26/F)

名稱	欄河UP鋁橫樑(等邊角鋼)	制圖	CJM	2021.12.22	修改		
材料	40x40x4mm 鍍鋅角鋼(材質: SJ275)	復核	SHUI	2021.12.25	日期		
顏色		批准			圖號	51-N01-GTR02	



美特鋁質 有限公司
MIDI Aluminium Fabricator Ltd.

工程號 J-853 地盤 錦上路/延平道

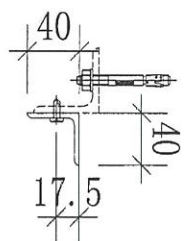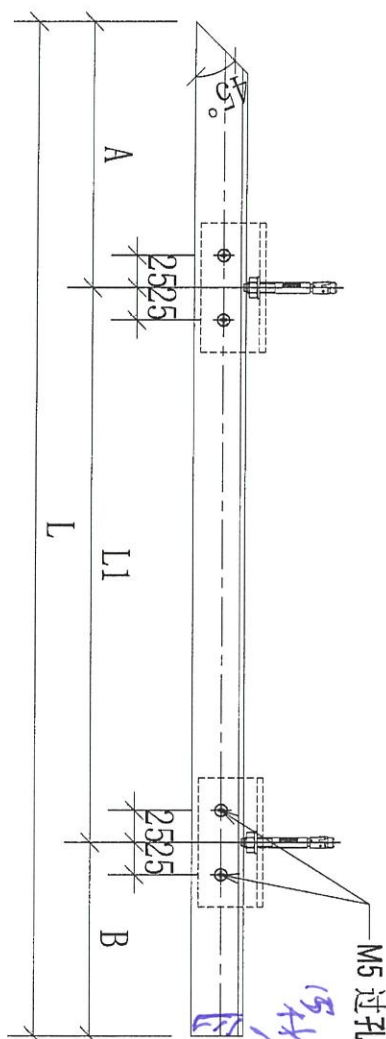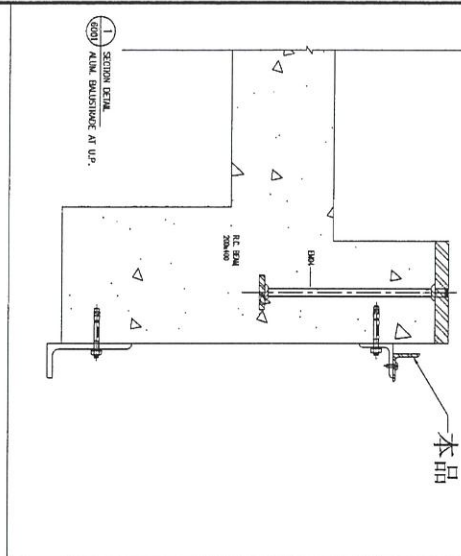

1000
1065
1065



序號	物料編號	數量	L:	L1:	M:	N:	A:	B:	C:	使用位置	樓層
01	51-N01-GTR03	10	1015	660			205	150		UP-4501	T5/(5/F-16/F)
02	54-N01-GTR03	4	1080	675			205	200		UP-4504	T5/(11/F-16/F)
03	54-N01-GTR03	7	1080	675			205	200		UP-4504	T5/(17F-23/F)
		20									

名稱	橫河UP 鋁橫樑 (等邊角鋼)	制圖	CJM	2021.12.22	修改		
材料	40x40x4mm 鍍鋅角鋼 (材質: S275)	復核	SHUI	2021.12.25	日期		
顏色		批準			圖號	51-N01-GTR03	



美特鋁質 有限公司
MIDI Aluminium Fabricator Ltd.

工程號	J-853	地盤	錦上路/延平道
-----	-------	----	---------

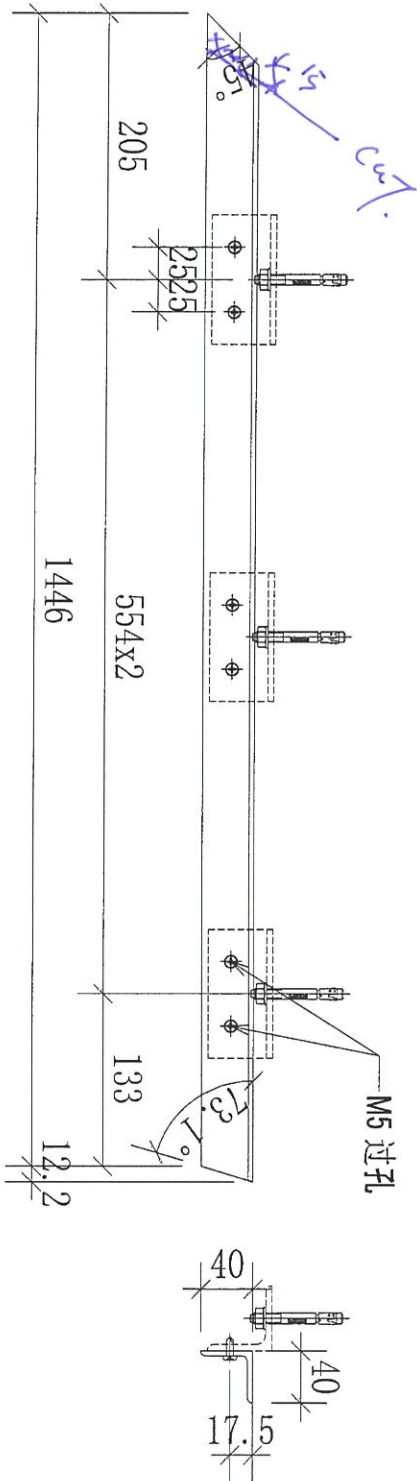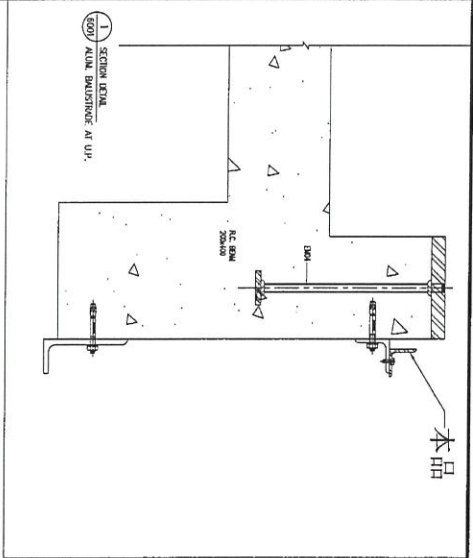

序號	物料編號	數量	L:	M:	A:	使用位置	樓層
01	55-N01-GTR02	13	1446			UP-4505	T5/(11/F-26/F)
02							
03							




名稱	欄河UP 鋼橫樑(等邊角鋼)	制圖	CJM	2021.12.22	修改		
材料	40x40x4mm 鍍鋅角鋼(材質:SJ275)	復核	SHUI	2021.12.25	日期		
顏色		批准			圖號	55-N01-GTR02	

25



美特鋁質 有限公司
MIDI Aluminium Fabricator Ltd.

工程號	J-853	地盤	錦上路/延平道
-----	-------	----	---------

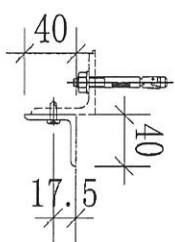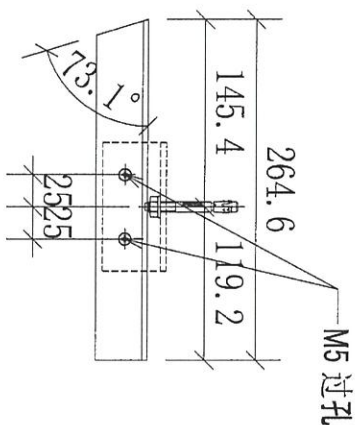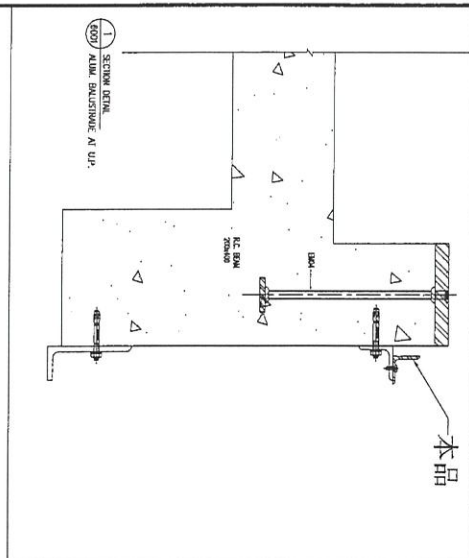

序號	物料編號	數量	L:	M:	A:	使用位置	樓層
01	55-N01-GTR03	13	264.6			UP-4505	T5/(11/F-26/F)
02							
03							

名稱	橫河UP鋼橫樑(等邊角鋼)	制圖	CJM	2021.12.22	修改		
材料	40x40x4mm 鍍鋅角鋼(材質:SU275)	復核	SHUI	2021.12.25	日期		
顏色		批准			圖號	55-N01-GTR03	






美特鋁質 有限公司
MIDI Aluminium Fabricator Ltd.

工程號

J-853

地盤



錦上路/延平道

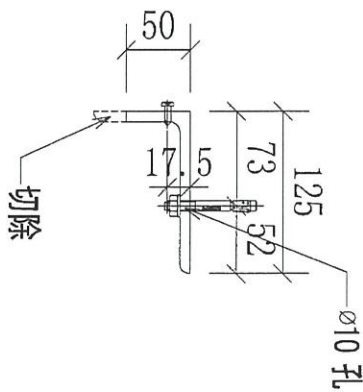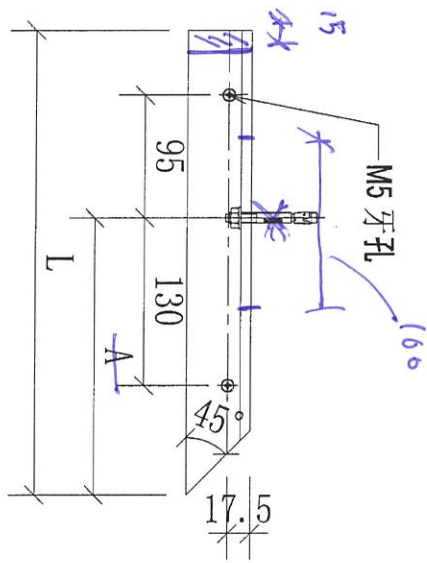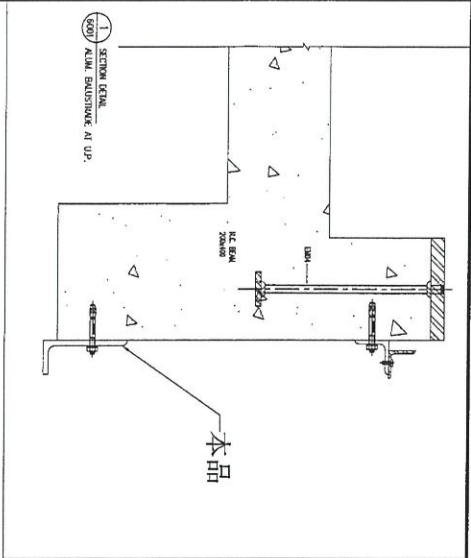


序號	物料編號	數量	L:	L1:	M:	A:	使用位置	樓層
01	51-P01-GTR01	10	345	330		200	UP-4501	T5/(5/F-16/F)
02	54-P01-GTR01	4	465	445		250	UP-4504	T5/(11F-26/F)
03	54-P01-GTR01	7	465			250	UP-4504	T5/(17F-23/F)

名稱	欄河UP 銅黃模(不等邊角鋼)	制圖	CJM	2021.12.22	修改		
材料	125x75x8mm 鍍鋅角鋼(材質: SJ275)	復核	SHUI	2021.12.25	日期		
顏色		批準			圖號	51-P01-GTR01	

28

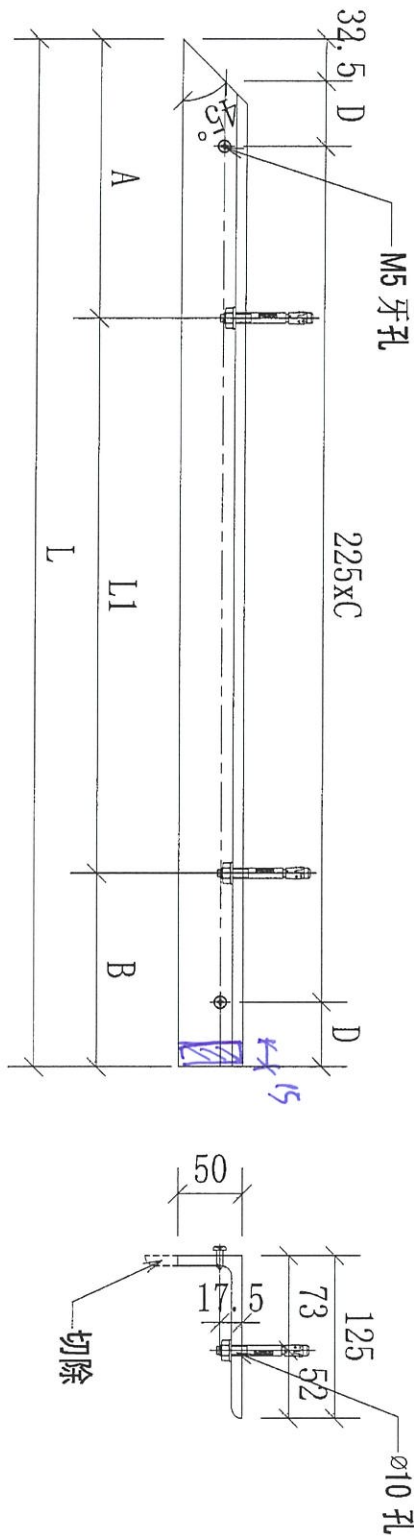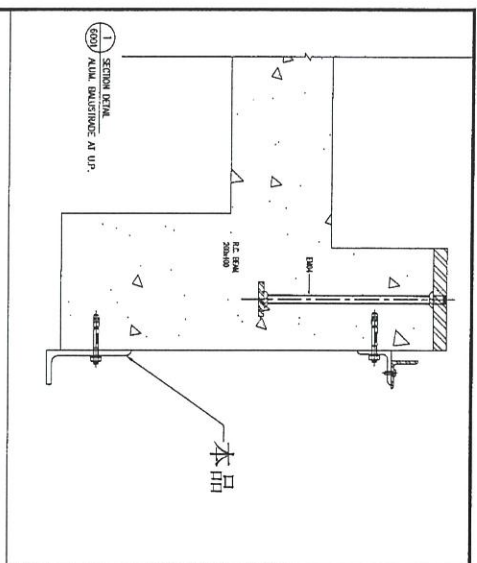

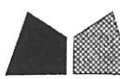 美特鋁質 有限公司 MIDI Aluminium Fabricator Ltd.			
工程號	J-853	地盤	錦上路/延平道

序號	物料編號	數量	L:	L1:	A:	B:	C:	D:	使用位置	樓層
01	51-P01-GTR03	10	1010	660	200	150	4	38.75	UP-4501	T5/(5/F-16/F)
02	54-P01-GTR03	4	1075	675	200	200	4	71.25	UP-4504	T5/(17/F-16/F)
03	54-P01-GTR03	7	1075	675	200	200	4	71.25	UP-4504	T5/(17/F-23/F)

995
1060
1060

135 185 185



名稱	橫河UP 鋼橫樑(不等邊角鋼)	制圖	CJM	2021.12.22	修改		
材料	125x75x8mm 鍍鋅角鋼(材質: SJ275)	復核	SHUI	2021.12.25	日期		
顏色		批准			圖號	51-P01-GTR03	

30



美特鋁質 有限公司
MIDI Aluminium Fabricator Ltd.

工程號 J-853 地盤 錦上路/延平道

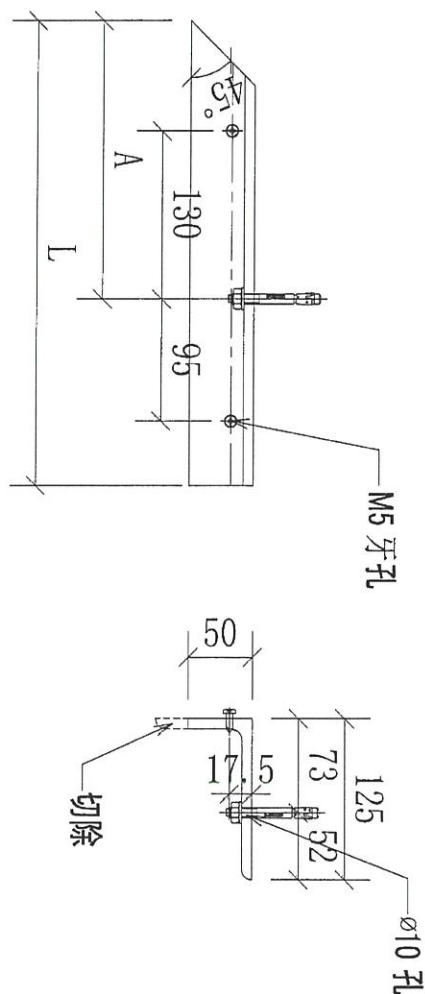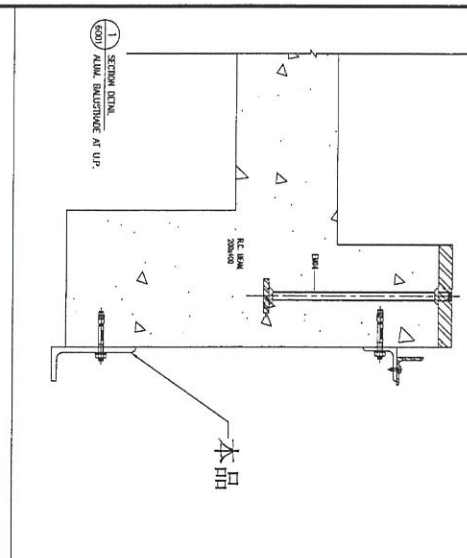

330
310
330

序號	物料編號	數量	L:	L1:	M:	A:	使用位置	樓層
01	52-P01-GTR03	7	345			200	UP-4502	T5/(17F-23/F)
02	53-P01-GTR03	10	325			200	UP-4503	T5/(5/F-16/F)
03	56-P01-GTR03	13	345			200	UP-4506	T5/(11/F-26/F)

名稱	欄河UP鋁橫樑(不等邊角鋼)	制圖	CJM	2021.12.22	修改		
材料	125x75x8mm 鍍鋅角鋼(材質: SJ275)	復核	SHUI	2021.12.25	日期		
顏色		批准			圖號	52-P01-GTR03	





美特鋁質 有限公司
MIDI Aluminium Fabricator Ltd.

工程號

J-853

地盤

錦上路/延平道

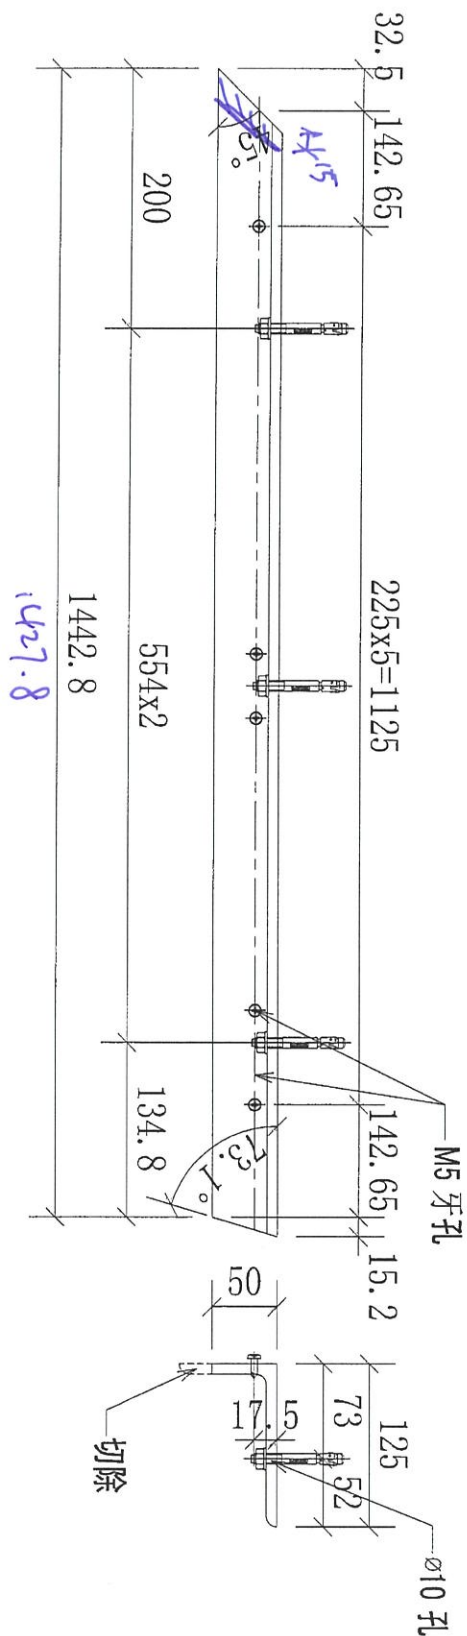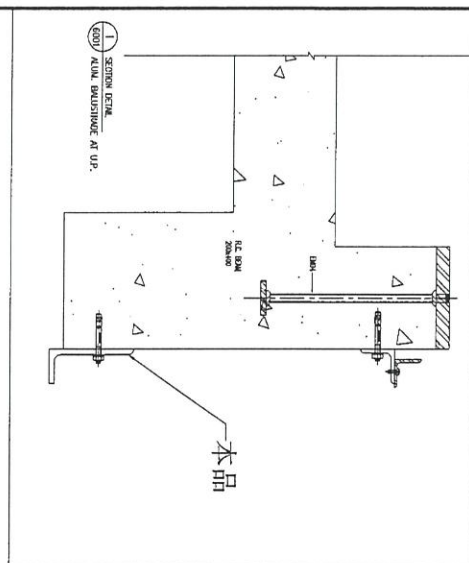



序號	物料編號	數量	L:	M:	A:	使用位置	樓層
01	55-P01-GTR02	13	1442.8			UP-4505	T5/(11/F-26/F)
02							
03							

名稱	攪河UP 鋁橫樑(不等邊角鋼)	制圖	CJM	2021.12.22	修改		
材料	125x75x8mm 鍍鋅角鋼(材質:SU275)	復核	SHUI	2021.12.25	日期		
顏色		批準			圖號	55-P01-GTR02	



美特鋁質 有限公司
MIDI Aluminium Fabricator Ltd.

工程號 J-853 地盤 錦上路/延平道

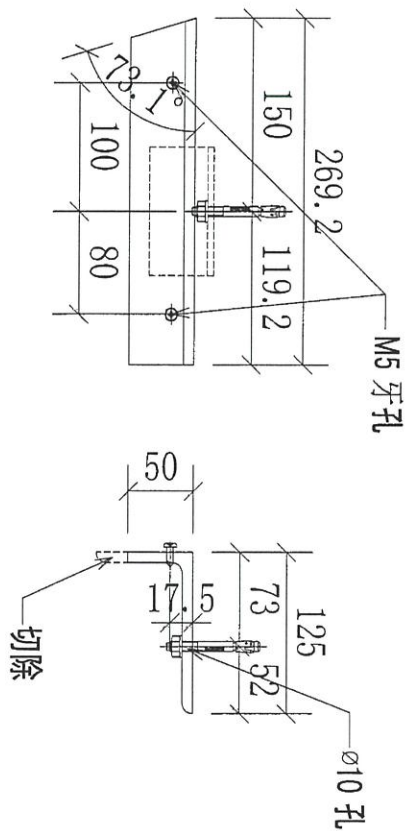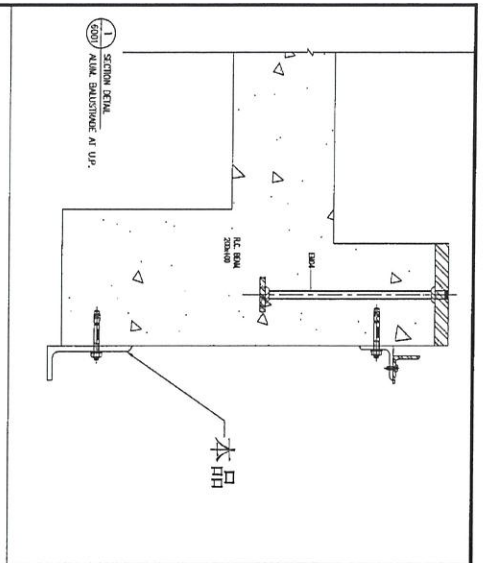



序號	物料編號	數量	L:	M:	A:	使用位置	樓層
01	55-P01-GTR03	13	269.2			UP-4505	T5/(11/F-26/F)
02							
03							

名稱	欄河UP 鋼橫樑(不等邊角鋼)	制圖	CJM	2021.12.22	修改		
材料	125x75x8mm 鍍鋅角鋼(材質: SJ275)	復核	SHUI	2021.12.25	日期		
顏色		批準			圖號	55-P01-GTR03	



美特鋁質 有限公司
MIDI Aluminium Fabricator Ltd.

工程號 J-853 地盤 錦上路/延平道

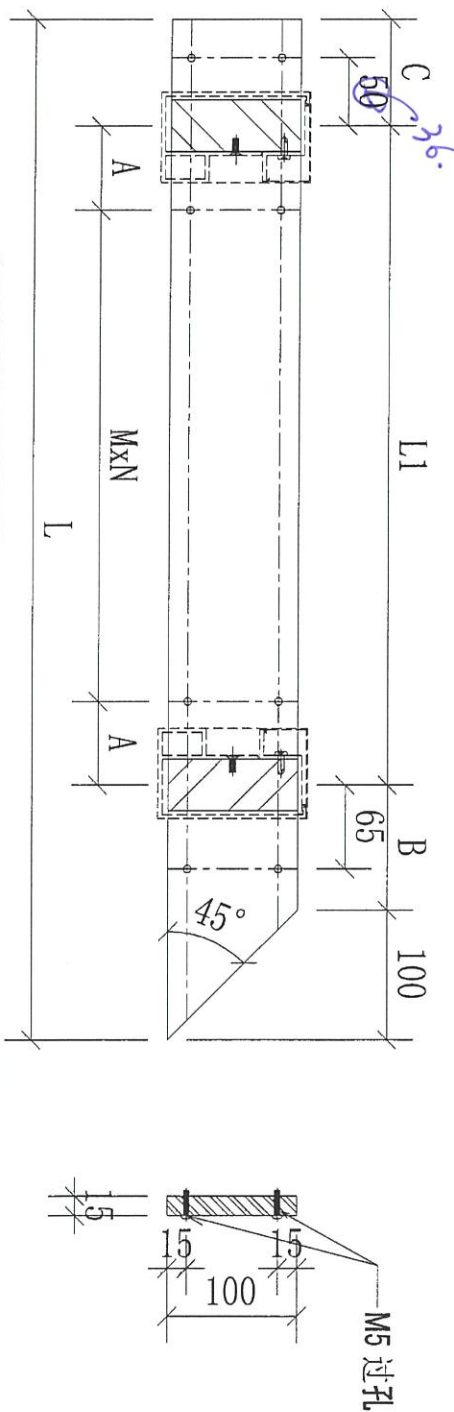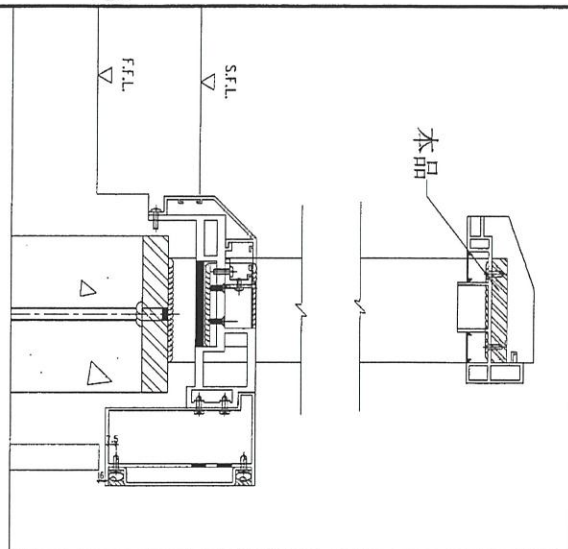



序號	物料編號	數量	L:	L1:	M:	N:	A:	B:	C:	使用位置	樓層
01	51-BA01-GTR01	10	1432	1154	300	3	127	97	81	BAL-5501	T5/(5/F-16/F)
02	52-BA01-GTR01	8	577	299	200	1	49.5	97	81	BAL-5502	T5/(17F-25/F)
03	53-BA01-GTR01	10	668	389	300	1	44.5	97	81	BAL-5503	T5/(5/F-16/F)
04	54-BA01-GTR01	8	1343	1064	300	3	82	97	81	BAL-5504	T5/(17F-25/F)

名稱	橫河BAL 鋼模架(扁巴)	制圖	CJM	2021.12.22	修改		
材料	100x15mm 鍍鋅鋼(材質: SJ275)	復核	SHUI	2021.12.25	日期		
顏色		批準			圖號	51-BA01-GTR01	



美特鋁質 有限公司
MIDI Aluminium Fabricator Ltd.

工程號	J-853	地盤	錦上路/延平道
-----	-------	----	---------

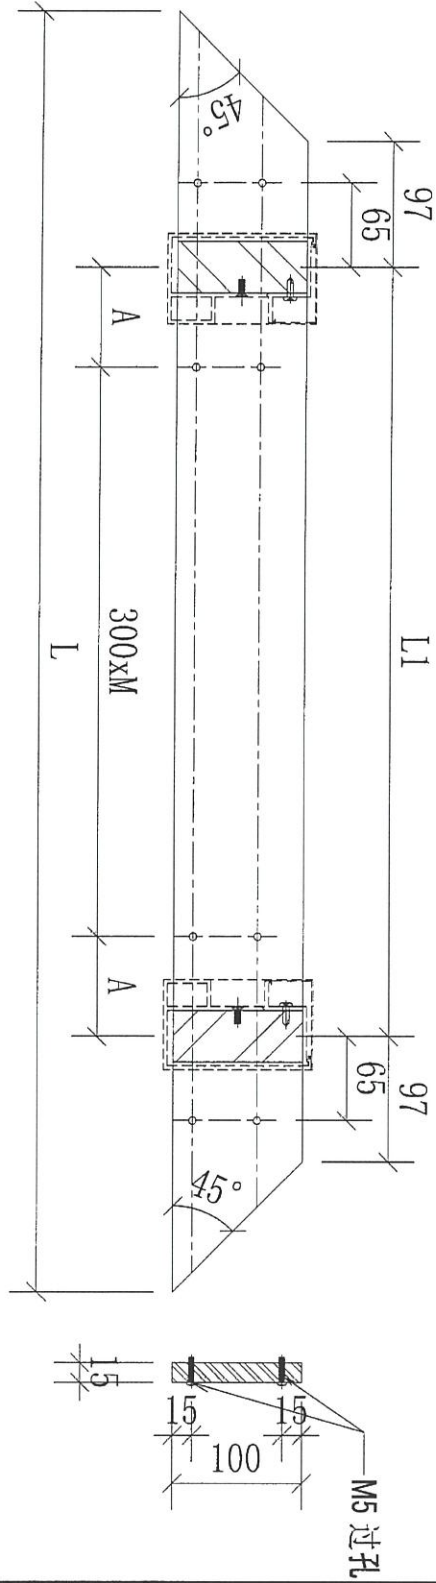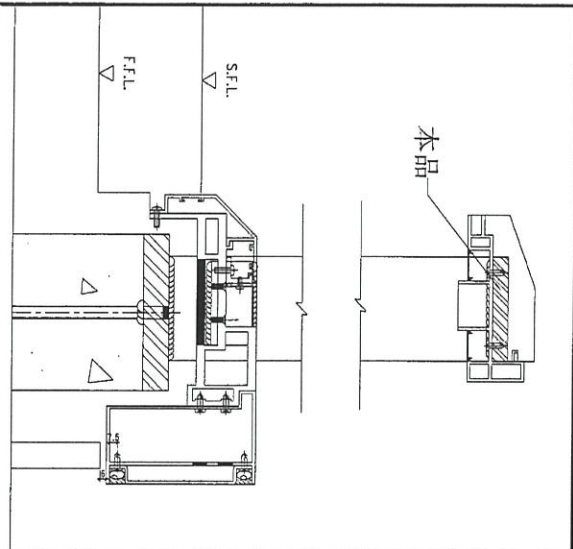


序號	物料編號	數量	L:	L1:	M:	A:	使用位置	樓層
01	51-BA01-GTR02	10	2435.5	2041.5	6	120.75	BAL-5501	T5/(5/F-16/F)
02	53-BA01-GTR02	10	1860	1466	4	133	BAL-5503	T5/(5/F-16/F)
03	55-BA01-GTR02	4	2435	2041	6	120.5	BAL-4505	T5/(11/F-16/F)

名稱	欄河BAL鋼橫樑(扁巴)	制圖	CJM	2021.12.22	修改		
材料	100x15mm 鍍鋅鋼巴(材質:SJ275)	復核	SHUI	2021.12.25	日期		
顏色		批准			圖號	51-BA01-GTR02	


38

美特鋁質 有限公司
MIDI Aluminium Fabricator Ltd.

工程號 J-853 地盤 錦上路/延平道

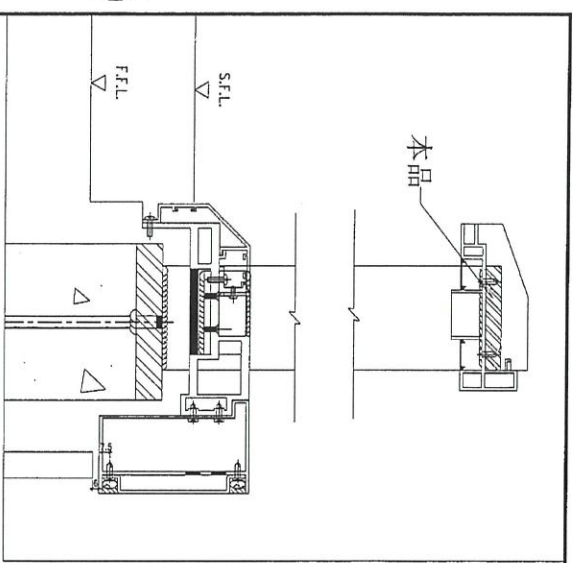

638
498
1403
1403
113
2503
2503

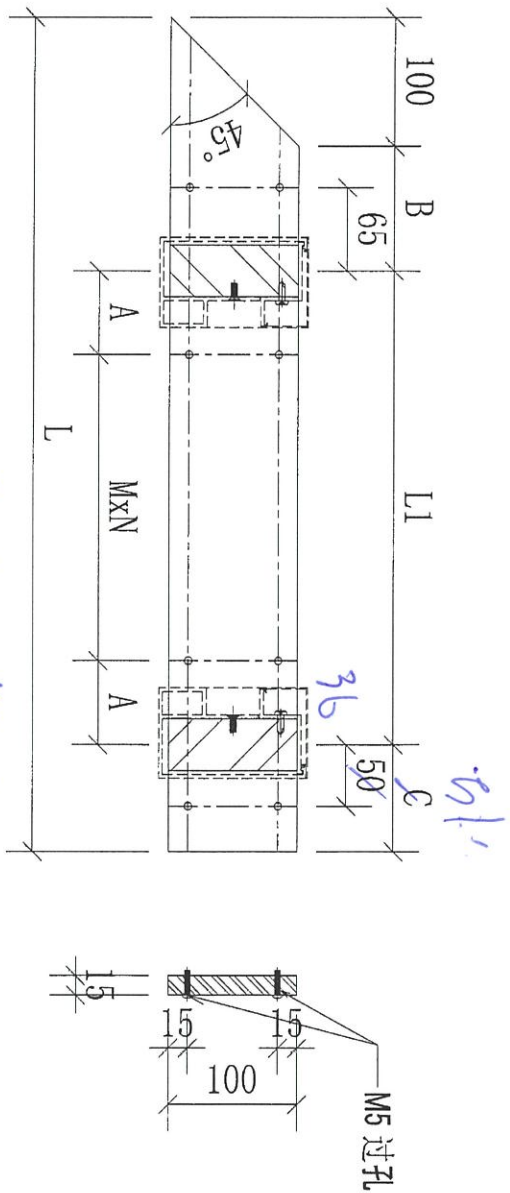

序號	物料編號	數量	L:	L1:	M:	N:	A:	B:	C:	使用位置	樓層
01	51-BA01-GTR03	10	915	740	300	20	61	34		BAL-5501	T5/(5/F-16/F)
02	52-BA01-GTR03	8	577	299	200	1	49.5	98	81	BAL-5502	T5/(17F-25/F)
03	53-BA01-GTR03	10	1433	1154	300	3	127	98	81	BAL-5503	T5/(5/F-16/F)
04	55-BA01-GTR03	4	1433	1154	300	3	127	98	81	BAL-5505	T5/(11/F-16/F)
05	56-BA01-GTR02	4	742	464	300	1	82	98	81	BAL-5506	T5/(11/F-16/F)
06	57-BA01-GTR02	13	2532	2254	300	7	77	98	81	BAL-5508	T5/(11/F-26/F)
07	57-BA01-GTR03 (57-BA01-GTR02R)	13	2532	2254	300	7	77	98	81	BAL-5508	T5/(11/F-26/F)

名稱	橫河BAL鋼模(扁巴)	制圖	CJM	2021.12.22	修改		
材料	100x15mm 鍍鋅鋼巴(材質: SJ275)	復核	SHUI	2021.12.25	日期		
顏色		批准			圖號	51-BL01-GTR03	


39




美特鋁質 有限公司
MIDI Aluminium Fabricator Ltd.

工程號	J-853	地盤	錦上路/延平道
-----	-------	----	---------

序號	物料編號	數量	L:	L1:	L2:	A:	B:	M:	N:	使用位置	樓層
01	52-BA01-GTR02	8	7435	2050	2041	125	120.5	6	6	BAL-5502	T5/(17F-25/F)

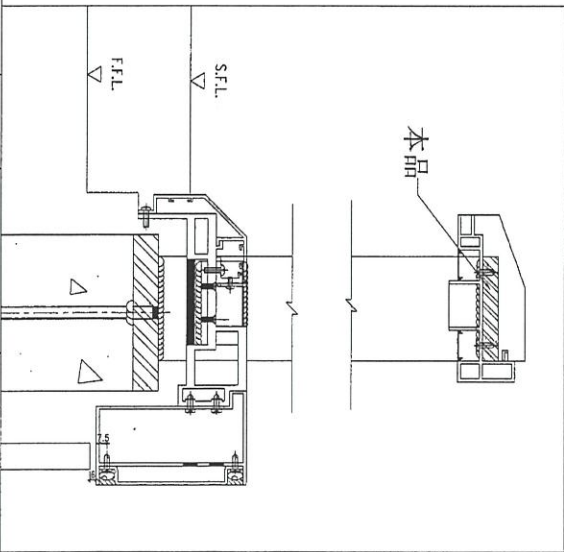

1份 3件

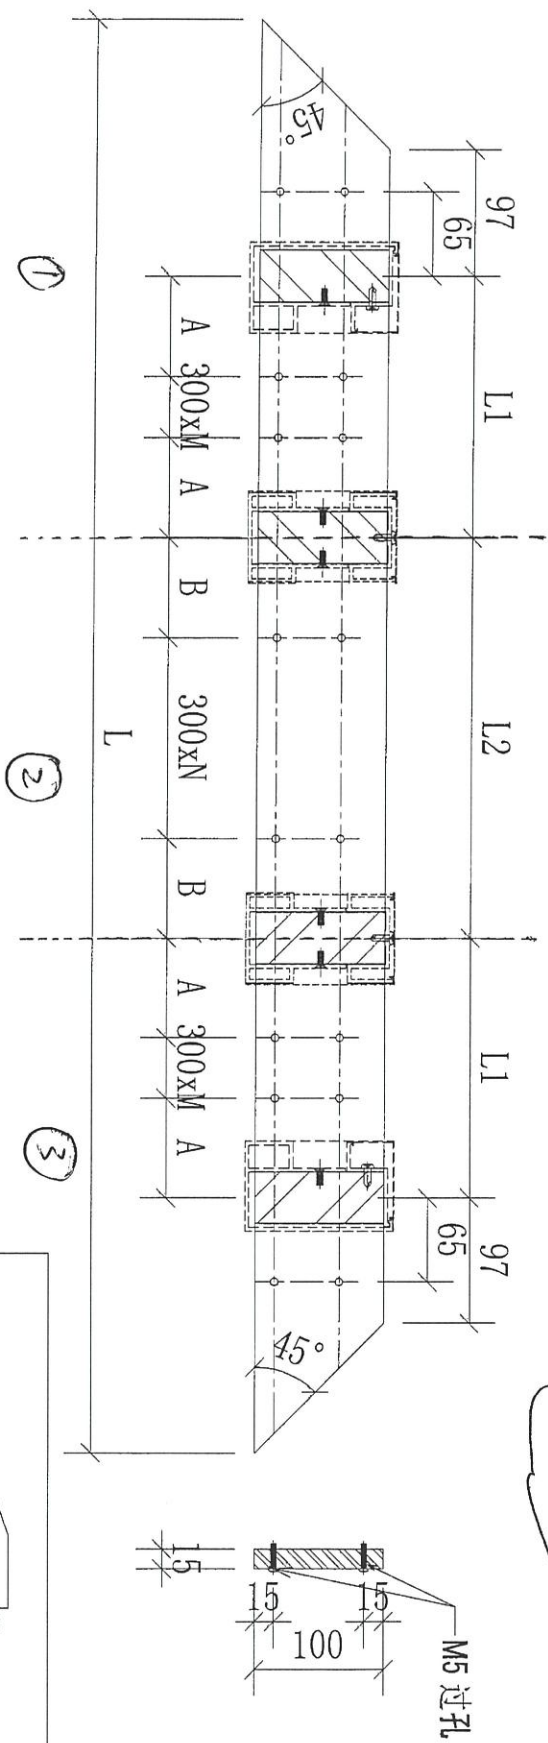

Hold

名稱	橫河BAL鋼模梁(馬巴)	制圖	CJM	2021.12.22	修改		
材料	100x15mm 鍍鋅鋼吧(材質: SJ275)	復核	SHUI	2021.12.25	日期		
顏色		批準			圖號	52-BA01-GTR02	

40



美特鋁質 有限公司
MIDI Aluminium Fabricator Ltd.



工程號

J-853

地盤

錦上路/延平道

Hold

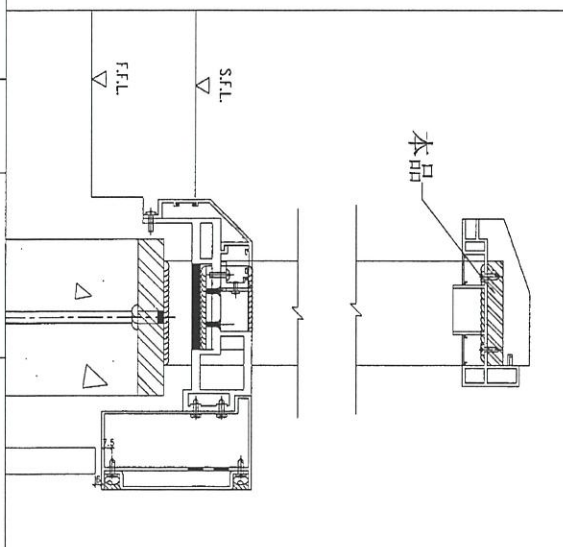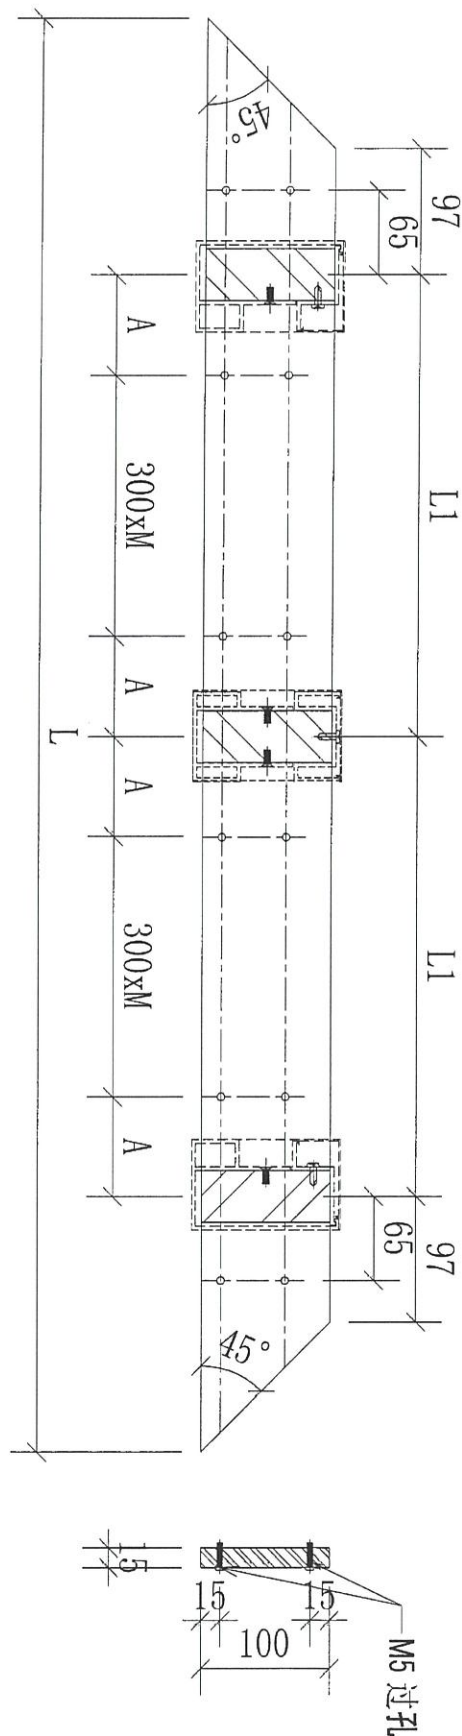

序号	物料編號	數量	L:	L1:	L2:	A:	B:	M:	N:	使用位置	樓層
01	54-BA01-GTR02	8	4035	1820		160		5		BAL-5504	T5/(17F-25/F)

名稱	欄河BAL 銅橫樑(扁巴)	制圖	CJM	2021.12.22	修改			
材料	100x15mm 鍍鋅鋼巴(材質: SJ275)	復核	SHUI	2021.12.25	日期			
顏色		批准			圖號	54-BA01-GTR02		

41






美特鋁質 有限公司
MIDI Aluminium Fabricator Ltd.

工程號

J-853

地盤

錦上路/延平道

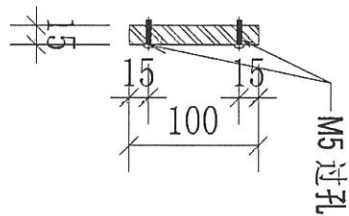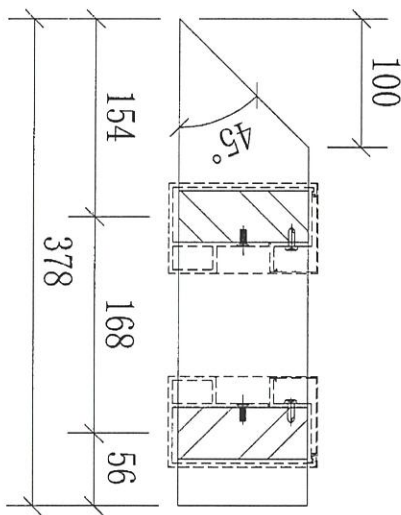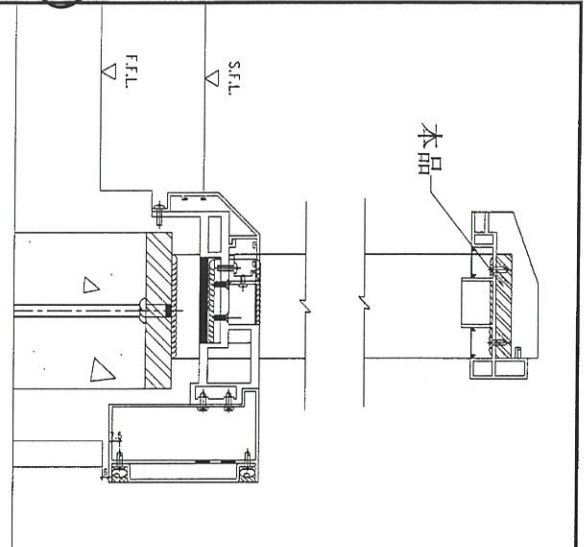

序號	物料編號	數量	L:	L1:	M:	A:	使用位置	樓層
01	54-BA01-GTR03	8					BAL-504	T5/(17F-25/F)



名稱	橫河BAL 銅橫樑(扁巴)	制圖	CJM	2021.12.22	修改			
材料	100x15mm 鍍鋅鋼巴(材質:SU275)	復核	SHUI	2021.12.25	日期			
顏色		批准			圖號	54-BA01-GTR03		

42



美特鋁質 有限公司
MIDI Aluminium Fabricator Ltd.

工程號	J-853	地盤	錦上路/延平道
-----	-------	----	---------

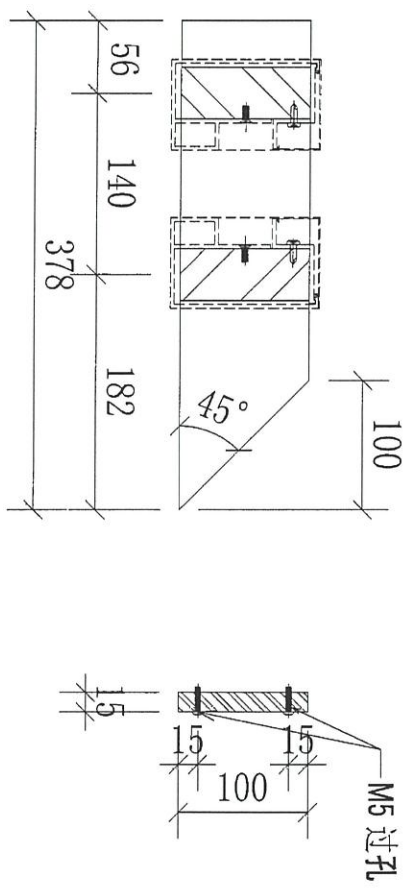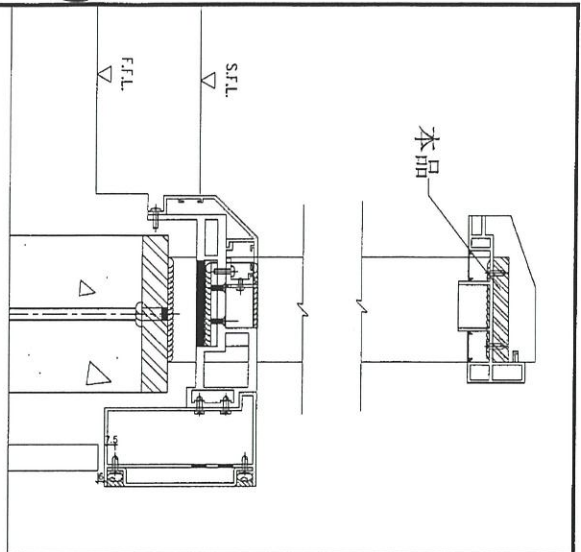

序號	物料編號	數量	L:	L1:	M:	A:	使用位置	樓層
01	55-BA01-GTR01	4	378				BAL-5505	T5/(11/F-16/F)

名稱	欄杆BAL 鋼橫樑(扁巴)	制圖	CJM	2021.12.22	修改			
材料	100x15mm 鍍鋅鋼巴(材質: SJ275)	復核	SHUI	2021.12.25	日期			
顏色		批准			圖號	55-BA01-GTR01		





美特鋁質 有限公司
MIDI Aluminium Fabricator Ltd.

工程號	J-853	地盤	錦上路/延平道
-----	-------	----	---------

序號	物料編號	數量	L:	L1:	L2:	A:	B:	M:	N:	使用位置	樓層
01	56-BA01-GTR01	4	2683	1202		151		3		BAL-5506	T5/(11F-16/F)

2553




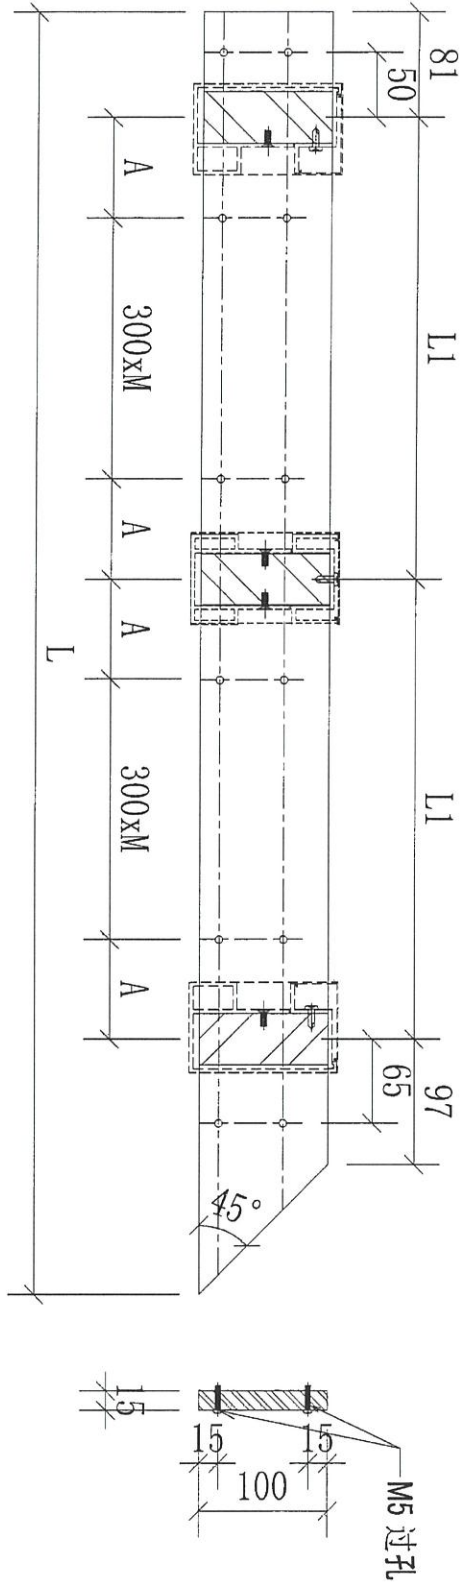
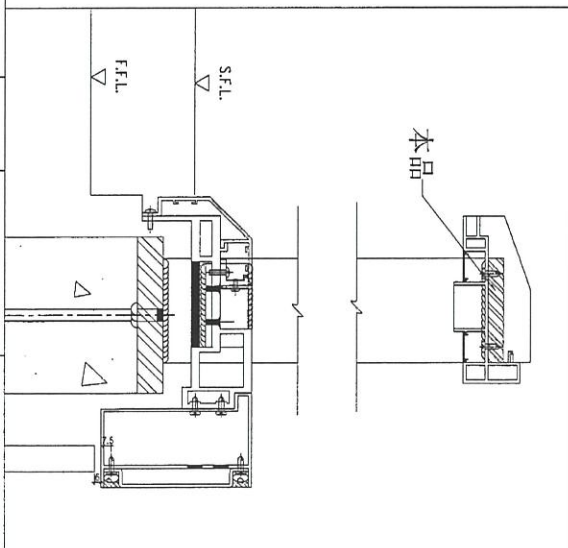


名稱	橫河BAL銅橫樑(扁巴)	制圖	CJM	2021.12.22	修改		
材料	100x15mm 鍍鋅鋼巴(材質: SJ275)	復核	SHUI	2021.12.25	日期		
顏色		批准			圖號	56-BA01-GTR01	



美特鋁質 有限公司
MIDI Aluminium Fabricator Ltd.

工程號	J-853	地盤	錦上路/延平道
-----	-------	----	---------

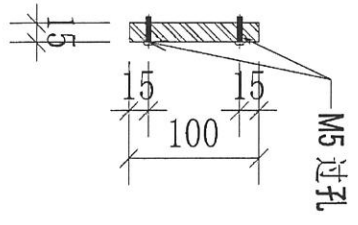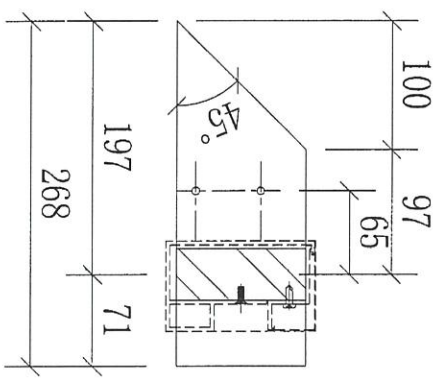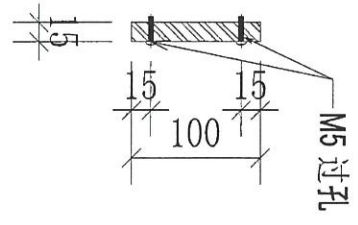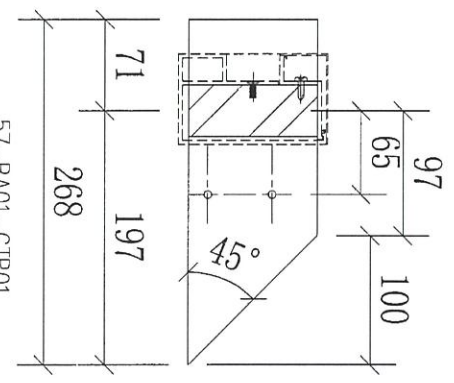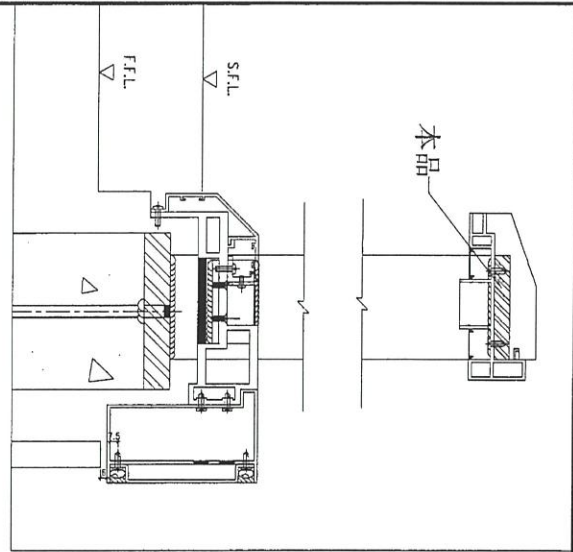

序號	物料編號	數量	L:	L1:	M:	A:	使用位置	樓層
01	57-BA01-GTR01	13	268				BAL-5507	T5/(11/F-26/F)
02	57-BA01-GTR04	13	268				BAL-5507	T5/(11/F-26/F)
	(57-BA01-GTR01R)							

57-BA01-GTR04
(57-BA01-GTR01R)

名稱	橫河BAL 銅橫樑 (扁巴)	制圖	CJM	2021.12.22	修改		
材料	100x15mm 鍍鋅鋼巴 (材質: SJ275)	復核	SHUI	2021.12.25	日期		
顏色		批准			圖號	57-BA01-GTR01	



錦上路／延平道



225XC

D 13215

—Ø10 孔

50

17

c

CO	1
----	---

Ø10 孔

切除

1539
680
270
1995
260
285
379

51-BB01-GTR01

日期	
----	--

圖號





美特鋁質 有限公司
MIDI Aluminium Fabricator Ltd.

工程號

J-853

地盤

錦上路／延平道

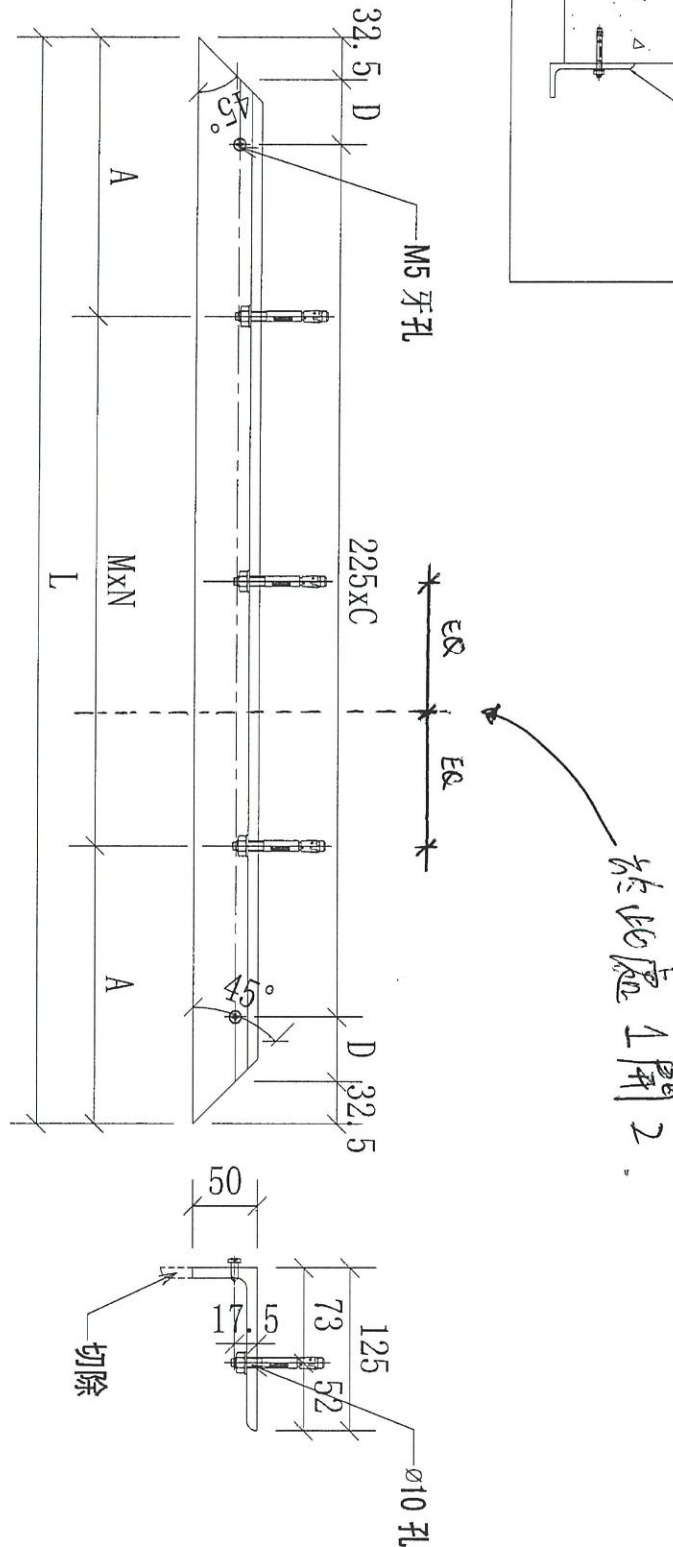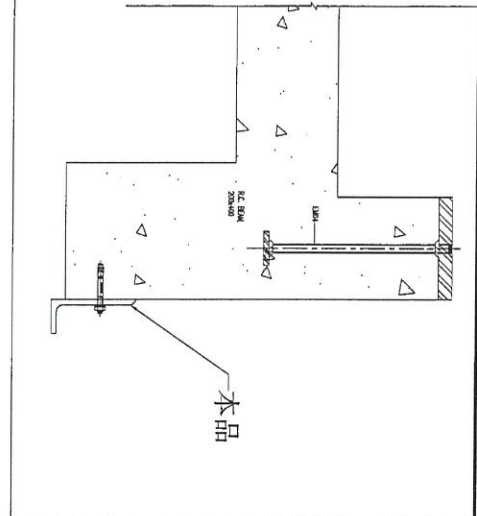

序號	物料編號	數量	L:	A	C	D	M:	N:	使用位置	樓層
01	51-BB01-G1R02	10	2600	250	11	30	525	4	BAL-5501	T5/(5/F-16/F)
02	53-BB01-G1R02	10	2025	262.5	8	80	500	3	BAL-4503	T5/(5/F-16/F)
03	54-BB01-G1R02	8	4200	200	18	42.5	633.3	6	BAL-4504	T5/(17/F-25/F)
04	55-BB01-G1R02	4	2680	200	11	70	525	4	BAL-4505	T5/(11/F-16/F)
05	57-BB01-G1R02	13	5500	200	23	130	637.5	8	BAL-4507	T5/(17/F-23/F)
		43								

名稱	攝河BAL 銅橫樑 (不等邊角銅)	制圖	CJM	2021.12.22	修改			
材料	125x75x8mm 鍍鋅角鋼 (材質: SJ275)	復核	SHUI	2021.12.25	日期			
顏色		批準			圖號	51-BB01-GTR02		





美特鋁質 有限公司
MIDI Aluminium Fabricator Ltd.

工程號

J-853

地盤




錦上路／延平道

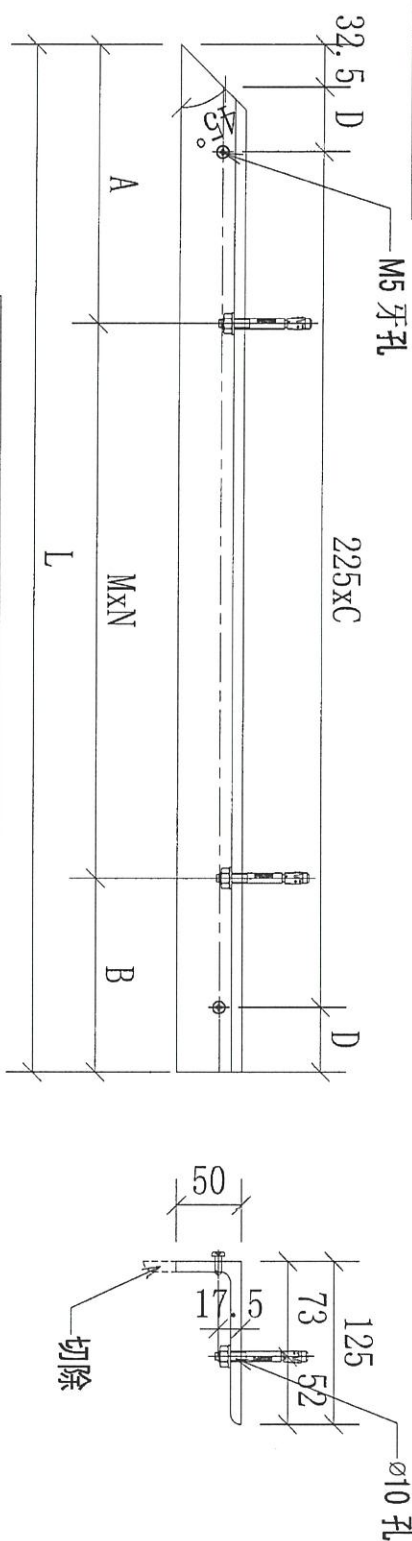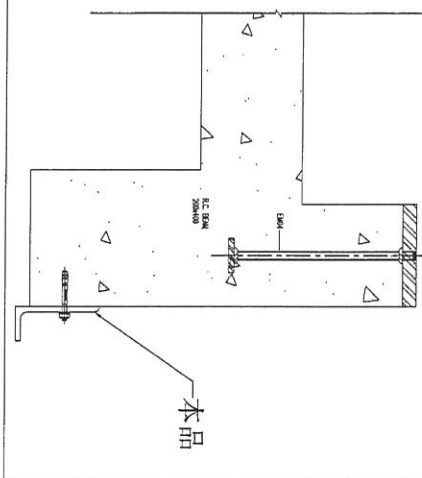

序號	物料編號	數量	L:	M:	N:	A:	B:	C:	D:	使用位置	樓層
01	51-BB01-GTR03	10	760	440	1	200	120	4	38.75	BAL-5501	T5/(5/F-16/F)
02	52-BB01-GTR04	8	670	300	1	200	170	2	93.75	BAL-5502	T5/(17F-25/F)
03	53-BB01-GTR03	10	1525	600	2	200	125	6	71.25	BAL-5503	T5/(5/F-16/F)
04	54-BB01-GTR03	8	460	195	1	200	65	1	101.25	BAL-5504	T5/(17F-25/F)
05	55-BB01-GTR03	4	1525	600	2	200	125	6	71.25	BAL-5505	T5/(11F-16/F)
06	56-BB01-GTR02	4	835	550	1	200	85	3	63.75	BAL-5506	T5/(11F-16/F)
07	57-BB01-GTR03	13	360	150	1	150	60	1	51.25	BAL-5506	T5/(11F-26/F)
08	57-BB01-GTR04 (57-BB01-GTR02R)	13	360	150	1	150	60	1	51.25	BAL-5506	T5/(11F-26/F)

名稱	灤河BAL 銅橫樑 (不等邊角銅)	制圖	CJM	2021.12.22	修改			
材料	125x75x8mm 鍍鋅角鋼 (材質: SJ275)	復核	SHUI	2021.12.25	日期			
顏色		批准			圖號	51-BB01-GTR03		

48

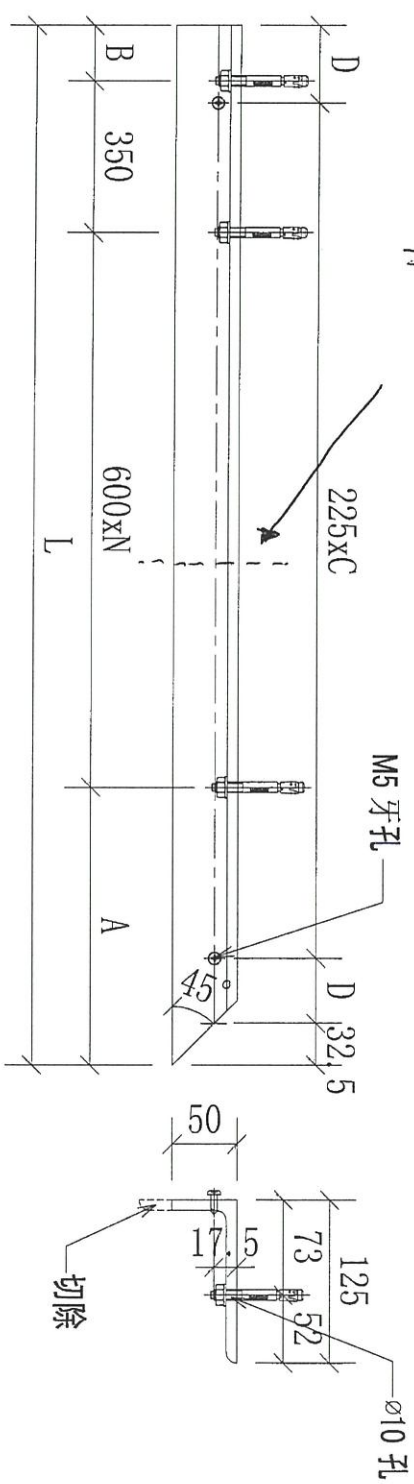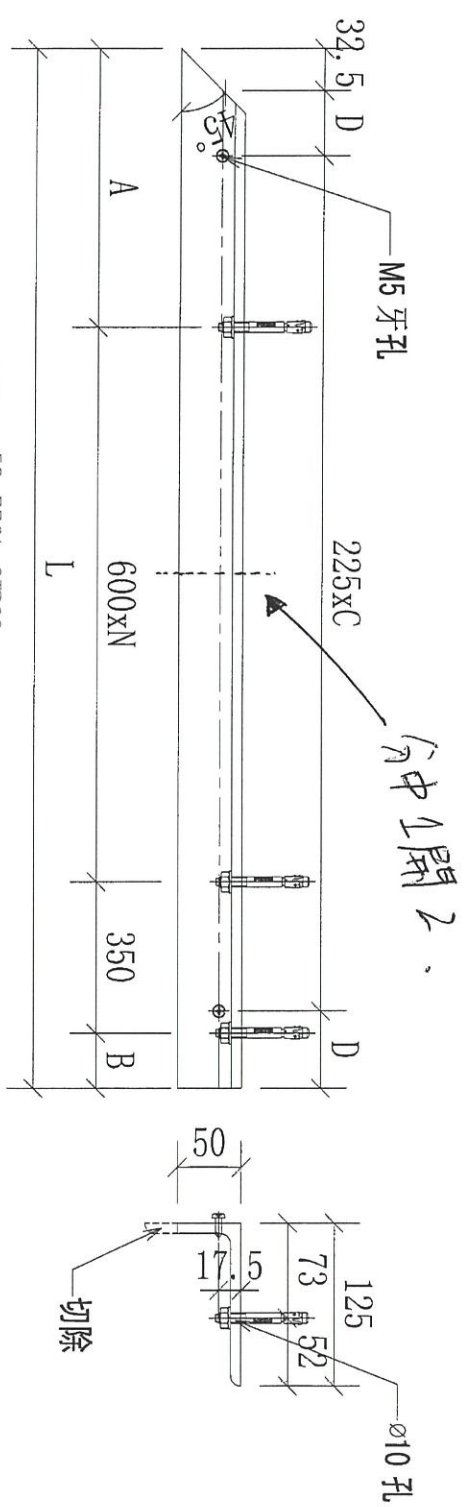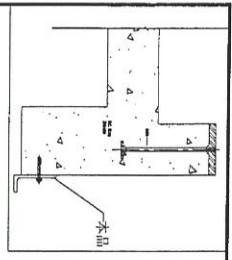

52-BB01-GTR03
(52-BB01-GTR02R)



 美特鋁質 有限公司 MIDI Aluminium Fabricator Ltd.			
工程號	J-853	地盤	錦上路/延平道

序號	物料編號	數量	L:	N:	A:	B:	C:	D:	使用位置	樓層
01	52-BB01-GTR02	8	3800	5	200	250	16	83.75	BAL-5502	T5/(17F-25/F)
02	52-BB01-GTR03	8	3800	5	200	250	16	83.75	BAL-4502	T5/(17F-25/F)
	(52-BB01-GTR02R)									

名稱	橫河BAL 鋼橫樑 (不等邊角鋼)	制圖	CJM	2021.12.22	修改		
材料	125x75x8mm 鍍鋅角鋼 (材質: SJ275)	復核	SHUI	2021.12.25	日期		
顏色		批准			圖號	52-BB01-GTR03	

物料編號: XX-01

50 x 50 x 5 角鐵

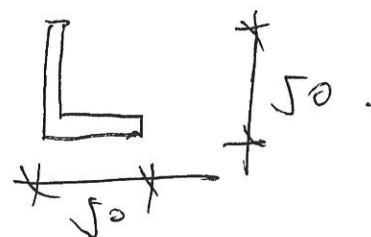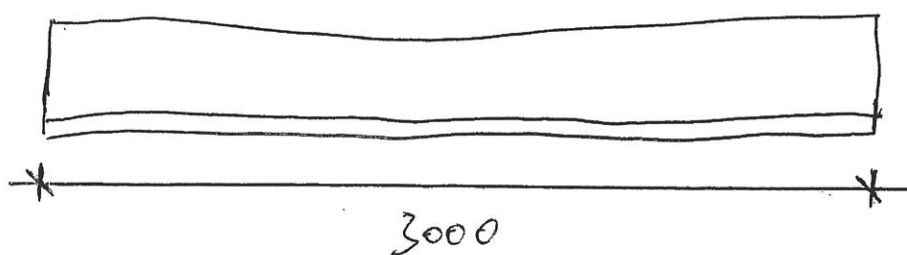


25 件

地盤用定位角鐵

B.O. REF. :		CLIENT :		ARCHITECT :		STRUCTURAL ENGINEER :		FACADE CONSULTANT :		NOTE :	
				WONG TUNG & PARTNERS LIMITED 		WONG TUNG & PARTNERS LIMITED 		MEINHARDT 		1. ALL DIMENSIONS ARE IN mm. 2. ALL DIMENSIONS TO BE REVEALED TYPICAL OUTSIDE. 3. ALL DIMENSIONS TO BE REVEALED ON SITE BEFORE FABRICATION. LEGEND :  DETAIL MARK NO. 11  DETAIL MARK NO. 12 1. F.F.L. --- FINISHED FLOOR LEVEL 2. S.F.L. --- STAIR/CORR. FLOOR LEVEL 3.  --- REBARRED DETAIL	
JOB NO. : J-653		PROJECT : PROPOSED RESIDENTIAL DEVELOPMENT AT N.K.L. 6542 YIN PING ROAD KOWLOON		TITLE : PART ELEVATION OF ALUM. BALUSTRADE AT TOWER 5		DATE : 08-MAR-21		SCALE : 1:60(A1)		DRAWN BY : C.M. CHENG	
DATE : 08-MAR-21		CHECKED BY :		DATE : 08-MAR-21		CHECKED BY :		DATE : 08-MAR-21		CHECKED BY :	
 MIDI 美特經貿有限公司 Unit 6-10, Sunny Industrial Centre, 1/F 162-14821-1-4 Tel: (852) 27222668		 WONG TUNG & PARTNERS LIMITED 402-14821-1-4 Tel: (852) 27222668		 MEINHARDT 402-14821-1-4 Tel: (852) 27222668		 MEINHARDT 402-14821-1-4 Tel: (852) 27222668		 MEINHARDT 402-14821-1-4 Tel: (852) 27222668		 MEINHARDT 402-14821-1-4 Tel: (852) 27222668	


17F-23/F=7

編號:	數量	總數量
51-M01-GMU01	4	28
51-M01-GMU02	2	14
52-M01-GTR01	1	7
52-M01-GTR02	1	7
52-M01-GTR03	1	7
52-N01-GTR01	1	7
52-N01-GTR02	1	7
52-N01-GTR03	1	7
52-P01-GTR01	1	7
52-P01-GTR02	1	7
52-P01-GTR03	1	7
		105

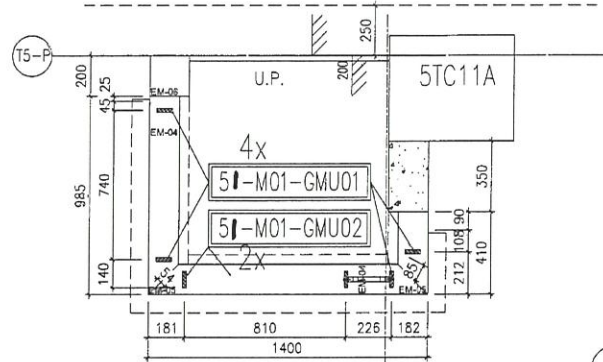


1
4502


TYPICAL PART PLAN FOR
T5 FLAT A U.P. 17/F-23/F
(OMITTED 24)

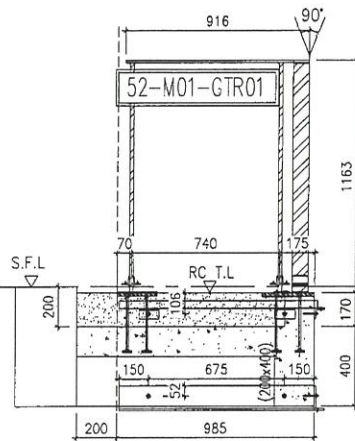


4 STEEL FRAME ONLY
— T5 FLAT A U.P. 17/F ~ 23/F

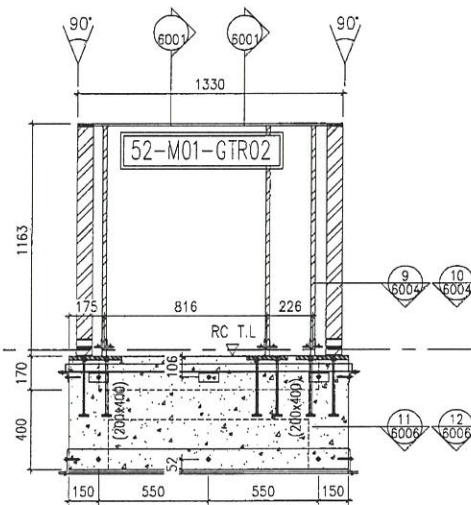


5 STEEL FRAME ONLY
- T5 FLAT A U.P. 17/F ~ 23/F

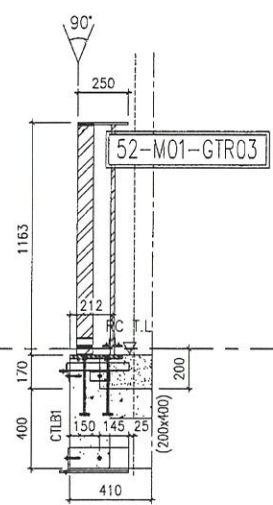

6	STEEL FRAME ONLY
-	T5 FLAT A U.P. 17/F ~ 23/F

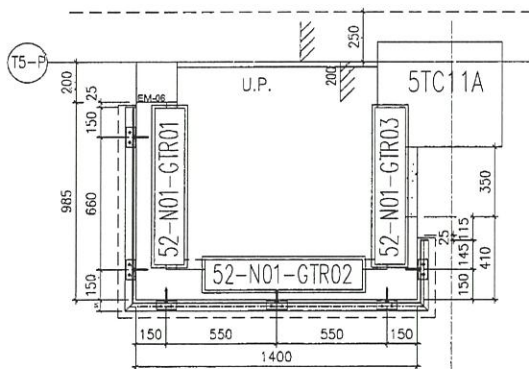

40x40x4-钢件位置图

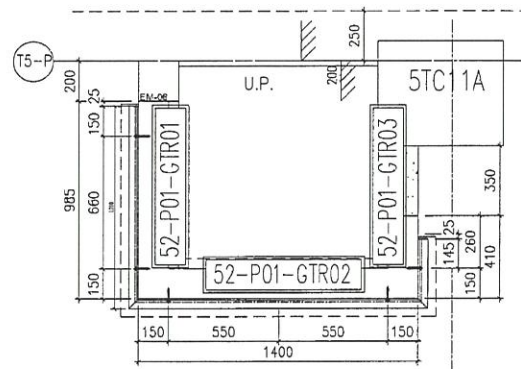


125x50x8-钢件位置图

UP4502-钢件位置图

B.O. REF. :			
CLIENT :			
ARCHITECT WONG TUNG & PARTNERS LIMITED ARCHITECTS & ENGINEERS 			
MAIN CONTRACTOR :			
STRUCTURE ENGINEER :			
 WONG TUNG & PARTNERS LIMITED ARCHITECTS & ENGINEERS			
FACADE CONSULTANT :			
MEINHARDT			
NOTE :			
1. ALL DIMENSIONS ARE IN mm. 2. ALL ELEVATIONS ARE VIEWED FROM OUTSIDE. 3. ALL DIMENSIONS TO BE REVERSED ON SITE. 4. ALL DIMENSIONS TO BE REVERSED ON SITE. 5. ALL DIMENSIONS TO BE REVERSED ON SITE.			
LEGEND :			
X1 DETAIL MARK NO. 1000 REVERSED SHEET NO. 1. F.F.L. --- FINISHED FLOOR LEVEL 2. S.F.L. --- STRUCTURAL FLOOR LEVEL 3. --- REVERSED DETAIL			
NO.	DATE	REVISION	BY
JOB NO. : J-H33			
PROJECT : PROPOSED RESIDENTIAL DEVELOPMENT AT N.K.L.L. 6542 YIN PING ROAD KOWLOON			
TITLE : PART ELEVATION OF ALUM. BALUSTRADE AT TOWER 5			
DATE : 08-MAR-21		SCALE : 1:60(A1)	
DRAWN BY : CHAN		CHECKED BY :	
 美特經貿有限公司 MEI TAI ENGINEERING CO., LTD. 6-B, Seng Hong Industrial Centre, 1/F 162-1871-4 Tel: (852) 27171065			
DWG NO. : JH33-ALU-DW-4502		REV. :	

52

編號:	數量:	總數量:
51-M01-GMU01	4	36
51-M01-GMU02	2	18
53-M01-GTR01	1	9
53-M01-GTR02	1	9
53-M01-GTR03	1	9
53-N01-GTR01	1	9
53-N01-GTR02	1	9
53-N01-GTR03	1	9
53-P01-GTR01	1	9
53-P01-GTR02	1	9
53-P01-GTR03	1	9
		135

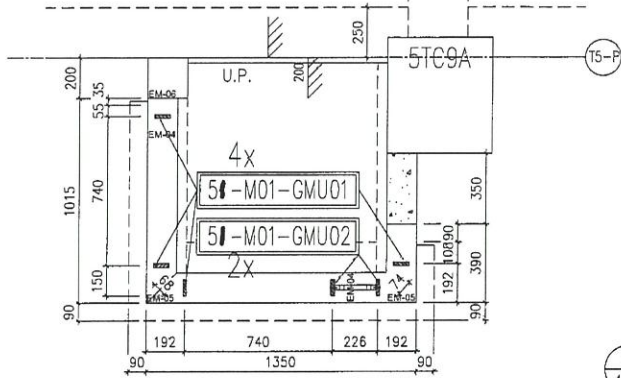


J853-SD-UP-4503


1400 T5 FLAT B

5/F-16/F=10


1 TYPICAL PART PLAN FOR
4503 T5 FLAT B U.P. 6/F~16/F
(OMITTED 13, 14)

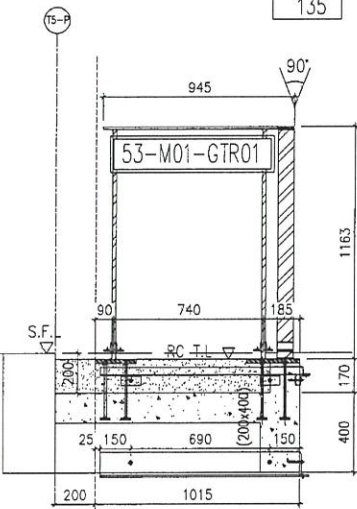


4 STEEL FRAME ONLY
T5 FLAT B U.P. 6/F ~ 16/F

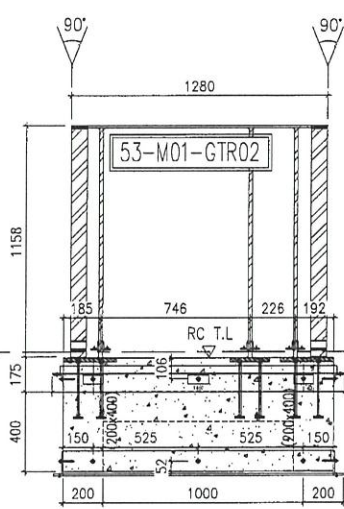


5 STEEL FRAME ONLY
T5 FLAT B U.P. 6/F ~ 16/F

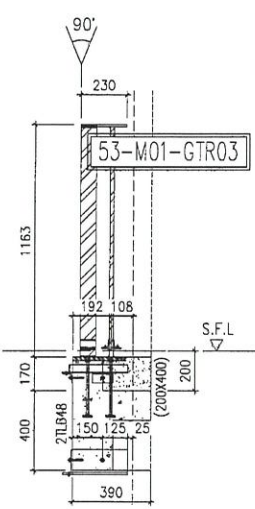

6 STEEL FRAME ONLY
T5 FLAT B U.P. 6/F ~ 16/F

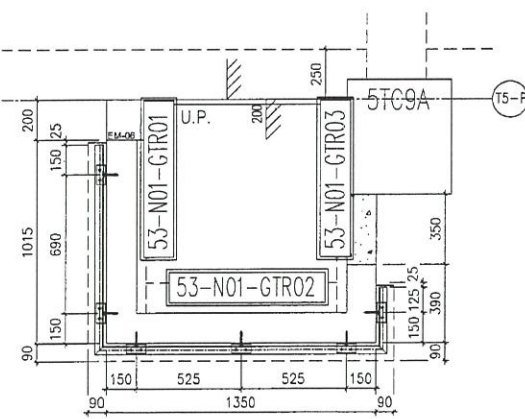

40x40x4-steel position diagram

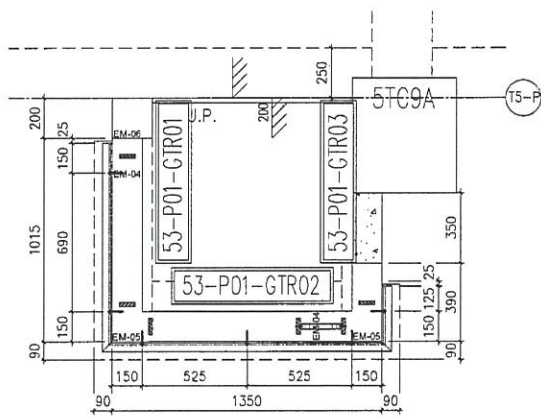


125x50x8-steel position diagram

UP4503-steel position diagram


DATE: 08-MAY-21 DRAWN BY: CLM CHECKED BY: [Signature]		DATE: 08-MAY-21 SCALE: 1:50(A1)		PROJECT: PROPOSED RESIDENTIAL DEVELOPMENT AT HKO 6542 XIN PING ROAD KOWLOON		TITLE: PART ELEVATION OF ALUM. BALUSTRADE AT TOWER 5		UNIT NO.: J-853		REVISION:	
NOTE: 1. ALL DIMENSIONS ARE IN mm. 2. ALL DIMENSIONS ARE REFERRED FROM OUTSIDE. 3. ALL DIMENSIONS ARE TO BE CHECKED ON SITE BEFORE FABRICATION.											
LEGEND: 1. DETAIL WORK NO. 2. REFER SHEET NO. 3. F.F.L. - FINISHED FLOOR LEVEL 4. S.F.L. - FINISHED TOWER LEVEL 5. REVERSED DETAIL											
STRUCTURAL ENGINEER: [Signature] ARCHITECT: [Signature] MAIN CONTRACTOR: [Signature]											
CLIENT: [Signature]											

54


編號:	數量	總數量
51-M01-GMU01	5	65
51-M01-GMU02	2	26
55-M01-GTR01	1	13
55-M01-GTR02	1	13
55-M01-GTR03	1	13
55-N01-GTR01	1	13
55-N01-GTR02	1	13
55-N01-GTR03	1	13
55-P01-GTR01	1	13
55-P01-GTR02	1	13
55-P01-GTR03	1	13
		208

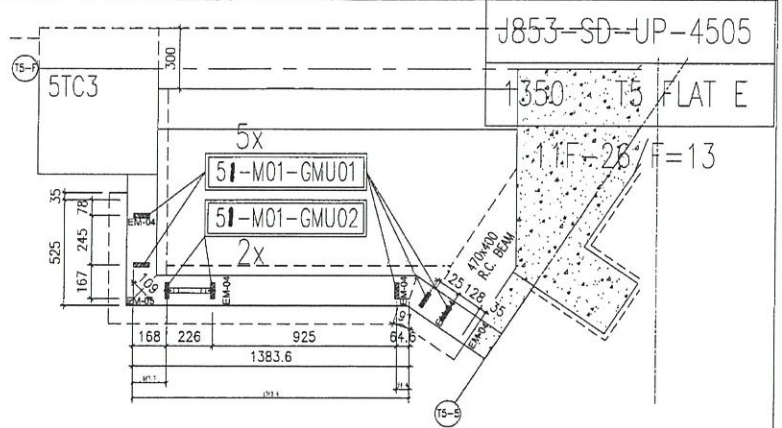


1 TYPICAL PART PLAN FOR
4505 T5 FLAT E U.P. 11/F-26/F

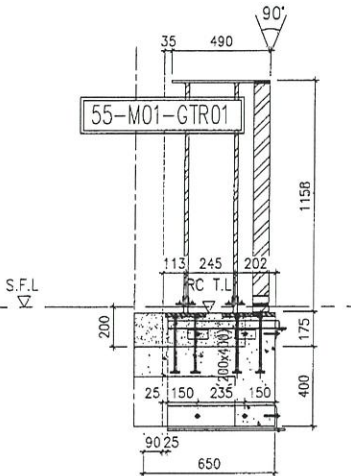


3 STEEL FRAME ONLY
T5 FLAT E U.P. 11/F ~ 26/F

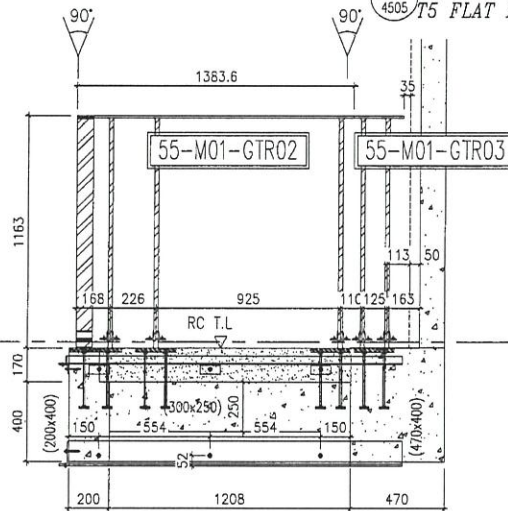

4 STEEL FRAME ONLY
T5 FLAT E U.P. 11/F ~ 26/F

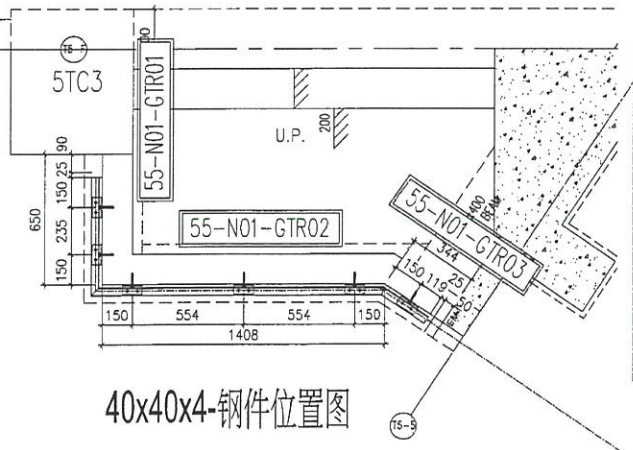

40x40x4-鋼件位置圖

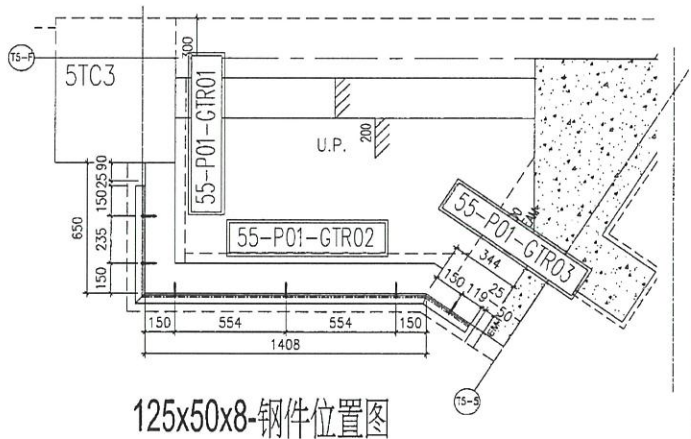


125x50x8-鋼件位置圖

UP4505-鋼件位置圖

REVISION NO. 1 DATE: 08-MAR-21 SCALE: 1:500(A1) DRAWN BY: CLM CHECKED BY: [Signature] DATE: 08-MAR-21 SCALE: 1:500(A1)		PROJECT PROPOSED RESIDENTIAL DEVELOPMENT AT N.K.L. 6542 YIN PING ROAD KOWLOON		TITLE PART ELEVATION OF ALUM. BALUSTRADE AT TOWER 5		CLIENT [Signature] [Signature]		ARCHITECT HOON TING & PARTNERS LIMITED ARCHITECTS & PLANNERS 11/F, 111, QUEEN'S ROAD EAST, HONG KONG TEL: (852) 2511-1111 FAX: (852) 2511-1112		STRUCTURAL ENGINEER HOON TING & PARTNERS LIMITED STRUCTURAL ENGINEERS 11/F, 111, QUEEN'S ROAD EAST, HONG KONG TEL: (852) 2511-1111 FAX: (852) 2511-1112		MECHANICAL ENGINEER HOON TING & PARTNERS LIMITED MECHANICAL ENGINEERS 11/F, 111, QUEEN'S ROAD EAST, HONG KONG TEL: (852) 2511-1111 FAX: (852) 2511-1112		ELECTRICAL ENGINEER HOON TING & PARTNERS LIMITED ELECTRICAL ENGINEERS 11/F, 111, QUEEN'S ROAD EAST, HONG KONG TEL: (852) 2511-1111 FAX: (852) 2511-1112		PLUMBING ENGINEER HOON TING & PARTNERS LIMITED PLUMBING ENGINEERS 11/F, 111, QUEEN'S ROAD EAST, HONG KONG TEL: (852) 2511-1111 FAX: (852) 2511-1112		CLIENT [Signature] [Signature]	
--	--	---	--	---	--	---	--	---	--	--	--	--	--	--	--	--	--	---	--


J853-SD-UP-4506
1350 T5 FLAT F
11F-26/F=13

編號:	數量	總數量
51-M01-GMU01	4	52
51-M01-GMU02	2	26
56-M01-GTR01	1	13
56-M01-GTR02	1	13
56-M01-GTR03	1	13
56-N01-GTR01	1	13
56-N01-GTR02	1	13
56-N01-GTR03	1	13
56-P01-GTR01	1	13
56-P01-GTR02	1	13
56-P01-GTR03	1	13
		195

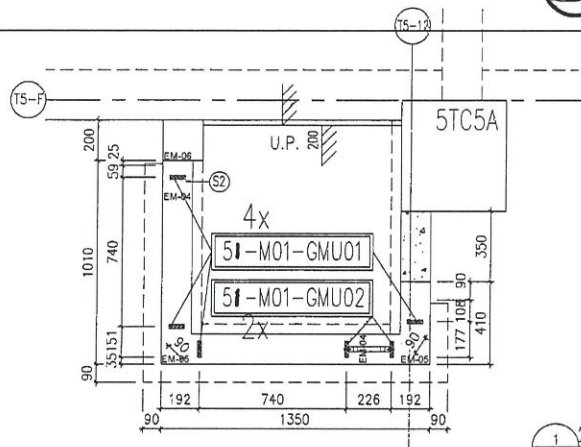


1
4506


TYPICAL PART PLAN FOR
T5 FLAT F U.P. 11/F-26/F

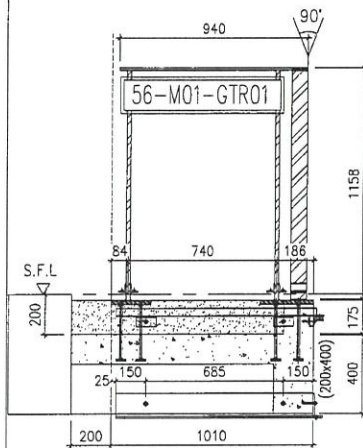


④ STEEL FRAME ONLY
— T5 FLAT F U.P. 11/F ~ 26/F

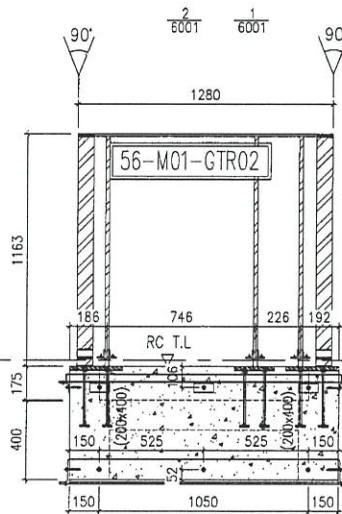


5 STEEL FRAME ONLY
- T5 FLAT F U.P. 11/F ~ 26/F

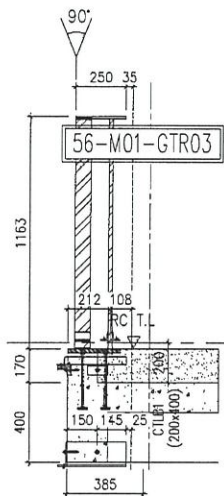

6	STEEL FRAME ONLY
-	T5 FLAT F U.P. 11/F ~ 26/F

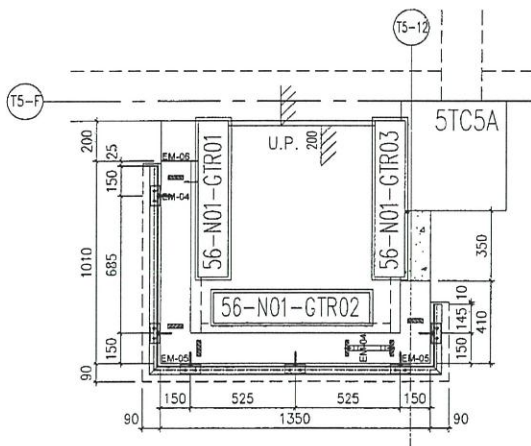

40x40x4-钢件位置图

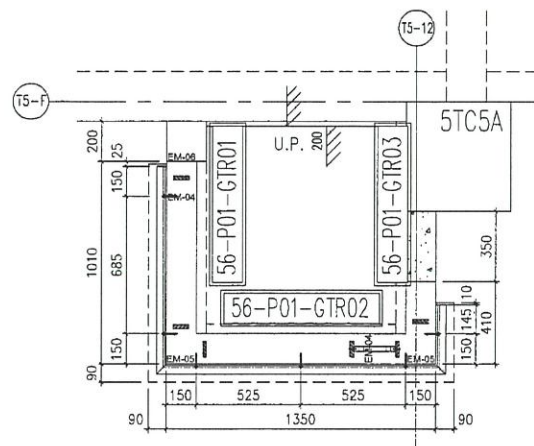

125x50x8-钢件位置图


UP4506-钢件位置图

B.O. REF. :	
CLIENT :	
ARCHITECT : WONG TUNG & PARTNERS LIMITED 	
MAIN CONTRACTOR :	
STRUCTURAL DESIGNER :  WONG TUNG & PARTNERS LIMITED ARCHITECTS & ENGINEERS	
FAÇADE CONSULTANT: 	
NOTE : 1. ALL DIMENSIONS ARE IN MM. 2. ALL ELEVATIONS ARE VIEWED FROM OUTSIDE. 3. DIMENSIONS TO BE REVERSED ON SITE BEFORE FABRICATION. LEGEND :  DETAIL MARK NO. 1  REVERSED DETAIL 1. F.F.L.—FINISHED FLOOR LEVEL 2. S.T.L.—STRUCTURAL FLOOR LEVEL 3. Ⓢ —REVERSED DETAIL.	
JOB NO. : J-853	
PROJECT : PROPOSED RESIDENTIAL DEVELOPMENT AT N.K.I.L. 6542 YIN PING ROAD KOWLOON	
TITLE : PART ELEVATION OF ALUM. BUILDINGROOE AT TOWER 5	
DATE : 08-MAR-21	SCALE : 1:60(A1)
DRAWN BY : CLM	CHECKED BY :
 MTDI 美特经贸有限公司 DATA 6-Bld., Sunny Island Office Building 1/F Tel: 2429211-4 Fax: (852) 27227665	
DWG NO. : JB53-SO-DP-4306	REV. :


J853-SD-CB-5501

T5 FLAT A


6/F-16/F=9

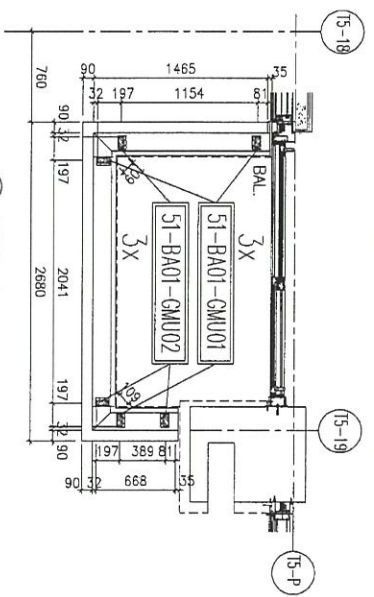


1 PART PLAN For GLASS BALUSTRADE
15 FLAT A at 6/F-16/F

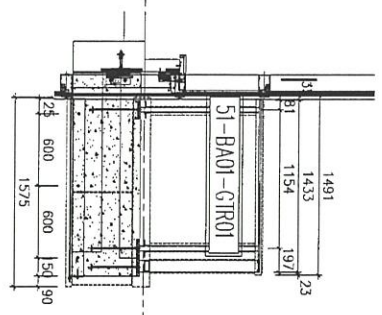

2 PART ELEV For GLASS BALUSTRADE
15 FLAT A at 6/F-16/F

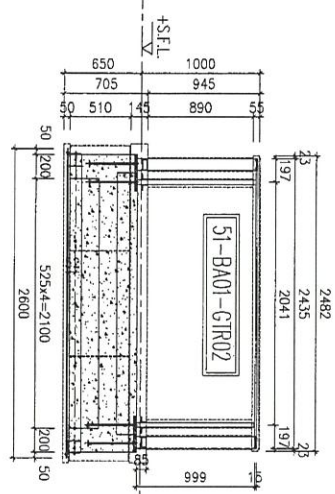


3 PART ELEV For GLASS BALUSTRADE
15 FLAT A at 6/F-16/F

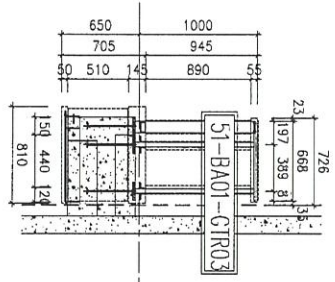

4 PART ELEV For GLASS BALUSTRADE
15 FLAT A at 6/F-16/F

編號:	數量:	總數量:
51-BA01-GMU01	3	27
51-BA01-GMU02	3	27
51-BA01-GTR01	1	9
51-BA01-GTR02	1	9
51-BA01-GTR03	1	9
51-BB01-GTR01	1	9
51-BB01-GTR02	1	9
51-BB01-GTR03	1	9
108		

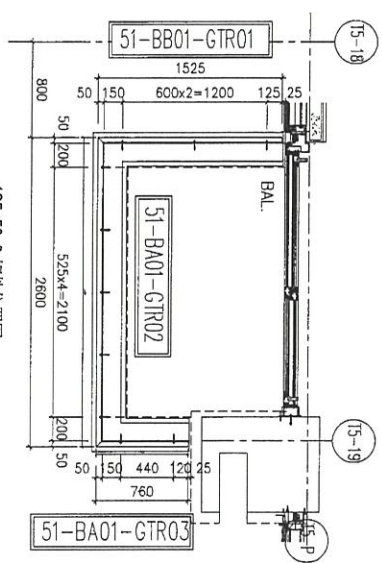

BAL5501-鋼材位置圖

B.O. REF :

CLIENT :

ARCHITECT :
WONG TUNG & PARTNERS LIMITED
ARCHITECTS & PLANNERS

STRUCTURAL ENGINEER :
WONG TUNG & PARTNERS LIMITED
ARCHITECTS & PLANNERS

FACE CONSULTANT:
MEINHARDT

NOTE:
1. ALL DIMENSIONS ARE IN mm.
2. ALL DIMENSIONS ARE MEASURED FROM OUTSIDE.
3. ALL DIMENSIONS TO BE REVERSED ON SITE BEFORE FABRICATION.


LEGEND:
1. DETAIL MARK NO.
2. REFER SHEET NO.
3. F.F.L. - FINISHED FLOOR LEVEL.
4. S.F.L. - STRUCTURAL FLOOR LEVEL.
5. REVERSED DETAIL.

JOB NO. : J-853
PROJECT : PROPOSED RESIDENTIAL DEVELOPMENT AT RICKLE 6542 YAN KOW LON

TITLE : PART ELEV and PART PLAN for GLASS BALUSTRADE AT TOWER 5 FLAT A

DATE : 18-MAY-21
SCALE : 1:50(A1)
DRAWN BY : HOON
CHECKED BY :
WONG TUNG & PARTNERS LIMITED
610 Chin Kuo Yee Road, Kowloon
Tel: (852) 27777668
Fax: (852) 27777668
DWC NO. : J853-SD-CB-5501
REV :

(57)

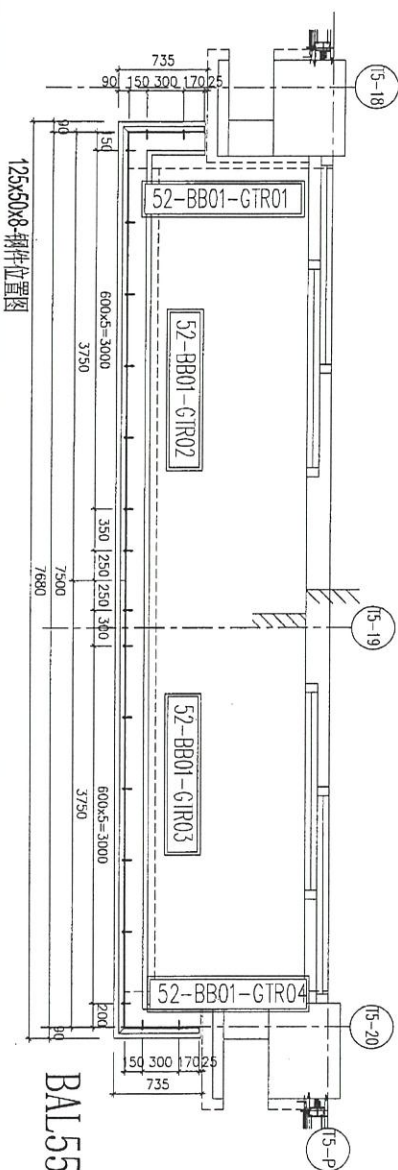

1853-SD-GB-5502

15 FLAT A

CLIENT

ARCHITECT :
WONG TUNG & PARTNERS LIMITED

MAIN CONTRACTOR :

STRUCTURAL ENGINEER :

FACADE CONSULTANT:

MEIN-HARDT

1. ALL DIMENSIONS ARE IN FEET.
2. ALL ELEVATIONS ARE VIEWED FROM OUTSIDE.
3. ALL DIMENSIONS TO BE VERIFIED ON SITE BEFORE FABRICATION.

1. F.F.L. --- FINISHED FLOOR LEVEL
2. S.F.L. --- STRUCTURAL FLOOR LEVEL
3. (7/9) --- REVERSED DETAIL.

PROJECT :	PROPOSED RESIDENTIAL DEVELOPMENT AT N.K.I.L. 6542 YIN PING ROAD KOWLOON
TITLE :	PART ELEV and PART PLAN for GLASS BALUSTRADE AT TOWER 5 FLAT A
DATE : 18-MAY-21	SCALE : 1:50(A1)

DRAWN BY : Iwon	CHECKED BY :
-----------------	--------------

美特鋁質有限公司
MIDI ALUMINIUM FABRICATOR LTD.
Units 6-B, Sunny Industrial Center, 1/F
610 Cho Kwo Lin Road, Kowloon

DWG NO. : JB53-SD-GH-5502	REV. :
---------------------------	--------

58


$$6/F-16/F=9$$


1853-SD-GB-5503

T5 FLAT B


NO. REF : DATE : 18-MAY-21		CLIENT : WONG TUNG & PARTNERS LIMITED PROJECT MANAGER 		ARCHITECT : WONG TUNG & PARTNERS LIMITED PROJECT MANAGER 		STRUCTURAL ENGINEER : WONG TUNG & PARTNERS LIMITED ARCHITECTS & ENGINEERS 		INVOICE CONSULTANT: 		NOTE : 1. ALL DIMENSIONS ARE IN mm. 2. ALL ELEVATIONS ARE TO BE WORKED ON OUTSIDE. 3. ALL DIMENSIONS TO BE DERIVED ON SITE BEFORE FABRICATION. (REMARK) DETAIL MARK NO. 11 1. F.F.L. --- FINISHED FLOOR LEVEL. 2. S.F.L. --- STRUCTURAL FLOOR LEVEL. 3. (7/9) --- FINISHED DETAIL.	
JOB NO. : J-B53 PROJECT : PROPOSED RESIDENTIAL DEVELOPMENT AT NIKELL 6542 YIN PING ROAD KOWLOON		DRAWN BY : NON CHECKED BY : SCALE : 1:30(A1)		TITLE : PART ELEV AND PART PLAN for GLASS BALUSTRADE AT TOWER 3 FLAT B		DATE : 18-MAY-21 ORDERED BY :		PROJECT MANAGER : 		PROJECT MANAGER : 	

1853-SD-GB-5504


T5 FLAT B
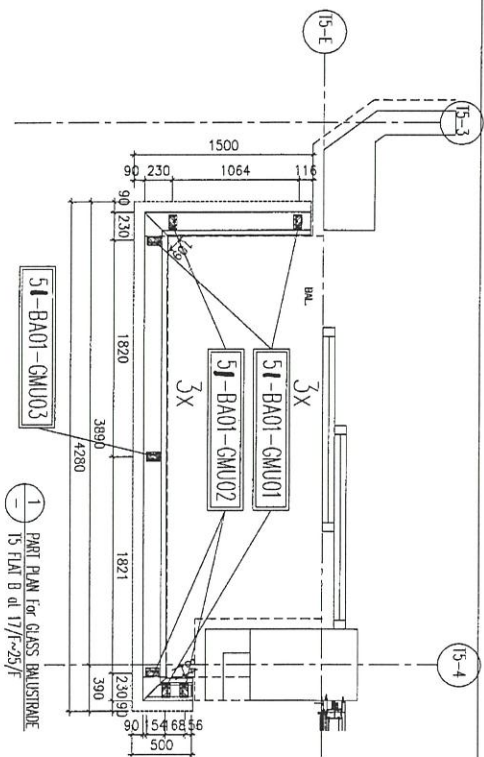
$$17/F - 25/F = 8$$


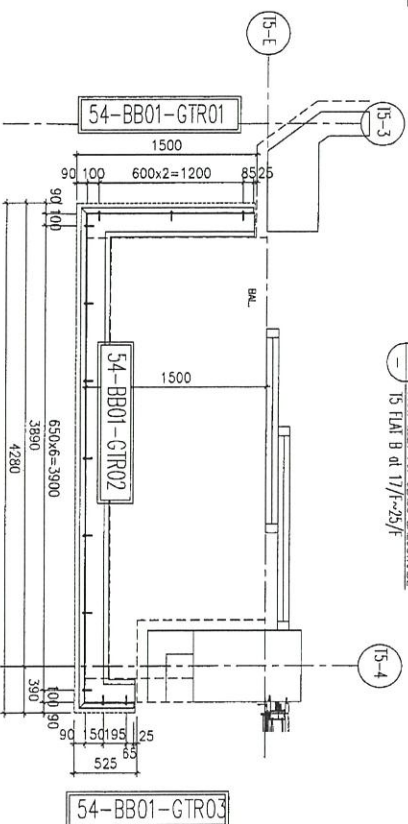
1
- PART PLAN for GLASS BALUSTRADE
15 FLAT B at 17/F~25/F

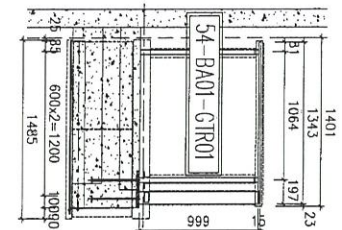

2. PART ELEV For GLASS BALUSTRADE
15 FLAT B at 17/F ~ 25/F

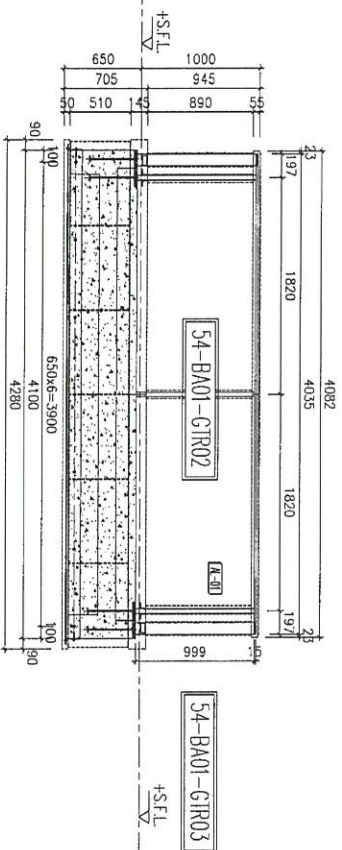

3 PART FILE FOR GLASS BALUSTRADE
— 15 FLAT B at 17/F~25/F



125x50x8-钢件位置图

BAL5504-鋼材位置圖

編號:	數量:	總數量
51-BA01-GMU01	3	24
51-BA01-GMU02	3	24
51-BA01-GMU03	1	8
54-BA01-GIR01	1	8
54-BA01-GIR02	1	8
54-BA01-GIR03	1	8
54-BB01-GTR01	1	8
54-BB01-GTR02	1	8
54-BB01-GTR03	1	8
		104

B.D. Ref :

CLIENT:

ARCHITECTS
WONG TUNG & PARTNERS LIMITED
ARCHITECTS & PLANNERS

MAIN CONTRACTOR :

STRUCTURAL ENGINEER :

FACADE CONSULTANT:

MEIN-YARDI

NOTE:

1. ALL DIMENSIONS ARE IN mm.
2. ALL ELEVATIONS ARE VIEWED FROM OUTSIDE.
3. ALL DIMENSIONS TO BE VIEWED ON SITE BEFORE FABRICATION.

LEGEND:

1. F.F.L.---FINISHED FLOOR LEVEL
2. S.F.L.---STRUCTURAL FLOOR LEVEL
3. (R) ---REVERSED DETAIL

JOB NO. : J-853

PROJECT :
PROPOSED RESIDENTIAL
DEVELOPMENT AT N.K.I.L. 6542
YIN PING ROAD
KOWLOON

PART ELEV and PART PLAN
for GLASS BALUSTRADE
AT TOWER 5 FLAT B (17/F-25/F)

DATE : 18-MAY-21	SCALE : 1:90(A1)
------------------	------------------

DRAWN BY : Iwon

CHECKED BY :

美特鋁質有限公司

MIDI ALUMINIUM PNEUMATOR LTD.
Units 6-8, Sunray Industrial Centre, 1/F

Tel: 23489211-4 Fax: (852) 2772766




DWC NO. : JB53-SD-CB-5504	REV. :
---------------------------	--------

60



美特鋁質 有限公司
MIDI Aluminium Fabricator Ltd.

工程號 J-853 地盤 錦上路/延平道

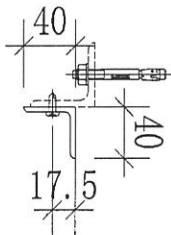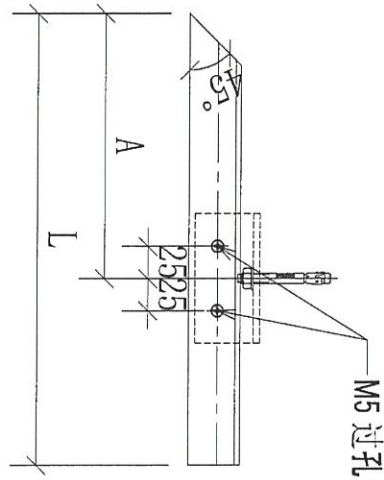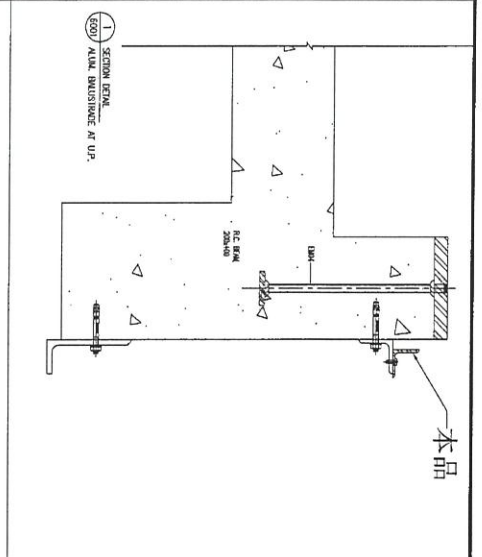

序號	物料編號	數量	L:	L1:	M:	A:	使用位置	樓層
01	52-N01-GTR03	7	350			205	UP-4502	T5/(17F-23/F)
02	53-N01-GTR03	10	330			205	UP-4503	T5/(5F-16/F)
03	56-N01-GTR03	13	350			205	UP-4506	T5/(11F-26/F)



名稱	橫河UP鋼橫樑(等邊角鋼)	制圖	CJM	2021.12.22	修改			
材料	40x40x4mm 鍍鋅角鋼(材質:SU275)	復核	SHUI	2021.12.25	日期			
顏色		批准			圖號	52-N01-GTR03		

61



美特鋁質 有限公司
MIDI Aluminium Fabricator Ltd.

工程號	J-853	地盤	錦上路/延平道
-----	-------	----	---------


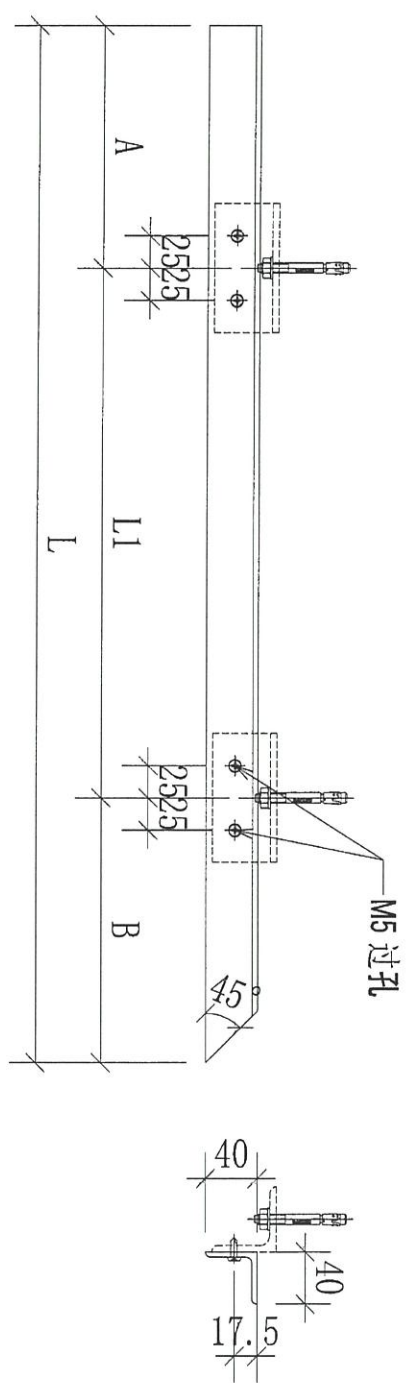
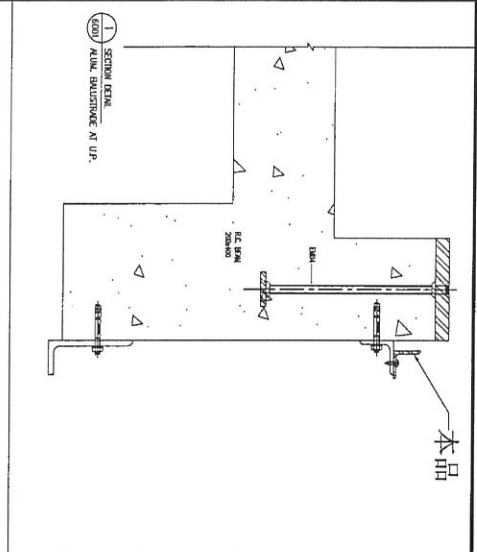


序號	物料編號	數量	L:	L1:	A:	B:	C:	使用位置	樓層
01	52-N01-GTR01	7	1015	660	150	205		UP-4502	T5/(17F-23/F)
02	53-N01-GTR01	10	1045	690	150	205		UP-4503	T5/(5/F-16/F)
03	55-N01-GTR01	13	590	235	150	205		UP-4505	T5/(11/F-26/F)
04	56-N01-GTR01	13	1040	685	150	205		UP-4506	T5/(11/F-26/F)

名稱	欄河UP 銅橫樑(等邊角鋼)	制圖	CJM	2021.12.22	修改		
材料	40x40x4mm 鍍鋅角鋼(材質:SJ275)	復核	SHUI	2021.12.25	日期		
顏色		批准			圖號	52-N01-GTR01	

1853-SD-GB-5505

T5 FLAT C
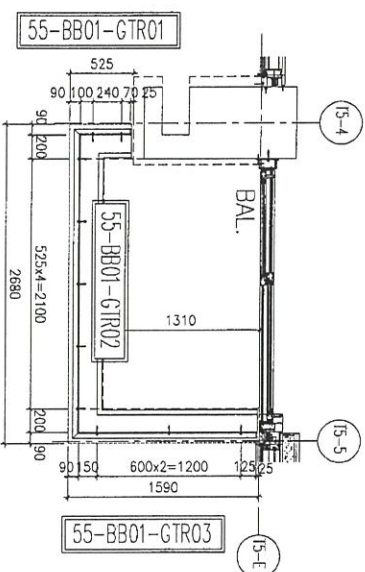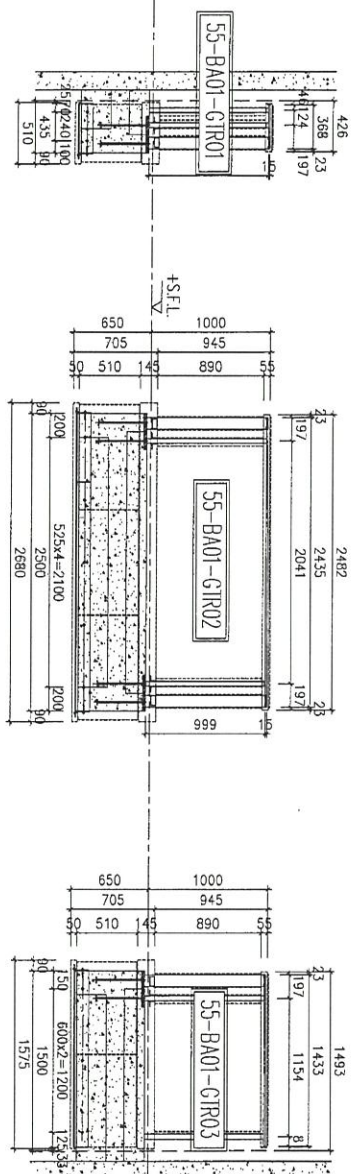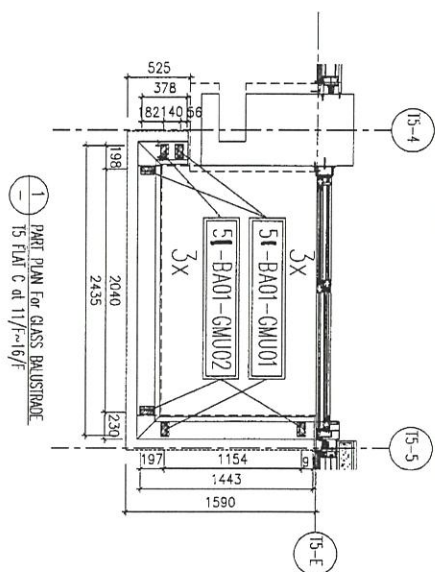
$$11/F-16/F=4$$


編號:	數量:	總數量
51-BA01-GMU01	3	12
51-BA01-GMU02	3	12
55-BA01-GIR01	1	4
55-BA01-GIR02	1	4
55-BA01-GIR03	1	4
55-BB01-GIR01	1	4
55-BB01-GIR02	1	4
55-BB01-GIR03	1	4
		48

125x50x8-钢件位置图

BAL5505-鋼材位置圖




BO. REF : 	CLIENT : 	ARCHITECT : WONG TUNG & PARTNERS LIMITED ARCHITECTS & PLANNERS 	MAIN CONTRACTOR : 	STRUCTURAL ENGINEER : WONG TUNG & PARTNERS LIMITED ARCHITECTS & PLANNERS 	FACADE CONSULTANT : 	NOTE : 1. ALL DIMENSIONS ARE IN METRE. 2. ALL ELEVATIONS ARE REFERRED FROM ELEVAGE. 3. ALL DIMENSIONS ARE TO BE FINISHED ON SITE BEFORE FABRICATION. LEGEND : 21 DETAIL MARK NO. 1000 - REIN. SHEET NO. 1. F.F.L. --- FINISHED FLOOR LEVEL 2. S.F.L. --- STRUCTURAL FLOOR LEVEL 3. --- REINFORCED DETAIL
-------------------	------------------	---	---------------------------	---	-----------------------------	---

DATE : 18-MAY-21	SCALE : 1:30(A1)	DRAWN BY : YWON	CHECKED BY :	
JOB NO. : J-853 PROJECT : PROPOSED RESIDENTIAL DEVELOPMENT AT N.K.L.L. 6542 YIN PING ROAD KOWLOON TITLE : PART ELEV AND PART PLAN for CLASS BALUSTRADE AT TOWER 3 FLAT C				

美特经贸有限公司
MIDI INTERNATIONAL DEVELOPMENT LTD.
 Units 6-9, Sunny Industrial Centre, 1/F
 662A9271-1-4 Fax: (852) 27227666

DATE NO. : J853-SO-GB-5664
 REC. :

編號:		數量:	總數量
51--BA01-GMU01	2	8	36
51--BA01-GMU02	2	8	
51--BA01-GMU03	1	4	
56--BA01-GTR01	1	4	
56--BA01-GTR02	1	4	
56--BB01-GTR01	1	4	4
56--BB01-GTR02	1	4	

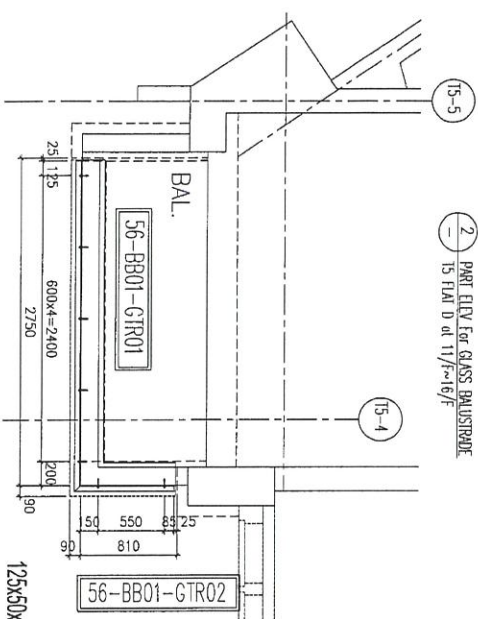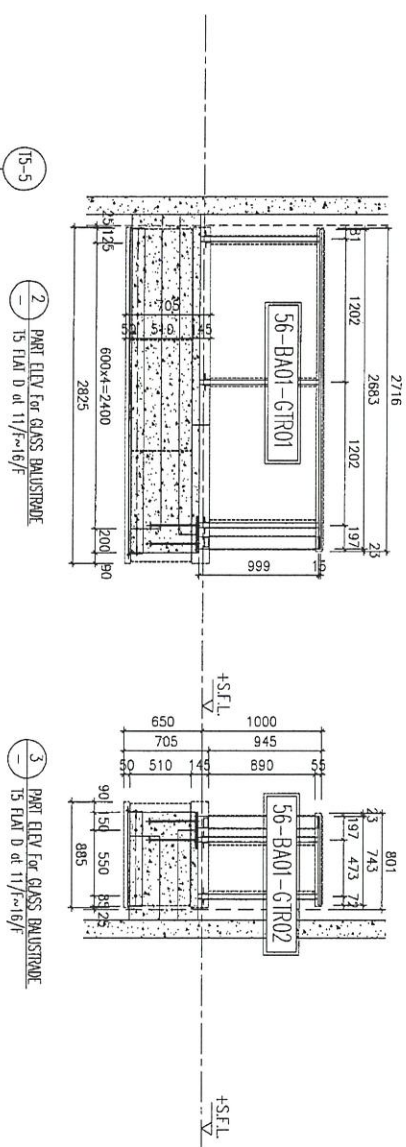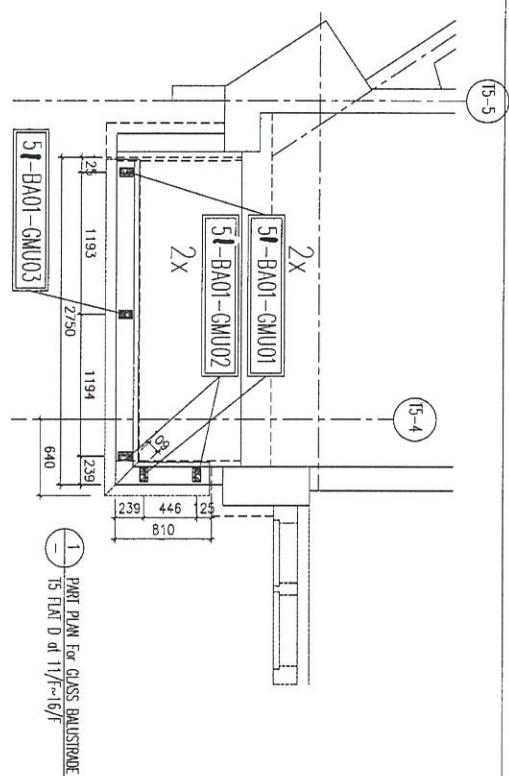

125x50x8-钢件位置图

BAL5506-鋼材位置圖

J853-SD-GB-5506

T5 FLAT D

$$11/F-16/F=4$$

BIB. REF. :		REV. :	
CLIENT :		REV. :	
ARCHITECT : HONG TUNG & PARTNERS LIMITED  HONG TUNG & PARTNERS ARCHITECTS & PLANNERS		ARCHITECT : HONG TUNG & PARTNERS LIMITED  HONG TUNG & PARTNERS ARCHITECTS & PLANNERS	
MAIN CONTRACTOR :		MAIN CONTRACTOR :	
STRUCTURAL ENGINEER :		STRUCTURAL ENGINEER :	
FUTURE CONSULTANT:  MEIN-HARDT		FUTURE CONSULTANT:  MEIN-HARDT	
NOTE : 1. ALL DIMENSIONS ARE IN mm. 2. ALL ELEVATIONS ARE VIEWED FROM OUTSIDE. 3. ALL DIMENSIONS TO BE VIEWED ON SITE. 4. REFERENCE DIMENSIONS. LEGEND : 		NOTE : 1. ALL DIMENSIONS ARE IN mm. 2. ALL ELEVATIONS ARE VIEWED FROM OUTSIDE. 3. ALL DIMENSIONS TO BE VIEWED ON SITE. 4. REFERENCE DIMENSIONS. LEGEND : 	
PROJECT : PROPOSED RESIDENTIAL DEVELOPMENT AT N.A.L.E. 05-42 YIN PING ROAD KOWLOON		PROJECT : PROPOSED RESIDENTIAL DEVELOPMENT AT N.A.L.E. 05-42 YIN PING ROAD KOWLOON	
TITLE : PLANT ELEV AND PART PLAN FOR CROSS BUILDING NO. 1 AT TOWER 5, FLAT D		TITLE : PLANT ELEV AND PART PLAN FOR CROSS BUILDING NO. 1 AT TOWER 5, FLAT D	
DATE : 18-MAY-21 DRAWN BY : Ison CHECKED BY :		DATE : 18-MAY-21 DRAWN BY : Ison CHECKED BY :	
JOB NO. : J-4553 SCALE : 1:100(A1)		JOB NO. : J-4553 SCALE : 1:100(A1)	
 美特硬實有限公司 Meinhardt Engineering & Planning 100, Des Voeux Road, Central, H.K. Tel: 24248211-4 Fax: 24250727/27866		 美特硬實有限公司 Meinhardt Engineering & Planning 100, Des Voeux Road, Central, H.K. Tel: 24248211-4 Fax: 24250727/27866	
DME NO. : J4553-SD-CG-5506		DME NO. : J4553-SD-CG-5506	

64

J853-SD-CB-5507

T5 FLAT E/F

11/F-26/F=13

110. REF :

CLIENT :

ARCHITECT : YONG TUNG & PARTNERS LIMITED

MAIN CONTRACTOR :

STRUCTURAL ENGINEER :

FAÇADE CONSULTANT :


MEINHARDT

NOTE:
1. ALL DIMENSIONS ARE IN MM.
2. ALL ELEVATIONS ARE VIEWED FROM OUTSIDE.
3. ALL DIMENSIONS TO BE VERIFIED ON SITE BEFORE FABRICATION.
4. REVERSE DETAIL.


1. F.T.L. --- FINISHED FLOOR LEVEL.
2. S.F.L. --- STRUCTURAL FLOOR LEVEL.
3. --- REVERSED DETAIL.

JOB NO. : J-053
PROJECT : PROPOSED RESIDENTIAL DEVELOPMENT AT TOWER 5 FLAT E/F
DEVELOPER : KOWLOON
DATE : 18-MAY-21
SCALE : 1:150(A1)
DRAWN BY : Yip Yuen
CHECKED BY :
TITLE : PART ELEV and PART PLAN for GLASS BALUSTRADE AT TOWER 5 FLAT E/F
UNIT 6-8, Sunny Industrial Centre, 1/F
610 Che Kwo Ling Road, Kowloon
TEL: 23882171-4 Fax: (02) 27272466
DWG NO. : J853-SD-CB-5507
REV. :


1 PART ELEV for GLASS BALUSTRADE
T5 FLAT E/F at 11/F-26/F

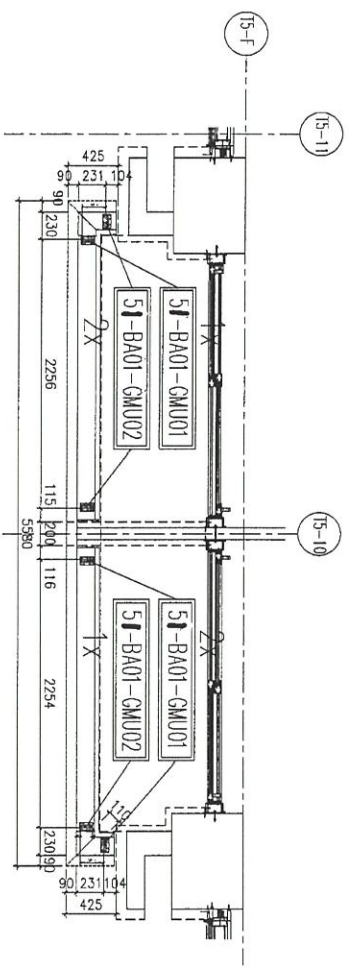

3 PART ELEV for GLASS BALUSTRADE
T5 FLAT E/F at 11/F-26/F

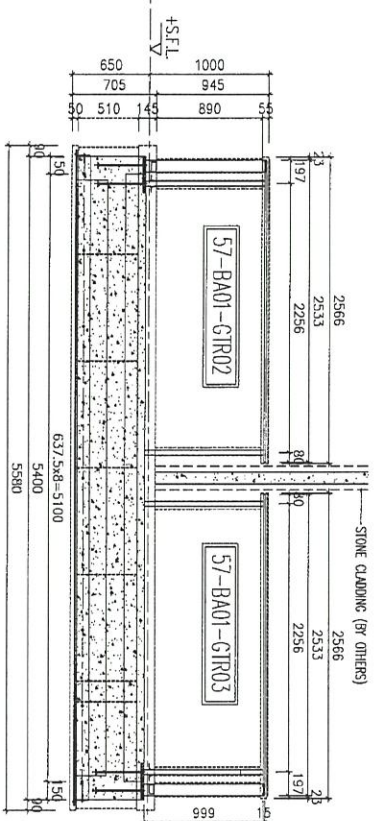


4 PART ELEV for GLASS BALUSTRADE
T5 FLAT E/F at 11/F-26/F

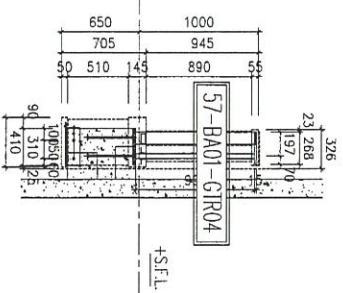


編號:	數量:	總數量:
51-BA01-GMU01	3	39
51-BA01-GMU02	3	39
57-BA01-GTR01	1	13
57-BA01-GTR02	1	13
57-BA01-GTR03	1	13
57-BA01-GTR04	1	13
57-BB01-GTR01	1	13
57-BB01-GTR02	1	13
57-BB01-GTR03	1	13
57-BB01-GTR04	1	13
		182

125x50x8-鋼件位置圖

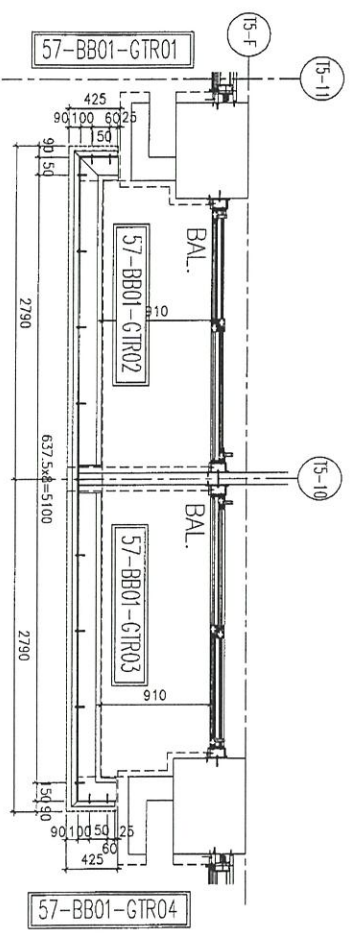

BA15507-鋼材位置圖

65

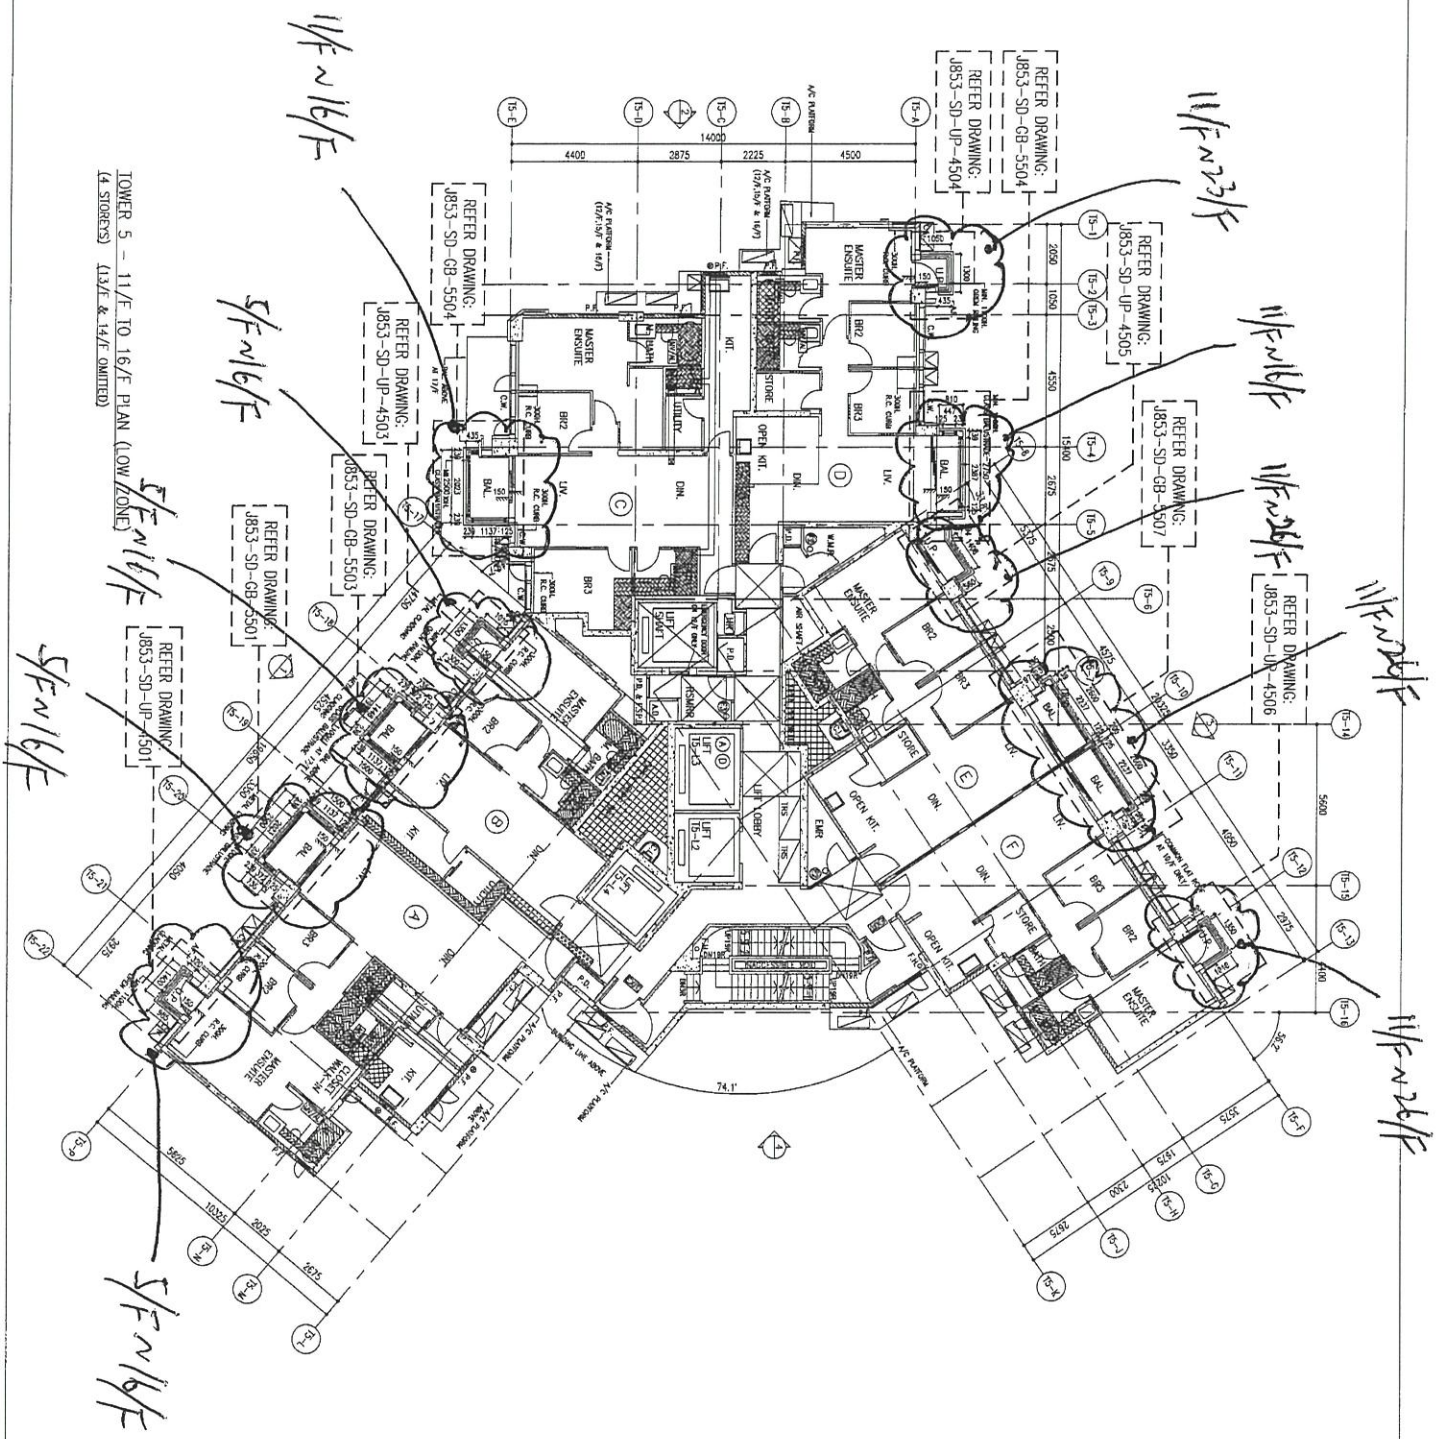

TOWER 5 - 11/F TO 16/F PLAN (LOW ZONE)
(4 STOREYS) (1/3" & 1/4" OMITTED)

FLOOR	LEVEL
16/F	+177.80
15/F	+174.65
12/F	+171.50
11/F	+168.35

DATE	NO.	REVISION
03-09-21	J-853	
PROJECT: PROPOSED RESIDENTIAL DEVELOPMENT AT N.K.L. 6542 YIN PING ROAD KOWLOON		
TITLE: LOCATION PLAN FOR TOWER 5 (11/F-16/F)		
DRAWN BY: CLM		
CHECKED BY:		
DATE: 03-09-21		
SCALE: 1:100		
FLOOR LEVEL (S.F.L.)		
16/F +177.80		
15/F +174.65		
12/F +171.50		
11/F +168.35		

NOTE:

1. ALL DIMENSIONS ARE IN mm.
2. ALL ELEVATIONS ARE VIEWED FROM OUTSIDE.
3. ALL DIMENSIONS TO BE VIEWED ON SITE BEFORE FABRICATION.


LEGEND:

- 1. DETAIL MARK NO.
- 2. REFER SHEET NO.
- 3. REFER TO THE FOLLOWING SHEET.
- 4. REFER TO THE FOLLOWING SHEET.
- 5. REFER TO THE FOLLOWING SHEET.

CLIENT:	SHIMAO GROUP HOLDINGS LIMITED
ARCHITECT:	WATKINS & PARTNERS LIMITED
MAIN CONTRACTOR:	
STRUCTURAL ENGINEER:	CM WONG & ASSOCIATES LTD
FAÇADE CONSULTANT:	MEIN-HARDT

66

TOWER 5 - 17/F TO 23/F PLAN (HIGH ZONE)
(7 STOREYS)

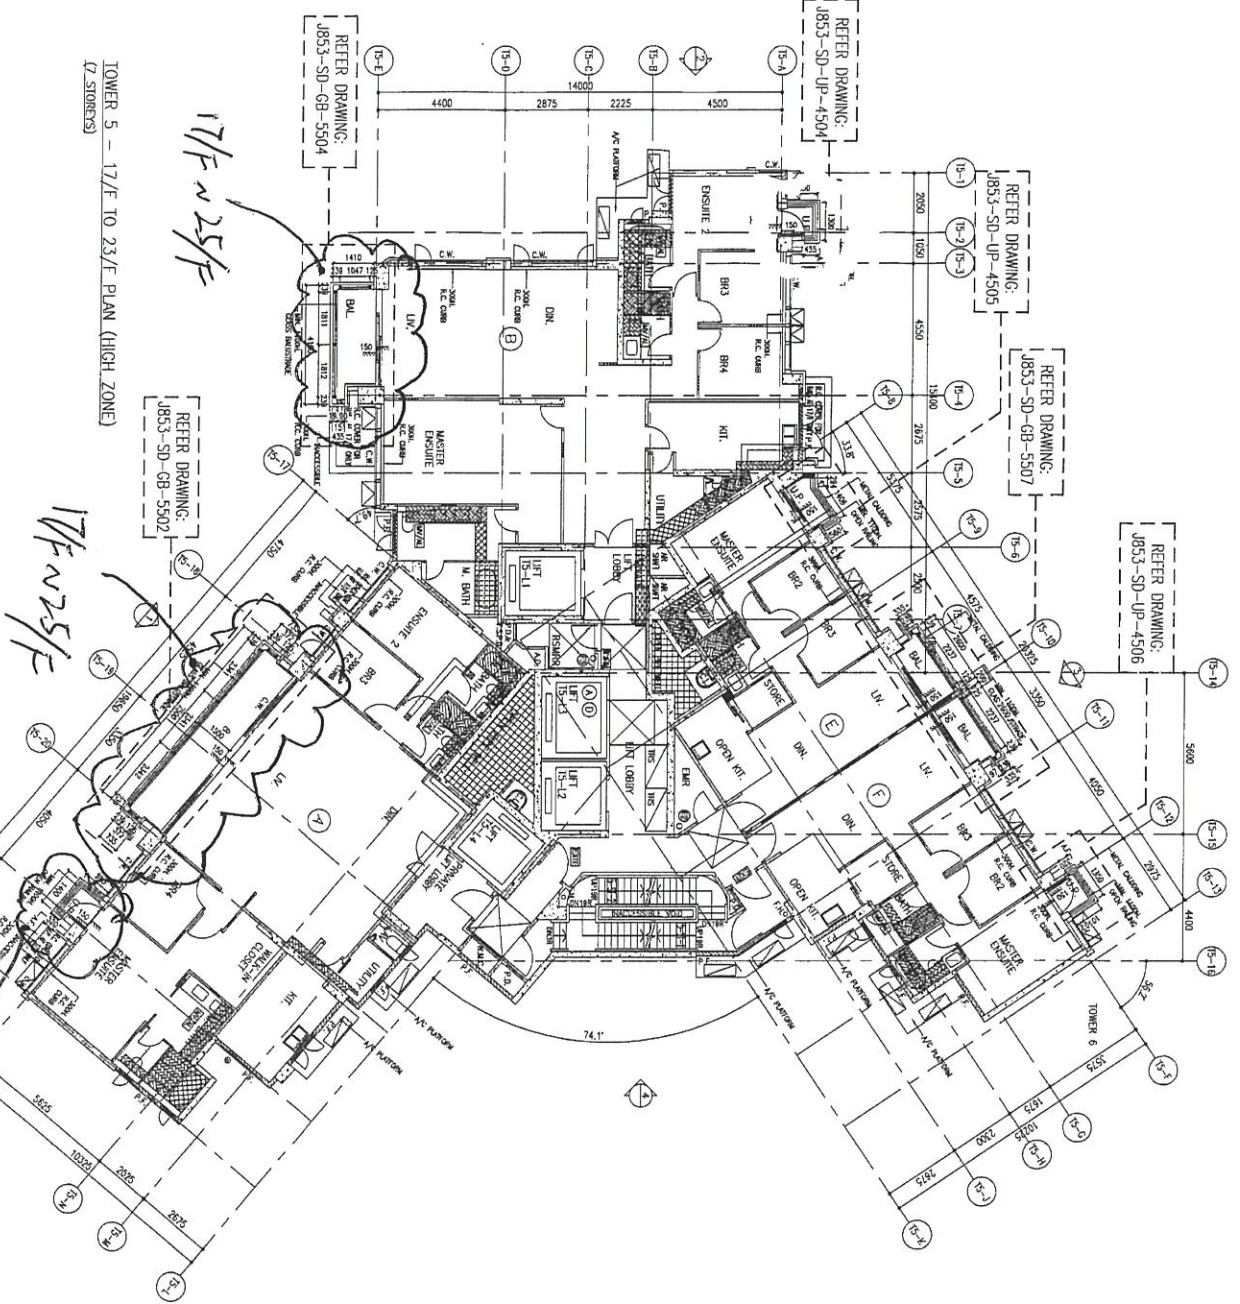

17/F ~ 23/F

FLOOR LEVEL (S.F.L.)
23/F
22/F
21/F
20/F
19/F
18/F
17/F

JOB NO. : J-853	
PROJECT : PROPOSED RESIDENTIAL DEVELOPMENT AT NKLL 6542 YIN PING ROAD KOWLOON	
TITLE : LOCATION PLAN FOR GLASS BALUSTRADE FOR TOWER 5 (17/F-23/F)	
DATE : 03-APR-21	SCALE : 1:100
DRAWN BY : C.M.	CHECKED BY :
Units 6-8, Sunny Industrial Centre, 17/F 610 Che Koo Ling Road, Kowloon Tel: (853) 27277166 Fax: (853) 27277166	
DWG NO. : J853-SD-BC-PL-3504	
REV. : A	

CLIENT : SHIMAO GROUP HOLDINGS LIMITED
ARCHITECT : YOUNG TUNG & PARTNERS LIMITED
MAIN CONTRACTOR : Y.T.
STRUCTURAL ENGINEER : C.M. WONG & ASSOCIATES LTD
GEOTECH CONSULTANT : WEINHARDT

NOTE:

1. ALL DIMENSIONS ARE IN mm.
2. ALL ELEVATIONS ARE VIEWED FROM OUTSIDE BEFORE FABRICATION.
3. ALL DIMENSIONS TO BE VERIFIED ON SITE.

LEGEND:

- 1. F.F.L. - FINISHED FLOOR LEVEL
- 2. S.F.L. - SUBMITTAL FLOOR LEVEL
- 3. ② - REFINISHED DETAIL