

工程指示 / 要求簡箋(E.I.)

工程指示編號：EI/ 4318 /22

修改版次：

工程編號：J853

工程名稱：延坪道住宅項目

工程項目：

收件人：

發件人：

Joe Chan

日期：4/1/2022

☐ 要求提供 / ☒ 確認 事項：☐ 初步鋁料 B.M.☐ 加工拆圖，然後生產☐ 尺寸表☐ 正式鋁料 B.M.☐ 技術上資料 / 指示☐ 報價☐ 配件 B.M.☐ 樣辦或貨品說明書☐ 分判合約☐ 其他：_____

內容：

請依附件資料，生產地盤用鋁掛碼，分座送地盤。每座5層數量出貨一次。

按地盤進度出貨

請在 3/13/2022 前完成上列要求。

第一批出貨

附有關圖紙 / 文件：

1169頁

以上項目為：

☐ 原合約工程包☐ 原合約工程加 / 減賬☐ 新工程報價

原因：-

分發東莞各部門：

☐ 生產技術總監 ☐ 連附件☒ 技術部 ☐ 連附件☐ 生產部☐ 連附件☐ 機械設計部 ☐ 連附件☐ 採購部☐ 連附件☒ 生產統籌部☐ 連附件

梅 TRACY

☐ 質檢部☐ 連附件☐ 會計部☐ 連附件☐ 報關組☐ 連附件☒ 其他

小羅

☐ 連附件

分發香港各部門：

☐ 行政部 ☐ 連附件☐ 會計部 ☐ 連附件☐ 統籌部 ☐ 連附件☒ 工程部地盤科文☐ 連附件

炳哥

☐ 採購部 ☐ 連附件☐ QS 部 ☐ 連附件☐ 維修部 ☐ 連附件☐ 其他☐ 連附件

傳遞編號：

HK0167/21

發件人簽署：

項目經理簽署：

T1 幕掛碼分層數量表

[illegible]

2

T2幕牆掛碼分層數量表

	BT01	BT01a	BT02	BT02a	BT03	BT03a	BT04	BT05	BT06	BT06a	BT07	BT08	BT09	BT10	BT11	每層總數	PL03 (方介數量)
26/F	18	0	7	0	8	0	0	0	0	0	0	0	0	0	0	33	66
25/F	15	2	7	1	7	1	0	0	0	0	0	0	0	0	0	33	66
23/F	14	0	8	0	7	0	0	1	0	0	1	0	0	0	0	31	62
22/F	14	0	8	0	7	0	0	1	0	0	1	0	0	0	0	31	62
21/F	14	0	8	0	7	0	0	1	0	0	1	0	0	0	0	31	62
20/F	14	0	8	0	7	0	0	1	0	0	1	0	0	0	0	31	62
19/F	14	0	8	0	7	0	0	1	0	0	1	0	0	0	0	31	62
18/F	14	0	8	0	7	0	0	1	0	0	1	0	0	0	0	31	62
17/F	14	0	8	0	7	0	0	1	0	0	1	0	0	0	0	31	62
16/F	13	0	10	0	9	0	0	1	1	0	1	0	0	0	0	35	70
15/F	14	0	9	0	8	0	0	1	1	0	1	0	0	0	0	34	68
12/F	14	0	9	0	8	0	0	1	1	0	1	0	0	0	0	34	68
11/F	14	0	9	0	8	0	0	1	1	0	1	0	0	0	0	34	68
10/F	14	0	9	0	8	0	0	1	1	0	1	0	0	0	0	34	68
9/F	14	0	9	0	8	0	0	1	1	0	1	0	0	0	0	34	68
8/F	14	0	9	0	8	0	0	1	1	0	1	0	0	0	0	34	68
7/F	14	0	9	0	8	0	0	1	1	0	1	0	0	0	0	34	68
6/F	14	0	9	0	8	0	0	1	1	0	1	0	0	0	0	34	68
5/F	14	0	10	1	8	1	0	1	1	1	1	0	0	0	0	38	76
TOTAL	270	2	162	2	145	2	0	17	10	1	17	0	0	0	0		1256

T3幕牆掛碼分層數量表

	BT01	BT01a	BT02	BT02a	BT03	BT03a	BT04	BT05	BT06	BT06a	BT07	BT08	BT09	BT10	BT11	每層總數	PL03 (方介數量)
26/F	18	0	8	0	8	0	0	0	0	0	0	0	0	0	0	34	68
25/F	15	2	7	1	7	1	0	0	0	0	0	0	0	0	0	33	66
23/F	14	0	8	0	7	0	0	1	0	0	1	0	0	0	0	31	62
22/F	14	0	8	0	7	0	0	1	0	0	1	0	0	0	0	31	62
21/F	14	0	8	0	7	0	0	1	0	0	1	0	0	0	0	31	62
20/F	14	0	8	0	7	0	0	1	0	0	1	0	0	0	0	31	62
19/F	14	0	8	0	7	0	0	1	0	0	1	0	0	0	0	31	62
18/F	14	0	8	0	7	0	0	1	0	0	1	0	0	0	0	31	62
17/F	14	0	8	0	7	0	0	1	0	0	1	0	0	0	0	31	62
16/F	13	0	10	0	9	0	0	1	1	0	1	0	0	0	0	35	70
15/F	14	0	9	0	8	0	0	1	1	0	1	0	0	0	0	34	68
12/F	14	0	9	0	8	0	0	1	1	0	1	0	0	0	0	34	68
11/F	14	0	9	0	8	0	0	1	1	0	1	0	0	0	0	34	68
10/F	14	0	9	0	8	0	0	1	1	0	1	0	0	0	0	34	68
9/F	14	0	9	0	8	0	0	1	1	0	1	0	0	0	0	34	68
8/F	14	0	9	0	8	0	0	1	1	0	1	0	0	0	0	34	68
7/F	14	0	9	0	8	0	0	1	1	0	1	0	0	0	0	34	68
6/F	14	0	9	0	8	0	0	1	1	0	1	0	0	0	0	34	68
5/F	14	0	9	1	8	1	0	1	1	1	1	0	0	0	0	37	74
TOTAL	270	2	162	2	145	2	0	17	10	1	17	0	0	0	0		1256

T5幕牆掛碼分層數量表

	BT01	BT01a	BT02	BT02a	BT03	BT03a	BT04	BT05	BT06	BT06a	BT07	BT08	BT09	BT10	BT11	每層數量	PL03 (方分數量)
26/F	21	0	12	0	12	0	0	0	0	0	0	0	1	1	1	48	96
25/F	18	3	11	1	11	1	0	0	0	0	0	0	0	1	0	46	92
23/F	18	0	12	0	12	0	1	1	0	0	0	0	0	0	0	44	88
22/F	18	0	12	0	12	0	1	1	0	0	0	0	0	0	0	44	88
21/F	18	0	12	0	12	0	1	1	0	0	0	0	0	0	0	44	88
20/F	18	0	12	0	12	0	1	1	0	0	0	0	0	0	0	44	88
19/F	18	0	12	0	12	0	1	1	0	0	0	0	0	0	0	44	88
18/F	18	0	12	0	12	0	1	1	0	0	0	0	0	0	0	44	88
17/F	18	0	12	0	12	0	1	1	0	0	0	0	0	0	0	44	88
16/F	15	0	12	0	12	0	1	1	0	0	0	1	0	0	0	42	84
15/F	17	0	12	0	12	0	1	1	0	0	0	1	0	0	0	44	88
12/F	17	0	12	0	12	0	1	1	0	0	0	1	0	0	0	44	88
11/F	17	0	12	0	12	0	1	1	0	0	0	1	0	0	0	44	88
10/F	4	0	4	0	4	0	0	0	0	0	0	1	0	0	0	13	26
9/F	4	0	4	0	4	0	0	0	0	0	0	1	0	0	0	13	26
8/F	4	0	4	0	4	0	0	0	0	0	0	1	0	0	0	13	26
7/F	4	0	4	0	4	0	0	0	0	0	0	1	0	0	0	13	26
6/F	4	0	4	0	4	0	0	0	0	0	0	1	0	0	0	13	26
5/F	4	0	4	0	4	0	0	0	0	0	0	0	0	0	0	12	24
TOTAL	255	3	179	1	179	1	11	11	0	0	0	9	1	2	1		1306

T6幕牆掛碼分層數量表

[illegible]

(7)

圖則登記表

DRAWING REGISTER

接收日期 Receiving Date (適用於客戶圖則)

工程名稱 Project Title: 延坪道
地台碼拆圖

工程編號 Project No: J-853

年									
月									
日									

分發予 Distributed To

年	22								
月	1								
日	17								

圖則編號 Drg. No.	圖則名稱 Drawing Title
853-BT01	牆邊鋁碼
853-BT01(1)	牆邊鋁碼(數據表)
853-BT01a	牆邊鋁碼
853-BT02	牆邊鋁碼
853-BT02(1)	牆邊鋁碼(數據表)
853-BT02a	牆邊鋁碼
853-BT03	牆邊鋁碼
853-BT03(1)	牆邊鋁碼(數據表)
853-BT03a	牆邊鋁碼
853-BT04	牆邊鋁碼
853-BT05	牆邊鋁碼
853-BT06	牆邊鋁碼
853-BT06a	牆邊鋁碼
853-BT07	牆邊鋁碼
853-BT08	牆邊鋁碼
853-BT09	牆邊鋁碼
853-BT10	牆邊鋁碼
853-BT11	牆邊鋁碼
853-PL01	單元安裝凹碼
853-PL01R	單元安裝凹碼
853-PL04	單元安裝凹碼
853-PL04R	單元安裝凹碼
853-PL02/853-PL03	介子 (48) /介子 (60)

修訂編號 Revision No.									
1	-								
2	-								
3	-								
8

圖則登記表
DRAWING REGISTER

接收日期 Receiving Date (適用於客戶圖則)

工程名稱 Project Title:	延坪道
	地台碼拆圖
工程編號 Project No:	J-853

年									
月									
日									

分發予 Distributed To

年	22								
月	1								
日	17								

圖則編號 Drg. No.	圖則名稱 Drawing Title
J853-SD-CW-4101	位置圖
J853-SD-CW-4102	位置圖
J853-SD-CW-4103	位置圖
J853-SD-CW-4104	位置圖
J853-SD-CW-4105	位置圖
J853-SD-CW-4106	位置圖
J853-SD-CW-4201	位置圖
J853-SD-CW-4202	位置圖
J853-SD-CW-4203	位置圖
J853-SD-CW-4204	位置圖
J853-SD-CW-4205	位置圖
J853-SD-CW-4206	位置圖
J853-SD-CW-4301	位置圖
J853-SD-CW-4302	位置圖
J853-SD-CW-4303	位置圖
J853-SD-CW-4304	位置圖
J853-SD-CW-4305	位置圖
J853-SD-CW-4306	位置圖
J853-SD-CW-4501	位置圖
J853-SD-CW-4502	位置圖
J853-SD-CW-4503	位置圖
J853-SD-CW-4504	位置圖
J853-SD-CW-4505	位置圖
J853-SD-CW-4506	位置圖
J853-SD-CW-4507	位置圖

修訂編號 Revision No.
24
25
26
9

圖則登記表
DRAWING REGISTER

接收日期 Receiving Date (適用於客戶圖則)

工程名稱 Project Title:	延坪道
	地台碼拆圖
工程編號 Project No:	J-853

年									
月									
日									

分發予 Distributed To

年	22								
月	1								
日	17								

圖則編號 Drg. No.	圖則名稱 Drawing Title
J853-SD-CW-4508	位置圖
J853-SD-CW-4509	位置圖
J853-SD-CW-4510	位置圖
J853-SD-CW-4601	位置圖
J853-SD-CW-4602	位置圖
J853-SD-CW-4603	位置圖
J853-SD-CW-4604	位置圖
J853-SD-CW-4605	位置圖
J853-SD-CW-4606	位置圖
J853-SD-CW-4607	位置圖
J853-SD-CW-4608	位置圖
J853-SD-CW-4609	位置圖

	修訂編號 Revision No.
49	-
50	-
51	-
52	-
53	-
54	-
55	-
56	-
57	-
58	-
59	-
60	-


10

EG-DWG4


美特鋁質有限公司 MIDI Aluminium Fabricator Ltd.					類別		物料號		
					制圖	陳俊賢	2021.10.29	圖號	853-BT01
修改					復核	謝永林	2021.12.21	數量	—
日期					批准	胡哥		位置	

數據表見: 853-BT01 (1)


此孔由地盤開

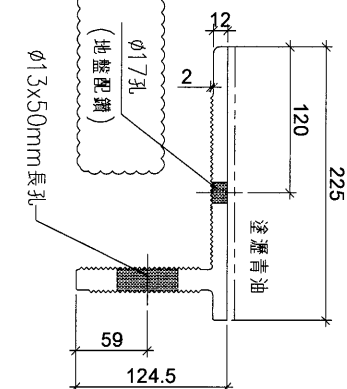

室外

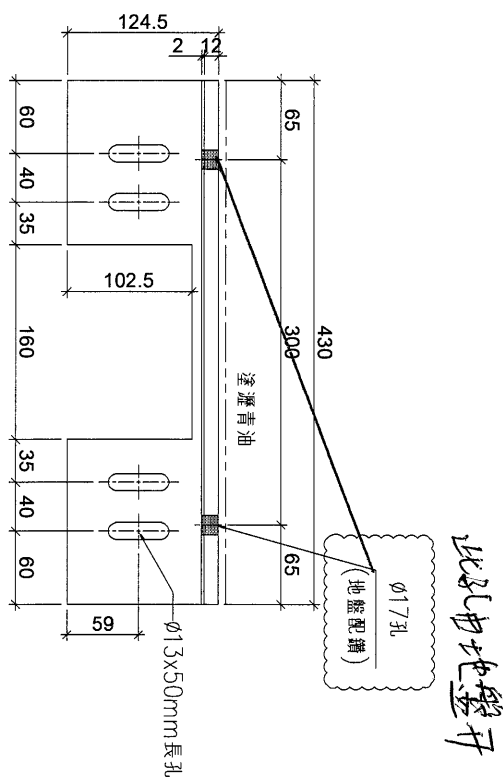

組裝示意圖

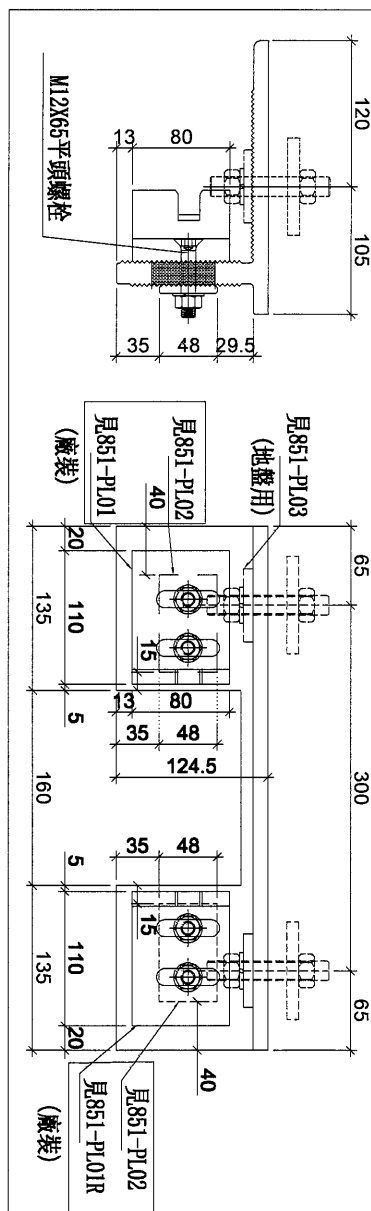

工程號	J853	地盤	延坪道	附 件
名稱	牆邊鋁碼	採用		
材料	X85996	地盤	✓	
顏色	塗瀝青油	工廠		



 美特鋁質有限公司 MIDI Aluminium Fabricator Ltd.					類別	物料號			
					制圖	陳俊賢	2021.10.29	圖號	853-BT01(1)
修改					復核	謝永林	2021.12.21	數量	-
日期					批准	胡哥		位置	

使用位置	數量	層數	總數	樓層	使用位置	數量	層數	總數	樓層
T1CW-A-1	3	16	48	5F-22F	T3CW-A-7	2	1	2	25F
	2	1	2	23F		2	1	2	26F
T1CW-B-1	3	16	48	5F-22F	T3CW-A-8	3	1	3	26F
	2	1	2	23F	T5CW-A-1	1	7	7	17F-23F
T1CW-A-2	3	16	48	5F-22F	T5CW-C-1	3	3	9	11F-15F
	2	1	2	23F		3	9	27	5F-15F
	4	1	4	25F	T5CW-A-2	2	1	2	16F
T1CW-B-2	1	2	2	23F-25F	T5CW-A-3	1	7	7	17F-23F
T1CW-A-4	1	16	16	5F-22F	T5CW-A-5	1	19	19	5F-26F
	6	16	96	5F-22F	T5CW-B-1	1	4	4	11F-16F
T1CW-B-3	1	6	6	23F		1	7	7	17F-23F
	1	8	8	25F	T5CW-A-6	2	2	4	25F-26F
T1CW-A-5	4	1	4	23F		2	9	18	16F-23F, 26F
	4	1	4	25F	T5CW-B-2	1	1	1	25F
T1CW-B-4	4	1	4	23F		3	8	24	17F-25F
	4	1	4	25F	T5CW-B-3	2	1	2	26F
T1CW-A-6	3	1	3	23F		3	4	12	11F-16F
	5	1	5	25F	T5CW-D-2	3	7	21	17F-23F
T2CW-A-1	1	9	9	17F-26F	T5CW-B-4	3	13	39	11F-26F
T2CW-A-2	1	17	17	5F-23F	T5CW-F-2	3	13	39	11F-26F
	3	9	27	5F-15F	T5CW-E-1	3	1	3	26F
T2CW-A-3	2	1	2	16F	T5CW-A-7	2	1	2	25F
	1	7	7	17F-23F		2	1	2	26F
T2CW-A-4	2	2	4	25F-26F	T5CW-B-5	3	1	3	25F
	1	7	7	17F-23F		3	1	3	26F
T2CW-A-5	1	7	7	17F-23F	T6CW-A-1	1	19	19	5F-26F
T2CW-C-1	3	19	57	5F-26F	T6CW-A-2	1	19	19	5F-26F
T2CW-B-1	2	19	38	5F-26F	T6CW-A-3	2	19	38	5F-26F
T2CW-C-2	2	19	38	5F-26F	T6CW-B-1	2	19	38	5F-26F
T2CW-B-2	3	19	57	5F-26F	T6CW-B-2	3	19	57	5F-26F
	2	1	2	25F	T7CW-A-4	2	17	34	7F-26F
T2CW-A-7	2	1	2	26F	T7CW-A-5	3	17	51	7F-26F
	2	1	2	26F	T7CW-B-4	3	15	45	7F-23F
T2CW-A-8	3	1	3	26F	T6CW-C-2	3	14	42	10F-26F
T3CW-A-1	1	7	7	17F-23F	T6CW-D-2	1	14	14	10F-26F
T3CW-A-2	1	9	9	17F-26F	T7CW-B-6	1	17	17	7F-26F
T3CW-A-3	1	17	17	5F-23F		3	13	39	9F-23F
	3	9	27	5F-15F	T7CW-B-7	3	1	3	8F
T3CW-A-4	2	1	2	16F		5	1	5	25F
	1	7	7	17F-23F	T7CW-B-8	8	1	8	26F
T3CW-A-5	2	2	4	25F-26F	合計:	~~1530~~ 1530			
T3CW-C-1	3	19	57	5F-26F					
T3CW-C-2	2	19	38	5F-26F					
T3CW-B-1	2	19	38	5F-26F					
T3CW-B-2	3	19	57	5F-26F					

工程號	J853	地盤	延坪道	附 件	拆圖見:853-BT01	預15後備數。 多
名稱	牆邊鋁碼(數據表)		採用			
材料	X85996		地盤			
顏色	MILL		工廠			

美特鋁質有限公司 MIDI Aluminium Fabricator Ltd.					類別		物料號		
修改					制圖	陳俊賢	2021.10.29	圖號	853-BT01a
日期					復核	謝永林	2021.12.21	數量	—
					批准	胡哥		位置	

使用位置	數量	層數	總數	樓層
T1CW-A-5	4	1	4	23F
T1CW-B-4	4	1	4	23F
T2CW-A-7	2	1	2	25F
T3CW-A-7	2	1	2	25F
T5CW-A-8	3	1	3	25F
T7CW-A-7	3	1	3	8F
T7CW-B-8	5	1	5	8F

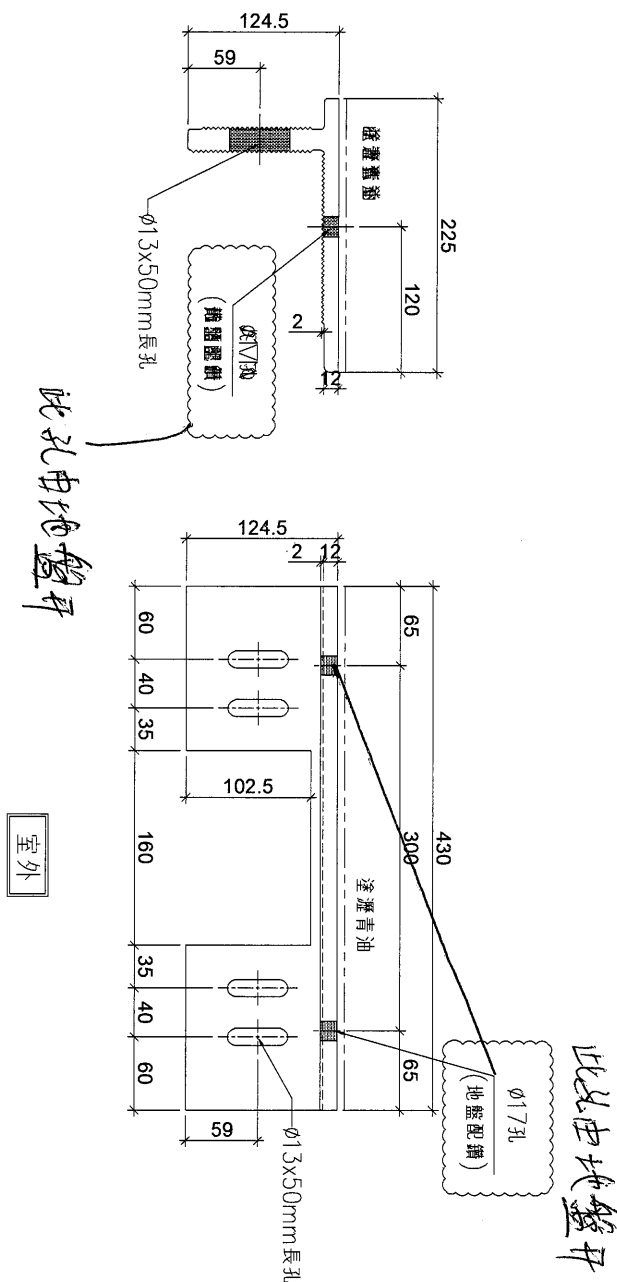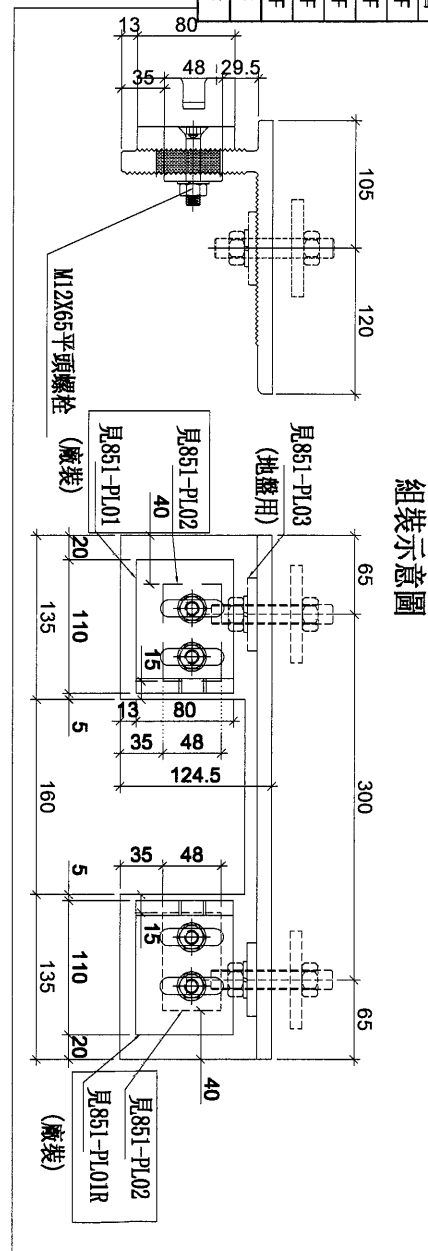



工程號	J853	地盤	延坪道	附件
名稱	牆邊鋁碼	採用		
材料	X85996	地盤	✓	
顏色	塗瀝青油	工廠		

(13)


EG-DWG4


 美特鋁質有限公司 MIDI Aluminium Fabricator Ltd.				類別		物料號	
				制圖	陳俊賢	2021.10.29	圖號 853-BT02
修改				復核	謝永林	2021.12.21	數量 -
日期				批准	胡哥		位置

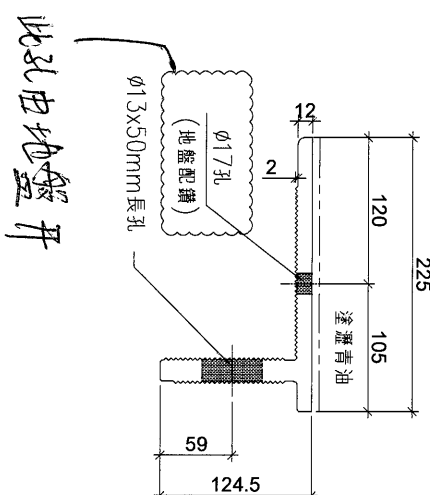

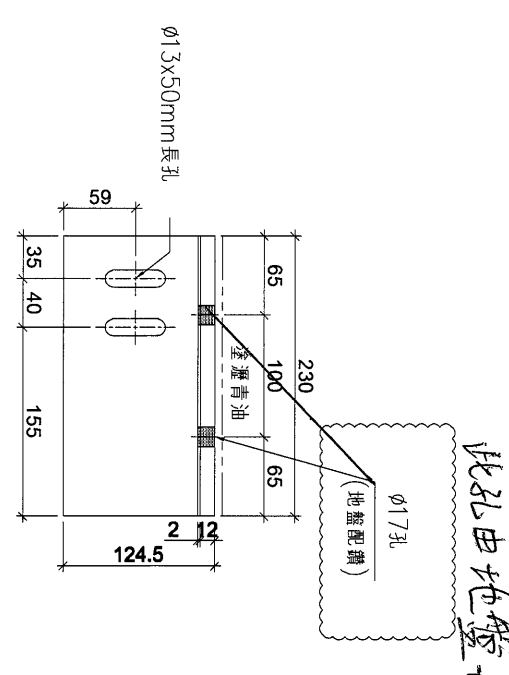



室外

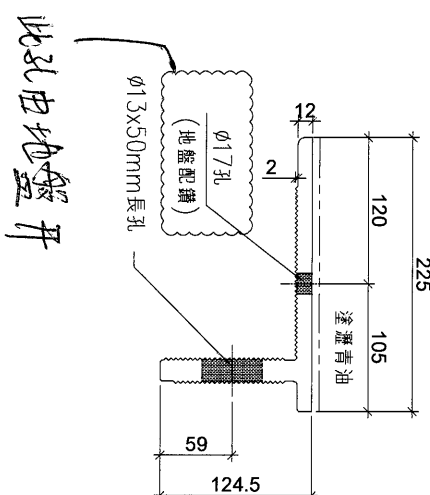

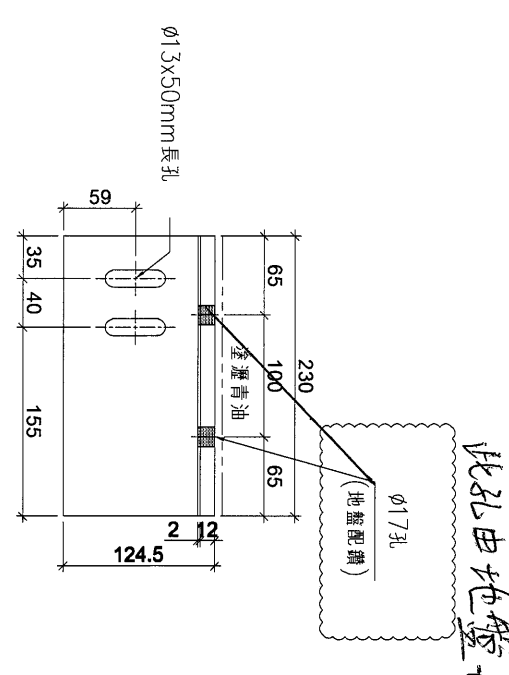



室外

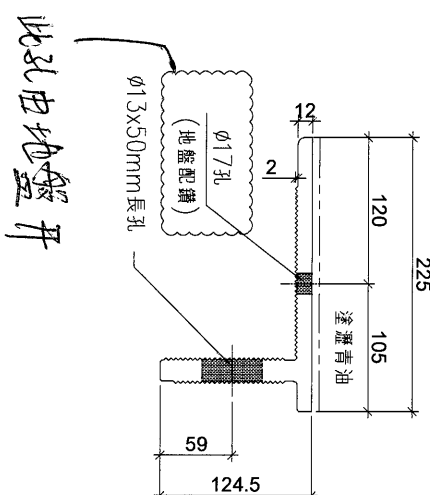

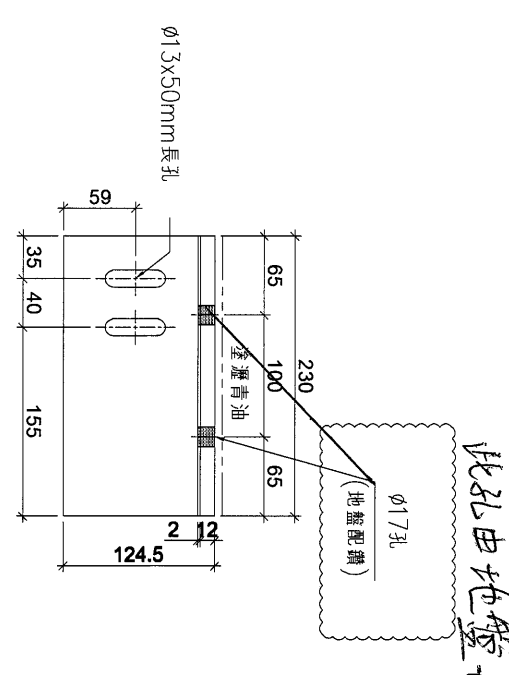



室外

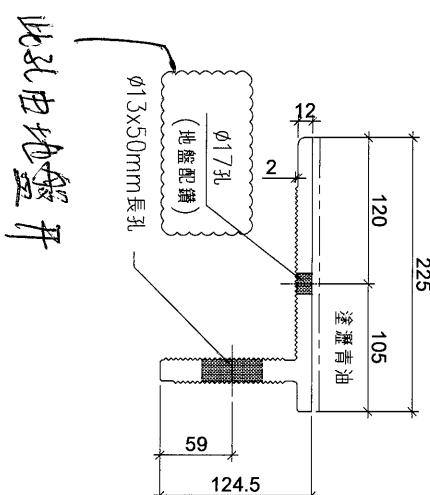

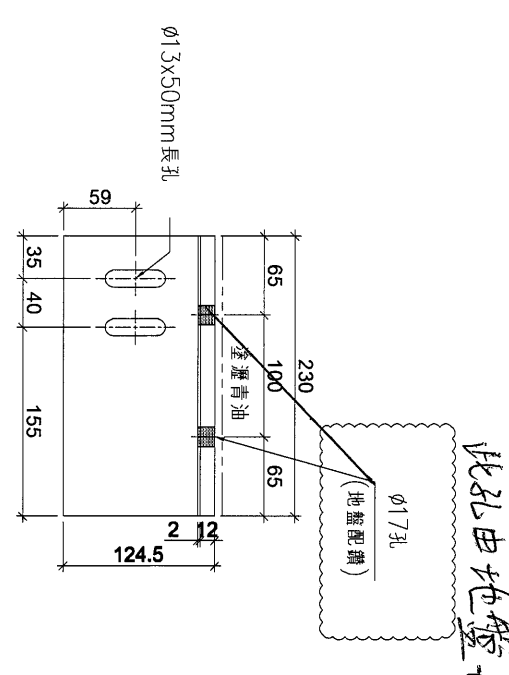



室外

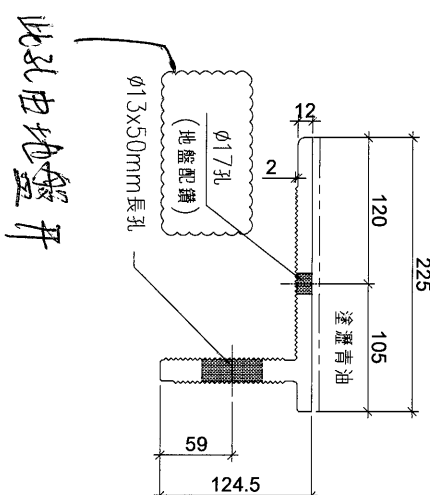

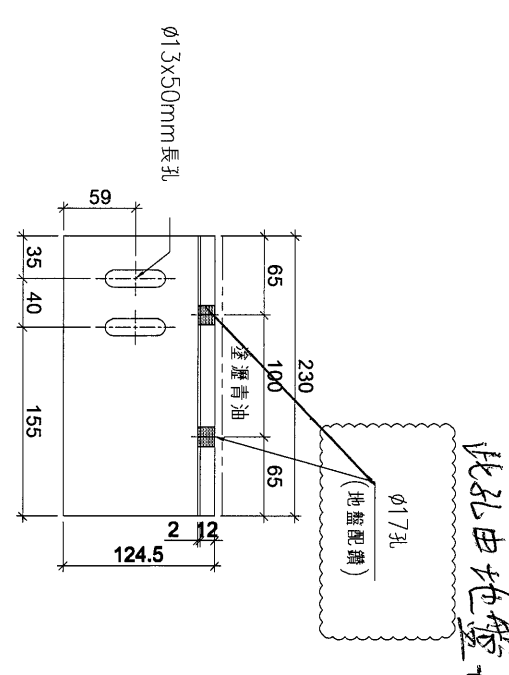



室外

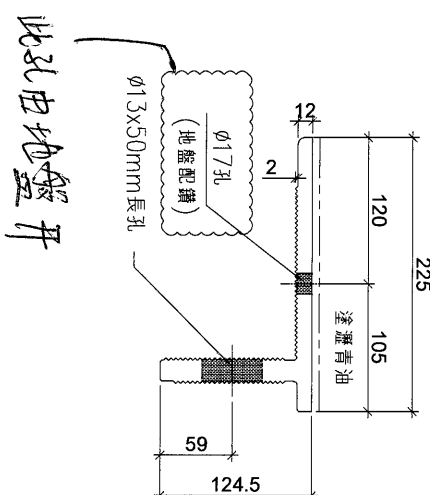

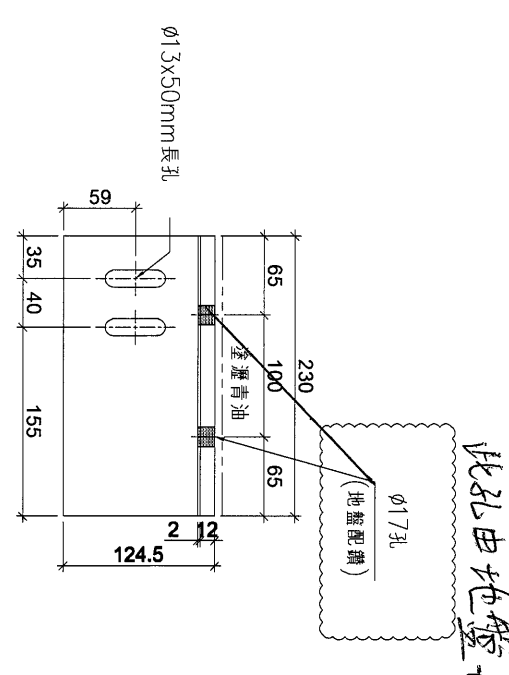



室外

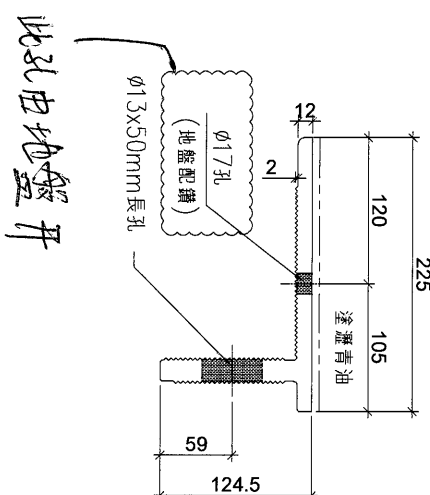

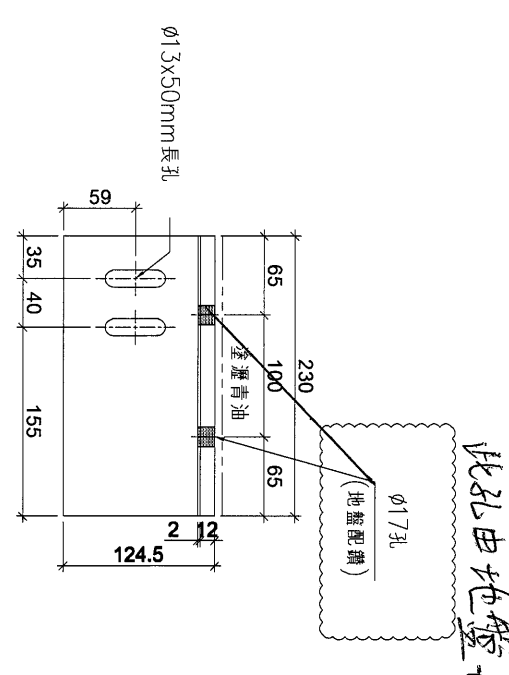



室外

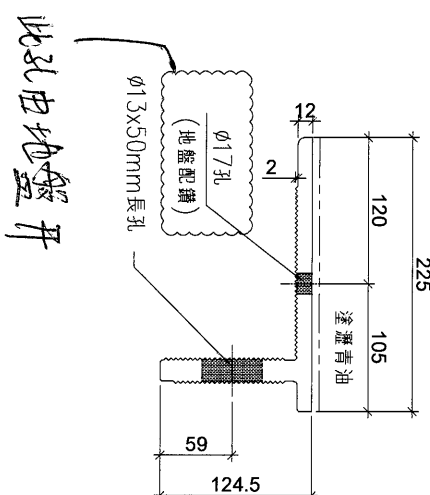

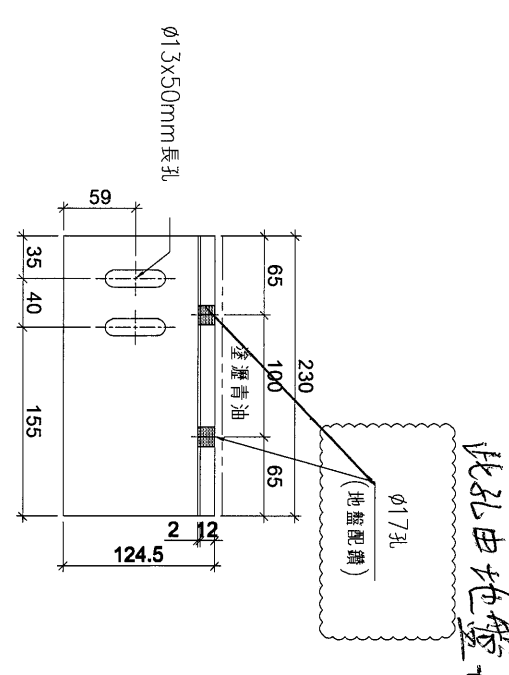



室外

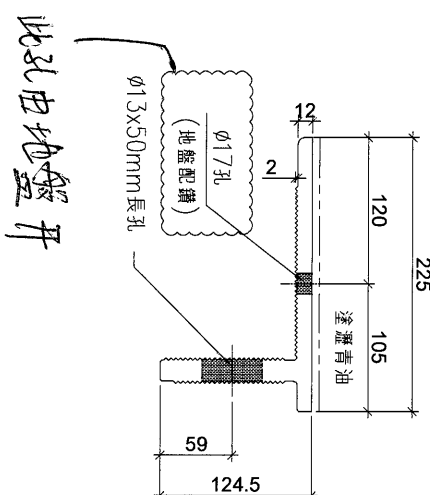

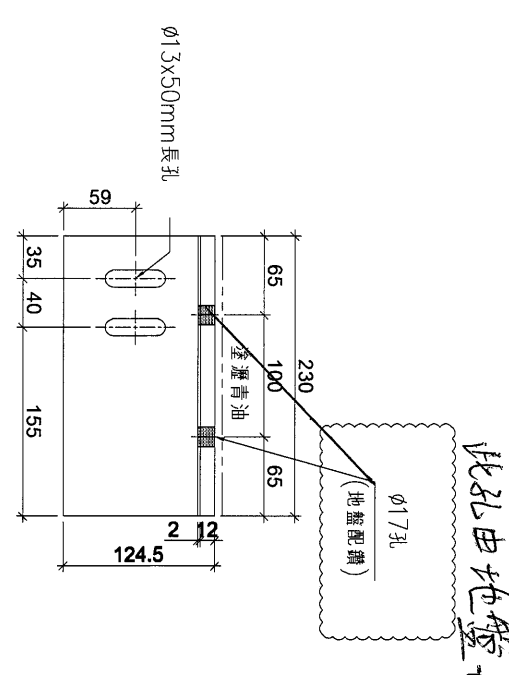



室外

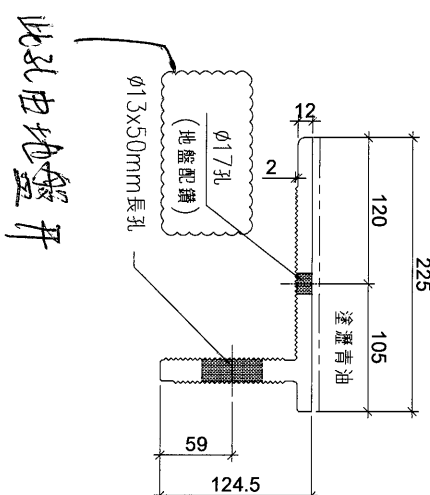

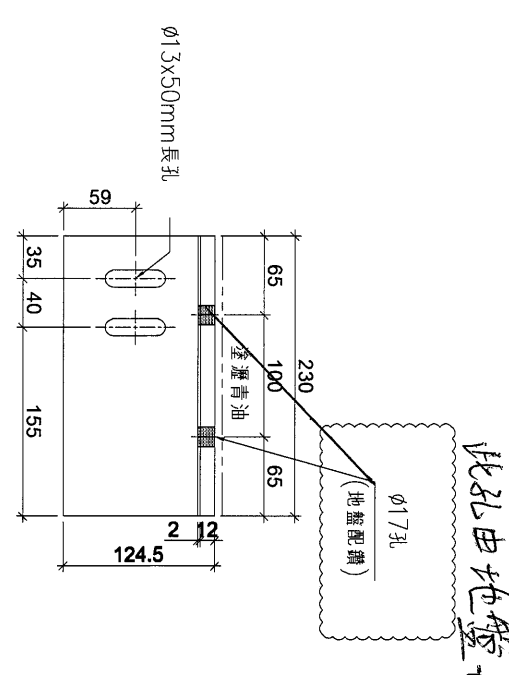



室外

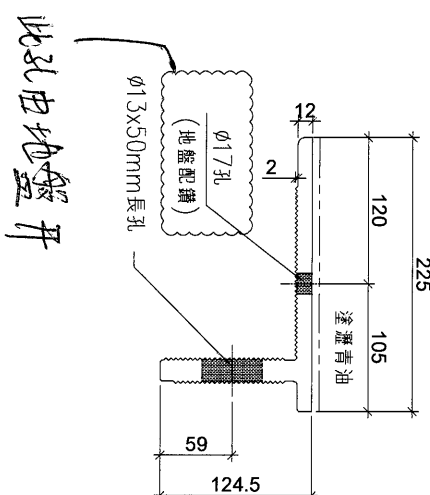

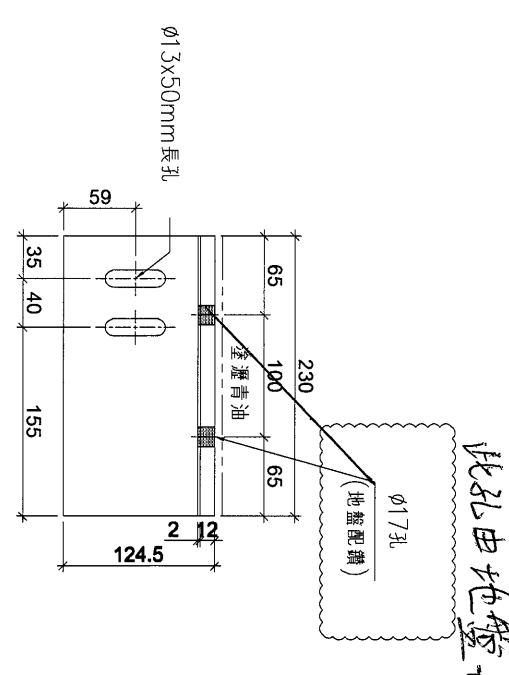



室外

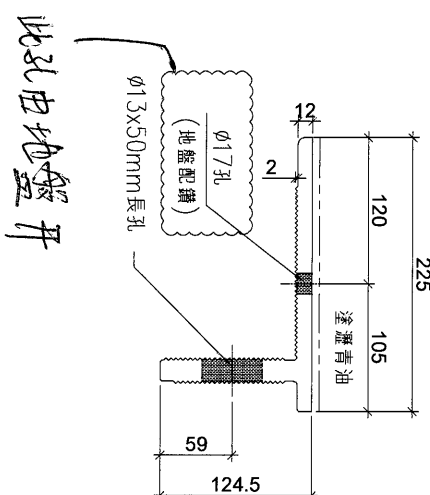

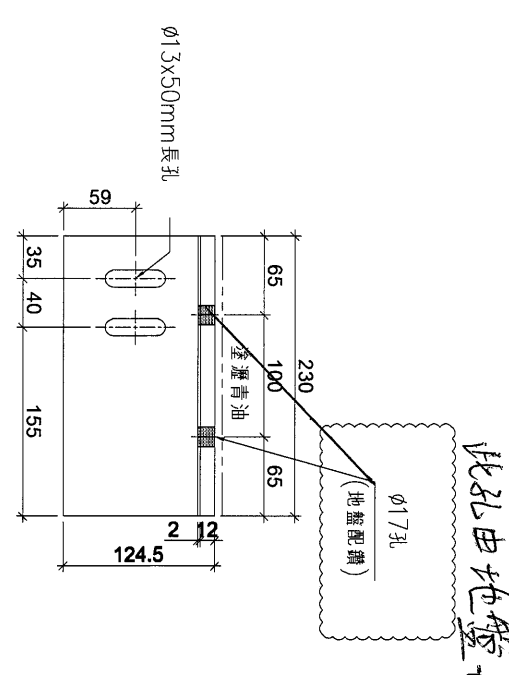



室外

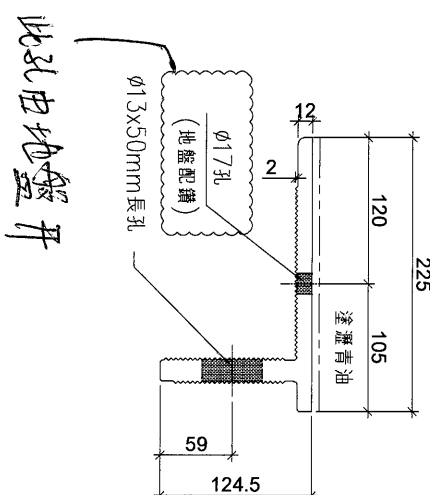

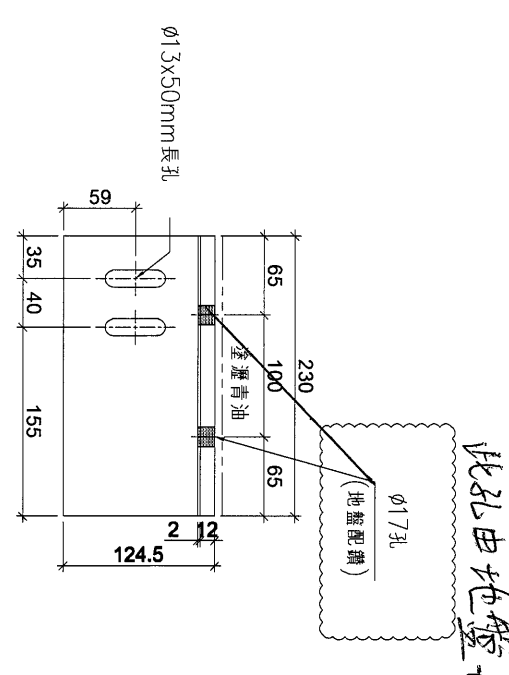



室外

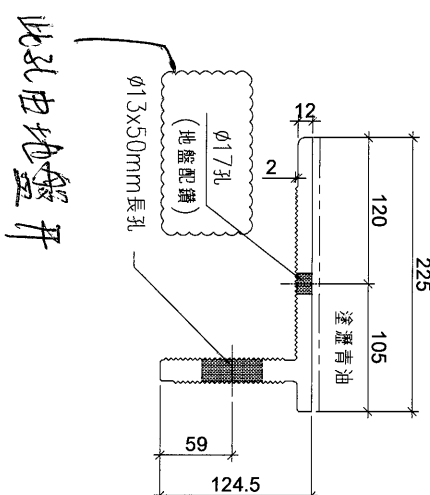

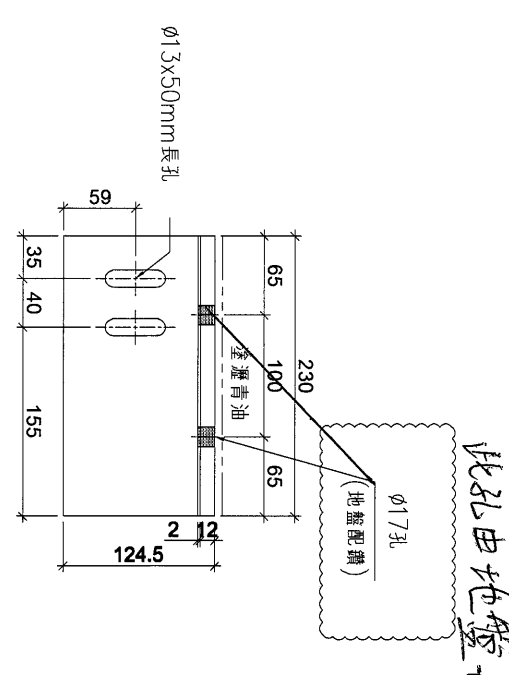



室外

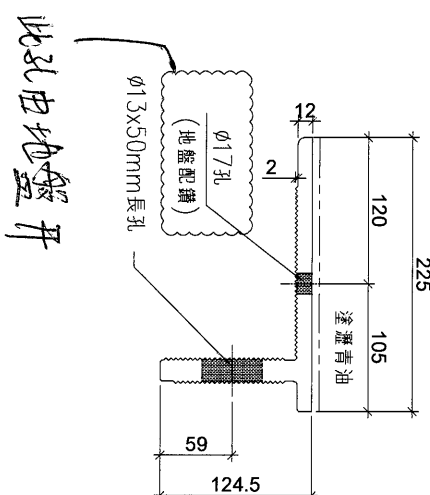

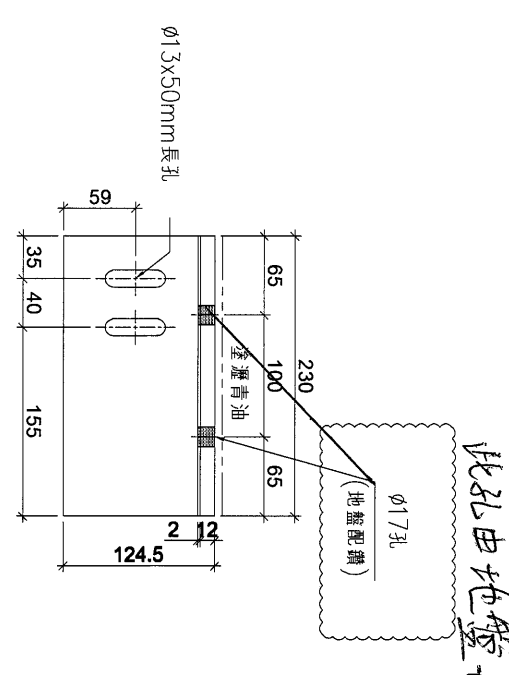



室外

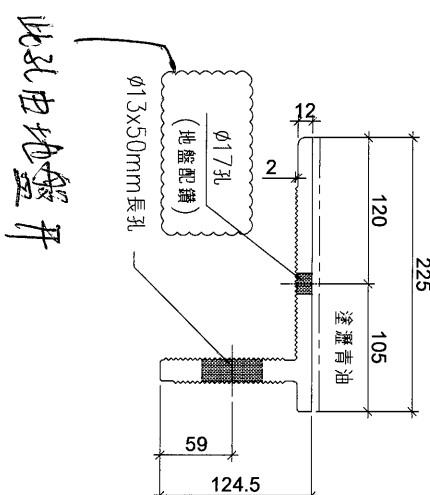

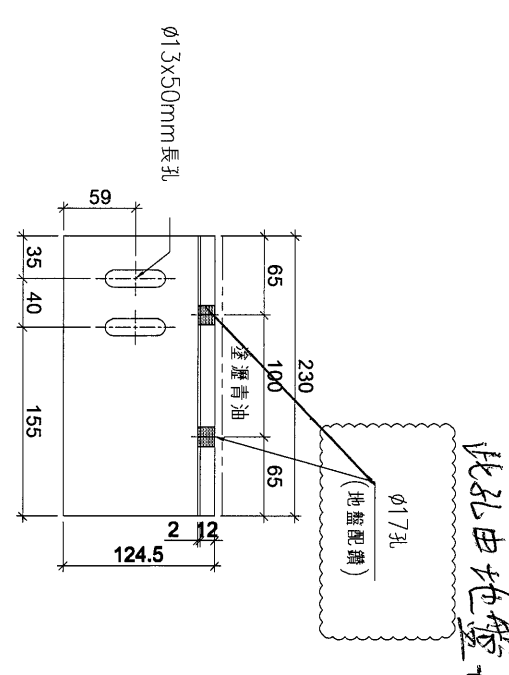



室外

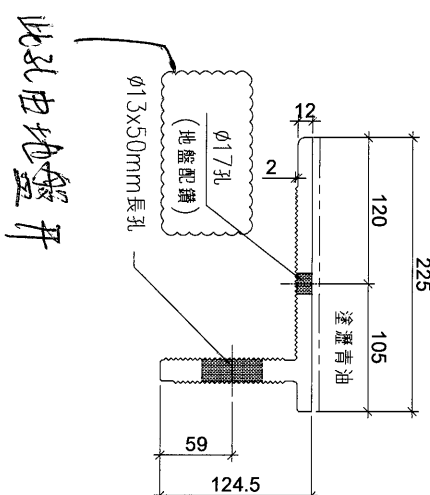

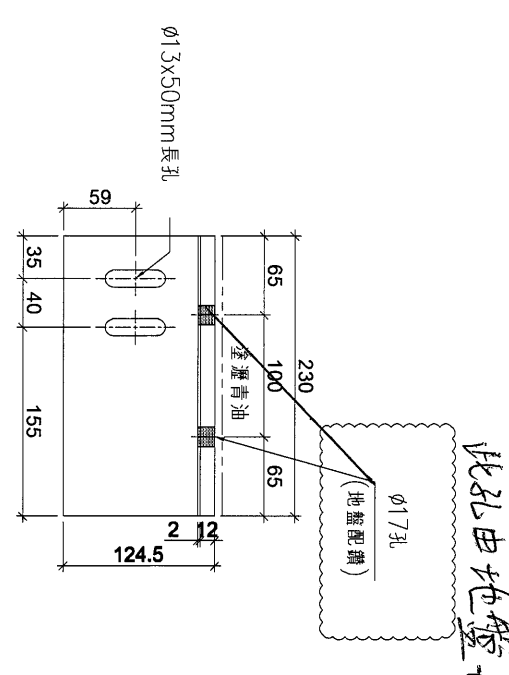



室外

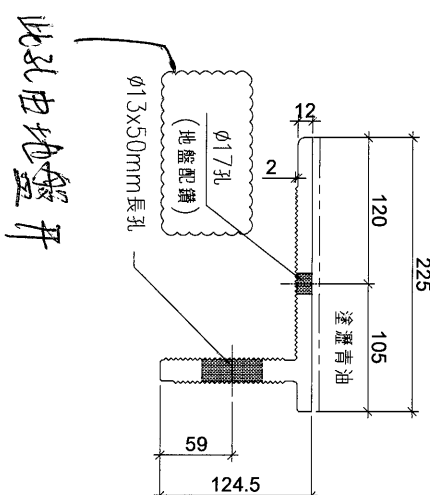

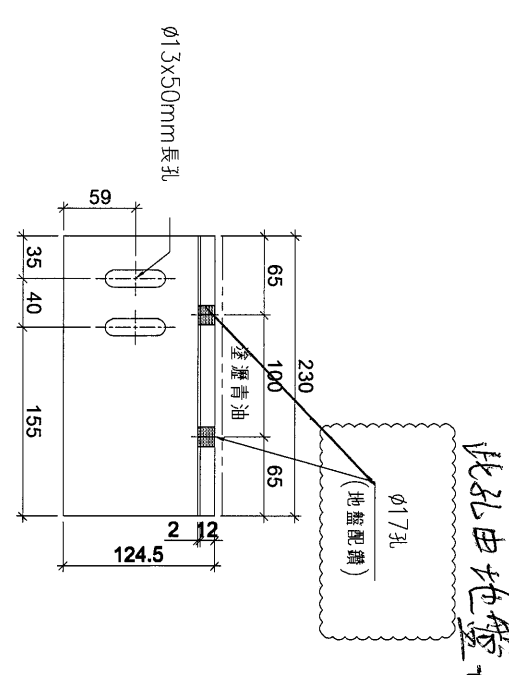



室外

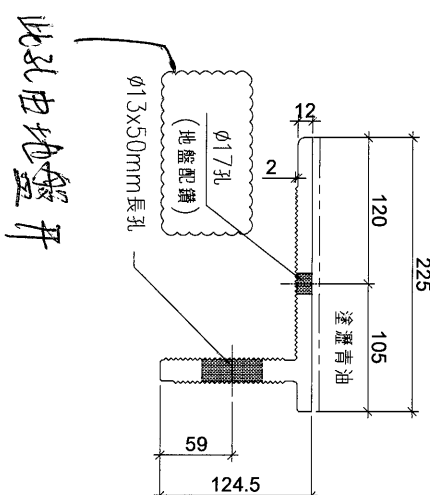

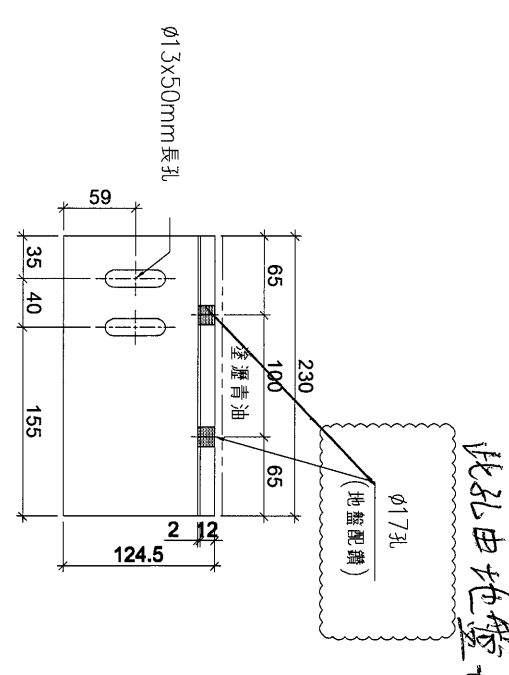



室外

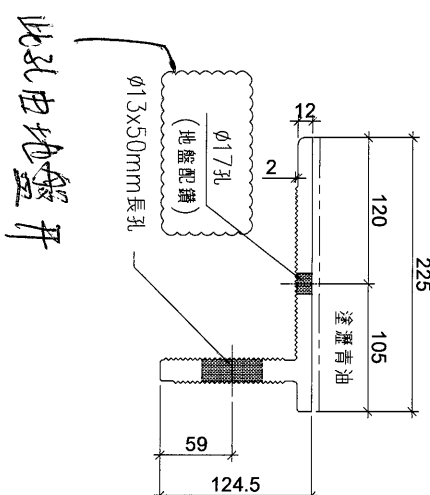

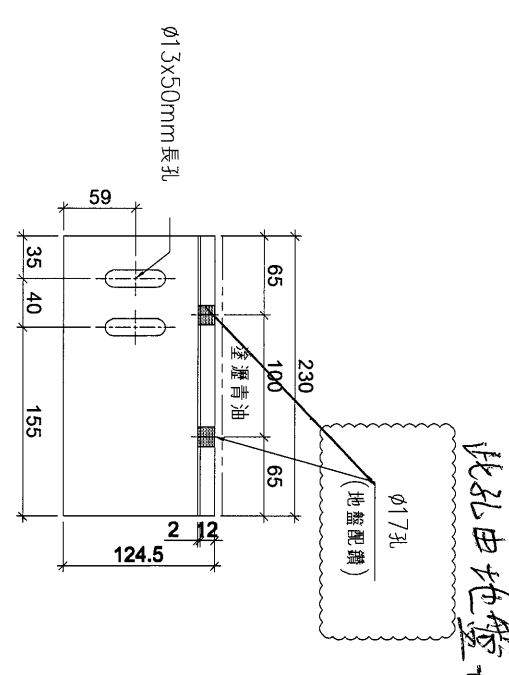



室外

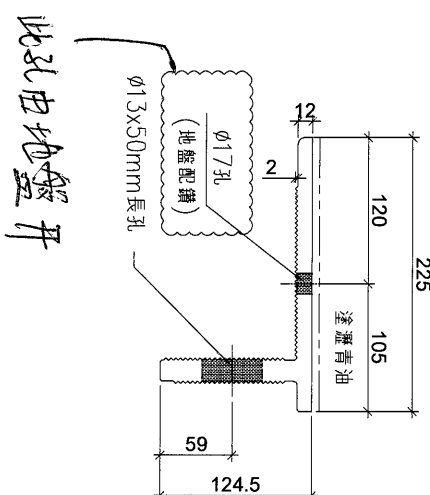

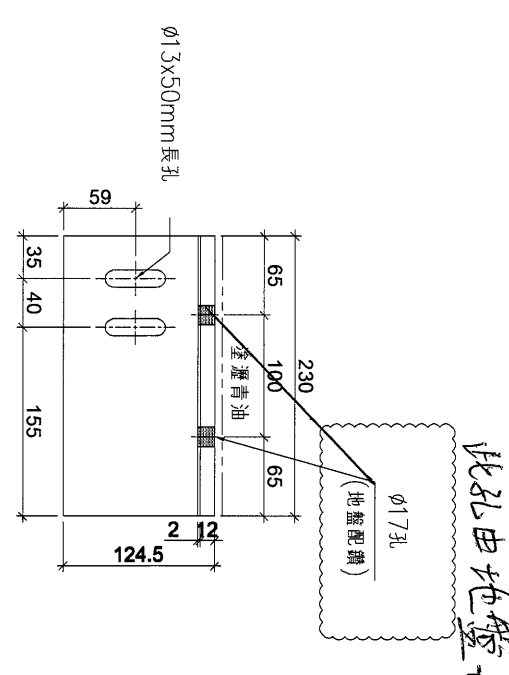



室外

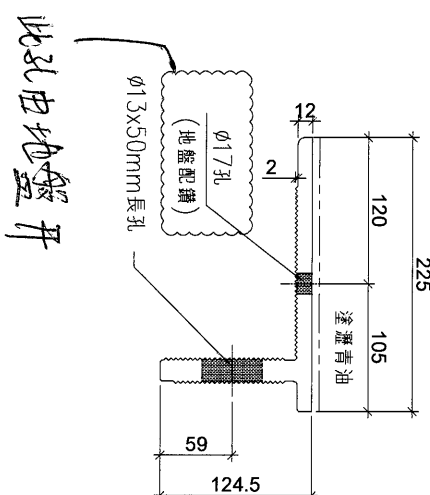

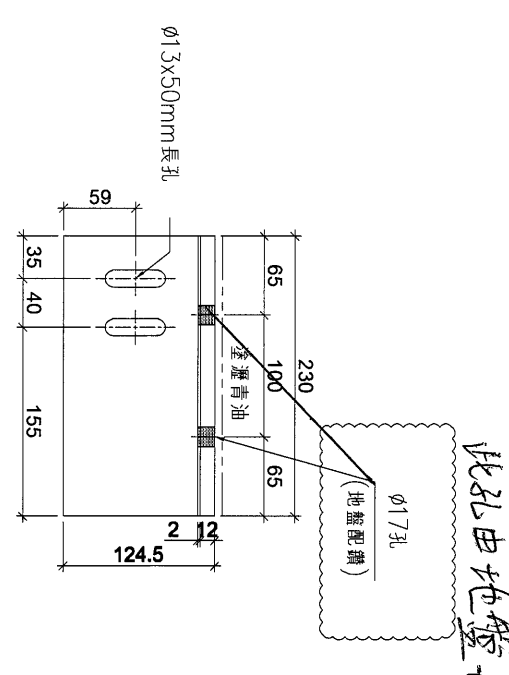



室外

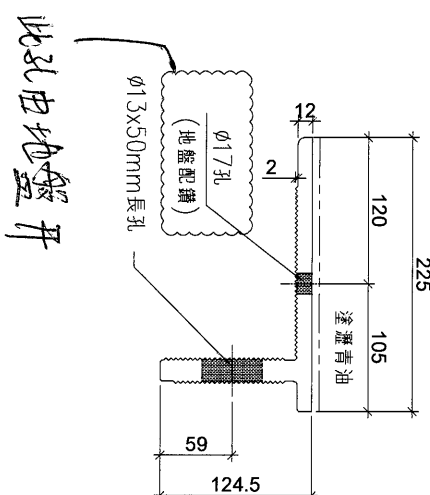

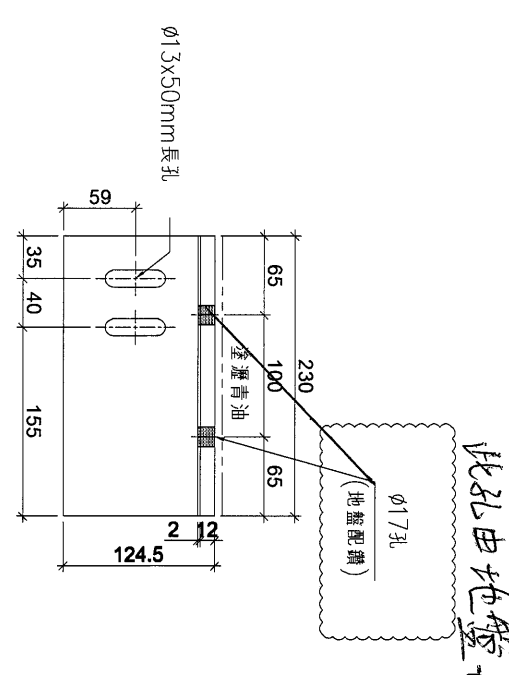



室外

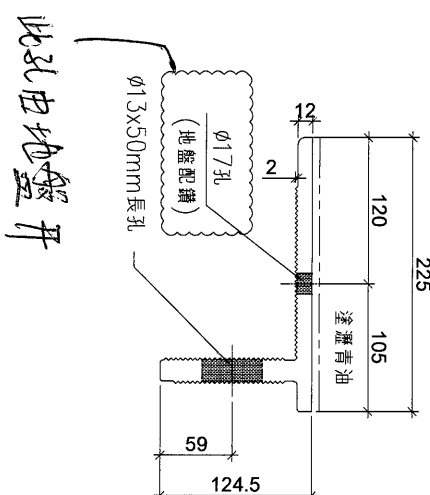

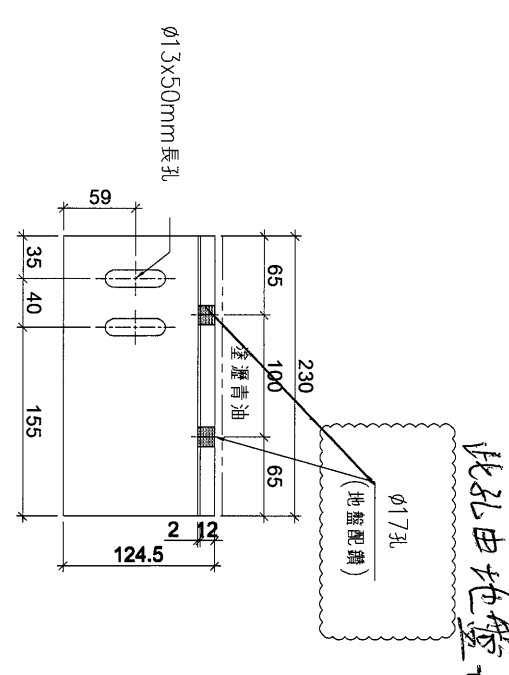



室外

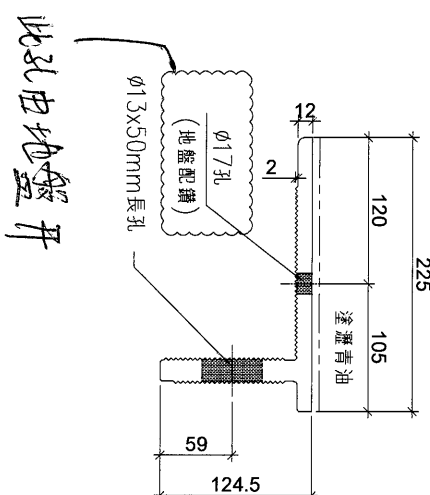

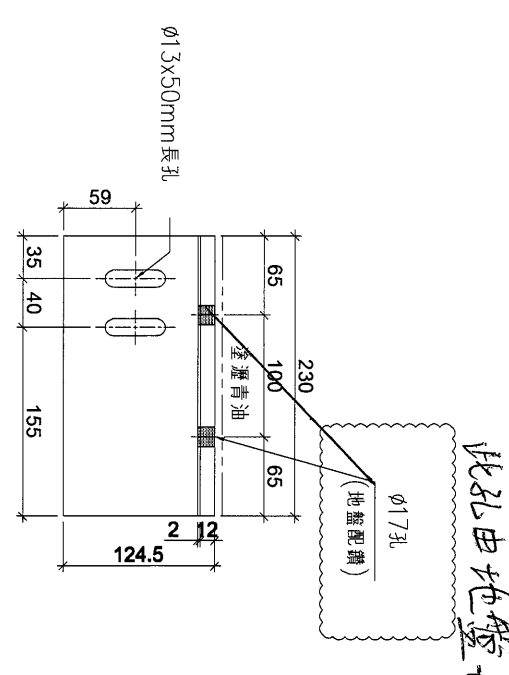



室外

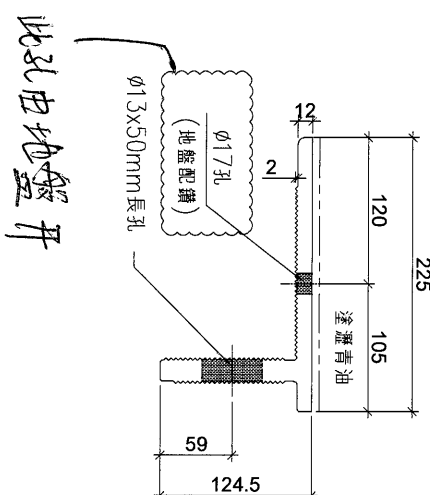

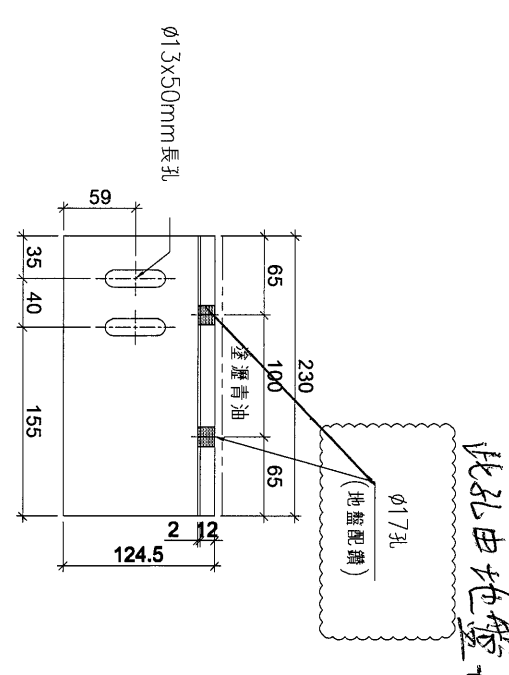


室外

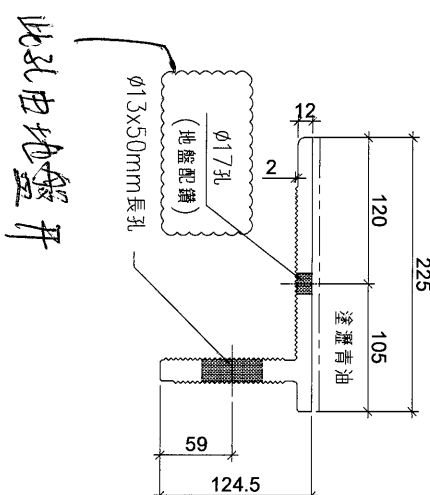

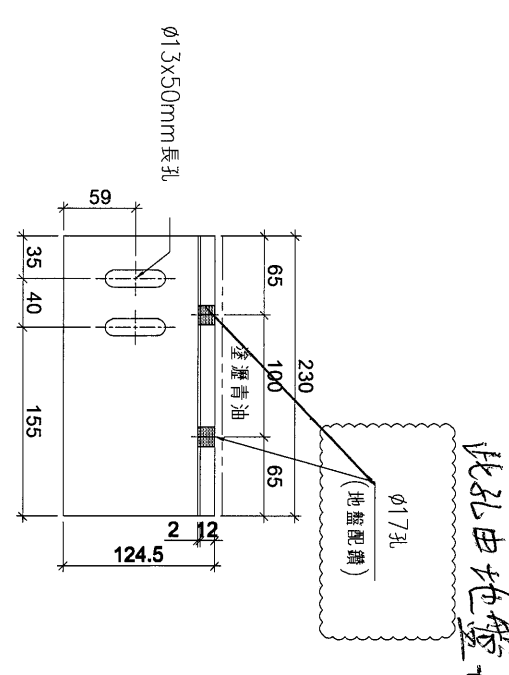

室外

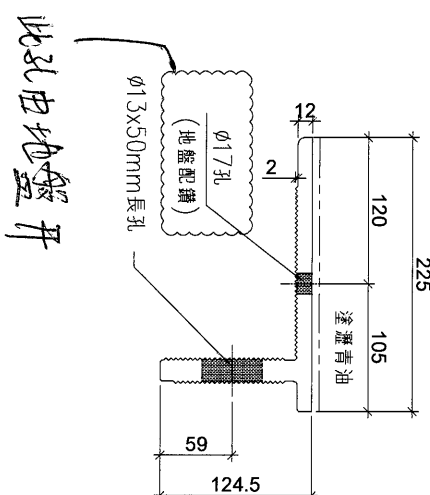

 美特鋁質有限公司 MIDI Aluminium Fabricator Ltd.				類別	物料號			
制圖 陳俊賢 2021.10.29				圖號	853-BT02(1)			
修改 日期				復核 謝永林 2021.12.21	數量	-		
				批准 胡哥	位置			

使用位置	數量	層數	總數	樓層
T1CW-A-1	2	16	32	5F-22F
	1	1	1	23F
T1CW-B-1	2	16	32	5F-22F
	1	1	1	23F
T1CW-A-2	1	18	18	5F-25F
T1CW-A-3	1	16	16	5F-22F
T1CW-A-4	1	16	16	5F-22F
T1CW-B-2	1	18	18	5F-25F
T1CW-B-3	2	16	32	5F-22F
	1	18	18	5F-25F
T1CW-A-5	2	1	2	25F
T1CW-B-4	2	1	2	25F
T1CW-A-6	4	1	4	23F
	1	1	1	25F
T2CW-A-1	1	19	19	5F-26F
T2CW-A-2	1	17	17	5F-23F
T2CW-A-3	1	9	9	5F-15F
	2	1	2	16F
T2CW-A-4	1	7	7	17F-23F
	1	2	2	25F-26F
T2CW-D-1	1	10	10	5F-16F
T2CW-A-5	1	7	7	17F-23F
T2CW-C-1	1	19	19	5F-26F
T2CW-B-1	1	19	19	5F-26F
T2CW-C-2	1	19	19	5F-26F
T2CW-B-2	1	19	19	5F-26F
T2CW-A-6	1	9	9	6F-16F
	1	1	1	5F
T2CW-A-7	1	1	1	25F
	1	1	1	26F
T2CW-A-8	1	1	1	26F
T3CW-D-1	1	10	10	5F-16F
T3CW-A-1	1	7	7	17F-23F
T3CW-A-2	1	19	19	5F-26F
T3CW-A-3	1	17	17	5F-23F
T3CW-A-4	1	9	9	5F-15F
	2	1	2	16F
T3CW-A-5	1	7	7	17F-23F
	1	2	2	25F-26F
T3CW-C-1	1	19	19	5F-26F
T3CW-C-2	1	19	19	5F-26F
T3CW-B-1	1	19	19	5F-26F
T3CW-B-2	1	19	19	5F-26F
T3CW-A-6	1	9	9	6F-16F
	1	1	1	5F
T3CW-A-7	1	1	1	25F
	1	1	1	26F

使用位置	數量	層數	總數	樓層
T3CW-A-8	1	1	1	26F
T5CW-A-1	1	17	17	5F-23F
T5CW-C-1	1	3	3	1 F-15F
T5CW-A-2	1	9	9	5F-15F
	2	1	2	16F
T5CW-A-3	1	7	7	17F-23F
T5CW-A-5	1	19	19	5F-26F
T5CW-B-1	1	10	10	5F-16F
	1	4	4	11F-16F
T5CW-A-6	1	7	7	17F-23F
	1	2	2	25F-26F
T5CW-C-2	1	3	3	11F-15F
T5CW-B-2	1	10	10	16F-26F
T5CW-D-1	1	11	11	11F-23F
T5CW-B-3	2	9	18	17F-26F
T5CW-D-2	1	4	4	11F-16F
T5CW-B-4	1	7	7	17F-23F
T5CW-F-1	1	13	13	11F-26F
T5CW-F-2	1	13	13	11F-26F
T5CW-E-1	1	13	13	11F-26F
T5CW-A-7	1	1	1	26F
T5CW-B-5	2	1	2	25F
	2	1	2	26F
T5CW-A-8	1	1	1	25F
	1	1	1	26F
T6CW-A-1	1	19	19	5F-26F
T6CW-A-2	1	19	19	5F-26F
T6CW-A-3	1	19	19	5F-26F
T6CW-B-1	1	19	19	5F-26F
T6CW-B-2	1	19	19	5F-26F
T7CW-A-4	1	17	17	7F-26F
T7CW-A-5	1	17	17	7F-26F
T7CW-B-3	1	15	15	7F-23F
T7CW-B-4	1	15	15	7F-23F
T7CW-B-5	1	16	16	7F-25F
T6CW-C-1	1	14	14	10F-26F
T6CW-C-2	1	14	14	10F-26F
T6CW-D-1	1	14	14	10F-26F
T6CW-D-2	1	14	14	10F-26F
T7CW-B-6	1	17	17	7F-26F
T7CW-B-7	1	13	13	9F-23F
	1	1	1	8F
T7CW-B-8	1	1	1	25F
	1	1	1	26F
合計:			960	

工程號	J853	地盤	延坪道	附件
名稱	牆邊鋁碼(數據表)		採用	
材料	X85996		地盤	
顏色	MILL		工廠	

拆圖見:853-BT02

預多10後備數

美特鋁質有限公司 MIDI Aluminium Fabricator Ltd.					類別	物料號			
					制圖	陳俊賢	2021.10.29	圖號	853-BT02a
					復核	謝永林	2021.12.21	數量	-
					批准	胡哥		位置	
修改									
日期									

使用位置	數量	層數	總數	樓層
T1CW-A-5	1	1	1	23F
T1CW-B-4	1	1	1	23F
T1CW-A-6	2	1	2	23F
T2CW-A-6	1	1	1	5F
T2CW-A-7	1	1	1	25F
T3CW-A-6	1	1	1	5F
T3CW-A-7	1	1	1	25F
T5CW-A-8	1	1	1	25F
T7CW-A-7	1	1	1	8F
T7CW-B-8	1	1	1	8F

124.5

59

105

225

120

2

17

13

124.5

59

35

40

155

2

12

124.5

230

65

100

65

124.5

59

105

120

225

2

17

13

124.5

59

35

40

155

2

12

124.5

230

65

100

65

124.5

59

105

120

225

2

17

13

124.5

59

35

40

155

2

12

124.5

230

65

100

65

124.5

59

105

120

225

2

17

13

124.5

59

35

40

155

2

12

124.5

230

65

100

65

124.5

59

105


<

(16)




EG-DWG4

美特鋁質有限公司 MIDI Aluminium Fabricator Ltd.					類別		物料號		
修改					制圖	陳俊賢	2021.10.29	圖號	853-BT03
日期					復核	謝永林	2021.12.21	數量	—
					批准	胡哥		位置	

數據表見: 853-BT03 (1)

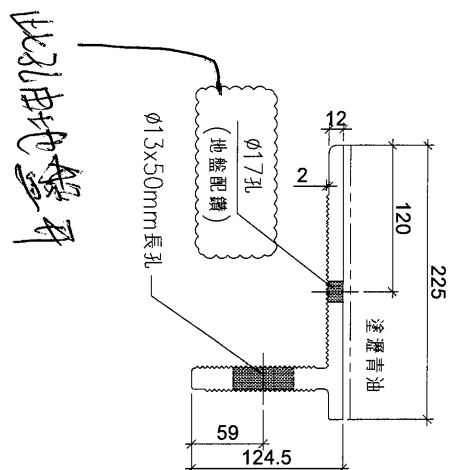

室外

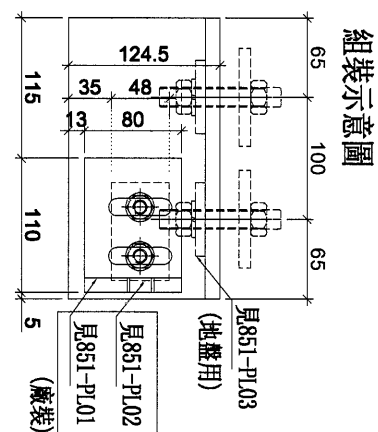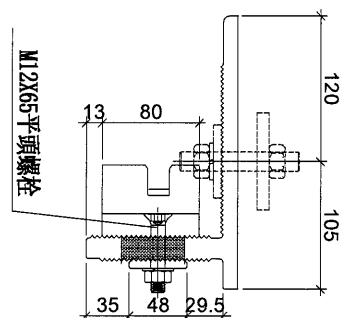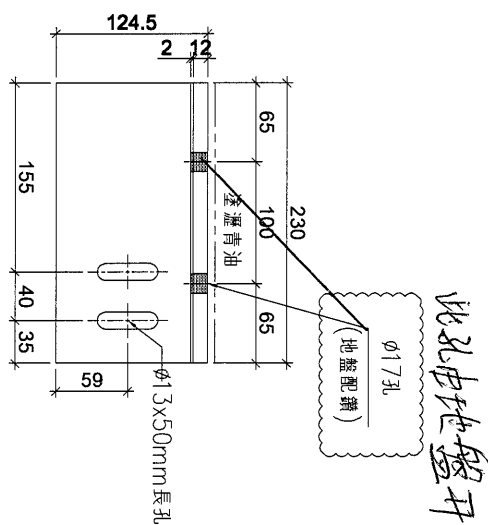

組裝示意圖

工程號	J853	地盤	延坪道	附件	
名稱	牆邊鋁碼	採用			
材料	X85996	地盤	✓		
顏色	塗瀝青油	工廠			

(17)

EG-DWG4

 美特鋁質有限公司 MIDI Aluminium Fabricator Ltd.					類別	物料號			
					制圖	陳俊賢	2021.10.29	圖號	853-BT03(1)
修改					復核	謝永林	2021.12.21	數量	-
日期					批准	胡哥		位置	

使用位置	數量	層數	總數	樓層	使用位置	數量	層數	總數	樓層
T1CW-A-1	2	16	32	5F-22F	T5CW-C-1	1	3	3	11F-15F
	1	1	1	23F					
T1CW-B-1	2	16	32	5F-22F	T5CW-A-2	1	9	9	5F-15F
	1	1	1	23F		2	1	2	16F
T1CW-A-2	1	18	18	5F-25F	T5CW-A-3	1	7	7	17F-23F
T1CW-A-3	1	16	16	5F-22F	T5CW-A-5	1	19	19	5F-26F
T1CW-A-4	1	16	16	5F-22F	T5CW-B-1	1	10	10	5F-16F
T1CW-B-2	1	18	18	5F-25F		1	4	4	11F-16F
T1CW-B-3	2	16	32	5F-22F	T5CW-A-6	1	7	7	17F-23F
	1	18	18	5F-25F		1	2	2	25F-26F
T1CW-A-5	1	1	1	23F	T5CW-C-2	1	3	3	11F-15F
	1	1	1	25F	T5CW-B-2	1	10	10	16F-26F
T1CW-B-4	1	1	1	23F	T5CW-D-1	1	11	11	11F-23F
	1	1	1	25F	T5CW-B-3	2	9	18	17F-26F
T1CW-A-6	4	1	4	23F	T5CW-D-2	1	4	4	11F-16F
	1	1	1	25F	T5CW-B-4	1	7	7	17F-23F
T2CW-A-1	1	19	19	5F-26F	T5CW-F-1	1	13	13	11F-26F
T2CW-A-2	1	17	17	5F-23F	T5CW-F-2	1	13	13	11F-26F
T2CW-A-3	1	9	9	5F-15F	T5CW-E-1	1	13	13	11F-26F
	2	1	2	16F	T5CW-A-7	1	1	1	26F
T2CW-A-4	1	7	7	17F-23F					
	1	2	2	25F-26F	T5CW-B-5	2	1	2	25F
T2CW-C-1	1	19	19	5F-26F		2	1	2	26F
T2CW-B-1	1	19	19	5F-26F	T5CW-A-8	1	1	1	25F
T2CW-C-2	1	19	19	5F-26F		1	1	1	26F
T2CW-B-2	1	19	19	5F-26F	T6CW-A-1	1	19	19	5F-26F
T2CW-A-6	1	9	9	6F-16F	T6CW-A-2	1	19	19	5F-26F
	1	1	1	5F	T6CW-A-3	1	19	19	5F-26F
T2CW-A-7	1	1	1	25F	T6CW-B-1	1	19	19	5F-26F
	1	1	1	26F	T6CW-B-2	1	19	19	5F-26F
T2CW-A-8	1	1	1	26F	T7CW-A-4	1	17	17	7F-26F
T3CW-A-2	1	19	19	5F-26F	T7CW-A-5	1	17	17	7F-26F
T3CW-A-3	1	17	17	5F-23F	T7CW-B-3	1	15	15	7F-23F
T3CW-A-4	1	9	9	5F-15F	T7CW-B-4	1	15	15	7F-23F
	2	1	2	16F	T7CW-B-5	1	16	16	7F-25F
T3CW-A-5	1	7	7	17F-23F	T6CW-C-1	1	14	14	10F-26F
	1	2	2	25F-26F	T6CW-C-2	1	14	14	10F-26F
T3CW-C-1	1	19	19	5F-26F	T6CW-D-1	1	14	14	10F-26F
T3CW-C-2	1	19	19	5F-26F	T6CW-D-2	1	14	14	10F-26F
T3CW-B-1	1	19	19	5F-26F	T7CW-B-6	1	17	17	7F-26F
T3CW-B-2	1	19	19	5F-26F	T7CW-B-7	1	13	13	9F-23F
T3CW-A-6	1	9	9	6F-16F		1	1	1	8F
	1	1	1	5F	T7CW-B-8	1	1	1	25F
T3CW-A-7	1	1	1	25F		1	1	1	26F
	1	1	1	26F	合計:	~~908~~ 926			
T3CW-A-8	1	1	1	26F					
T5CW-A-1	1	17	17	5F-23F					


工程號	J853	地盤	延坪道	附 件	拆圖見:853-BT03	預多10隻備數.	
名稱	牆邊鋁碼(數據表)		採用				
材料	X85996		地盤				✓
顏色	MILL		工廠				

18


EG-DWG4

 美特鋁質有限公司 MIDI Aluminium Fabricator Ltd.				類別	物料號		
				制圖	陳俊賢	2021.10.29	圖號
				復核	謝永林	2021.12.21	數量
				批准	胡哥		位置
修改							
日期							


使用位置	數量	層數	總數	樓層
T1CW-A-5	1	1	1	23F
T1CW-B-4	1	1	1	23F
T1CW-A-6	2	1	2	23F
T2CW-A-6	1	1	1	5F
T2CW-A-7	1	1	1	25F
T3CW-A-6	1	1	1	5F
T3CW-A-7	1	1	1	25F
T5CW-A-8	1	1	1	25F
T7CW-A-7	1	1	1	8F
T7CW-B-8	1	1	1	8F

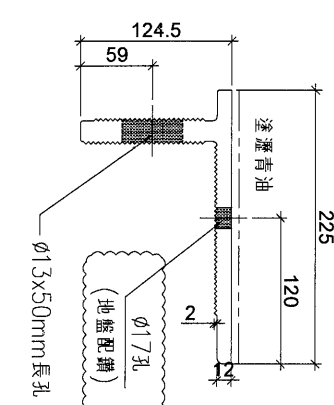


此孔由地盤開

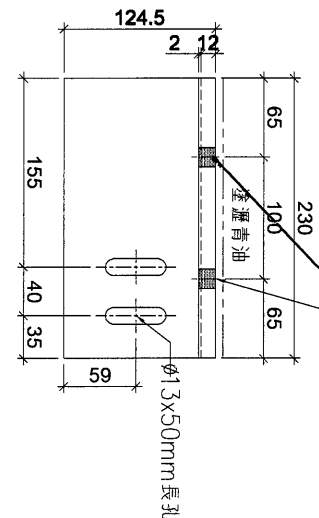

此孔由地盤開

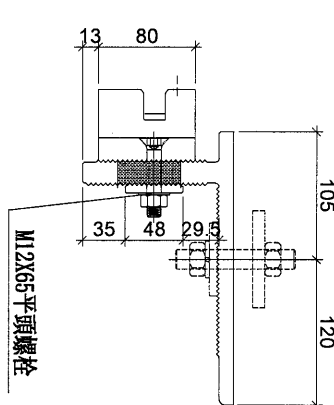

M12X65平頭螺栓

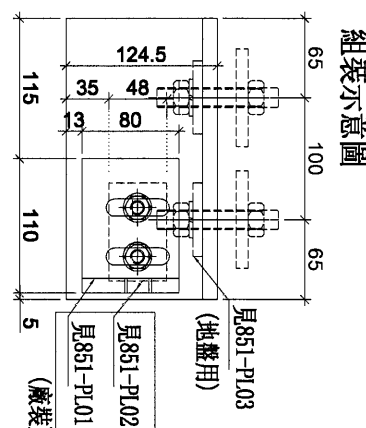

組裝示意圖

工程號 J853 地盤 延坪道

名稱 牆邊鋁碼

材料 X85996

顏色 塗瀝青油

採 用


地 盤

工 廠

附 件

美特鋁質有限公司 MIDI Aluminium Fabricator Ltd.					類別		物料號		
修改					制圖	陳俊賢	2021.10.29	圖號	853-BT04
日期					復核	謝永林	2021.12.21	數量	-
					批准	胡哥		位置	



使用位置	數量	層數	總數	樓層
T1CW-A-4	1	16	16	5F-22F
T1CW-B-2	1	2	2	23F-25F
T5CW-D-1	1	12	12	10F-23F
T7CW-B-5	1	16	16	7F-25F
合計:			46	

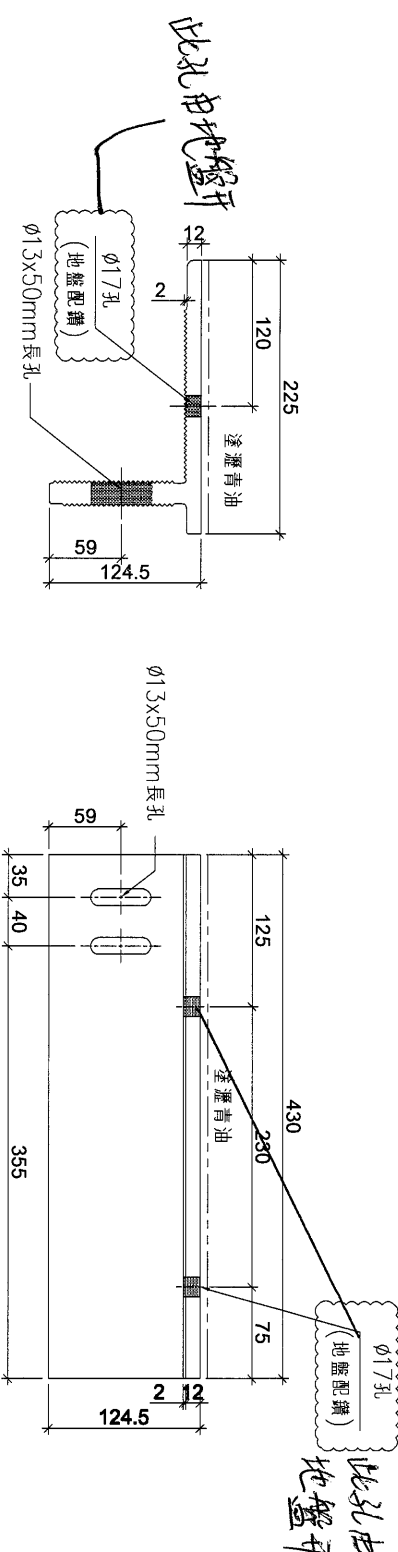


工程號	J853	地盤	延坪道	附 件	
名稱	牆邊鋁碼	採用			
材料	X85996	地盤	✓		
顏色	塗瀝青油	工廠			

 美特鋁質有限公司 MIDI Aluminium Fabricator Ltd.				類別	物料號	
修改				制圖	陳俊賢	2021.10.29
日期				復核	謝永林	2021.12.21
				批准	胡哥	位置
					圖號	853-BT05
					數量	-

使用位置	數量	層數	總數	樓層
T1CW-A-4	1	16	16	5F-22F
T1CW-B-2	1	2	2	23F-25F
T2CW-D-1	1	10	10	5F-16F
T2CW-A-5	1	7	7	17F-23F
T3CW-D-1	1	10	10	5F-16F
T3CW-A-1	1	7	7	17F-23F
T5CW-D-1	1	12	12	10F-23F
T7CW-B-5	1	16	16	7F-25F
合計:				80

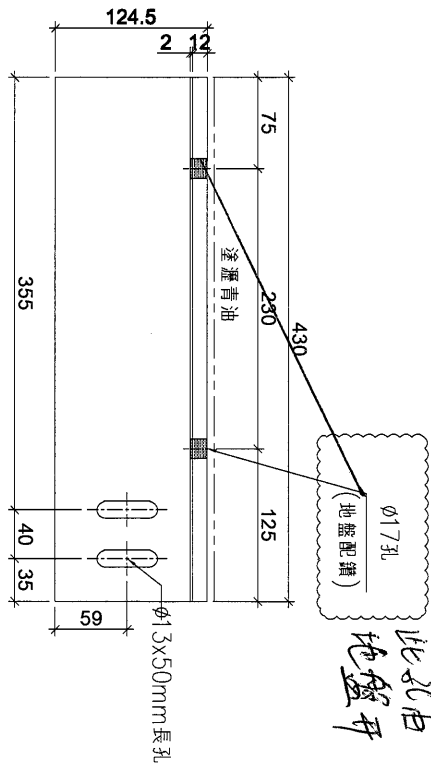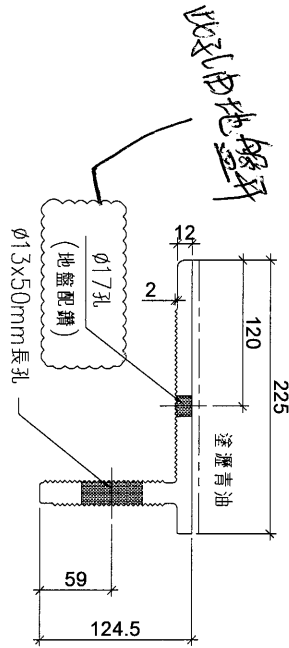

室外

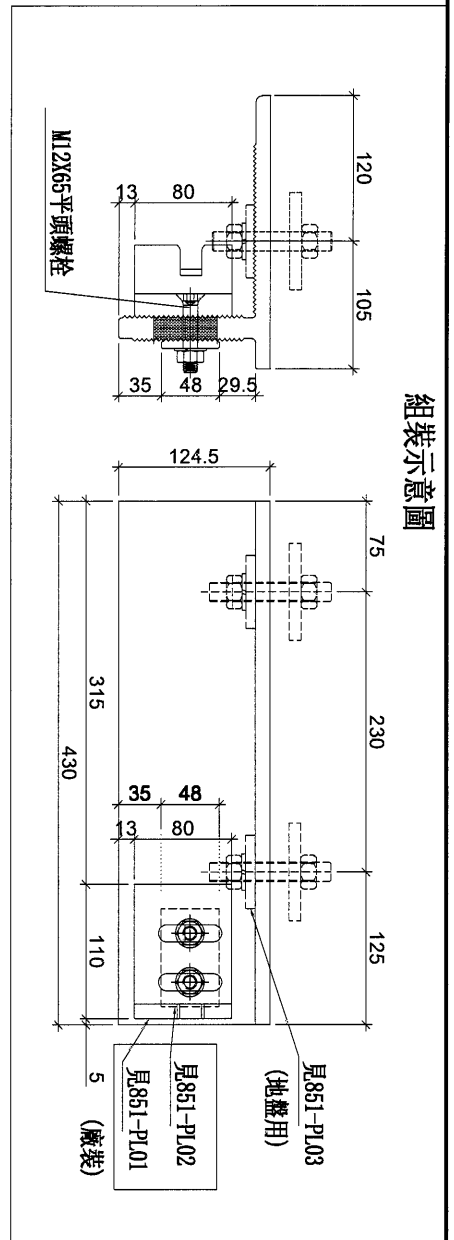

工程號	J853	地盤	延坪道	附件
名稱	牆邊鋁碼	採用		
材料	X85996	地盤	✓	
顏色	塗瀝青油	工廠		



組

此孔由地盤打

使用位置	數量	層數	總數	樓層
------	----	----	----	----

T2CW-D-2	1	9	9	6F-16F
	1	1	1	5F



T3CW-D-2	1	9	9	6F-16F
	1	1	1	5F

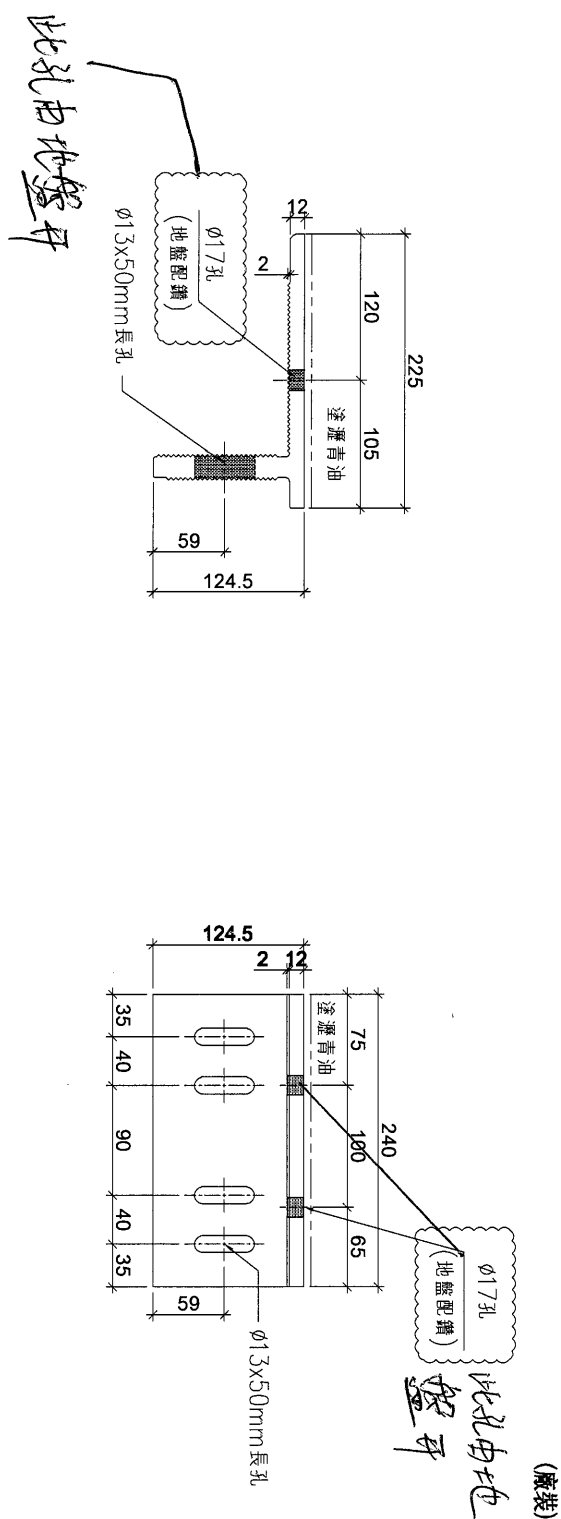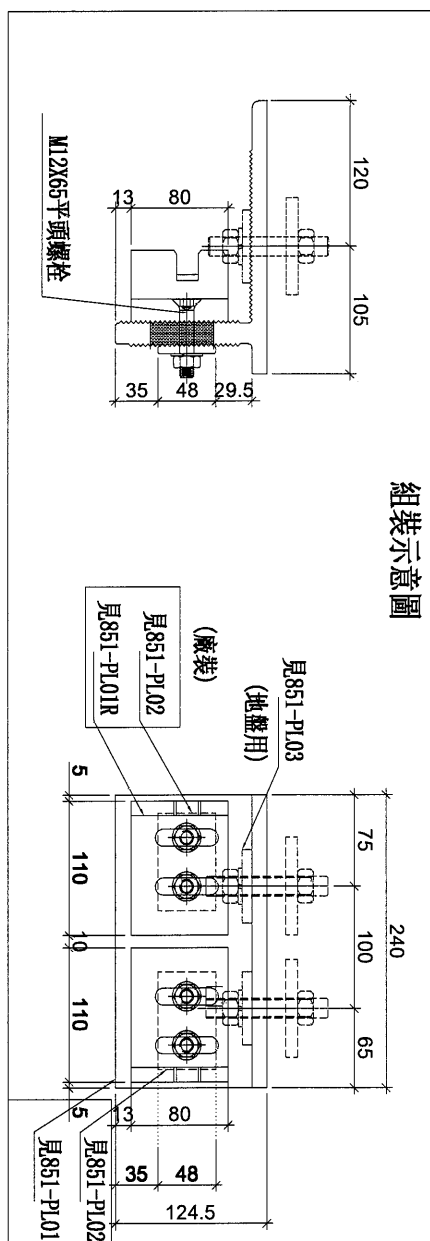


工程號	J853	地盤	延坪道	附件
名稱	牆邊鉛碼		採用	
材料	X85996		地盤 ☒	
顏色	塗瀝青油		工廠 ☐	

 美特鋁質有限公司 MIDI Aluminium Fabricator Ltd.				類別	物料號		
				制圖	陳俊賢	2021.10.29	圖號
修改				復核	謝永林	2021.12.21	數量
日期				批准	胡哥		位置

使用位置	數量	層數	總數	樓層
T2CW-D-2	1	1	1	5F
T3CW-D-2	1	1	1	5F

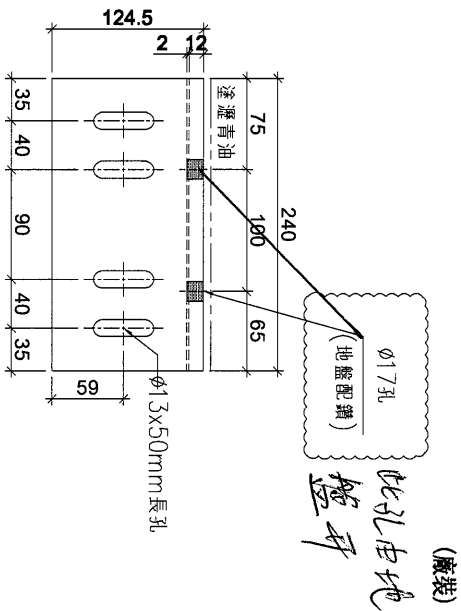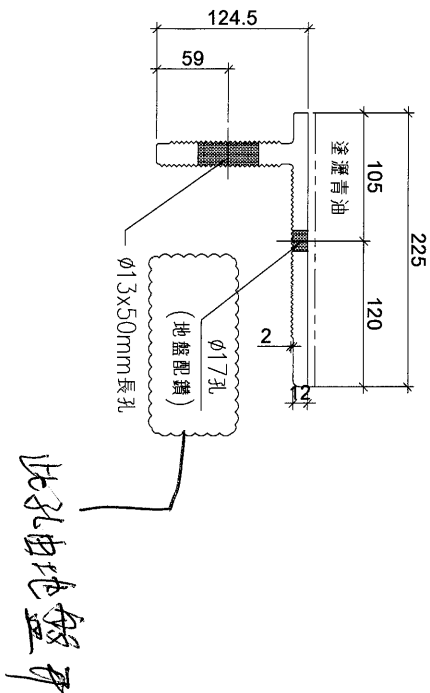



室外

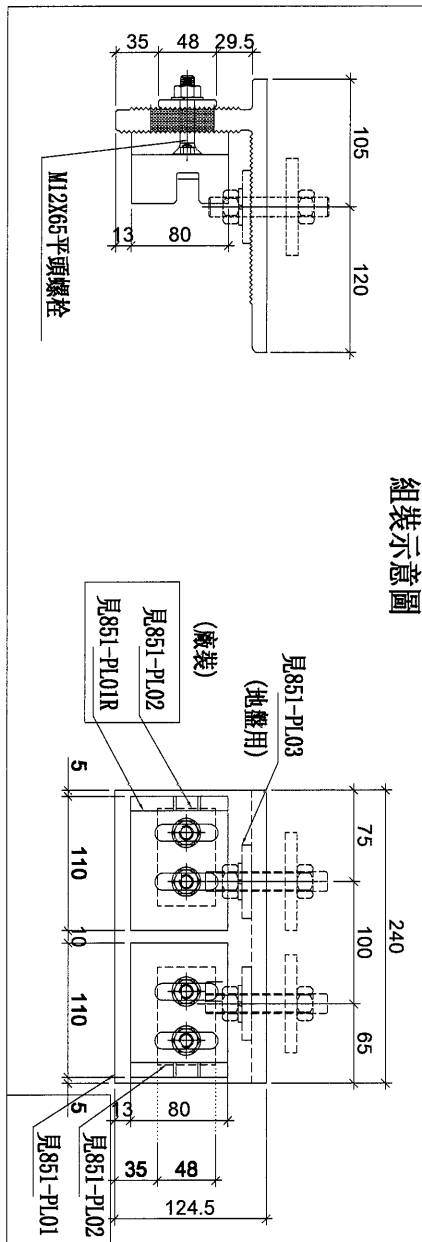

工程號	J853	地盤	延坪道	附件
名稱	牆邊鋁碼	採用		
材料	X85996	地盤	✓	
顏色	塗瀝青油	工廠		


美特鋁質有限公司 MIDI Aluminium Fabricator Ltd.				類別	物料號		
				制圖 陳俊賢	2021.10.29	圖號	853-BT07
修改				復核 謝永林	2021.12.21	數量	-
日期				批准 胡哥		位置	

使用位置	數量	層數	總數	樓層
T2CW-D-1	1	10	10	5F-16F
T2CW-A-5	1	7	7	17F-23F
T3CW-D-1	1	10	10	5F-16F
T3CW-A-1	1	7	7	17F-23F
合計:	34			

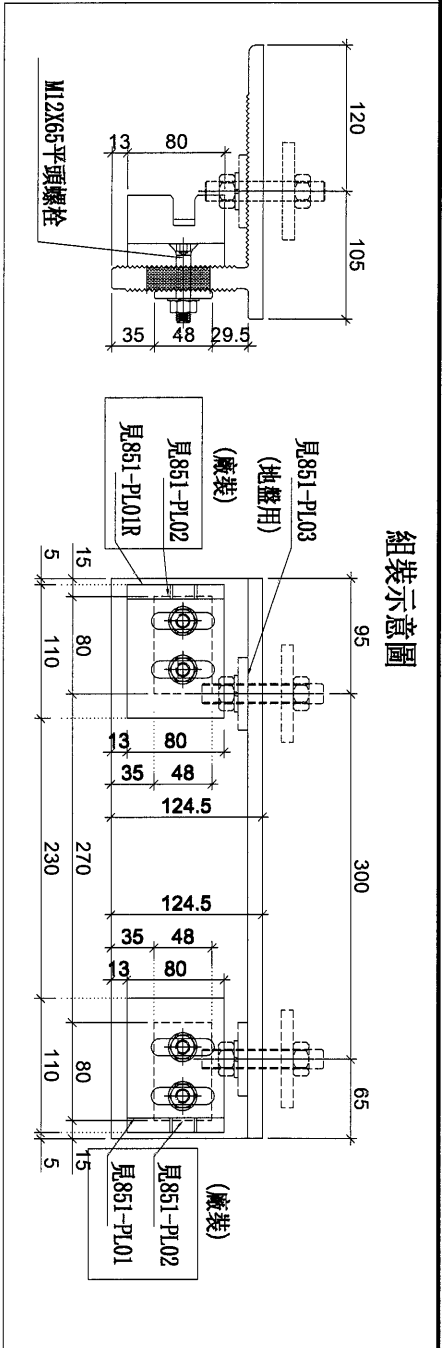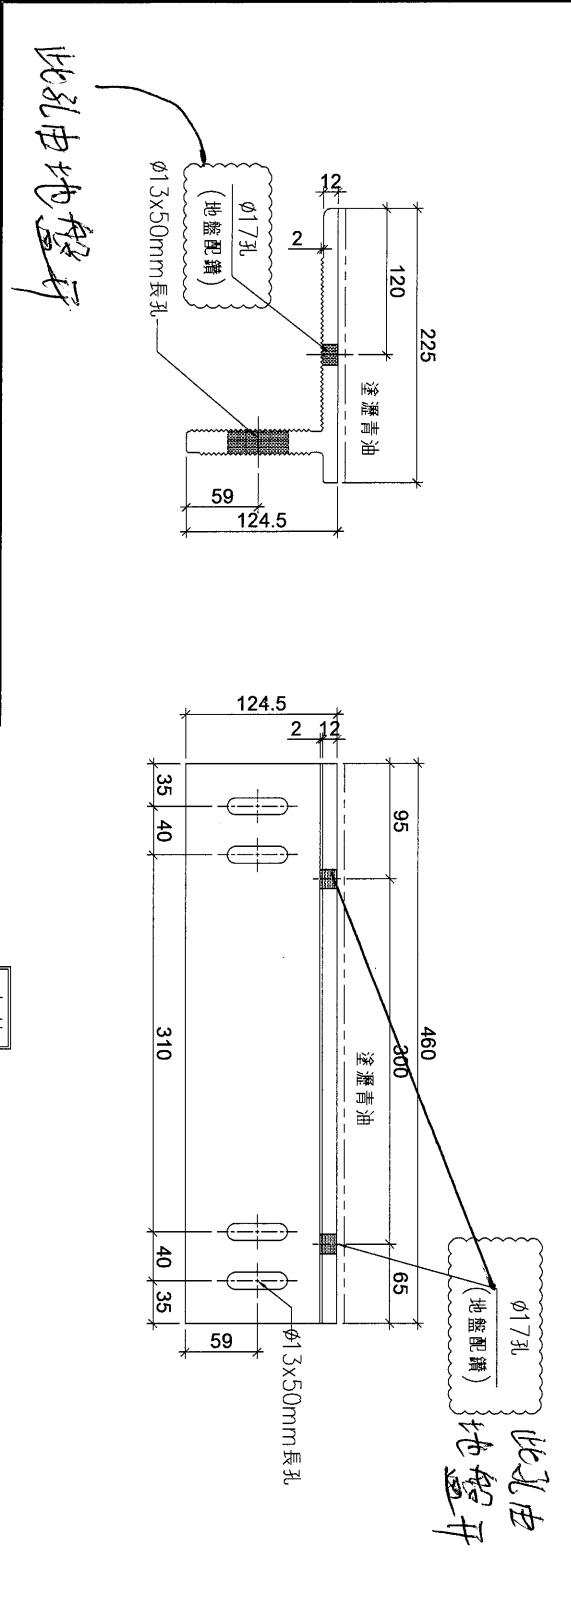

工程號	J853	地盤	延坪道	附 件
名稱	牆邊鋁碼	採用		
材料	X85996	地盤	✓	
顏色	塗瀝青油	工廠		

 美特鋁質有限公司 MIDI Aluminium Fabricator Ltd.				類別		物料號	
修改				制圖	陳俊賢	2021.10.29	圖號 853-BT08
日期				復核	謝永林	2021.12.21	數量 -
				批准	胡哥		位置

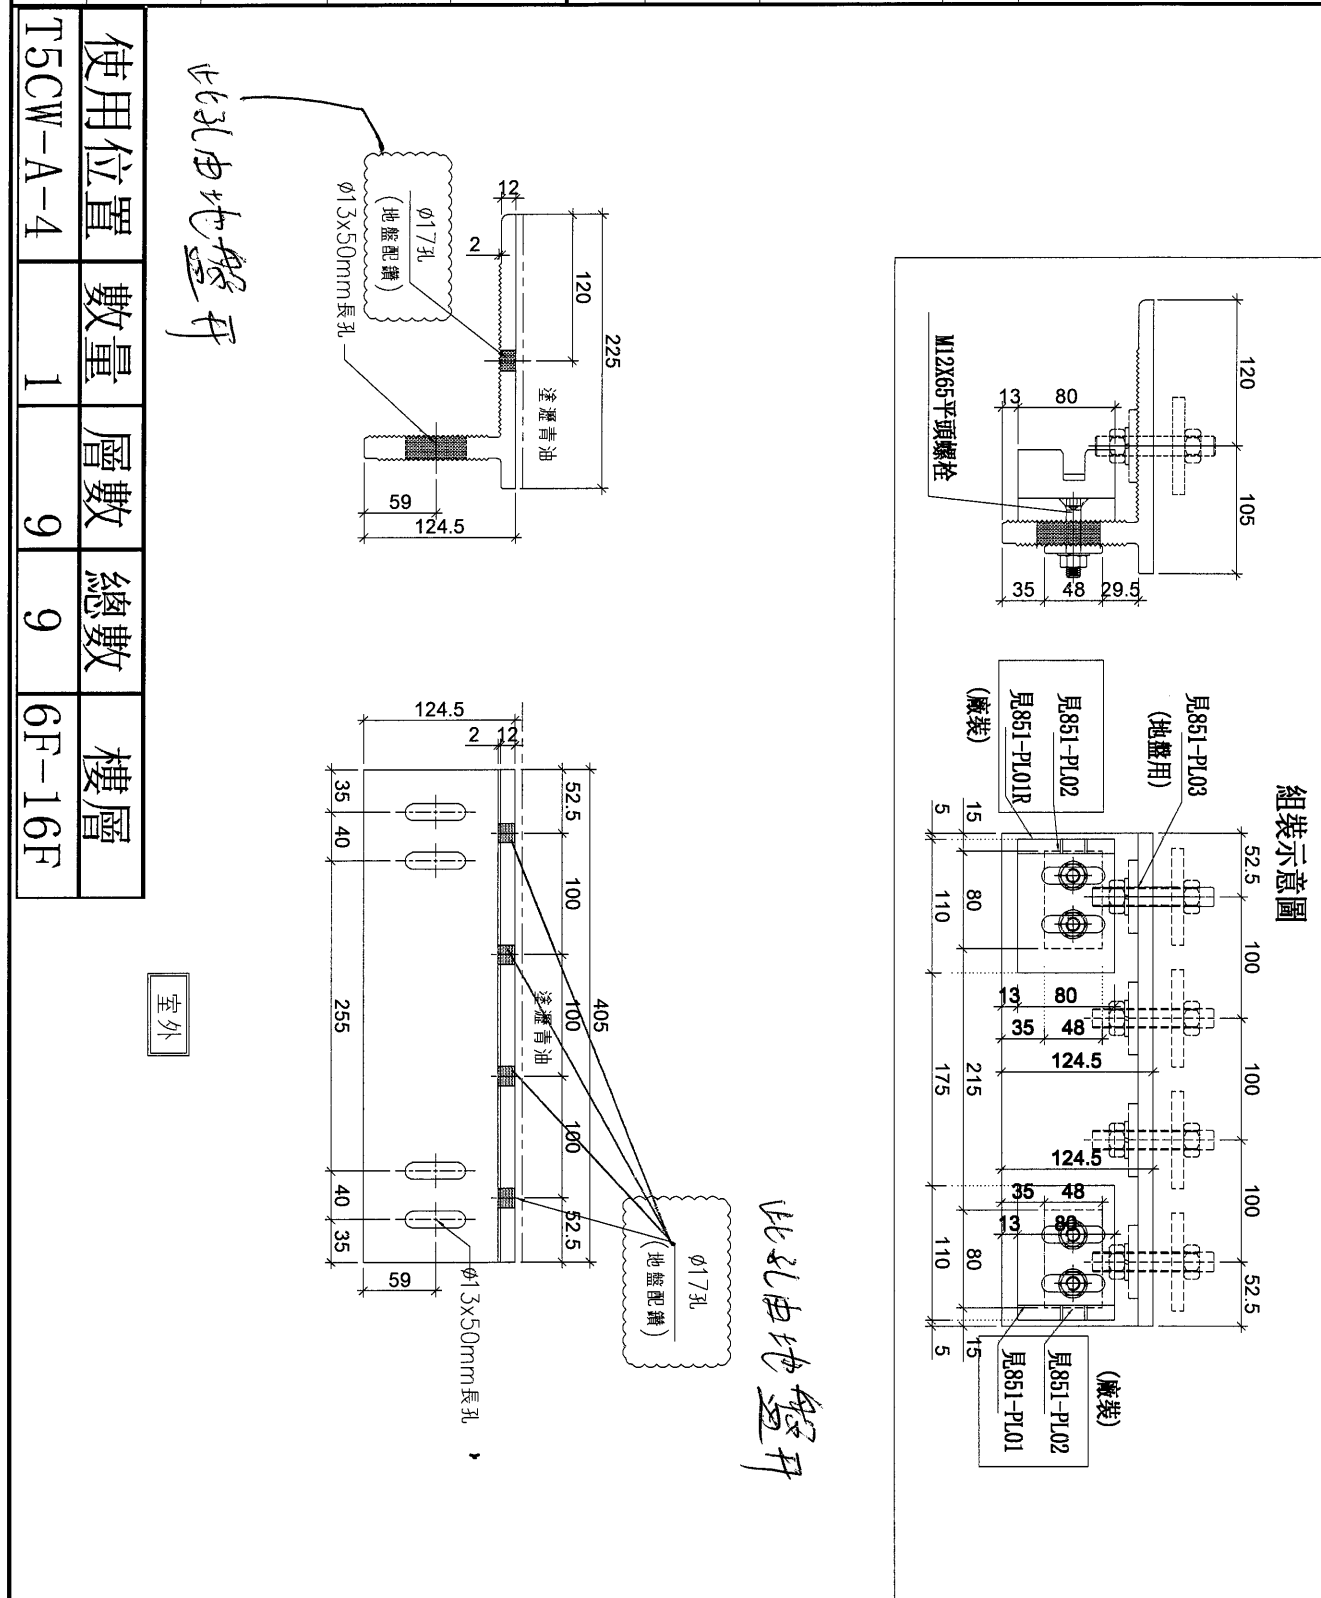

工程號	J853	地盤	延坪道	附件	
名稱	牆邊鋁碼	採用			
材料	X85996	地盤	✓		
顏色	塗瀝青油	工廠			

組裝示意圖

此孔由地盤开

此孔由地盤开

使用位置	數量	層數	總數	樓層
T5CW-B-3	1	1	1	26F

室外



工程號	J853	地盤	延坪道
名稱	牆邊鋁碼	採用	
材料	X85996	地盤	✓
顏色	塗瀝青油	工廠	

附件


美特鋁質有限公司 MIDI Aluminium Fabricator Ltd.					類別		物料號		
					制圖	陳俊賢	2021.10.29	圖號	853-BT10
修改					復核	謝永林	2021.12.21	數量	—
日期					批准	胡哥		位置	

使用位置	數量	層數	總數	樓層
T5CW-B-5	1	2	2	25F, 26F

此乳由地盤中

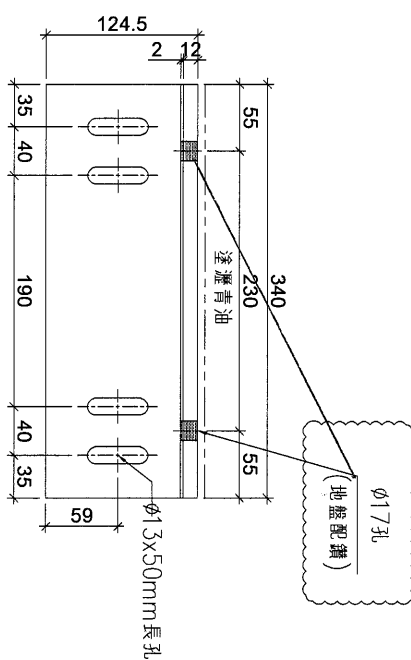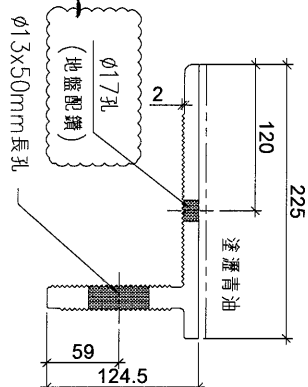

此孔由地盤开

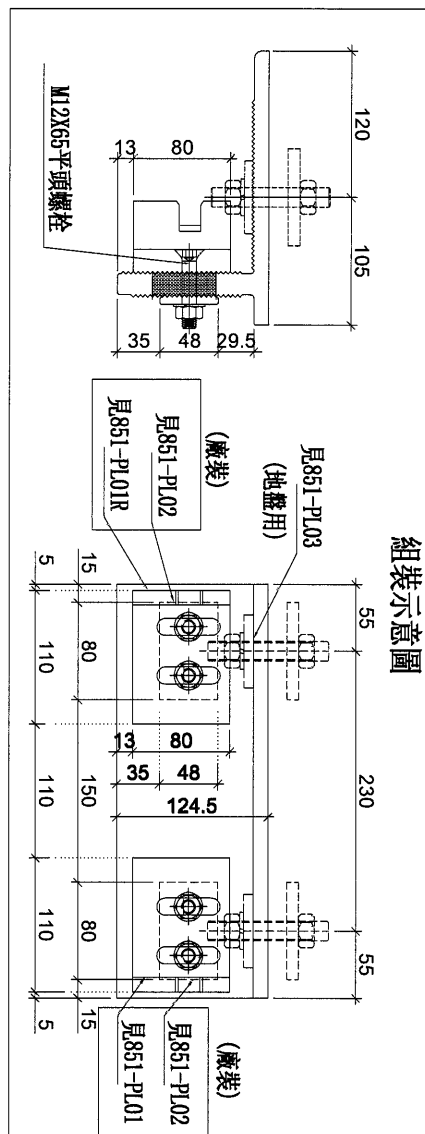


工程號	J853	地盤	延坪道
名稱	牆邊鋁碼	採	用
材料	X85996	地盤	✓
顏色	塗瀝青油	工廠	

附件


美特鋁質有限公司 MIDI Aluminium Fabricator Ltd.					類別		物料號		
修改					制圖	陳俊賢	2021.10.29	圖號	853-BT11
日期					復核	謝永林	2021.12.21	數量	—
					批准	胡哥		位置	

使用位置	數量	層數	總數	樓層
T5CW-B-3	1	1	1	26F


此孔由地盤開

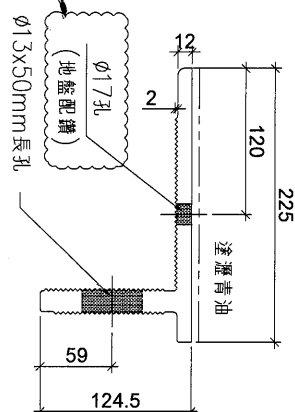

室外



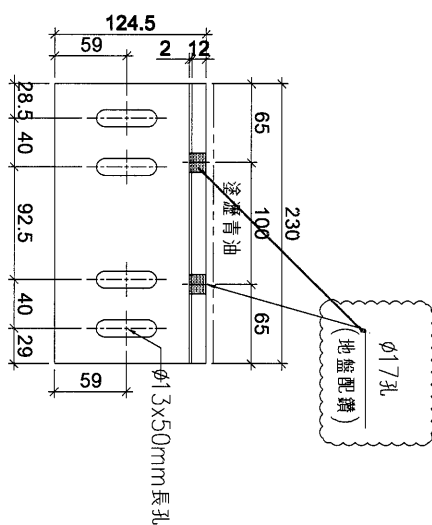


此孔由地盤開

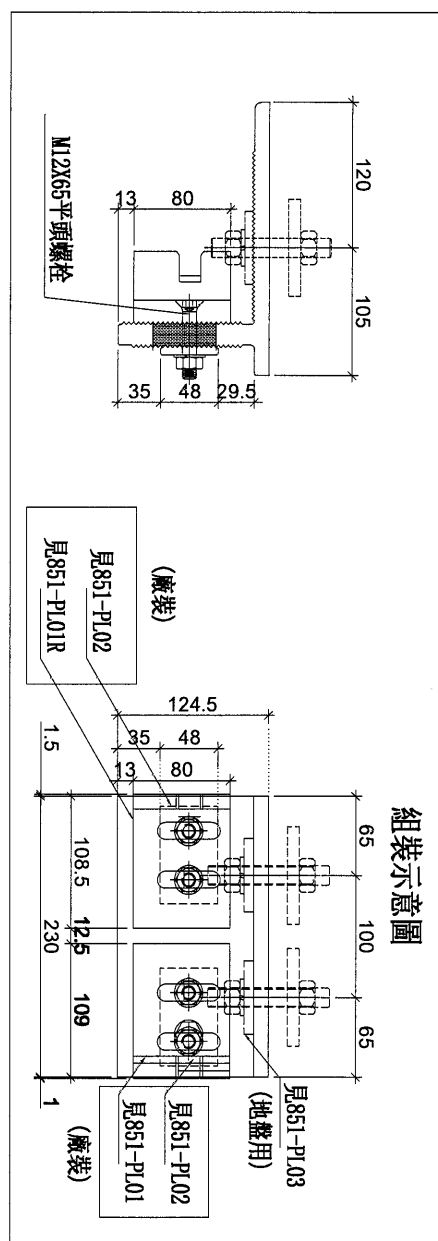


工程號	J853	地盤	延坪道	附件
名稱	牆邊鋁碼	採用		
材料	X85996	地盤	✓	
顏色	塗瀝青油	工廠		

 美特鋁質有限公司 MIDI Aluminium Fabricator Ltd.				類別		物料號	
修改				制圖	陳俊賢	2021.10.29	圖號 853-PL01
日期				復核	謝永林	2021.12.21	數量 -
				批准	胡哥		位置

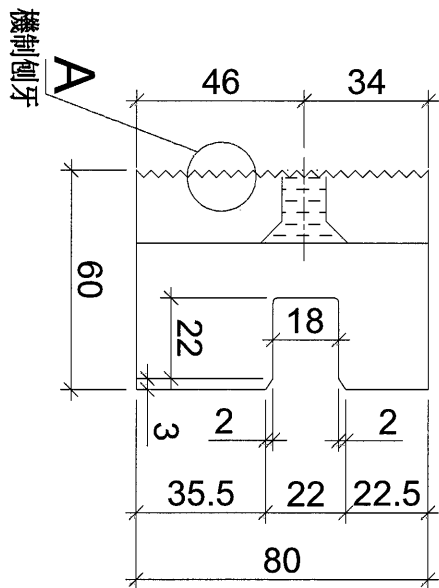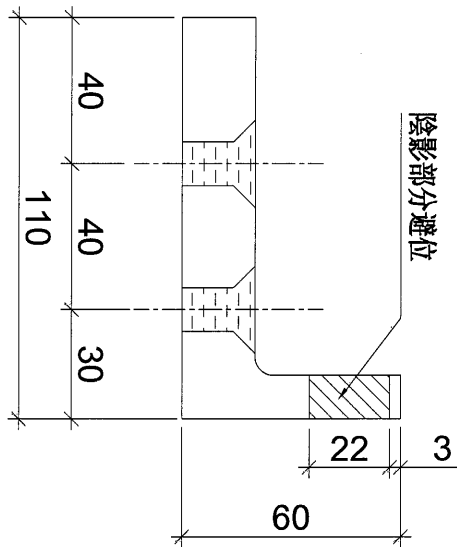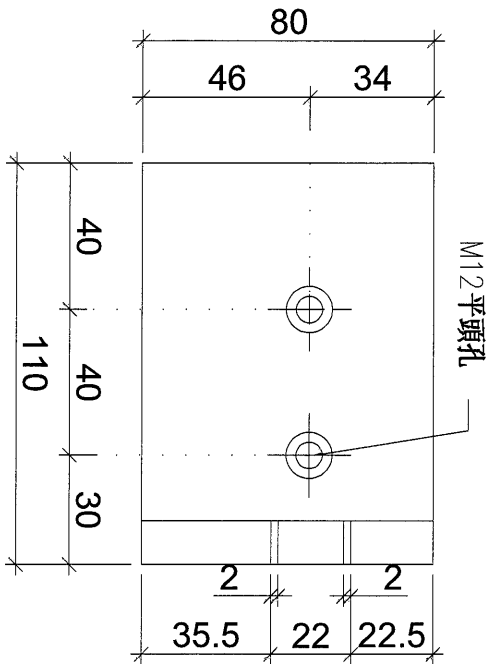

SCALE 4:1


A

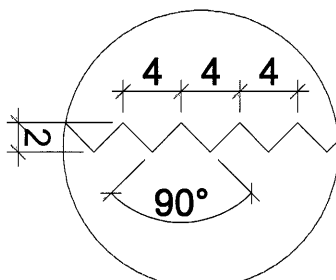




使用位置	數量
BT01	1542
BT01a	23
BT03	933
BT03a	11
BT05	80
BT06	20
BT06a	2
BT07	34
BT08	9
BT10	2
BT11	1
後備	10
合計	2667

工程號	J853	地盤	延坪道	附件	
名稱	單元安裝凹碼		採用		
材料	X85997		地盤		
顏色	MILL		工廠		

美特鋁質有限公司 MIDI Aluminium Fabricator Ltd.					類別		物料號		
					制圖	陳俊賢	2021.10.29	圖號	853-PL01R
修改					復核	謝永林	2021.12.21	數量	—
日期					批准	胡哥		位置	

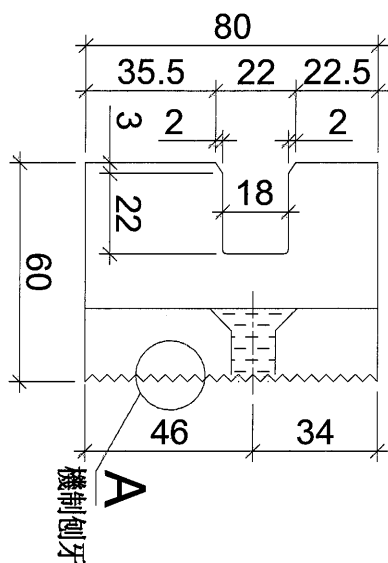

SCALE 4:1

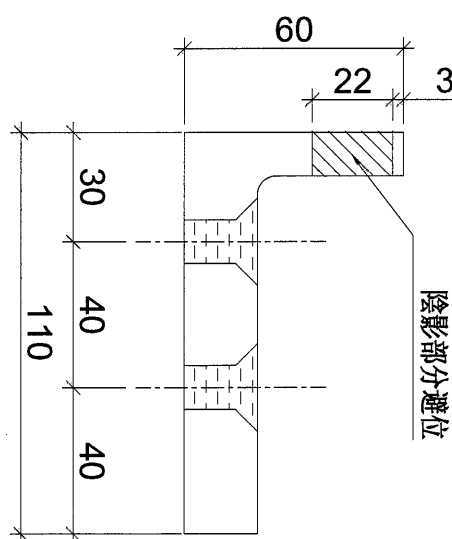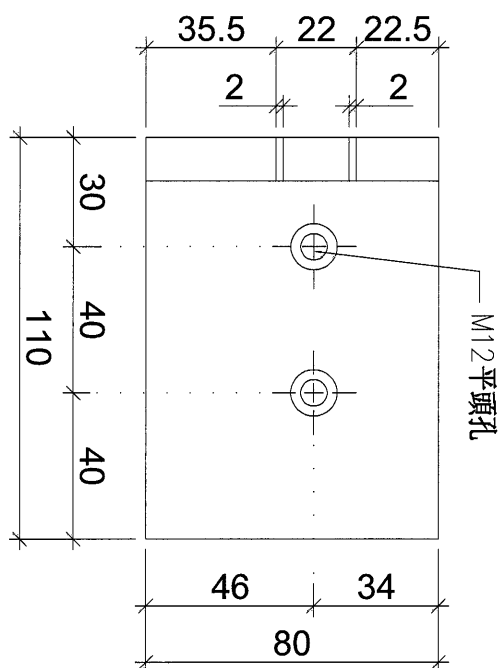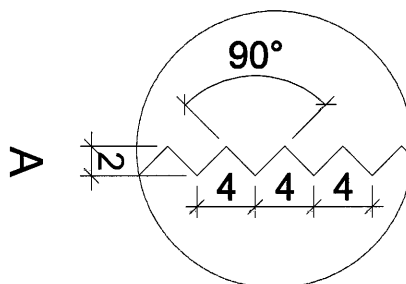


使用位置	數量
BT01	1542
BT01a	23
BT02	967
BT02a	11
BT04	46
BT06	20
BT06a	2
BT07	34
BT08	9
BT10	2
BT11	1
後備	10
合計	2667

工程號	J853	地盤	延坪道	附件	
名稱	單元安裝凹碼		採用		
材料	X85997		地盤		
顏色	MILL		工廠		

(30)


EG-DWG4

 美特鋁質有限公司 MIDI Aluminium Fabricator Ltd.				類別	物料號			
				制圖	陳俊賢	2021.10.29	圖號	853-PL04
修改				復核	謝永林	2021.12.21	數量	—
日期				批准	胡哥		位置	

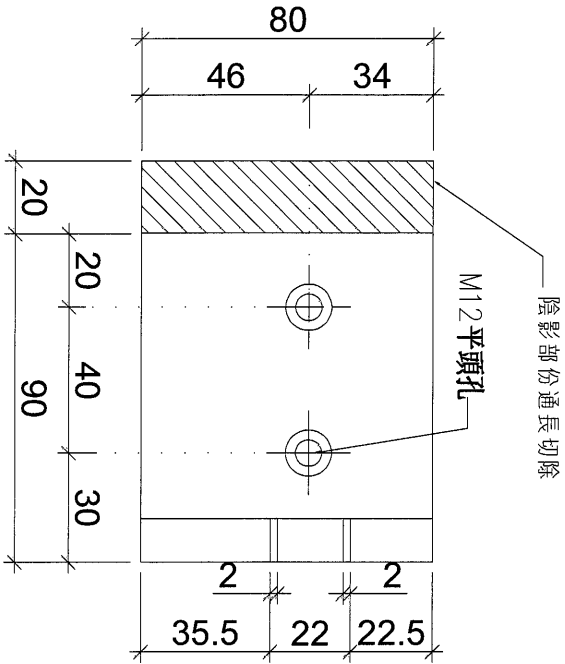


M12平頭孔

陰影部份通長切除

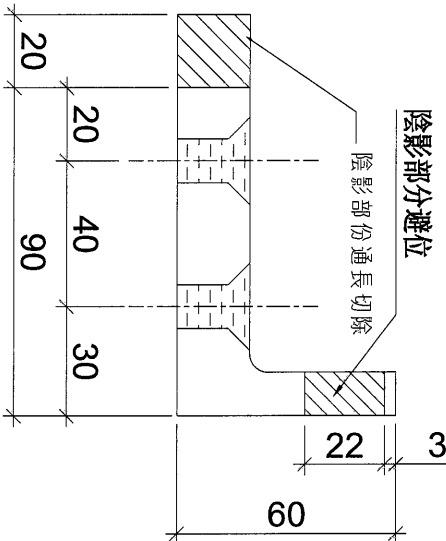

陰影部分避位


陰影部份通長切除

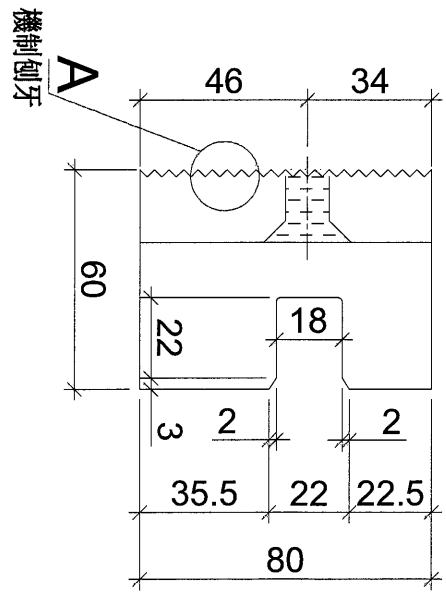

機制刨牙

SCALE 4:1


A

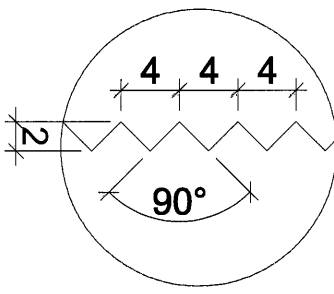




使用位置		數量	
BT09		1	

工程號	J853	地盤	延坪道	附件
名稱	單元安裝凹碼		採用	
材料	X85997		地盤	
顏色	MILL		工廠	

 美特鋁質有限公司 MIDI Aluminium Fabricator Ltd.					類別		物料號		
修改					制圖	陳俊賢	2021.10.29	圖號	853-PL04R
日期					復核	謝永林	2021.12.21	數量	—
					批准	胡哥		位置	

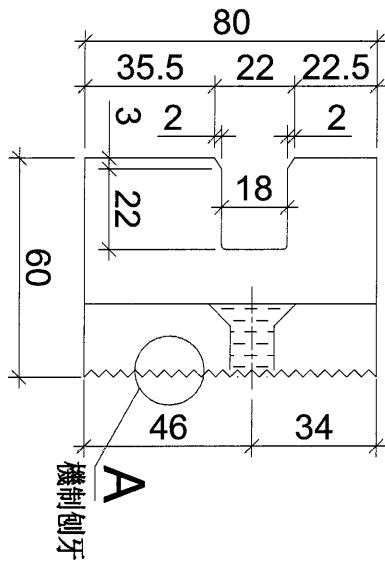

SCALE 4:1

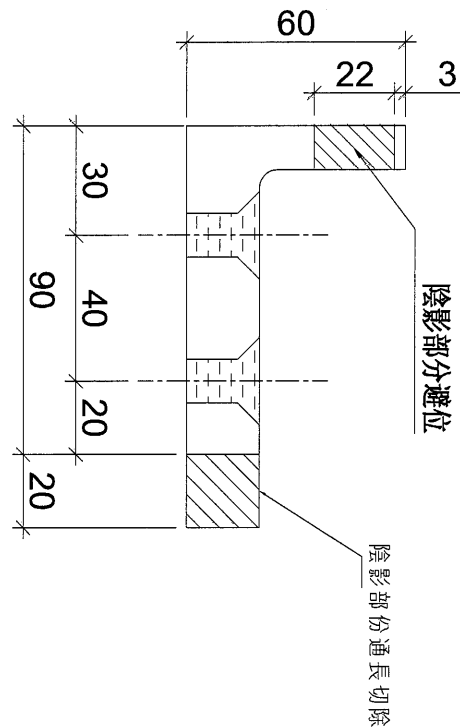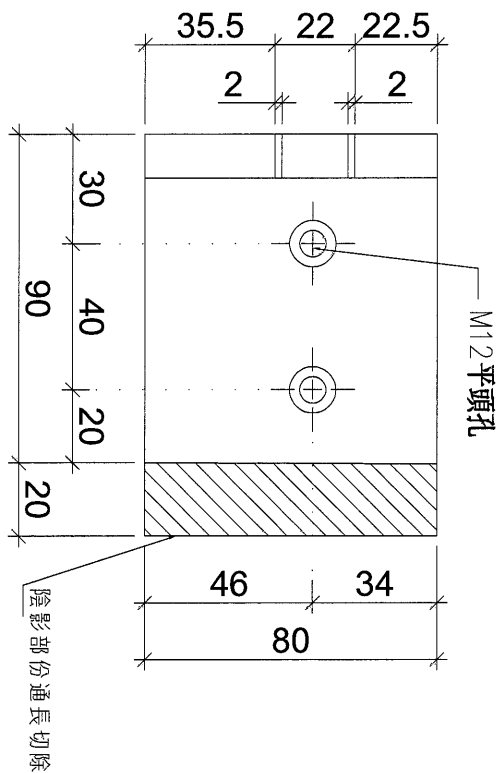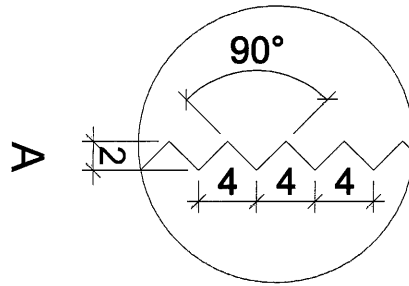


使用位置	數量
BT09	1

工程號	J853	地盤	延坪道	附件	
名稱	單元安裝凹碼		採用		
材料	X85997		地盤		
顏色	MILL		工廠		

 美特鋁質有限公司 MIDI Aluminium Fabricator Ltd.				類別	物料號	圖號	
				制圖 陳俊賢	2021.10.29	853-PL02/853-PL03	
修改				復核 謝永林	2021.12.21	數量	-
日期				批准 胡哥		位置	


853-PL02

圖號	使用位置	數量
BT01	3084	
BT01a	46	
BT02	967	
BT02a	11	
BT03	933	
BT03a	11	
BT04	46	
BT05	80	
BT06	40	
BT06a	4	
BT07	68	
BT08	18	
BT09	2	
BT10	4	
BT11	2	
後備:	20	
合計:	5336	

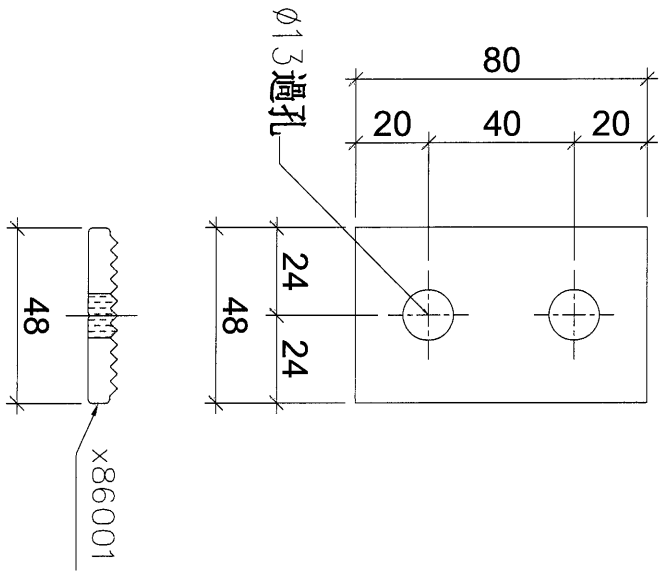

853-PL03

圖號	使用位置	數量
BT01	3084	
BT01a	46	
BT02	1934	
BT02a	22	
BT03	1866	
BT03a	22	
BT04	92	
BT05	160	
BT06	40	
BT06a	4	
BT07	68	
BT08	36	
BT09	2	
BT10	4	
BT11	2	
後備:	50	
合計:	7432	

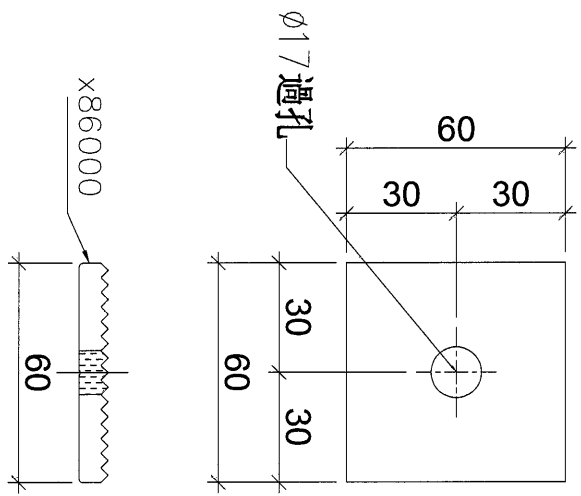

工程號 J853

地盤 延坪道

名稱 介子 (48) / 介子 (60)

採 用

材 料 X86001 / X86000


地 盤 ✓

顏 色 MILL

工 廠 ✓

附件

數量 350 後備數量.

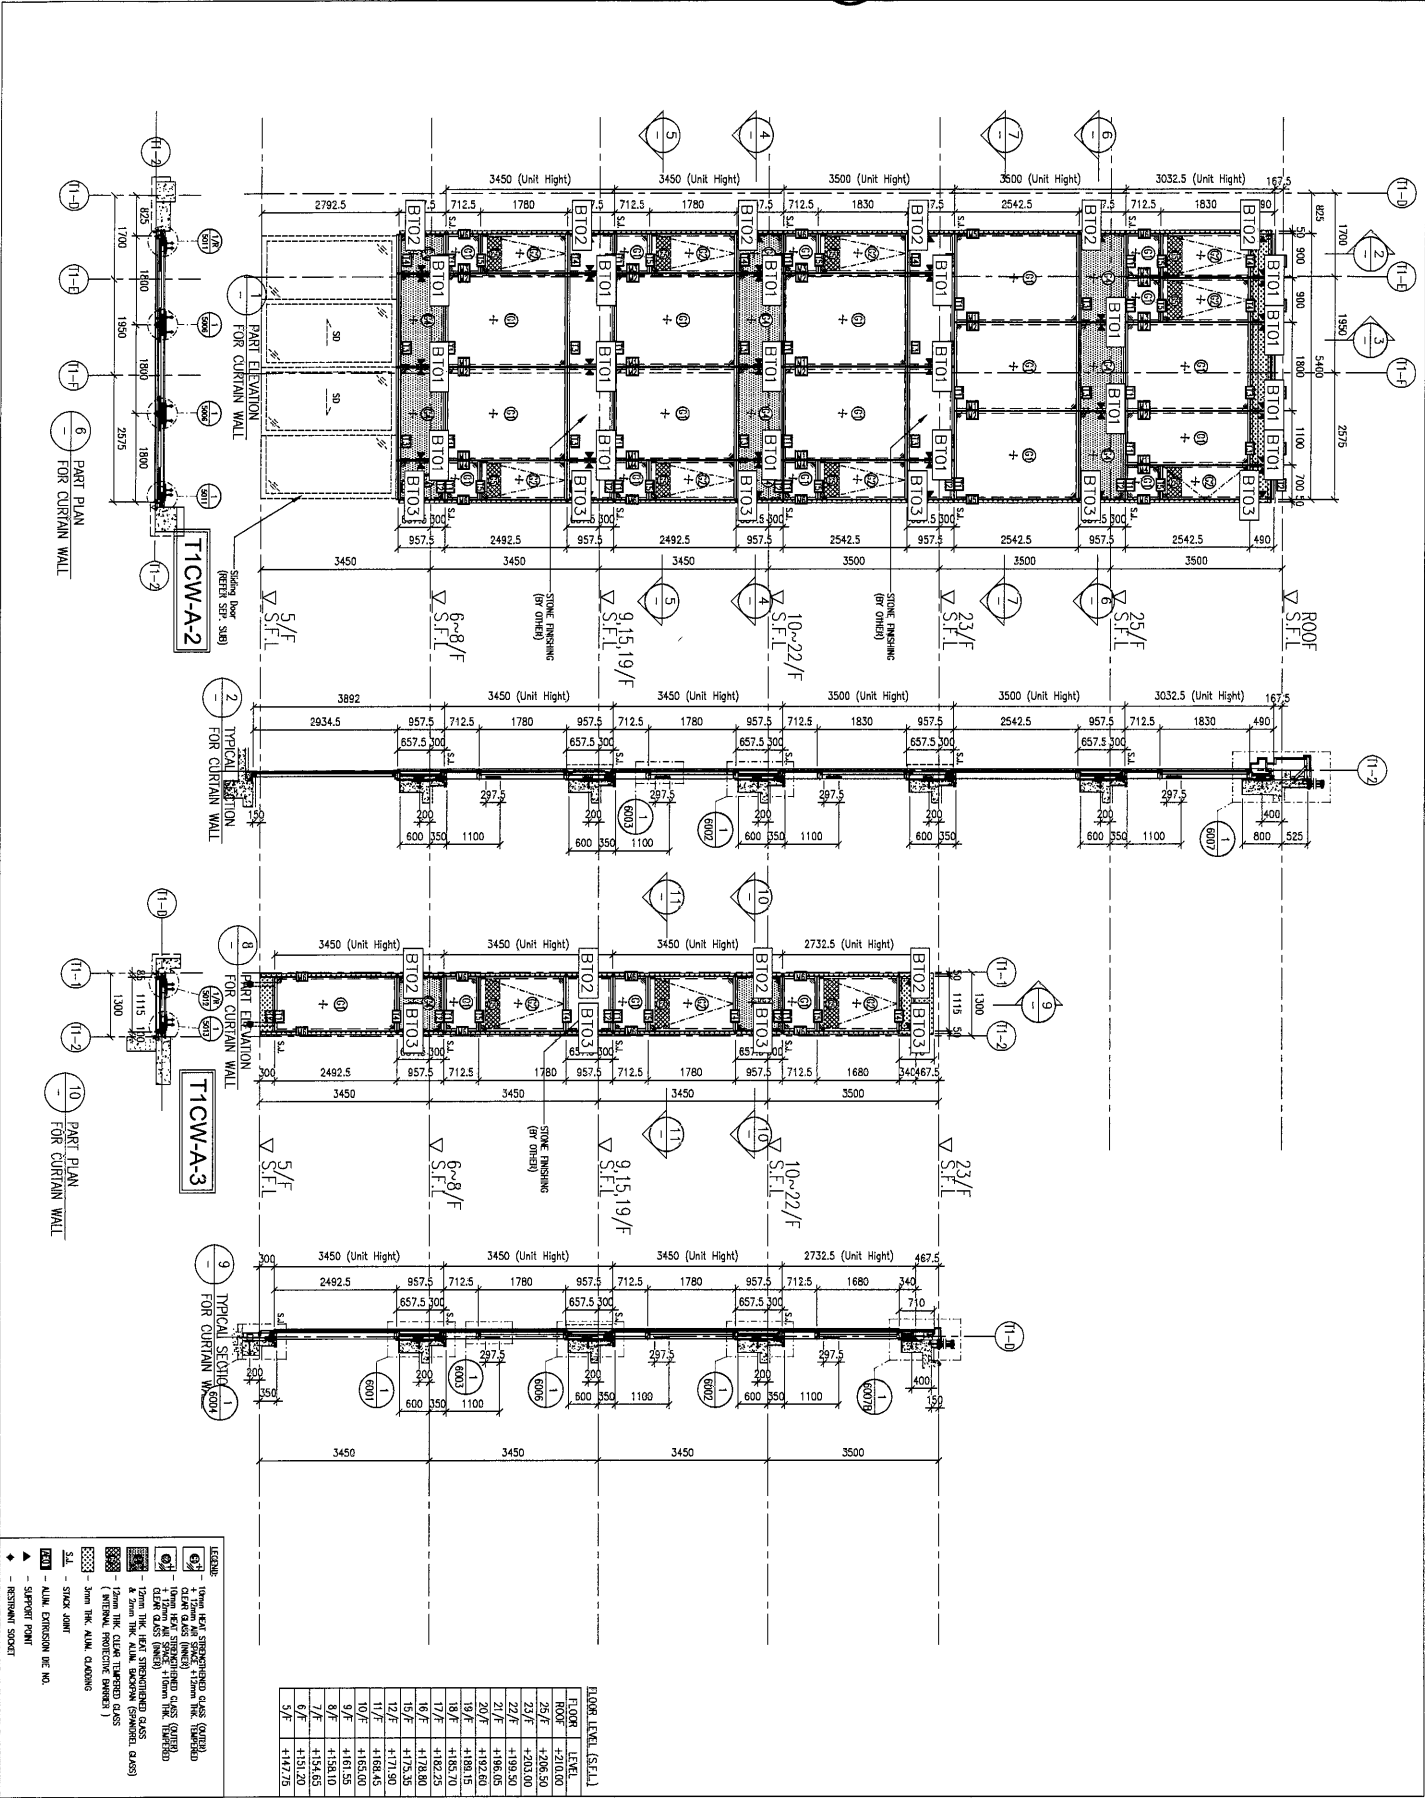

CLIENT : SHIMAO GROUP HOLDINGS LIMITED

ARCHITECT : WONG TUNG & PARTNERS LIMITED

MAIN CONTRACTOR : 協興建築有限公司
HIP HING CONSTRUCTION CO. LTD

STRUCTURAL ENGINEER : C.M. WONG & ASSOCIATES LTD
黃志明建築工程師有限公司

FAÇADE CONSULTANT : MEINHARDT

PROJECT : PROPOSED RESIDENTIAL DEVELOPMENT AT N.K.L.L. 6542 YIN PING ROAD KOWLOON


TITLE : PART ELEVATION FOR CURTAIN WALL AT TOWER 1

DRAWN BY : L.H.S. **CHECKED BY :** L.H.S.

DATE : 18-MAR-21 **SCALE :** 1:50 (A1)

DESIGNER : 美特銘有限公司
METE MING CO., LTD.
610 Chee Kwo Ling Road, Kowloon
Tel: 24246211-4 Fax: (852) 2727666

DWG NO. : 0553-SO-CN-4102 **REV. :** A

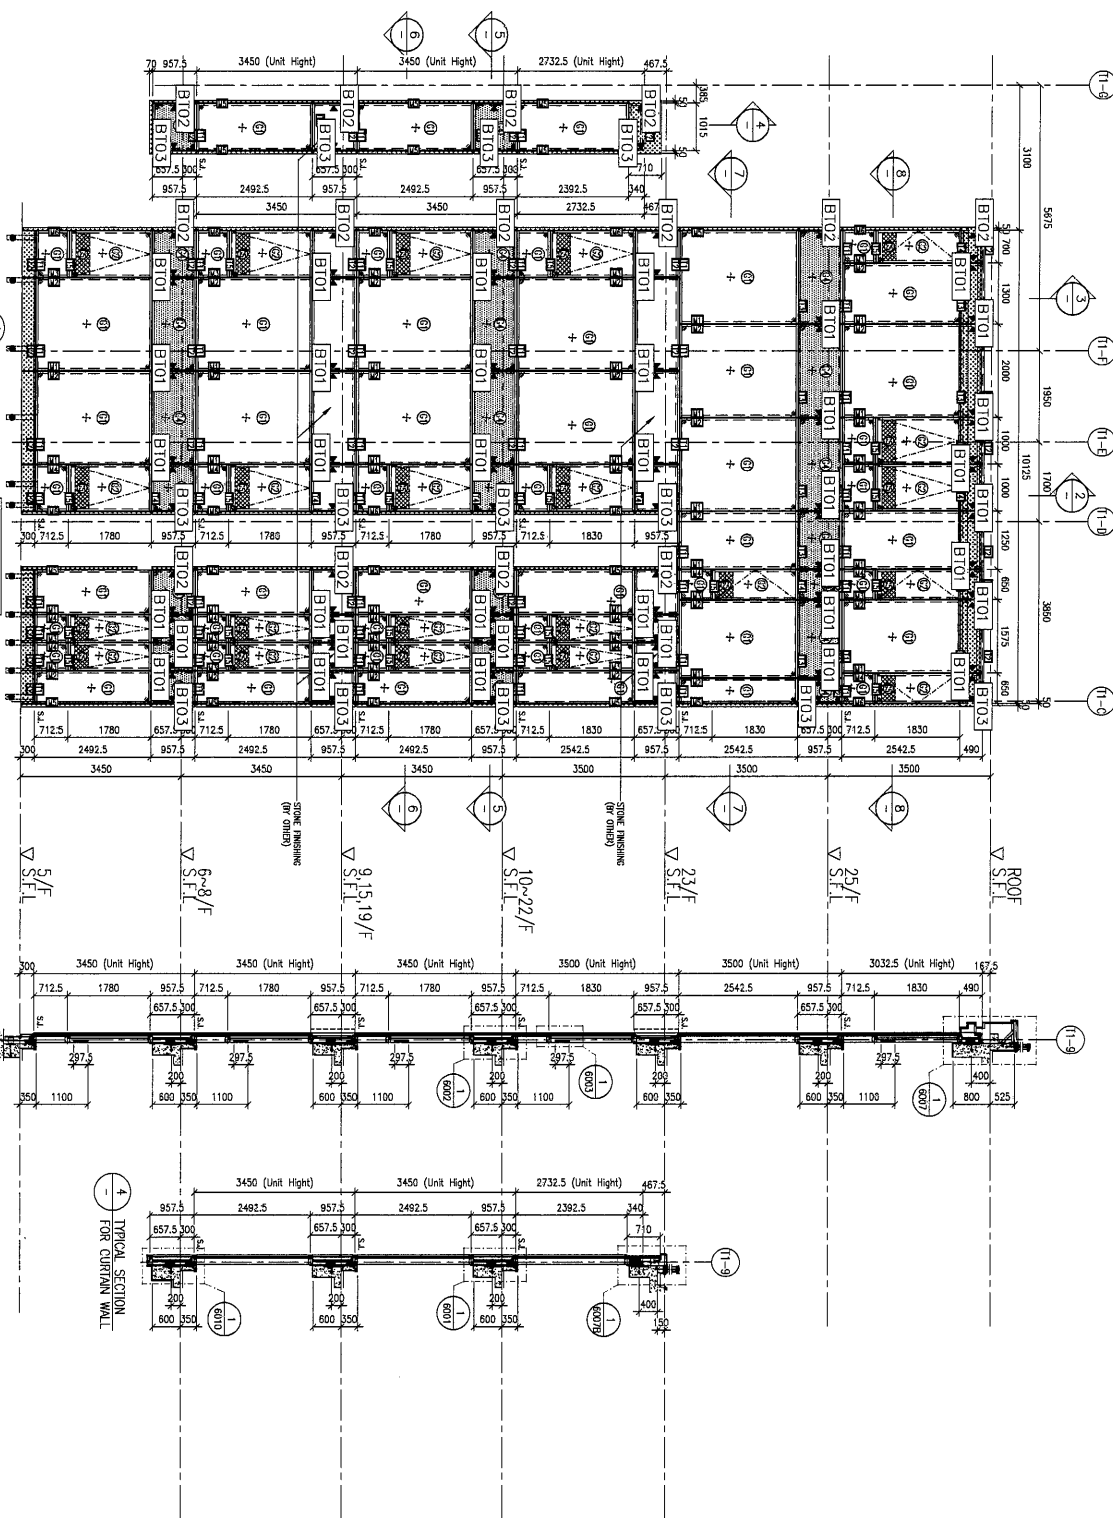

FLOOR LEVEL (S.F.L)	FLOOR	FLTR
Roof	+210.00	
29/F	+206.50	
22/F	+203.00	
22/F	+199.50	
21/F	+196.05	
20/F	+192.60	
19/F	+189.15	
18/F	+185.70	
17/F	+182.25	
16/F	+178.80	
15/F	+175.35	
12/F	+171.90	
11/F	+168.45	
10/F	+165.00	
9/F	+161.55	
8/F	+158.10	
7/F	+154.65	
6/F	+151.20	
5/F	+147.75	

NOTE:

1. ALL DIMENSIONS ARE IN mm.
2. ALL ELEVATIONS ARE VIEWED FROM OUTSIDE.
3. ALL DIMENSIONS TO BE VERIFIED ON SITE BEFORE FABRICATION.

LEGEND:

	DETAIL MARK NO.
	REFER SHEET NO.

1. F.F.L. --- FINISHED FLOOR LEVEL
2. S.F.L. --- STRUCTURAL FLOOR LEVEL
3. --- REVERSED DETAIL

MEINHARDT

FACADE CONSULTANT:

C M WONG & ASSOCIATES LTD
黃志明建築工程師有限公司

STRUCTURAL ENGINEER :

協興建築有限公司
HIP HING CONSTRUCTION CO LTD

ARCHITECT
WONG TUNG & PARTNERS LIMITED
ARCHITECTS & PLANNERS

WT




MAIN CONTRACTOR •

SHIMAO GROUP
HOLDINGS LIMITED

CLIENT :

	LEADING
	- 10mm HEAT STRENGTHENED GLASS (OUTER) + 12mm HEAT TREATED GLASS (INNER)
	- 10mm HEAT STRENGTHENED GLASS (OUTER) + 12mm AIR SPACE + 10mm THK. TREATED GLASS (INNER)
	- 12mm THK. HEAT STRENGTHENED GLASS & 2mm THK. ALU. DRYFAN (SPANDREL GLASS)
	- 12mm THK. CLEAR TREATED GLASS (INTERNAL POLYESTER BARRIER)
	- 3mm THK. ALUM. CLADDING
	S.L. - STOCK JOINT
	AECO - ALUM. EXTRUSION BE NO.
	- SUPPORT POINT
	- RESISTANT SOCKET

PRODUCT : PROPOSED RESIDENTIAL DEVELOPMENT AT N.K.L.L. 6542 YIN PING ROAD KOMLOON	DATE : 18-MAR-21 SCALE : 1:50 (A1) DRAWN BY : LHT CHECKED BY : TITLE : PART ELEVATION FOR CURTAIN WALL AT TOWER 1	 Units 6-15, Sunny Industrial Estate, 610 Shing Tung Ring Road, Kowloon Tel: 23689211-4 Fax: 23689217/212888 MMDI 美特德实业有限公司 MMDI Kowloon Industrial Estate, Ltd.	DGC NO. : JHS3-SJ-CW-41104 REL. : A
---	--	--	--

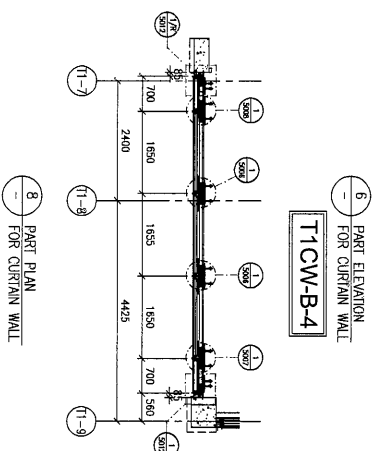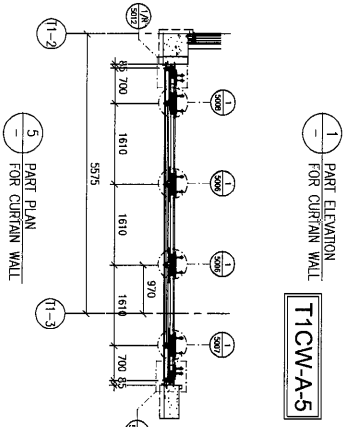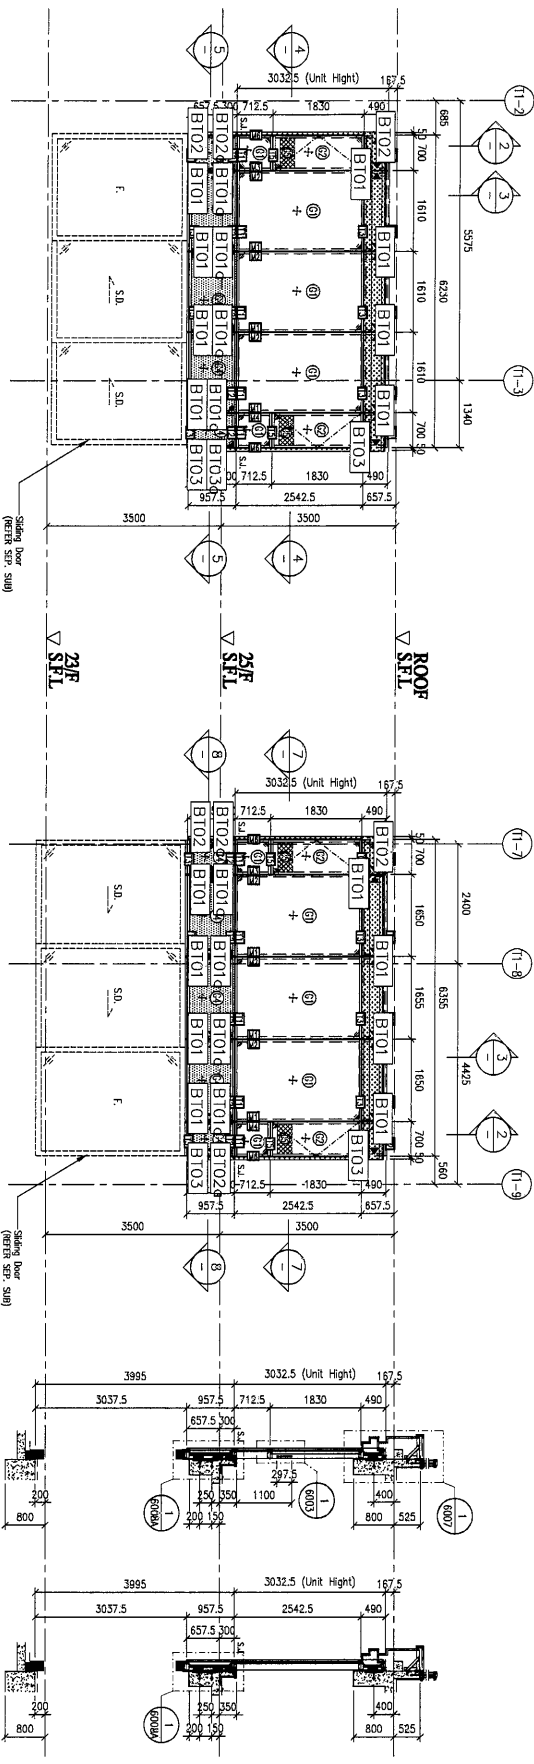

FLOOR	LEVEL
ROOF	+210.00
25/F	+206.50
23/F	+203.00


LEAD-NO.	DESCRIPTION
①	10mm HEAT STRENGTHENED GLASS (OUTER) + 12mm AIR SPACE + 12mm THK. TEMPERED CLEAR GLASS (INNER)
②	10mm HEAT STRENGTHENED GLASS (OUTER) + 17mm AIR SPACE + 10mm THK. TEMPERED CLEAR GLASS (INNER)
③	12mm THK. HEAT STRENGTHENED GLASS + 2mm THK. ALUM. BARRIER (SPANDREL GLASS)
④	12mm THK. CLEAR TEMPERED GLASS (INTERNAL PROTECTIVE BARRIER)

 — 3mm THK. ALUM. CLADDING
S.L.
 — STACK JOINT
ALCO — ALUM. EXTRUSION DIE NO.
 ▲ — SUPPORT POINT
 ◆ — RESTRAINT SOCKET

B.O. REF. :	
CLIENT :	
SHIMAO GROUP HOLDINGS LIMITED	
ARCHITECT :	
WONG TUNG & PARTNERS LIMITED STRUCTURAL ENGINEERS	
MAIN CONTRACTOR :	
協興建築有限公司 HIP HING CONSTRUCTION CO. LTD.	
STRUCTURAL ENGINEER :	
CMA C.M. WONG & ASSOCIATES LTD 黃志明建築工程師有限公司	
FACADE CONSULTANT :	
MEINHARDT	

NOTE: 1. ALL DIMENSIONS ARE IN mm. 2. ALL DIMENSIONS ARE TAKEN FROM OUTSIDE. 3. ALL DIMENSIONS TO BE VARIOUS ON SITE BEFORE FABRICATION.				
LEGEND: ① DETAIL MARK NO. ② REVER SHEET NO. 1. FEEL --- INVERTED FLOOR LEVEL 2. SEL --- STRUCTURAL FLOOR LEVEL 3. ②⑨ --- REVERSED DETAIL				
NO.	DATE	REVISION	B	
JOB NO.:	J-4953			
PRODUCT:	PROPOSED RESIDENTIAL DEVELOPMENT AT N.K.I.L. 6542 TM KONG ROAD KOWLOON			
TITLE:	PART ELEVATION FOR CURTAIN WALL AT TOWER 1			
DATE: 02-OCT-21	SCALE: 1:40 (A1)			
DRAWN BY: LHR	CHECKED BY:			
 美特銘貿有限公司 MTD International Ltd. Units 6-8, Sunny Industrial Centre, 1/F 610 Chin Nee Ling Road, Kowloon Tel: 23488271-4 Fax: (852) 27727866				
DCG NO.: J853-SJ-CW-4105	REV: A			

38

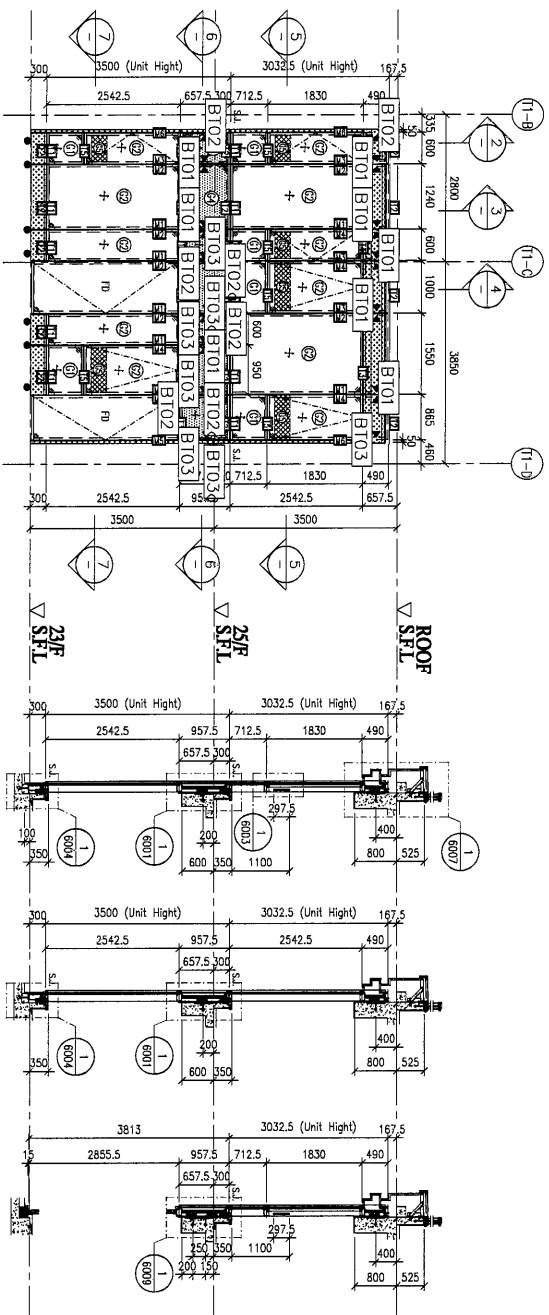


1 PART ELEVATION
FOR CURTAIN WALL
T1CW-A-6

2 TYPICAL SECTION
FOR CURTAIN WALL

3 TYPICAL SECTION
FOR CURTAIN WALL

4 TYPICAL SECTION
FOR CURTAIN WALL

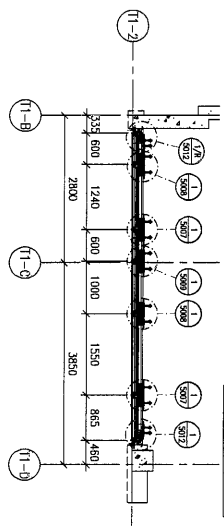

6 PART PLAN
FOR CURTAIN WALL

FLOOR LEVEL (S.F.L.)		
NO.	LEVEL	FIN.
1	FLOOR	+210.00
2	ROOF	+208.50
3	23/F	+203.00

- LEGEND:
- ① 10mm HEAT STRENGTHENED GLASS (OUTER)
 - ② 12mm AIR SPACE + 12mm THK. TEMPERED CLEAR GLASS (INNER)
 - ③ 10mm HEAT STRENGTHENED GLASS (OUTER)
 - ④ 12mm AIR SPACE + 10mm THK. TEMPERED CLEAR GLASS (INNER)
 - ⑤ 12mm THK. HEAT STRENGTHENED GLASS & 2mm THK. ALUM. BACKING (SPANDREL GLASS)
 - ⑥ 3mm THK. ALUM. CLADDING (INTERNAL PROTECTIVE BARRIER)
 - ⑦ 3mm THK. ALUM. CLADDING
 - ⑧ 3mm THK. ALUM. CLADDING
 - ⑨ 3mm THK. ALUM. CLADDING
 - ⑩ 3mm THK. ALUM. CLADDING
 - ⑪ 3mm THK. ALUM. CLADDING
 - ⑫ 3mm THK. ALUM. CLADDING
 - ⑬ 3mm THK. ALUM. CLADDING
 - ⑭ 3mm THK. ALUM. CLADDING
 - ⑮ 3mm THK. ALUM. CLADDING
 - ⑯ 3mm THK. ALUM. CLADDING
 - ⑰ 3mm THK. ALUM. CLADDING
 - ⑱ 3mm THK. ALUM. CLADDING
 - ⑲ 3mm THK. ALUM. CLADDING
 - ⑳ 3mm THK. ALUM. CLADDING
 - ㉑ 3mm THK. ALUM. CLADDING
 - ㉒ 3mm THK. ALUM. CLADDING
 - ㉓ 3mm THK. ALUM. CLADDING
 - ㉔ 3mm THK. ALUM. CLADDING
 - ㉕ 3mm THK. ALUM. CLADDING
 - ㉖ 3mm THK. ALUM. CLADDING
 - ㉗ 3mm THK. ALUM. CLADDING
 - ㉘ 3mm THK. ALUM. CLADDING
 - ㉙ 3mm THK. ALUM. CLADDING
 - ㉚ 3mm THK. ALUM. CLADDING
 - ㉛ 3mm THK. ALUM. CLADDING
 - ㉜ 3mm THK. ALUM. CLADDING
 - ㉝ 3mm THK. ALUM. CLADDING
 - ㉞ 3mm THK. ALUM. CLADDING
 - ㉟ 3mm THK. ALUM. CLADDING
 - ㊱ 3mm THK. ALUM. CLADDING
 - ㊲ 3mm THK. ALUM. CLADDING
 - ㊳ 3mm THK. ALUM. CLADDING
 - ㊴ 3mm THK. ALUM. CLADDING
 - ㊵ 3mm THK. ALUM. CLADDING
 - ㊶ 3mm THK. ALUM. CLADDING
 - ㊷ 3mm THK. ALUM. CLADDING
 - ㊸ 3mm THK. ALUM. CLADDING
 - ㊹ 3mm THK. ALUM. CLADDING
 - ㊺ 3mm THK. ALUM. CLADDING
 - ㊻ 3mm THK. ALUM. CLADDING
 - ㊼ 3mm THK. ALUM. CLADDING
 - ㊽ 3mm THK. ALUM. CLADDING
 - ㊾ 3mm THK. ALUM. CLADDING
 - ㊿ 3mm THK. ALUM. CLADDING

CLIENT : SHIMAO GROUP HOLDINGS LIMITED

ARCHITECT : WONG TUNG & PARTNERS LIMITED

MAIN CONTRACTOR : 協興建築有限公司
HIP HING CONSTRUCTION CO. LTD

STRUCTURAL ENGINEER : C.N. WONG & ASSOCIATES LTD
黃志輝建築工程師有限公司

TRADE CONSULTANT : MEYNERDT

NOTE:

1. ALL DIMENSIONS ARE IN mm.
2. ALL ELEVATIONS ARE VIEWED FROM OUTSIDE.
3. DIMENSIONS NOT SHOWN ARE TO BE VIEWED ON SITE BEFORE FABRICATION.

LEGEND:

- ① DETAIL MARK NO.
- ② REFER SHEET NO.
- 1. F.F.L. --- FINISHED FLOOR LEVEL.
- 2. S.F.L. --- STRUCTURAL FLOOR LEVEL.
- 3. --- REVERSED DETAIL.

PROJECT : PROPOSED RESIDENTIAL DEVELOPMENT AT N.K.L.L. 65+42 YIN PING ROAD KOWLOON


TITLE : PART ELEVATION FOR CURTAIN WALL AT TOWER 1

DATE : 02-OCT-21 SCALE : 1:60 (A1)

DRAWN BY : LHR CHECKED BY :

MDI ARCHITECTURE PRACTICE LTD.
610 Cheong Cheong Street, 17/F
T423498211-4 Fax: (852) 27272666

DWG NO. : JBS3-SD-CW-4106 REV. : A

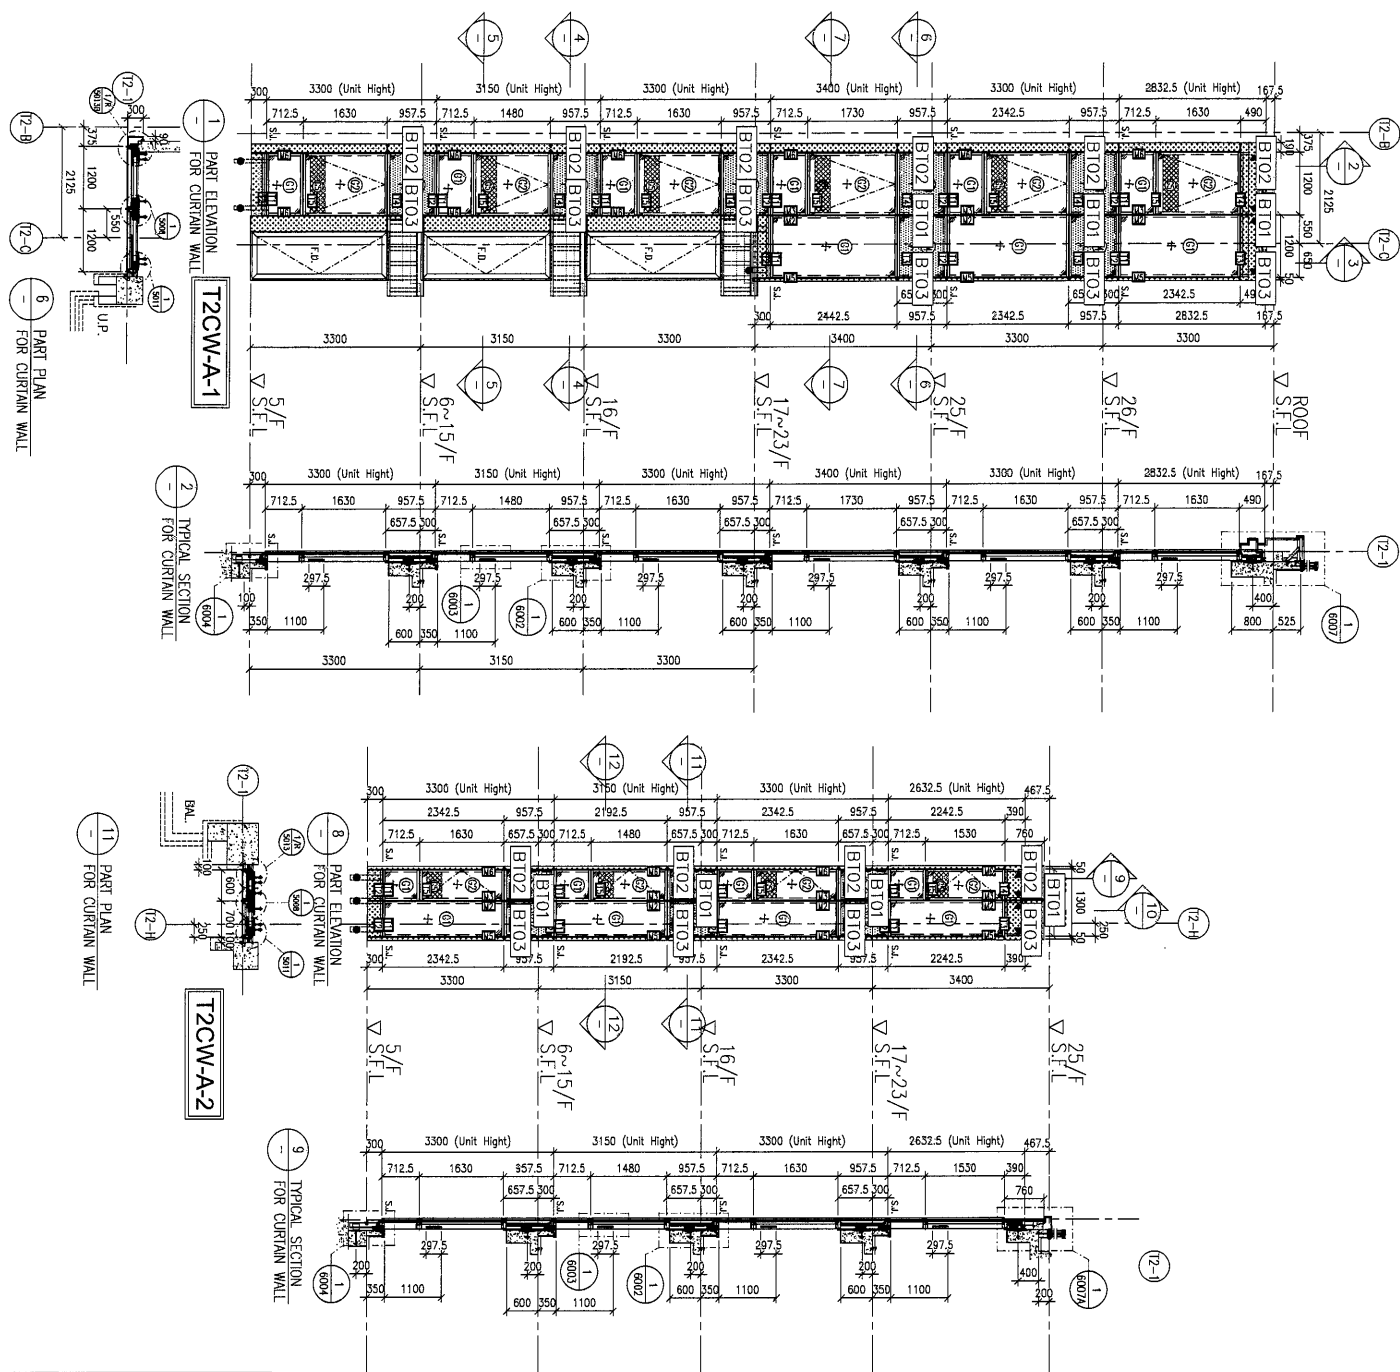

- LEGEND:
- 1. 12mm HEAT STRENGTHENED GLASS (OUTER)
 - 2. 12mm HEAT STRENGTHENED GLASS (INNER)
 - 3. 12mm AIR SPACE + 12mm THK. TEMPERED CLEAR GLASS (INNER)
 - 4. 12mm THK. HEAT STRENGTHENED GLASS (INTERNAL PROTECTIVE BARBER)
 - 5. 3mm THK. ALUM. CLADDING
 - 6. 12mm THK. ALUM. CLADDING
 - 7. 12mm THK. ALUM. CLADDING
FLOOR	LEVEL
R/F	+210.00
29/F	+206.70
28/F	+203.40
27/F	+200.00
26/F	+196.65
25/F	+193.30
24/F	+190.00
23/F	+186.65
22/F	+183.30
21/F	+180.00
20/F	+176.65
19/F	+173.30
18/F	+170.00
17/F	+166.65
16/F	+163.30
15/F	+160.00
14/F	+156.65
13/F	+153.30
12/F	+150.00
11/F	+146.65
10/F	+143.30
9/F	+140.00
8/F	+136.65
7/F	+133.30
6/F	+130.00
5/F	+126.65

1. ALL DIMENSIONS ARE IN MM.
2. ALL ELEVATIONS ARE MEASURED FROM OUTSIDE.
3. BEFORE FABRICATION.
- LEGEND:
- 1. DETAIL MARK NO.
 - 2. REVISION SHEET NO.
 - 3. F.F.L. --- FINISHED FLOOR LEVEL.
 - 4. S.F.L. --- STRUCTURAL FLOOR LEVEL.
 - 5. --- REVERSED DETAIL.

CLIENT : SHIMAO GROUP HOLDINGS LIMITED

ARCHITECT : HOKU & PARTNERS LIMITED

MAIN CONTRACTOR : 協興建築有限公司
HIP HING CONSTRUCTION CO. LTD

STRUCTURAL ENGINEER : C.M. WONG & ASSOCIATES LTD
黃志明建築工程師有限公司

FAÇADE CONSULTANT : WEINYARDT

DATE : 26-MAR-21

DRAWN BY : LHR

CHECKED BY : [Signature]

SCALE : 1:60 (A1)

TITLE : PART ELEVATION FOR CURTAIN WALL AT TOWER 2

PROJECT : PROPOSED RESIDENTIAL DEVELOPMENT AT N.K.I.L. 6542 YIN PING ROAD KOWLOON

JOB NO. : J-653

REVISION SHEET NO. : 1

DATE : 26-MAR-21

BY : [Signature]

DATE : 26-MAR-21

DRAWN BY : LHR

CHECKED BY : [Signature]

SCALE : 1:60 (A1)

TITLE : PART ELEVATION FOR CURTAIN WALL AT TOWER 2


PROJECT : PROPOSED RESIDENTIAL DEVELOPMENT AT N.K.I.L. 6542 YIN PING ROAD KOWLOON

JOB NO. : J-653


REVISION SHEET NO. : 1

DATE : 26-MAR-21

BY : [Signature]

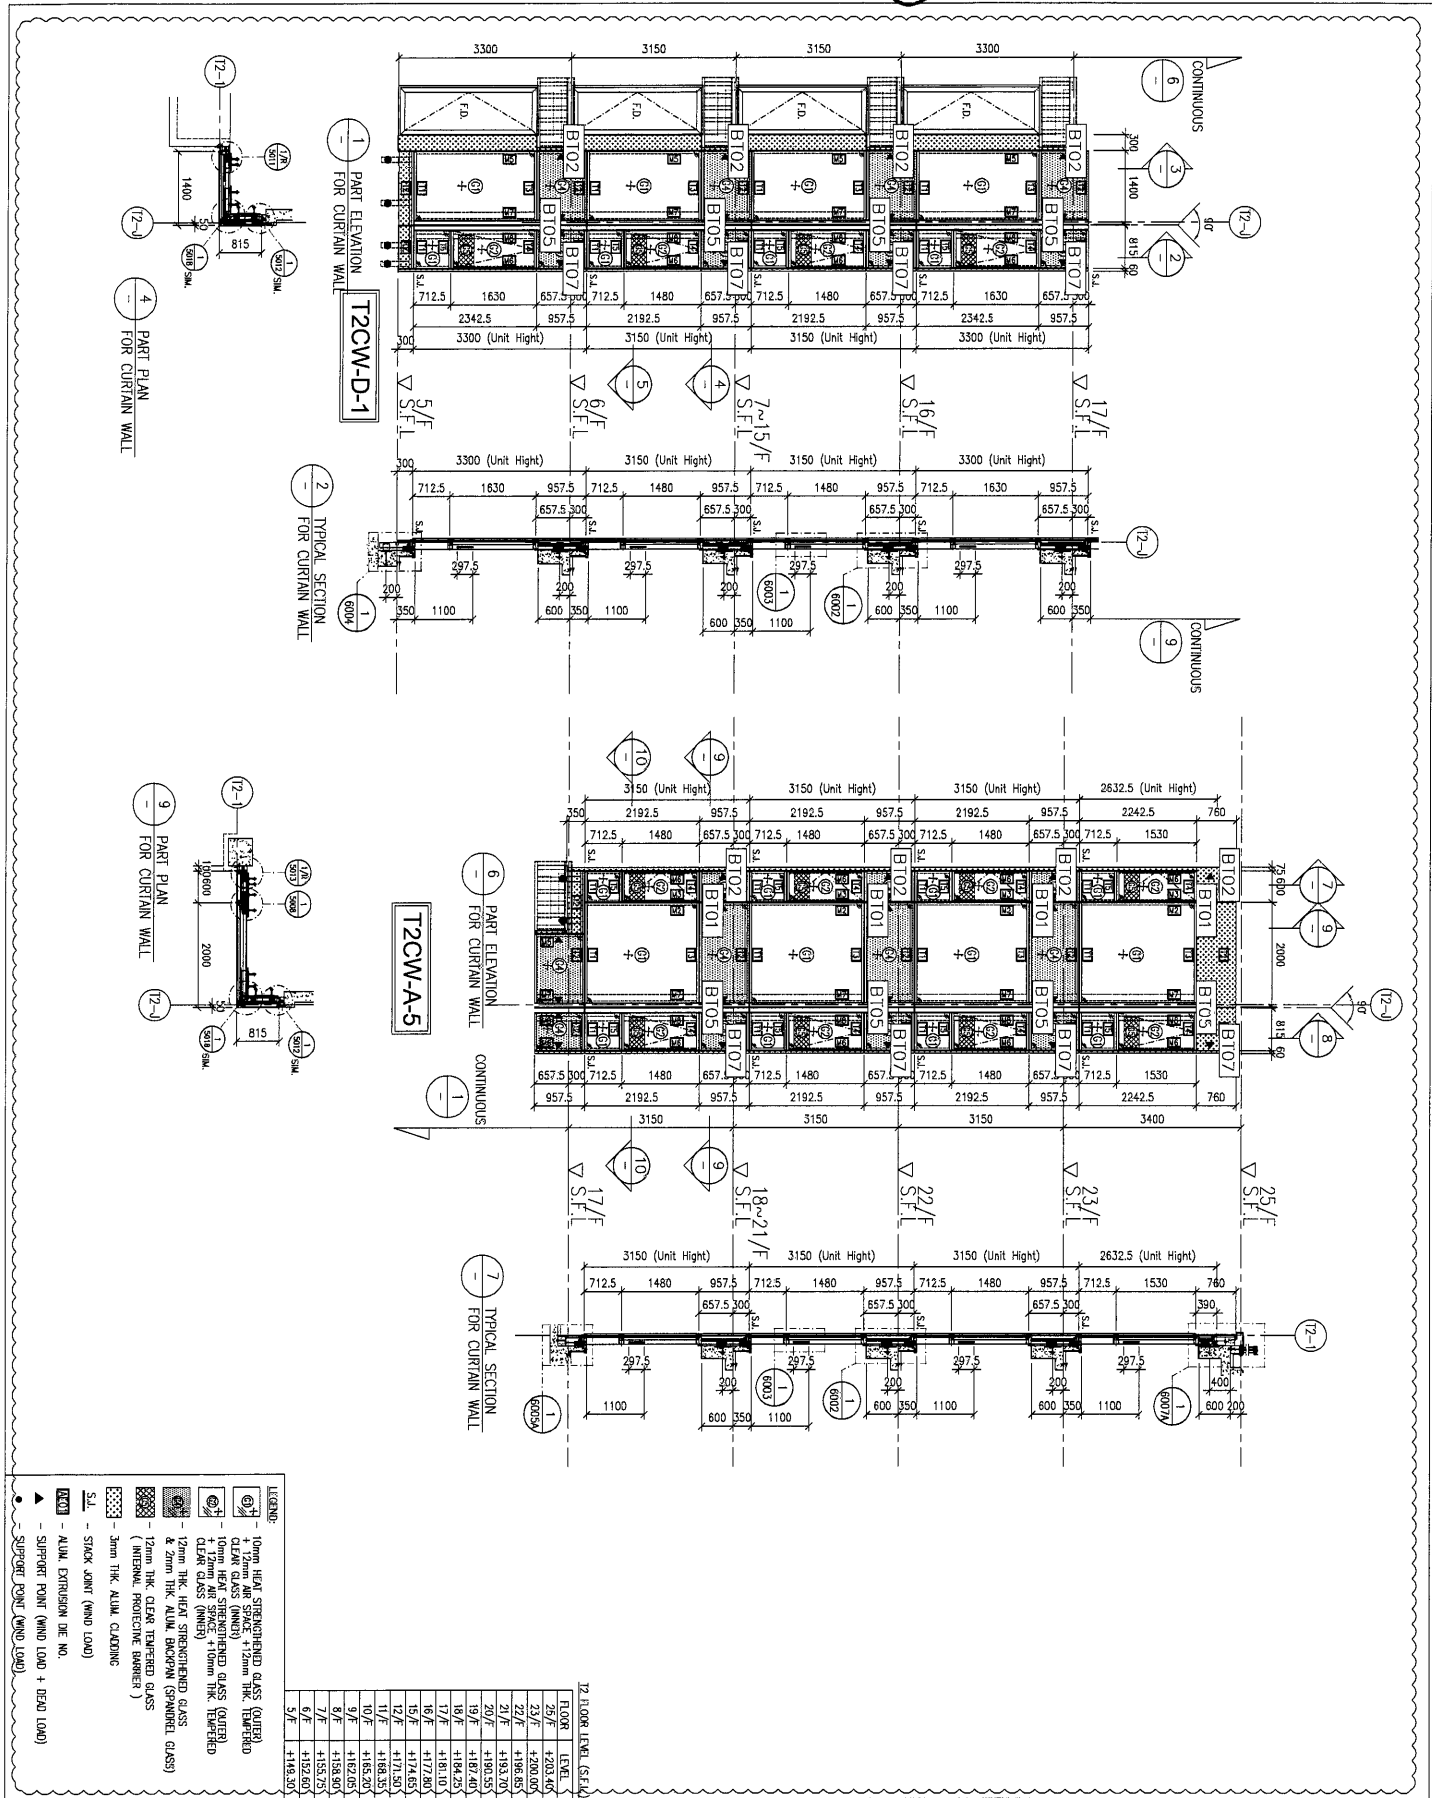

CLIENT : SHIMAO GROUP HOLDINGS LIMITED	
ARCHITECT : WONG TUNG & PARTNERS LIMITED 	
MAIN CONTRACTOR : 協興建築有限公司 HIP HING CONSTRUCTION CO LTD	
STRUCTURAL ENGINEER :  C M WONG & ASSOCIATES LTD 黃志明建築工程師有限公司	
FACADE CONSULTANT: MEINHARDT	
NOTE: 1. ALL DIMENSIONS ARE IN mm. 2. ALL DIMENSIONS ARE TAKEN FROM OUTSIDE. 3. DIMENSIONS TO BE VERTICAL ON SITE. 4. REFERENCE TO BE VERTICAL ON SITE. LEGEND: 	
PROJECT : PROPOSED RESIDENTIAL DEVELOPMENT AT NKILL 65+2 YIN PING ROAD KOWLOON	JOB NO : J-1853
DATE : 26-MAR-21 DRAWN BY : LHR  美特經貿有限公司 650 D'Almeida Street, Kowloon, H.K. Tel: 2488211-4 Fax: 24822727666	SCALE : 1:50 (A1) CHECKED BY : - PAIR ELEVATION OF CURTAIN WALL AT TOWER 2
DWG NO. : JMS3-5D-CN-4203	REV. : A

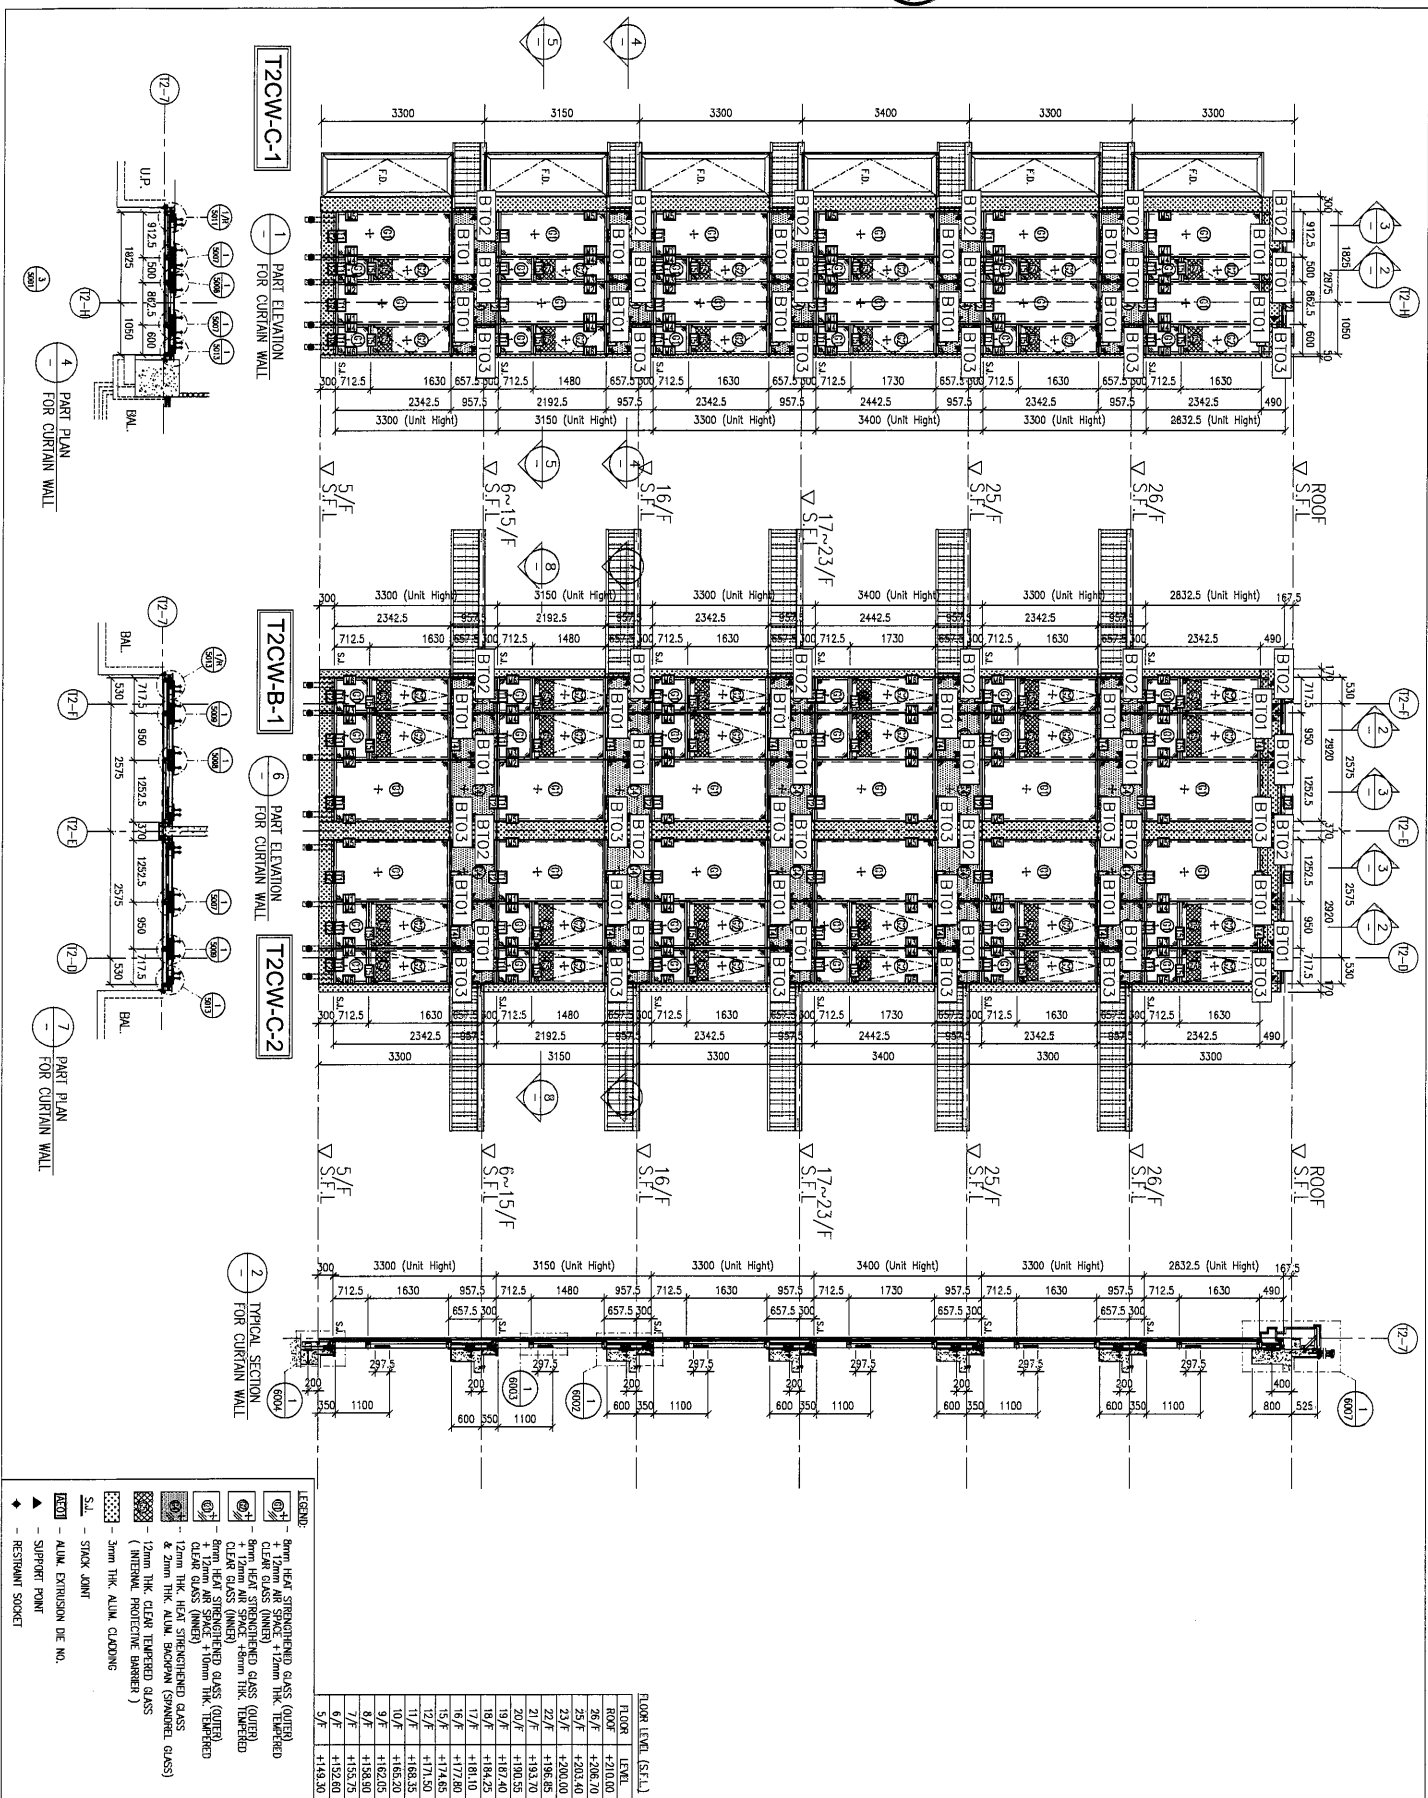

FLOOR LEVEL (F.L.)	FLOOR	LEVEL
26/F	ROOF	+210.00
25/F		+206.70
23/F		+203.40
22/F		+200.00
21/F		+196.85
20/F		+193.70
19/F		+190.55
18/F		+187.40
17/F		+184.25
16/F		+181.10
15/F		+177.80
12/F		+174.65
11/F		+171.50
10/F		+168.35
9/F		+165.20
8/F		+162.05
7/F		+158.90
6/F		+155.75
5/F		+152.60
		+149.30

NOTE :

1. ALL DIMENSIONS ARE IN mm.
2. ALL ELEVATIONS ARE MEASURED FROM OUTSIDE
3. ALL DIMENSIONS TO BE VERIFIED ON SITE BEFORE FABRICATION.

LEGEND :

MEINHARDT

CMA
C M WONG & ASSOCIATES LTD
黃志明建築工程師有限公司
FACADE CONSULTANT:

STRUCTURAL ENGINEER

MAIN CONTRACTOR :
協興建築有限公司
HIP HING CONSTRUCTION CO. LTD.


WONG TUNG & PARTNERS LIMITED
ARCHITECTS & PLANNERS

SHIMAO GROUP
HOLDINGS LIMITED

CLIENT :

BD REF : _____

PROJECT :	PROPOSED RESIDENTIAL DEVELOPMENT AT N.K.I.L. 6542 YIN PING ROAD KOWLOON
TITLE :	PART ELEVATION FOR CURTAIN WALL AT TOWER 2
DATE :	26 - MAR - 21
SCALE :	1:60 (A1)
DRAWN BY :	LHR
CHECKED BY :	黃特銘
	MIDT ALUMINUM FABRICATORS LTD. Data 6-8, Sunny Industrial Centre, 1/F 162, KASNET 1-17, Tseung Koon OI, Kowloon
DWG NO. :	0853-50-CW-420A
REV. :	A

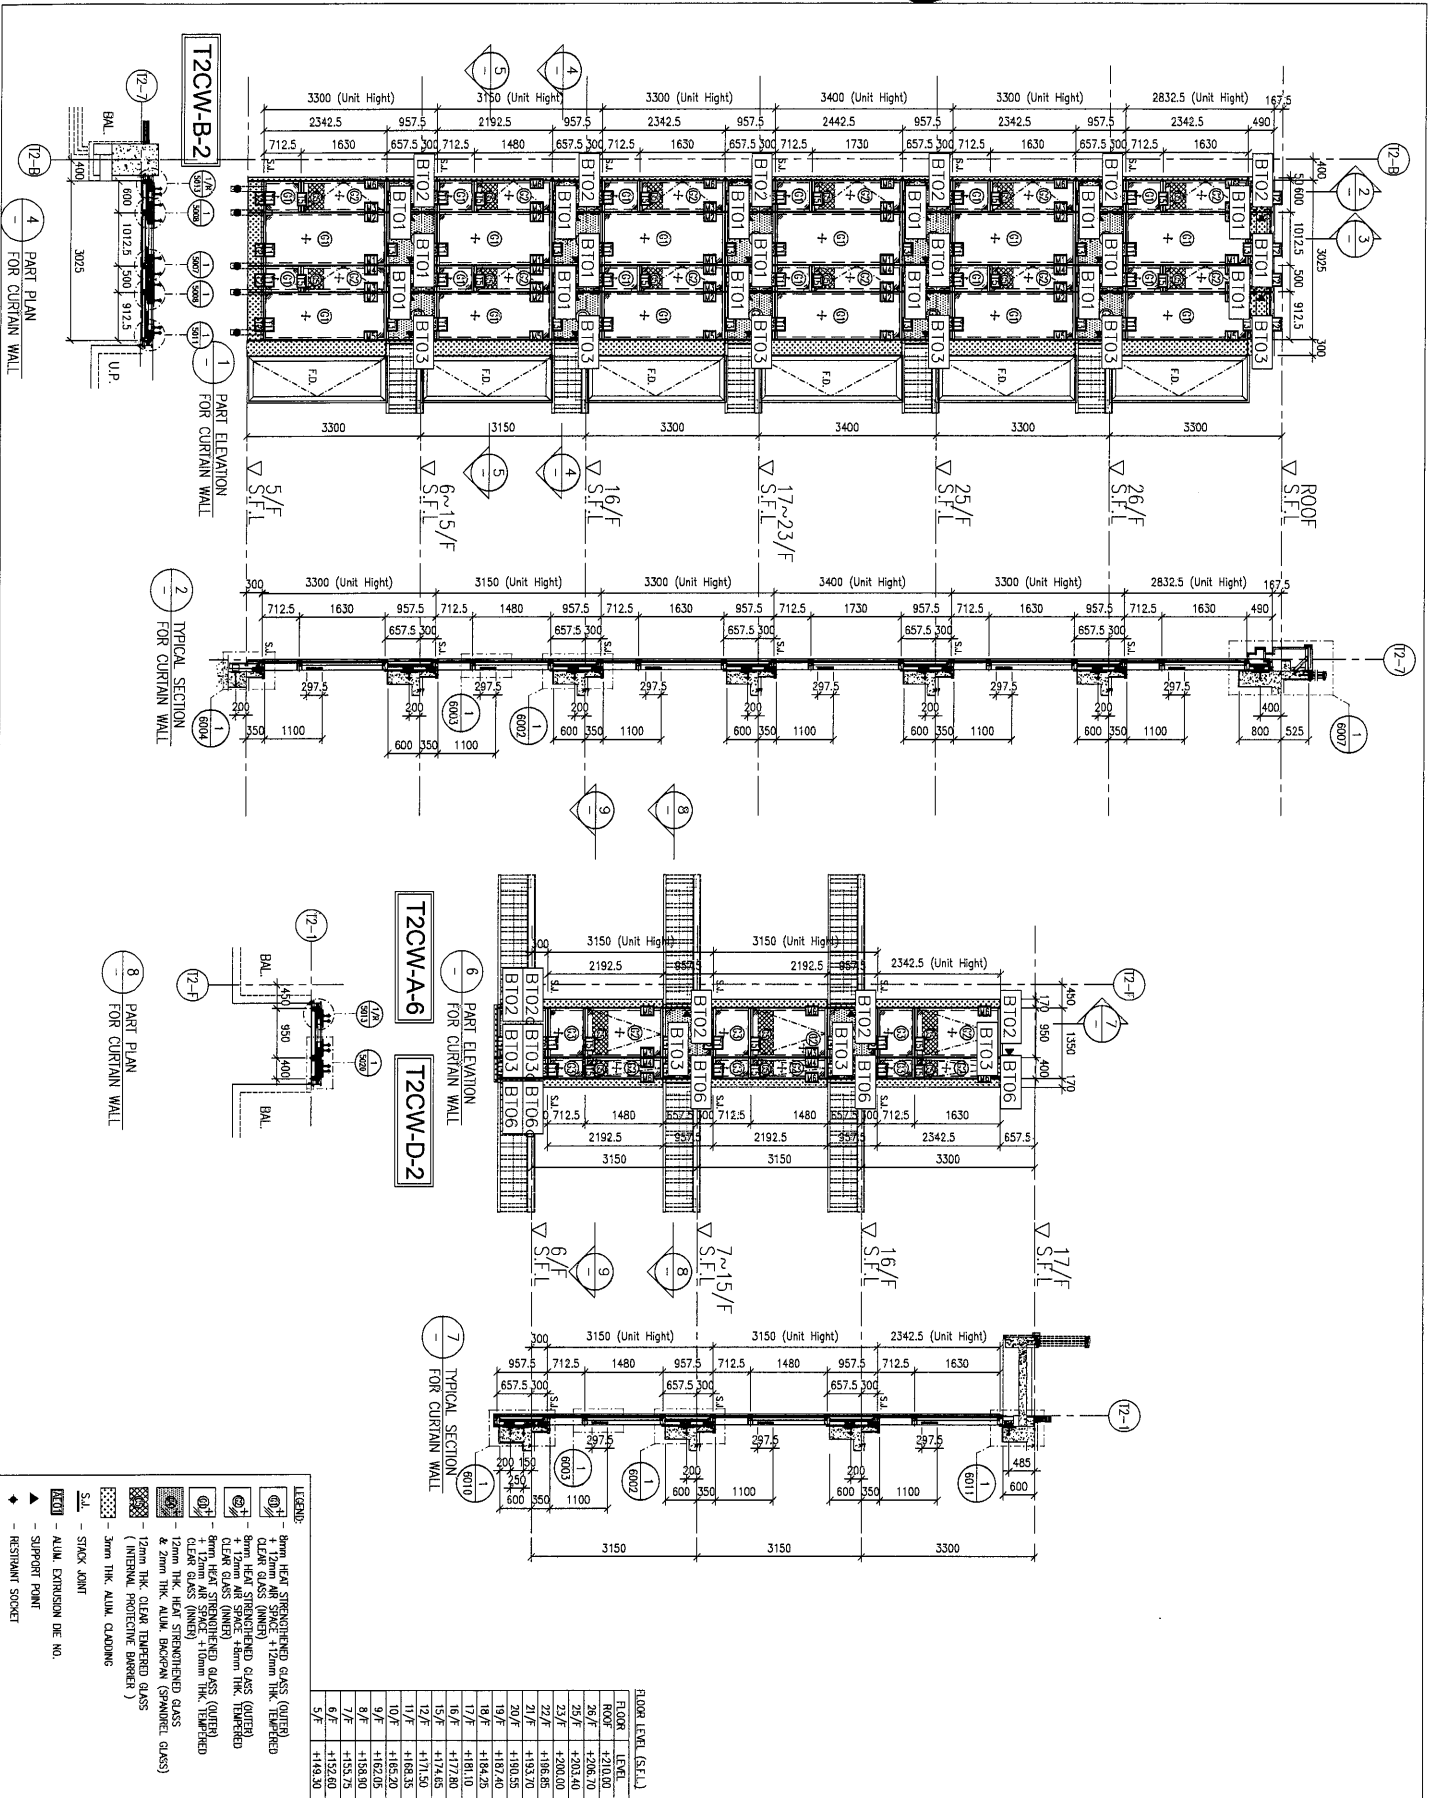

FLOOR LEVEL (SEI.)	LEVEL	FLOOR
	+210.00	ROOF
	+206.70	26/F
	+203.40	25/F
	+200.00	23/F
	+196.85	22/F
	+193.70	21/F
	+190.55	20/F
	+187.40	19/F
	+184.25	18/F
	+181.10	17/F
	+177.85	16/F
	+174.65	15/F
	+171.50	12/F
	+168.35	11/F
	+165.20	10/F
	+162.05	9/F
	+158.90	8/F
	+155.75	7/F
	+152.60	6/F
	+149.50	5/F

NOTE:

1. ALL DIMENSIONS ARE IN mm.
2. ALL ELEVATIONS ARE VIEWED FROM OUTSIDE.
3. ALL DIMENSIONS TO BE VERIFIED ON SITE BEFORE FABRICATION.

LEGEND:

AT

X

0000

DETAIL MARK NO.


REFER SHEET NO.

1. F.F.L. --- FINISHED FLOOR LEVEL
2. S.F.L. --- STRUCTURAL FLOOR LEVEL
3. (70) --- REVERSED DETAIL

CLIENT :	SHIMAO GROUP HOLDINGS LIMITED
ARCHITECT :	WONG TUNG & PARTNERS LIMITED ARCHITECTS & PLANNERS
MAIN CONTRACTOR :	協興建築有限公司 HAP HING CONSTRUCTION CO.
STRUCTURAL ENGINEER :	C M WONG & ASSOCIATES 英荷印建築工程師有限公司
FAÇADE CONSULTANT :	WEINHARDT

BD REF :

PROJECT :	PROPOSED RESIDENTIAL DEVELOPMENT AT N.K.L.L. 65422 YIN PING ROAD KOMOLUON
TITLE :	PART ELEVATION FOR CURTAIN WALL AT TOWER 2
DATE : 26-MAR-21	SCALE : 1:60 (A)
DRAWN BY : L.H.T	CHECKED BY :
 莫特设计有限公司 M&T ENGINEERING & ARCHITECTURE Unit 6-8, Sunny Industrial Estate, 610 Chee Nio Ling Road, Kelantan Tel: 09821-4714 Fax: 09821-7272805	
CWC NO. : J853-SY-CW-42405	REV. :

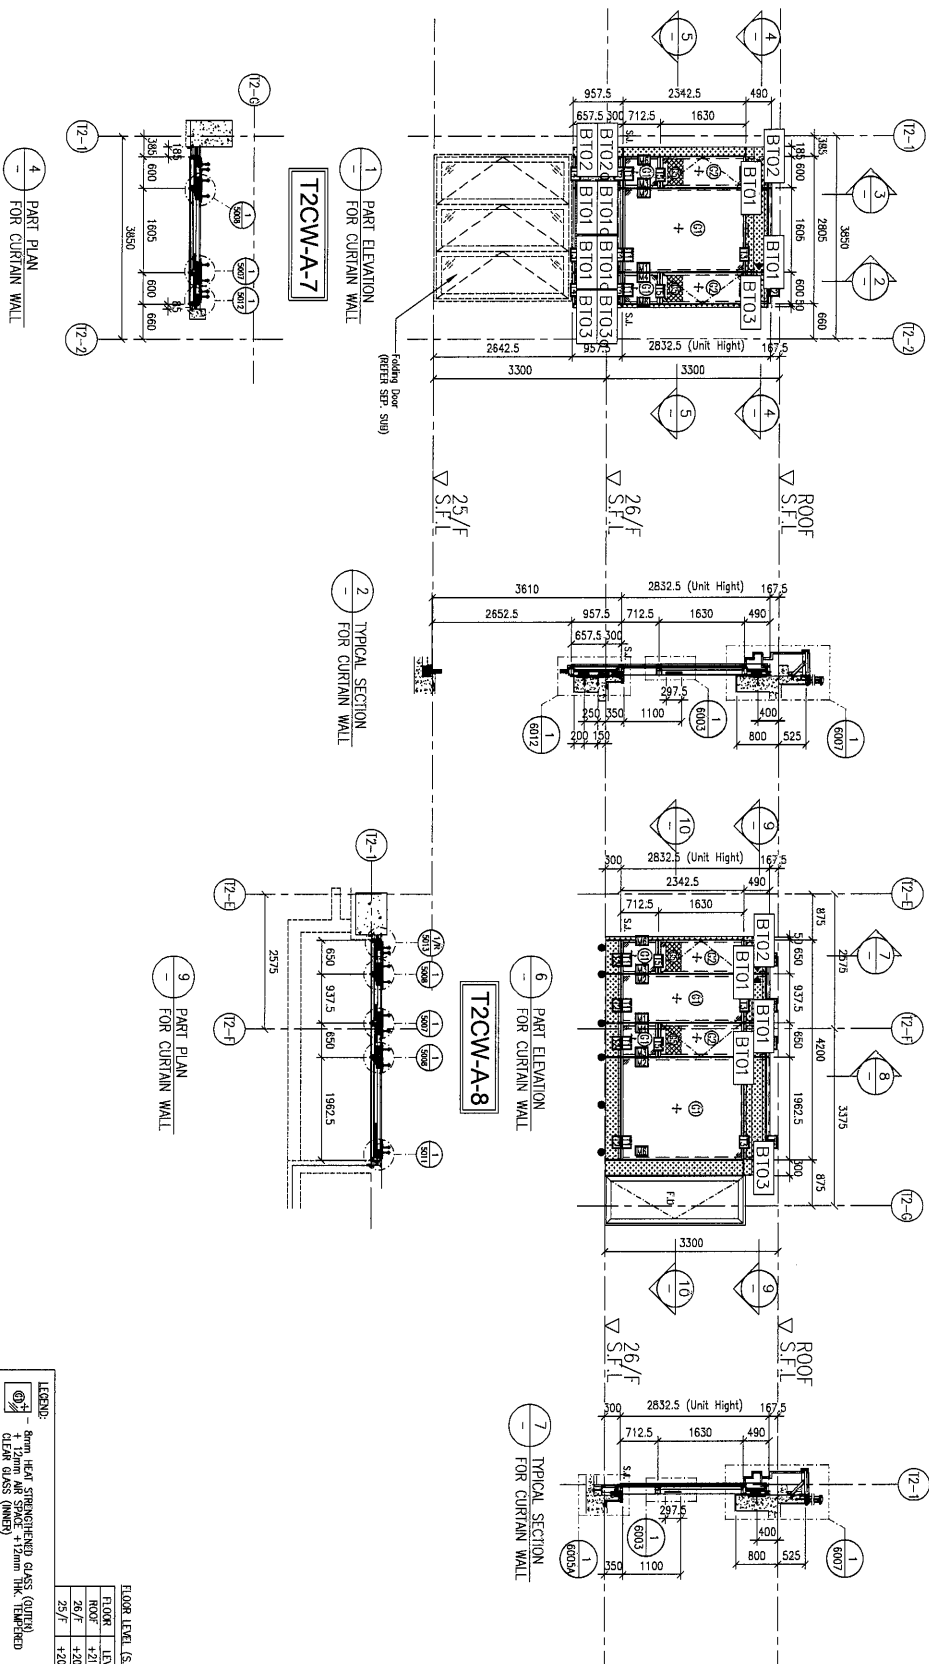

FLOOR LEVEL (S.F.L.)	
FLOOR	LEVEL
ROOF	+210.00
26/F	+206.70
25/F	+203.40

- NOTE:**
1. ALL DIMENSIONS ARE IN mm.
 2. ALL ELEVATIONS ARE VIEWED FROM OUTSIDE.
 3. ALL DIMENSIONS TO BE VERIFIED ON SITE BEFORE FABRICATION.
- LEGEND:**
- X1

DETAIL MARK NO.
- X200

DETER SHEET NO.
1. F.F.L. --- FINISHED FLOOR LEVEL.
 2. S.F.L. --- STRUCTURAL FLOOR LEVEL.
 3. Φ --- REINFORCED DETAIL.

MEIN-YARDI

FACADE CONSULTANT:

C M WONG & ASSOCIATES LTD
黃志明建築工程師有限公司

STRUCTURAL ENGINEER :

協興建築有限公司
HIP HING CONSTRUCTION CO LTD

WONG TUNG & PARTNERS LIMITED



SHIMAO GROUP
HOLDINGS LIMITED

CLIENT :

DATE : 05-OCT-21	SCALE : 1:60 (A1)
DRAWN BY : LHR	CHECKED BY :

美特鋁質有限公司
MIDI ALUMINIUM FABRICATOR LTD.
Units 6-8, Sunray Industrial Centre, 1/F


DWG NO. : J853-SD-CW-4206	REV. : A
---------------------------	----------

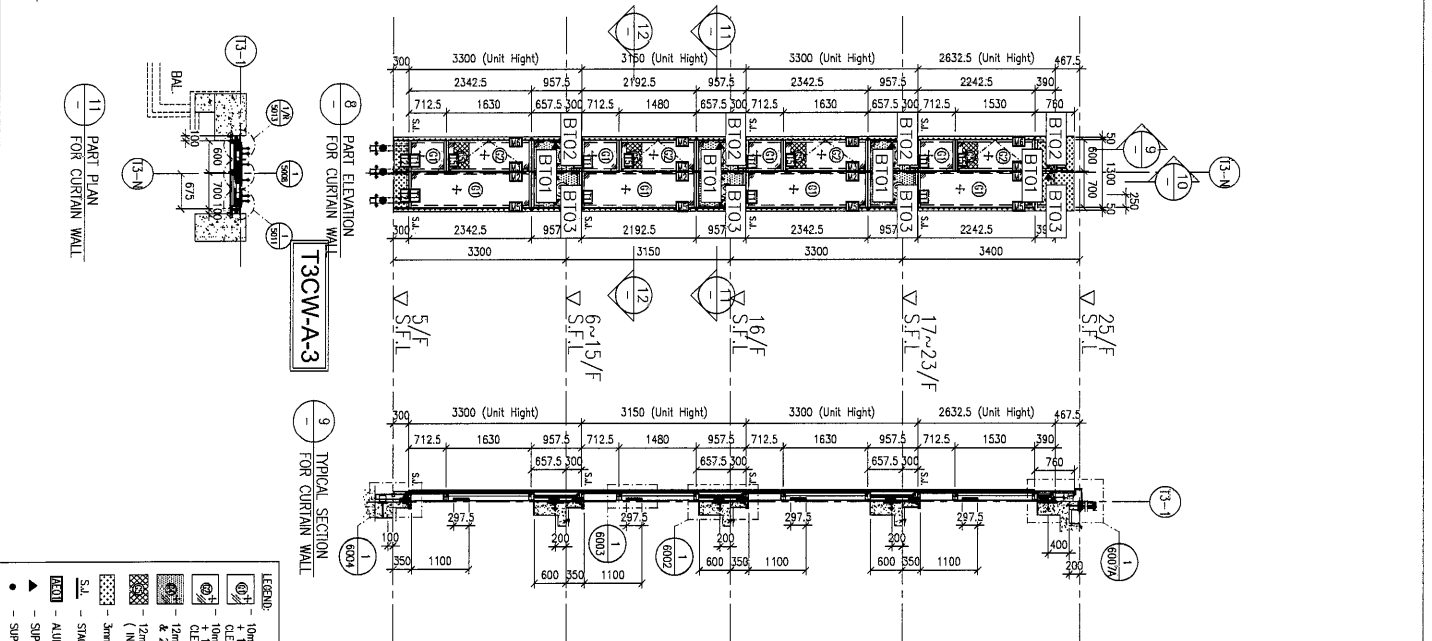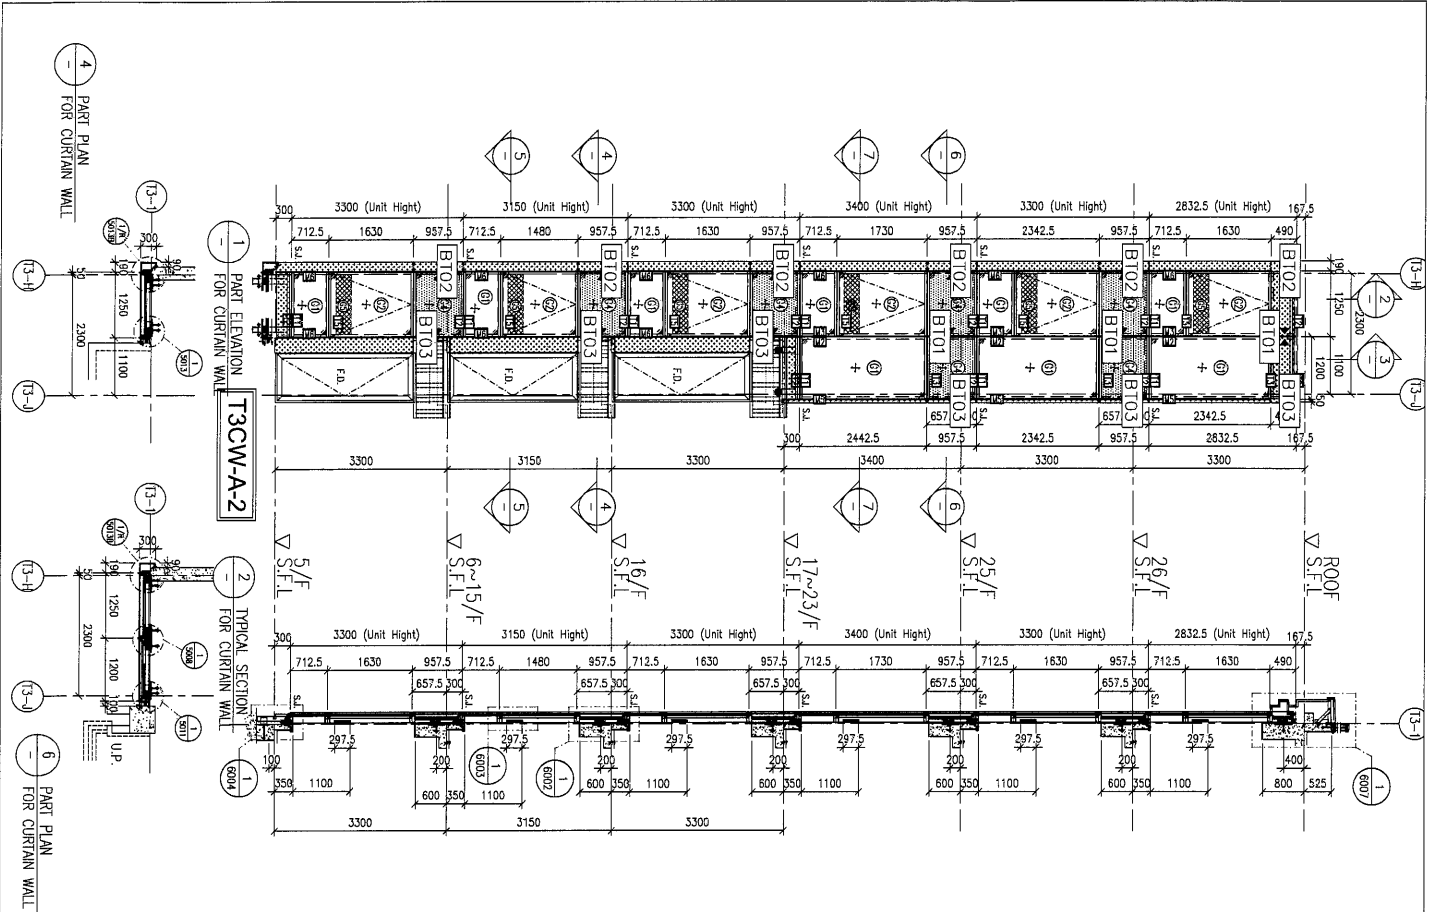

FLOOR	LEVEL
25/F	+206.70
25/F	+203.40
23/F	+200.00
22/F	+196.85
21/F	+193.70
20/F	+190.55
18/F	+184.25
17/F	+181.10
16/F	+177.80
15/F	+174.65
12/F	+171.50
11/F	+168.35
10/F	+165.20
9/F	+162.05
8/F	+158.90
7/F	+155.75
6/F	+152.60
5/F	+149.50

- | LEGEND: | |
|---------|--|
| | - 10mm HEAT STRENGTHENED GLASS (OUTER) |
| | - 10mm HEAT STRENGTHENED GLASS (INNER) |
| | - 12mm HEAT STRENGTHENED GLASS (OUTER) |
| | - 12mm HEAT STRENGTHENED GLASS (INNER) |
| | - 12mm HEAT STRENGTHENED GLASS (SPANDREL GLASS) |
| | - 12mm THK. CLEAR TEMPERED GLASS (INTERNAL PROTECTIVE BARRIER) |
| | - 3mm THK. ALUM. CLADDING |
| | - STACK JOINT (WIND LOO) |
| | - ALUM. EXTRUSION DE NO. |
| | - SUPPORT POINT (WIND LOO) + DEO LOO |
| | - SUPPORT POINT (WIND LOO) |

B.O. REF : 		CLIENT : SHIMAO GROUP HOLDINGS LIMITED		ARCHITECT : MOCK TUNG & PARTNERS LIMITED 		MAIN CONTRACTOR :  協興建築有限公司 HIP HING CONSTRUCTION CO LTD		STRUCTURAL ENGINEER : CMA C M WONG & ASSOCIATES LTD 黃志明建築工程師有限公司		FACADE CONSULTANT: MEINHARDT		NOTE: 1. ALL DIMENSIONS ARE IN mm. 2. ALL ELEVATIONS ARE WORKED FROM OUTSIDE. 3. ALL DIMENSIONS TO BE VERIFIED ON SITE BEFORE FABRICATION. LEGEND: (X) REF. DETAIL MARK NO. (200) REF. SHEET NO. 1. F.F.L. --- FINISHED FLOOR LEVEL 2. S.F.L. --- STRUCTURAL FLOOR LEVEL 3. (P) --- PROPOSED DETAIL	
DATE : 26-MAR-21 DRAWN BY : LHR CHECKED BY : DATE : 05-04-2021 NO. 4 JOB NO. : J-453 PRODUCT : PROPOSED RESIDENTIAL DEVELOPMENT AT N.K.L. 6542 YIN PING ROAD KOWLOON TITLE : PART ELEVATION FOR CURTAIN WALL AT TOWER 3 DWG NO. : J053-SI-CW-A-4302 REV. : A		SCALE : 1:80 (A1) CHECKED BY : DATE : 05-04-2021 NO. 4 JOB NO. : J-453 PRODUCT : PROPOSED RESIDENTIAL DEVELOPMENT AT N.K.L. 6542 YIN PING ROAD KOWLOON TITLE : PART ELEVATION FOR CURTAIN WALL AT TOWER 3 DWG NO. : J053-SI-CW-A-4302 REV. : A		DATE : 26-MAR-21 DRAWN BY : LHR CHECKED BY : DATE : 05-04-2021 NO. 4 JOB NO. : J-453 PRODUCT : PROPOSED RESIDENTIAL DEVELOPMENT AT N.K.L. 6542 YIN PING ROAD KOWLOON TITLE : PART ELEVATION FOR CURTAIN WALL AT TOWER 3 DWG NO. : J053-SI-CW-A-4302 REV. : A		DATE : 26-MAR-21 DRAWN BY : LHR CHECKED BY : DATE : 05-04-2021 NO. 4 JOB NO. : J-453 PRODUCT : PROPOSED RESIDENTIAL DEVELOPMENT AT N.K.L. 6542 YIN PING ROAD KOWLOON TITLE : PART ELEVATION FOR CURTAIN WALL AT TOWER 3 DWG NO. : J053-SI-CW-A-4302 REV. : A		DATE : 26-MAR-21 DRAWN BY : LHR CHECKED BY : DATE : 05-04-2021 NO. 4 JOB NO. : J-453 PRODUCT : PROPOSED RESIDENTIAL DEVELOPMENT AT N.K.L. 6542 YIN PING ROAD KOWLOON TITLE : PART ELEVATION FOR CURTAIN WALL AT TOWER 3 DWG NO. : J053-SI-CW-A-4302 REV. : A		DATE : 26-MAR-21 DRAWN BY : LHR CHECKED BY : DATE : 05-04-2021 NO. 4 JOB NO. : J-453 PRODUCT : PROPOSED RESIDENTIAL DEVELOPMENT AT N.K.L. 6542 YIN PING ROAD KOWLOON TITLE : PART ELEVATION FOR CURTAIN WALL AT TOWER 3 DWG NO. : J053-SI-CW-A-4302 REV. : A			

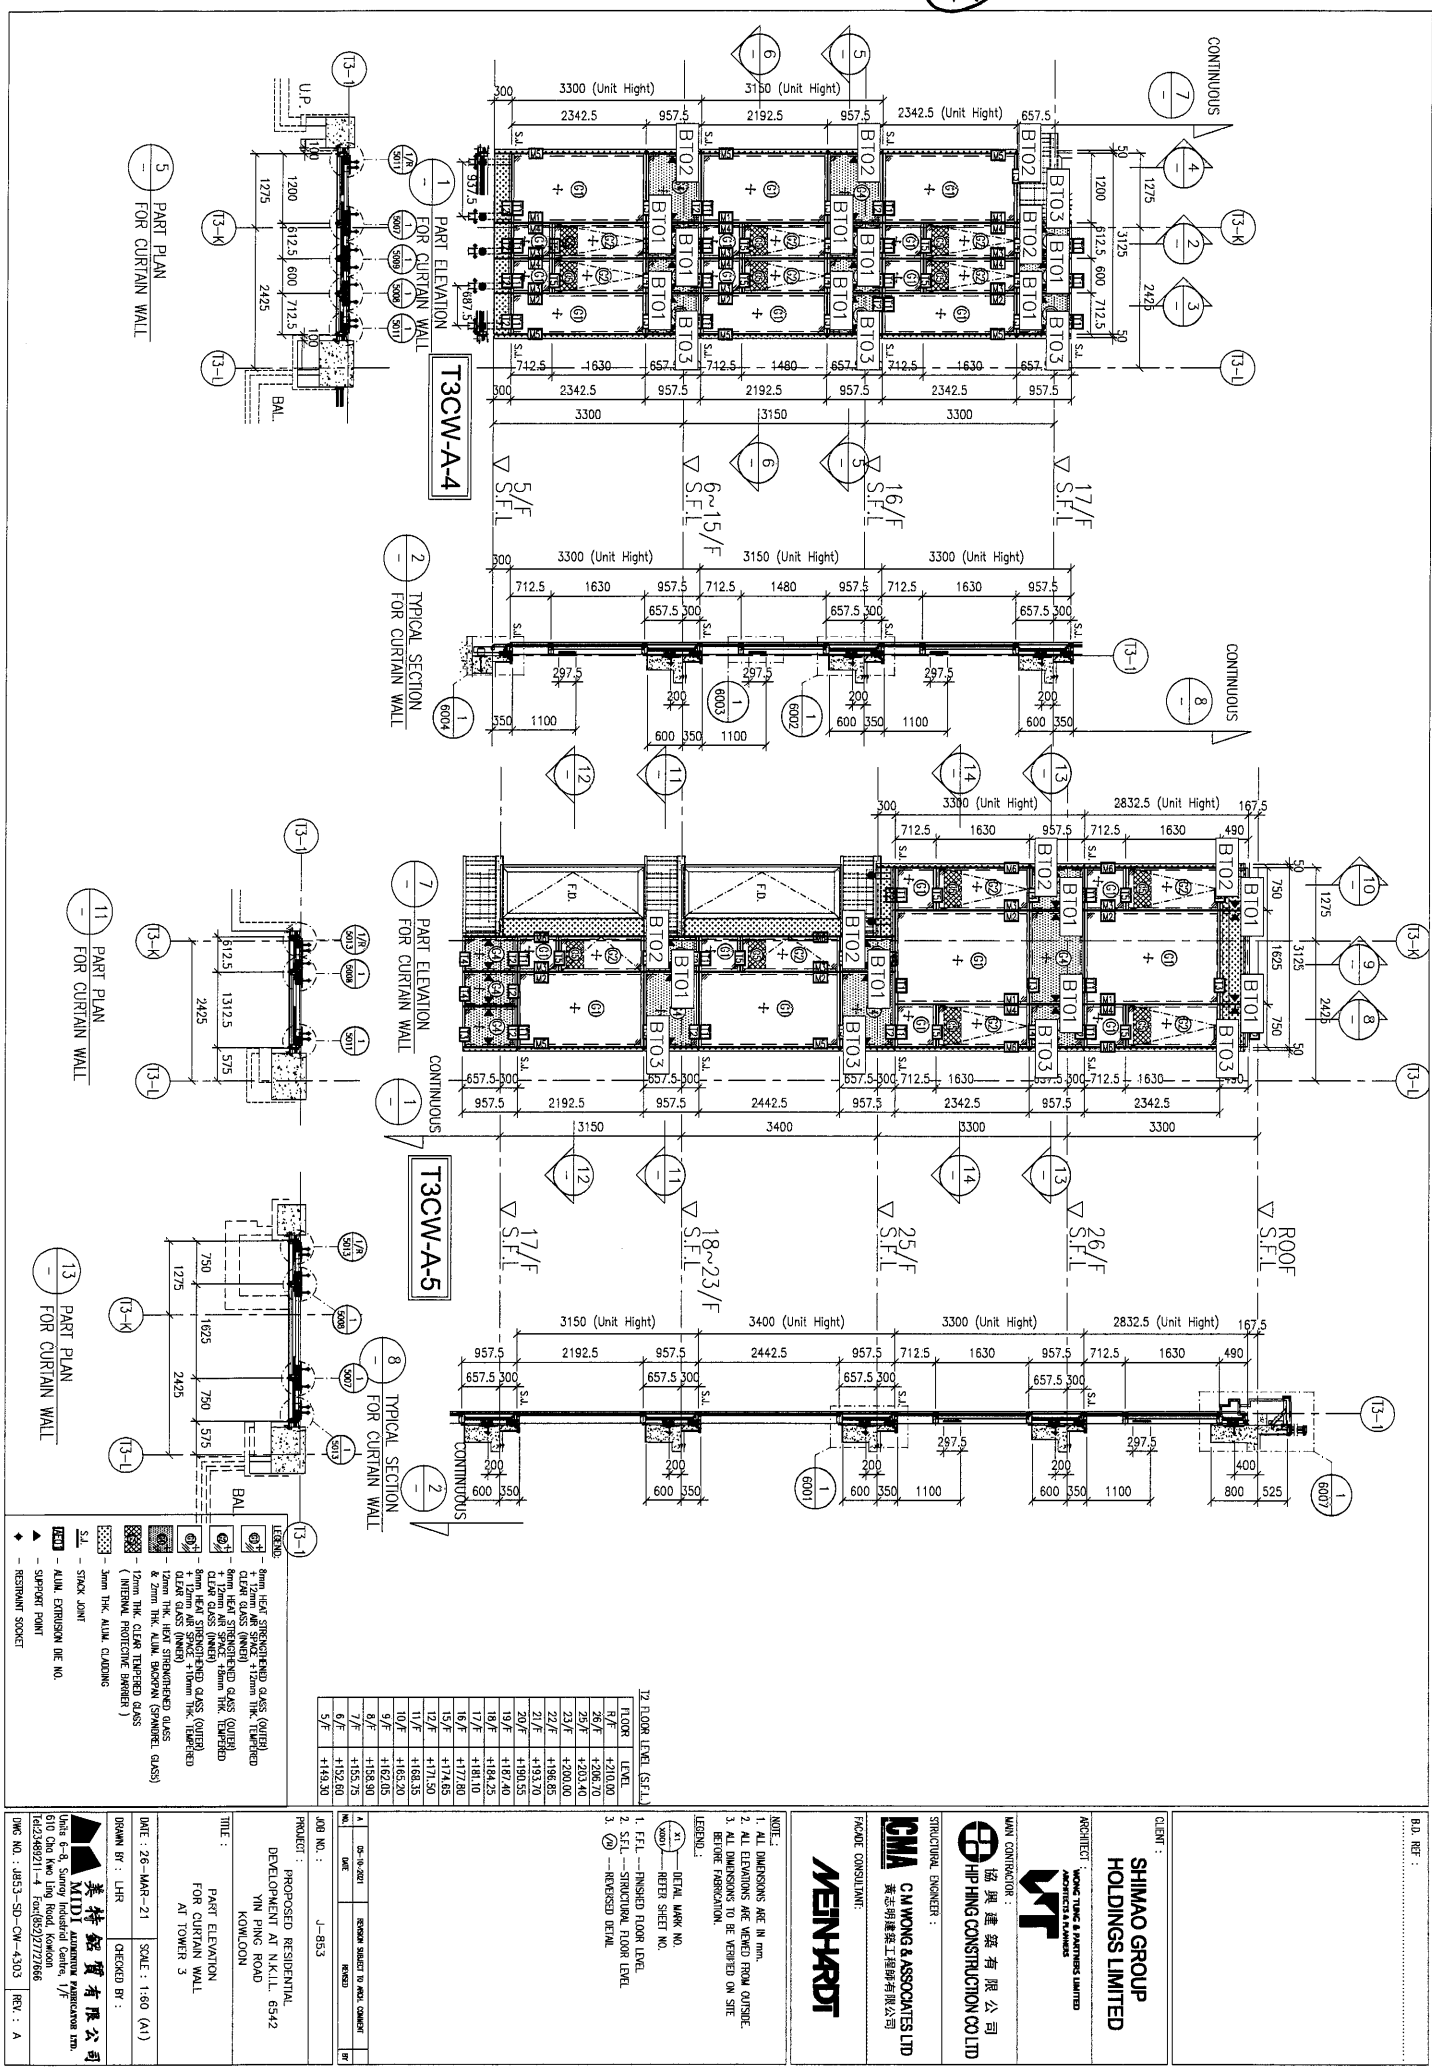

**ARCHITECT :
WONG TUNG & PARTNERS LIMITED**

MAIN CONTRACTOR :

HIP HING CONSTRUCTION CO LTD
協興建築有限公司

C M WONG & ASSOCIATES LTD
黃志明建築工程師有限公司

FACADE CONSULTANT:

MEINARDT

NOTE:

2. ALL ELEVATIONS ARE MEASURED FROM OUTSIDE.
3. ALL DIMENSIONS TO BE VERIFIED ON SITE BEFORE FABRICATION.

LEGEND

1. F.F.L. --- FINISHED FLOOR LEVEL
2. S.F.L. --- STRUCTURAL FLOOR LEVEL
3. ☒ R --- REVERSED DETAIL

JOB NO. : J-8

PROPOSED RESIDENTIAL
DEVELOPMENT AT N.K.I.L. 6542

YIN PING ROAD

TIME : DATE :

FOR CURTAIN WALL
AT TOWER 3



[illegible]

DRAWN BY : IHB	CHECKED BY :
----------------	--------------

富特有限公司

Units 6-8, Sunray Industrial Centre, 1/F

16:23489211-4 Fox:(852)21121666

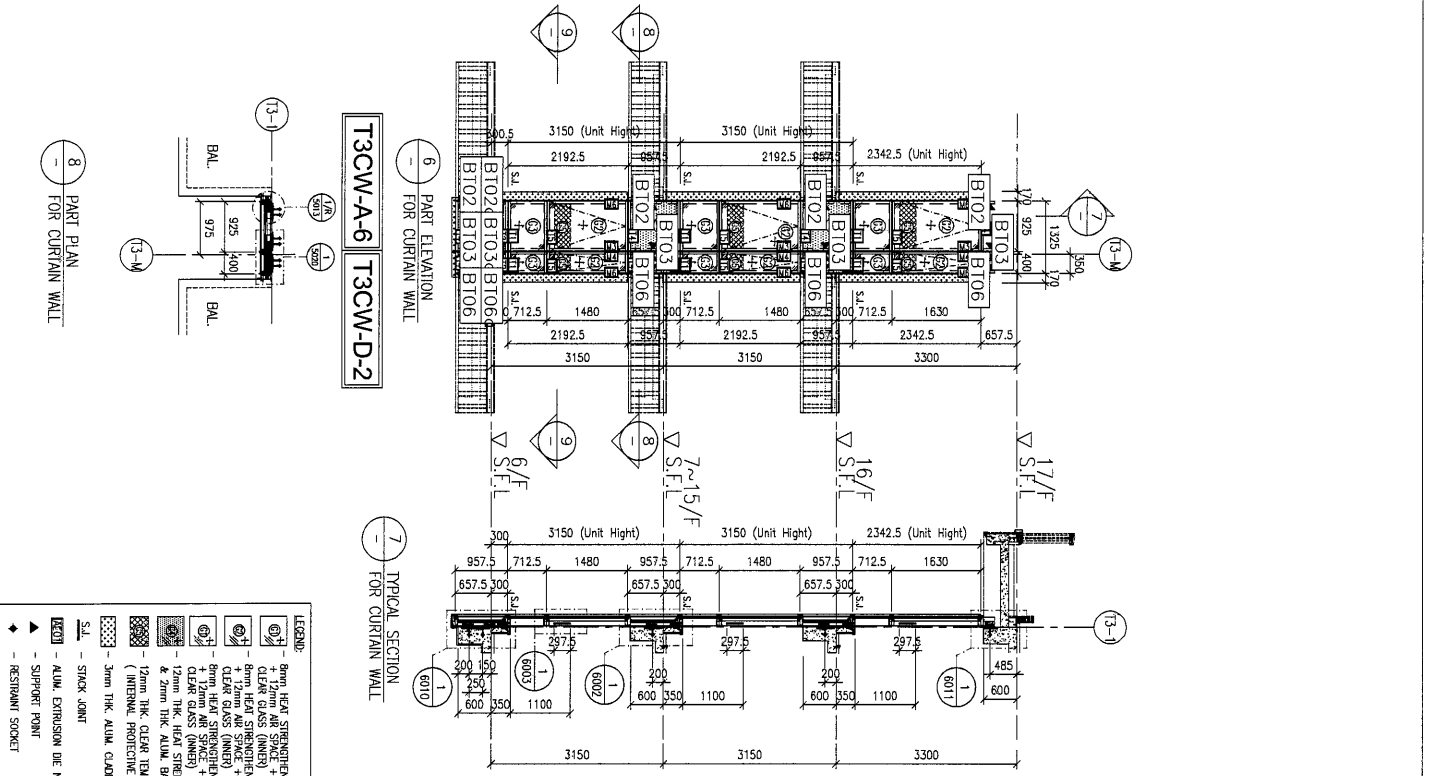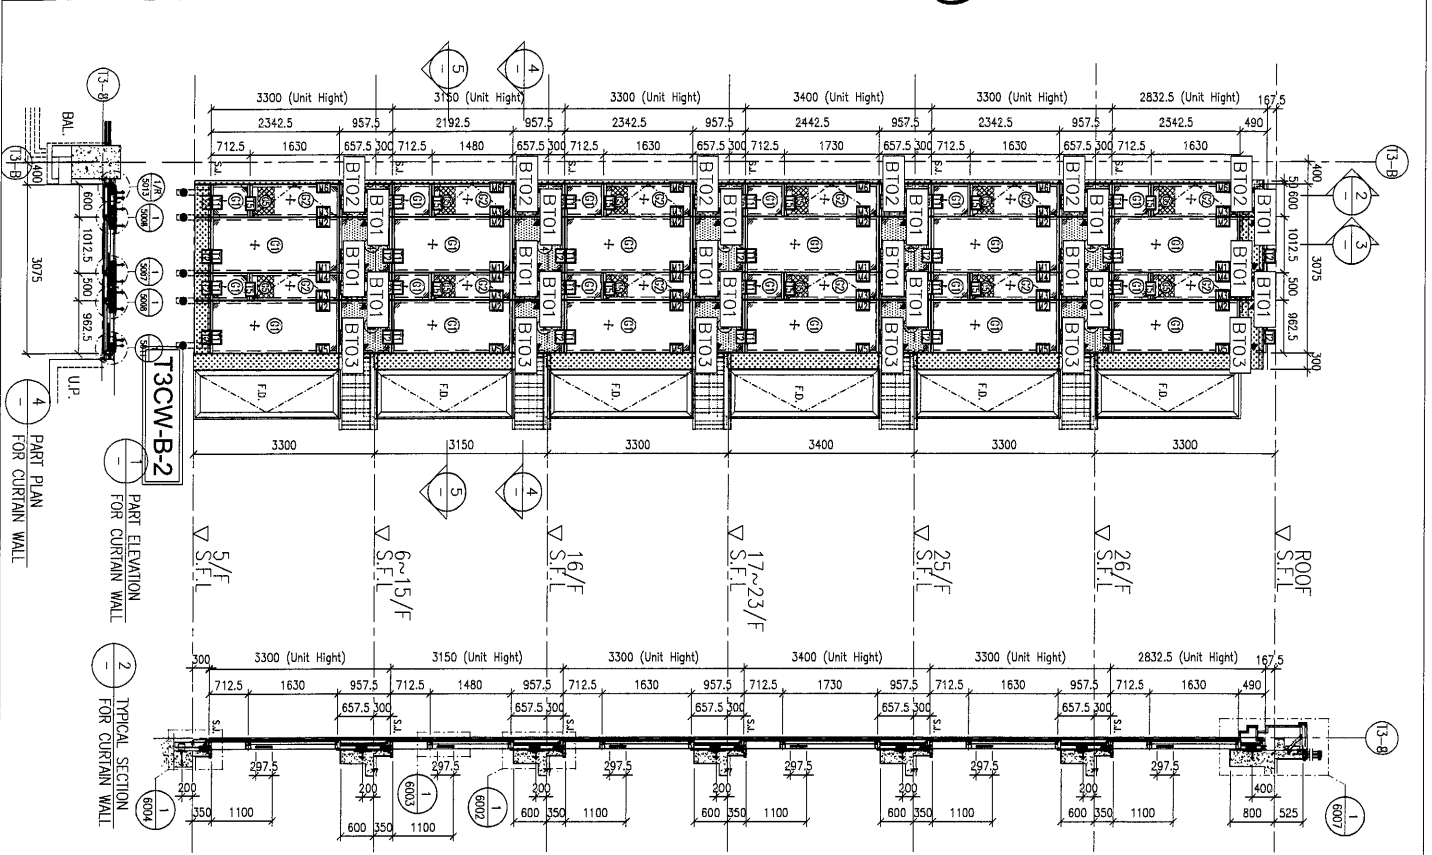

FLOOR LEVEL (S.F.L.)	FLOOR LEVEL (S.F.L.)
ROOF	+210.00
26/F	+206.70
25/F	+203.40
24/F	+200.00
23/F	+196.85
22/F	+193.70
21/F	+190.35
20/F	+187.40
19/F	+184.25
18/F	+181.10
17/F	+177.95
16/F	+174.80
15/F	+171.65
14/F	+168.50
13/F	+165.35
12/F	+162.20
11/F	+159.05
10/F	+155.90
9/F	+152.75
8/F	+149.60
7/F	+146.45
6/F	+143.30
5/F	+140.15

CLIENT : SHIMAO GROUP HOLDINGS LIMITED

ARCHITECT : WONG TUNG & PARTNERS LIMITED

MAIN CONTRACTOR : 協興建築有限公司 HIP HING CONSTRUCTION CO. LTD

STRUCTURAL ENGINEER : CMA C.H. WONG & ASSOCIATES LTD 黃志明建築工程師有限公司

FAÇADE CONSULTANT : MEYNERDT

NOTE:

1. ALL DIMENSIONS ARE IN mm.

2. ALL DIMENSIONS ARE VERIFIED FROM OUTSIDE.

3. BEFORE FABRICATION, BE VERIFIED ON SITE.

LEGEND:

1. DETAIL MARK NO.

2. REFER SHEET NO.

3. SELF-STRUCTURAL FLOOR LEVEL.

4. REVERSED DETAIL.

PROJEC : PROPOSED RESIDENTIAL DEVELOPMENT AT N.K.L.L. 6542 YIN PING ROAD KOWLOON

TITLE : PART ELEVATION FOR CURTAIN WALL AT TOWER 3

DATE : 05-OCT-21 SCALE : 1:80 (A1)

DRAWN BY : LHM CHECKED BY :

MDI ALUMINUM HANGKOWAN LTD. 美特鋁貿有限公司

810 Cheung Cheong Street, 1/F

Tel: 2469211-4 Fax: 2469277

DWG NO. : 4853-SD-CN-4305 REF. : A

ARCHITECT : WONG TUNG & PARTNERS LIMITED

NON CONTINUO :
協興建築有限公司
HIP HING CONSTRUCTION CO LTD

C M WONG & ASSOCIATES LTD
黃志明建築工程師有限公司

MEINHARDT

1. ALL DIMENSIONS ARE IN mm.
2. ALL ELEVATIONS ARE VIEWED FROM OUTSIDE.
3. ALL DIMENSIONS TO BE VERIFIED ON SITE BEFORE FABRICATION.

X1	DETAIL MARK NO.
X001	REFER SHEET NO.

1. F.F.L. — FINISHED FLOOR LEVEL
2 S.F.I. — STRUCTURAL FLOOR LEVEL

...מסמכים שונים

--	--

JOB NO. : 1-85

PROJECT : PROPOSED RE

DEVELOPMENTAL AI
YIN PING

NAME :	
--------	--

FOR CURTAIN

--	--


DATE : 03-06-21	3
-----------------	---

▲▲▲

MIDI ATU
Units 6-8 Sinter Industrial C

Tel: 23489211-4 Fax: (852) 27

DMS NO. : 0000-3D-CM-


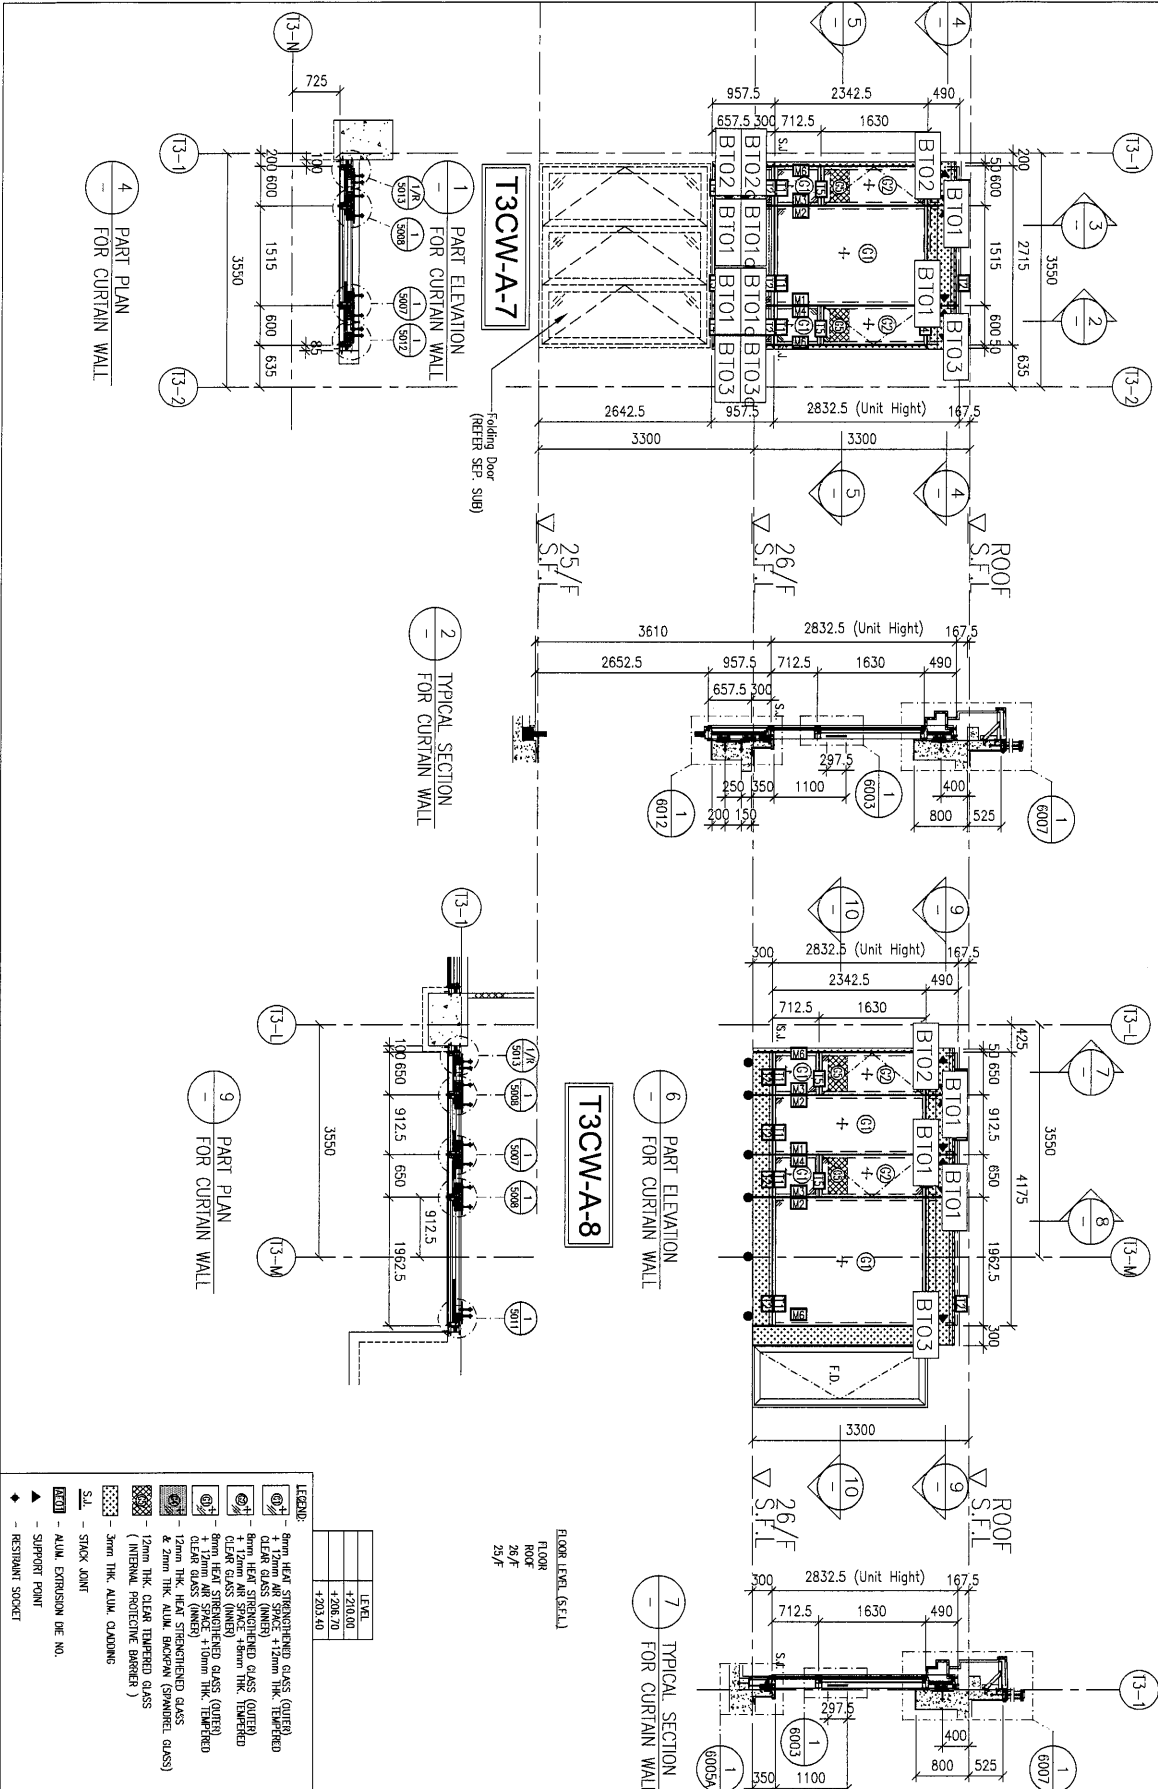


	LEVEL
	+210.00
	+206.70
	+203.40

FLOOR
ROOF
26/F
25/F

	Brown HEAT STRENGTHENED GLASS (QUELYE) + 12mm air space + 12mm thick, tempered CLEAR GLASS (INTEK)
	Brown HEAT STRENGTHENED GLASS (QUELYE) + 12mm air space + 12mm thick, tempered CLEAR GLASS (INTEK)
	Brown HEAT STRENGTHENED GLASS (QUELYE) + 12mm air space + 10mm thick, tempered CLEAR GLASS (INTEK)
	12mm thick CLEAR TEMPERED GLASS (INTERNAL PROTECTIVE BARRIER)
	12mm thick CLEAR TEMPERED GLASS (INTERNAL PROTECTIVE BARRIER)

- STACK JOINT
- ALUM. EXTRUSION DIE NO.
- SUPPORT POINT
- RESISTANT SOCKET

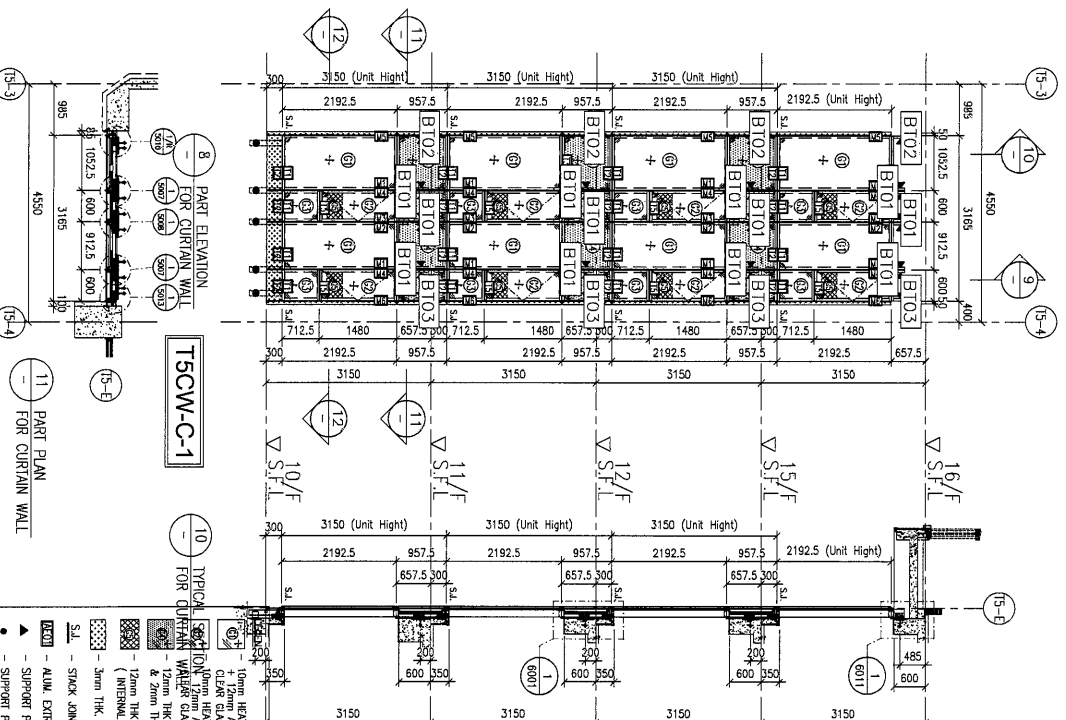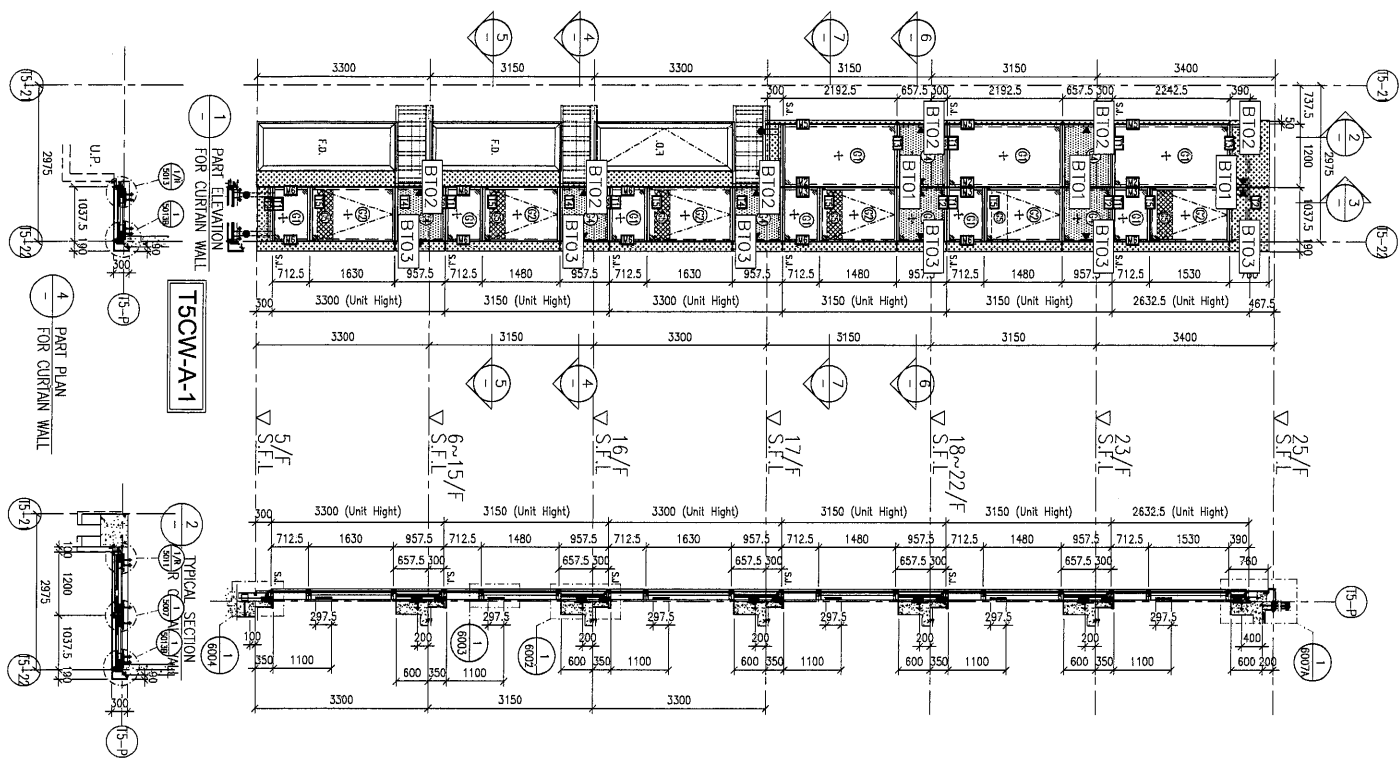

FLOOR	LEVEL
25/F	+203.40
23/F	+200.00
22/F	+196.85
21/F	+193.70
20/F	+190.55
19/F	+187.40
18/F	+184.25
17/F	+181.10
16/F	+177.90
15/F	+174.65
12/F	+171.50
11/F	+168.35
10/F	+165.20
9/F	+162.05
8/F	+158.90
7/F	+155.75
6/F	+152.60
5/F	+149.40

NOTE:

1. ALL DIMENSIONS ARE IN mm.
2. ALL ELEVATIONS ARE VIEWED FROM OUTSIDE.
3. ALL DIMENSIONS TO BE VARIED ON SITE BEFORE FABRICATION.

LEGEND:

	DETAIL MARK NO.
	REFER SHEET NO.

1. F.F.L. --- FINISHED FLOOR LEVEL
2. S.F.L. --- STRUCTURAL FLOOR LEVEL
3.  --- REVERSED DETAIL

CEMA
C M WONG & ASSOCIATES LTD
黃志明建築工程師有限公司

MEINHARDT

FAÇADE CONSULTANT:

ARCHITECT :
WONG TUNG & PARTNERS LIMITED
ARCHITECTS & PLANNERS


MAIN CONTRACTOR :
WTF

STRUCTURAL ENGINEER :
協興建築有限公司
HIP HING CONSTRUCTION CO. LD.

CLIENT : **SHIMAO GROUP
HOLDINGS LIMITED**

B.O. REF. :

DATE : 31-MAR-21		SQME : 1:50 (A1)
CHECKED BY :		
DRAWN BY : LHR		
 美特銘貿易有限公司 (MID) Mitsui Bussan Kaisha, Ltd. 610 Cho Kuo Ling Road, Kowloon, HONG KONG Tel: 28289271-4 Fax: 2828772656		
DWG NO.: JH35-SO-CR-A-1501		
REV.: A		

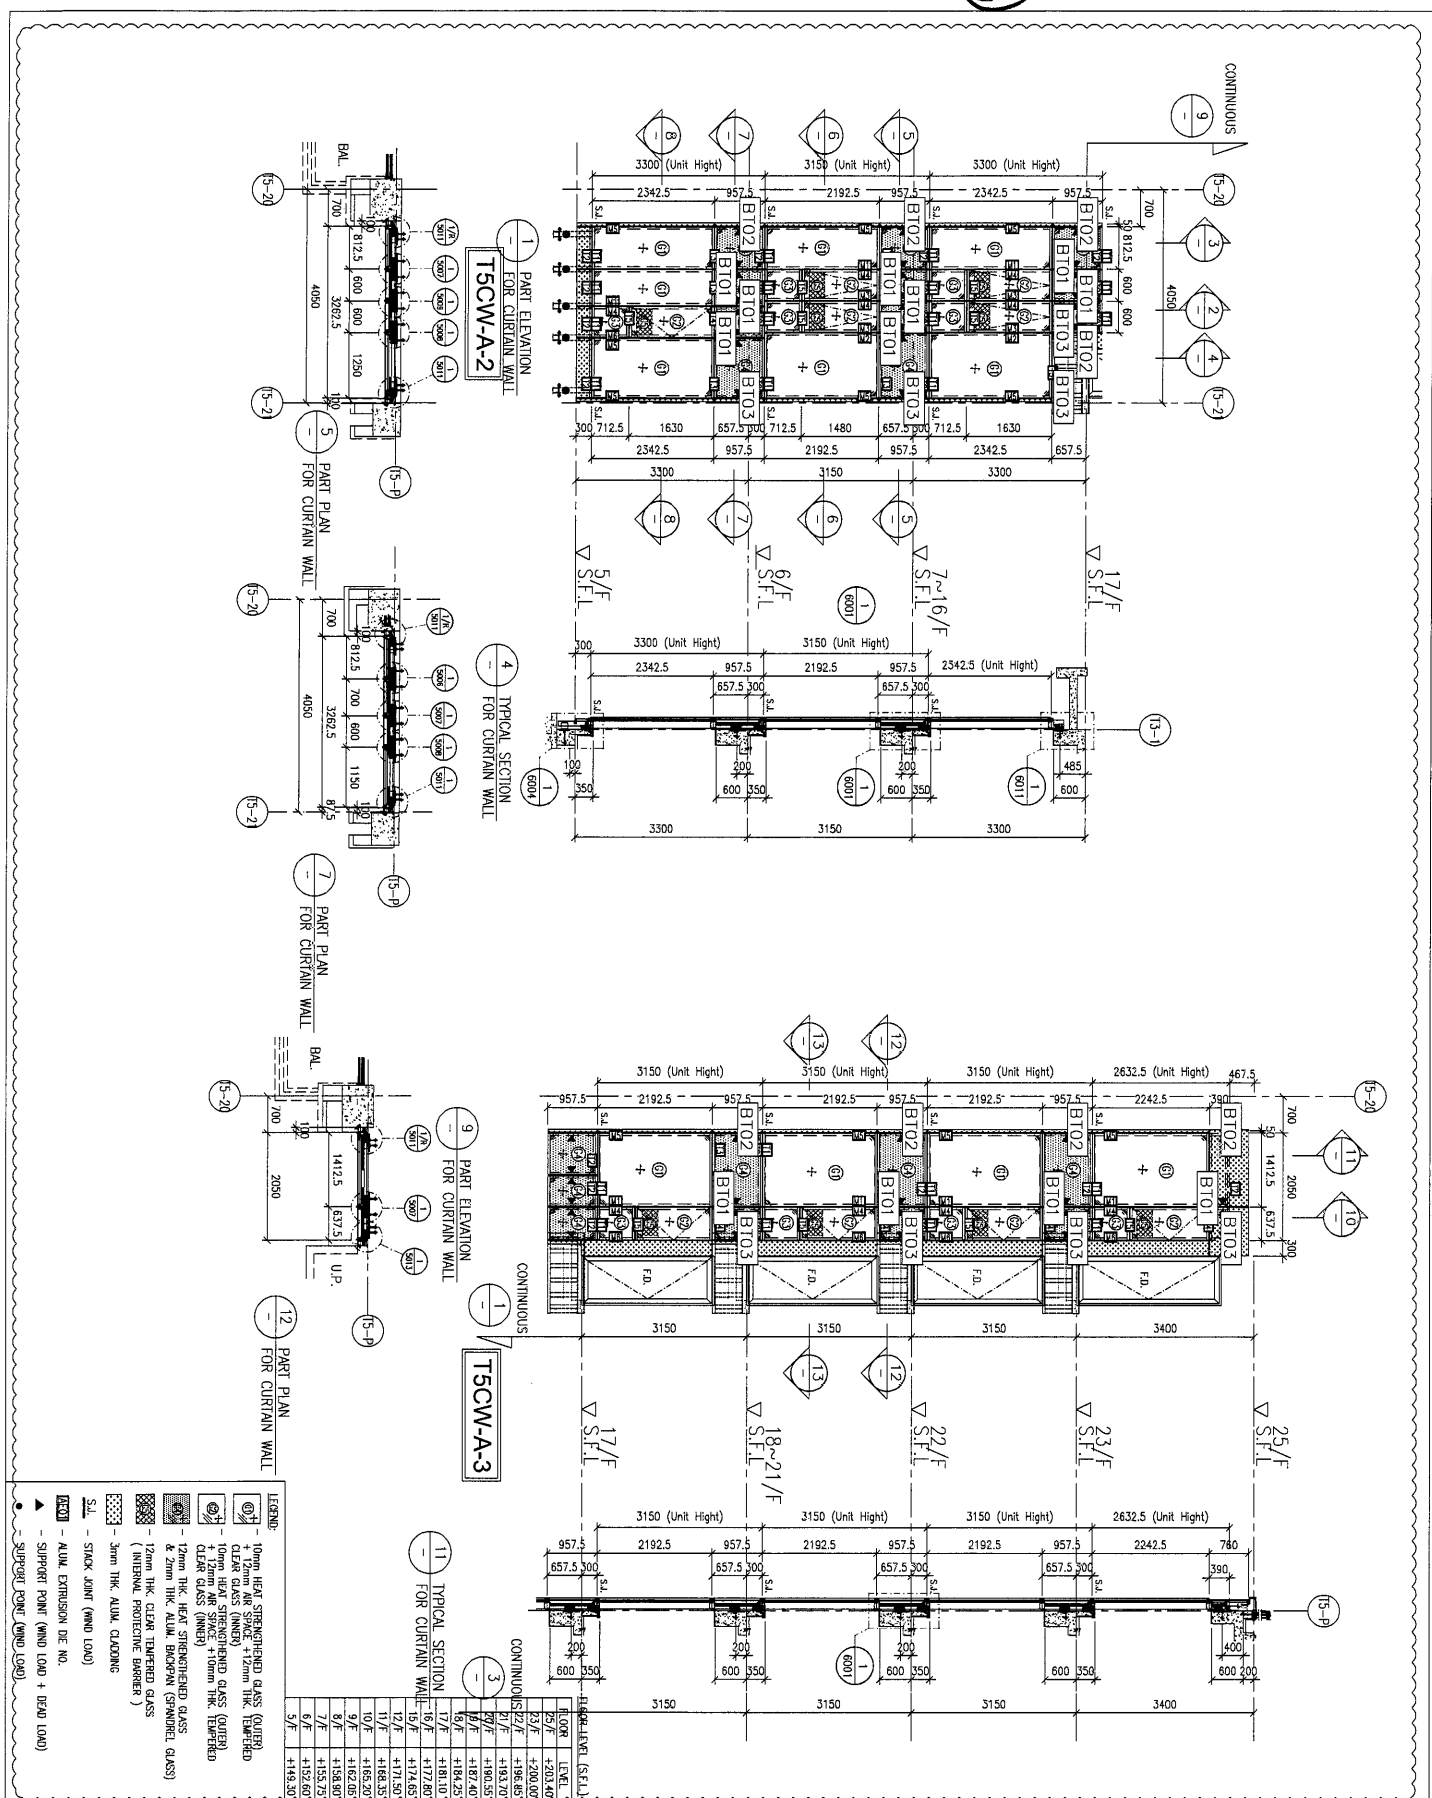

FLLOOR	LEVEL
203.3F	+203.40
23.5F	+200.00
22.5F	+196.85
22.0F	+193.70
21.5F	+190.55
20.5F	+187.40
19.5F	+184.25
18.5F	+181.10
17.5F	+177.80
16.5F	+174.65
15.5F	+171.50
14.5F	+168.35
13.5F	+165.20
12.5F	+162.05
11.5F	+158.80
10.5F	+155.75
9.5F	+152.60
8.5F	+149.50

NOTE:

1. ALL DIMENSIONS ARE IN mm.
2. ALL ELEVATIONS ARE VIEWED FROM OUTSIDE.
3. ALL DIMENSIONS TO BE VERIFIED ON SITE BEFORE FABRICATION.

LEGEND:

STRUCTURAL ENGINEER :
CMA
C M WONG & ASSOCIATES LTD
黃志明建築工程師有限公司
FACADE CONSULTANT:
MEIN YARDT


CLIENT
SHIMAO GROUP
HOLDINGS LIMITED

ARCHITECT
JONG TUNG & PARTNERS LIMITED
ARCHITECTS IN HONGKONG

MAIN CONTRACTOR :
協興建築有限公司
HIP HING CONSTRUCTION CO. LTD.




P.O. REF. : _____

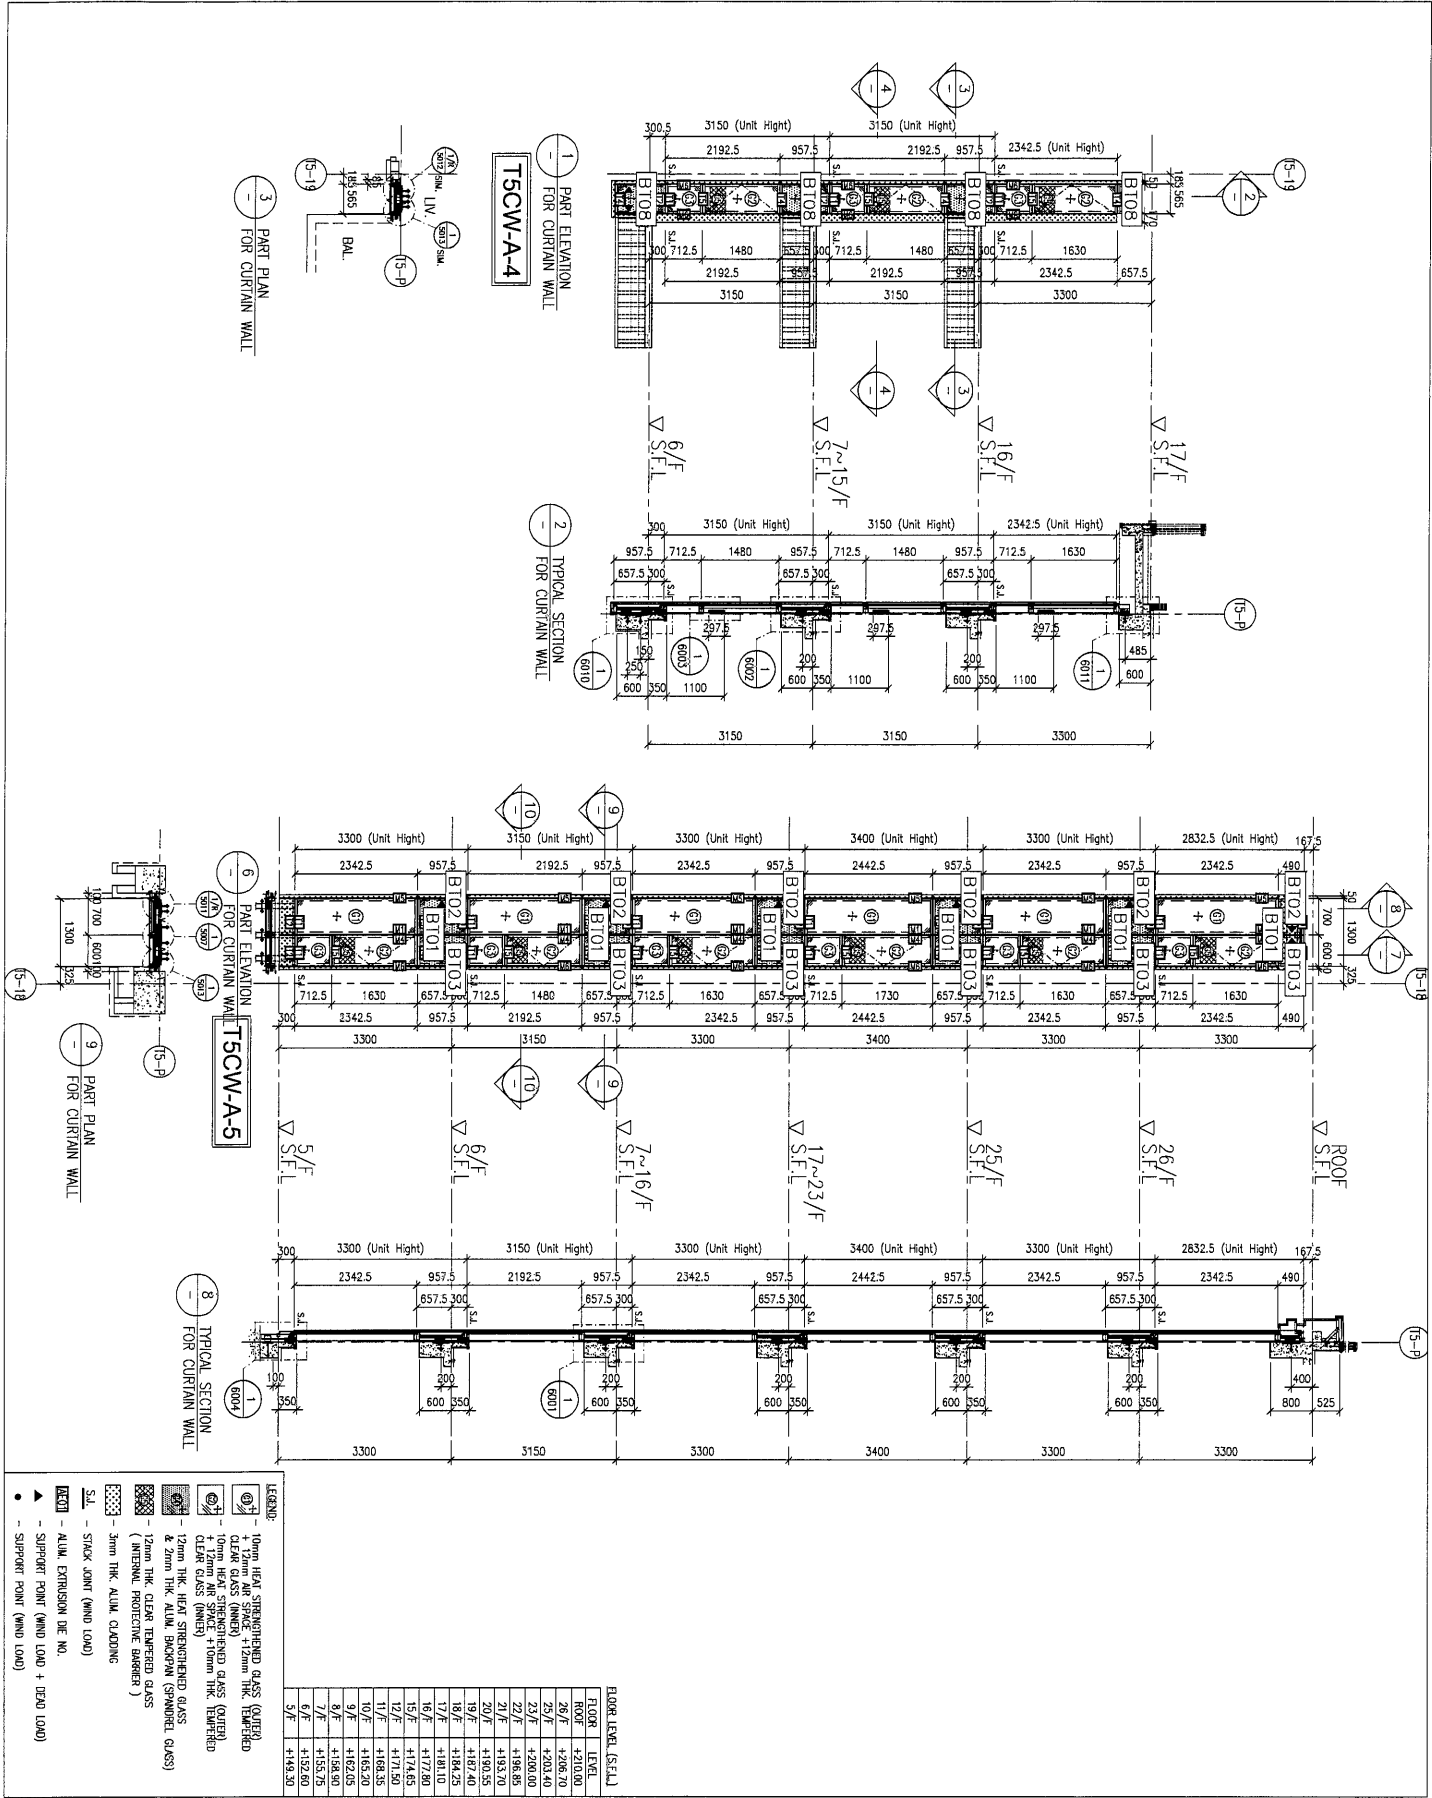

1. ALL DIMENSIONS ARE IN mm.
2. ALL ELEVATIONS ARE VIEWED FROM OUTSIDE.
3. BEFORE FABRICATION.

LEGEND:
① - DETAIL MARK NO.
② - REFER SHEET NO.
1. F.F.L. - FINISHED FLOOR LEVEL.
2. S.F.L. - STRUCTURAL FLOOR LEVEL.
3. Ⓡ - REVERSED DETAIL.

NOTE:
1. ALL DIMENSIONS ARE IN mm.
2. ALL ELEVATIONS ARE VIEWED FROM OUTSIDE.
3. BEFORE FABRICATION.

LEGEND:
① - DETAIL MARK NO.
② - REFER SHEET NO.
1. F.F.L. - FINISHED FLOOR LEVEL.
2. S.F.L. - STRUCTURAL FLOOR LEVEL.
3. Ⓡ - REVERSED DETAIL.

PROJECT: PROPOSED RESIDENTIAL DEVELOPMENT IN KAILI 6542 TOWER 5 KONGLOON

JOB NO.: J-B53

DATE: 06-10-2013

REVISION SUBJECT TO ARCH. COMMENT

NO.	DATE	REVISION
1	06-10-2013	REVISION SUBJECT TO ARCH. COMMENT

CLIENT: SHIMAO GROUP HOLDINGS LIMITED

ARCHITECT: KONG TUNG & PARTNERS LIMITED

MAIN CONTRACTOR: 協興建築有限公司 HIP HING CONSTRUCTION CO. LTD

STRUCTURAL ENGINEER: C.M. WONG & ASSOCIATES LTD 黃志明建築工程師有限公司

FAÇADE CONSULTANT: MEINWART

DATE: 31-MAR-21
SCALE: 1:60 (A1)
DRAWN BY: LHR
CHECKED BY:

TITLE: PART ELEVATION FOR CURTAIN WALL AT TOWER 5

UNIT: 6-6, Storey Industrial Centre, 1/F
TEL: 2489271-4
FAX: 2489271-4

DATE: 31-MAR-21
SCALE: 1:60 (A1)
DRAWN BY: LHR
CHECKED BY:


TITLE: PART ELEVATION FOR CURTAIN WALL AT TOWER 5

UNIT: 6-6, Storey Industrial Centre, 1/F
TEL: 2489271-4
FAX: 2489271-4

DATE: 31-MAR-21
SCALE: 1:60 (A1)
DRAWN BY: LHR
CHECKED BY:

TITLE: PART ELEVATION FOR CURTAIN WALL AT TOWER 5

UNIT: 6-6, Storey Industrial Centre, 1/F
TEL: 2489271-4
FAX: 2489271-4

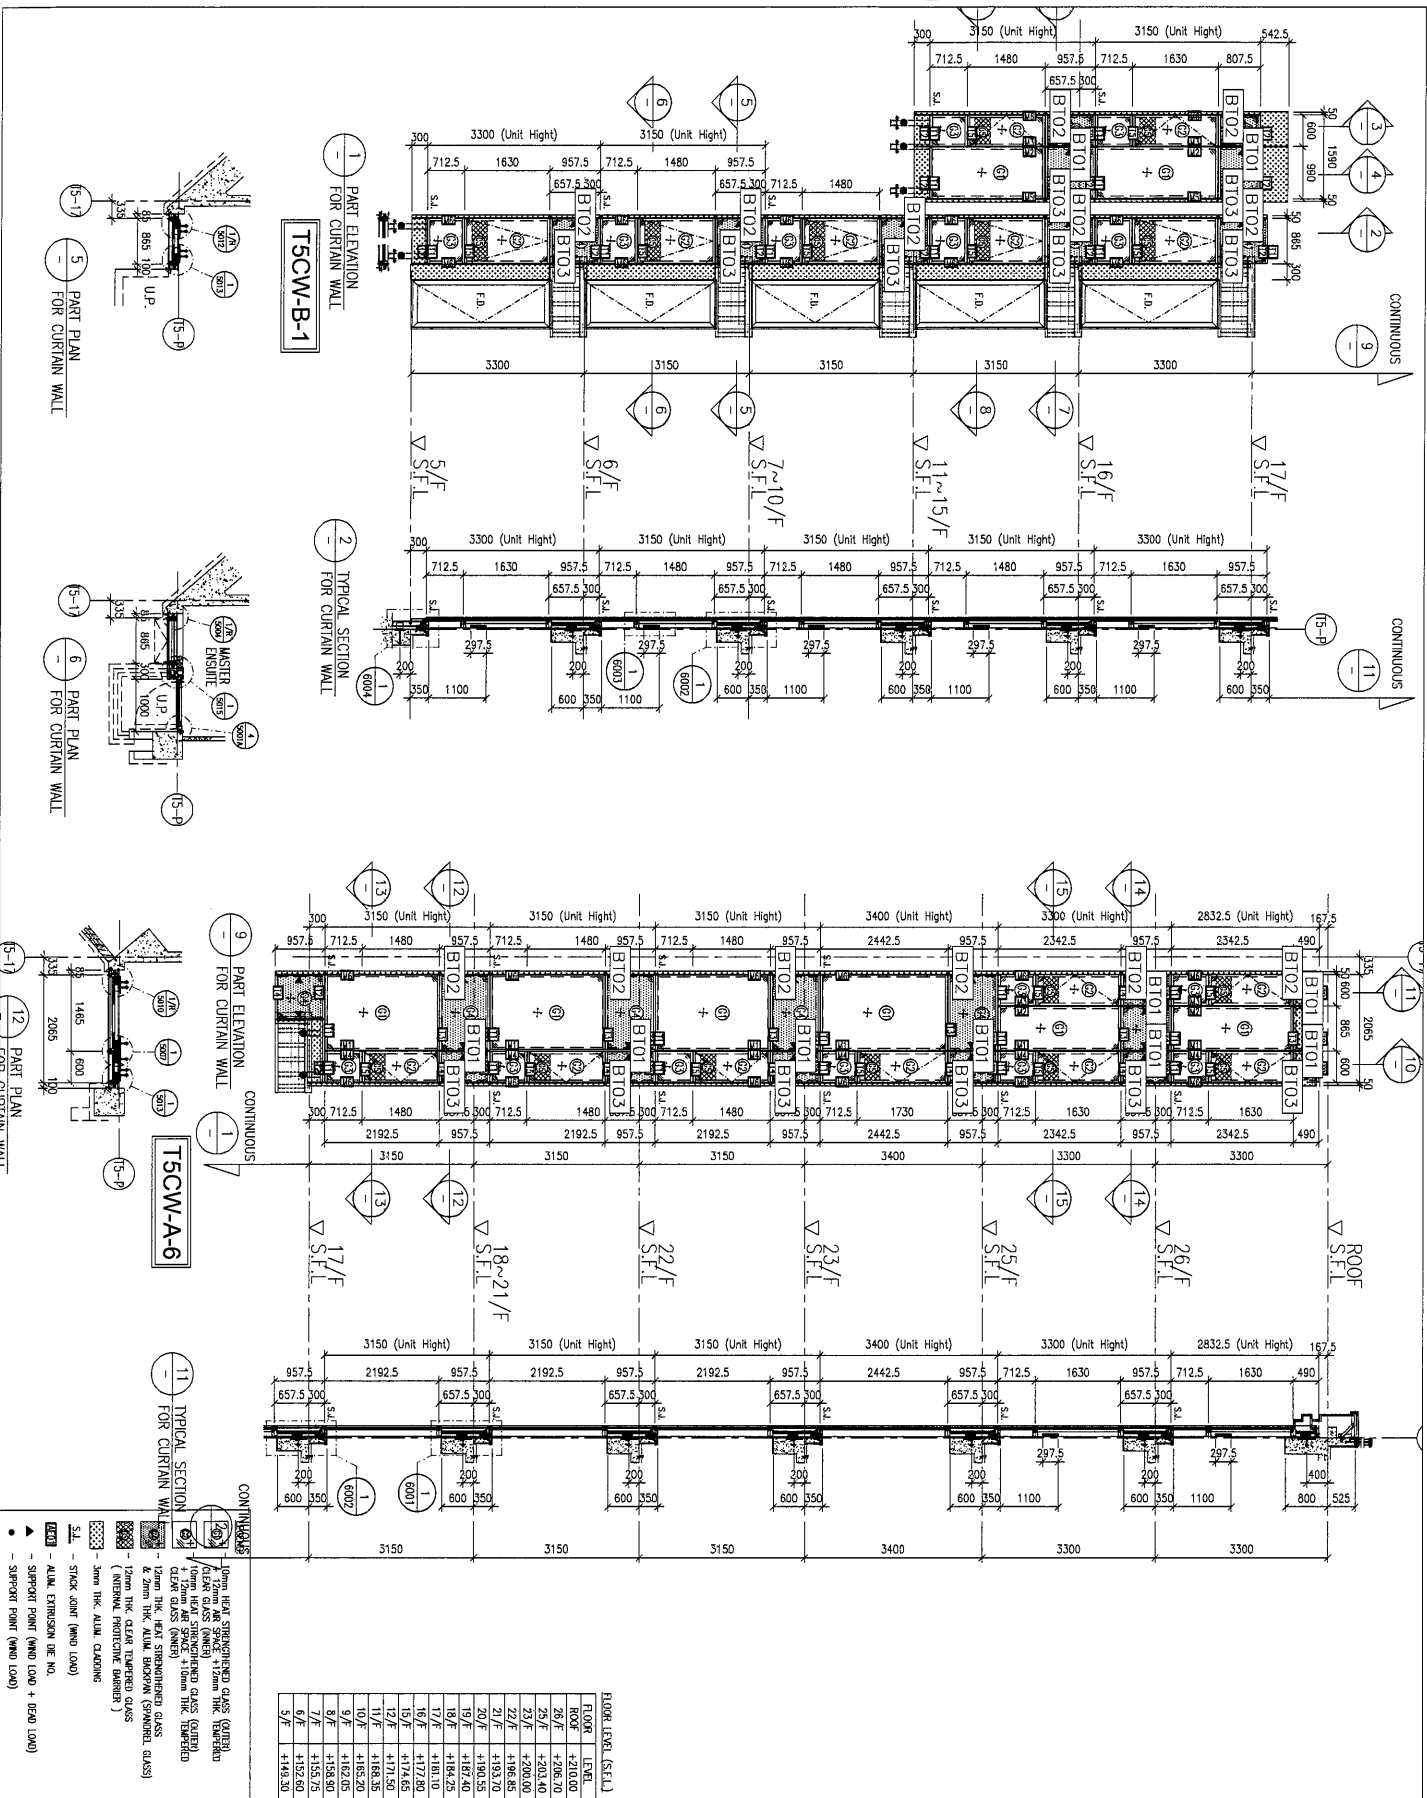

FLOOR LEVEL (SEL.)	LEVEL
FLOOR	+210.00
26/F	+206.70
25/F	+203.40
23/F	+200.00
22/F	+196.85
21/F	+193.70
20/F	+190.55
19/F	+187.40
18/F	+184.25
17/F	+181.10
16/F	+177.80
15/F	+174.65
12/F	+171.50
11/F	+168.35
10/F	+165.20
9/F	+162.05
8/F	+158.90
7/F	+155.75
6/F	+152.60
5/F	+149.45

NOTES:

1. ALL DIMENSIONS ARE IN mm.
2. ALL ELEVATIONS ARE MEASURED FROM OUTSIDE.
3. ALL DIMENSIONS TO BE VERIFIED ON SITE BEFORE FABRICATION.

LEGEND:



X1 --- DETAIL MARK NO.

X001 --- REFER SHEET NO.

1. F.E.L. --- FINISHED FLOOR LEVEL.
2. S.F.L. --- STRUCTURAL FLOOR LEVEL.
3. (R) --- REVERSED DETAIL.

MEINARDT

CM WONG & ASSOCIATES
黃志明建築工程師有限公司

ICMA
THE INSTITUTE OF COSTS MANAGEMENT

FACADE CONSULTANT:

協興建築有限公司
HIP HING CONSTRUCTION CO.

ARCHITECT :
WONG TUNG & PARTNERS LIMITED
 ARCHITECTS & PLANNERS


MAIN CONTRACTOR :






CLIENT : SHIMAO GROUP HOLDINGS LIMITED

B.O. REF : _____

DATE : 01-APR-21	SCALE : 1:80 (A)
DRAWN BY : LHR	CHECKED BY :
 美特銘實有限 MDI ADVANTAGE MATERIALS Suite 6-B, Sunny Industrial Centre, 510 Cheong Ning Road, Kowloon Tel: (852) 2511-4141 Fax: (852) 2511-7886	
TITLE : PART ELEVATION FOR CURTAIN WALL AT TOWER 5	
DEVELOPMENT AT N.K.I.L 65-42 YIN PING ROAD KOWLOON	
DWG NO. : MS3-3-50-CW-4504 REV. :	

55

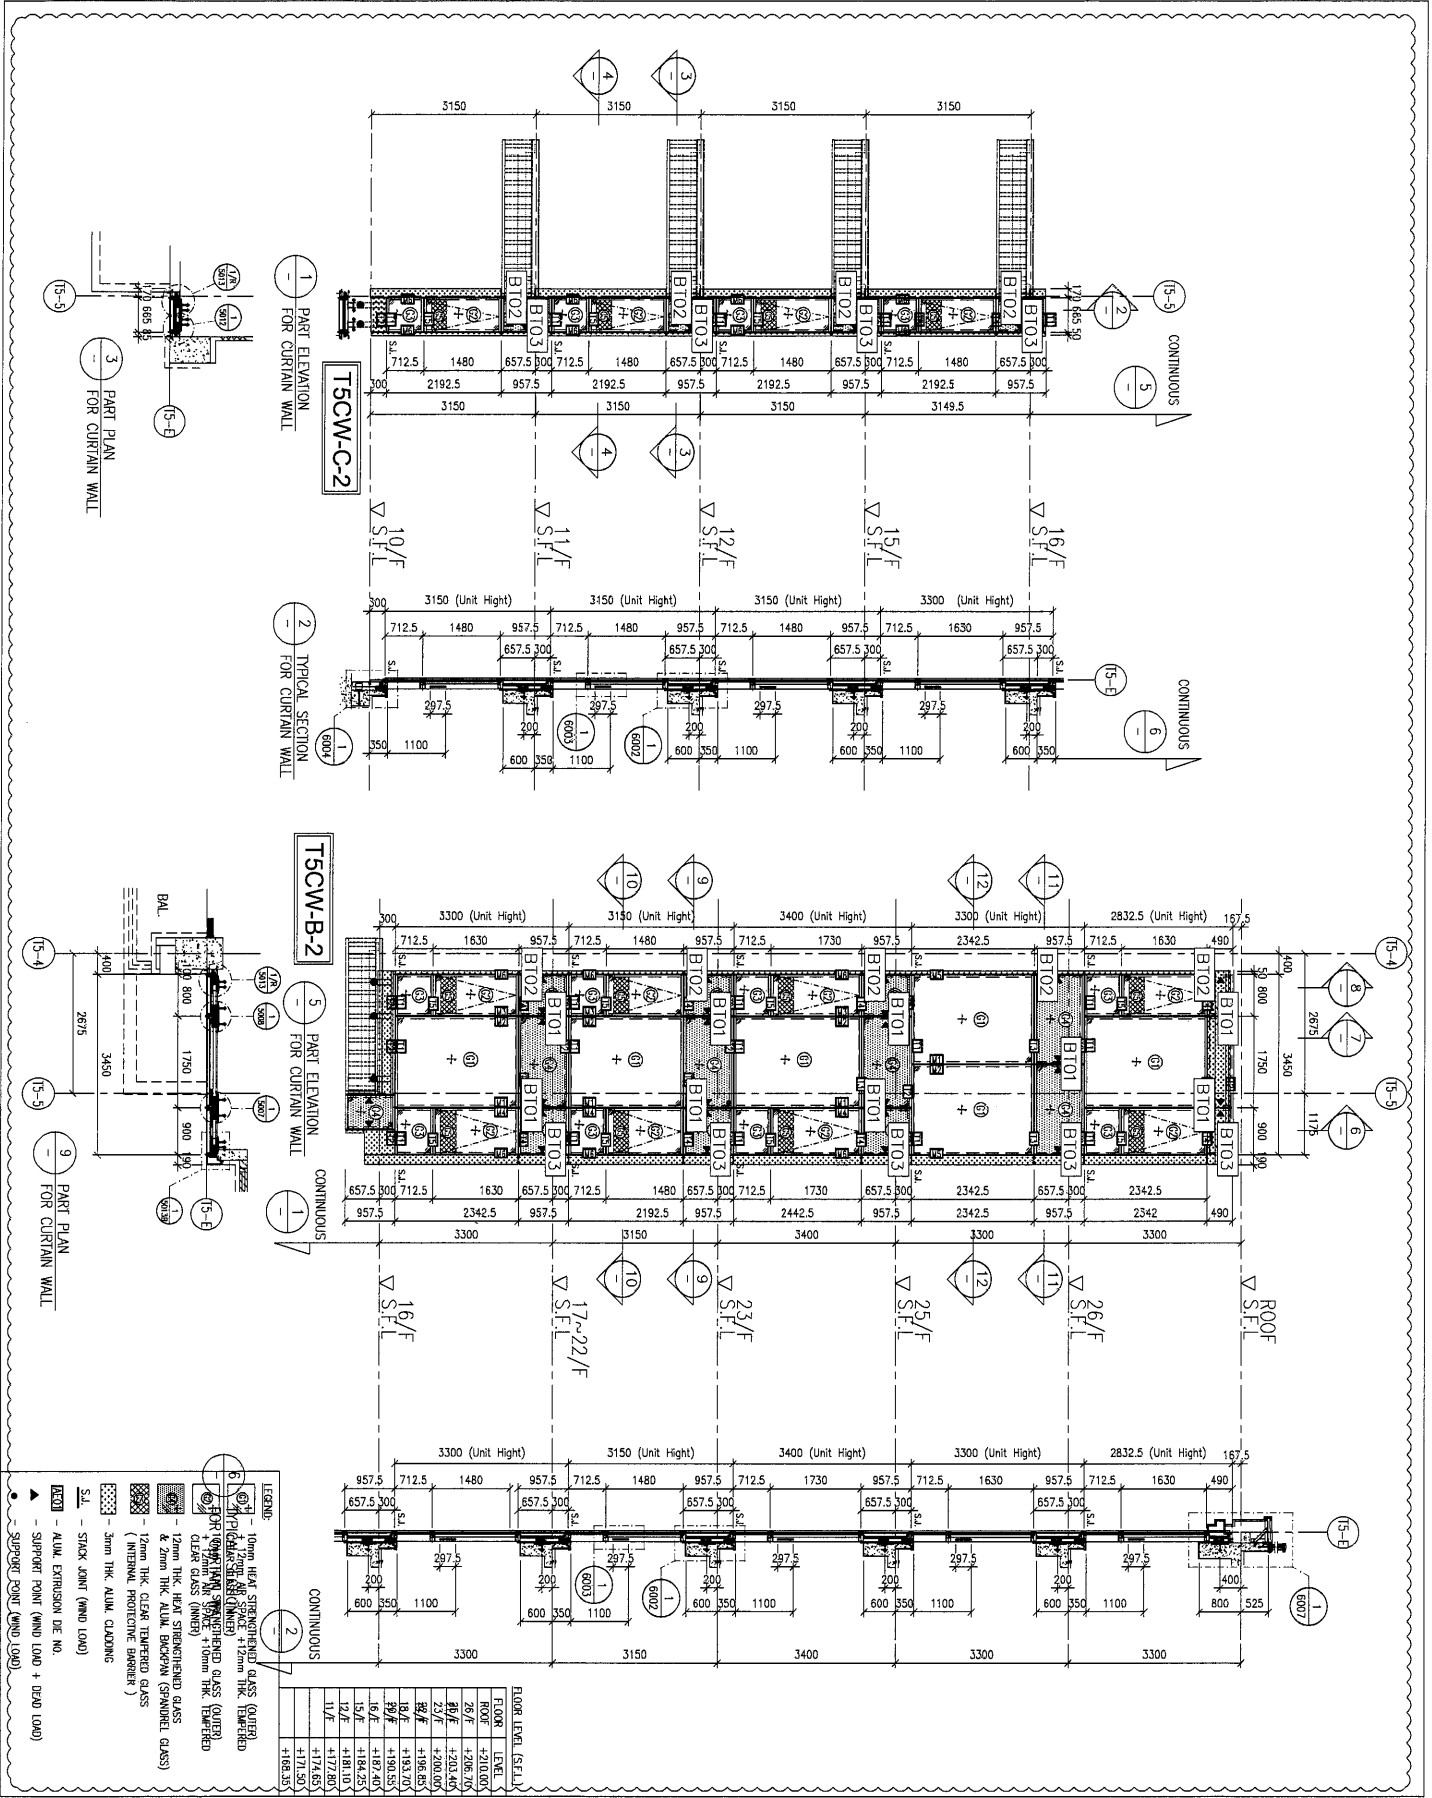

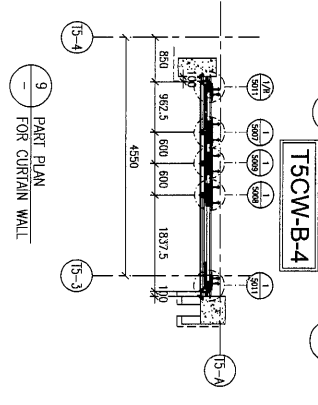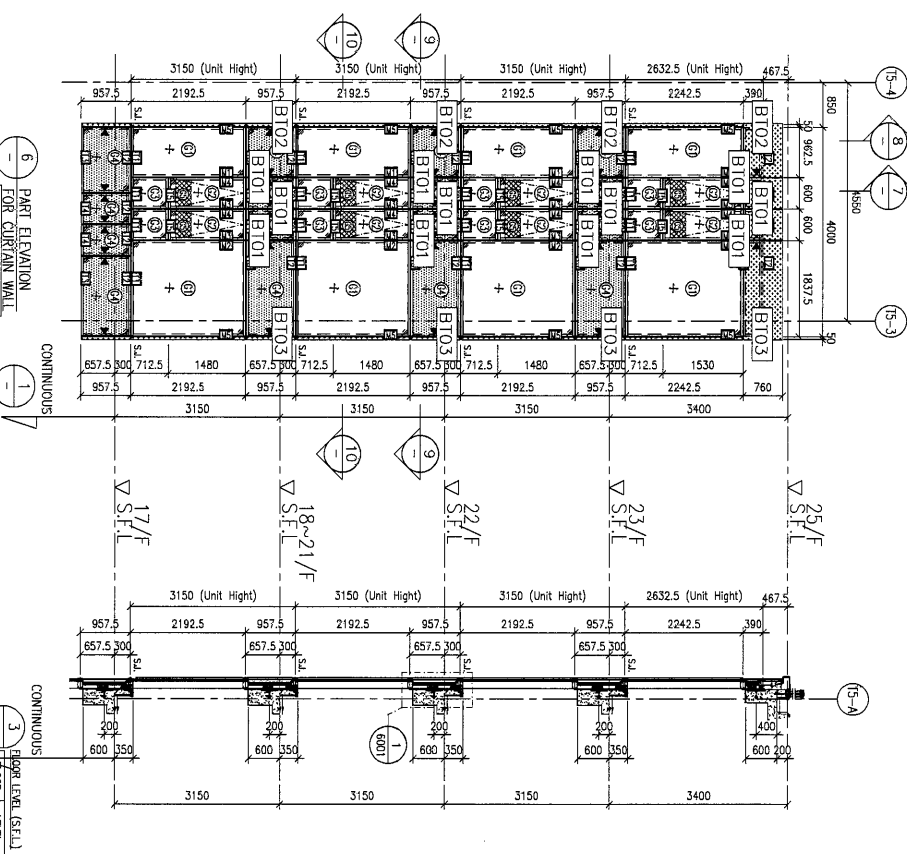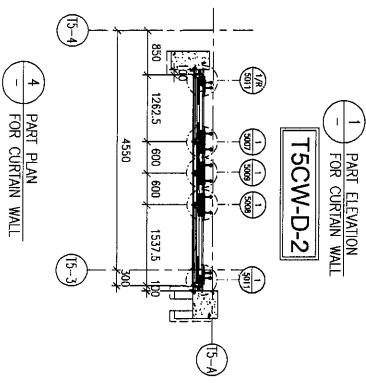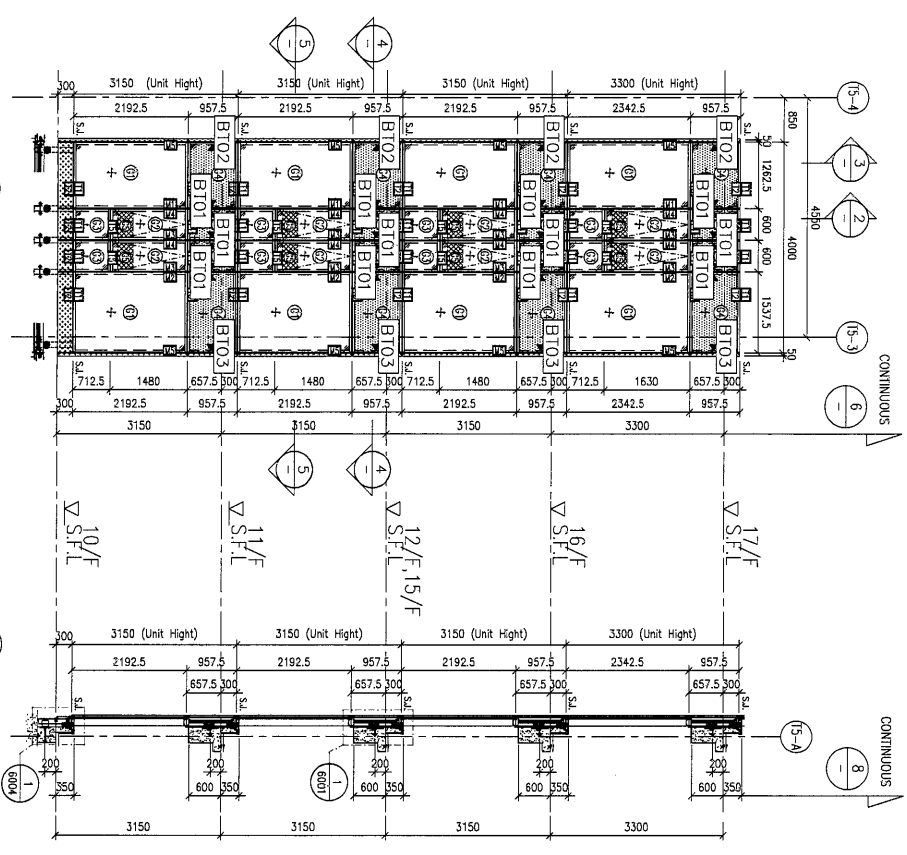

LEGEND

①	10mm HEAT STRENGTHENED GLASS (OUTER)
②	12mm AIR SPACE + 12mm THK. TEMPERED CLEAR GLASS (INNER)
③	10mm HEAT STRENGTHENED GLASS (OUTER)
④	12mm AIR SPACE + 12mm THK. TEMPERED CLEAR GLASS (INNER)
⑤	12mm THK. HEAT STRENGTHENED GLASS & 2mm THK. ALUM. BURGON (SPANDREL GLASS)
⑥	3mm THK. ALUM. CLADDING
⑦	STACK JOINT (WIND LOAD)
⑧	ALUM. EXTRUSION DET. NO.
⑨	SUPPORT POINT (WIND LOAD) + DEAD LOAD
⑩	SUPPORT POINT (WIND LOAD)

3 TYPICAL SECTION FOR CURTAIN WALL 21/F

FLOOR LEVEL (S.F.L.)	20/F	21/F	22/F	23/F	24/F	25/F
20/F	+203.40	+203.40	+203.40	+203.40	+203.40	+203.40
21/F	+203.40	+203.40	+203.40	+203.40	+203.40	+203.40
22/F	+203.40	+203.40	+203.40	+203.40	+203.40	+203.40
23/F	+203.40	+203.40	+203.40	+203.40	+203.40	+203.40
24/F	+203.40	+203.40	+203.40	+203.40	+203.40	+203.40
25/F	+203.40	+203.40	+203.40	+203.40	+203.40	+203.40
11/F	+168.35	+168.35	+168.35	+168.35	+168.35	+168.35

CLIENT : SHIMAO GROUP HOLDINGS LIMITED

ARCHITECT : WONG TUNG & PARTNERS LIMITED

MAIN CONTRACTOR : 協興建築有限公司
HIP HING CONSTRUCTION CO. LTD

STRUCTURAL ENGINEER : CMA C.M. WONG & ASSOCIATES LTD
黃金均建築工程師有限公司

TRACER CONSULTANT : MEINHARDT

NOTE:

1. ALL DIMENSIONS ARE IN mm.
2. ALL DIMENSIONS ARE VERIFIED FROM ORIGIN.
3. BEFORE FABRICATION, TO BE VERIFIED ON SITE.

LEGEND:

- ① DETAIL MARK NO.
- ② REFER SHEET NO.
- 1. F.E.L. -- FINISHED FLOOR LEVEL.
- 2. S.F.L. -- STRUCTURAL FLOOR LEVEL.
- 3. ⑨ -- REVERSED DETAIL.

PROJECT : PROPOSED RESIDENTIAL DEVELOPMENT AT NYLL 6542 YIN PING ROAD KOWLOON


TITLE : PART ELEVATION FOR CURTAIN WALL AT TOWER 5

DATE : 05-APR-21 SCALE : 1:60 (A1)

DRAWN BY : LHR CHECKED BY :

DESIGNED BY : 美特銘實有限公司
M.T.M. MIDLAND AUTOMATIC PAPERWORK LTD.
610 Cheung Yee Road, Kowloon
Tel: 23489211-4 Fax: (852) 27272666

DWG NO. : 0553-SD-CW-4507 REV. : A

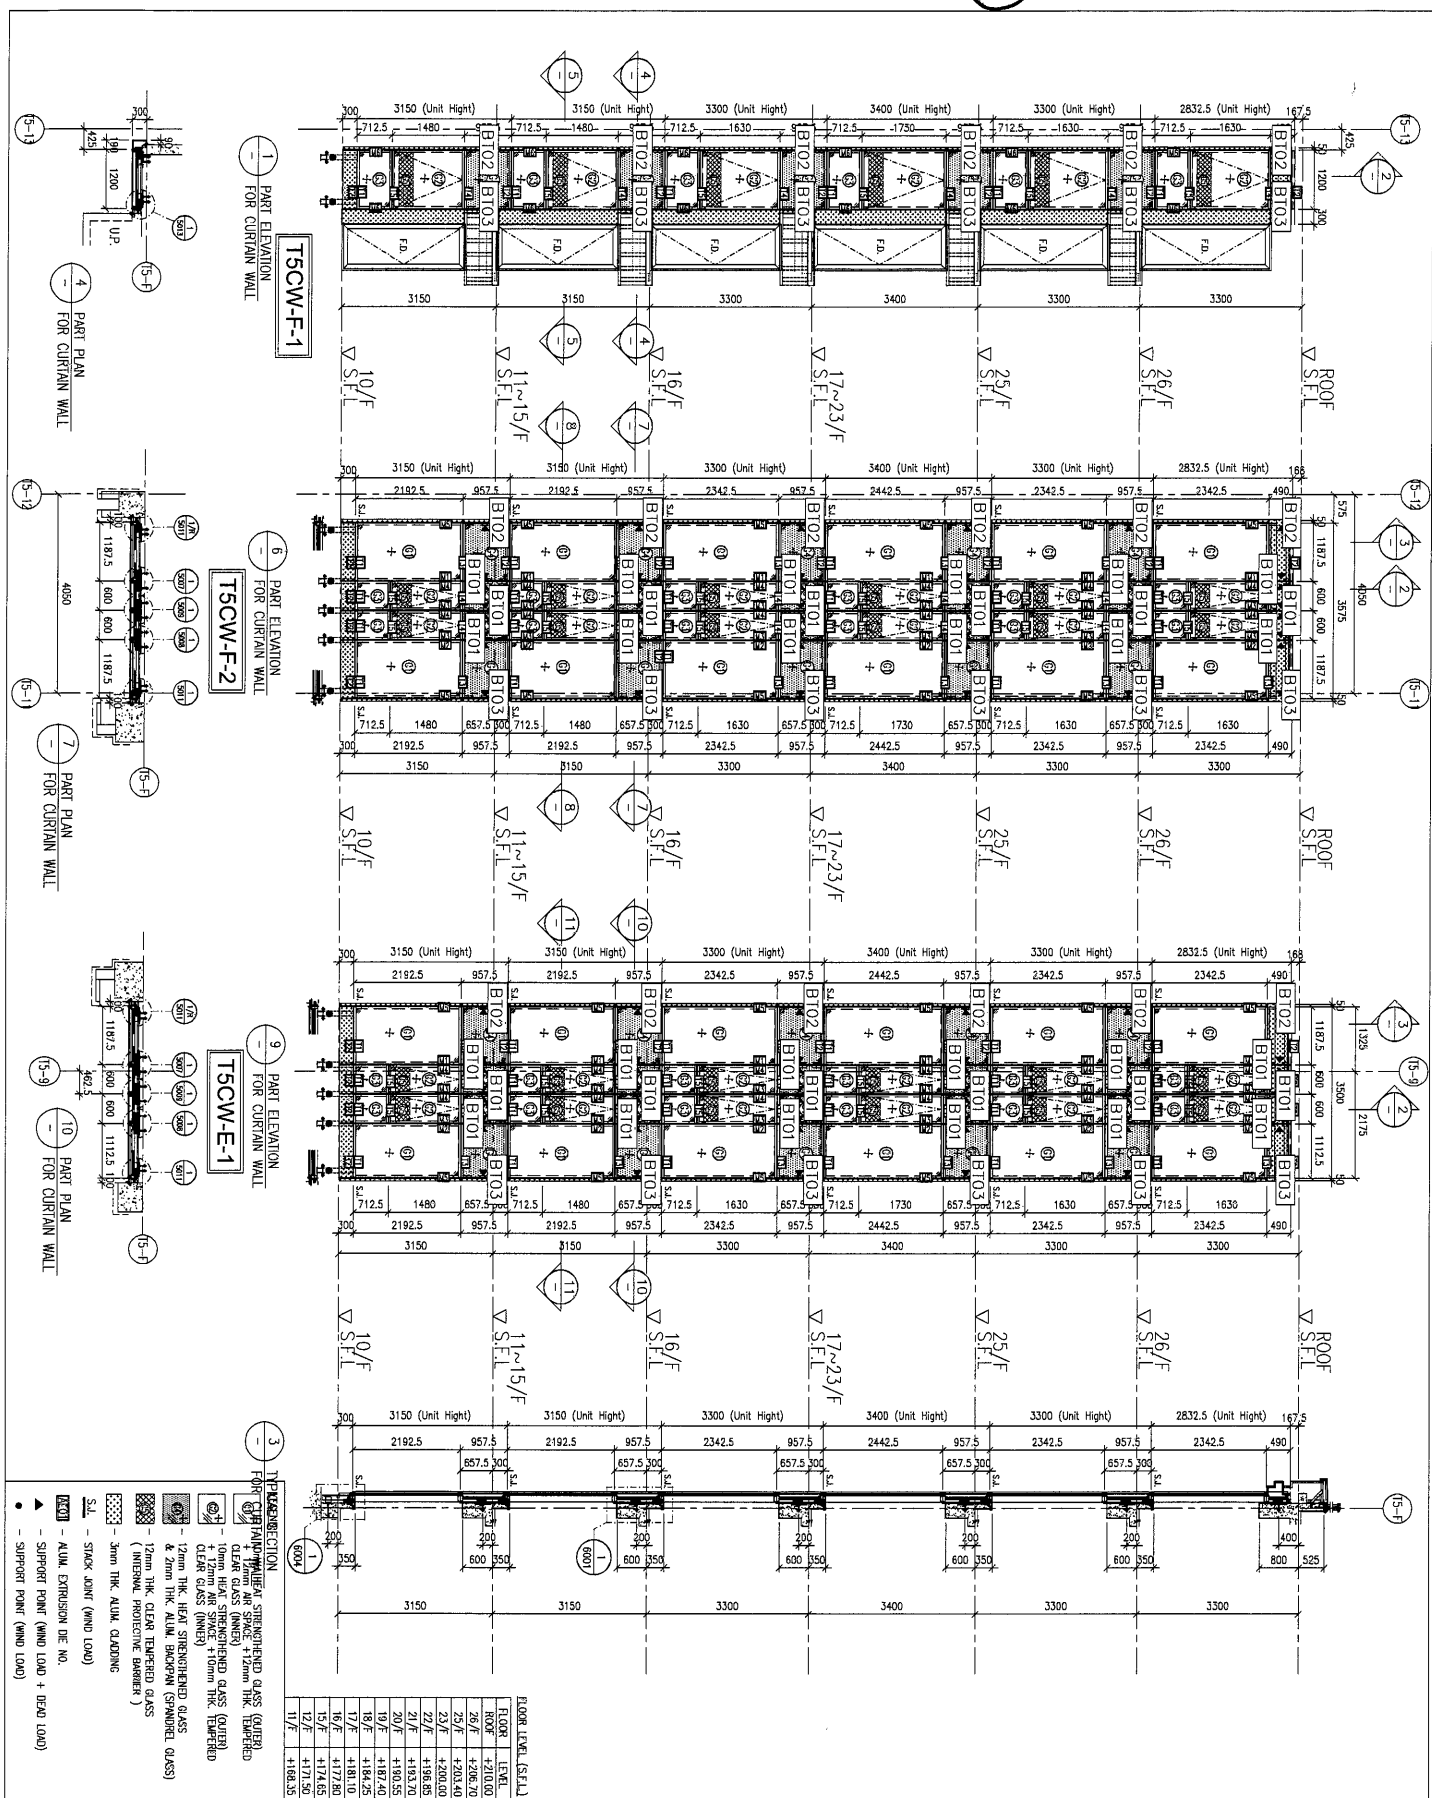

FLOOR	LEVEL
ROOF	+210.00
26/F	+206.70
25/F	+203.40
23/F	+200.00
22/F	+196.85
20/F	+193.55
19/F	+187.40
18/F	+184.25
17/F	+181.10
16/F	+177.80
15/F	+174.65
12/F	+171.50
11/F	+168.35

NOTE:

1. ALL DIMENSIONS ARE IN mm.
2. ALL ELEVATIONS ARE MEASURED FROM OUTSIDE
3. ALL DIMENSIONS TO BE VERIFIED ON SITE BEFORE FABRICATION.

LEGEND:



DETAIL MARK NO.
20001
---REFER SHEET NO.

1. F.F.L ---FINISHED FLOOR LEVEL
2. S.F.L ---STRUCTURAL FLOOR LEVEL
3. (R) ---REVERSED DETAIL

MEINHARDT

C M WONG & ASSOCIATE
黃志明建築工程師有限公司

STRUCTURAL ENGINEER :

MAIN CONTRACTOR :

ARCHITECT :
WONG TUNG & PARTNERS LIMITED
ARCHITECTS & PLANNERS

CLIENT : **SHIMAO GROUP**

10

B.D. REF :



FLOOR LEVEL (S.F.L.)	
FLOOR	LEVEL
ROOF	+210.00
26/F	+206.70
25/F	+203.40

- | LEGEND: | |
|---|---|
|  | 10mm H&H STRENGTHENED GLASS (GLUEF) |
|  | + 12mm AIR SPACE + 12mm THK. THERPAED CLEAR GLASS (INNER) |
|  | 10mm H&H STRENGTHENED GLASS (GLUEF) |
|  | + 12mm AIR SPACE + 12mm THK. THERPAED CLEAR GLASS (INNER) |
|  | 12mm THK. H&H STRENGTHENED GLASS & 12mm THK. ALUM. BACKING (SPANDREL GLASS) |
|  | 12mm THK. CLEAR THERPAED GLASS (INTERNAL GLAZING BARRIER) |
|  | 3mm THK. ALUM. CLADDING |
|  | STACK JOINT (WIND LOAD) |
|  | ALUM. EXTRUSION DIS. NO. |
|  | SUPPORT POINT (WIND LOAD + DEAD LOAD) |
|  | SUPPORT POINT (WIND LOAD) |

NOTE:

1. ALL DIMENSIONS ARE IN MM.
2. ALL ELEVATIONS ARE VIEWED FROM OUTSIDE.
3. ALL DIMENSIONS TO BE VERIFIED ON SITE BEFORE FABRICATION.

LEGEND:

X1

DETAIL MARK NO.
X000 ----- REFER SHEET NO.

1. F.F.L. --- FINISHED FLOOR LEVEL
2. S.F.L. --- STRUCTURAL FLOOR LEVEL
3. (R) --- REVERSED DETAIL

MEIN-YARDT

FACADE CONSULTANT:

C M WONG & ASSOCIATES
黃志明建築工程師有限公司

STRUCTURAL ENGINEER :

協興建築有限公司
HIP HING CONSTRUCTION CO.

ARCHITECT
WONG TUNG & PARTNERS LIMITED
ARCHITECTS & PLANNERS

WT

MAIN CONTRACTOR •

CLIENT : **SHIMAO GROUP
HOLDINGS LIMITED**

© 2006 The Authors
Journal compilation © 2006 Blackwell Publishing Ltd

B.D. REF :

DATE : 06-OCT-21	SCALE : 1:60 (A1)
DRAWN BY : LHR	CHECKED BY :



美特鋁質有限公司
MTDI ALUMINIUM PUBLISHERS

Unit 6-8, Sunny Industrial Centre, 1/F
610 Chai Kwoi Ling Road, Kowloon
Tel: 37489211-4 Fax: (852) 27721666


DWG NO. : JB53-SD-CW-4510 REC. : /

PROJECT : PROPOSED RESIDENTIAL
DEVELOPMENT AT N.K.I.L. 6542
YIN PING ROAD
KOWLOON

TITLE : PART ELEVATION
FOR CURTAIN WALL
AT TOWER 5

JOB NO. : J-853

NO.	DATE	RECEIVED
-----	------	----------

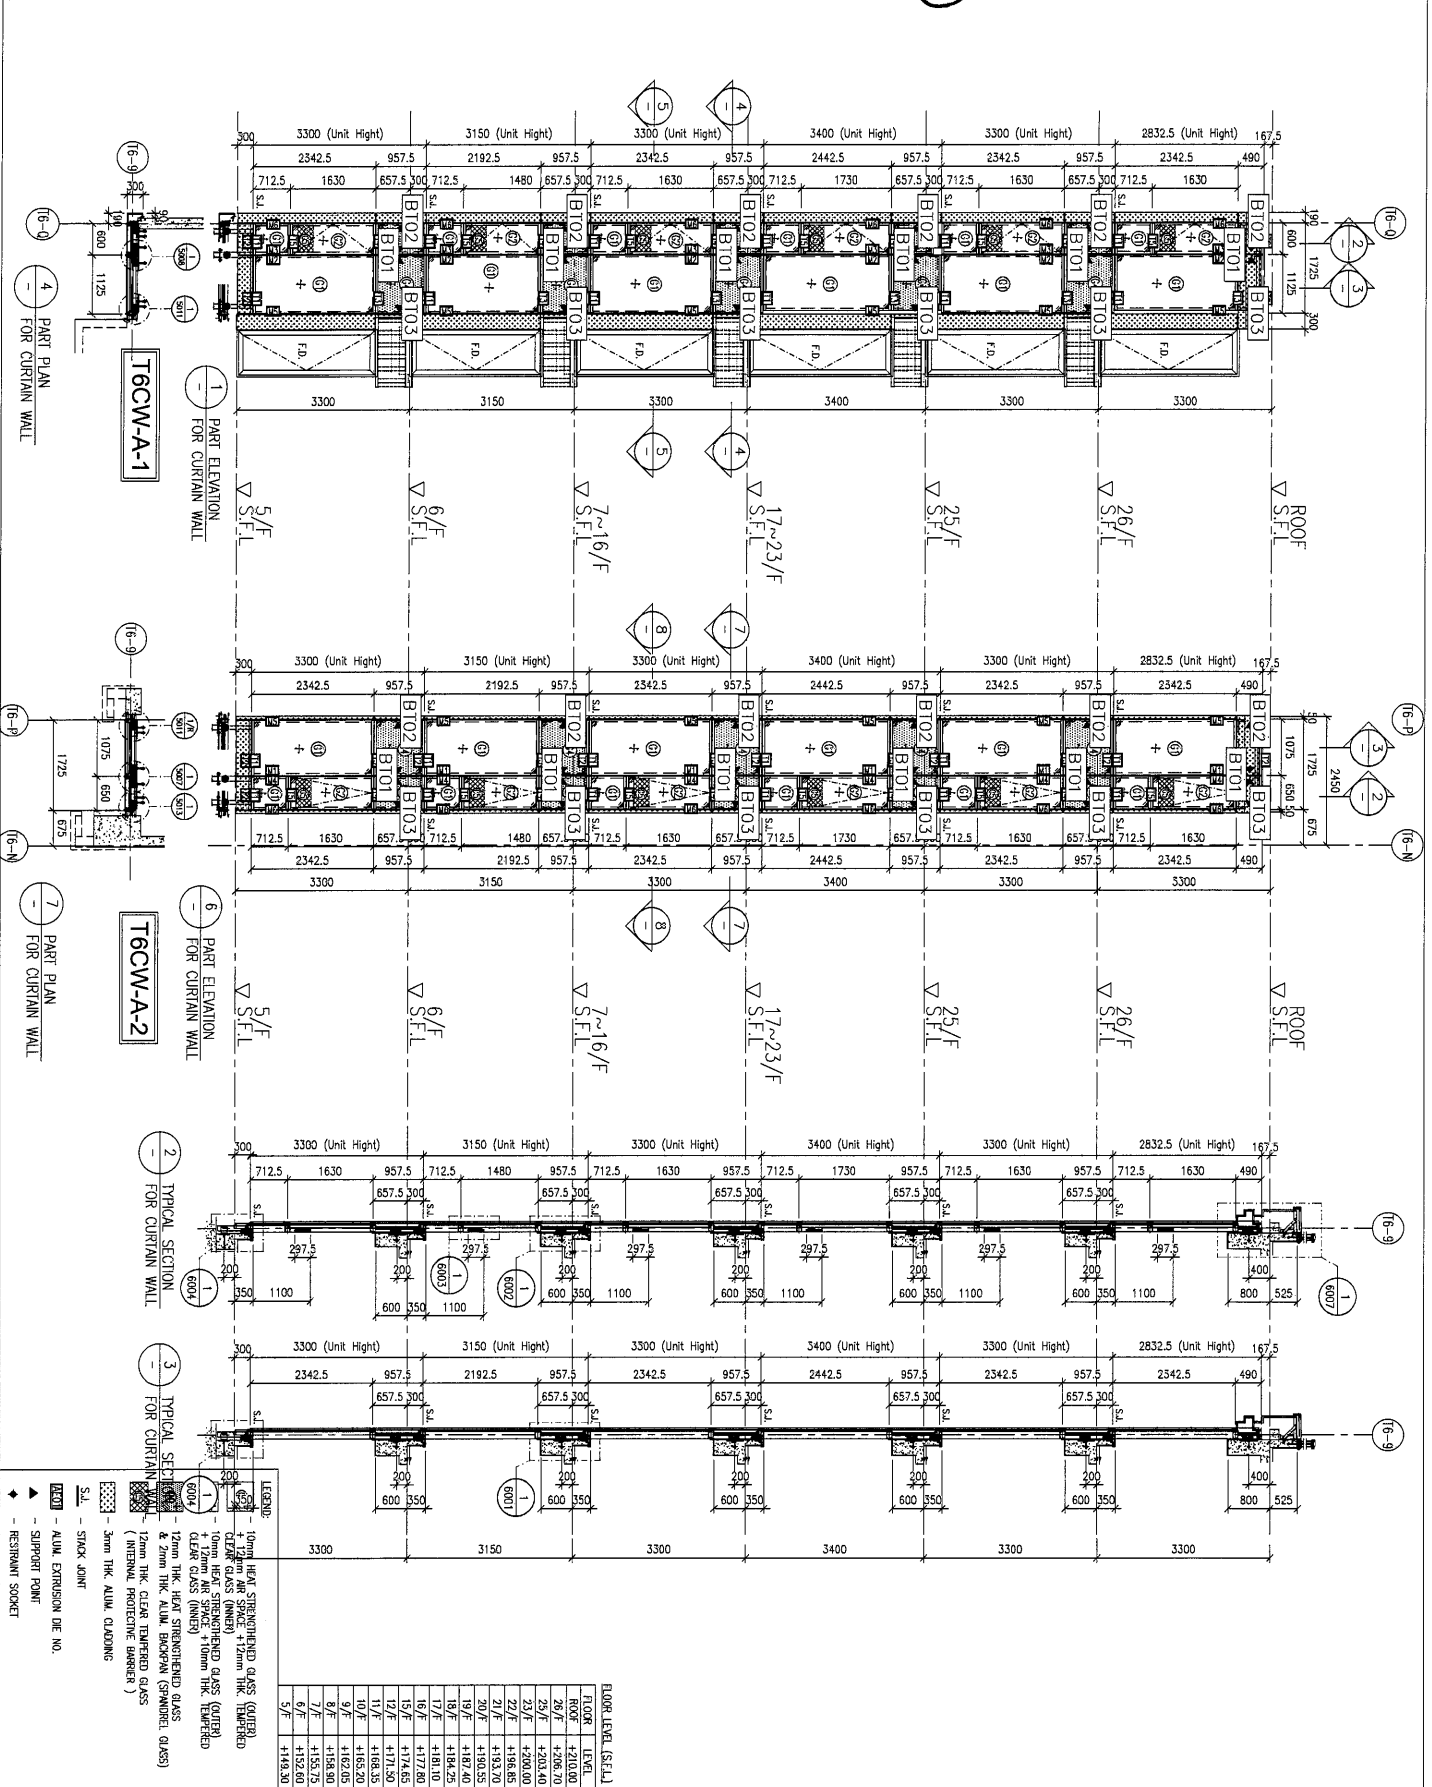

CLIENT : SHIMAO GROUP HOLDINGS LIMITED

ARCHITECT : WONG TUNG & PARTNERS LIMITED

STRUCTURAL ENGINEER : CMA C.H. WONG & ASSOCIATES LTD

MAIN CONTRACTOR : 協興建築有限公司 HOP HING CONSTRUCTION CO. LTD

TRADING CONSULTANT : MEINERD

DATE : 12-APR-21

SCALE : 1:60 (A1)

DRAWN BY : LHF

CHECKED BY :

TITLE : PART ELEVATION FOR CURTAIN WALL AT TOWER 6 & 7

PROJECT : PROPOSED RESIDENTIAL DEVELOPMENT AT N.K.L. 6542 YIN PING ROAD KOWLOON

JOB NO. : J-453

DATE : 09-10-2021

REVISION SUBJECT TO ARCH. COMMENT

NO.	DATE	REVISION	BY
1			
2			
3			

NOTE :

1. ALL DIMENSIONS ARE IN mm.
2. ALL DIMENSIONS ARE VIEWED FROM OUTSIDE, BEFORE FABRICATION.
3. (R) - REVERSED DETAIL.

LEGEND :

- 1. DETAIL MARK NO.
- 2. REVERSED DETAIL.
- 3. F.F.L. - FINISHED FLOOR LEVEL.
- 4. S.F.L. - STRUCTURAL FLOOR LEVEL.

FLOOR LEVEL (S.F.L.)

FLOOR	LEVEL
ROOF	+210.00
26/F	+206.70
25/F	+203.40
24/F	+200.00
23/F	+196.85
22/F	+193.70
21/F	+190.55
20/F	+187.40
19/F	+184.25
18/F	+181.10
17/F	+177.95
16/F	+174.80
15/F	+171.65
14/F	+168.50
13/F	+165.35
12/F	+162.20
11/F	+159.05
10/F	+155.90
9/F	+152.75
8/F	+149.60
7/F	+146.45
6/F	+143.30
5/F	+140.15

LEGEND :


- 1. 10mm LUMI STRENGTHENED GLASS (GLASS)
- 2. 12mm AIR SPACE + 12mm THK. THERMO BREAK GLASS (GLASS)
- 3. 12mm THK. CLEAR TINTED GLASS (GLASS)
- 4. 12mm THK. CLEAR TINTED GLASS (GLASS)
MDI 美特銘實業有限公司

810 Cheung Yee Road, Kowloon

Tel: 23489211-4 Fax: 23272766

DWG NO. : JBS3-SD-CW-4601 REV. : A

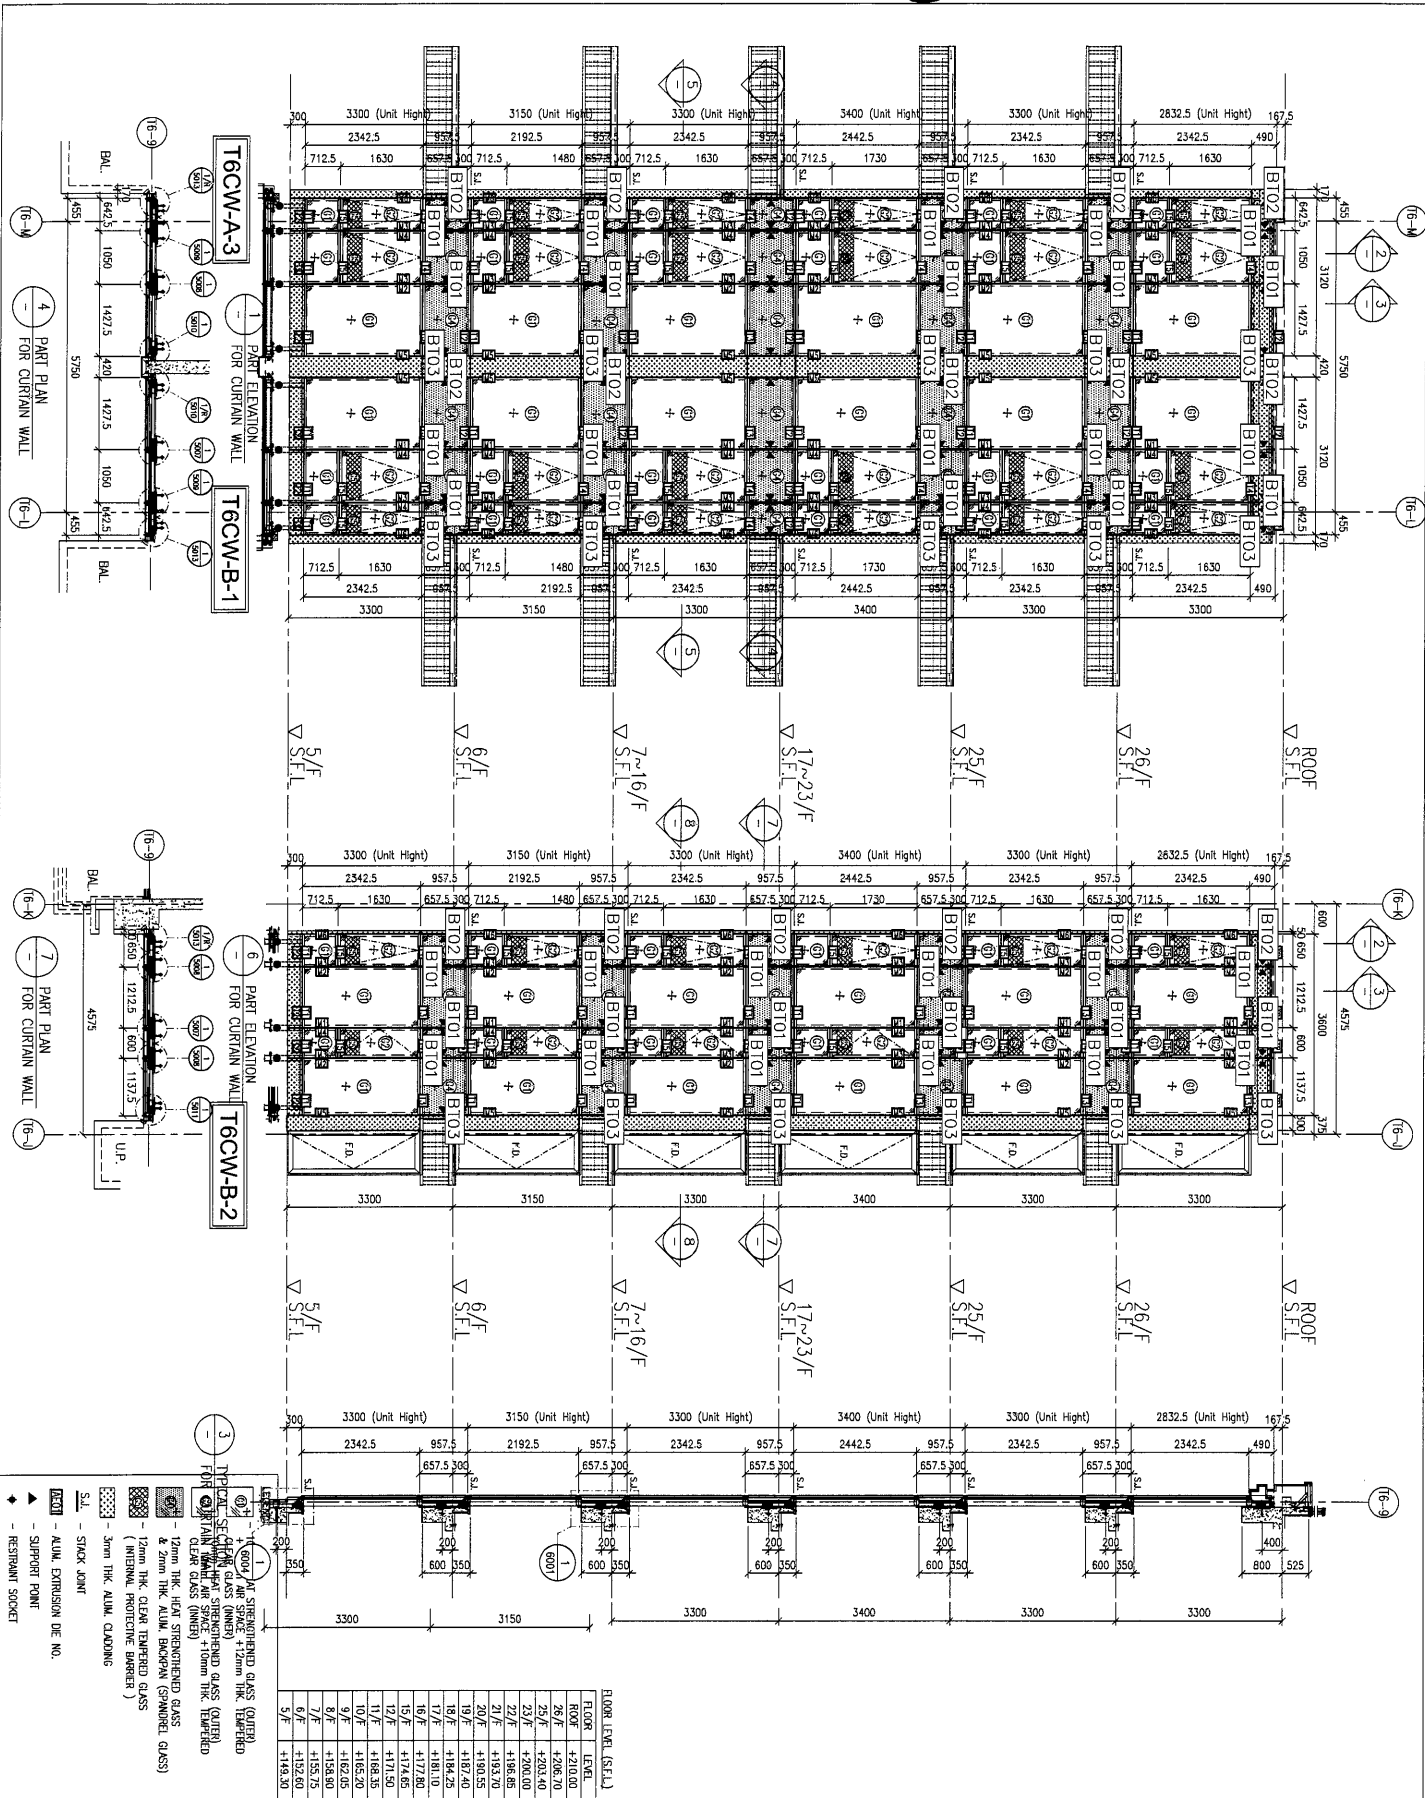

1	2	3	521	5
---	---	---	---	---	---	---	---	---	----	----	-----	-----	---

CLIENT : SHIMAO GROUP HOLDINGS LIMITED

ARCHITECT : WONG TUNG & PARTNERS LIMITED

ARCHITECTS & PLANNERS

協興建築有限公司

HP HING CONSTRUCTION CO LTD

MNN CONTRACTOR :

STRUCTURAL ENGINEER :

CM WONG & ASSOCIATES LTD
黃志明建築工程師有限公司

MEINHARDT

NOTE:

1. ALL DIMENSIONS ARE IN mm.
2. ALL ELEVATIONS ARE TAKEN FROM OUTSIDE.
3. ALL DIMENSIONS TO BE VERIFIED ON SITE BEFORE FABRICATION.

LEGEND :

11

2000

DETAIL MARK NO.
 REEFER SHEET NO.

1. F.F.L --- FINISHED FLOOR LEVEL
2. S.F.L --- STRUCTURAL FLOOR LEVEL
3. --- REVERSED DETAIL

100

A	09-10-2021	REVISION SUBJECT TO AFDL COMMENT	BY
NO.	DATE	REVISION	

JOB NO. : J-853

PROJECT : PROPOSED RESIDENTIAL DEVELOPMENT AT N.K.I.L. 6542

YIN PING ROAD KOMLOON	TITLE : PART ELEVATION FOR CURTAIN WALL AT TOWER 6 & 7
--------------------------	---

DATE : 2-APR-21	SCALE : 1:50 (A1)
DRAWN BY : LHR	CHECKED BY :



美特鋁質有限公司
MIDI ALUMINUM FABRICATOR LTD.

Units 6-8, Sunray Industrial Centre, 1/F
610 Cho Kwong Road, Kowloon
Tel: 23700000
Fax: 23700001


DATE : 2-APR-21

SCALE : 1:50 (A1)

DRAWN BY : LHR

CHECKED BY :

16123489211-4	FOR: (852) 21121666
DMC NO. : J853-SD-CW-4602	REV. : A

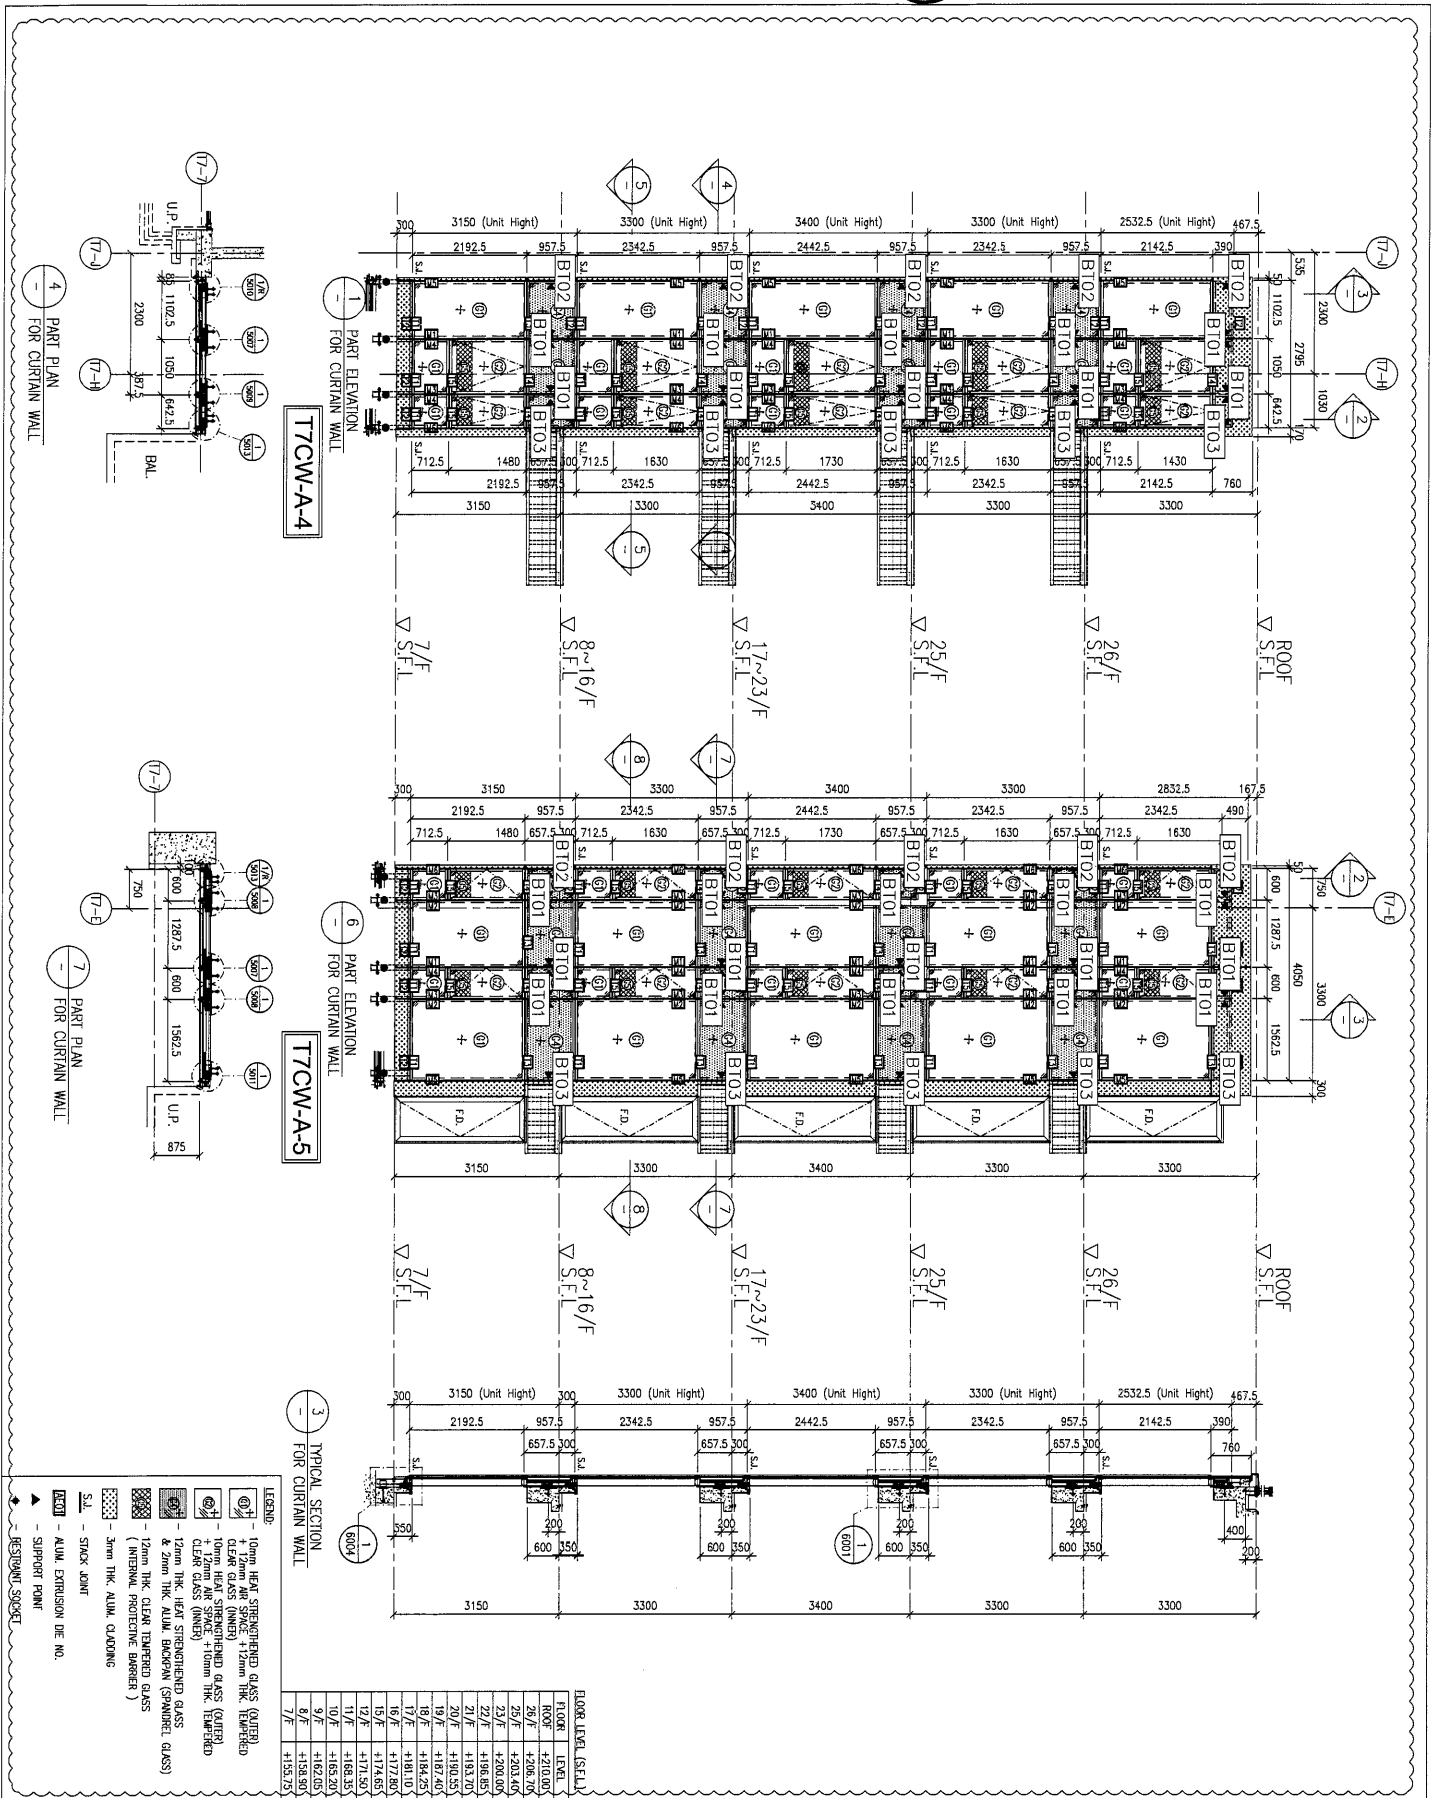

NOTE :

1. ALL DIMENSIONS ARE IN mm.
2. ALL ELEVATIONS ARE VIEWED FROM OUTSIDE.
3. ALL DIMENSIONS TO BE VERIFIED ON SITE BEFORE FABRICATION.

LEGEND :

X1
X001

DETAIL MARK NO.

REFER SHEET NO.

1. F.F.L. --- FINISHED FLOOR LEVEL.
2. S.F.L. --- STRUCTURAL FLOOR LEVEL.
3. (R) --- REVERSED DETAIL.

FACADE CONSULTANT:

C M WONG & ASSOCIATES LTD
黃志明建築工程師有限公司

STRUCTURAL ENGINEER

 協興建築有限公司
HIP HING CONSTRUCTION CO LTD

WONG TUNG & PARTNERS LIMITED
ARCHITECTS & PLANNERS

WT

MAIN CONTRACTOR :



SHIMAO GROUP
HOLDINGS LIMITED

CLIENT :

B.D. REF :

JOB NO.:		J-853	
PROJECT:		PROPOSED RESIDENTIAL DEVELOPMENT AT N.KILL 6542 YIN PING ROAD KOWLOON	
TITLE:		PART ELEVATION FOR CURTAIN WALL AT TOWER 6 & 7	
DATE: 12-APR-21		SCALE: 1:60 (A1)	
DRAWM BY: LHR		CHECKED BY:	
 M&M ENGINEERING & ARCHITECTURE LTD. Unit 6-8, Sunny Industrial Centre, 610 Cheong Cheong Road, Kowloon Tel: 28482121 Fax: 28482122 E-MAIL: J-853-SU-CA-4603		葵特堅實有限公司 M&M ENGINEERING & ARCHITECTURE LTD. Unit 6-8, Sunny Industrial Centre, 610 Cheong Cheong Road, Kowloon Tel: 28482121 Fax: 28482122 E-MAIL: J-853-SU-CA-4603	
REV: A			

B.D. REF :

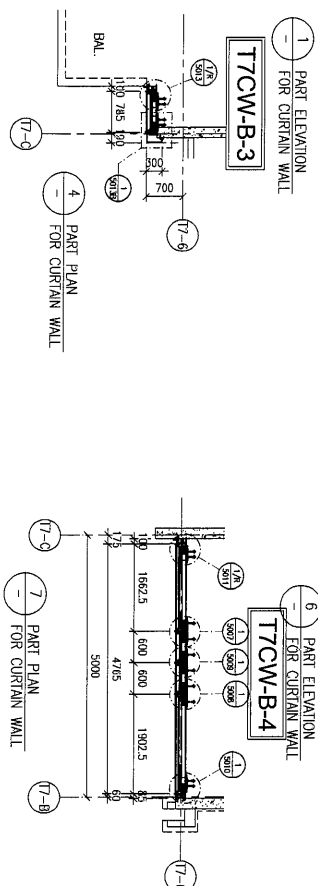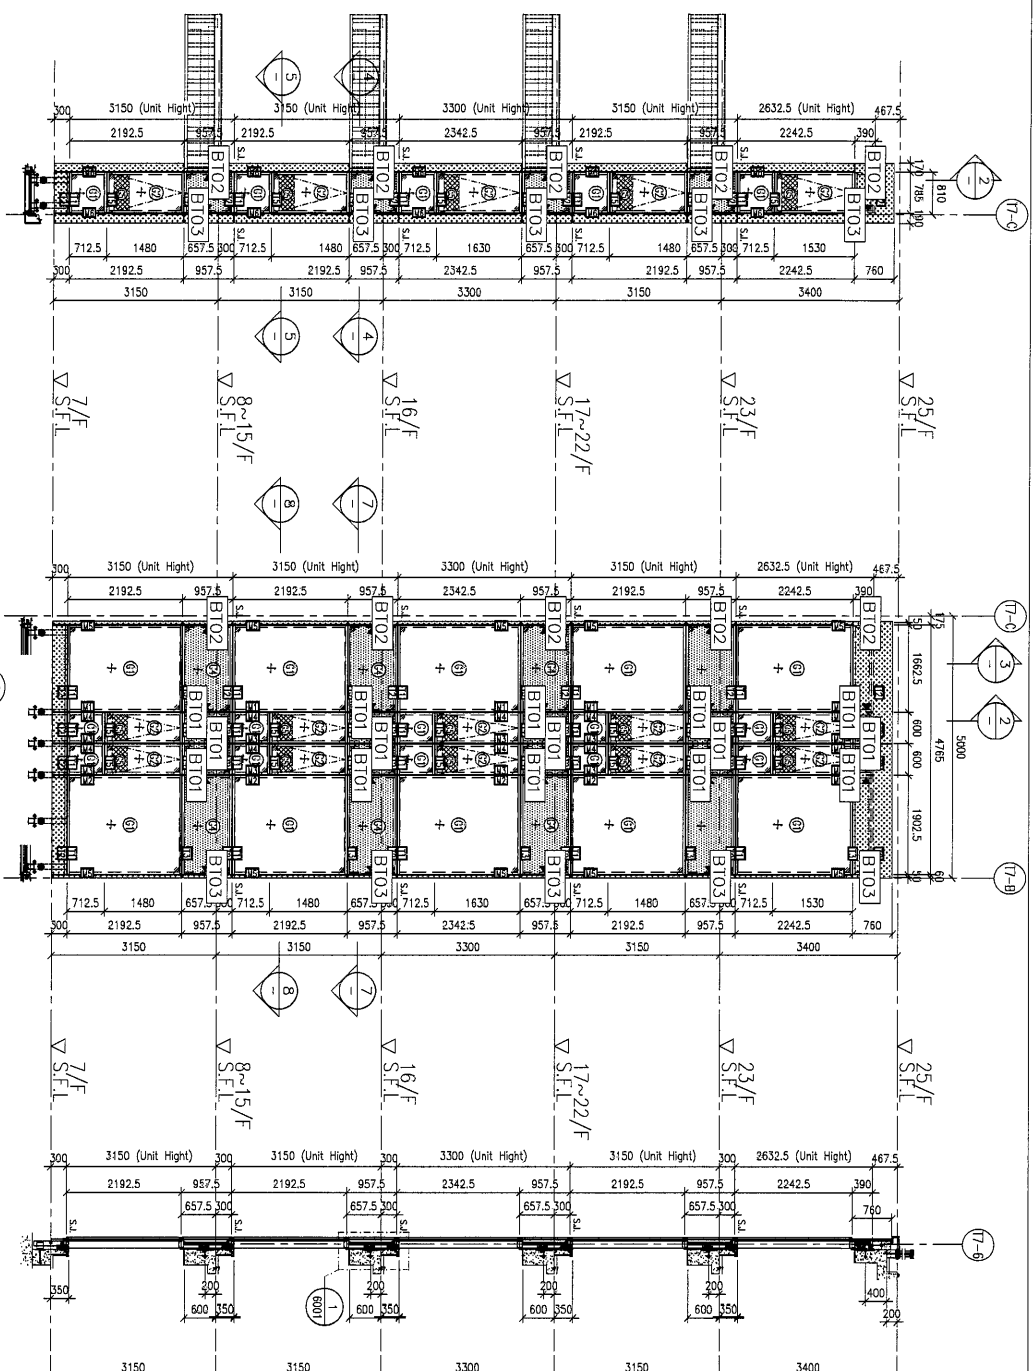

FLOOR LEVEL (SELL)	FLOOR	LEVEL
25/F	+203.40	
23/F	+200.00	
22/F	+196.85	
21/F	+193.70	
20/F	+190.55	
19/F	+187.40	
18/F	+184.25	
17/F	+181.10	
16/F	+177.80	
15/F	+174.65	
12/F	+171.50	
11/F	+168.35	
10/F	+165.20	
9/F	+162.05	
8/F	+158.90	
7/F	+155.75	

- NOTE:**
1. ALL DIMENSIONS ARE IN mm.
 2. ALL ELEVATIONS ARE VIEWED FROM
 3. ALL DIMENSIONS TO BE VERIFIED BEFORE FABRICATION.
- LEGEND:**
- DETAIL MARK NO.

REFR SHEET NO.
1. F.F.L. --- FINISHED FLOOR LEVEL
 2. S.F.L. --- STRUCTURAL FLOOR LEVEL
 3. R --- REVERSED DETAIL

MEINHARDT

FACADE CONSULTANT:

CIM WONG & ASSOCIATES LTD
黃志明建築工程師有限公司

STRUCTURAL ENGINEER :


 鴻興建築有限公司
 HIP HING CONSTRUCTION CO. LTD.

MAIN CONTRACTOR

ARCHITECT
WONG TUNG & PARTNERS LIMITED
ARCHITECTS & PLANNERS

SHIMAO GROUP
HOLDINGS LIMITED

CLIENT :

- | | LEGEND: |
|--|---|
| | 10mm HEAT STRENGTHENED GLASS (QHS) |
| | + 12mm AIR SPACE + 12mm THK. TEMPERED |
| | GLASS (NG) |
| | + 12mm AIR SPACE + 10mm THK. TEMPERED |
| | CLEAR GLASS (NG) |
| | 12mm THK. HEAT STRENGTHENED GLASS |
| | + 2mm THK. ALUM. BOREPAN (SPINDEL GLASS) |
| | 12mm THK. ALUM. TEMPERED GLASS
(INTERNAL PROTECTIVE BARRIER) |
| | 3mm THK. ALUM. CLADDING |
| | STICK JOINT |
| | ALUM. EXTRUSION DIE NO. |
| | SUPPORT POINT |
| | RESTRAINT SOCKET |

DATE : 12-APR-21	SCALE : 1:60 (A1)
DRAWN BY : LHR	CHECKED BY :
 美特鋁質有限公司 MTDI ALUMINUM FABRICATOR LTD. Units 6-8, Sunway Industrial Centre, 1/F 610 Chio Kwe Ling Road, Kowloon Tel:3489211-4 Fax:852(2)7772666	
DWG NO : JB53-SD-CN-4604 REV. : A	

PROPOSED RESIDENTIAL
DEVELOPMENT AT N.K.I.L. 65
YIN PING ROAD
KOWLOON

FILE : PART ELEVATION

FOR CURTAIN WALL
AT TOWER 6 & 7


DATE : 12-APR-21	SCALE : 1:60
------------------	--------------

DRAWN BY : LHR	CHECKED BY :
----------------	--------------

美特鋁質有限公司
MIDI ALUMINIUM FABRICATOR LTD.

Units 6-8, Sunray Industrial Centre, 1/F
610 Cha Kwo Ling Road, Kowloon
T: (37480314-4 Fax: (852) 37727355

TEL: 23709211-7	REV. : A
FAX: 652/21121000	
DWG NO. : J853-SD-CW-4604	

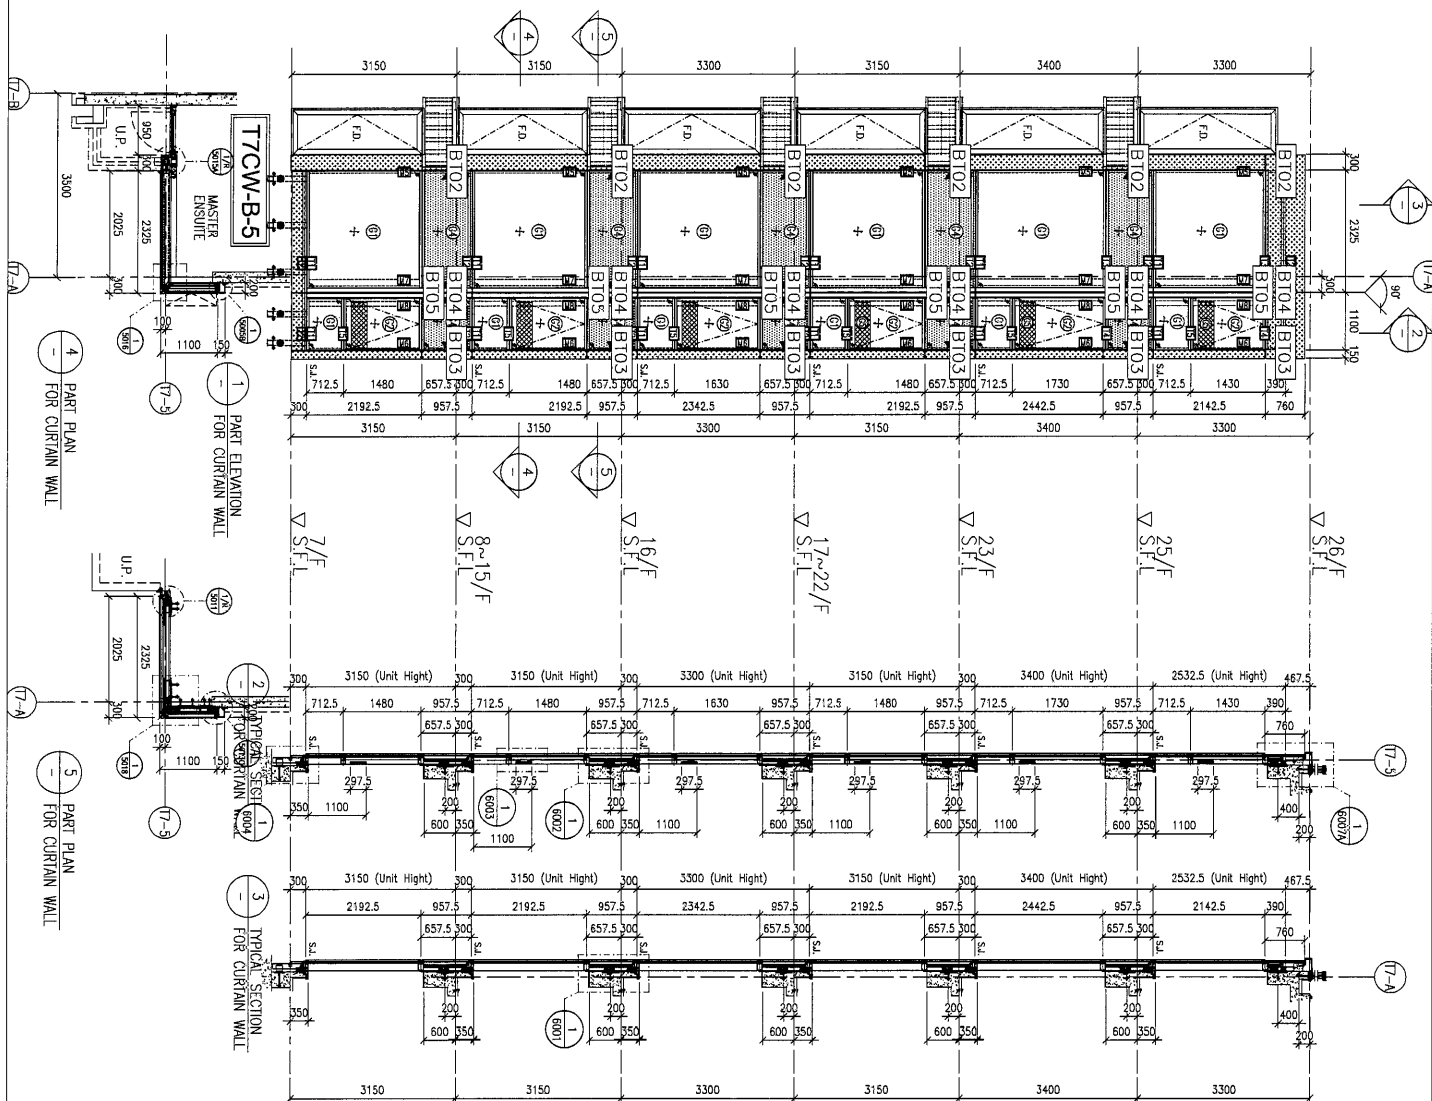

LEGEND:

①	10mm HEAT STRENGTHENED GLASS (INTER)
②	12mm HEAT STRENGTHENED GLASS (INTER)
③	12mm HEAT STRENGTHENED GLASS (INTER)
FLOOR LEVEL (S.F.L.)

FLOOR	LEVEL
26/F	+206.70
25/F	+203.40
23/F	+200.00
22/F	+196.85
21/F	+193.70
20/F	+190.35
19/F	+187.40
18/F	+184.25
17/F	+181.10
16/F	+177.95
15/F	+174.80
12/F	+171.50
11/F	+168.35
10/F	+165.20
9/F	+162.05
8/F	+158.90
7/F	+155.75

CLIENT : SHIMAO GROUP HOLDINGS LIMITED

ARCHITECT : YOUNG TUNG & PARTNERS LIMITED

MAIN CONTRACTOR : 協興建築有限公司
HIP HING CONSTRUCTION CO LTD

STRUCTURAL ENGINEER : C M WONG & ASSOCIATES LTD
黃志明建築工程師有限公司

FAÇADE CONSULTANT : MEINHARDT

NOTE :
1. ALL DIMENSIONS ARE IN mm.
2. ALL DIMENSIONS ARE MEASURED FROM OUTSIDE.
3. ALL DIMENSIONS TO BE VERIFIED ON SITE BEFORE FABRICATION.


LEGEND :
① DETAIL MARK NO.
② HATCH SHEET NO.
1. F.F.L. -- FINISHED FLOOR LEVEL.
2. S.F.L. -- STRUCTURAL FLOOR LEVEL.
3. ㉑ -- REVERSED DETAIL.

PROJECT : PROPOSED RESIDENTIAL DEVELOPMENT AT N.K.L.L. 6542 YIN PING ROAD KOWLOON


TITLE : PART ELEVATION FOR CURTAIN WALL AT TOWER 6 & 7

DATE : 12-APR-21 SCALE : 1:40 (A1)

DRAWN BY : LHF CHECKED BY :
M.T. 協興建築有限公司
610 Chee Yee Road, Kowloon
Tel: 23489211-4 Fax: (852) 27277866
DWG NO. : 4853-SD-CN-4605 REV. : A

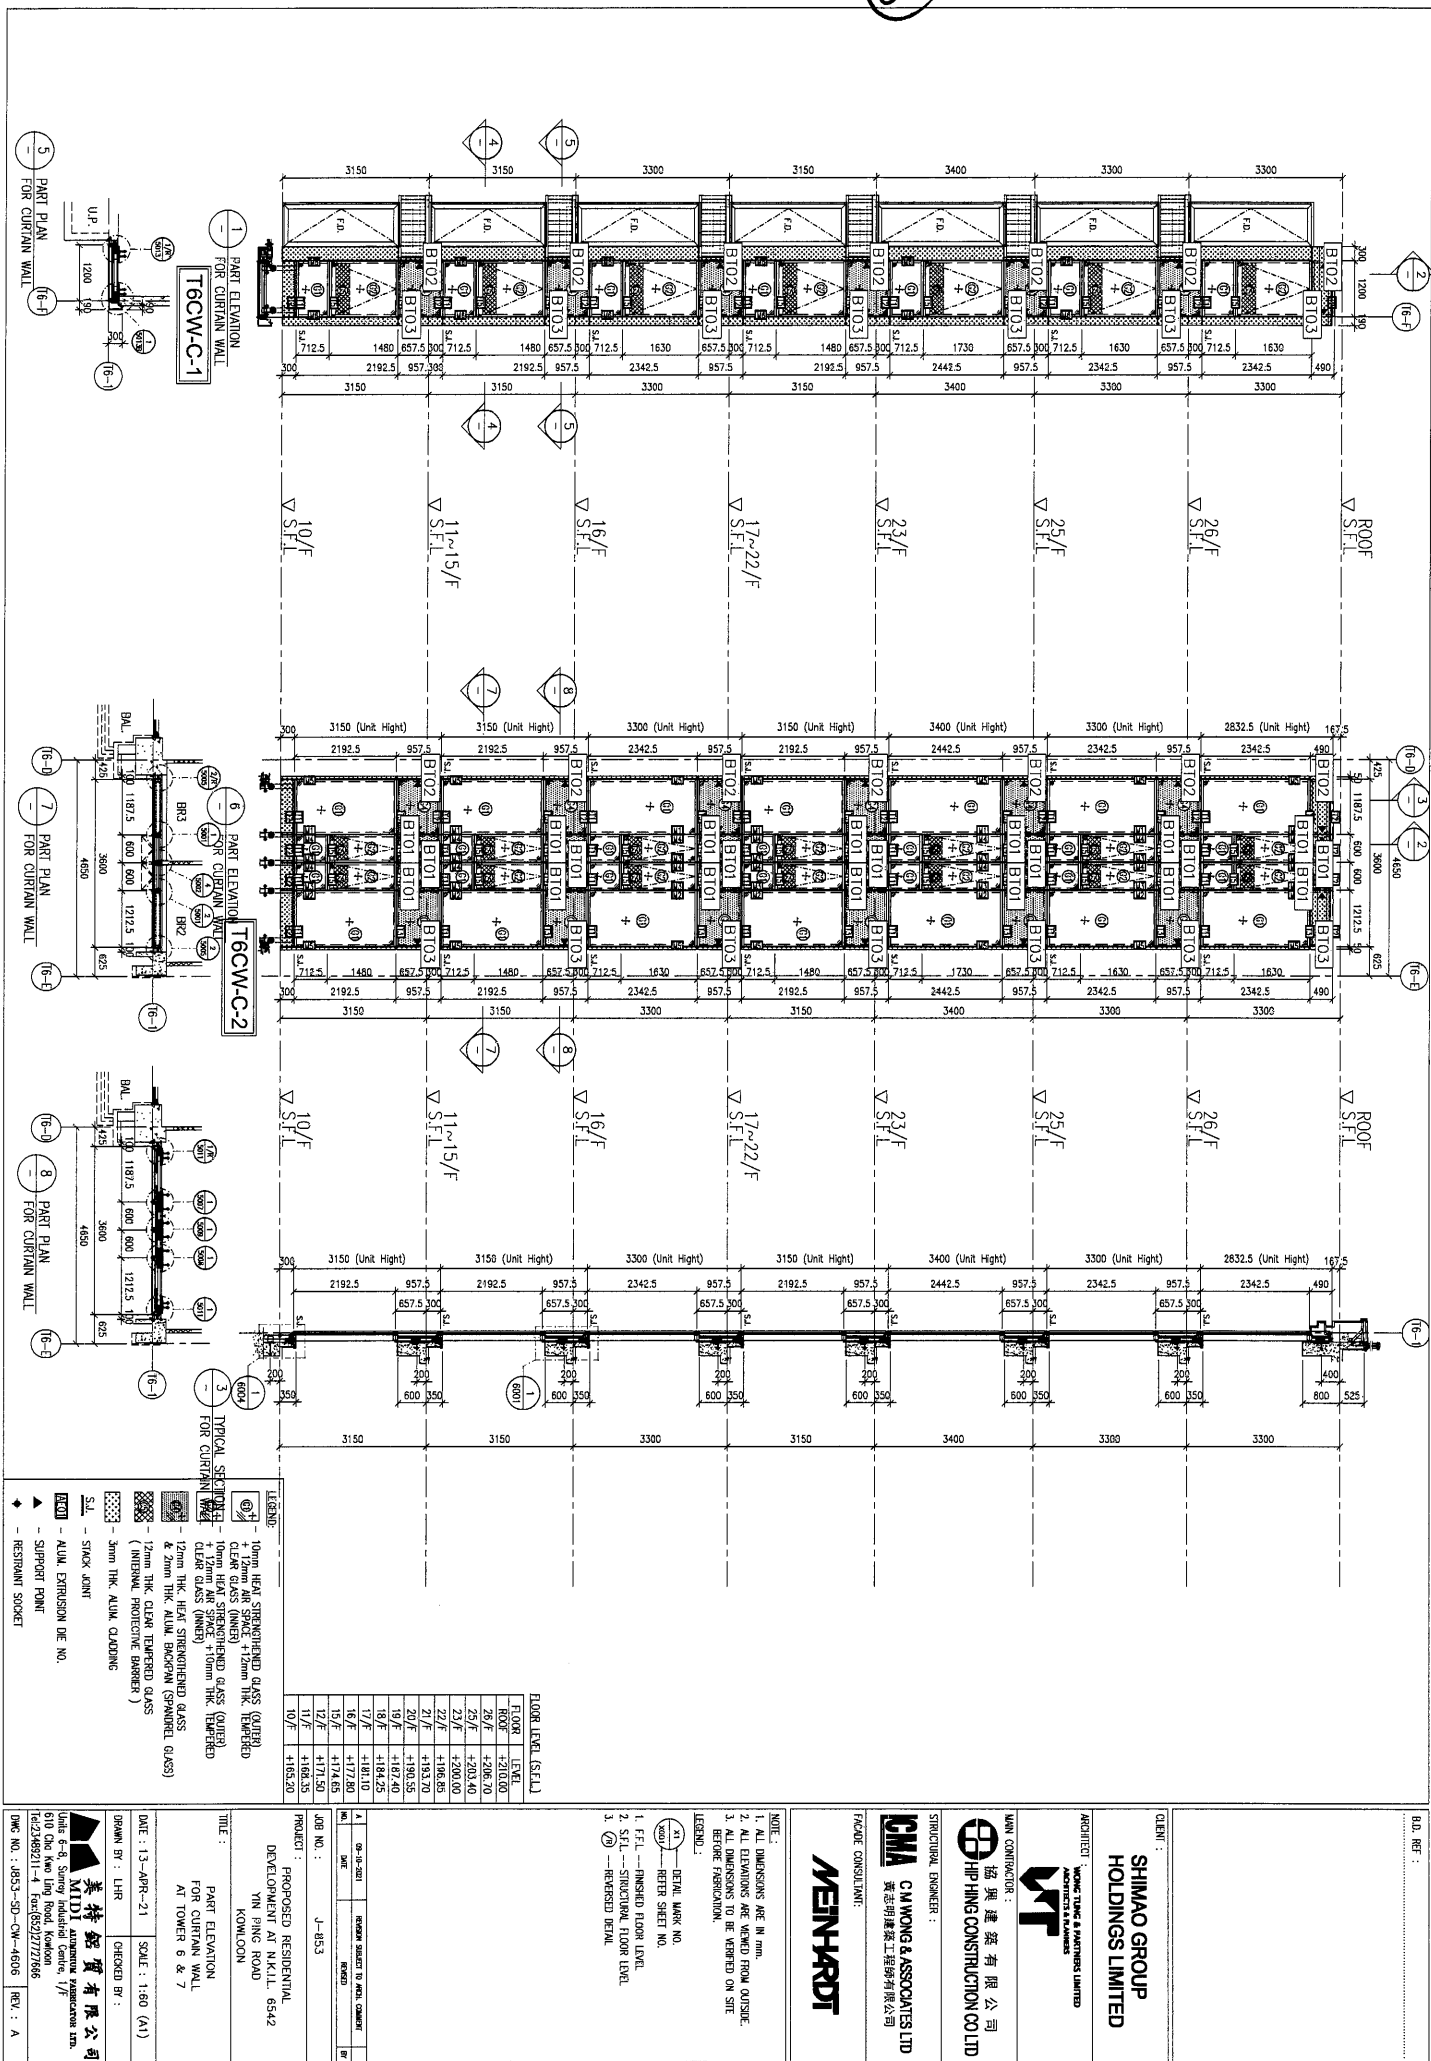

UW6 NU. : J853--5D--CW--4606

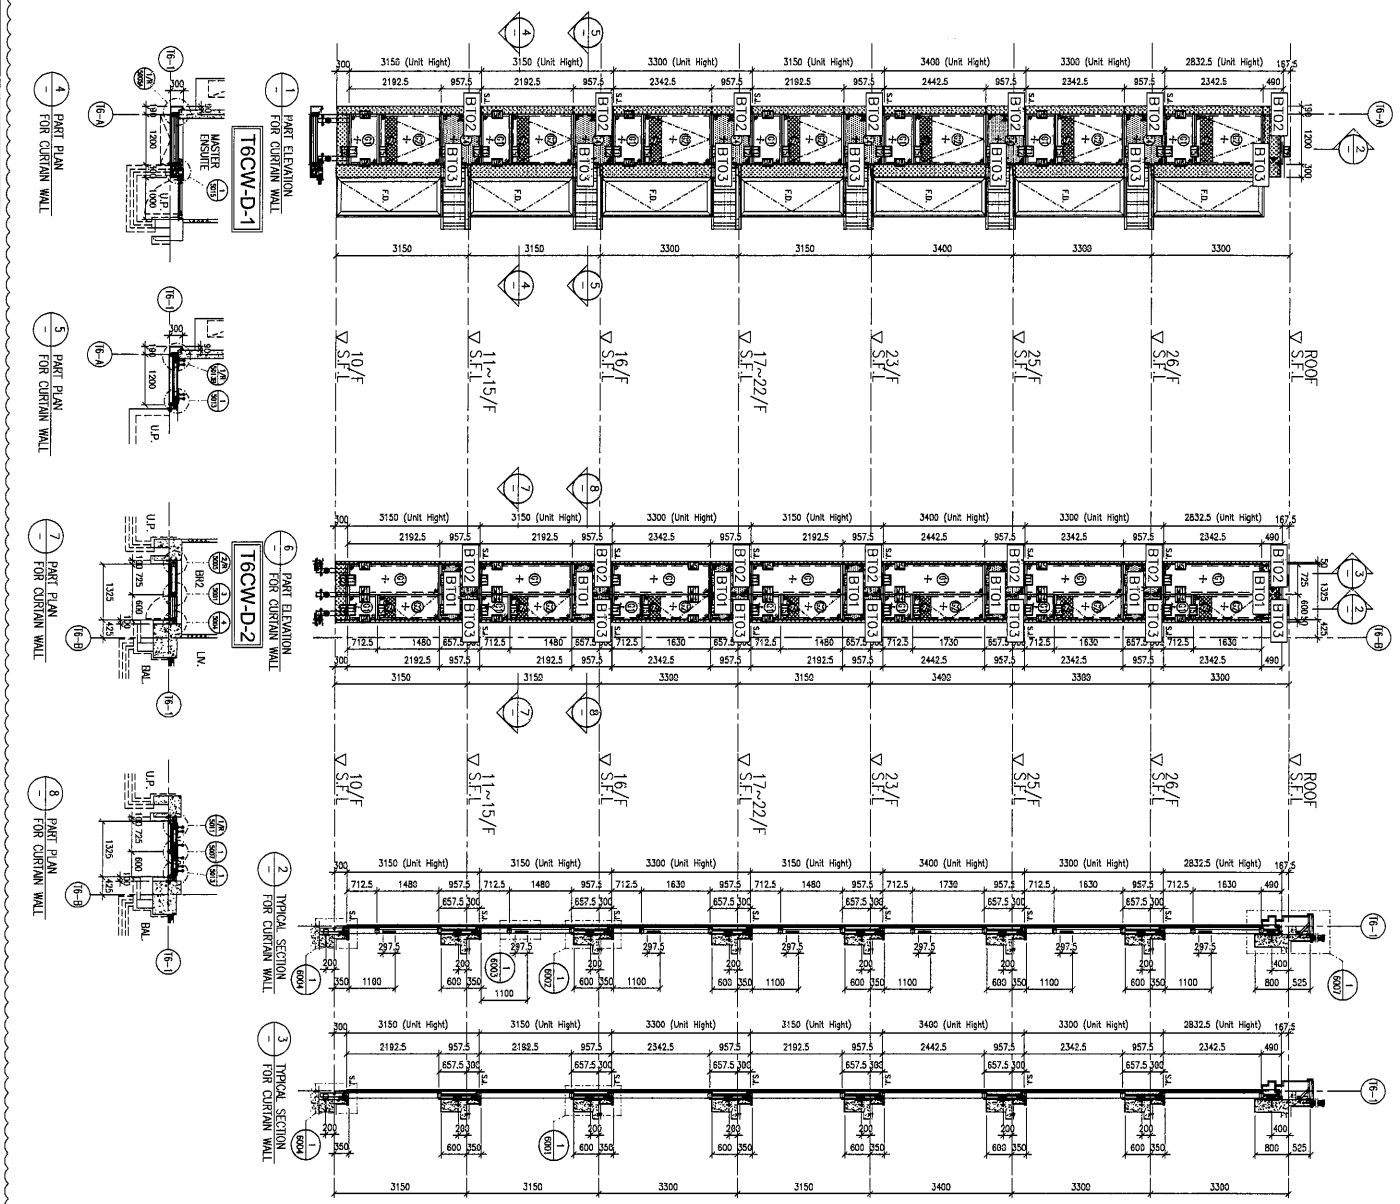

LEGEND:

①	10mm HEAT STRENGTHENED GLASS (OUTER)
②	12mm HEAT STRENGTHENED GLASS (INNER)
③	12mm HEAT STRENGTHENED GLASS (OUTER)
④	12mm HEAT STRENGTHENED GLASS (INNER)
⑤	12mm HEAT STRENGTHENED GLASS (OUTER)
㊿	12mm HEAT STRENGTHENED GLASS (INNER)

CLIENT : SHIMAO GROUP HOLDINGS LIMITED

ARCHITECT : WONG TUNG & PARTNERS LIMITED

MAIN CONTRACTOR : 協興建築有限公司
HIP HING CONSTRUCTION CO. LTD

STRUCTURAL ENGINEER : C.M. WONG & ASSOCIATES LTD
黃志明建築工程師有限公司

FAÇADE CONSULTANT : MEINHARDT

PROJECT : PROPOSED RESIDENTIAL DEVELOPMENT AT NKILL 6542 YIN PING ROAD KOWLOON

TITLE : PART ELEVATION FOR CURTAIN WALL AT TOWER 6 & 7


DATE : 13-APR-21 **SCALE :** 1:50 (A1)

DRAWN BY : LHR **CHECKED BY :**

DESIGNER : 美特銘實業有限公司
M.T.M. INTERNATIONAL CORPORATION LTD.
510-6-23 Sunny Industrial Centre, 1/F
1023480211-4 Fax: (852) 27272666

DWG NO. : JBS5-SD-CN-4607 **REV. :** A

28

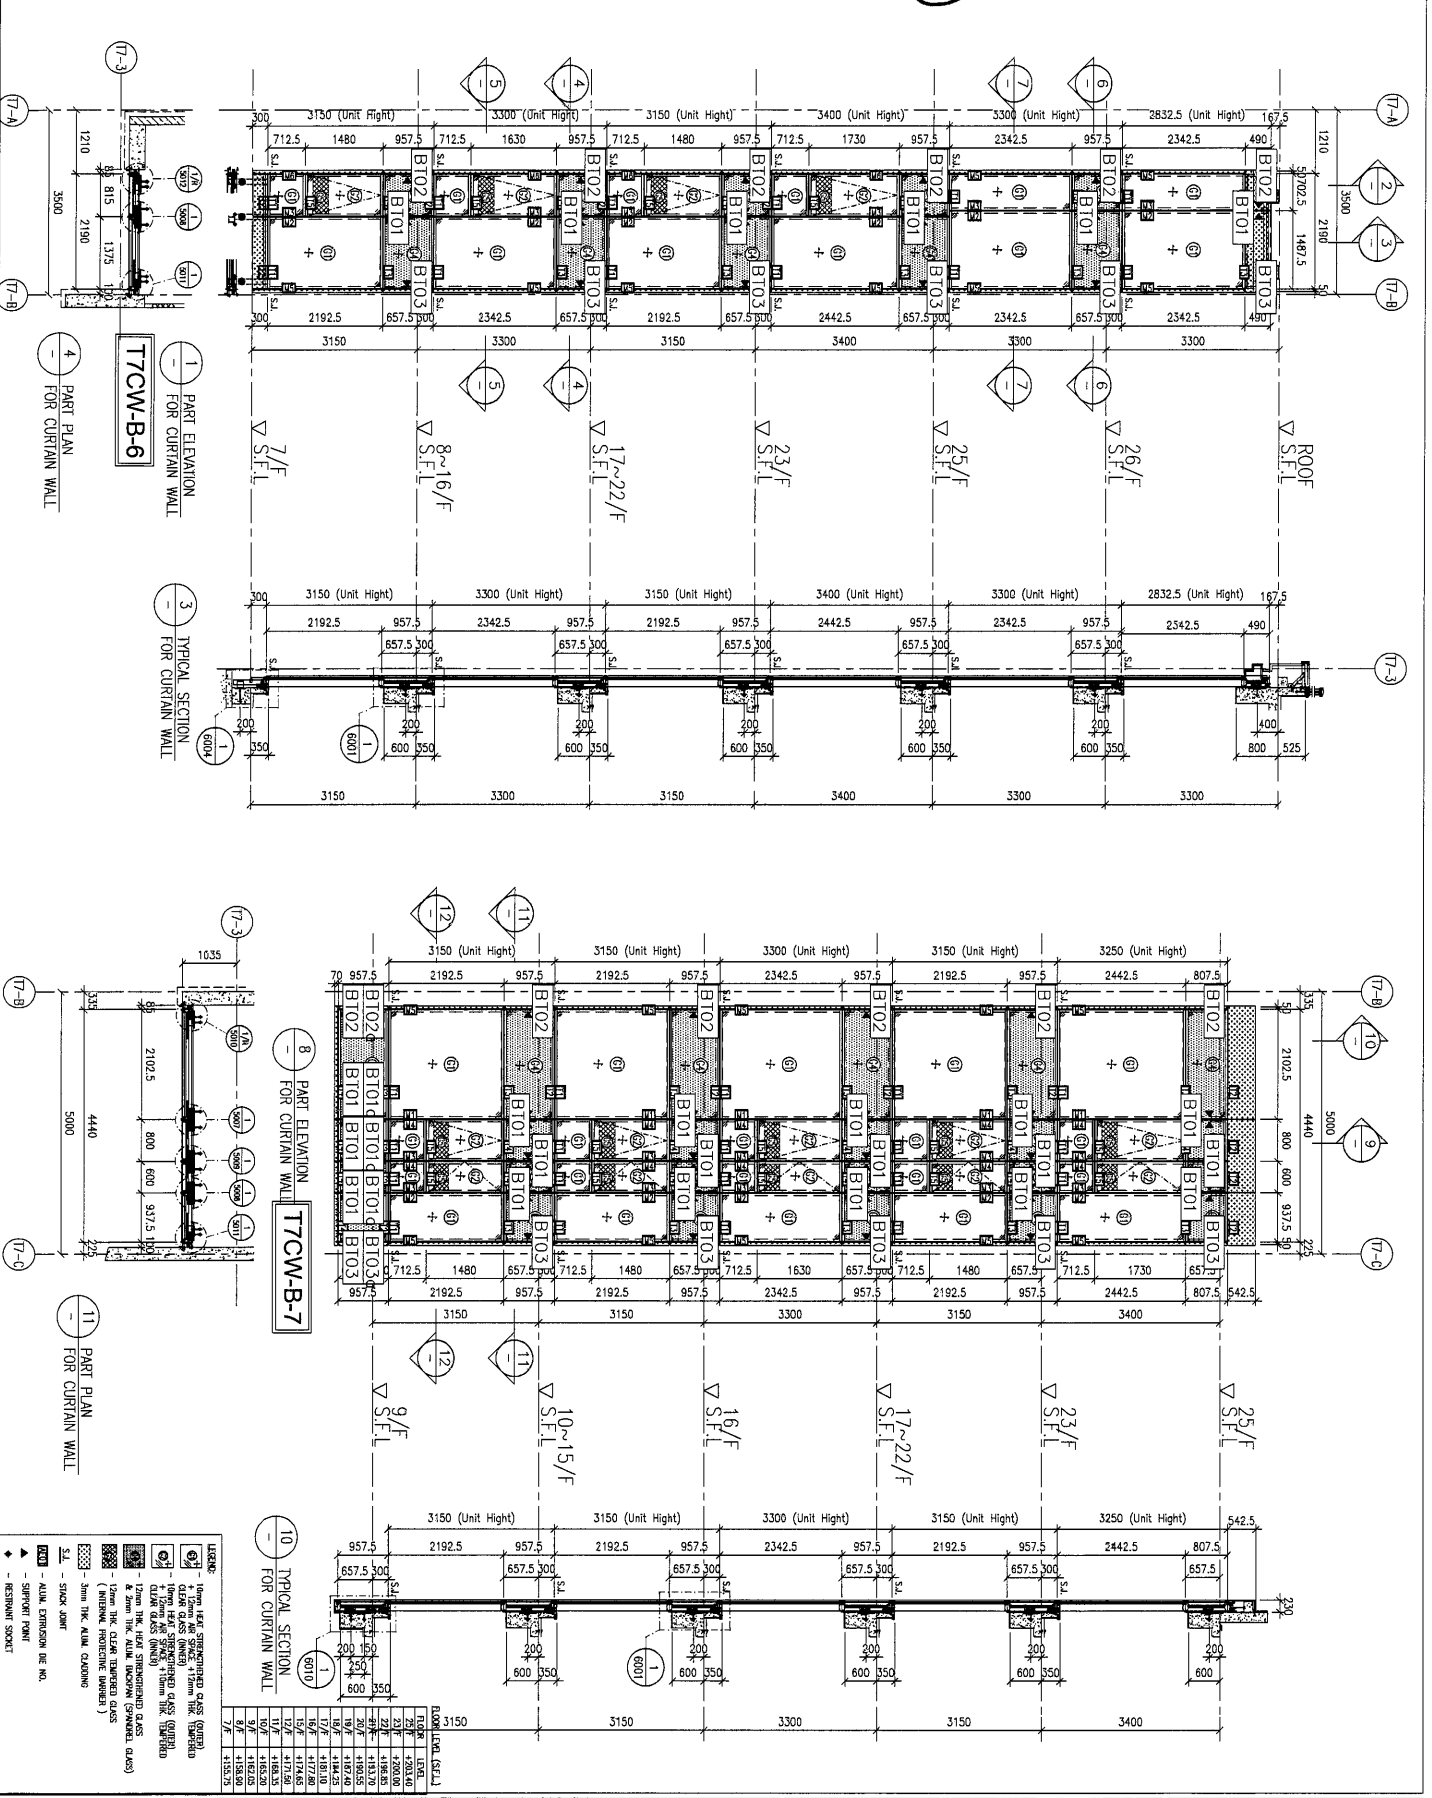

BLD. REF. :

CLIENT : SHIMAO GROUP HOLDINGS LIMITED

ARCHITECT : WONG TUNG & PARTNERS LIMITED

MAIN CONTRACTOR : 協興建築有限公司
HIP HING CONSTRUCTION CO. LTD

STRUCTURAL ENGINEER : CMA C M WONG & ASSOCIATES LTD
黃志明建築工程師有限公司

FAÇADE CONSULTANT : MEINHARDT

NOTE :

1. ALL DIMENSIONS ARE IN mm.

2. ALL DIMENSIONS ARE VIEWED FROM OUTSIDE.

3. BEFORE FABRICATION.

LEGEND :

1. DETAIL MARK NO.

2. F.F.L. --- FINISHED FLOOR LEVEL.

3. S.F.L. --- STRUCTURAL FLOOR LEVEL.

4. --- REVERSED DETAIL.

PROJECT : PROPOSED RESIDENTIAL DEVELOPMENT AT NIKILL, 6542 YIN PING ROAD KOWLOON

TITLE : PART ELEVATION FOR CURTAIN WALL AT TOWER 6 & 7

DWG NO. : 0553-SD-CN-4608

DATE : 13-APR-21

DRAWN BY : LHF

CHECKED BY : QED

SCALE : 1:60 (A1)

DATE : 13-APR-21

DWG NO. : 0553-SD-CN-4608

REV. : A

LEGEND :

1. 12mm THK. CLEAR STRENGTHENED GLASS (OUTER)

2. 12mm THK. CLEAR STRENGTHENED GLASS (INNER)

3. 12mm THK. CLEAR STRENGTHENED GLASS (OUTER)

4. 12mm THK. CLEAR STRENGTHENED GLASS (INNER)

5. 12mm THK. CLEAR STRENGTHENED GLASS (OUTER)

100. 12mm THK. CLEAR STRENGTHENED GLASS (INNER)

