



工程指示 / 要求簡箋(E.I.)

工程指示編號：EI/ 4372 / 22

修改版次：A

工程編號：J-853

工程名稱：大窩坪(廷坪路)

工程項目：欄河項目開模

收件人：Maggie

發件人：大明

日期：14/03/2022

要求提供 / 確認 事項：

- | | | |
|------------------------------------|-------------------------------------|-------------------------------|
| <input type="checkbox"/> 初步鋁料 B.M. | <input type="checkbox"/> 加工拆圖，然後生產 | <input type="checkbox"/> 尺寸表 |
| <input type="checkbox"/> 正式鋁料 B.M. | <input type="checkbox"/> 技術上資料 / 指示 | <input type="checkbox"/> 報 |
| <input type="checkbox"/> 配件 B.M. | <input type="checkbox"/> 樣辦或貨品說明書 | <input type="checkbox"/> 分判合約 |
| <input type="checkbox"/> 其他：_____ | | |

內容：

煩請 按圖紙修改模圖

(CKHK17041, 17046) 共 2 個

(X86223, X86228)

請在 11/04/2022 前完成上列要求。

附有關圖紙 / 文件：附 B.M 表 頁,圖紙 2 頁

以上項目為:

- 原合約工程包 原合約工程加 / 減賬 新工程報價

原因：-

分發東莞各部門：

- () 生產技術總監 連附件 () 技術部 連附件 () 生產部 連附件 () 機械設計部 連附件
 () 採購部 連附件 () 生產統籌部 連附件
 () 質檢部 連附件 () 會計部 連附件 () 報關組 連附件 () 其他 _____ 連附件

分發香港各部門：

- () 行政部 連附件 () 會計部 連附件 () 統籌部 連附件 () 工程部地盤科文 連附件
 () 採購部 連附件 () QS 部 連附件 () 維修部 連附件 () 其他 _____ 連附件

傳遞編號：




發件人簽署：

項目經理簽署：

CUSTOMER	CUSTOMER APPROVAL	CUST PART NO.	AL-GB-A14(0)
		SECTION NO.	X86228


$a=0.1r$
 $b=0.2r$
 $c=0.3r$
 $d=0.4r$
 $e=0.5r$

玻璃欄河主企收口疋 (5)

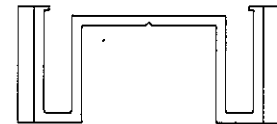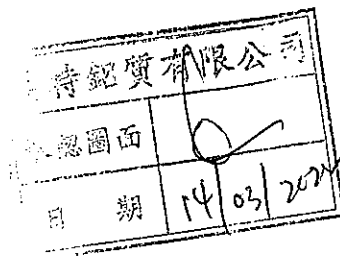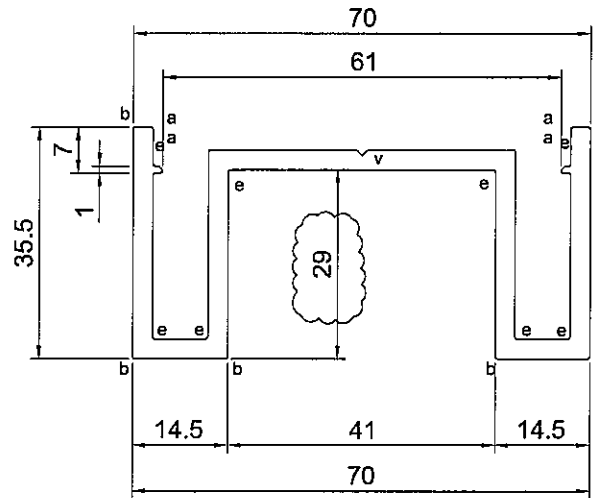

V.F




SCALE 1:2

SIGNATURE GRADEING	HIGH SIGNATURE GRADEING	C.C.DIA(MM)	78.48						
AREA (SQ MM)	581.18	UNSPECIFIED THICKNESS	3.0	PERIMETER (MM)	394.91	STANDARD		SCALE	1:1
MASS (KG/M)	1.575	UNSPECIFIED CORNERS	-	SURFACE AREA	71.45	ALLOY	6063-T5	VERSION	-
COMPANY ISSUE		DRAWN	CJM	DATE	2022-01-18	APELLATION		PAGE OF	
		STANDARDIZATION		DATE		 美特鋁質有限公司 MIDI Aluminium Fabricator Ltd.			
		TO SIGN		DATE					
		AUDITING		DATE					
MARKER	MODIFY	FILE NO	SIGNATURE	DATE	APPROV	DATE			

CUSTOMER	CUSTOMER APPROVAL	CUST PART NO.	AL-UP-A9(0)
		SECTION NO.	X86223

柵格欄河特飾 (頂)

$a=0.1r$
 $b=0.2r$
 $c=0.3r$
 $d=0.4r$
 $e=0.5r$

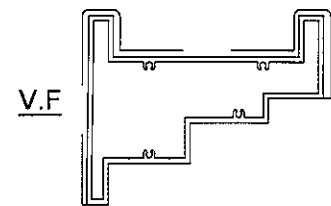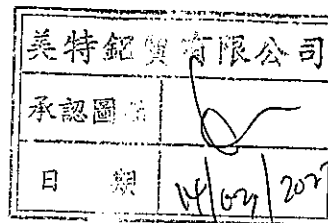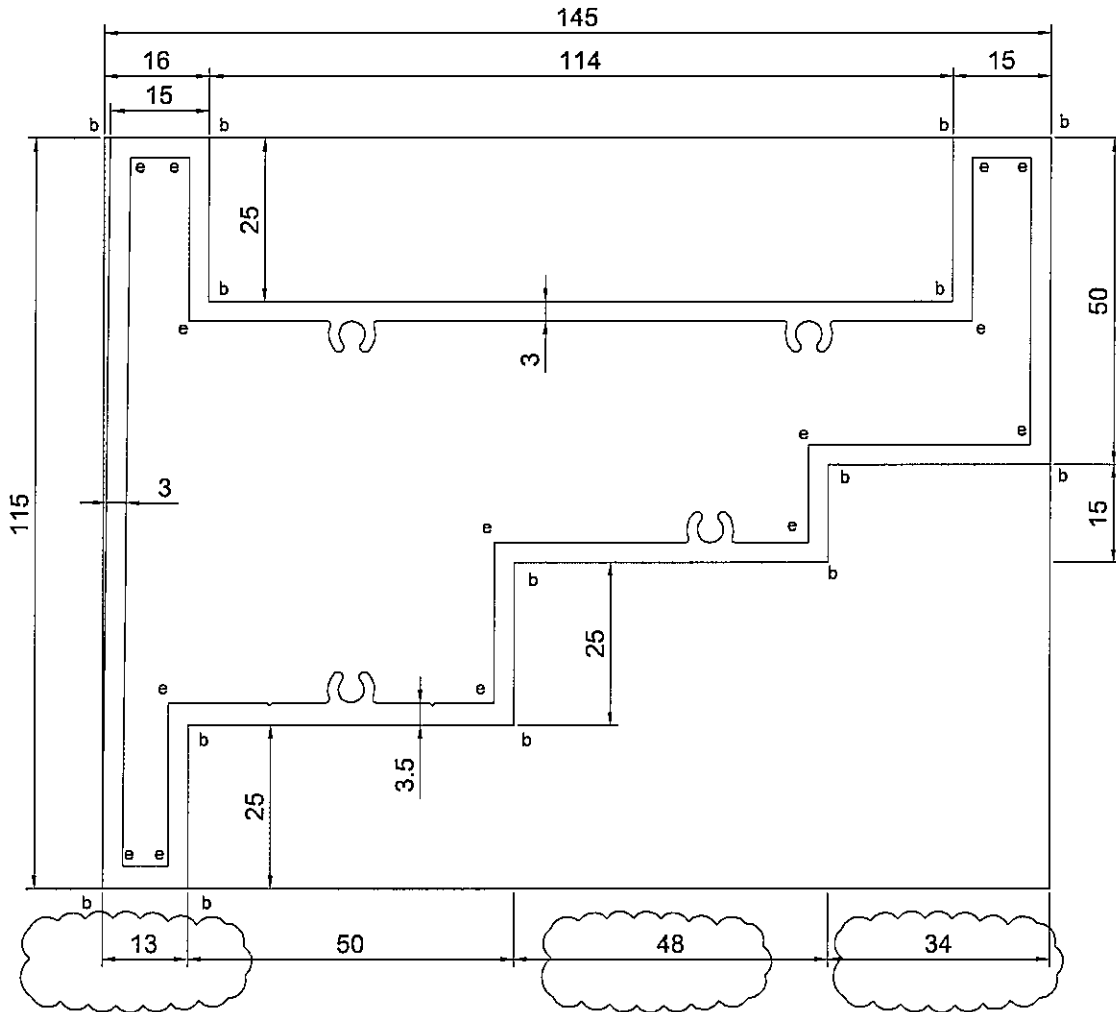

SIGNATURE GRADEING	HIGH SIGNATURE GRADEING	C.C.DIA(MM)	185.06						
AREA (SQ MM)	1765.32	UNSPECIFIED THICKNESS	3.0	PERIMETER (MM)	569.05	STANDARD		SCALE	1:1
MASS (KG/M)	4.784	UNSPECIFIED CORNERS	-	SURFACE AREA	387.00	ALLOY	6063-T6	VERSION	-
COMPANY ISSUE			DRAWN	CJM	DATE	2022-01-18	APPELLATION	PAGE OF	
			STANDARDIZATION		DATE				
			TO SIGN		DATE				
			AUDITING		DATE				
MARKER	MODIFY	FILE NO	SIGNATURE	DATE	APPROV	DATE			

