

工程指示 / 要求簡箋 ENGINEER INSTRUCTIONS(E.I.)

工程指示編號:	EI- 4579	修改版本:	A
	HK- 1323		
工程編號:	J 853	工程名稱:	大窩坪 (延坪道)
收件人:	生統	發件人:	Bear Lam
工程項目:	幕牆 (T3) 背板2mm 厚鋁板 (廠用) 大貨更新	日期:	11/08/2022

<input type="checkbox"/> 原合約工程包	<input type="checkbox"/> 原合約工程加 / 減脹 QT-	<input type="checkbox"/> 新工程報價 QT-
---------------------------------	--	------------------------------------

信件批核號碼/圖紙參考編號:	批核模具圖紙編號:
客戶指示附件:	管理內部批簽署:

<input type="checkbox"/> 初步鋁料 B.M.	<input type="checkbox"/> 加工拆圖, 然後生產	<input type="checkbox"/> 尺寸表
<input type="checkbox"/> 正式鋁料 B.M.	<input type="checkbox"/> 技術上資料/指示	<input type="checkbox"/> 報價
<input type="checkbox"/> 配件 B.M.	<input type="checkbox"/> 樣辦或貨品說明書	<input type="checkbox"/> 分判合約
<input type="checkbox"/> 其他:		

內容: 請依照附件取消及新增廠用T3幕牆背板 (2mm 厚鋁板), 特此通知。

完成上列要求日期:

國內

<input type="checkbox"/> 生產技術總監	<input type="checkbox"/> 連附件	<input type="checkbox"/> 技術部	<input type="checkbox"/> 連附件	<input type="checkbox"/> 生產部	<input type="checkbox"/> 連附件
<input type="checkbox"/> 採購部	<input type="checkbox"/> 連附件	<input checked="" type="checkbox"/> 生產統籌部	<input checked="" type="checkbox"/> 連附件	<input type="checkbox"/> 報關組	<input type="checkbox"/> 連附件
<input type="checkbox"/> 質檢部	<input type="checkbox"/> 連附件	<input type="checkbox"/> 會計部	<input type="checkbox"/> 連附件	<input type="checkbox"/> 機械設計部	<input type="checkbox"/> 連附件
<input type="checkbox"/> 香港辦	<input checked="" type="checkbox"/> 連附件	<input type="checkbox"/> 其他:			

香港

<input type="checkbox"/> 行政部	<input type="checkbox"/> 連附件	<input type="checkbox"/> 會計部	<input type="checkbox"/> 連附件	<input type="checkbox"/> 統籌部	<input type="checkbox"/> 連附件	<input type="checkbox"/> 工程部	<input type="checkbox"/> 連附件
<input type="checkbox"/> 採購部	<input type="checkbox"/> 連附件	<input type="checkbox"/> QS部	<input type="checkbox"/> 連附件	<input checked="" type="checkbox"/> 地盤管理	<input checked="" type="checkbox"/> 連附件	<input type="checkbox"/> 維修部	<input type="checkbox"/> 連附件

*發件人簽署:		*組別成員批核簽署:	
傳遞編號:		項目經理簽署:	

圖則登記表
DRAWING REGISTER

工程名稱 Project Title:	九龍延坪道 大貨(T3座)幕牆背板
工程編號 Project No:	J-853

分發予 Distributed To

接收日期 Receiving Date (適用於客戶圖則)

年									
月									
日									

發出日期 Issued Date


年	22	22	22						
月	4	4	8						
日	10	13	9						


圖則編號 Drg. No.	圖則名稱 Drawing Title
DBP-01	背板拆圖
DBP-01-SJ	背板拆圖數據表
DBP-01d	背板拆圖
DBP-05a	背板拆圖
DBP-05a-SJ	背板拆圖數據表
DBP-06b	背板拆圖
DBP-301	轉角梗窗背板拆圖
DBP-22	轉角生窗背板拆圖
DBP-302b	轉角梗窗背板拆圖
DBP-22b	轉角生窗背板拆圖
J853-SD-CW-4301	背板位置圖
J853-SD-CW-4302	背板位置圖
J853-SD-CW-4303	背板位置圖
J853-SD-CW-4304	背板位置圖
J853-SD-CW-4304A	背板位置圖
J853-SD-CW-4305	背板位置圖
J853-SD-CW-4306	背板位置圖

修訂編號
Revision No.

1	-	-	A						
2	-	-	A						
3	-	A	B						
4	-	-	A						
5	-	-	A						
6	-	-	A						
7	-	-	A						
8	-	-	A						
9	-	-	A						
10	-	-	A						
11	-	-	-						
12	-	-	A						
13	-	-	A						
14	-	-	-						
15	-	-	-						
16	-	-	-						
17	-	-	-						

 美特鋁質有限公司 MIDI Aluminium Fabricator Ltd.		工程號:	J-853	計算:	陳敏聰	日期:	2022.04.03			送呈:					
		地盤名稱:	延坪道住宅	核對:	謝永林	日期:	2022.08.09			副本:					
廠用鋁背板B.M.表		項目類別:	T3座幕牆背板	批准:		日期:				A/C Code:					
		修改版次:	A 22.8.9	總V.F.:	280.68		總重量:		2009.48						
序號	修改內容	鋁板圖號	鋁板名稱	顏色	實用	後備	總數	總重量	單件展開面積m ²	總展開面積m ²	單件V.F.m ²	總V.F.m ²	位置	樓層	類型
1		DBP-1	2mm厚鋁板	UCT542049SC-3(淺灰)	8		8	17.49	0.40	3.227	0.26	2.040	J853-SD-CW-4305	6/F-15/F	標準層
2		DBP-5	2mm厚鋁板	UCT542049SC-3(淺灰)	18		18	48.64	0.50	8.975	0.34	6.091	J853-SD-CW-4304	5/F-25/F	標準層
3		DBP-5	2mm厚鋁板	UCT542049SC-3(淺灰)	18		18	48.64	0.50	8.975	0.34	6.091	J853-SD-CW-4305	5/F-25/F	標準層
4		DBP-6	2mm厚鋁板	UCT542049SC-3(淺灰)	6		6	19.31	0.59	3.562	0.42	2.531	J853-SD-CW-4301	17/F-22/F	標準層
5		DBP-6	2mm厚鋁板	UCT542049SC-3(淺灰)	16		16	51.49	0.59	9.500	0.42	6.748	J853-SD-CW-4302	5/F-22/F	標準層
6		DBP-6	2mm厚鋁板	UCT542049SC-3(淺灰)	10		10	32.18	0.59	5.937	0.42	4.218	J853-SD-CW-4303	5/F-16/F	標準層
7		DBP-6	2mm厚鋁板	UCT542049SC-3(淺灰)	18		18	57.92	0.59	10.687	0.42	7.592	J853-SD-CW-4304	5/F-25/F	標準層
8		DBP-6	2mm厚鋁板	UCT542049SC-3(淺灰)	18		18	57.92	0.59	10.687	0.42	7.592	J853-SD-CW-4305	5/F-25/F	標準層
9	取消一個	DBP-7	2mm厚鋁板	UCT542049SC-3(淺灰)	9		9	29.54	0.61	5.451	0.43	3.890	J853-SD-CW-4303	6/F-16/F	標準層
10		DBP-7	2mm厚鋁板	UCT542049SC-3(淺灰)	7		7	22.98	0.61	4.239	0.43	3.025	J853-SD-CW-4303	17/F-23/F	標準層
11		DBP-16	2mm厚鋁板	UCT542049SC-3(淺灰)	18		18	68.83	0.71	12.700	0.52	9.354	J853-SD-CW-4304A	5/F-25/F	標準層
12		DBP-16	2mm厚鋁板	UCT542049SC-3(淺灰)	18		18	68.83	0.71	12.700	0.52	9.354	J853-SD-CW-4304A	5/F-25/F	標準層
13		DBP-18	2mm厚鋁板	UCT542049SC-3(淺灰)	2		2	7.98	0.74	1.473	0.55	1.094	J853-SD-CW-4303	25/F	標準層
14	取消	DBP-25	2mm厚鋁板	UCT542049SC-3(淺灰)	0		0	0.00	0.00	0.000	0.00	0.000	J853-SD-CW-4302	5/F-25/F	標準層
15		DBP-28	2mm厚鋁板	UCT542049SC-3(淺灰)	8		8	39.15	0.90	7.224	0.69	5.541	J853-SD-CW-4305	6/F-15/F	標準層
16		DBP-30	2mm厚鋁板	UCT542049SC-3(淺灰)	18		18	90.41	0.93	16.682	0.71	12.843	J853-SD-CW-4304A	5/F-25/F	標準層
17		DBP-30	2mm厚鋁板	UCT542049SC-3(淺灰)	18		18	90.41	0.93	16.682	0.71	12.843	J853-SD-CW-4304A	5/F-25/F	標準層
18		DBP-303	2mm厚鋁板	UCT542049SC-3(淺灰)	8		8	50.50	1.16	9.317	0.92	7.375	J853-SD-CW-4302	17/F-25/F	標準層
19		DBP-304	2mm厚鋁板	UCT542049SC-3(淺灰)	16		16	59.74	0.69	11.022	0.51	8.082	J853-SD-CW-4302	5/F-22/F	標準層
20	取消一個	DBP-305	2mm厚鋁板	UCT542049SC-3(淺灰)	8		8	50.50	1.16	9.317	0.92	7.375	J853-SD-CW-4303	6/F-15/F	標準層
21	取消一個	DBP-306	2mm厚鋁板	UCT542049SC-3(淺灰)	9		9	34.18	0.70	6.307	0.52	4.640	J853-SD-CW-4303	6/F-16/F	標準層
22		DBP-307	2mm厚鋁板	UCT542049SC-3(淺灰)	7		7	48.25	1.27	8.902	1.02	7.109	J853-SD-CW-4303	17/F-23/F	標準層
23		DBP-308	2mm厚鋁板	UCT542049SC-3(淺灰)	1		1	8.50	1.57	1.569	1.28	1.276	J853-SD-CW-4303	25/F	標準層
24		DBP-309	2mm厚鋁板	UCT542049SC-3(淺灰)	18		18	86.93	0.89	16.039	0.68	12.280	J853-SD-CW-4304	5/F-25/F	標準層
25		DBP-310	2mm厚鋁板	UCT542049SC-3(淺灰)	18		18	96.22	0.99	17.752	0.77	13.780	J853-SD-CW-4304	5/F-25/F	標準層
26		DBP-311	2mm厚鋁板	UCT542049SC-3(淺灰)	18		18	118.50	1.21	21.863	0.97	17.381	J853-SD-CW-4304A	5/F-25/F	標準層

		工程號:	J-853	計算:	陳敏聰	日期:	2022.04.03	送呈:							
		地盤名稱:	延坪道住宅	核對:	謝永林	日期:	2022.08.09	副本:							
廠用鋁背板B.M.表		項目類別:	T3座幕牆背板	批准:		日期:		A/C Code:							
		修改版次:	A 22.8.9	總V.F.:	280.68	總重量:	2009.48								
序號	修改內容	鋁板圖號	鋁板名稱	顏色	實用	後備	總數	總重量	單件展開面積m ²	總展開面積m ²	單件V.F.m ²	總V.F.m ²	位置	樓層	類型
27		DBP-312	2mm厚鋁板	UCT542049SC-3(淺灰)	18		18	118.50	1.21	21.863	0.97	17.381	J853-SD-CW-4304A	5/F-25/F	標準層
28		DBP-313	2mm厚鋁板	UCT542049SC-3(淺灰)	18		18	96.22	0.99	17.752	0.77	13.780	J853-SD-CW-4305	5/F-25/F	標準層
29		DBP-314	2mm厚鋁板	UCT542049SC-3(淺灰)	18		18	91.58	0.94	16.896	0.72	13.030	J853-SD-CW-4305	5/F-25/F	標準層
30		DBP-1d	2mm厚鋁板	UCT542049SC-3(淺灰)	1		1	2.19	0.40	0.403	0.26	0.255	J853-SD-CW-4305	5/F	標準層雙掛碼
31		DBP-6d	2mm厚鋁板	UCT542049SC-3(淺灰)	2		2	6.44	0.59	1.187	0.42	0.844	J853-SD-CW-4306	25/F	標準層雙掛碼
32		DBP-28d	2mm厚鋁板	UCT542049SC-3(淺灰)	1		1	4.89	0.90	0.903	0.69	0.693	J853-SD-CW-4305	5/F	標準層雙掛碼
33		DBP-315d	2mm厚鋁板	UCT542049SC-3(淺灰)	1		1	7.94	1.46	1.464	1.18	1.184	J853-SD-CW-4306	25/F	標準層雙掛碼
34		DBP-5a	2mm厚鋁板	UCT542049SC-3(淺灰)	1		1	1.37	0.25	0.254	0.15	0.149	J853-SD-CW-4304	26/F	特式層
35		DBP-5a	2mm厚鋁板	UCT542049SC-3(淺灰)	1		1	1.37	0.25	0.254	0.15	0.149	J853-SD-CW-4305	26/F	特式層
36		DBP-6a	2mm厚鋁板	UCT542049SC-3(淺灰)	1		1	1.64	0.30	0.302	0.19	0.185	J853-SD-CW-4304	26/F	特式層
37		DBP-6a	2mm厚鋁板	UCT542049SC-3(淺灰)	1		1	1.64	0.30	0.302	0.19	0.185	J853-SD-CW-4305	26/F	特式層
38		DBP-6a	2mm厚鋁板	UCT542049SC-3(淺灰)	2		2	3.27	0.30	0.604	0.19	0.370	J853-SD-CW-4306	26/F	特式層
39		DBP-10a	2mm厚鋁板	UCT542049SC-3(淺灰)	2		2	3.54	0.33	0.652	0.20	0.407	J853-SD-CW-4306	26/F	特式層
40		DBP-16a	2mm厚鋁板	UCT542049SC-3(淺灰)	1		1	1.95	0.36	0.359	0.23	0.228	J853-SD-CW-4304A	26/F	特式層
41		DBP-16a	2mm厚鋁板	UCT542049SC-3(淺灰)	1		1	1.95	0.36	0.359	0.23	0.228	J853-SD-CW-4304A	26/F	特式層
42		DBP-18a	2mm厚鋁板	UCT542049SC-3(淺灰)	2		2	4.06	0.37	0.749	0.24	0.480	J853-SD-CW-4303	26/F	特式層
43	取消	DBP-25a	2mm厚鋁板	UCT542049SC-3(淺灰)	0		0	0.00	0.00	0.000	0.00	0.000	J853-SD-CW-4302	26/F	特式層
44		DBP-30a	2mm厚鋁板	UCT542049SC-3(淺灰)	1		1	2.56	0.47	0.471	0.31	0.313	J853-SD-CW-4304A	26/F	特式層
45		DBP-30a	2mm厚鋁板	UCT542049SC-3(淺灰)	1		1	2.56	0.47	0.471	0.31	0.313	J853-SD-CW-4304A	26/F	特式層
46		DBP-303a	2mm厚鋁板	UCT542049SC-3(淺灰)	1		1	3.21	0.59	0.592	0.40	0.405	J853-SD-CW-4302	26/F	特式層
47		DBP-308a	2mm厚鋁板	UCT542049SC-3(淺灰)	1		1	4.33	0.80	0.798	0.56	0.560	J853-SD-CW-4303	26/F	特式層
48		DBP-309a	2mm厚鋁板	UCT542049SC-3(淺灰)	1		1	2.46	0.45	0.453	0.30	0.300	J853-SD-CW-4304	26/F	特式層
49		DBP-310a	2mm厚鋁板	UCT542049SC-3(淺灰)	1		1	2.72	0.50	0.502	0.34	0.336	J853-SD-CW-4304	26/F	特式層
50		DBP-311a	2mm厚鋁板	UCT542049SC-3(淺灰)	1		1	3.35	0.62	0.618	0.42	0.424	J853-SD-CW-4304A	26/F	特式層
51		DBP-312a	2mm厚鋁板	UCT542049SC-3(淺灰)	1		1	3.35	0.62	0.618	0.42	0.424	J853-SD-CW-4304A	26/F	特式層
52		DBP-313a	2mm厚鋁板	UCT542049SC-3(淺灰)	1		1	2.72	0.50	0.502	0.34	0.336	J853-SD-CW-4305	26/F	特式層

		工程號:	J-853	計算:	陳敏聰	日期:	2022.04.03	送呈:							
		地盤名稱:	延坪道住宅	核對:	謝永林	日期:	2022.08.09	副本:							
廠用鋁背板B.M.表		項目類別:	T3座幕牆背板	批准:		日期:		A/C Code:							
		修改版次:	A 22.8.9	總V.F.:	280.68	總重量:	2009.48								
序號	修改內容	鋁板圖號	鋁板名稱	顏色	實用	後備	總數	總重量	單件展開面積m ²	總展開面積m ²	單件V.F.m ²	總V.F.m ²	位置	樓層	類型
53		DBP-314a	2mm厚鋁板	UCT542049SC-3(淺灰)	1		1	2.59	0.48	0.477	0.32	0.318	J853-SD-CW-4305	26/F	特式層
54		DBP-315a	2mm厚鋁板	UCT542049SC-3(淺灰)	1		1	4.04	0.74	0.745	0.52	0.520	J853-SD-CW-4306	26/F	特式層
55		DBP-316a	2mm厚鋁板	UCT542049SC-3(淺灰)	1		1	2.46	0.45	0.453	0.30	0.300	J853-SD-CW-4306	26/F	特式層
56		DBP-317a	2mm厚鋁板	UCT542049SC-3(淺灰)	1		1	5.21	0.96	0.961	0.68	0.684	J853-SD-CW-4306	26/F	特式層
57		DBP-6b	2mm厚鋁板	UCT542049SC-3(淺灰)	1		1	1.30	0.24	0.240	0.13	0.135	J853-SD-CW-4302	23/F	特式層
58		DBP-302b	2mm厚鋁板	UCT542049SC-3(淺灰)	1		1	4.21	0.78	0.777	0.51	0.507	J853-SD-CW-4301	23/F	特式層
59		DBP-304b	2mm厚鋁板	UCT542049SC-3(淺灰)	1		1	1.51	0.28	0.278	0.16	0.161	J853-SD-CW-4302	23/F	特式層
60		DBP-22	2mm厚鋁板	UCT542049SC-3(淺灰)	10		10	36.85	0.68	6.798	0.51	5.059	J853-SD-CW-4301	5/F-16/F	轉角生窗
61		DBP-22	2mm厚鋁板	UCT542049SC-3(淺灰)	6		6	22.11	0.68	4.079	0.51	3.036	J853-SD-CW-4301	17/F-22/F	轉角生窗
62		DBP-301	2mm厚鋁板	UCT542049SC-3(淺灰)	10		10	66.58	1.23	12.284	1.00	9.964	J853-SD-CW-4301	5/F-16/F	轉角梗窗
63		DBP-302	2mm厚鋁板	UCT542049SC-3(淺灰)	6		6	58.51	1.80	10.796	1.50	8.979	J853-SD-CW-4301	17/F-22/F	轉角梗窗
64		DBP-22b	2mm厚鋁板	UCT542049SC-3(淺灰)	1		1	1.49	0.27	0.274	0.16	0.161	J853-SD-CW-4301	23/F	轉角特式層
65		DBP-302b	2mm厚鋁板	UCT542049SC-3(淺灰)	1		1	3.94	0.73	0.726	0.48	0.478	J853-SD-CW-4301	23/F	轉角特式層
66	新增	DBP-6	2mm厚鋁板	UCT542049SC-3(淺灰)	1		1	2.53	0.47	0.467	0.33	0.330	J853-SD-CW-4303	5/F	標準層
67	新增	DBP-320	2mm厚鋁板	UCT542049SC-3(淺灰)	1		1	5.05	0.93	0.931	0.74	0.736	J853-SD-CW-4303	5/F	標準層
68	新增	DBP-321	2mm厚鋁板	UCT542049SC-3(淺灰)	1		1	3.76	0.69	0.693	0.53	0.528	J853-SD-CW-4303	5/F	標準層
69	新增	DBP-25x	2mm厚鋁板	UCT542049SC-3(淺灰)	18		18	103.60	1.06	19.114	0.85	15.311	J853-SD-CW-4302	5/F-25/F	標準層
70	新增	DBP-25a	2mm厚鋁板	UCT542049SC-3(淺灰)	1		1	2.93	0.54	0.540	0.37	0.374	J853-SD-CW-4302	26/F	特式層
統計:							456	2009.48		370.75		280.68			




美特鋁質有限公司
MIDI Aluminium Fabricator Ltd.

數據參考圖號: DBP-01-SJ

工程號 J-853 地盤 延坪道住宅

依據E14933避地臺碼位

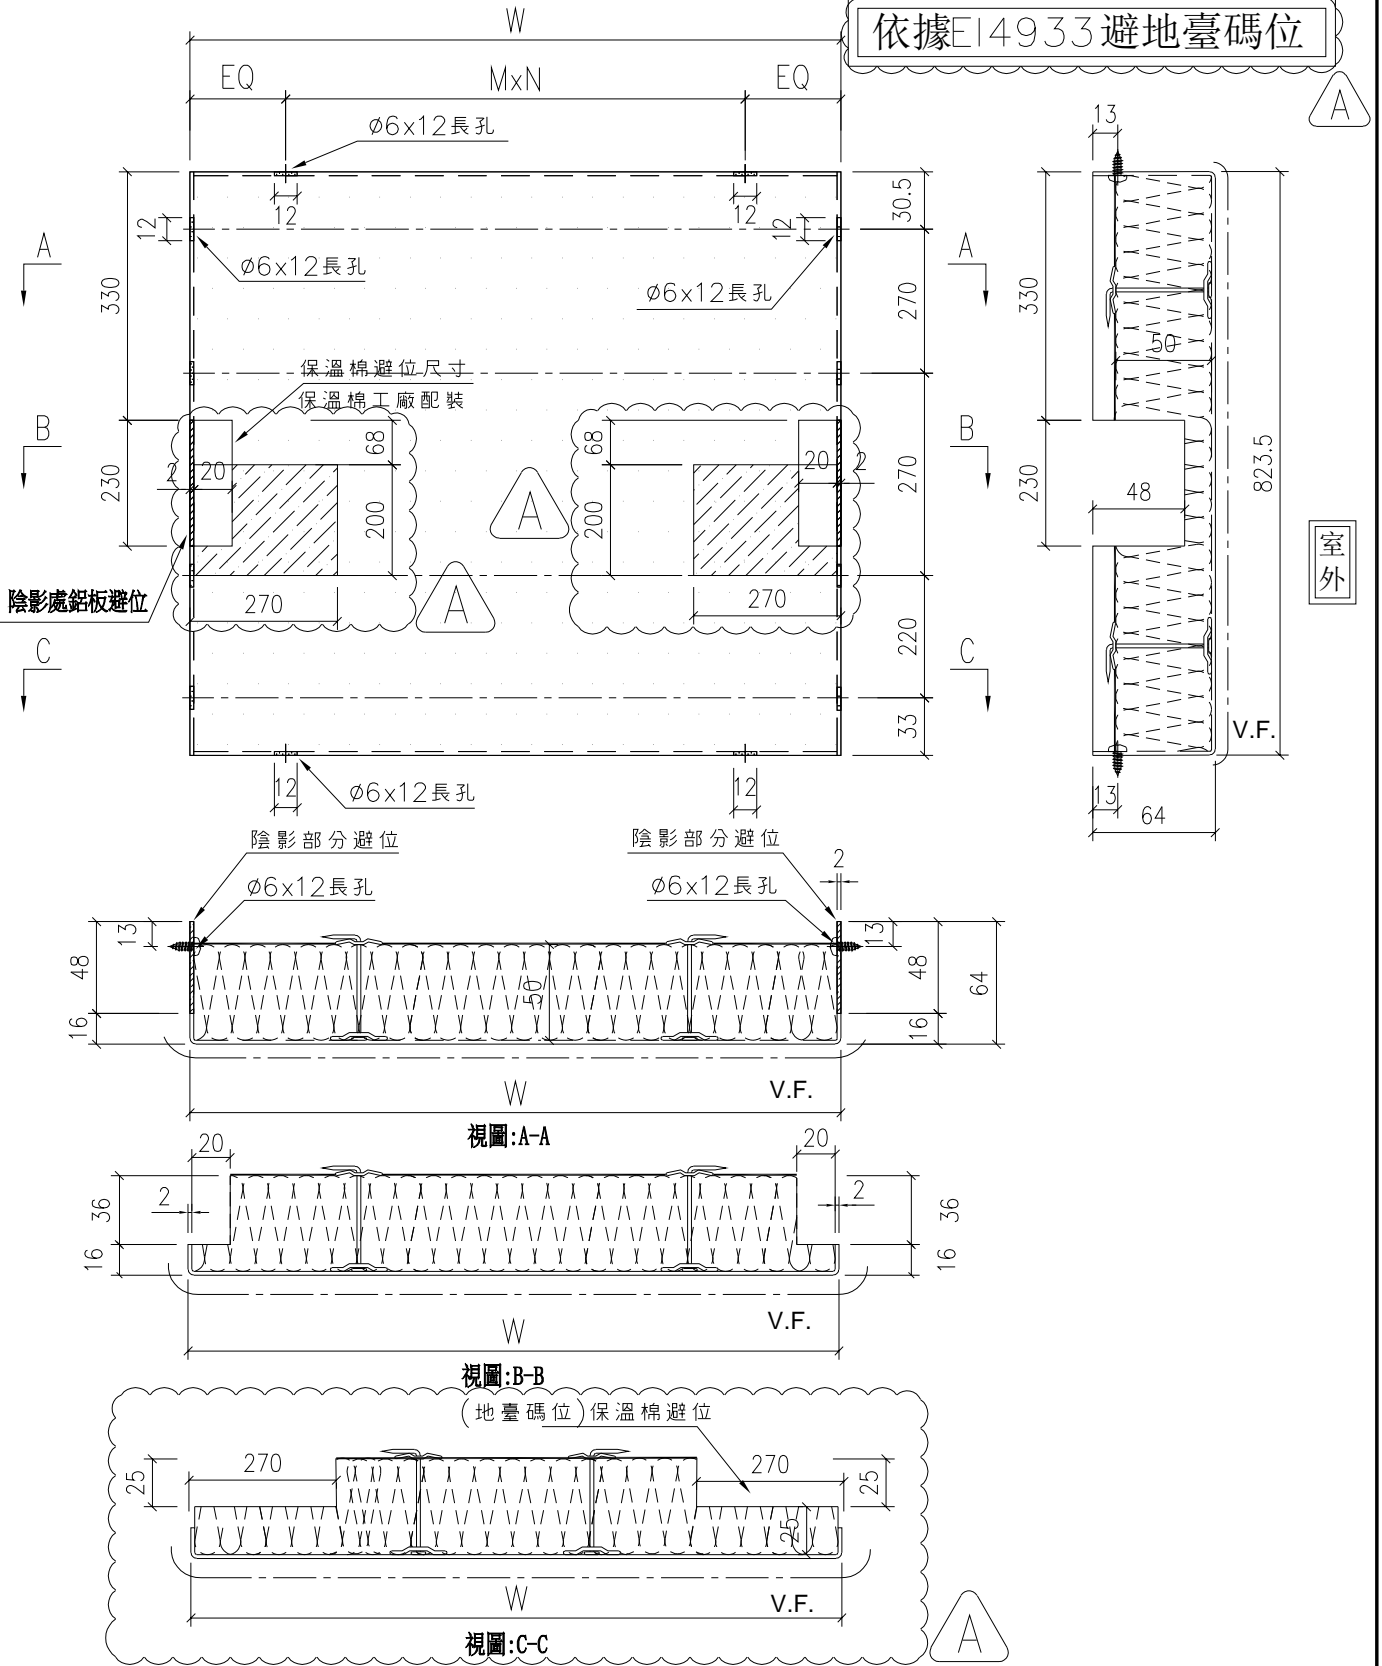

室外

名稱	背板拆圖	制圖	陳敏聰	2022.04.03	修改	A	
材料	2mm鋁板	復核	謝永林	2022.04.10	日期	2022.08.09	
顏色	UCT542049SC-3(淺灰)	批准	Daniel		圖號	DBP-01	



美特鋁質有限公司
MIDI Aluminium Fabricator Ltd.

依據E14439A修改分格尺寸



工程號 J-853 地盤 延坪道住宅

序號	物料編號	W	數量	EQ	M	X	N	位置	分格尺寸	樓層	樓層數	每層數量	備註
1	DBP-1	296	8	48.0	200	x	1	J853-SD-CW-4305	400	6/F-15/F	8	1	
2	DBP-5	396	18	48.0	300	x	1	J853-SD-CW-4304	500	5/F-25/F	18	1	
3		396	18	48.0	300	x	1	J853-SD-CW-4305	500	5/F-25/F	18	1	
4		496	6	98.0	300	x	1	J853-SD-CW-4301	600	17/F-22/F	6	1	
5	DBP-6	496	16	98.0	300	x	1	J853-SD-CW-4302	600	5/F-22/F	16	1	
6		496	10	98.0	300	x	1	J853-SD-CW-4303	600	5/F-16/F	10	1	
7		496	1	98.0	300	x	1	J853-SD-CW-4303	600	5/F	1	1	原612.5改600
8		496	18	98.0	300	x	1	J853-SD-CW-4304	600	5/F-25/F	18	1	
9		496	18	98.0	300	x	1	J853-SD-CW-4305	600	5/F-25/F	18	1	
10		DBP-7	508.5	9	104.3	300	x	1	J853-SD-CW-4303	612.5	6/F-16/F	9	1
11	508.5		7	104.3	300	x	1	J853-SD-CW-4303	612.5	17/F-23/F	7	1	
12	DBP-16	613.5	18	56.8	250	x	2	J853-SD-CW-4304A	717.5	5/F-25/F	18	1	
13		613.5	18	56.8	250	x	2	J853-SD-CW-4304A	717.5	5/F-25/F	18	1	
14	DBP-18	646	2	73.0	250	x	2	J853-SD-CW-4303	750	25/F	1	2	
15	DBP-25x	1121	18	110.5	300	x	3	J853-SD-CW-4302	1225	5/F-25/F	18	1	原1250改1225
16	DBP-28	821	8	110.5	300	x	2	J853-SD-CW-4305	925	6/F-15/F	8	1	
17	DBP-30	846	18	123.0	300	x	2	J853-SD-CW-4304A	950	5/F-25/F	18	1	
18		846	18	123.0	300	x	2	J853-SD-CW-4304A	950	5/F-25/F	18	1	
19	DBP-303	1096	8	98.0	300.0	x	3	J853-SD-CW-4302	1200	17/F-25/F	8	1	
20	DBP-304	596	16	48.0	250	x	2	J853-SD-CW-4302	700	5/F-22/F	16	1	
21	DBP-305	1096	8	98.0	300	x	3	J853-SD-CW-4303	1200	6/F-15/F	8	1	取消一個
22	DBP-306	608.5	9	54.3	250	x	2	J853-SD-CW-4303	712.5	6/F-16/F	9	1	取消一個
23	DBP-307	1208.5	7	104.3	250	x	4	J853-SD-CW-4303	1312.5	17/F-23/F	7	1	
24	DBP-308	1521	1	135.5	250	x	5	J853-SD-CW-4303	1625	25/F	1	1	
25	DBP-309	808.5	18	104.3	300	x	2	J853-SD-CW-4304	912.5	5/F-25/F	18	1	
26	DBP-310	908.5	18	79.3	250	x	3	J853-SD-CW-4304	1012.5	5/F-25/F	18	1	
27	DBP-311	1148.5	18	124.3	300	x	3	J853-SD-CW-4304A	1252.5	5/F-25/F	18	1	
28	DBP-312	1148.5	18	124.3	300	x	3	J853-SD-CW-4304A	1252.5	5/F-25/F	18	1	
29	DBP-313	908.5	18	79.3	250	x	3	J853-SD-CW-4305	1012.5	5/F-25/F	18	1	
30	DBP-314	858.5	18	129.3	300	x	2	J853-SD-CW-4305	962.5	5/F-25/F	18	1	
31	DBP-320	983.5	1	116.8	250	x	3	J853-SD-CW-4303	1087.5	5/F	1	1	原1200改1087.5
32	DBP-321	733.5	1	116.8	250	x	2	J853-SD-CW-4303	837.5	5/F	1	1	原712.5改837.5
總數：			388										




名稱	背板拆圖數據表	制圖	陳敏聰	2022.04.03	修改	A	
材料	2mm鋁板	復核	謝永林	2022.04.10	日期	2022.08.09	
顏色	UCT542049SC-3(淺灰)	批准	Daniel		圖號	DBP-01-SJ	



工程號 J-853 地盤 延坪道住宅

依據E14933避地臺碼位

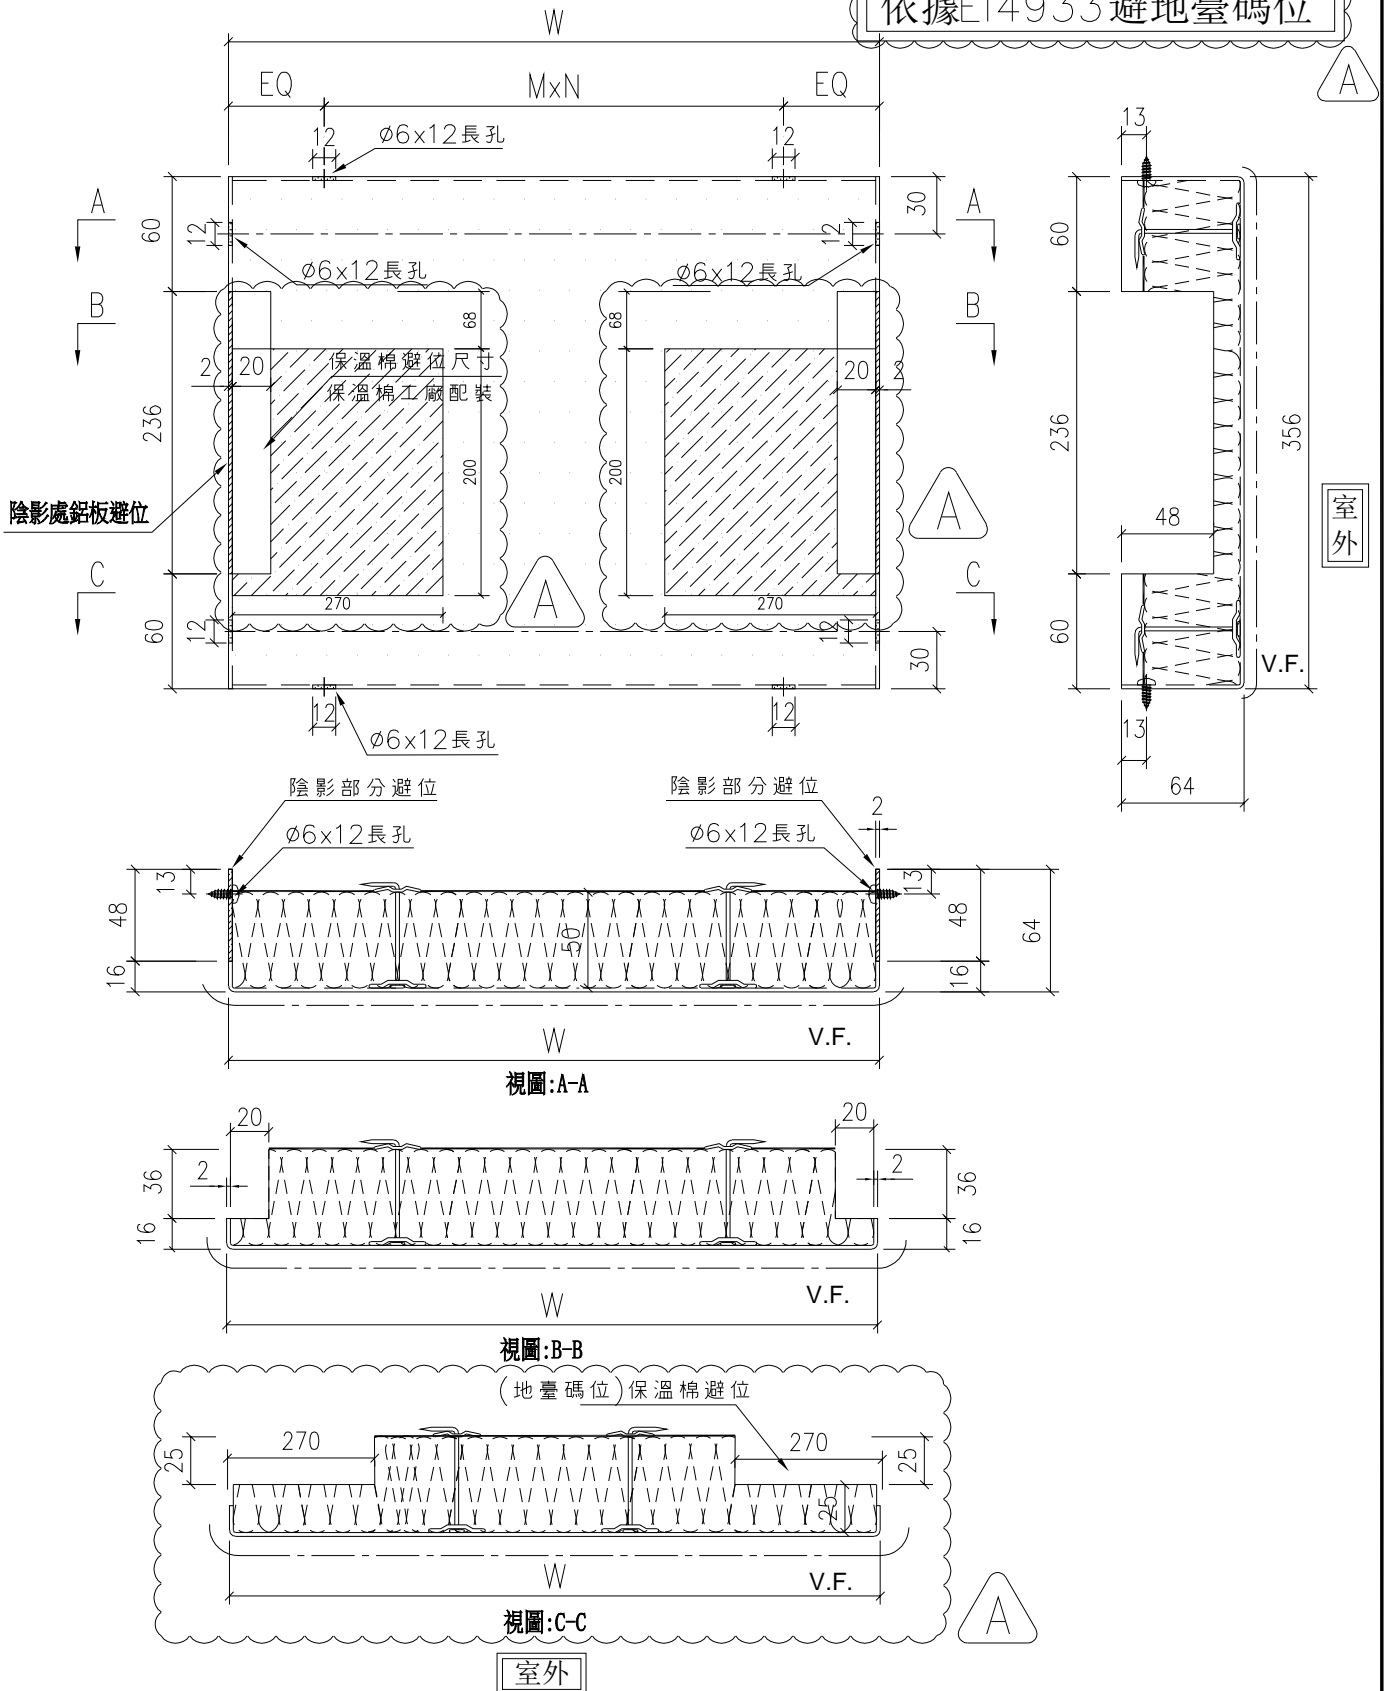

名稱	背板拆圖	制圖	陳敏聰	2022.04.03	修改	A	
材料	2mm鋁板	復核	謝永林	2022.04.10	日期	2022.08.09	
顏色	UCT542049SC-3(淺灰)	批准	Daniel		圖號	DBP-05a	



工程號 J-853 地盤 延坪道住宅

序號	物料編號	W	數量	EQ	M	X	N	位置	分格尺寸	樓層	樓層數	每層數量	備註
1	DBP-5a	396	1	48.0	300	x	1	J853-SD-CW-4304	500	26/F	1	1	
2		396	1	48.0	300	x	1	J853-SD-CW-4305	500	26/F	1	1	
3	DBP-6a	496	1	98.0	300	x	1	J853-SD-CW-4304	600	26/F	1	1	
4		496	1	98.0	300	x	1	J853-SD-CW-4305	600	26/F	1	1	
5		496	2	98.0	300	x	1	J853-SD-CW-4306	600	26/F	1	2	
6	DBP-10a	546	2	123.0	300	x	1	J853-SD-CW-4306	650	26/F	1	2	
7	DBP-16a	613.5	1	56.8	250	x	2	J853-SD-CW-4304A	717.5	26/F	1	1	
8		613.5	1	56.8	250	x	2	J853-SD-CW-4304A	717.5	26/F	1	1	
9	DBP-18a	646	2	73.0	250	x	2	J853-SD-CW-4303	750	26/F	1	2	
10	DBP-25a	1121	1	110.5	300	x	3	J853-SD-CW-4302	1225	26/F	1	1	原1250改1225
11	DBP-30a	846	1	123.0	300	x	2	J853-SD-CW-4304A	950	26/F	1	1	
12		846	1	123.0	300	x	2	J853-SD-CW-4304A	950	26/F	1	1	
13	DBP-303a	1096	1	98.0	300	x	3	J853-SD-CW-4302	1200	26/F	1	1	
14	DBP-308a	1521	1	135.5	250	x	5	J853-SD-CW-4303	1625	26/F	1	1	
15	DBP-309a	808.5	1	104.3	300	x	2	J853-SD-CW-4304	912.5	26/F	1	1	
16	DBP-310a	908.5	1	79.3	250	x	3	J853-SD-CW-4304	1012.5	26/F	1	1	
17	DBP-311a	1148.5	1	124.3	300	x	3	J853-SD-CW-4304A	1252.5	26/F	1	1	
18	DBP-312a	1148.5	1	124.3	300	x	3	J853-SD-CW-4304A	1252.5	26/F	1	1	
19	DBP-313a	908.5	1	79.3	250	x	3	J853-SD-CW-4305	1012.5	26/F	1	1	
20	DBP-314a	858.5	1	129.3	300	x	2	J853-SD-CW-4305	962.5	26/F	1	1	
21	DBP-315a	1411	1	105.5	300	x	4	J853-SD-CW-4306	1515	26/F	1	1	
22	DBP-316a	808.5	1	104.3	300	x	2	J853-SD-CW-4306	912.5	26/F	1	1	
23	DBP-317a	1858.5	1	54.3	250	x	7	J853-SD-CW-4306	1962.5	26/F	1	1	
		總數：	26										

名稱	背板拆圖數據表	制圖	陳敏聰	2022.04.03	修改	A		
材料	2mm鋁板	復核	謝永林	2022.04.10	日期	2022.08.09		
顏色	UCT542049SC-3(淺灰)	批准	Daniel		圖號	DBP-05a-SJ		




美特鋁質有限公司
MIDI Aluminium Fabricator Ltd.

依據E14933避地臺碼位



工程號 J-853 地盤 延坪道住宅

序號	物料編號	W	數量	EQ	M	X	N	位置	分格尺寸	樓層	樓層數	每層數量	備註
1	DBP-6b	496	1	98.0	300	x	1	J853-SD-CW-4301	600	23/F	1	1	
2		496	1	98.0	300	x	1	J853-SD-CW-4302	600	23/F	1	1	
3	DBP-304b	596	1	48.0	250	x	2	J853-SD-CW-4302	700	23/F	1	1	
		總數:	3										

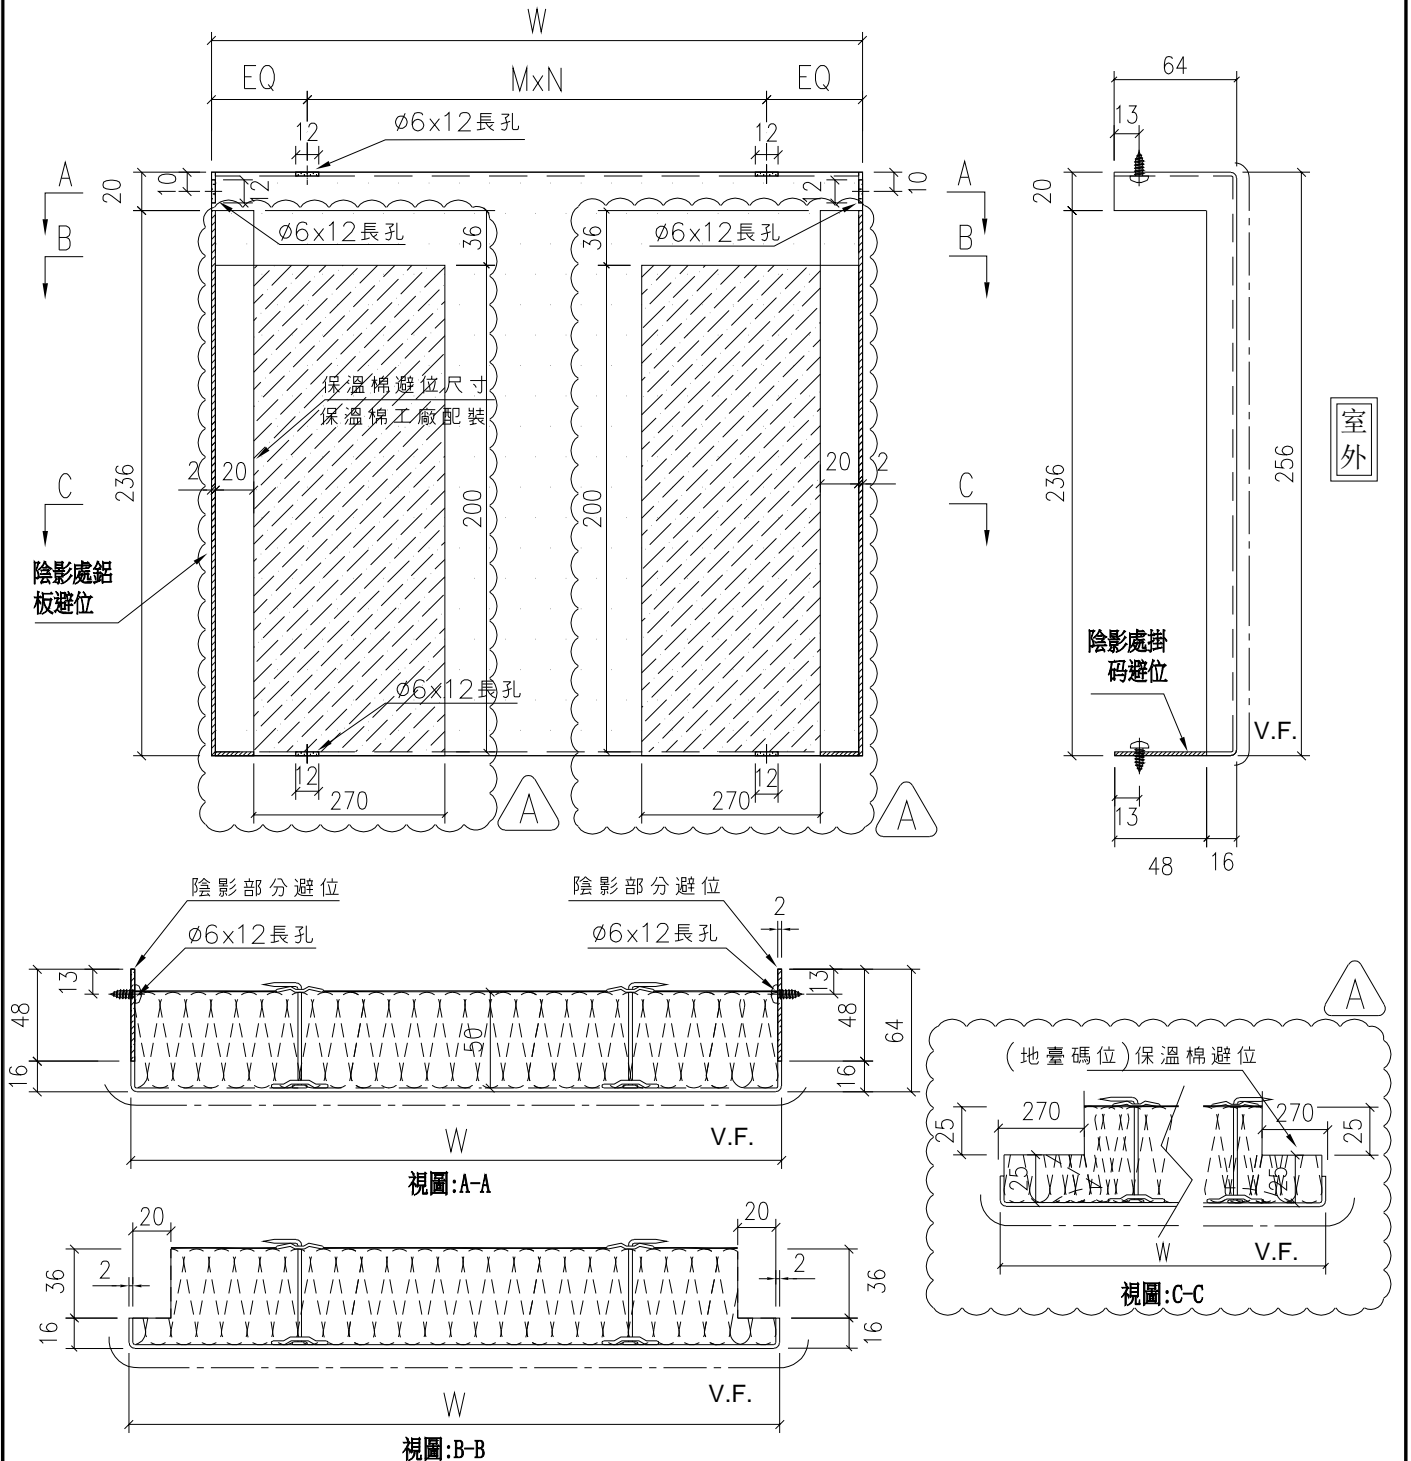

室外

名稱	背板拆圖	制圖	陳敏聰	2022.04.03	修改	A	
材料	2mm鋁板	復核	謝永林	2022.04.10	日期	2022.08.09	
顏色	UCT542049SC-3(淺灰)	批准	Daniel		圖號	DBP-06b	




美特鋁質有限公司
MIDI Aluminium Fabricator Ltd.

依據E14933避地臺碼位



工程號 J-853 地盤 延坪道住宅

序號	物料編號	W	數量	EQ	M	X	N	位置	分格尺寸	樓層	樓層數	每層數量	備註
1	DBP-301	1185.5	10	142.8	300	x	3	J853-SD-CW-4301	1400	5/F-16/F	10	1	
2	DBP-302	1785.5	6	142.8	300	x	5	J853-SD-CW-4301	2000	17/F-22/F	6	1	
		總數:	16										

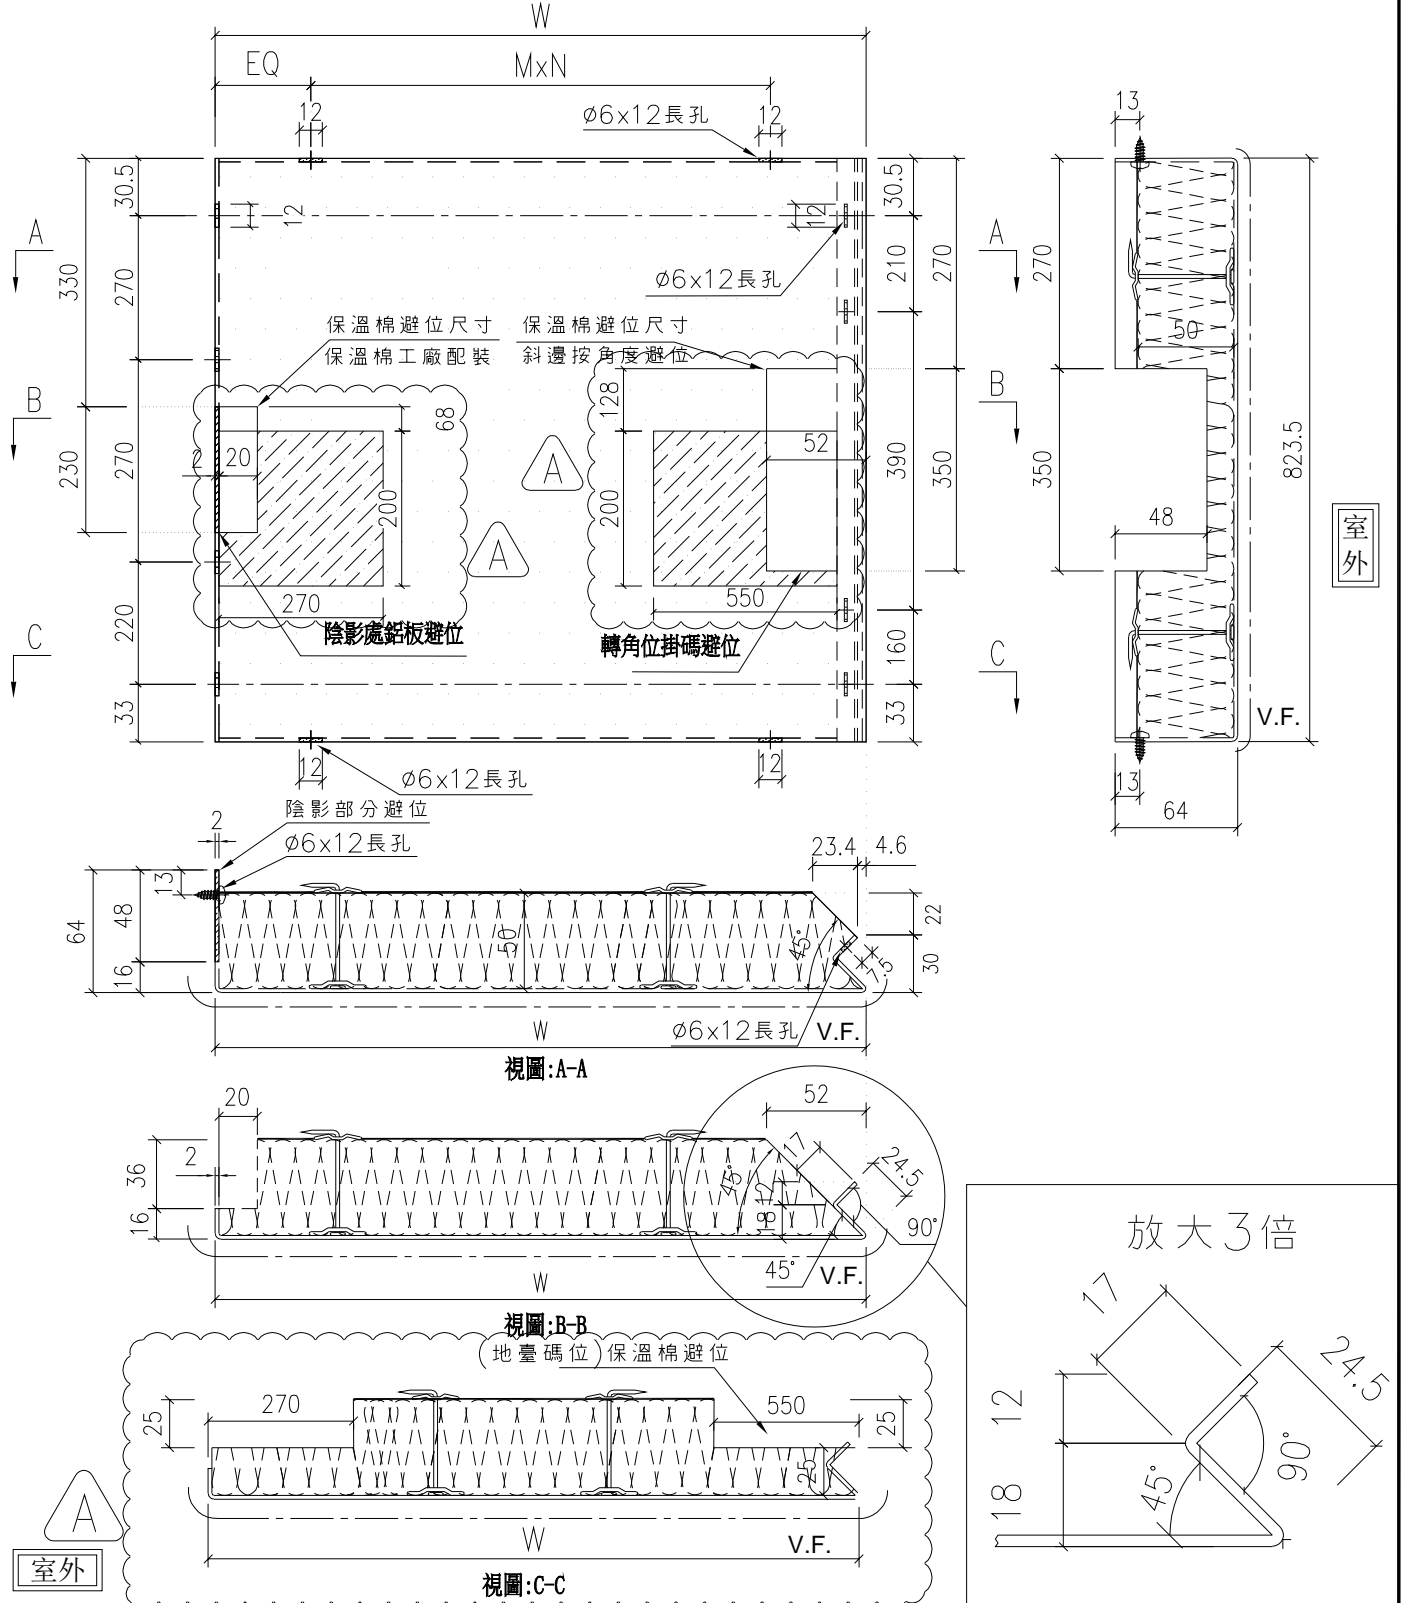

名稱	轉角梗窗背板拆圖	制圖	陳敏聰	2022.04.03	修改	A	
材料	2mm鋁板	復核	謝永林	2022.04.10	日期	2022.08.09	
顏色	UCT542049SC-3(淺灰)	批准	Daniel		圖號	DBP-301	








美特鋁質有限公司
MIDI Aluminium Fabricator Ltd.

依據E14933避地臺碼位



工程號 J-853 地盤 延坪道住宅

序號	物料編號	W	數量	EQ	M	X	N	位置	分格尺寸	樓層	樓層數	每層數量	備註
1	DBP-302b	1785.5	1	142.8	300	x	5	J853-SD-CW-4301	2000	23/F	1	1	

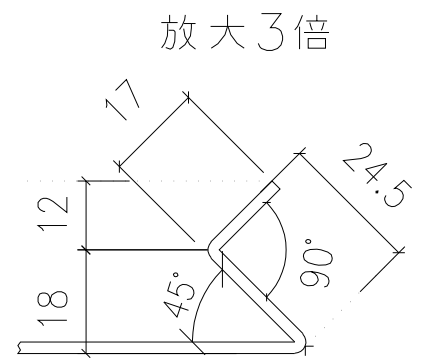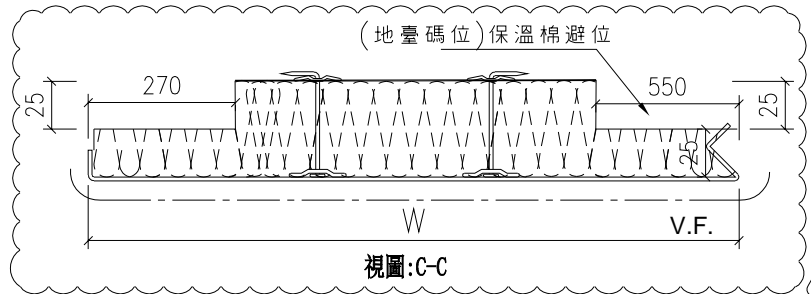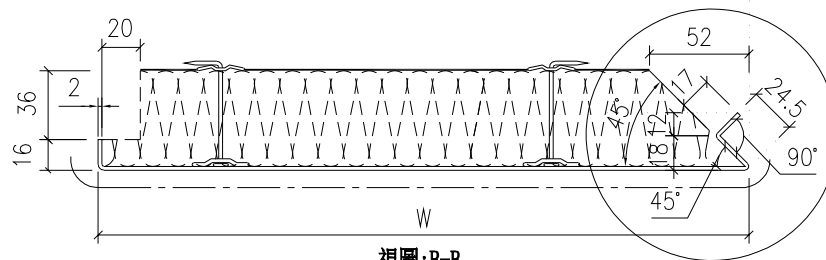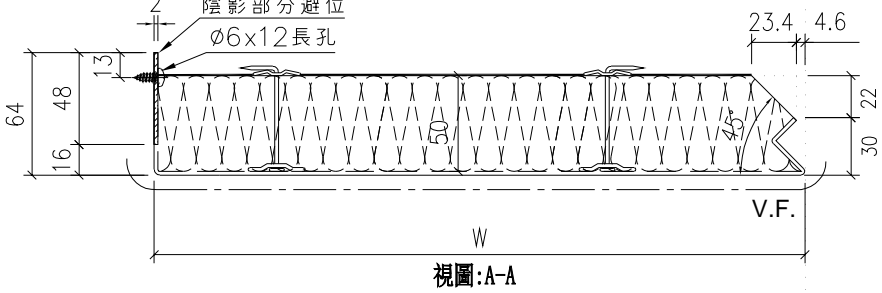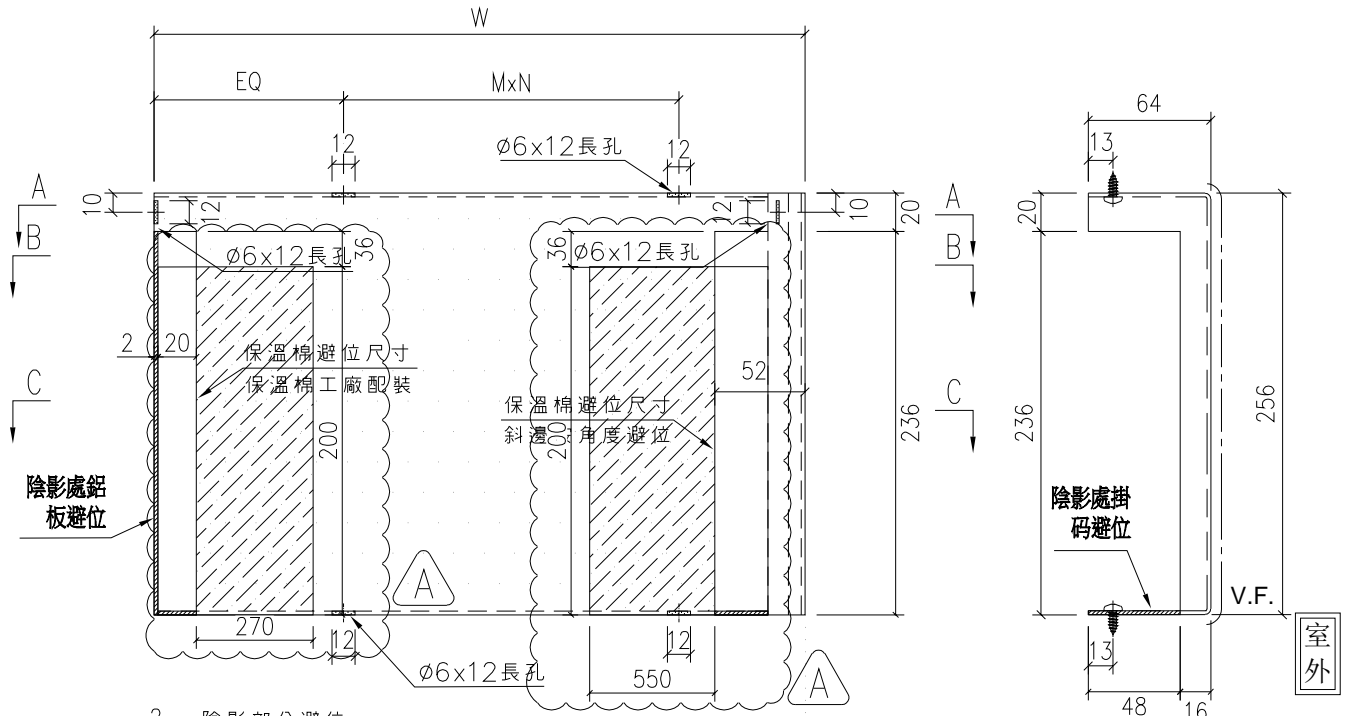

室外

名稱	轉角生窗背板拆圖	制圖	陳敏聰	2022.04.03	修改	A	
材料	2mm鋁板	復核	謝永林	2022.04.10	日期	2022.08.09	
顏色	UCT542049SC-3(淺灰)	批准	Daniel		圖號	DBP-302b	








美特鋁質有限公司
MIDI Aluminium Fabricator Ltd.

依據E14933避地臺碼位



工程號	J-853	地盤	延坪道住宅
-----	-------	----	-------

序號	物料編號	W	數量	EQ	M	X	N	位置	分格尺寸	樓層	樓層數	每層數量	備註
1	DBP-22b	597	1	48.5	250	x	2	J853-SD-CW-4301	815	23/F	1	1	

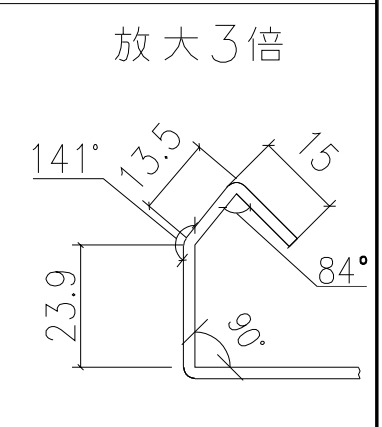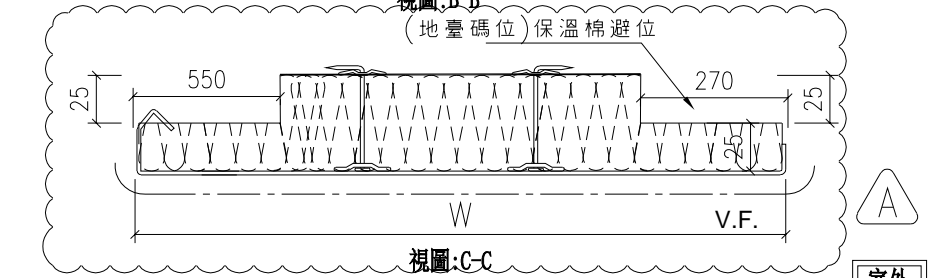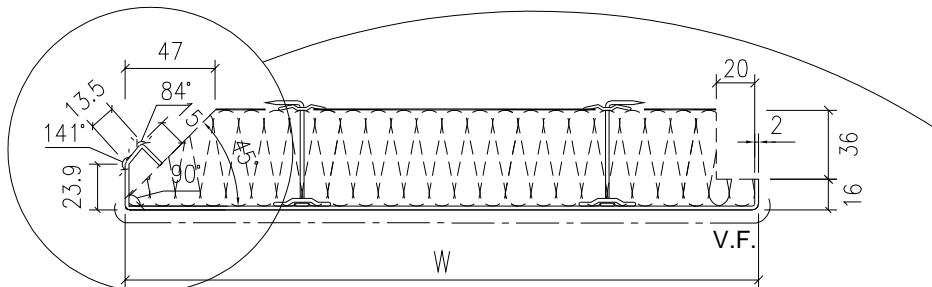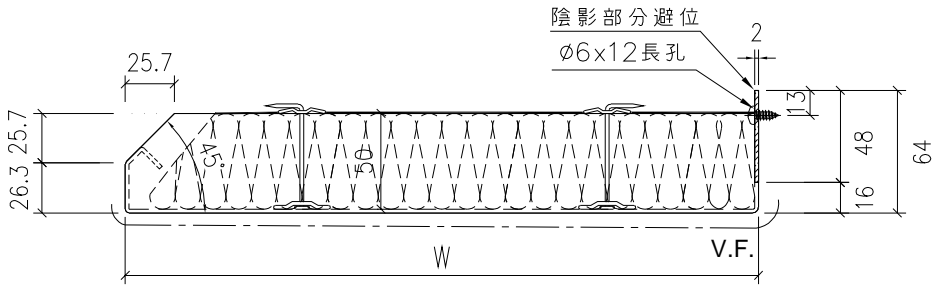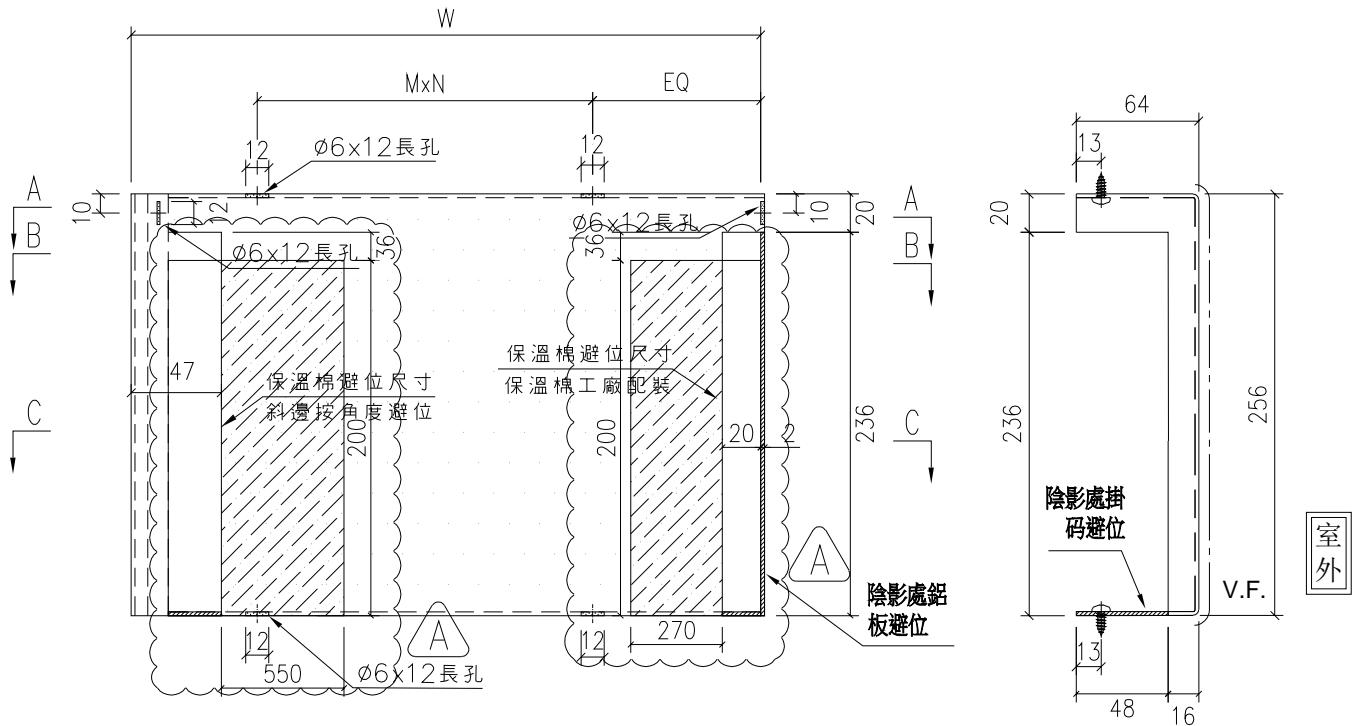

名稱	轉角梗窗背板拆圖	制圖	陳敏聰	2022.04.03	修改	A	
材料	2mm鋁板	復核	謝永林	2022.04.10	日期	2022.08.09	
顏色	UCT542049SC-3(淺灰)	批准	Daniel		圖號	DBP-22b	

請用A3紙打印

B.D. REF :

CLIENT :
SHIMAO GROUP HOLDINGS LIMITED

ARCHITECT :
WONG TUNG & PARTNERS LIMITED
ARCHITECTS & PLANNERS



MAIN CONTRACTOR :
協興建築有限公司
HIP HING CONSTRUCTION CO LTD

STRUCTURAL ENGINEER :
CMA
C M WONG & ASSOCIATES LTD
黃志明建築工程師有限公司

FAÇADE CONSULTANT:
MEINHARDT


NOTE:
1. ALL DIMENSIONS ARE IN mm.
2. ALL ELEVATIONS ARE VIEWED FROM OUTSIDE.
3. ALL DIMENSIONS TO BE VERIFIED ON SITE BEFORE FABRICATION.

LEGEND:
 (X1) DETAIL MARK NO.
 (X00) REFER SHEET NO.
 1. F.F.L. --- FINISHED FLOOR LEVEL
 2. S.F.L. --- STRUCTURAL FLOOR LEVEL
 3. (R) --- REVERSED DETAIL

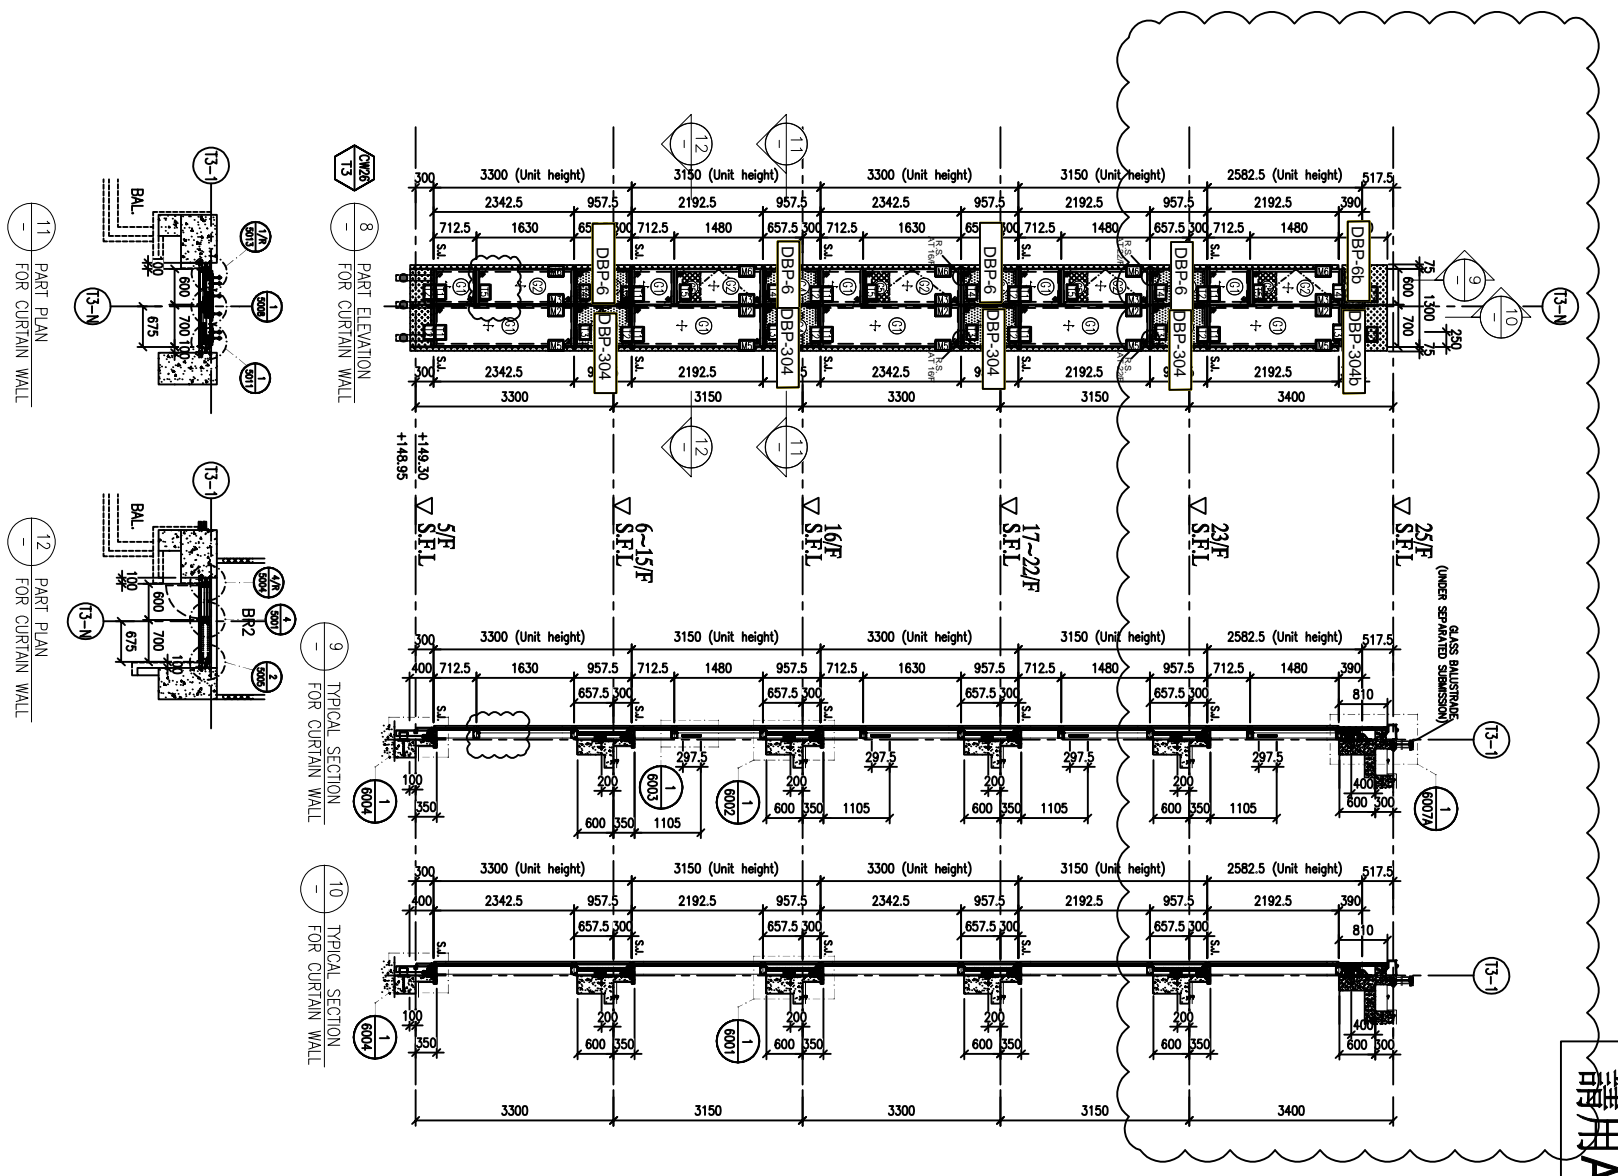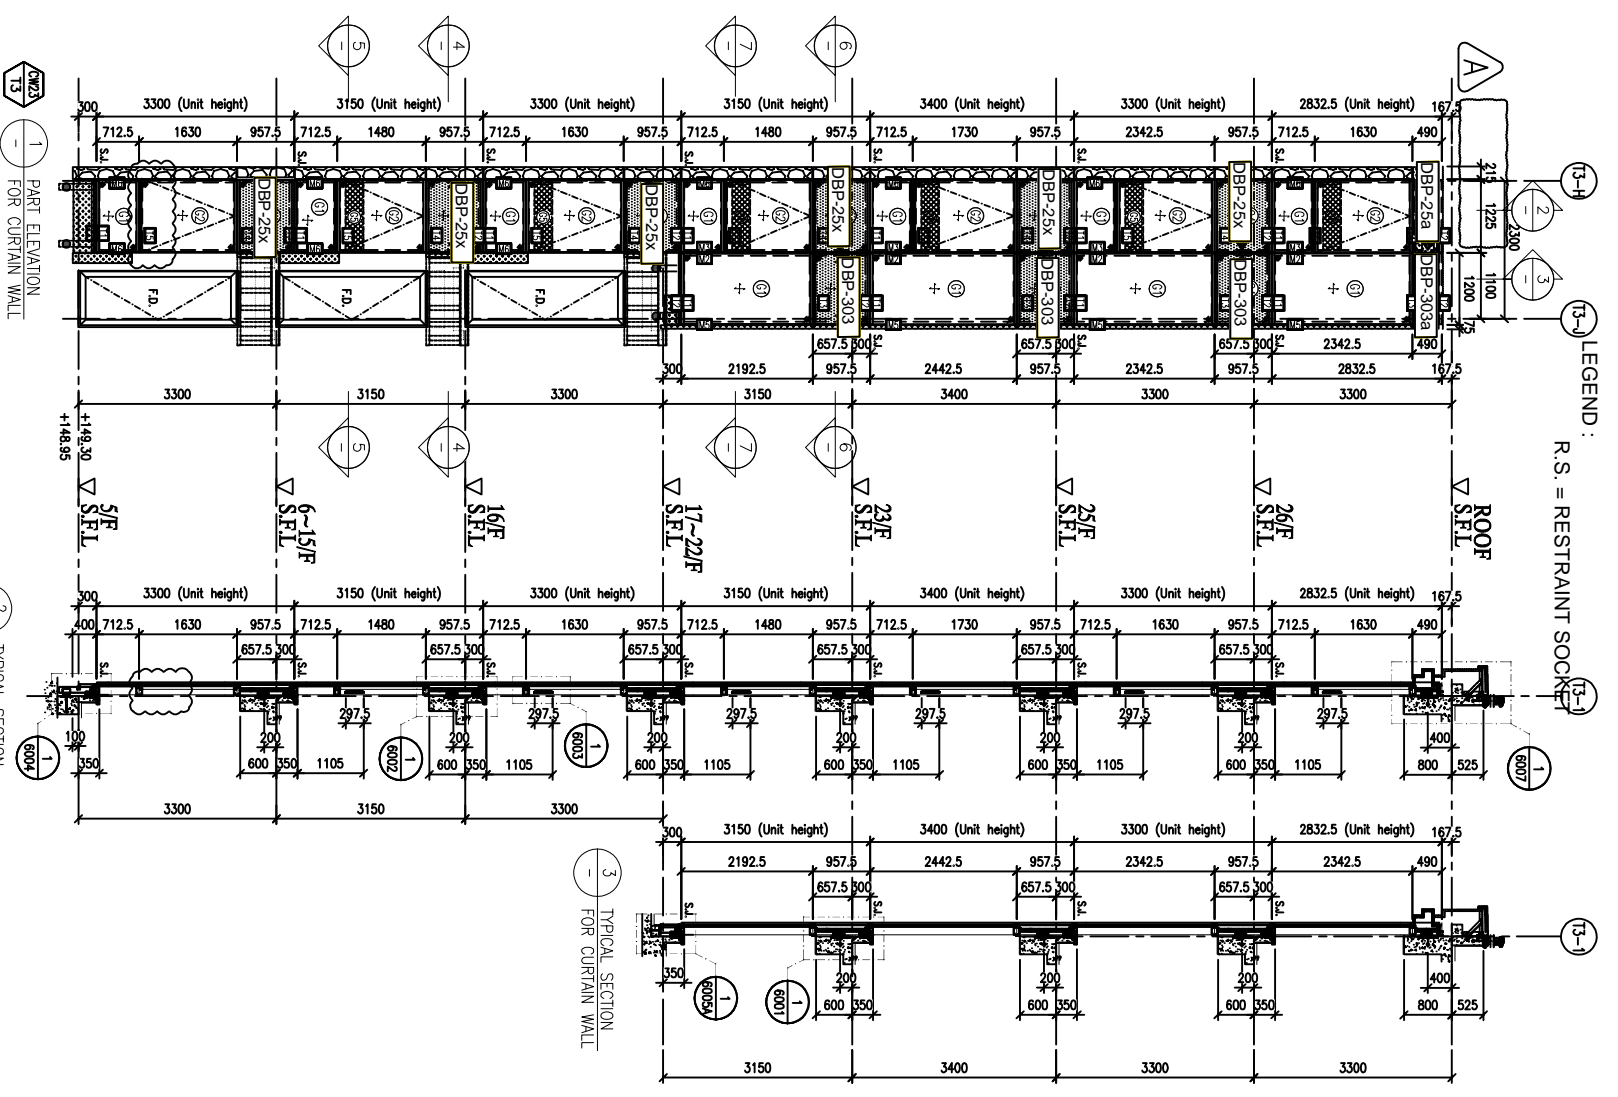

12 FLOOR LEVEL (S.F.L.)

FLOOR	LEVEL
R/F	+210.00
26/F	+208.70
25/F	+203.40
23/F	+200.00
22/F	+198.85
20/F	+193.55
19/F	+190.55
18/F	+187.40
17/F	+181.10
16/F	+177.80
15/F	+174.65
12/F	+171.50
10/F	+168.35
9/F	+165.20
8/F	+162.05
7/F	+158.90
6/F	+152.60
5/F	+149.30

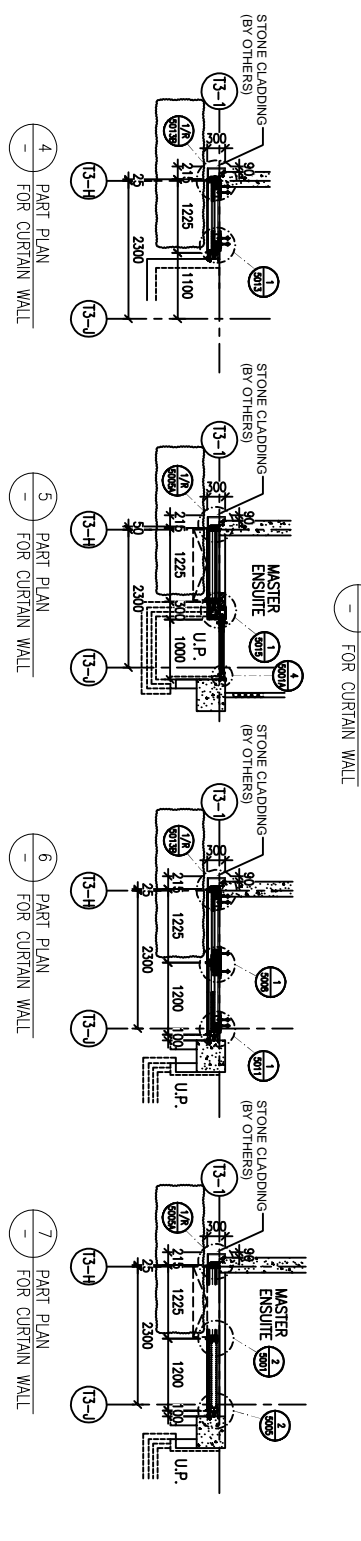

LEGEND:

- (X1) 10mm HEAT STRENGTHENED GLASS (OUTER)
- (X2) 10mm HEAT STRENGTHENED GLASS (INNER)
- (X3) 10mm HEAT STRENGTHENED GLASS (OUTER) & 12mm AIR SPACE (INNER)
- (X4) 12mm THK. CLEAR TEMPERED GLASS (INNER)
- (X5) 12mm THK. HEAT STRENGTHENED GLASS & 2mm THK. ALUM. BACKSPAN (SPANDREL GLASS) (INTERNAL PROTECTIVE BARRIER)
- (X6) 3mm THK. ALUM. CLADDING
- (X7) S.L. --- STACK JOINT (WIND LOAD)
- (X8) ALUM. EXTRUSION DIE NO.
- (X9) SUPPORT POINT (WIND LOAD + DEAD LOAD)
- (X0) SUPPORT POINT (WIND LOAD)

JOB NO. : J-853

PROJECT : PROPOSED RESIDENTIAL DEVELOPMENT AT N.K.I.L. 6542 YIN PING ROAD KOWLOON

TITLE : PART ELEVATION FOR CURTAIN WALL AT TOWER 3


DATE : 26-MAR-21 SCALE : 1:60 (A1)

DRAWN BY : LHR CHECKED BY :

Units 6-8, Sunny Industrial Centre, 7/F
 810 Chee Kwo Ling Road, Kowloon
 Tel: 23489271-4 Fax: (852) 27270666

DMG NO. : JB53-SB-CW-4302 REV. : A

LEGEND :
R.S. = RESTRAINT SOCKET

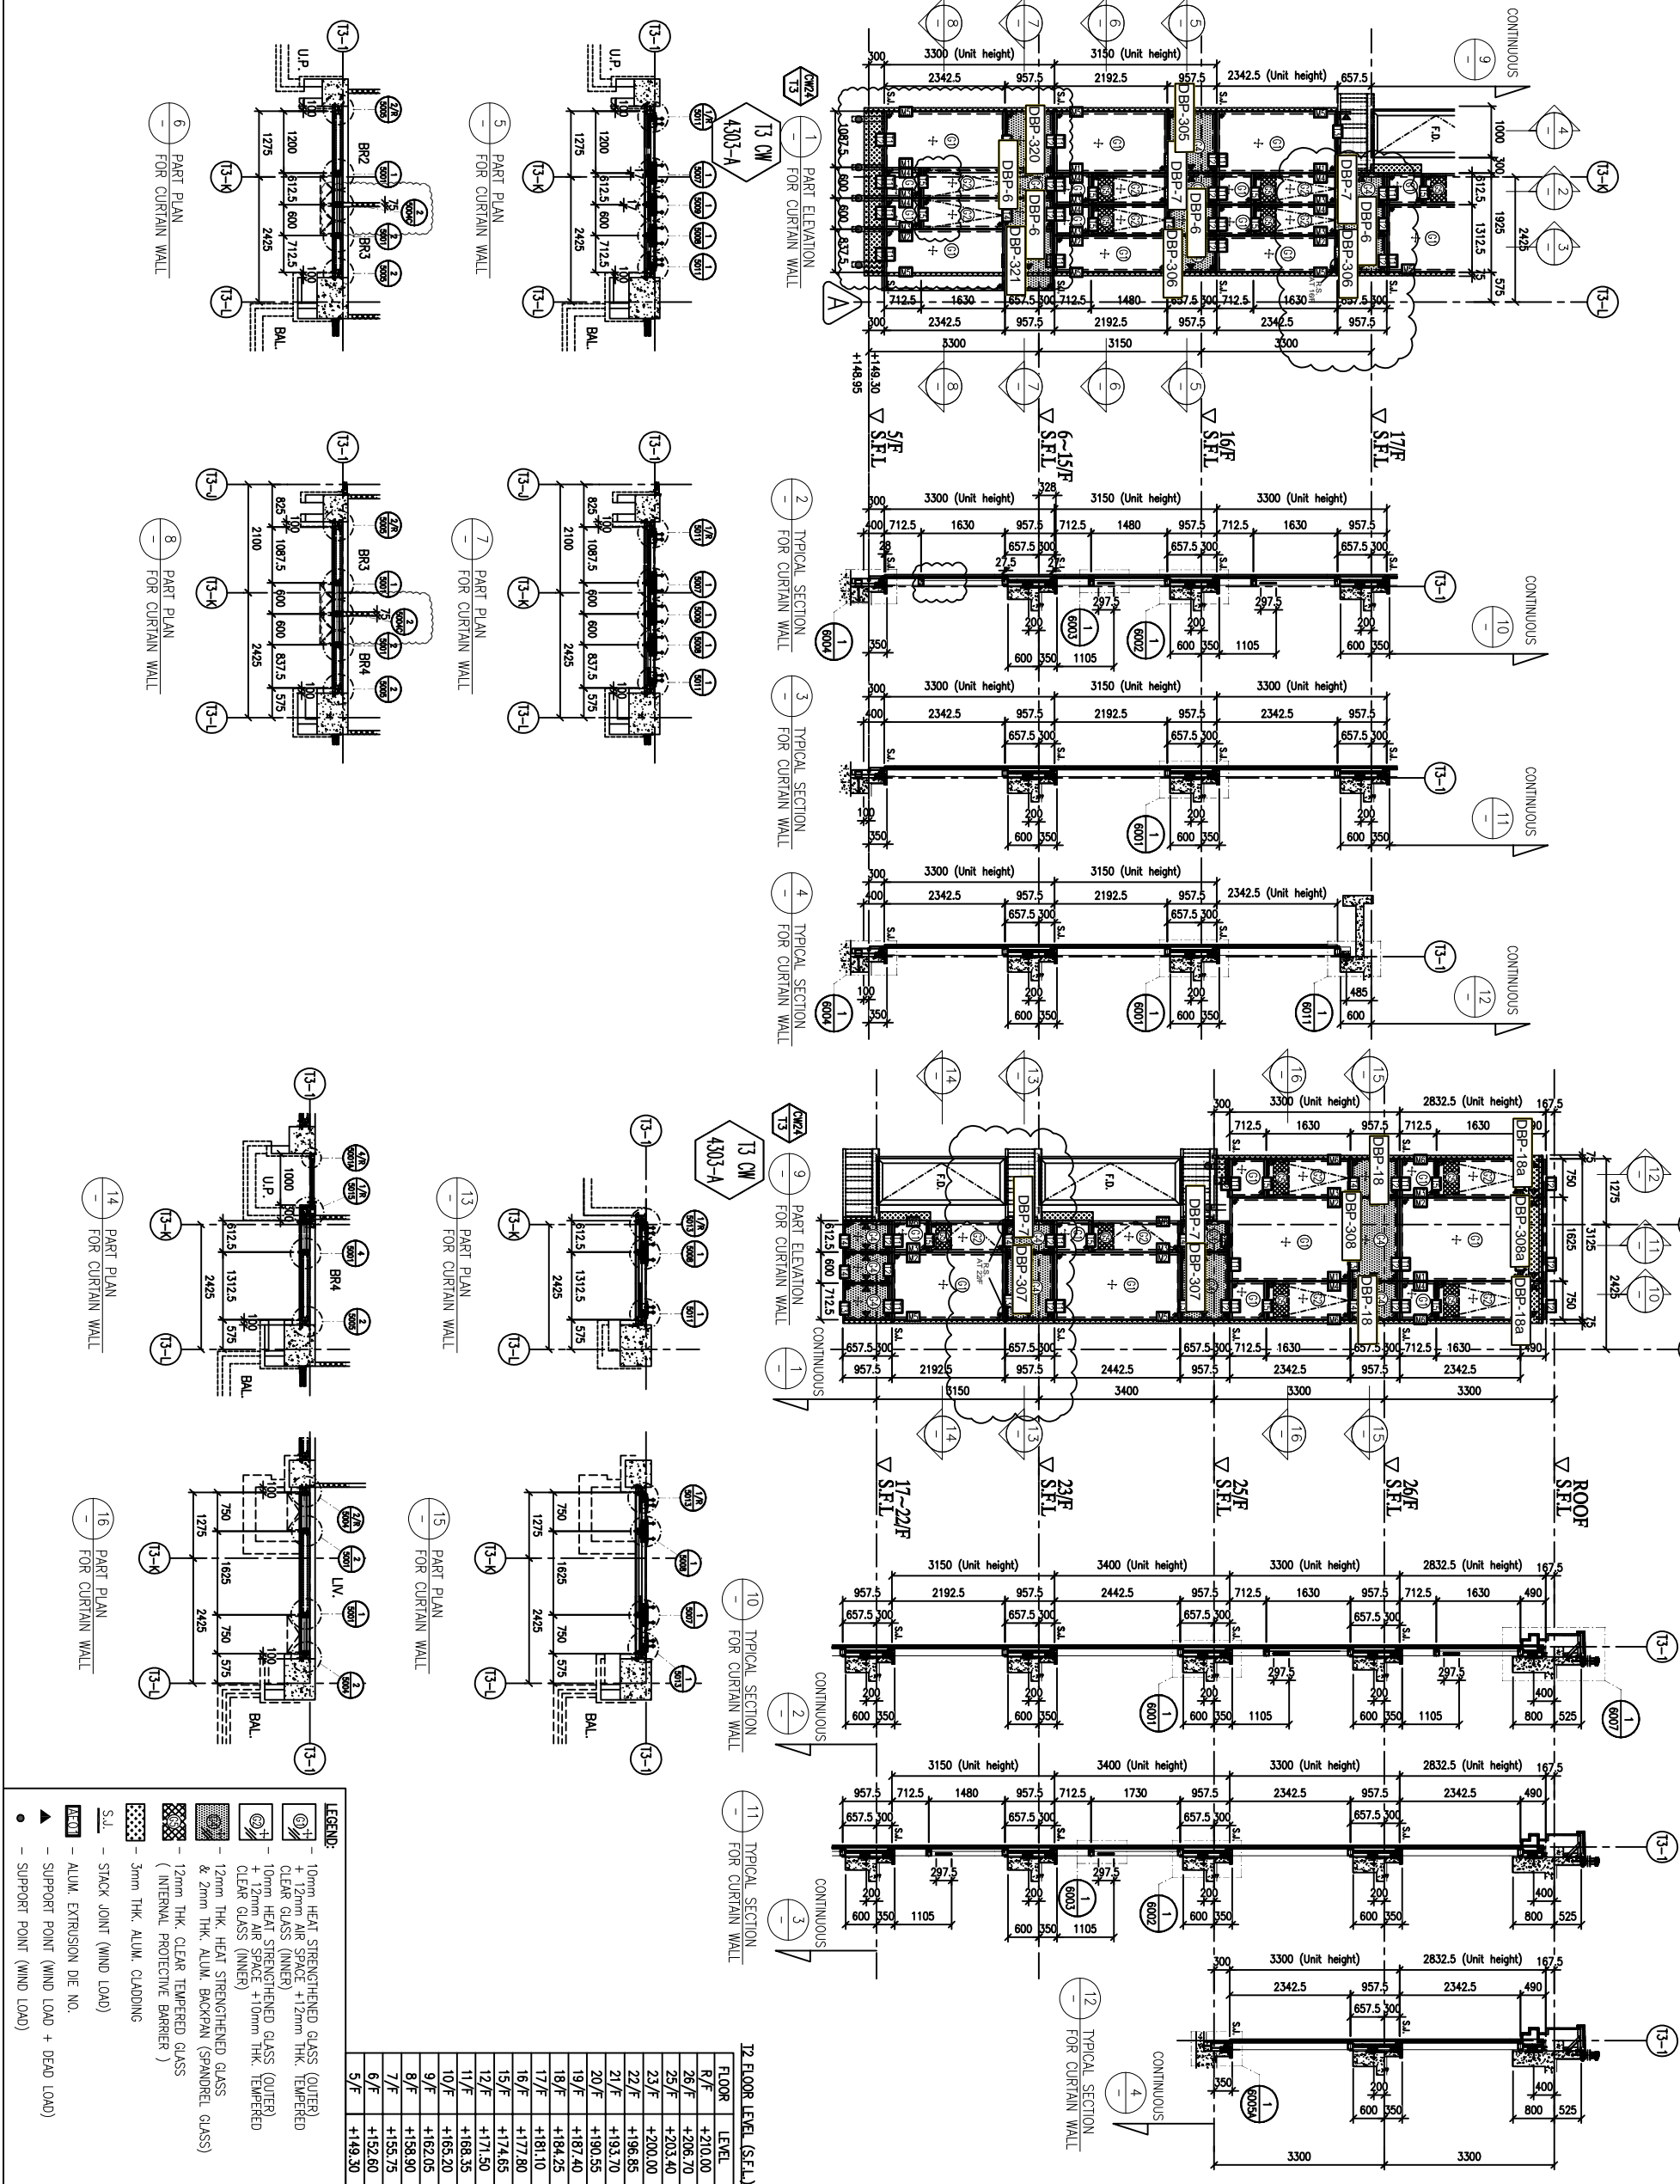

12 FLOOR LEVEL (S.F.L.)

FLOOR	LEVEL
R/F	+210.00
26/F	+208.70
25/F	+203.40
23/F	+200.00
22/F	+198.85
20/F	+193.70
19/F	+187.40
18/F	+184.25
17/F	+181.10
16/F	+177.80
15/F	+174.65
12/F	+171.50
11/F	+168.35
10/F	+165.20
9/F	+162.05
8/F	+158.90
7/F	+155.75
6/F	+152.60
5/F	+149.30

CLIENT : SHIMAO GROUP HOLDINGS LIMITED

ARCHITECT : WONG TUNG & PARTNERS LIMITED

MAIN CONTRACTOR : 協興建築有限公司
HIP HING CONSTRUCTION CO LTD

STRUCTURAL ENGINEER : C M WONG & ASSOCIATES LTD
黃志明建築工程師有限公司

FAÇADE CONSULTANT : MENHARDT

NOTE :
1. ALL DIMENSIONS ARE IN mm.
2. ALL ELEVATIONS ARE VIEWED FROM OUTSIDE.
3. ALL DIMENSIONS TO BE VERIFIED ON SITE BEFORE FABRICATION.

LEGEND :
 (X1) DETAIL MARK NO.
 (X00) REFER SHEET NO.
 1. F.F.L. -- FINISHED FLOOR LEVEL
 2. S.F.L. -- STRUCTURAL FLOOR LEVEL
 3. (R) -- REVERSED DETAIL

PROJECT : PROPOSED RESIDENTIAL DEVELOPMENT AT N.K.I.L. 6542 YIN PING ROAD KOWLOON

TITLE : PART ELEVATION FOR CURTAIN WALL AT TOWER 3

DATE : 26-MAR-21 **SCALE :** 1:60 (A1)

DRAWN BY : LHR **CHECKED BY :**

UNITS : G-8, Sunny Industrial Centre, 1/F
 810 Chee Kwo Ling Road, Kowloon
 Tel: 23489271-4 Fax: (852) 27270666
 DWG NO. : JB53-SD-CW-4303 REV. : A