



工程指示 / 要求簡箋(E.I.)

工程指示編號：EI/4647/22

修改版次：

工程編號：J-853

工程名稱：大窩坪(廷坪路)

工程項目：T7 座 幕埗單元件玻璃生產 (大貨)

收件人：Maggie Lor

發件人：大明

日期：03/05/2022

要求提供 / 確認 事項：

- | | | |
|------------------------------------|-------------------------------------|-------------------------------|
| <input type="checkbox"/> 初步鋁料 B.M. | <input type="checkbox"/> 加工拆圖，然後生產 | <input type="checkbox"/> 尺寸表 |
| <input type="checkbox"/> 正式鋁料 B.M. | <input type="checkbox"/> 技術上資料 / 指示 | <input type="checkbox"/> 報 |
| <input type="checkbox"/> 配件 B.M. | <input type="checkbox"/> 樣辦或貨品說明書 | <input type="checkbox"/> 分判合約 |
| <input type="checkbox"/> 其他：_____ | | |

內容：

煩請依附 BM 表資料生產玻璃後送廠

第一批次交貨：14/06/2022

第二批次交貨：18/07/2022

請在 _____ 前完成上列要求。

附有關圖紙 / 文件：附 B.M 表 4 頁,圖紙 1+5+5 頁

以上項目為：

- 原合約工程包 原合約工程加 / 減賬 新工程報價

原因：-_____

分發東莞各部門：

- ()生產技術總監 連附件 ()技術部 連附件 ()生產部 連附件 ()機械設計部 連附件
 ()採購部 連附件 (✓)生產統籌部 連附件 *粘*
 ()質檢部 連附件 ()會計部 連附件 ()報關組 連附件 ()其他 *謝林結* 連附件

分發香港各部門：

- ()行政部 連附件 ()會計部 連附件 ()統籌部 連附件 ()工程部地盤科文 連附件
 ()採購部 連附件 ()QS 部 連附件 ()維修部 連附件 ()其他 _____ 連附件

傳遞編號：

HK 0723


發件人簽署：

[Signature]

項目經理簽署：

[Signature]

(FJP)

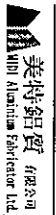


美特铝质有限公司
Meite Aluminum Fabricator Ltd.

工程名称: 1853
地址名称: 九鼎庭开里
项目名称: 17000000000000000000
设计: 林炳耀
审核: 梁永林
日期: 2022.01.01
A/C Code:

材料: 送星
备注: A/C Code

修改版本: 幕墙玻璃数据表
幕墙玻璃数据表 (M): 906
幕墙玻璃面积 (平方米): 1061.19

序號	修改內容	玻璃圖號	顏色與類型	厚度 (mm)	玻璃尺寸		數量	總面積 平方米	使用位置	單位	樓層	分類類型	分格寬度	分格高度	樞角	每樞數量	備註
					寬度 (mm)	高度 (mm)											
1		GI-3	GI	34	781	657	15	7.70	1853-SD-CW-4608	B	7/F-23/F	下樑	815	712.5	15	1	第一批交貨 7/F ~ 16/F (省略 13/F, 14/F)
2		GI-6	GI	34	566	657	34	12.64	1853-SD-CW-4603	A	7/F-26/F	下樑	600	712.5	17	2	第二批交貨 7/F ~ 16/F (省略 13/F, 14/F)
3		GI-6	GI	34	566	657	30	11.16	1853-SD-CW-4604	B	7/F-23/F	下樑	600	712.5	15	2	第一批交貨 7/F ~ 16/F (省略 13/F, 14/F)
4		GI-6	GI	34	566	657	13	4.83	1853-SD-CW-4608	B	9/F-23/F	下樑	600	712.5	13	1	第一批交貨 9/F ~ 16/F (省略 13/F, 14/F)
5		GI-6	GI	34	566	657	2	0.74	1853-SD-CW-4609	B	26/F	下樑	600	712.5	1	2	
6		GI-18	GI	34	716	657	2	0.94	1853-SD-CW-4609	B	26/F	下樑	750	712.5	1	2	
7		GI-19	GI	34	608.5	657	17	6.80	1853-SD-CW-4603	A	7/F-26/F	下樑	642.5	712.5	17	1	第一批交貨 7/F ~ 16/F (省略 13/F, 14/F)
8		GI-20	GI	34	766	657	13	6.54	1853-SD-CW-4608	B	9/F-23/F	下樑	800	712.5	13	1	第一批交貨 9/F ~ 16/F (省略 13/F, 14/F)
9		GI-21	GI	34	1016	657	17	11.35	1853-SD-CW-4603	A	7/F-26/F	下樑	1050	712.5	17	1	第一批交貨 7/F ~ 16/F (省略 13/F, 14/F)
10		GI-26	GI	34	866	657	1	0.57	1853-SD-CW-4609	B	26/F	下樑	900	712.5	1	1	
11		GI-27	GI	34	751	657	15	7.40	1853-SD-CW-4604	B	7/F-23/F	下樑	785	712.5	15	1	第一批交貨 7/F ~ 16/F (省略 13/F, 14/F)
12		GI-41	GI	34	978.5	657	16	10.29	1853-SD-CW-4605	B	7/F-25/F	下樑	1100	712.5	16	1	轉角 第一批交貨 7/F ~ 16/F (省略 13/F, 14/F)
13		GI-607	GI	34	1068.5	2137	6	13.70	1853-SD-CW-4603	A	17/F-22/F	全樑	1102.5	2192.5	6	1	
14		GI-607	GI	34	1068.5	2137	7	15.98	1853-SD-CW-4603	A	7/F-15/F	全樑	1102.5	2192.5	7	1	第一批交貨 (省略 13/F, 14/F)
15		GI-607A	GI	34	1068.5	2287	1	2.44	1853-SD-CW-4603	A	25/F	全樑	1102.5	2342.5	1	1	
16		GI-607A	GI	34	1068.5	2287	1	2.44	1853-SD-CW-4603	A	16/F	全樑	1102.5	2342.5	1	1	第一批交貨
17		GI-607B	GI	34	1068.5	2387	1	2.55	1853-SD-CW-4603	A	23/F	全樑	1102.5	2442.5	1	1	
18		GI-607D	GI	34	1068.5	2087	1	2.23	1853-SD-CW-4603	A	26/F	全樑	1102.5	2142.5	1	1	
19		GI-608	GI	34	1253.5	2137	6	16.07	1853-SD-CW-4603	A	17/F-22/F	全樑	1287.5	2192.5	6	1	第一批交貨
20		GI-608A	GI	34	1253.5	2137	7	18.75	1853-SD-CW-4603	A	7/F-15/F	全樑	1287.5	2192.5	7	1	
21		GI-608A	GI	34	1253.5	2287	1	2.87	1853-SD-CW-4603	A	25/F	全樑	1287.5	2342.5	1	1	
22		GI-608A	GI	34	1253.5	2287	1	2.87	1853-SD-CW-4603	A	16/F	全樑	1287.5	2342.5	1	1	第一批交貨
23		GI-608B	GI	34	1253.5	2387	1	2.99	1853-SD-CW-4603	A	23/F	全樑	1287.5	2442.5	1	1	
24		GI-608D	GI	34	1253.5	2087	1	2.62	1853-SD-CW-4603	A	26/F	全樑	1287.5	2142.5	1	1	
25		GI-609	GI	34	1528.5	2137	6	19.60	1853-SD-CW-4603	A	17/F-22/F	全樑	1562.5	2192.5	6	1	第一批交貨
26		GI-609A	GI	34	1528.5	2137	7	22.86	1853-SD-CW-4603	A	7/F-15/F	全樑	1562.5	2192.5	7	1	
27		GI-609A	GI	34	1528.5	2287	1	3.50	1853-SD-CW-4603	A	25/F	全樑	1562.5	2342.5	1	1	第一批交貨
28		GI-609A	GI	34	1528.5	2287	1	3.50	1853-SD-CW-4603	A	16/F	全樑	1562.5	2342.5	1	1	
29		GI-609B	GI	34	1528.5	2387	1	3.65	1853-SD-CW-4603	A	23/F	全樑	1562.5	2442.5	1	1	第一批交貨
30		GI-609D	GI	34	1528.5	2087	1	3.19	1853-SD-CW-4603	A	26/F	全樑	1562.5	2142.5	1	1	
31		GI-610	GI	34	1628.5	2137	7	24.36	1853-SD-CW-4604	B	17/F-23/F	全樑	1662.5	2192.5	7	1	第一批交貨
32		GI-610	GI	34	1628.5	2137	7	24.36	1853-SD-CW-4604	B	7/F-15/F	全樑	1662.5	2192.5	7	1	第一批交貨
33		GI-610A	GI	34	1628.5	2287	1	3.72	1853-SD-CW-4604	B	16/F	全樑	1662.5	2342.5	1	1	第一批交貨
34		GI-611	GI	34	1868.5	2137	7	27.95	1853-SD-CW-4604	B	17/F-23/F	全樑	1902.5	2192.5	7	1	第一批交貨
35		GI-611	GI	34	1868.5	2137	7	27.95	1853-SD-CW-4604	B	7/F-15/F	全樑	1902.5	2192.5	7	1	第一批交貨
36		GI-611A	GI	34	1868.5	2287	1	4.27	1853-SD-CW-4604	B	16/F	全樑	1902.5	2342.5	1	1	第一批交貨
37		GI-612	GI	34	2220.5	2137	6	28.47	1853-SD-CW-4605	B	17/F-22/F	全樑	2325	2192.5	6	1	轉角
38		GI-612	GI	34	2220.5	2137	7	33.22	1853-SD-CW-4605	B	7/F-15/F	全樑	2325	2192.5	7	1	轉角
39		GI-612A	GI	34	2220.5	2287	1	5.08	1853-SD-CW-4605	B	16/F	全樑	2325	2342.5	1	1	轉角
40		GI-612B	GI	34	2220.5	2387	1	5.30	1853-SD-CW-4605	B	23/F	全樑	2325	2442.5	1	1	轉角
41		GI-612D	GI	34	2220.5	2087	1	4.63	1853-SD-CW-4605	B	25/F	全樑	2325	2142.5	1	1	轉角

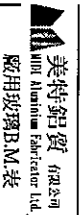

美特铝质有限公司
Meitong Aluminum Fabricator Ltd.

工程號: J853
地點名稱: 九龍旺角道
項目名稱: 訂造窗式玻璃幕
日期: 2022/04/04

材料: 玻璃
圖名: A/C Code

項目名稱: 訂造窗式玻璃幕
日期: 2022/04/04

項目名稱: 訂造窗式玻璃幕
日期: 2022/04/04

序號	物料內容	玻璃圖號	顏色與類型	厚度 (mm)	玻璃尺寸		數量	總面積 (平方米)	使用位置	單位	標稱	分類類型	分格寬度	分格高度	樞樞	每樞樞數量	備註
					寬度 (mm)	高度 (mm)											
42	G1-616A	G1	668.5	2287	2	3.06	1853-SD-CW-4608	B	25F-26F	全樞	702.5	2342.5	2	1			
43	G1-617	G1	1341	2137	6	17.19	1853-SD-CW-4608	B	17F-22F	全樞	1375	2192.5	6	1			第一批交貨
44	G1-617A	G1	1341	2137	7	20.06	1853-SD-CW-4608	B	7F-15F	全樞	1375	2192.5	7	1			第一批交貨
45	G1-617A	G1	1341	2287	1	3.07	1853-SD-CW-4608	B	16F	全樞	1375	2342.5	1	1			第一批交貨
46	G1-617B	G1	1341	2287	1	3.20	1853-SD-CW-4608	B	23F	全樞	1375	2442.5	1	1			
47	G1-618A	G1	1453.5	2287	2	6.65	1853-SD-CW-4608	B	25F-26F	全樞	1487.5	2342.5	2	1			
48	G1-619	G1	2068.5	2137	6	26.52	1853-SD-CW-4608	B	17F-22F	全樞	2102.5	2192.5	6	1			
49	G1-619	G1	2068.5	2137	5	22.10	1853-SD-CW-4608	B	9F-15F	全樞	2102.5	2192.5	5	1			第一批交貨
50	G1-619A	G1	2068.5	2287	1	4.73	1853-SD-CW-4608	B	16F	全樞	2102.5	2342.5	1	1			第一批交貨
51	G1-619B	G1	2068.5	2387	1	4.94	1853-SD-CW-4608	B	23F	全樞	2102.5	2442.5	1	1			
52	G1-620	G1	903.5	2137	6	11.58	1853-SD-CW-4608	B	17F-22F	全樞	937.5	2192.5	6	1			
53	G1-620	G1	903.5	2137	5	9.65	1853-SD-CW-4608	B	9F-15F	全樞	937.5	2192.5	5	1			第一批交貨
54	G1-620A	G1	903.5	2287	1	2.07	1853-SD-CW-4608	B	16F	全樞	937.5	2342.5	1	1			第一批交貨
55	G1-620B	G1	903.5	2287	1	2.16	1853-SD-CW-4608	B	23F	全樞	937.5	2442.5	1	1			
56	G1-621A	G1	866	2287	1	1.98	1853-SD-CW-4609	B	26F	全樞	900	2342.5	1	1			
57	G1-622A	G1	1151	2287	1	2.63	1853-SD-CW-4609	B	26F	全樞	1185	2342.5	1	1			
58	G1-623A	G1	1981	2287	1	4.53	1853-SD-CW-4609	B	26F	全樞	2015	2342.5	1	1			
59						320	558.21										
60	G2-3	G2	753	1426.5	6	6.44	1853-SD-CW-4608	B	17F-22F	TH	815	1480	6	1			
61	G2-3	G2	753	1426.5	7	7.52	1853-SD-CW-4608	B	7F-15F	TH	815	1480	7	1			第一批交貨
62	G2-3A	G2	753	1576.5	1	1.19	1853-SD-CW-4608	B	16F	TH	815	1650	1	1			第一批交貨
63	G2-3B	G2	753	1676.5	1	1.26	1853-SD-CW-4608	B	23F	TH	815	1730	1	1			
64	G2-6	G2	538	1426.5	12	9.21	1853-SD-CW-4603	A	17F-22F	SH	600	1480	6	2			第二批交貨
65	G2-6	G2	538	1426.5	14	10.74	1853-SD-CW-4603	A	7F-15F	SH	600	1480	7	2			第二批交貨
66	G2-6	G2	538	1426.5	14	10.74	1853-SD-CW-4604	B	17F-23F	TH	600	1480	7	2			第二批交貨
67	G2-6	G2	538	1426.5	14	10.74	1853-SD-CW-4604	B	7F-15F	TH	600	1480	7	2			第一批交貨
68	G2-6	G2	538	1426.5	6	4.60	1853-SD-CW-4608	B	17F-22F	SH	600	1480	6	1			
69	G2-6	G2	538	1426.5	5	3.84	1853-SD-CW-4608	B	9F-15F	SH	600	1480	5	1			第一批交貨
70	G2-6A	G2	538	1576.5	2	1.70	1853-SD-CW-4603	A	25F	SH	600	1650	1	2			第一批交貨
71	G2-6A	G2	538	1576.5	2	1.70	1853-SD-CW-4603	A	16F	SH	600	1650	1	2			第一批交貨
72	G2-6A	G2	538	1576.5	2	1.70	1853-SD-CW-4604	B	16F	TH	600	1650	1	2			第一批交貨
73	G2-6A	G2	538	1576.5	1	0.85	1853-SD-CW-4608	B	16F	SH	600	1650	1	1			第一批交貨
74	G2-6A	G2	538	1576.5	2	1.70	1853-SD-CW-4609	B	26F	SH	600	1730	1	2			第一批交貨
75	G2-6B	G2	538	1676.5	2	1.80	1853-SD-CW-4603	A	23F	SH	600	1730	1	2			
76	G2-6B	G2	538	1676.5	1	0.90	1853-SD-CW-4608	B	23F	SH	600	1730	1	1			
77	G2-6D	G2	538	1376.5	2	1.48	1853-SD-CW-4603	A	26F	SH	600	1430	1	2			
78	G2-18A	G2	688	1576.5	2	2.17	1853-SD-CW-4609	B	26F	TH	750	1650	1	2			
79	G2-19	G2	580.5	1426.5	6	4.97	1853-SD-CW-4603	A	17F-22F	SH	642.5	1480	6	1			第一批交貨
80	G2-19	G2	580.5	1426.5	7	5.80	1853-SD-CW-4603	A	7F-15F	SH	642.5	1480	7	1			第一批交貨
81	G2-19A	G2	580.5	1576.5	1	0.92	1853-SD-CW-4603	A	25F	SH	642.5	1650	1	1			
82	G2-19A	G2	580.5	1576.5	1	0.92	1853-SD-CW-4603	A	16F	SH	642.5	1650	1	1			第一批交貨

美特铝质有限公司 Mei Te Aluminum Panfector Ltd.		工程名称: JS3 地址名称: 九龍新界荃灣 项目名称: 荃灣新式車庫 地址:	日期: 2022.3.12 日期: 2022.04.04 日期:	项目经理: 謝永林 日期:	送货: 副本 A/C Code:	物料:
---	--	--	--	------------------	---------------------	-----

物料名称: 美特铝质JM表
 规格: 96
 单位: 1064.19
 备注: 172.33

序號	修改內容	玻璃圖號	顏色與類型	厚度 (mm)	玻璃尺寸 (mm)		數量	總面積 (平方米)	使用位置	單位	樓層	分類類型	分格寬度	分格高度	樓層	每層數量	備註
					寬度 (mm)	高度 (mm)											
83		G2-19B	G2	32	580.5	1676.5	1	0.97	J853-SD-CW-4603	A	23/F	SH	642.5	1730	1	1	
84		G2-19D	G2	32	580.5	1376.5	1	0.80	J853-SD-CW-4603	A	26/F	SH	642.5	1430	1	1	
85		G2-20	G2	32	738	1426.5	6	6.32	J853-SD-CW-4608	B	17/F-22/F	TH	800	1480	6	1	
86		G2-20	G2	32	738	1426.5	5	5.26	J853-SD-CW-4608	B	9/F-15/F	TH	800	1480	5	1	第二批交貨
87		G2-20A	G2	32	738	1576.5	1	1.16	J853-SD-CW-4608	B	16/F	TH	800	1630	1	1	第二批交貨
88		G2-20B	G2	32	738	1676.5	1	1.24	J853-SD-CW-4608	B	23/F	TH	800	1730	1	1	
89		G2-21	G2	32	988	1426.5	6	8.46	J853-SD-CW-4603	A	17/F-22/F	SH	1050	1480	6	1	
90		G2-21A	G2	32	988	1426.5	7	9.87	J853-SD-CW-4603	A	7/F-22/F	SH	1050	1480	7	1	第一批交貨
91		G2-21A	G2	32	988	1576.5	1	1.36	J853-SD-CW-4603	A	23/F	SH	1050	1630	1	1	
92		G2-21A	G2	32	988	1576.5	1	1.36	J853-SD-CW-4603	A	16/F	SH	1050	1630	1	1	第一批交貨
93		G2-21B	G2	32	988	1676.5	1	1.66	J853-SD-CW-4603	A	23/F	SH	1050	1730	1	1	
94		G2-21D	G2	32	988	1376.5	1	1.36	J853-SD-CW-4603	A	26/F	SH	1050	1430	1	1	
95		G2-26A	G2	32	723	1576.5	1	1.32	J853-SD-CW-4609	B	26/F	TH	900	1630	1	1	
96		G2-27	G2	32	723	1426.5	7	7.22	J853-SD-CW-4604	B	17/F-23/F	TH	785	1480	7	1	
97		G2-27	G2	32	723	1426.5	7	7.22	J853-SD-CW-4604	B	7/F-15/F	TH	785	1480	7	1	第二批交貨
98		G2-27A	G2	32	723	1576.5	1	1.14	J853-SD-CW-4604	B	16/F	TH	785	1630	1	1	第一批交貨
99		G2B-41	G2	32	964	1426.5	6	8.25	J853-SD-CW-4605	B	17/F-22/F	TH	1100	1480	6	1	轉角
100		G2B-41	G2	32	964	1426.5	7	9.63	J853-SD-CW-4605	B	7/F-15/F	TH	1100	1480	7	1	轉角
101		G2B-41A	G2	32	964	1576.5	1	1.52	J853-SD-CW-4605	B	16/F	TH	1100	1630	1	1	第一批交貨
102		G2B-41B	G2	32	964	1676.5	1	1.62	J853-SD-CW-4605	B	23/F	TH	1100	1730	1	1	轉角
103		G2B-41D	G2	32	964	1376.5	1	1.33	J853-SD-CW-4605	B	23/F	TH	1100	1430	1	1	轉角
104							合計:	172.33									
105		G4-3	G4	12	781	903	15	10.58	J853-SD-CW-4608	B	7/F-23/F	上樓	815	957.5	15	1	第一批交貨 7/F-16/F (省略 13/F, 14/F)
106		G4-6	G4	12	566	903	32	16.36	J853-SD-CW-4603	A	7/F-23/F	上樓	600	957.5	16	2	第二批交貨 7/F-16/F (省略 13/F, 14/F)
107		G4-6	G4	12	566	903	28	14.31	J853-SD-CW-4604	B	7/F-22/F	上樓	600	957.5	14	2	第二批交貨 7/F-16/F (省略 13/F, 14/F)
108		G4-6	G4	12	566	903	12	6.13	J853-SD-CW-4608	B	9/F-22/F	上樓	600	957.5	12	1	第二批交貨 9/F-16/F (省略 13/F, 14/F)
109		G4-6Z	G4	12	566	753	1	0.43	J853-SD-CW-4608	B	23/F	上樓	600	807.5	1	1	特殊高度
110		G4-6	G4	12	566	903	2	1.02	J853-SD-CW-4609	B	25/F	上樓	600	957.5	1	2	
111		G4-6A	G4	12	566	2288	2	2.59	J853-SD-CW-4609	B	26/F	上樓	600	2240.5	1	2	特殊高度
112		G4-18	G4	12	716	903	2	1.29	J853-SD-CW-4609	B	25/F	上樓	750	957.5	1	2	
113		G4-19	G4	12	680.5	903	16	8.79	J853-SD-CW-4603	A	7/F-23/F	上樓	642.5	957.5	16	1	
114		G4-20	G4	12	766	903	12	8.30	J853-SD-CW-4608	B	9/F-22/F	上樓	800	957.5	12	1	
115		G4-20Z	G4	12	766	753	1	0.38	J853-SD-CW-4608	B	23/F	上樓	800	807.5	1	1	特殊高度
116		G4-21	G4	12	1016	903	16	14.68	J853-SD-CW-4603	A	7/F-23/F	上樓	1050	957.5	16	1	
117		G4-27	G4	12	751	903	14	9.49	J853-SD-CW-4604	B	7/F-22/F	上樓	785	957.5	14	1	
118		G4-41	G4	12	978.5	903	15	13.25	J853-SD-CW-4605	B	7/F-23/F	上樓	1100	957.5	15	1	轉角
119		G4-607	G4	12	1068.5	903	16	15.44	J853-SD-CW-4603	A	7/F-23/F	上樓	1102.5	957.5	16	1	第一批交貨 7/F-16/F (省略 13/F, 14/F)
120		G4-608	G4	12	1253.5	903	16	18.11	J853-SD-CW-4603	A	7/F-23/F	上樓	1287.5	957.5	16	1	第一批交貨 7/F-16/F (省略 13/F, 14/F)
121		G4-609	G4	12	1528.5	903	16	22.08	J853-SD-CW-4603	A	7/F-23/F	上樓	1562.5	957.5	16	1	第一批交貨 7/F-16/F (省略 13/F, 14/F)
122		G4-610	G4	12	1628.5	903	14	20.59	J853-SD-CW-4604	B	7/F-22/F	上樓	1662.5	957.5	14	1	第二批交貨 7/F-16/F (省略 13/F, 14/F)
123		G4-611	G4	12	1868.5	903	14	23.62	J853-SD-CW-4604	B	7/F-22/F	上樓	1902.5	957.5	14	1	第一批交貨 7/F-16/F (省略 13/F, 14/F)

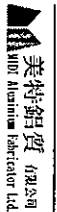

美特铝质有限公司
100 Aluminum Fabricator Ltd.
廠用玻璃目名表

工程號: J853 材料: 玻璃
地點名稱: 九龍旺角 製件名: 鋼板
項目類別: 77 覆面式玻璃 批准:
總工玻璃數量 (噸): 976 總工玻璃面積 (平方呎): 1064.19
日期: 2022.11.2
日期: 2022.04.04
項目名稱: AIC Code

項目: 鋼板
單位: 噸
日期: 2022.11.2
日期: 2022.04.04
項目名稱: AIC Code

註明參考數值/所屬位置/規格

序號	修改內容	玻璃圖號	顏色與類型	厚度 (mm)	玻璃尺寸 (mm)		數量	總面積 (平方米)	使用位置	單位	規格	分類型	分格寬度	分格高度	樞距	每層數量	備註
					width (mm)	height (mm)											
124	G4-612	G4		12	2220.5	903	15	30.08	J853-SD-CW-4605	B	71F-231F	上梗	2325	997.5	15	1	轉角
125	G4-616	G4		12	668.5	903	1	0.60	J853-SD-CW-4608	B	251F	上梗	702.5	997.5	1	1	
126	G4-617	G4		12	1341	903	15	18.16	J853-SD-CW-4608	B	71F-231F	上梗	1375	997.5	15	1	
127	G4-618	G4		12	1433.5	903	1	1.31	J853-SD-CW-4608	B	251F	上梗	1487.5	997.5	1	1	
128	G4-619	G4		12	2068.5	903	12	22.41	J853-SD-CW-4608	B	91F-221F	上梗	2102.5	997.5	12	1	
129	G4-619Z	G4		12	2068.5	753	1	1.56	J853-SD-CW-4608	B	231F	上梗	2102.5	807.5	1	1	特殊高度
130	G4-620	G4		12	903.5	903	12	9.79	J853-SD-CW-4608	B	91F-221F	上梗	937.5	997.5	12	1	
131	G4-620Z	G4		12	903.5	753	1	0.68	J853-SD-CW-4608	B	231F	上梗	937.5	807.5	1	1	特殊高度
132	G4-621	G4		12	866	903	1	0.78	J853-SD-CW-4609	B	251F	上梗	900	997.5	1	1	
133	G4-622	G4		12	1151	903	1	1.04	J853-SD-CW-4609	B	251F	上梗	1185	997.5	1	1	
134	G4-623	G4		12	1981	903	1	1.79	J853-SD-CW-4609	B	251F	上梗	2015	997.5	1	1	
135	待定 G4-624	G4		12	2066	903	1	1.87	J853-SD-CW-4609	B	251F	上梗	2100	997.5	1	1	
136							合計:	306	297.72								
137	G3-3X	G5		12	745	357.5	15	4.00	J853-SD-CW-4608	B	71F-231F	欄河	815	357.5	15	1	特殊高度
138	G3-6	G5		12	530	297.5	34	5.36	J853-SD-CW-4603	A	71F-261F	欄河	600	297.5	17	2	
139	G3-6	G5		12	530	297.5	30	4.73	J853-SD-CW-4604	B	71F-231F	欄河	600	297.5	15	2	
140	G3-6X	G5		12	530	407.5	13	2.81	J853-SD-CW-4608	B	91F-231F	欄河	600	407.5	13	1	特殊高度
141	G3-6	G5		12	530	297.5	2	0.32	J853-SD-CW-4609	B	261F	欄河	600	297.5	1	2	
142	G3-18	G5		12	680	297.5	2	0.40	J853-SD-CW-4609	B	261F	欄河	750	297.5	1	2	
143	G3-19	G5		12	572.5	297.5	17	2.90	J853-SD-CW-4603	A	71F-261F	欄河	642.5	297.5	17	1	
144	G3-20	G5		12	730	297.5	13	2.82	J853-SD-CW-4608	B	91F-231F	欄河	800	297.5	13	1	
145	G3-21	G5		12	980	297.5	17	4.96	J853-SD-CW-4603	A	71F-261F	欄河	1050	297.5	17	1	
146	G3-26	G5		12	830	297.5	1	0.25	J853-SD-CW-4609	B	261F	欄河	900	297.5	1	1	
147	G3-27	G5		12	715	297.5	15	3.19	J853-SD-CW-4604	B	71F-231F	欄河	785	297.5	15	1	
148	G3-41	G5		12	883	297.5	16	4.20	J853-SD-CW-4605	B	71F-251F	欄河	1100	297.5	16	1	轉角
149						合計:	175	35.93									

(1) 本表中玻璃尺寸圖樣與實際玻璃技術有限公司、棧板代號亦為三套產品代號。

(2) 本表中所有玻璃厚度均為標準要求不超過負2mm。

(3) 本表中玻璃要求扣膠處理並倒角。欄河玻璃頂底要磨薄邊，而所有玻璃之入端方向需保持一致。

加工注意事項:
玻璃類:
玻璃類:
(5) 本表中所有玻璃成品均需按雙面保護。用透明膠帶覆蓋玻璃表面，以便識別。

(G1) 10mm (Heat Strengthened) + 12mm Air + 12mm (Tempered) IGU (10mm FDNB0-54T#2 + 12A + 12mm Clear) Sample No.: D21031911

(G2) 10mm (Heat Strengthened) + 12mm Air + 10mm (Tempered) IGU (10mm FDNB0-54T#2 + 12A + 10mm Clear) Sample No.: D21031909

(G4) 12mm Clear (Heat Strengthened) with CSTT54(10mm Clear #2 SSC-50T) Sample No.: D21032005

(G5) 12mm Clear Tempered Glass(12mm Clear) Sample No.: D21032007

圖則登記表
DRAWING REGISTER

工程名稱 Project Title:	九龍延坪道 (大貨 (T7座))
	幕牆玻璃 (玻璃加工圖/位置圖)
工程編號 Project No:	J-853

接收日期 Receiving Date (適用於客戶圖則)

年									
月									
日									

分發予 Distributed To


發出日期 Issued Date



年	22								
月	4								
日	4								

圖則編號 Drg. No.	圖則名稱 Drawing Title
G1	玻璃加工圖 (大梗窗玻璃+小梗窗玻璃)
G2	玻璃加工圖 (生窗玻璃)
G2b-41	玻璃加工圖 (生窗轉角玻璃)
G4	玻璃加工圖 (背板位玻璃)
G5	玻璃加工圖 (攔河玻璃)
J853-T5-CW-4603	玻璃位置圖
J853-T5-CW-4604	玻璃位置圖
J853-T5-CW-4605	玻璃位置圖
J853-T5-CW-4608	玻璃位置圖
J853-T5-CW-4609	玻璃位置圖


修訂編號
Revision No.


1	-								
2	-								
3	-								
4	-								
5	-								
6	-								
7	-								
8	-								
9	-								
10	-								

 美特鋁質有限公司 MIDI Aluminium Fabricator Ltd.				類別	物料號		
				制圖	陳敏聰	2022.3.10	圖號 G1
修改				復核	謝永林	2022.3.16	數量 見BOM表
日期				批准			位置 見BOM表

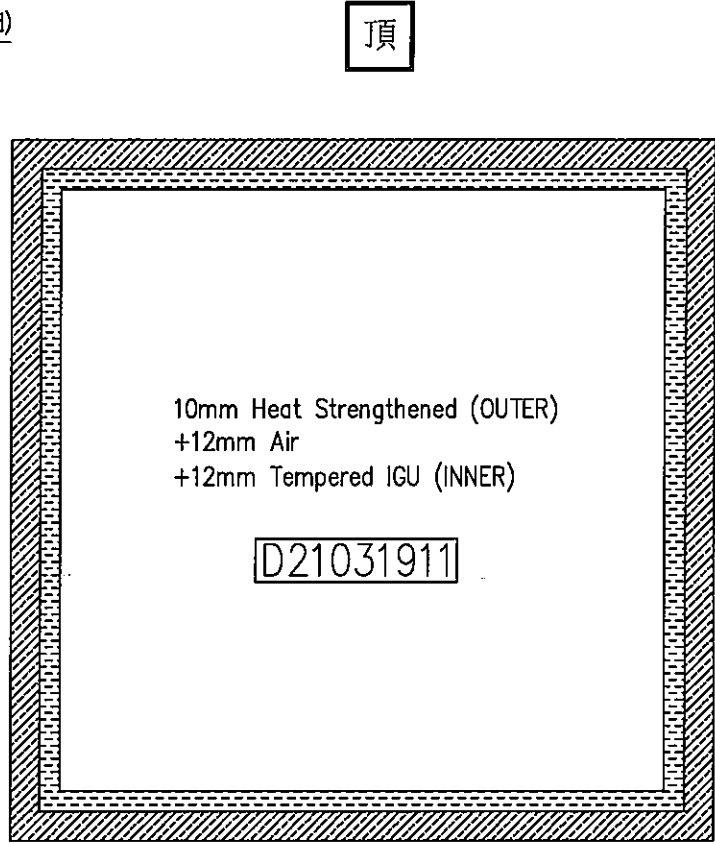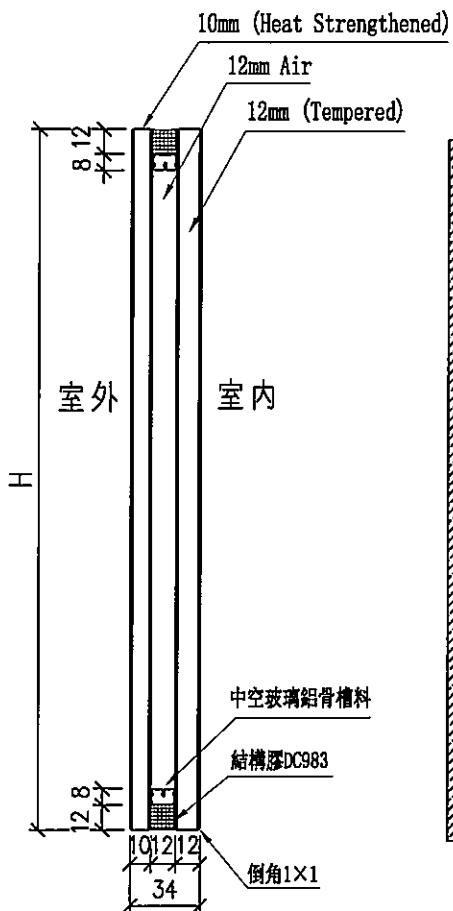

工程號	J-853	地盤	九龍延坪道	附 件	
名稱	玻璃加工圖 (大梗窗玻璃+小梗窗玻璃)		採用		
材料			地盤		
顏色	10mm FDNB0-54T#2+12A+12mm Clear	工廠	√		


 美特鋁質有限公司 MIDI Aluminium Fabricator Ltd.				類別	物料號			
修改				制圖	陳敏聰	2022.3.10	圖號	G2
日期				復核	謝永林	2022.3.16	數量	見BOM表
				批准			位置	見BOM表

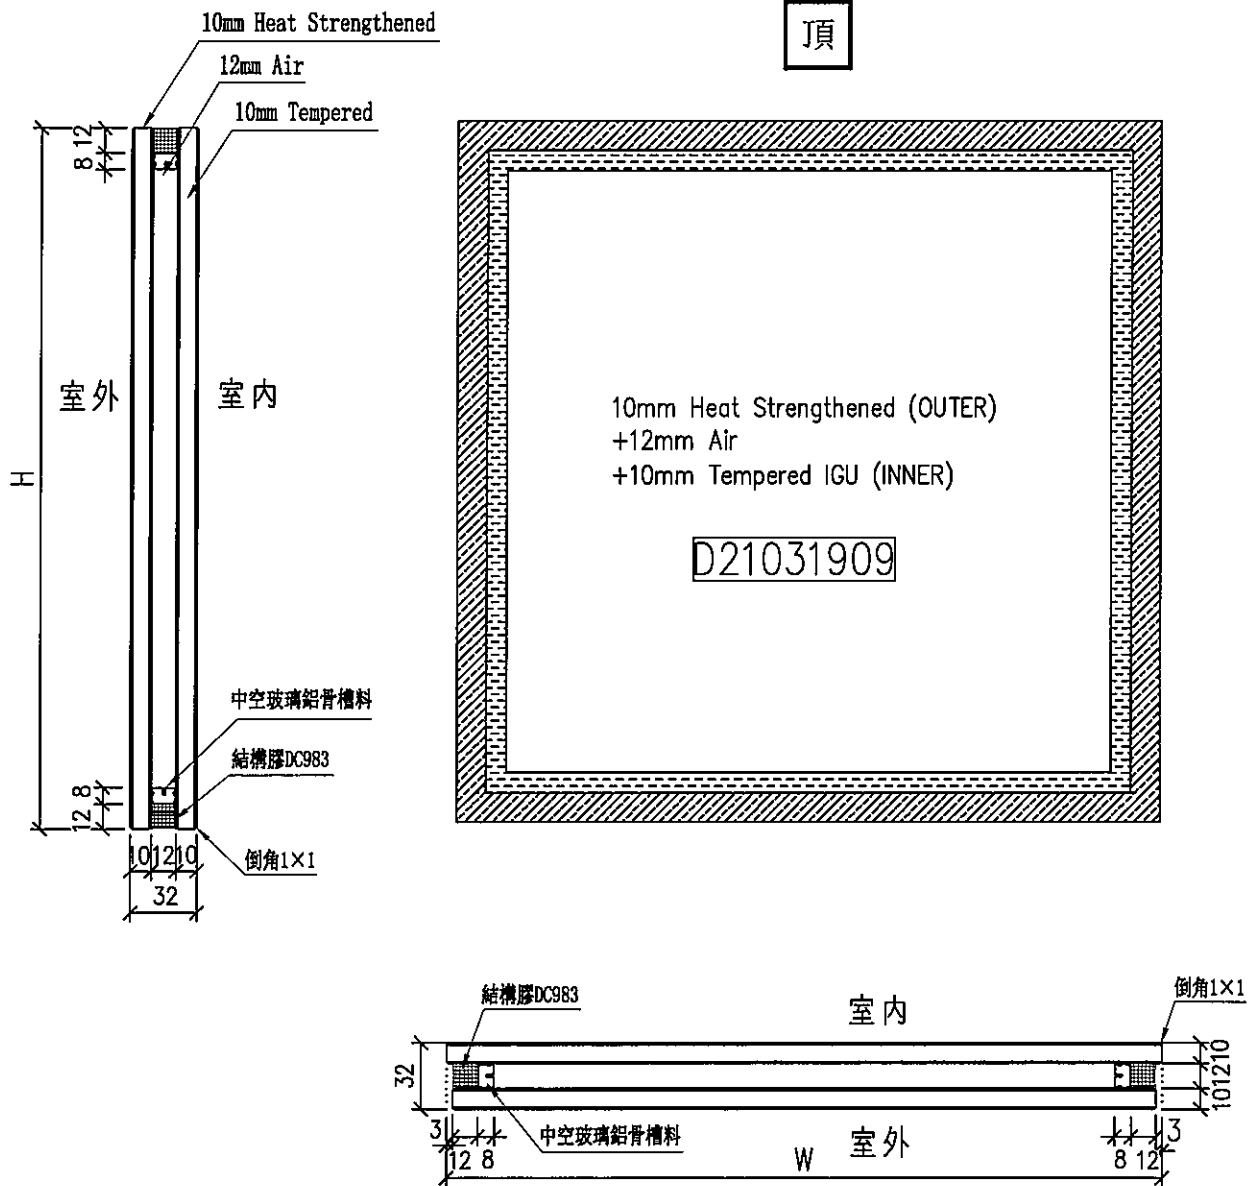


工程號	J-853	地盤	九龍延坪道	附件
名稱	玻璃加工圖 (生窗玻璃)		採用	
材料			地盤	
顏色	10mm FDNB0-54T#2+12A+10mm Clear	工廠	√	


 美特鋁質有限公司 MIDI Aluminium Fabricator Ltd.				類別	物料號			
修改				制圖	陳敏聰	2022.3.10	圖號	G2b-41
日期				復核	謝永林	2022.3.16	數量	-
				批准			位置	-

玻璃圖號	顏色與類型	厚度 (mm)	玻璃尺寸		數量	總面積 平方米	使用位置	樓層	分屬 類型	分格 寬度	分格 高度	樓層	每層 數量	備註
			寬度W (mm)	高度H (mm)										
G2b-41	G2	32	964	1426.5	6	8.25	J853-SD-CW-4605	17/F-22/F	TH	1100	1480	6	1	轉角
G2b-41	G2	32	964	1426.5	7	9.63	J853-SD-CW-4605	7/F-15/F	TH	1100	1480	7	1	轉角
G2b-41A	G2	32	964	1576.5	1	1.52	J853-SD-CW-4605	16/F	TH	1100	1630	1	1	轉角
G2b-41B	G2	32	964	1676.5	1	1.62	J853-SD-CW-4605	23/F	TH	1100	1730	1	1	轉角
G2b-41D	G2	32	964	1376.5	1	1.33	J853-SD-CW-4605	25/F	TH	1100	1430	1	1	轉角

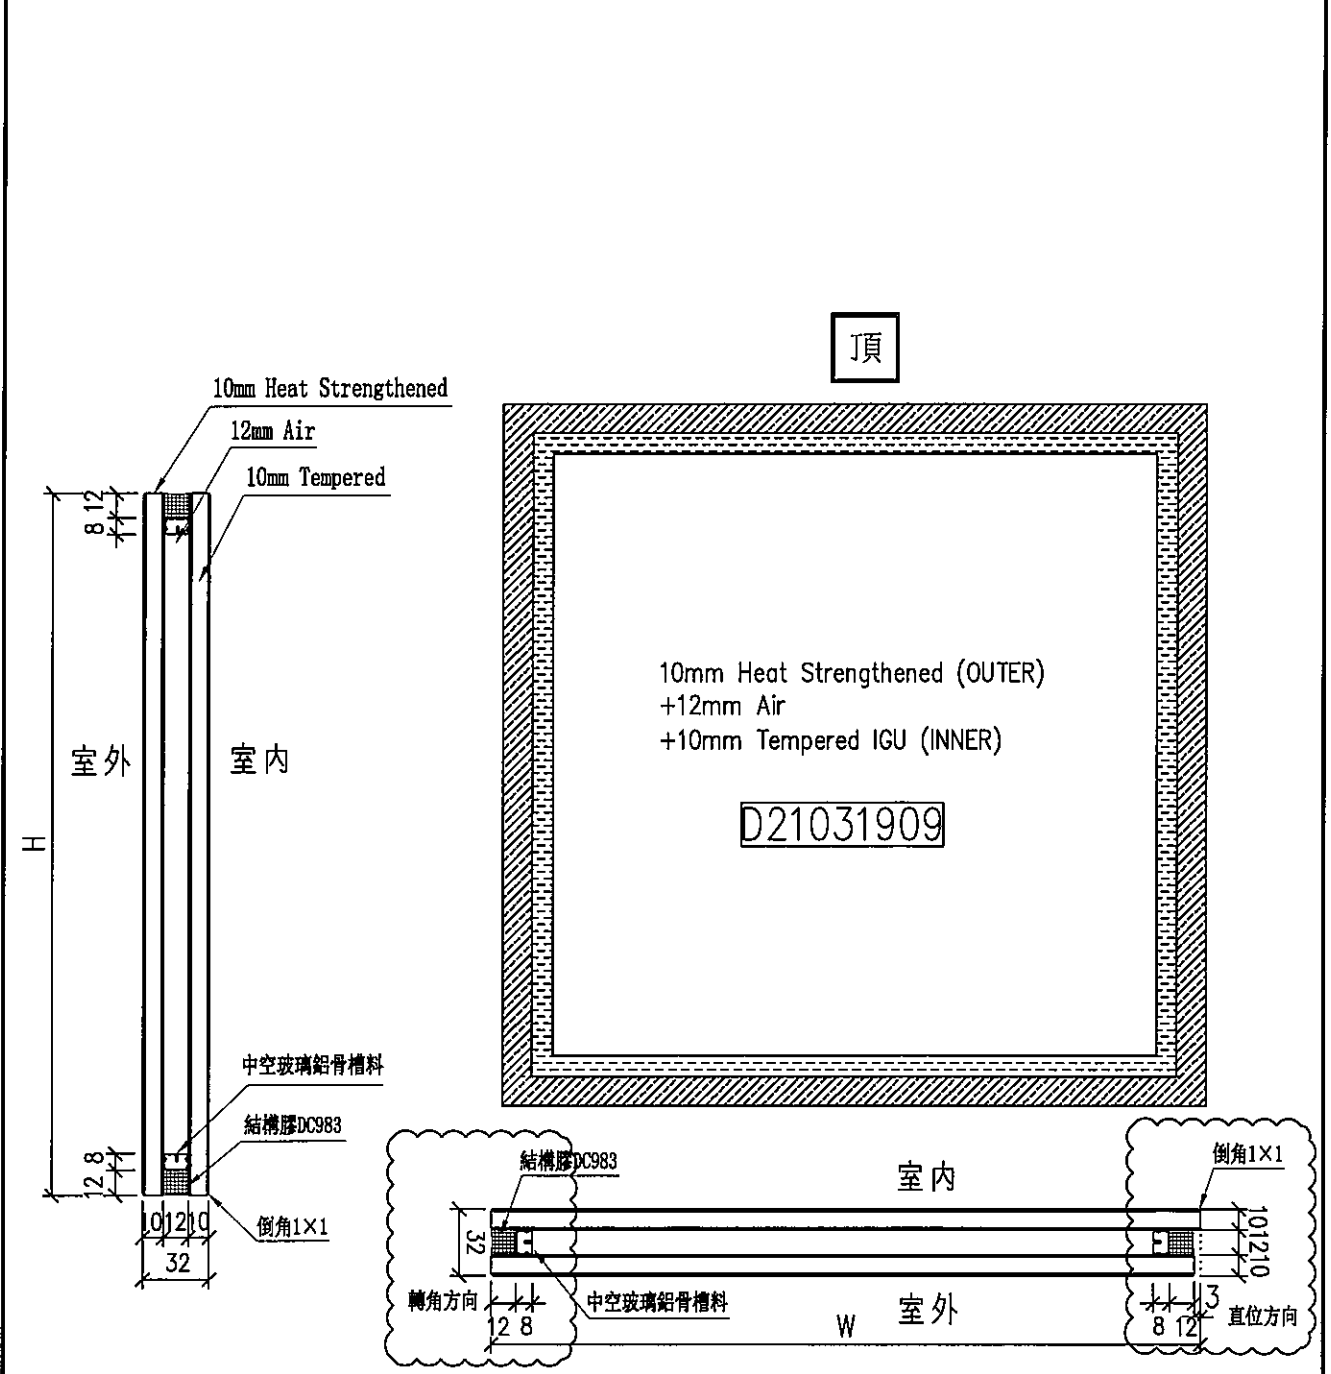


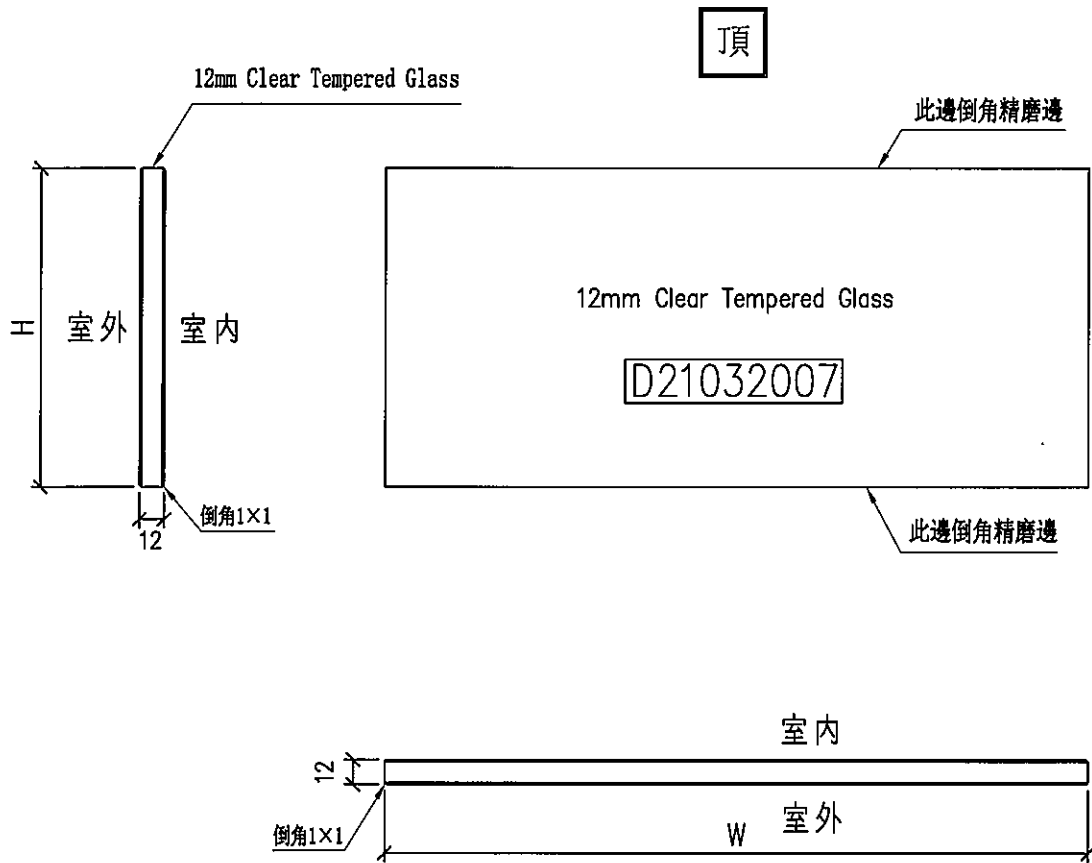
工程號	J-853	地盤	九龍延坪道	附 件
名稱	玻璃加工圖 (生窗轉角玻璃)		採用	
材料			地盤	
顏色	10mm FDNB0-54T#2+12A+10mm Clear		工廠	

 美特鋁質有限公司 MIDI Aluminium Fabricator Ltd.				類別	物料號			
修改				制圖	陳敏聰	2022.3.10	圖號	G4
日期				復核	謝永林	2022.3.16	數量	見BOM表
				批准			位置	見BOM表

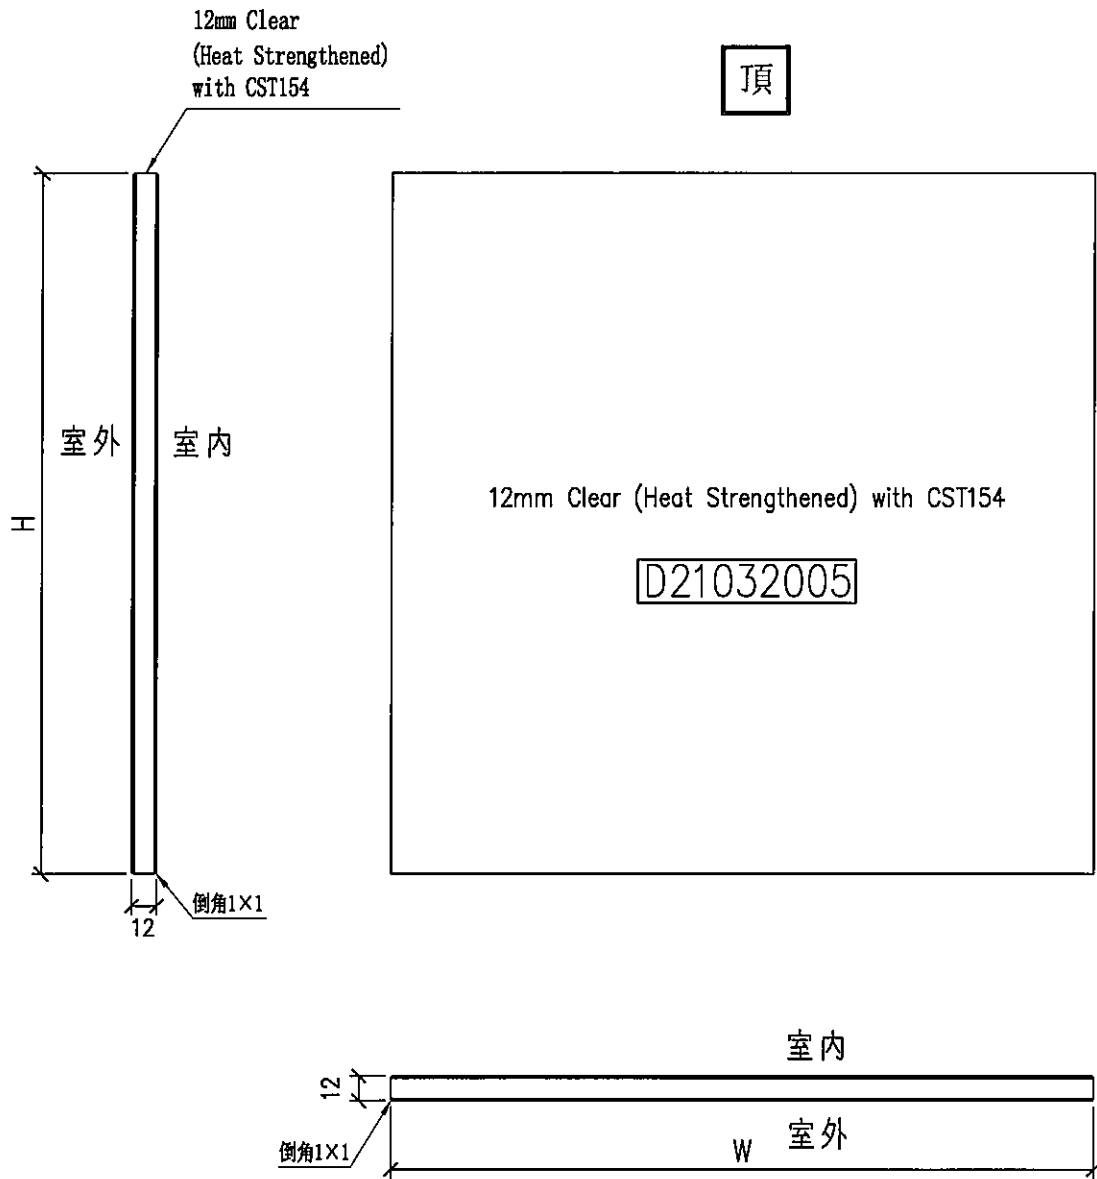

工程號	J-853	地盤	九龍延坪道	附件	
名稱	玻璃加工圖 (背板位玻璃)		採用		
材料			地盤		
顏色	12mm Clear #2 SSC-50T		工廠		

 美特鋁質有限公司 MIDI Aluminium Fabricator Ltd.				類別	物料號			
修改				制圖	陳敏聰	2022.3.10	圖號	G5
日期				復核	謝永林	2022.3.16	數量	見BOM表
				批准			位置	見BOM表



工程號	J-853	地盤	九龍延坪道		附件
名稱	玻璃加工圖 (攔河玻璃)		採用		
材料			地盤		
顏色	12mm Clear		工廠	√	

請用A3紙打印

BD. REF.:

CLIENT:
SHIMAO GROUP HOLDINGS LIMITED

ARCHITECT:
WTF
 WONG TUNG & PARTNERS LIMITED
 ARCHITECTS & PLANNERS

MAIN CONTRACTOR:
協興建築有限公司
 HOP HING CONSTRUCTION CO LTD

STRUCTURAL ENGINEER:
CMA
 C M WONG & ASSOCIATES LTD
 黃志明建築工程師有限公司

FAÇADE CONSULTANT:
MEINHARDT

NOTE:
 1. ALL DIMENSIONS ARE IN mm.
 2. ALL DIMENSIONS ARE TO FACE UNLESS OTHERWISE SPECIFIED.
 3. ALL INTERSECTIONS ARE TO BE TURNED ON SITE BEFORE CONSTRUCTION.
 4. ALL DIMENSIONS ARE TO FACE UNLESS OTHERWISE SPECIFIED.



LEGEND:
 (X1) DETAIL WORK NO.
 (X2) REITER SHEET NO.
 1. FEEL.—FINISHED FLOOR LEVEL
 2. S.F.L.—STRUCTURAL FLOOR LEVEL
 X ()—REVERSED DIMEN.

FLOOR LEVEL (S.F.L.)	LEVEL
15/F	+203.405
14/F	+200.000
13/F	+198.855
12/F	+193.700
11/F	+190.555
10/F	+187.400
9/F	+184.255
8/F	+181.100
7/F	+177.955
6/F	+174.800
5/F	+171.655
4/F	+168.500
3/F	+165.355
2/F	+162.200
1/F	+159.055
0/F	+155.900
1/F	+152.755

PROJECT: PROPOSED RESIDENTIAL DEVELOPMENT AT NKILL, 65#2 YIN PING ROAD, KOWLOON

TITLE: PART ELEVATION FOR CURTAIN WALL AT TOWER B & 7

DRAWN BY: UIR
 CHECKED BY:
 DATE: 12-APR-21
 SCALE: 1:80 (A1)
美特 鋁質有限公司
 MEI TAT ALUMINIUM PRODUCTS CO., LTD.
 Unit 5-8, Sunny Industrial Centre, 1/F
 610 Ona Yau Ling Road, Kowloon
 H21488111-4 Tel:(852)27271856
 DWG NO.: 4553-SD-CW-4604
 REV.: A

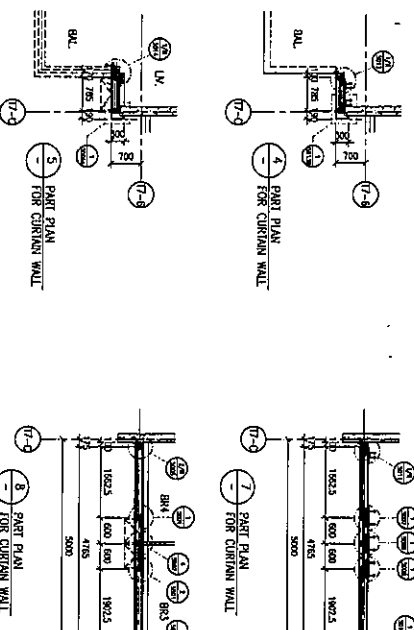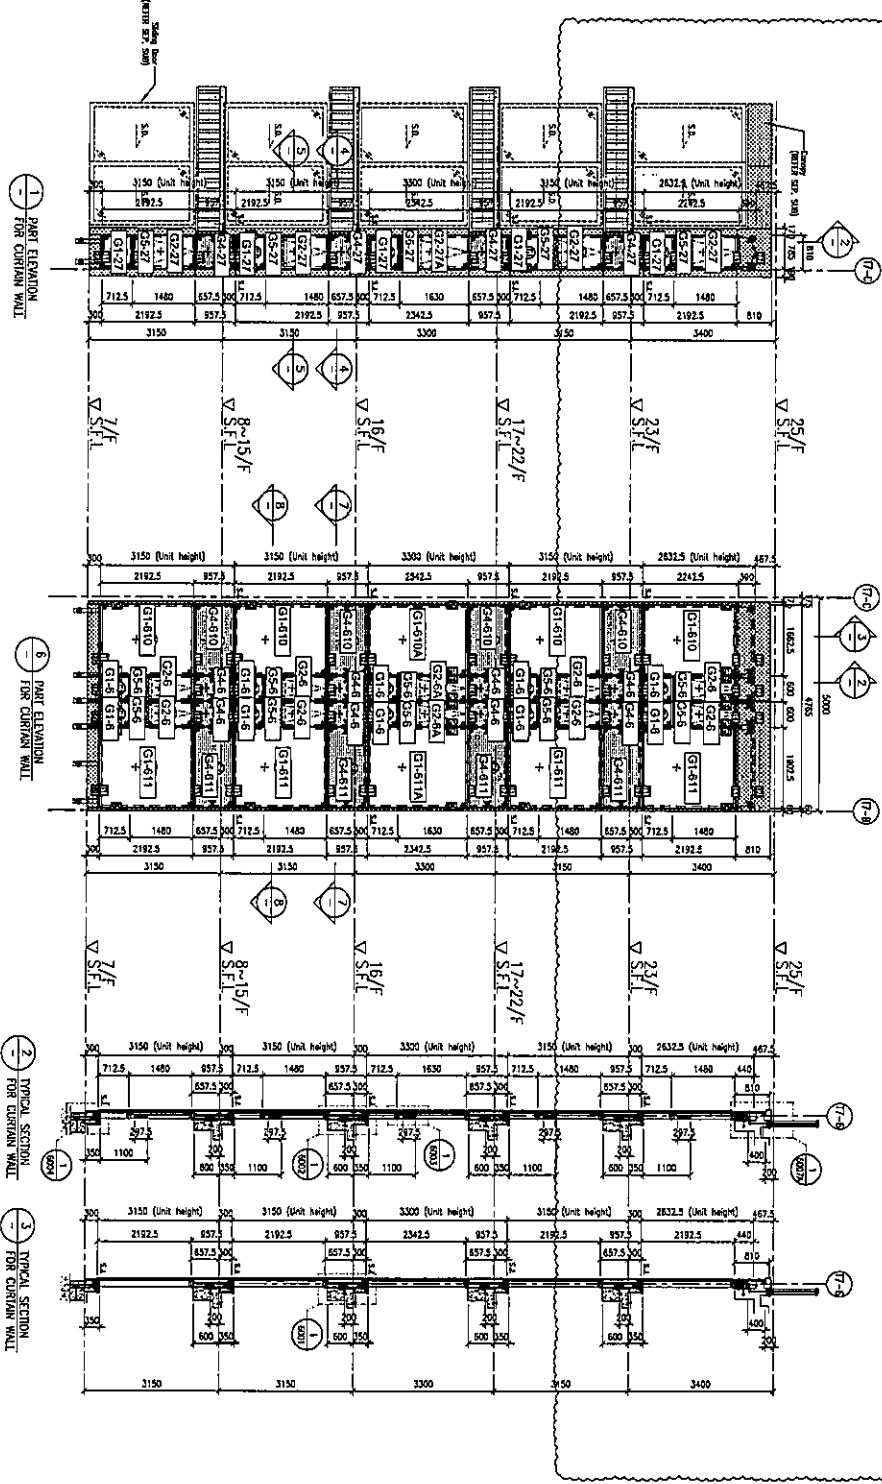

LEGEND:
 (X1) 10mm HEAT STRENGTHENED GLASS (OUTER)
 (X2) 12mm HEAT STRENGTHENED GLASS (INNER)
 (X3) 10mm HEAT STRENGTHENED GLASS (OUTER)
 (X4) 12mm HEAT STRENGTHENED GLASS (INNER)
 (X5) 10mm HEAT STRENGTHENED GLASS & 5mm THK ALUM. BACKING (SPANNING GLASS)
 (X6) 10mm THK CLEAR TEMPERED GLASS (FRONTAL PROTECTIVE GLASS)
 (X7) 5mm THK ALUM. CLADDING
 (X8) 3mm THK ALUM. CLADDING
 (X9) STICK JOINT (WIND LOAD)
 (X10) ALUM. EXPANSION JOINT
 (X11) SUPPORT POINT (WIND LOAD + DEAD LOAD)
 (X12) SUPPORT POINT (WIND LOAD)

請用A3紙打印

B.O. SET :

CLIENT :
SHIMAO GROUP HOLDINGS LIMITED

ARCHITECT :
WTF
WONG TUNG & PARTNERS LIMITED
ARCHITECTS & ENGINEERS


MAIN CONTRACTOR :
協興建築有限公司
HP HING CONSTRUCTION CO LTD

STRUCTURAL ENGINEER :
C M WONG & ASSOCIATES LTD
黃志明建築工程師有限公司

FAÇADE CONSULTANT :
MENHARDT

NOTE :
1. DIMENSIONS ARE IN mm.
2. ALL DIMENSIONS ARE MARKED FROM OUTSIDE.
3. ALL DIMENSIONS TO BE VERIFIED ON SITE BEFORE CONSTRUCTION.

LEGEND :
① - DETAIL MARK NO.
② - REFER SHEET NO.
1. E.F.L. - FINISHED FLOOR LEVEL.
2. S.F.L. - STRUCTURAL FLOOR LEVEL.
3. Ⓡ - REVERSED DETAIL.

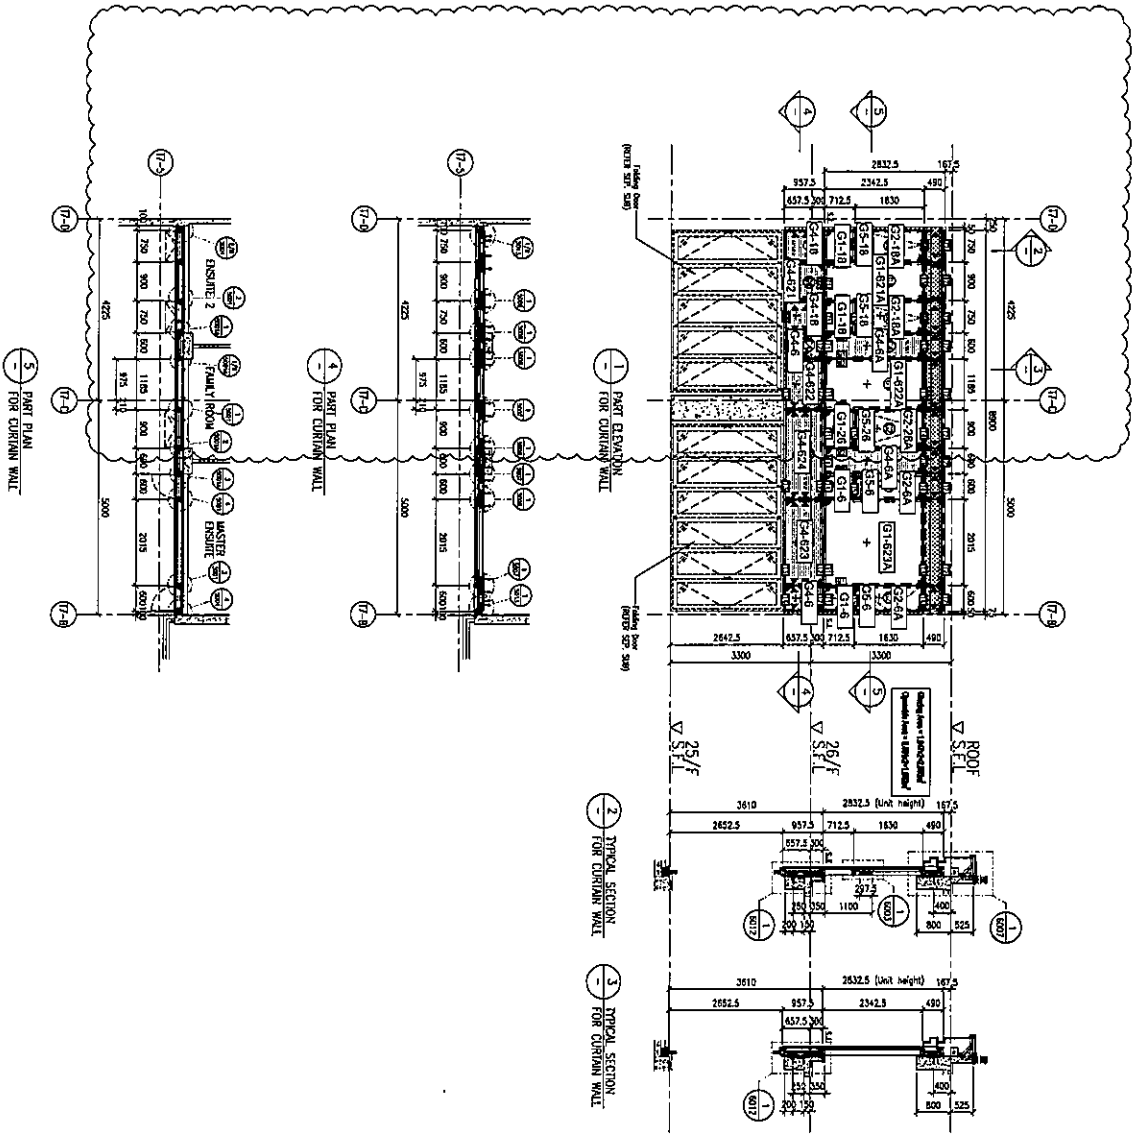

- LEGEND:**
- ① - 10mm HEAT STRENGTHENED GLASS (OUTER)
 - ② - 10mm HEAT STRENGTHENED GLASS (INNER)
 - ③ - 10mm HEAT STRENGTHENED GLASS (OUTER)
 - ④ - 10mm HEAT STRENGTHENED GLASS (INNER)
JOB NO. : J-853

PROJECT : PROPOSED RESIDENTIAL DEVELOPMENT AT N.K.L.L. 6542 YIN PING ROAD KOWLOON

TITLE : PART ELEVATION FOR CURTAIN WALL AT TOWER 6 & 7

DATE : 09-OCT-21 SCALE : 1:60 (A1)

DRAWN BY : LHR CHECKED BY :

WONG TUNG & PARTNERS LIMITED
11/F, 51-53, Shantung Road, Kowloon, HONG KONG

WONG TUNG & PARTNERS LIMITED
610 Cheong Yee Road, Kowloon, HONG KONG

TEL: (852) 27778568 FAX: (852) 27778568

WONG TUNG & PARTNERS LIMITED
11/F, 51-53, Shantung Road, Kowloon, HONG KONG

WONG TUNG & PARTNERS LIMITED
610 Cheong Yee Road, Kowloon, HONG KONG

TEL: (852) 27778568 FAX: (852) 27778568