



工程指示 / 要求簡箋 ENGINEER INSTRUCTIONS(E.I.)

工程指示編號:	EI- 4806 A	修改版本:	A
	HK		
工程編號:	J 853	工程名稱:	大窩坪 (延坪道)
收件人:	Maggie Lor	發件人:	Lai Sik Hung
工程項目:	露台天花用鐵件 T5 大貨 (A=因天花新舊片版圖紙問題 導致鐵件修改)	日期:	16/08/2022

<input type="checkbox"/> 原合約工程包	<input type="checkbox"/> 原合約工程加 / 減賬 QT-	<input type="checkbox"/> 新工程報價 QT-
---------------------------------	--	------------------------------------

信件批核號碼/圖紙參考編號:	批核模具圖紙編號:
客戶指示附件:	管理內部批簽署:

<input type="checkbox"/> 初步鋁料 B.M.	<input type="checkbox"/> 加工拆圖, 然後生產	<input type="checkbox"/> 尺寸表
<input type="checkbox"/> 正式鋁料 B.M.	<input type="checkbox"/> 技術上資料/指示	<input type="checkbox"/> 報價
<input type="checkbox"/> 配件 B.M.	<input type="checkbox"/> 樣辦或貨品說明書	<input type="checkbox"/> 分判合約
<input type="checkbox"/> 其他:		

內容: 請根據附件之露台天花用BM表出貨, 第一批出貨(5-16/F) ~ 06/07/2022 第二批出貨(17/F以上) ~ 01/09/2022 需驗焊(100%目視,10%磁粉) 驗焊報告名稱: Superstructure - Aluminium Ceiling	修訂A=因天花新舊片版圖紙問題 導致鐵件修改
完成上列要求日期: 26/08/2022	

國內

<input type="checkbox"/> 生產技術總監	<input type="checkbox"/> 連附件	<input type="checkbox"/> 技術部	<input type="checkbox"/> 連附件	<input type="checkbox"/> 生產部	<input type="checkbox"/> 連附件
<input type="checkbox"/> 採購部	<input type="checkbox"/> 連附件	<input type="checkbox"/> 生產統籌部	<input type="checkbox"/> 連附件	<input type="checkbox"/> 報關組	<input type="checkbox"/> 連附件
<input type="checkbox"/> 質檢部	<input type="checkbox"/> 連附件	<input type="checkbox"/> 會計部	<input type="checkbox"/> 連附件	<input type="checkbox"/> 機械設計部	<input type="checkbox"/> 連附件
<input type="checkbox"/> 香港辦	<input type="checkbox"/> 連附件	<input type="checkbox"/> 其他:			

<input type="checkbox"/> 行政部	<input type="checkbox"/> 連附件	<input type="checkbox"/> 會計部	<input type="checkbox"/> 連附件	<input type="checkbox"/> 統籌部	<input type="checkbox"/> 連附件	<input type="checkbox"/> 工程部	<input type="checkbox"/> 連附件
<input checked="" type="checkbox"/> 採購部	<input checked="" type="checkbox"/> 連附件	<input type="checkbox"/> QS部	<input type="checkbox"/> 連附件	<input type="checkbox"/> 地盤管理	<input type="checkbox"/> 連附件	<input type="checkbox"/> 維修部	<input type="checkbox"/> 連附件


*發件人簽署:		*組別成員批核簽署:	
傳遞編號:		項目經理簽署:	

圖則登記表 DRAWING REGISTER														
工程名稱 Project Title: 錦上路/延平道		接收日期 Receiving Date (適用於客戶圖則)												
T5露臺天花鋁板地盤用鐵件項目		年												
工程編號 Project No: J-853		月												
分發予 Distributed To		日												
		年		22	22	22	22							
		月		02	03	03	08							
		日		10	10	24	05							
圖則編號 Drg. No.	圖則名稱 Drawing Title	修訂編號 Revision No.												
J853-CE-MS5-01	鐵件加工圖	1	-		A	B								
J853-CE-MS5-02	鐵件加工圖	2	-											
J853-CE-MS5-03	鐵件加工圖	3	-		A	B								
J853-CE-MS5-04	鐵件加工圖	4	-		A									
J853-CE-MS5-05	鐵件加工圖	5	-		A	取消								
J853-CE-MS5-06	鐵件加工圖	6	-		A									
J853-CE-MS5-07	鐵件加工圖	7	-		A									
J853-CE-MS5-08	鐵件加工圖	8	-			取消								
J853-CE-MS5-09	鐵件加工圖	9	-			取消								
J853-CE-MS5-10	鐵件加工圖	10	-		取消									
J853-CE-MS5-11	鐵件加工圖	11	-		取消									
J853-CE-MS5-11A	鐵件加工圖	12	-			新增								
J853-CE-MS5-12	鐵件加工圖	13	-		A	B								
J853-CE-MS5-13	鐵件加工圖	14	-		A									
J853-CE-MS5-14	鐵件加工圖	15	-		A									
J853-CE-MS5-15	鐵件加工圖	16	-	A		取消								
J853-CE-MS5-16	鐵件加工圖	17	-			取消								
J853-CE-MS5-17	鐵件加工圖	18	-			取消								
J853-CE-MS5-17A	鐵件加工圖	19	-			新增								
J853-CE-MS5-18	鐵件加工圖	20	-											
J853-CE-MS5-19	鐵件加工圖	21	-		A									
J853-CE-MS5-20	鐵件加工圖	22	-											
J853-CE-MS5-21	鐵件加工圖	23	-			取消								
J853-CE-MS5-22	鐵件加工圖	24	-		A									
J853-CE-MS5-23	鐵件加工圖	25	-			取消								
J853-CE-MS5-24	鐵件加工圖	26	-		A	B								
J853-CE-MS5-25	鐵件加工圖	27	-			新增								
J853-CE-MS5-26	鐵件加工圖	28	-			新增								
J853-CE-MS5-27	鐵件加工圖	29	-			新增								
J853-CE-MS5-28	鐵件加工圖	30	-		新增	A								
J853-CE-MS5-29	鐵件加工圖	31	-			新增								
J853-CE-MS5-30	鐵件加工圖	32	-			新增								
J853-CE-MS5-31	鐵件加工圖	33	-			新增								
J853-CE-MS5-32	鐵件加工圖	34	-			新增								
J853-CE-MS5-33	鐵件加工圖	35	-			新增								
J853-CE-MS5-34	鐵件加工圖	36	-			新增								
J853-SD-ALC-4501	鐵件位置圖	37	-											
J853-SD-ALC-4502	鐵件位置圖	38	-											
J853-SD-ALC-4503	鐵件位置圖	39	-											
J853-SD-ALC-4504	鐵件位置圖	40	-											
J853-SD-ALC-4505	鐵件位置圖	41	-											
J853-SD-ALC-4506	鐵件位置圖	42	-			B								
J853-SD-ALC-4507	鐵件位置圖	43	-											
J853-SD-ALC-4508	鐵件位置圖	44	-			B								
J853-SD-ALC-4509	鐵件位置圖	45	-	A										
J853-SD-ALC-4510	鐵件位置圖	46	-	A		B								
J853-SD-ALC-4511	鐵件位置圖	47	-			B								
J853-SD-ALC-4511A	鐵件位置圖	48	-			新增								
J853-SD-ALC-4512	鐵件位置圖	49	-			B								

序號		修改標示	配件圖號	物料編號	配件名稱	顏色	實用	後備	總數	單位	單件重量	總重量	備註
											KG		
1				T5-MS-01	100*100*8mm角鋼	热浸锌	34		34	件	11.834	402.356	L=970
2				T5-MS-02	100*100*8mm角鋼	热浸锌	34		34	件	9.272	315.248	L=760
3				T5-MS-03	100*100*8mm角鋼	热浸锌	26		26	件	25.254	656.604	L=2070
4				T5-MS-04	100*100*8mm角鋼	热浸锌	58		58	件	13.176	764.208	L=1080
5				T5-MS-05	100*100*8mm角鋼	热浸锌	18		18	件	18.239	328.302	L=1495
6	B-改尺寸			T5-MS-06	100*100*8mm角鋼	热浸锌	20		20	件	9.699	193.980	L=795
7	C-取消			T5-MS-07	100*100*8mm角鋼	热浸锌	0		0	件	15.616	0.000	L=1280
8	C-減少數量			T5-MS-08	100*100*8mm角鋼	热浸锌	24		24	件	11.224	269.376	L=920
9	C-減少數量			T5-MS-09	100*100*8mm角鋼	热浸锌	22		22	件	10.126	222.772	L=830
10	C-減少數量			T5-MS-10	100*100*8mm角鋼	热浸锌	8		8	件	30.744	245.952	L=2520
11				T5-MS-11	100*100*8mm角鋼	热浸锌	8		8	件	5.856	46.848	L=480
12	C-取消			T5-MS-12	100*100*8mm角鋼	热浸锌	0		0	件	8.296	0.000	L=680
13	B-改數量			T5-MS-16	100*100*8mm角鋼	热浸锌	12		12	件	5.551	66.612	L=455
14	C-取消		J853-CE-MS5-01	T5-MS-17	100*100*8mm角鋼	热浸锌	0		0	件	21.594	0.000	L=1770
15	C-取消			T5-MS-18	100*100*8mm角鋼	热浸锌	0		0	件	7.991	0.000	L=655
16	C-減少數量			T5-MS-20	100*100*8mm角鋼	热浸锌	24		24	件	27.694	664.656	L=2270
17	C-減少數量			T5-MS-21	100*100*8mm角鋼	热浸锌	24		24	件	29.524	708.576	L=2420
18	B-改數量			T5-MS-22	100*100*8mm角鋼	热浸锌	24		24	件	8.296	199.104	L=680
19	C-取消			T5-MS-23	100*100*8mm角鋼	热浸锌	0		0	件	10.736	0.000	L=880
20	C-減少數量			T5-MS-28	100*100*8mm角鋼	热浸锌	24		24	件	9.638	231.312	L=790
21	B-改數量			T5-MS-29	100*100*8mm角鋼	热浸锌	32		32	件	41.907	1341.024	L=3435
22	B-改數量			T5-MS-30	100*100*8mm角鋼	热浸锌	16		16	件	12.566	201.056	L=1030
23	B-改尺寸			T5-MS-31	100*100*8mm角鋼	热浸锌	32		32	件	19.642	628.544	L=1610
24	B-取消			T5-MS-34	100*100*8mm角鋼	热浸锌	0		0	件	3.050	0.000	L=250
25	C-減少數量			T5-MS-08A	100*100*8mm角鋼	热浸锌	22		22	件	10.614	233.508	L=870
26	C-新增			T5-MS-51	100*100*8mm角鋼	热浸锌	4		4	件	43.127	172.508	L=3535
27	C-新增			T5-MS-52	100*100*8mm角鋼	热浸锌	2		2	件	13.176	26.352	L=1080
28	C-新增			T5-MS-52	100*100*8mm角鋼	热浸锌	2		2	件	13.176	26.352	L=1080
29	C-新增			T5-MS-53	100*100*8mm角鋼	热浸锌	2		2	件	22.387	44.774	L=1835
30	C-新增			T5-MS-54	100*100*8mm角鋼	热浸锌	1		1	件	0.000	0.000	L=1040
31	C-新增			T5-MS-55	100*100*8mm角鋼	热浸锌	2		2	件	25.254	50.508	L=2070
32			J853-CE-MS5-02	T5-MS-13	100*100*8mm角鋼	热浸锌	10		10	件	11.224	112.240	L=920
33	C-減少數量		J853-CE-MS5-03	T5-MS-14	100*100*8mm角鋼	热浸锌	1		1	件	20.984	20.984	L=1720
34	B-改數量		J853-CE-MS5-04	T5-MS-15	100*100*8mm角鋼	热浸锌	12		12	件	24.400	292.800	L=1325+675(轉角)
35	C-取消		J853-CE-MS5-05	T5-MS-19	100*100*8mm角鋼	热浸锌	0		0	件	27.011	0.000	L=1325+735+154(轉角)
36	B-改數量		J853-CE-MS5-06	T5-MS-24	100*100*8mm角鋼	热浸锌	12		12	件	10.126	121.512	L=190+250+390(轉角)
37	B-改數量		J853-CE-MS5-07	T5-MS-25	100*100*8mm角鋼	热浸锌	12		12	件	10.126	121.512	L=190+250+390(轉角)
38	C-取消		J853-CE-MS5-08	T5-MS-26	100*100*8mm角鋼	热浸锌	0		0	件	10.126	0.000	L=190+250+390(轉角)
39	C-取消		J853-CE-MS5-09	T5-MS-27	100*100*8mm角鋼	热浸锌	0		0	件	10.126	0.000	L=190+250+390(轉角)
40	B-取消		J853-CE-MS5-10	T5-MS-32	100*100*8mm角鋼	热浸锌	0		0	件	14.762	0.000	L=1060+150(轉角)
41	B-取消		J853-CE-MS5-11	T5-MS-33	100*100*8mm角鋼	热浸锌	0		0	件	7.320	0.000	L=385+215(轉角)
42	C-新增		J853-CE-MS5-11A	T5-MS-56	100*100*8mm角鋼	热浸锌	1		1	件	17.568	17.568	L=490+400+550(轉角)
				T5-MS-801	100*50*6mm角鋼	热浸锌	17		17	件	5.814	98.838	L=850
				T5-MS-802	100*50*6mm角鋼	热浸锌	15		15	件	5.198	77.976	L=760
				T5-MS-803	100*50*6mm角鋼	热浸锌	12		12	件	13.338	160.056	L=1950
	B-改數量			T5-MS-804	100*50*6mm角鋼	热浸锌	18		18	件	4.446	80.028	L=650
				T5-MS-805	100*50*6mm角鋼	热浸锌	9		9	件	9.405	84.645	L=1375
	B-改數量			T5-MS-806	100*50*6mm角鋼	热浸锌	12		12	件	5.472	65.664	L=800
				T5-MS-807	100*50*6mm角鋼	热浸锌	3		3	件	6.498	19.494	L=950
	C-取消			T5-MS-808	100*50*6mm角鋼	热浸锌	0		0	件	7.387	0.000	L=1080
	B-取消			T5-MS-809	100*50*6mm角鋼	热浸锌	0		0	件	4.788	0.000	L=700
				T5-MS-810	100*50*6mm角鋼	热浸锌	4		4	件	16.416	65.664	L=2400
				T5-MS-811	100*50*6mm角鋼	热浸锌	4		4	件	4.104	16.416	L=600
			J853-CE-MS5-12	T5-MS-812	100*50*6mm角鋼	热浸锌	8		8	件	5.130	41.040	L=750
	C-減少數量			T5-MS-813	100*50*6mm角鋼	热浸锌	1		1	件	10.944	10.944	L=1600
	B-改數量			T5-MS-814	100*50*6mm角鋼	热浸锌	24		24	件	14.706	352.944	L=2150

美特鋁質有限公司 MIDI Aluminium Fabricator Ltd.		工程號:	J853	計算:	LHR	日期:	2022.02.10	送呈:				
		地盤名稱:	錦上路/延平道	核對:		日期:		副本:				
BM編號:		項目類別:	T5露臺天花鋁板地盤用鐵件BM			修改:	C-2022.07.31	總重量(kg):	11642.6			
序號	修改標示	配件圖號	物料編號	配件名稱	顏色	實用	後備	總數	單位 件	單件重量	總重量	備註
										KG		
	B-改數量		T5-MS-815	100*50*6mm角鋼	热浸锌	24		24	件	5.540	132.970	L=810
	C-取消		T5-MS-816	100*50*6mm角鋼	热浸锌	0		0	件	6.566	0.000	L=960
	B-改數量		T5-MS-821	100*50*6mm角鋼	热浸锌	16		16	件	23.085	369.360	L=3375
	B-改尺寸		T5-MS-823	100*50*6mm角鋼	热浸锌	16		16	件	10.602	169.632	L=1550
	B-新增		T5-MS-806A	100*50*6mm角鋼	热浸锌	11		11	件	5.130	56.430	L=750
	C-新增		T5-MS-851	100*50*6mm角鋼	热浸锌	2		2	件	24.179	48.359	L=3535
	C-新增		T5-MS-852	100*50*6mm角鋼	热浸锌	2		2	件	4.446	8.892	L=650
	C-新增		T5-MS-853	100*50*6mm角鋼	热浸锌	1		1	件	13.338	13.338	L=1950
	C-新增		T5-MS-854	100*50*6mm角鋼	热浸锌	1		1	件	6.498	6.498	L=950
	B-改數量	J853-CE-MS5-13	T5-MS-817	100*50*6mm角鋼	热浸锌	12		12	件	5.506	66.074	L=320+150+335(轉角)
	B-改數量	J853-CE-MS5-14	T5-MS-818	100*50*6mm角鋼	热浸锌	12		12	件	5.506	66.074	L=320+150+335(轉角)
	C-取消	J853-CE-MS5-15	T5-MS-819	100*50*6mm角鋼	热浸锌	0		0	件	6.293	0.000	L=435+150+335(轉角)
	C-取消	J853-CE-MS5-16	T5-MS-820	100*50*6mm角鋼	热浸锌	0		0	件	6.293	0.000	L=435+150+335(轉角)
	A-取消	J853-CE-MS5-17	T5-MS-822	100*100*6mm角鋼	热浸锌	0		0	件	6.085	0.000	L=660
	C-新增	J853-CE-MS5-17A	T5-MS-855	100*500*6mm角鋼	热浸锌	1		1	件	5.643	5.643	L=375+450(轉角)
		J853-CE-MS5-18	T5-MS-901	100*100*8角+50*35*6角	热浸锌	10		10	件	41.224	412.240	L=920
	B-改數量	J853-CE-MS5-19	T5-MS-902	75*50*6mm角鋼	热浸锌	13		13	件	6.605	85.859	L=460+650(轉角)
		J853-CE-MS5-20	T5-MS-903	75*50*6mm角鋼	热浸锌	4		4	件	3.630	14.518	L=610
	C-取消	J853-CE-MS5-21	T5-MS-904	75*50*6mm角鋼	热浸锌	0		0	件	4.522	0.000	L=760
	B-改數量	J853-CE-MS5-22	T5-MS-905	75*50*6mm角鋼	热浸锌	12		12	件	4.641	55.692	L=780
	C-取消	J853-CE-MS5-23	T5-MS-906	75*50*6mm角鋼	热浸锌	0		0	件	4.373	0.000	L=735
	C-減少數量	J853-CE-MS5-24	T5-MS-907	75*50*6mm角鋼	热浸锌	16		16	件	3.927	62.832	L=660
	B-新增	J853-CE-MS5-25	T5-MS-908	75*50*6mm角鋼	热浸锌	10		10	件	4.790	47.898	L=805
	B-新增	J853-CE-MS5-26	T5-MS-909	75*50*6mm角鋼	热浸锌	11		11	件	4.195	46.142	L=705
	B-新增	J853-CE-MS5-27	T5-MS-910	75*50*6mm角鋼	热浸锌	8		8	件	3.570	28.560	L=600
	C-增加數量	J853-CE-MS5-28	T5-MS-911	75*50*6mm角鋼+30*30*4角鋼	热浸锌	11		11	件	13.162	144.778	L=1600
								總計	843	件	11642.6	

修訂A : 共需取消48件, 新增28件


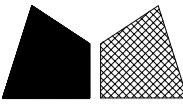


工程號 J853 地盤 錦上路


序號	物料編號	A	W	B	L	數量	使用位置	樓層
01	T5-MS-01	2	400	85	970	34	見派位圖	T5 FLAT A 6~23/F
02	T5-MS-02	2	300	80	760	34	見派位圖	T5 FLAT A 6~23/F
03	T5-MS-03	4	475	85	2070	26	見派位圖	T5 FLAT A,C 6~16/F
04	T5-MS-04	2	450	90	1080	58	見派位圖	T5 FLAT A,B,C 6~16,18~26/F
05	T5-MS-05	3	425	110	1495	18	見派位圖	T5 FLAT B 6~16/F
06	T5-MS-06	2	300	97.5	795	20	見派位圖	T5 FLAT B 6~17/F
07								
08	T5-MS-08	2	375	85	920	24	見派位圖	T5 FLAT F 12~26/F
09	T5-MS-09	2	350	65	830	22	見派位圖	T5 FLAT D 12~25/F
10	T5-MS-10	5	470	85	2520	8	見派位圖	T5 FLAT D 12~17/F
11	T5-MS-11	1	350	65	480	8	見派位圖	T5 FLAT D 12~17/F
12								
13	T5-MS-16	1	325	65	455	12	見派位圖	T5 FLAT E 12~26/F
14								
15								
16	T5-MS-20	4	500	135	2270	24	見派位圖	T5 FLAT E,F 12~26/F
17	T5-MS-21	5	450	85	2420	24	見派位圖	T5 FLAT E,F 12~26/F

序號	物料編號	A	W	B	L	數量	使用位置	樓層
18	T5-MS-22	1	500	90	680	24	見派位圖	T5 FLAT E,F 12~26/F
19								
20	T5-MS-28	2	300	95	790	24	見派位圖	T5 FLAT F 12~26/F
21	T5-MS-29	7	465	90	3435	32	見派位圖	T5 FLAT A 17~25/F
22	T5-MS-30	2	425	90	1030	16	見派位圖	T5 FLAT A 17~25/F
23	T5-MS-31	3	480	85	1610	32	見派位圖	T5 FLAT B 18~26/F
24								
25	T5-MS-08A	2	350	85	870	22	見派位圖	T5 FLAT D 12~25/F
26	T5-MS-51	7	475	105	3535	4	見派位圖	T5 FLAT A 26/F
27	T5-MS-52	2	450	90	1080	2	見派位圖	T5 FLAT A 26/F
28	T5-MS-52	2	450	90	1080	2	見派位圖	T5 FLAT B 17/F
29	T5-MS-53	4	400	117.5	1835	2	見派位圖	T5 FLAT B 17/F
30	T5-MS-54	2	450	70	1040	1	見派位圖	T5 FLAT B 17/F
31	T5-MS-55	4	475	85	2070	2	見派位圖	T5 FLAT B 17/F

送地盤

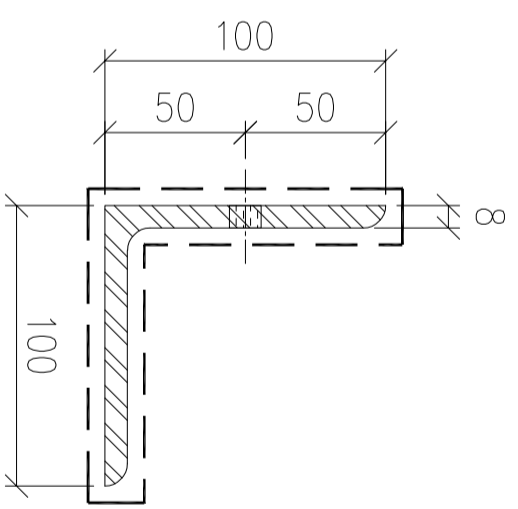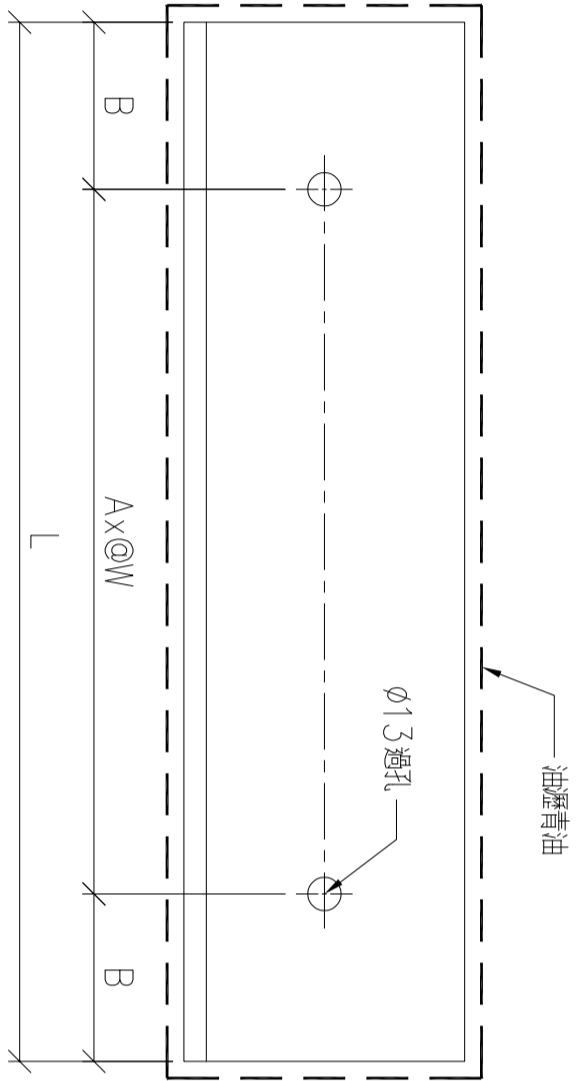

名稱	角鋼加工圖	制圖	LHR	2022.2.10	修改	A	B
材料	100x100x8mm厚角鋼 (S275)	復核	-	-	日期	2022.3.20	2022.7.31
顏色	熱浸鋅	批准			圖號	J853-CE-MS5-01	

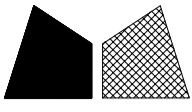




工程號

J853

地盤


錦上路

送地盤

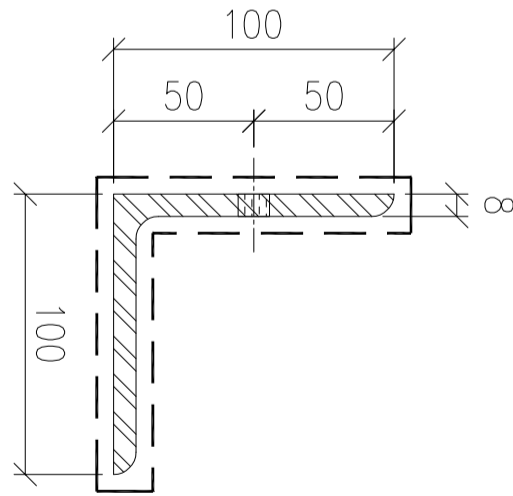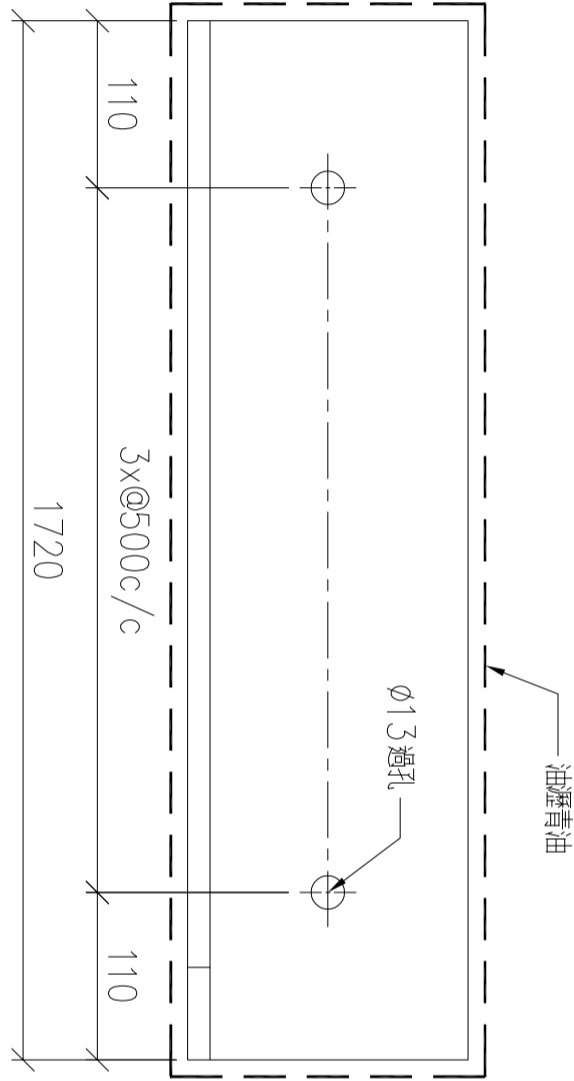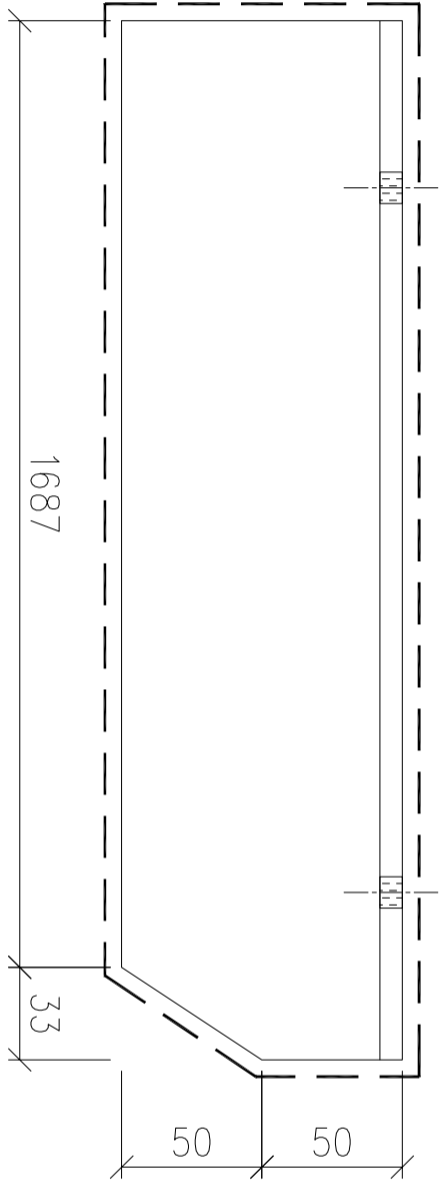

序號	物料編號	數量	使用位置	樓層
01	T5-MS-14	1	見派位圖	T5 FLAT E 26/F
02				
03				

名稱	角鋼加工圖	制圖	LHR	2022.2.10	修改	A	B
材料	100x100x8mm厚角鋼 (S275)	復核	-	-	日期	2022.3.23	2022.8.2
顏色	熱浸鋅	批准			圖號	J853-CE-MS5-03	

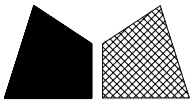



工程號

J853

地盤


錦上路

送地盤

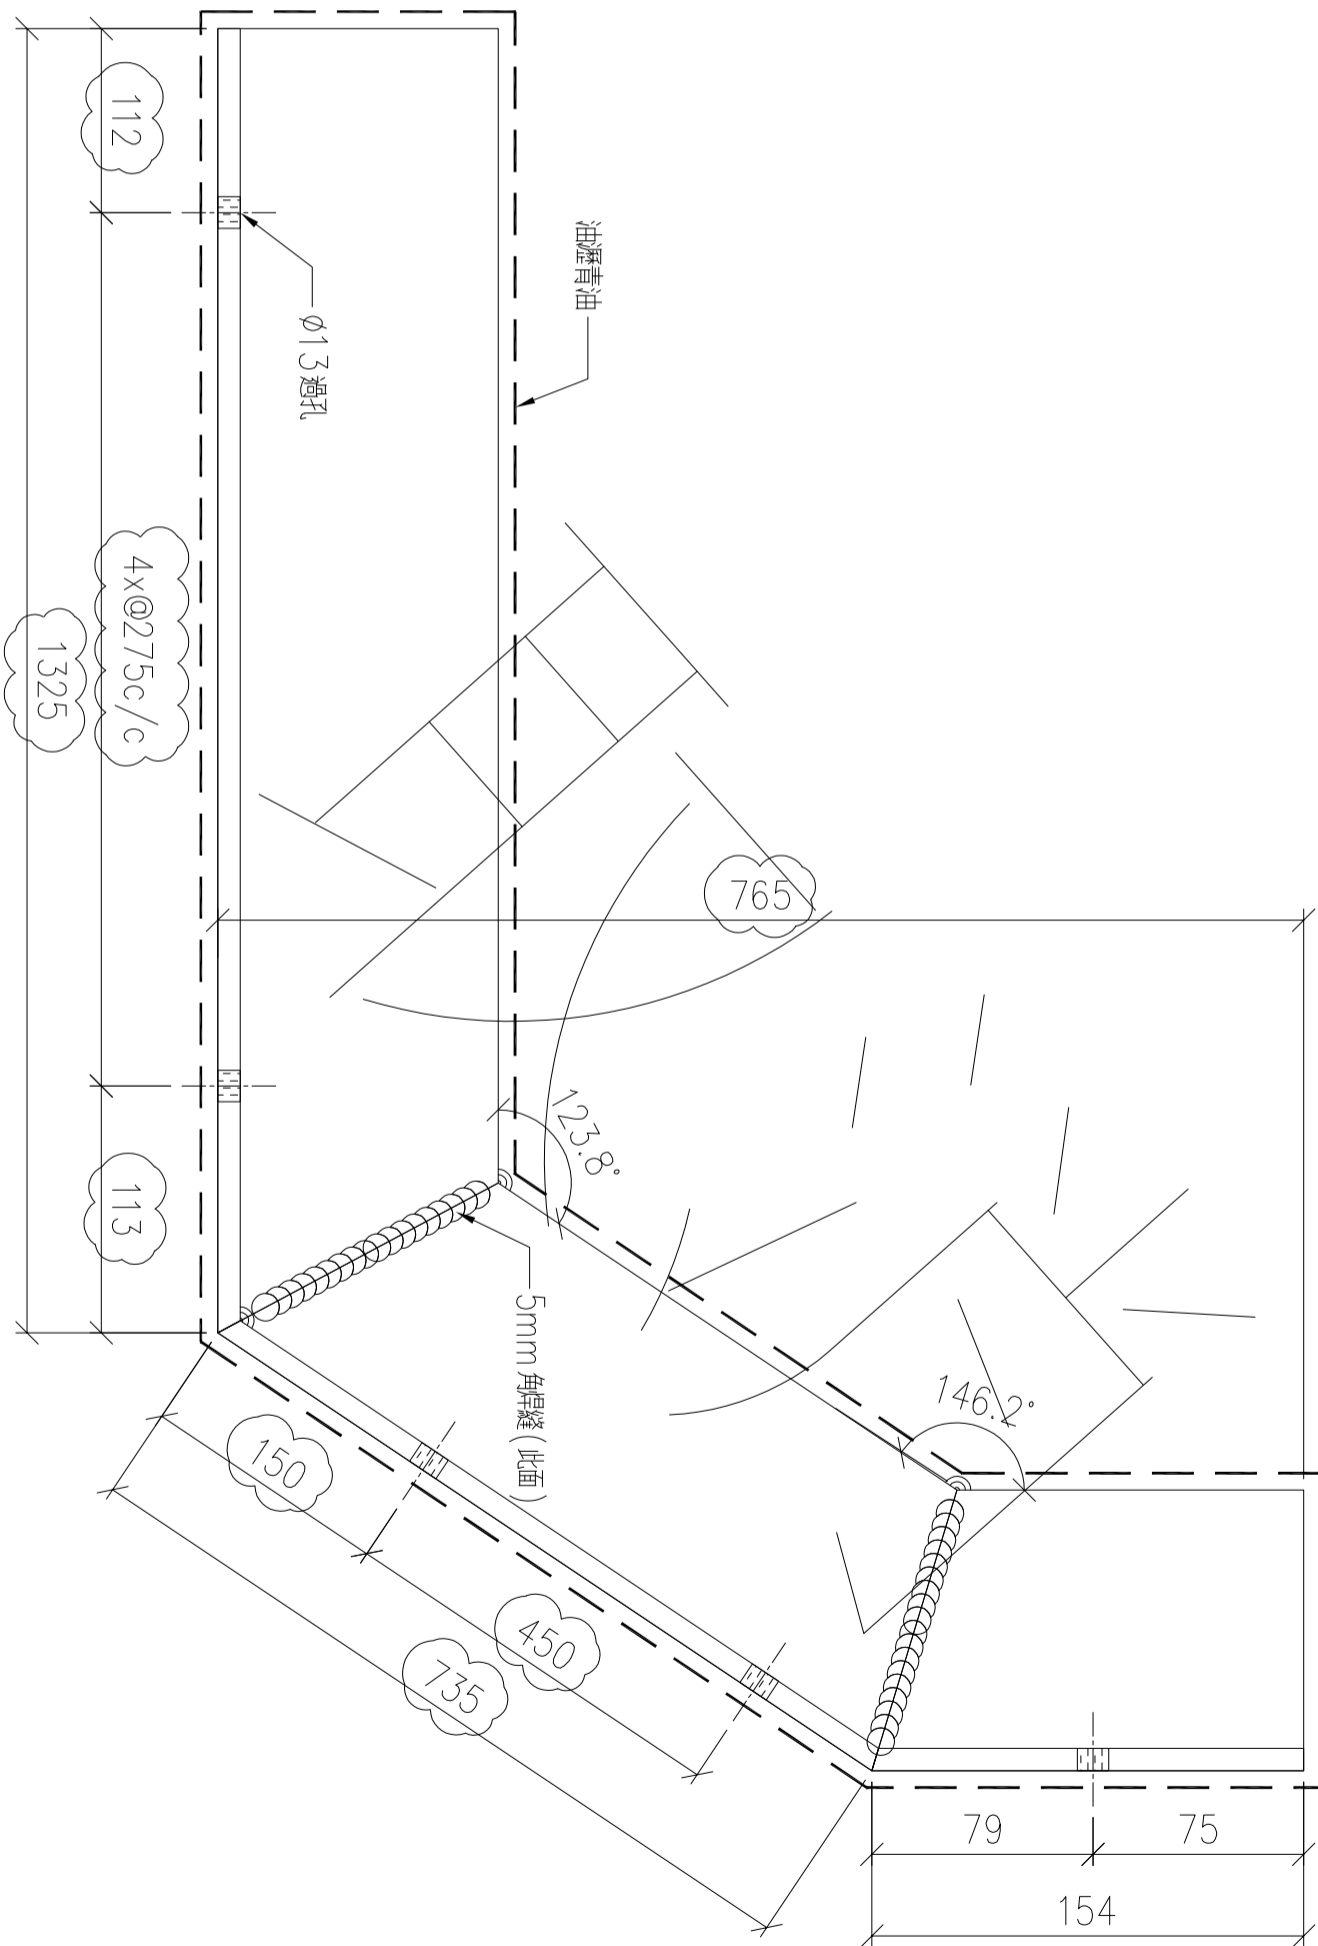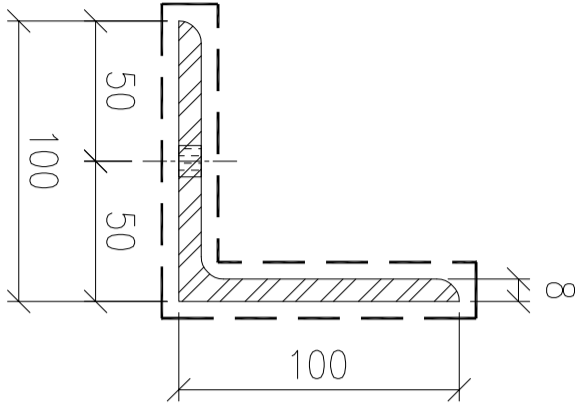

序號	物料編號	數量	使用位置	樓層
01	T5-MS-19	1	見派位圖	T5 FLAT E 11/F
02				
03				

名稱	角鋼加工圖	制圖	LHR	2022.2.10	修改	A	
材料	100x100x8mm厚角鋼 (S275)	復核	-	-	日期	2022.3.23	
顏色	熱浸鋅	批准			圖號	J853-CE-MS5-05	

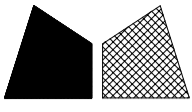


工程號

J853

地盤


錦上路

送地盤

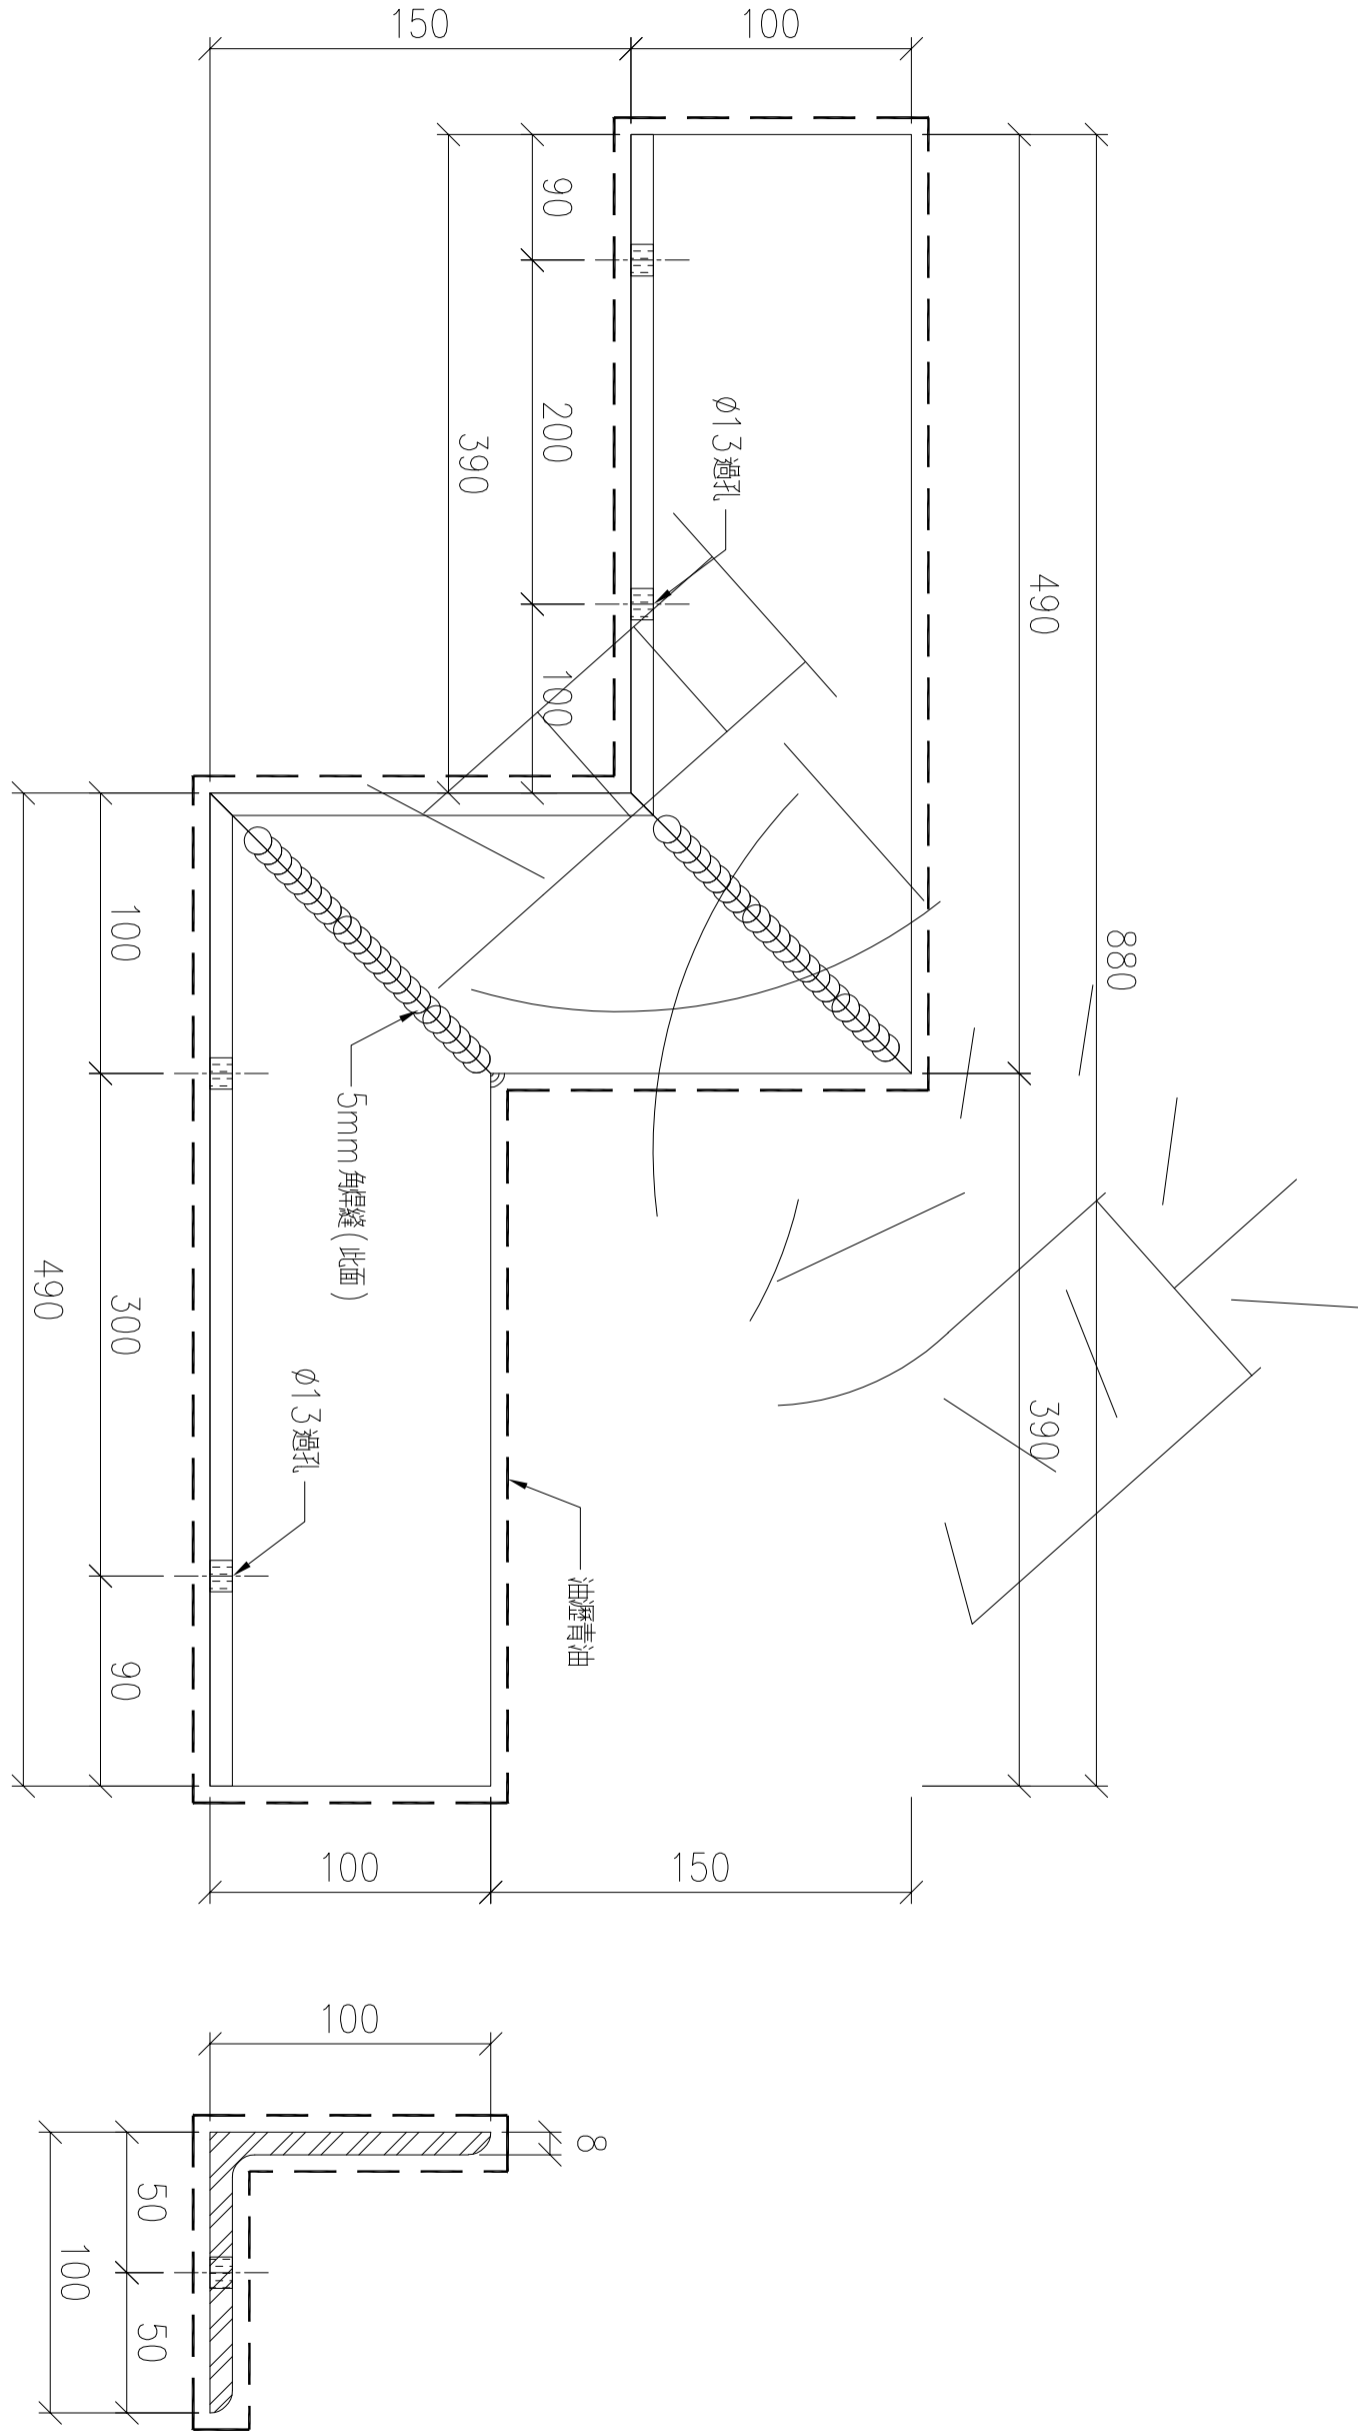

序號	物料編號	數量	使用位置	樓層
01	T5-MS-26	1	見派位圖	T5 FLAT E,F 11/F
02				
03				

名稱	角鋼加工圖	制圖	LHR	2022.2.10	修改		
材料	100x100x8mm厚角鋼 (S275)	復核	-	-	日期		
顏色	熱浸鋅	批准			圖號	J853-CE-MS5-08	

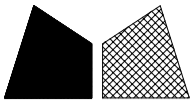


工程號

J853

地盤


錦上路

送地盤

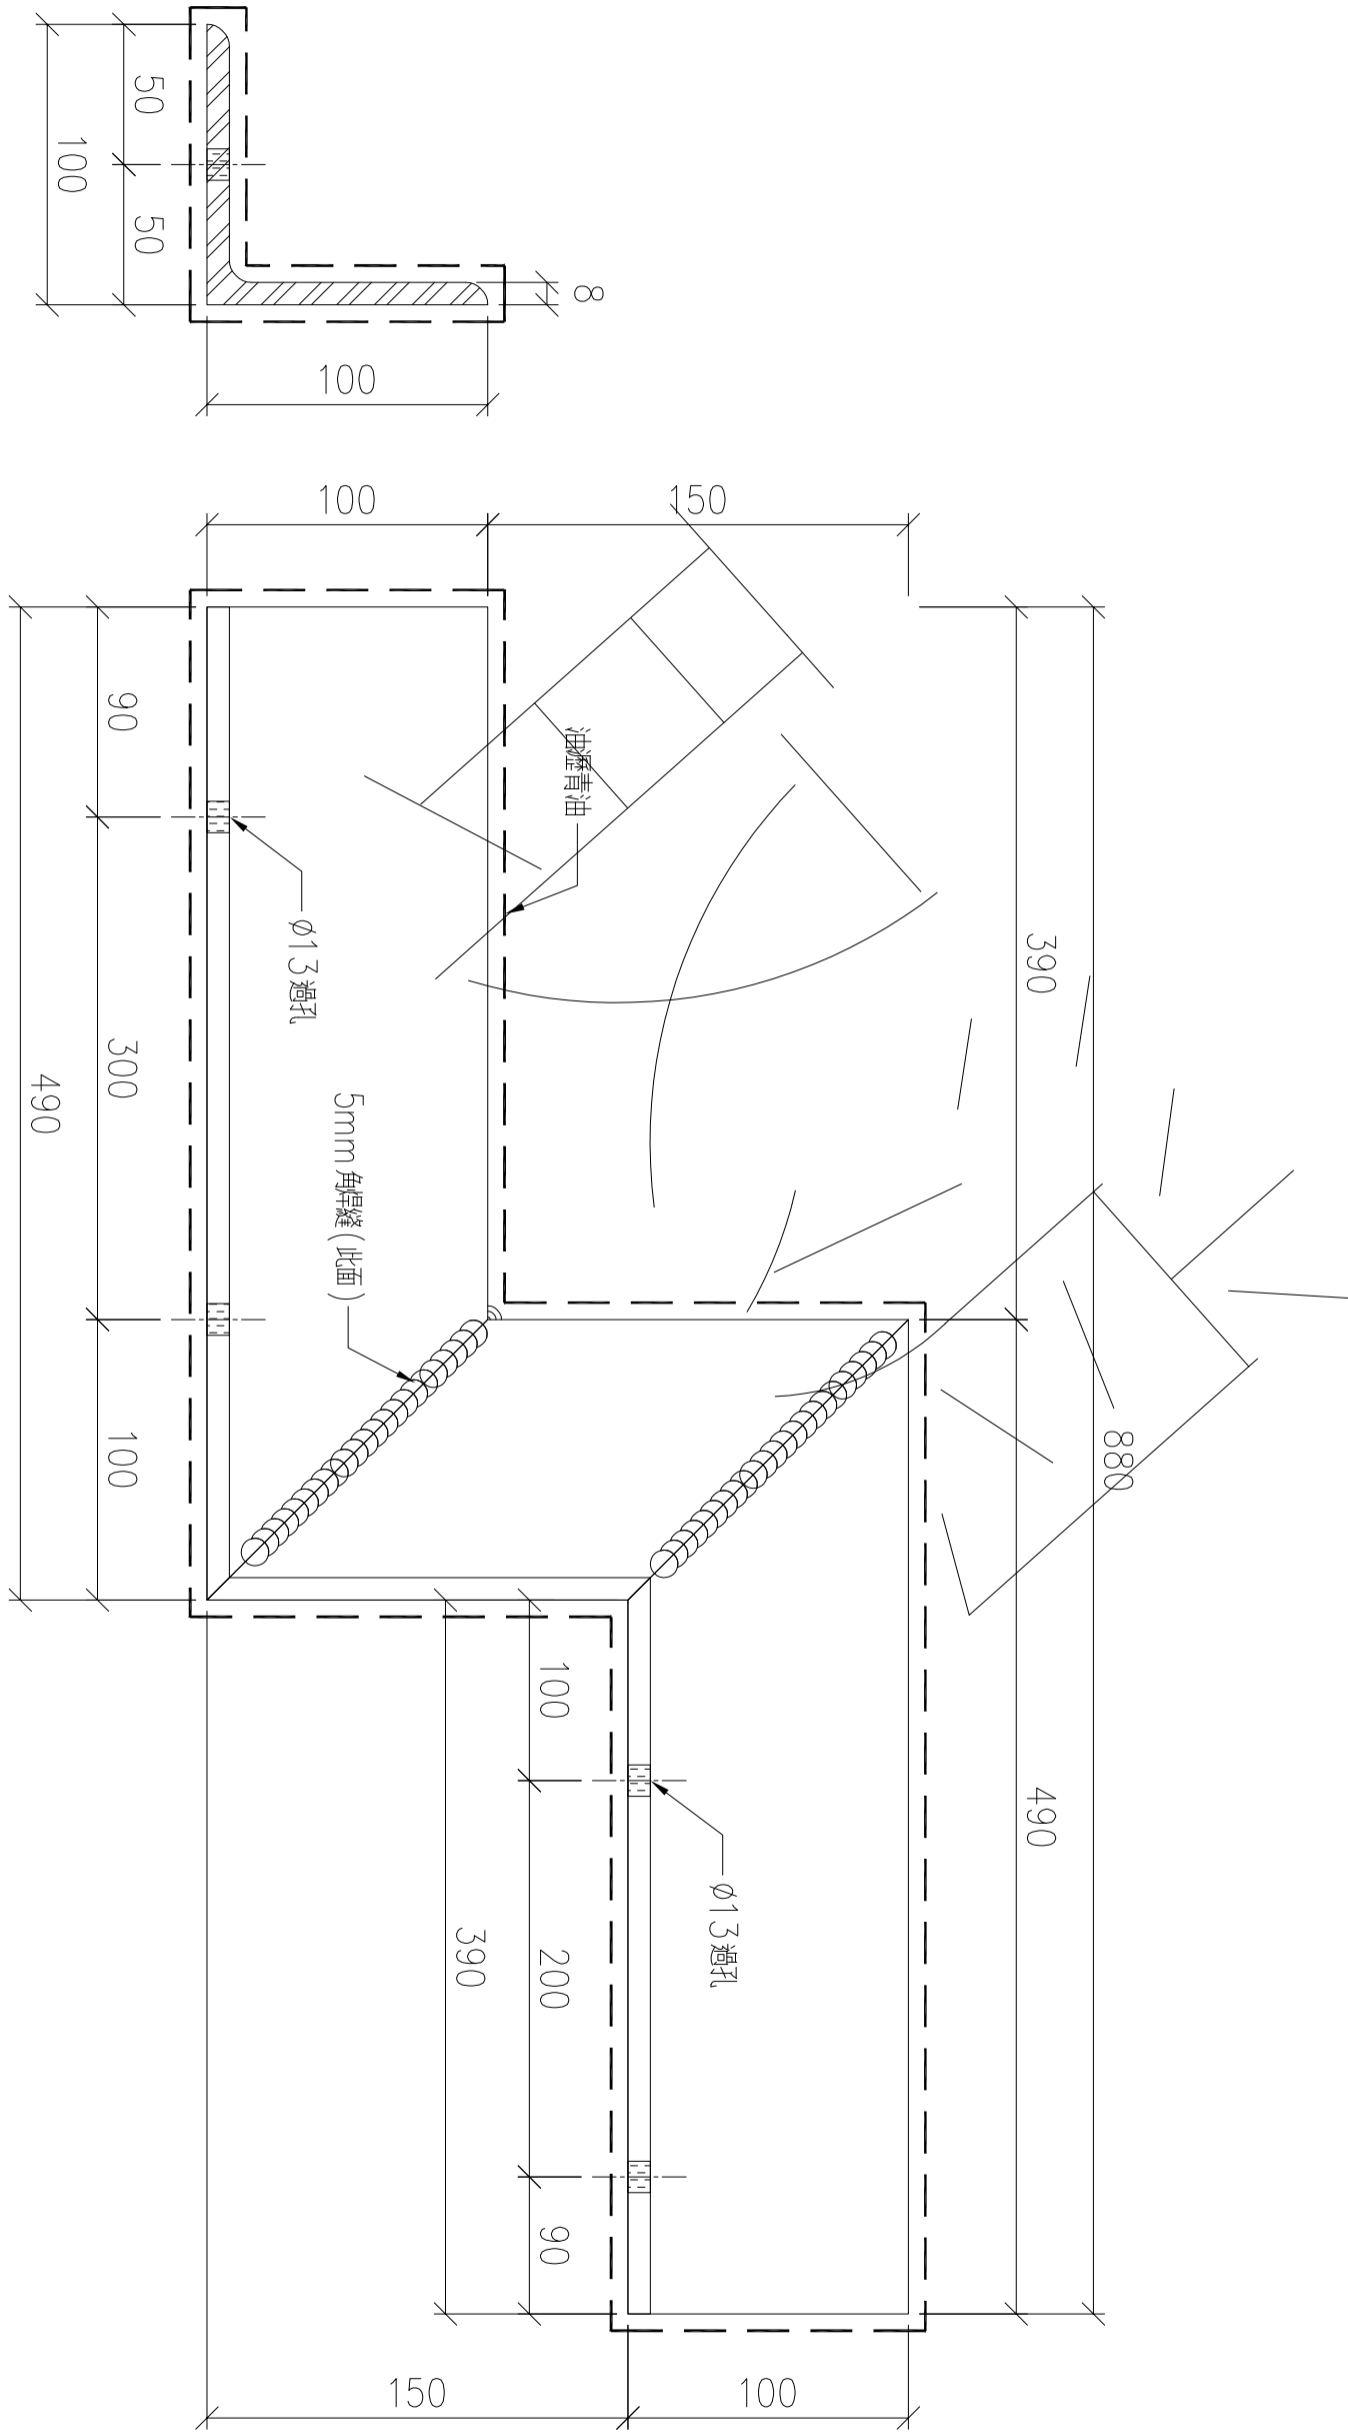

序號	物料編號	數量	使用位置	樓層
01	T5-MS-27	1	見派位圖	T5 FLAT E,F 11/F
02				
03				

名稱	角鋼加工圖	制圖	LHR	2022.2.10	修改		
材料	100x100x8mm厚角鋼 (S275)	復核	-	-	日期		
顏色	熱浸鋅	批准			圖號	J853-CE-MS5-09	

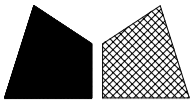


工程號

J853

地盤


錦上路

送地盤

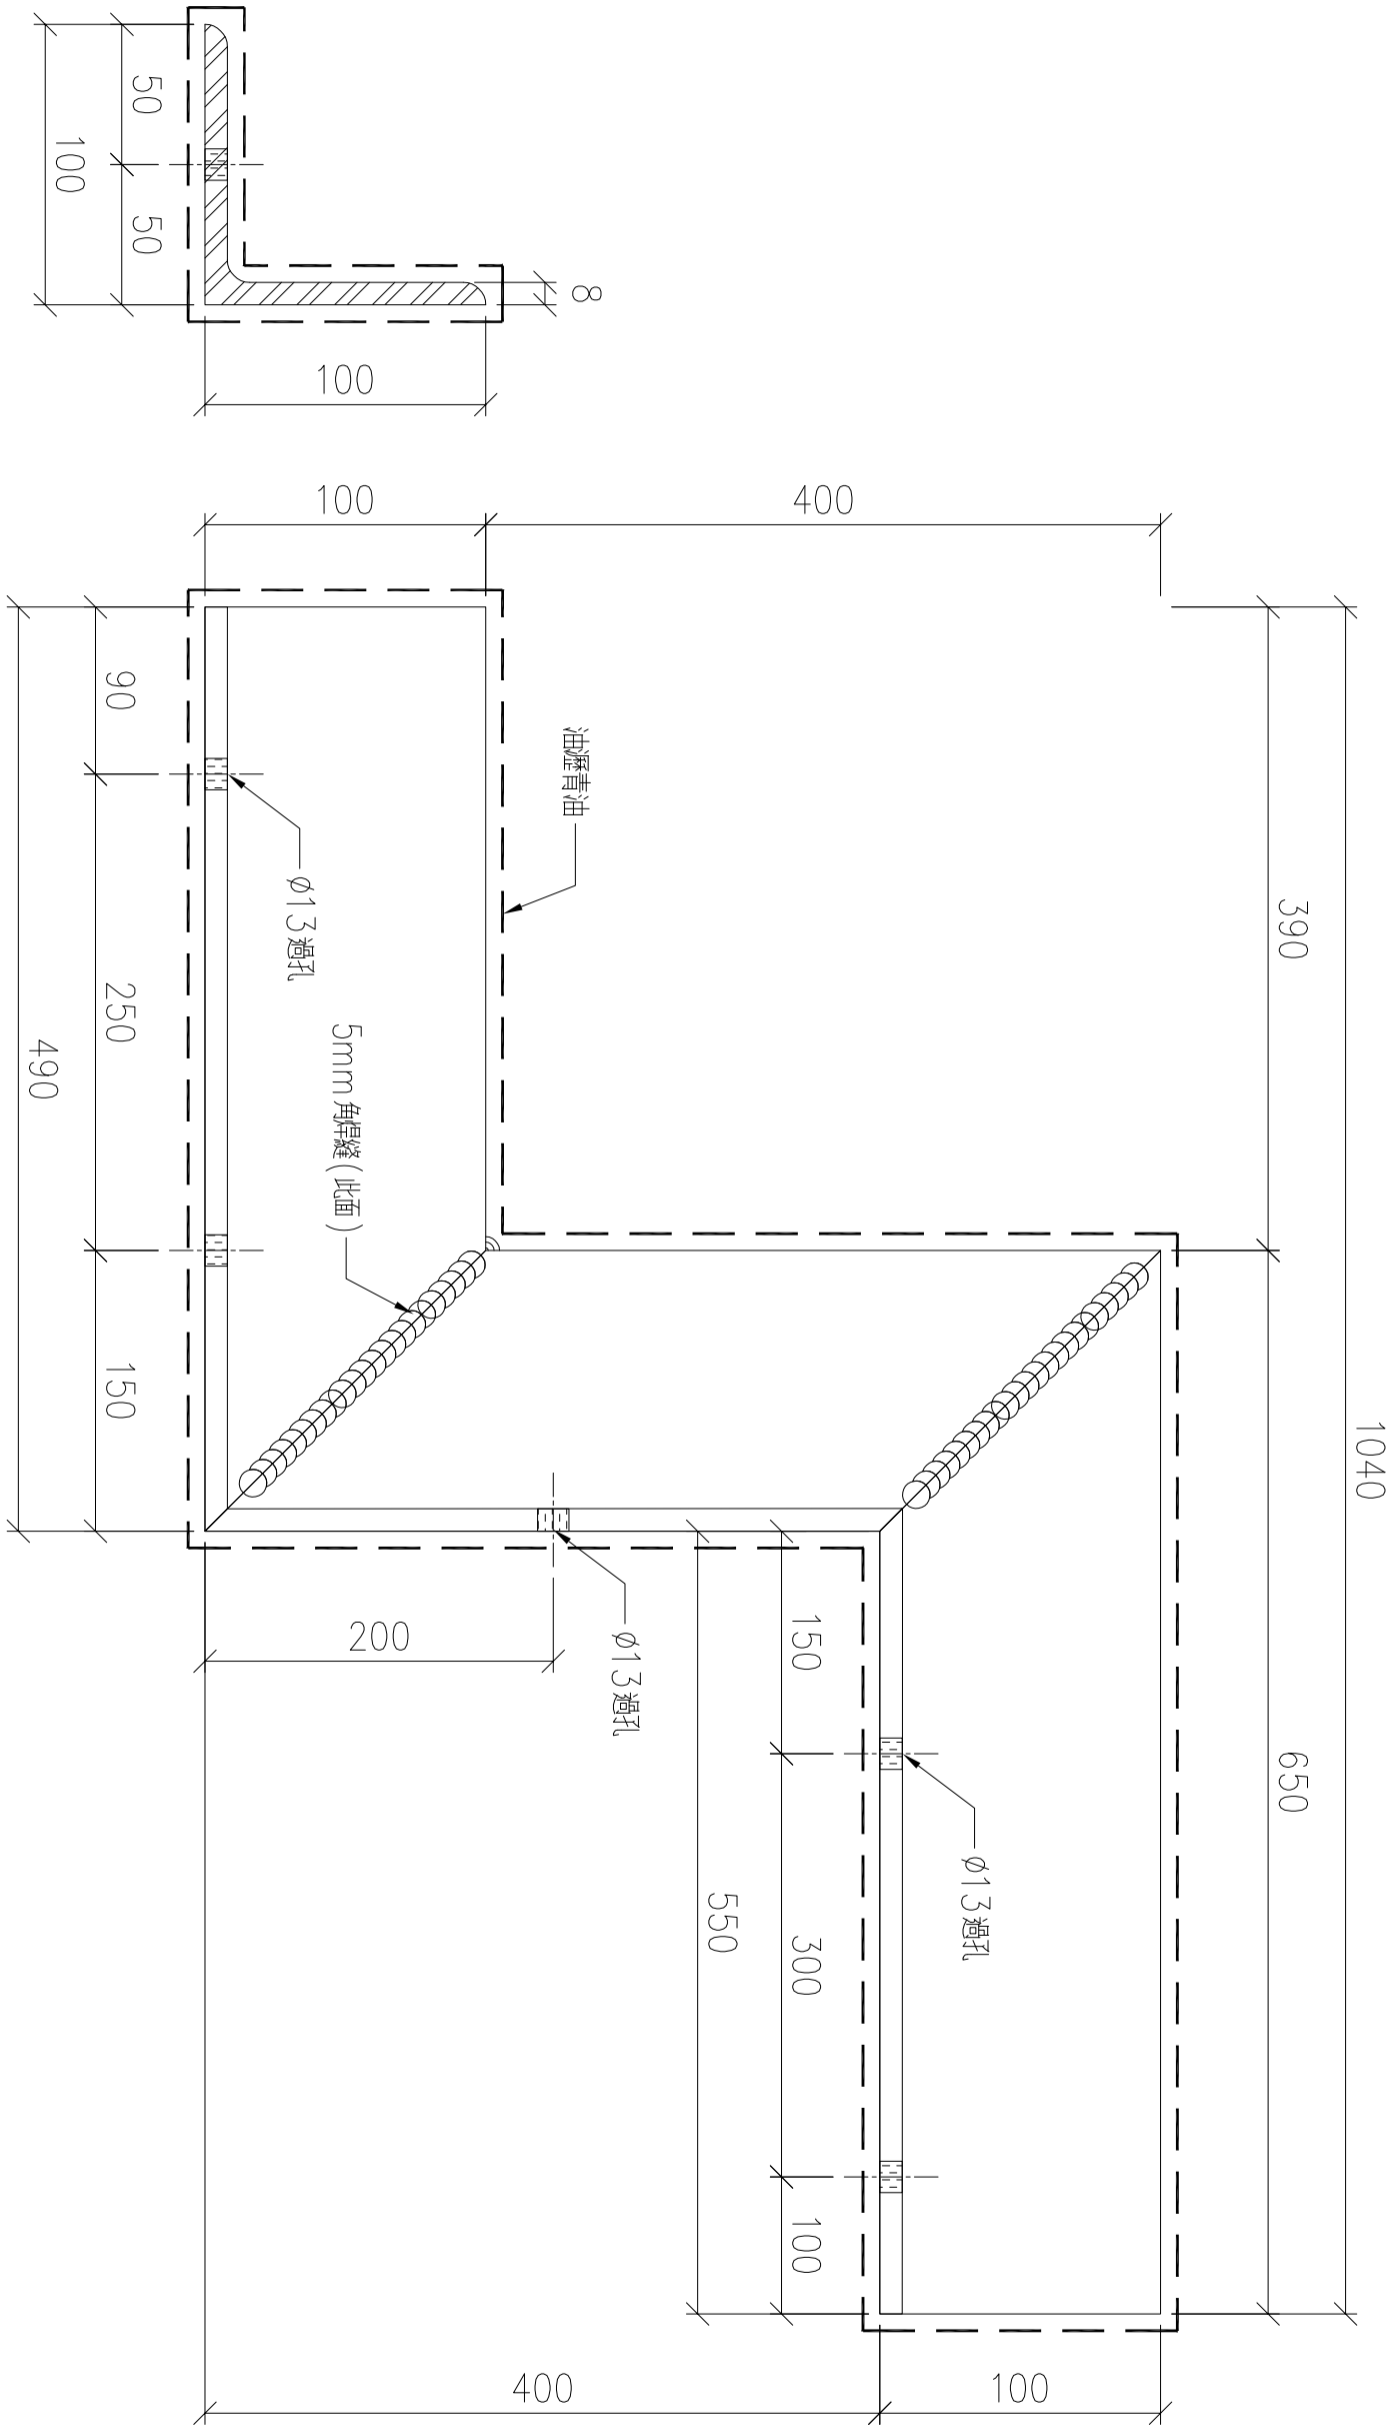

序號	物料編號	數量	使用位置	樓層
01	T5-MS-56	1	見派位圖	T5 FLAT B 17/F

名稱	角鋼加工圖	制圖	LHR	2022.7.31	修改		
材料	100x100x8mm厚角鋼 (S275)	復核	-	-	日期		
顏色	熱浸鋅	批准			圖號	J853-CE-MS5-11A	

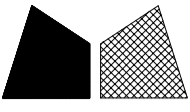



工程號

J853

地盤


錦上路

送地盤

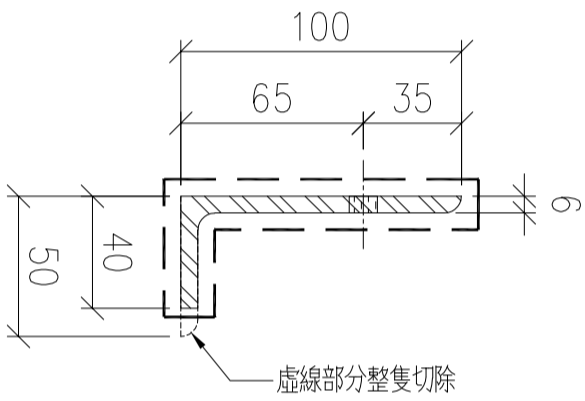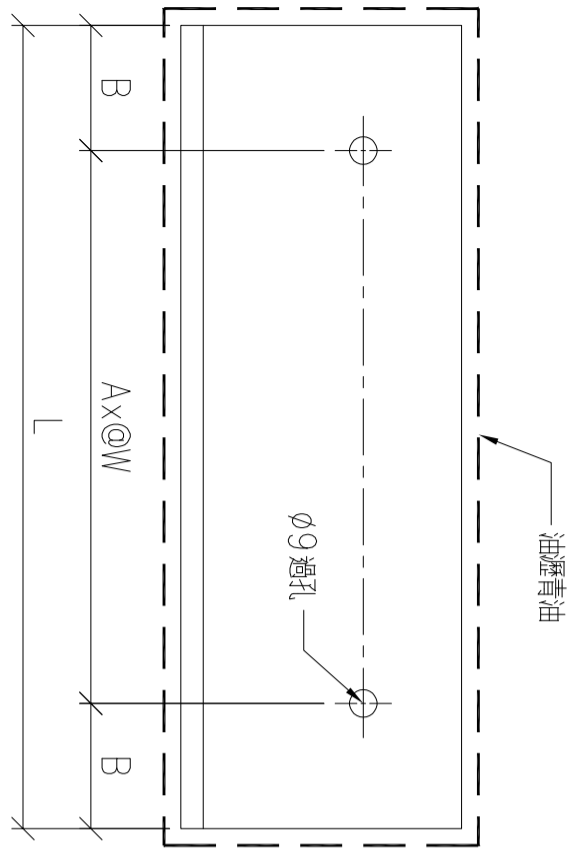

序號	物料編號	A	W	B	L	數量	使用位置	樓層
01	T5-MS-801	2	350	75	850	17	見派位圖	T5 FLAT A 6~23/F
02	T5-MS-802	2	300	80	760	15	見派位圖	T5 FLAT A,F 6~17/F
03	T5-MS-803	4	450	75	1950	12	見派位圖	T5 FLAT A,C 6~17/F
04	T5-MS-804	2	250	75	650	18	見派位圖	T5 FLAT A,B 6~17/F
05	T5-MS-805	3	400	87.5	1375	9	見派位圖	T5 FLAT A 6~17/F
06	T5-MS-806	2	300	100	800	12	見派位圖	T5 FLAT F 12~26/F
07	T5-MS-807	2	400	75	950	3	見派位圖	T5 FLAT C 12~16/F
08								
09								
10	T5-MS-810	5	450	75	2400	4	見派位圖	T5 FLAT D 12~17/F
11	T5-MS-811	2	250	50	600	4	見派位圖	T5 FLAT D 12~17/F
12	T5-MS-812	2	300	75	750	8	見派位圖	T5 FLAT A,D 11,17~23/F
13	T5-MS-813	3	500	50	1600	1	見派位圖	T5 FLAT E 26/F
14	T5-MS-814	4	500	75	2150	24	見派位圖	T5 FLAT E,F 12~26/F
15	T5-MS-815	2	300	105	810	24	見派位圖	T5 FLAT E,F 12~26/F
16								
17	T5-MS-821	7	465	60	3375	16	見派位圖	T5 FLAT A 17~25/F
18	T5-MS-823	3	450	100	1550	16	見派位圖	T5 FLAT B 18~26/F
19	T5-MS-806A	2	300	75	750	11	見派位圖	T5 FLAT D 12~25/F
20	T5-MS-851	7	475	105	3535	2	見派位圖	T5 FLAT A 26/F
21	T5-MS-852	2	250	75	650	2	見派位圖	T5 FLAT A 26/F
22	T5-MS-853	4	450	75	1950	1	見派位圖	T5 FLAT B 17/F
23	T5-MS-854	2	400	75	950	1	見派位圖	T5 FLAT B 17/F

名稱	角鋼加工圖	制圖	LHR	2022.2.10	修改	A	B
材料	100x50x6mm厚角鋼 (S275)	復核	-	-	日期	2022.3.20	2022.7.31
顏色	熱浸鋅	批准			圖號	J853-CE-MS5-12	

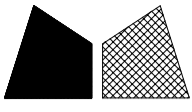


工程號

J853

地盤


錦上路

送地盤

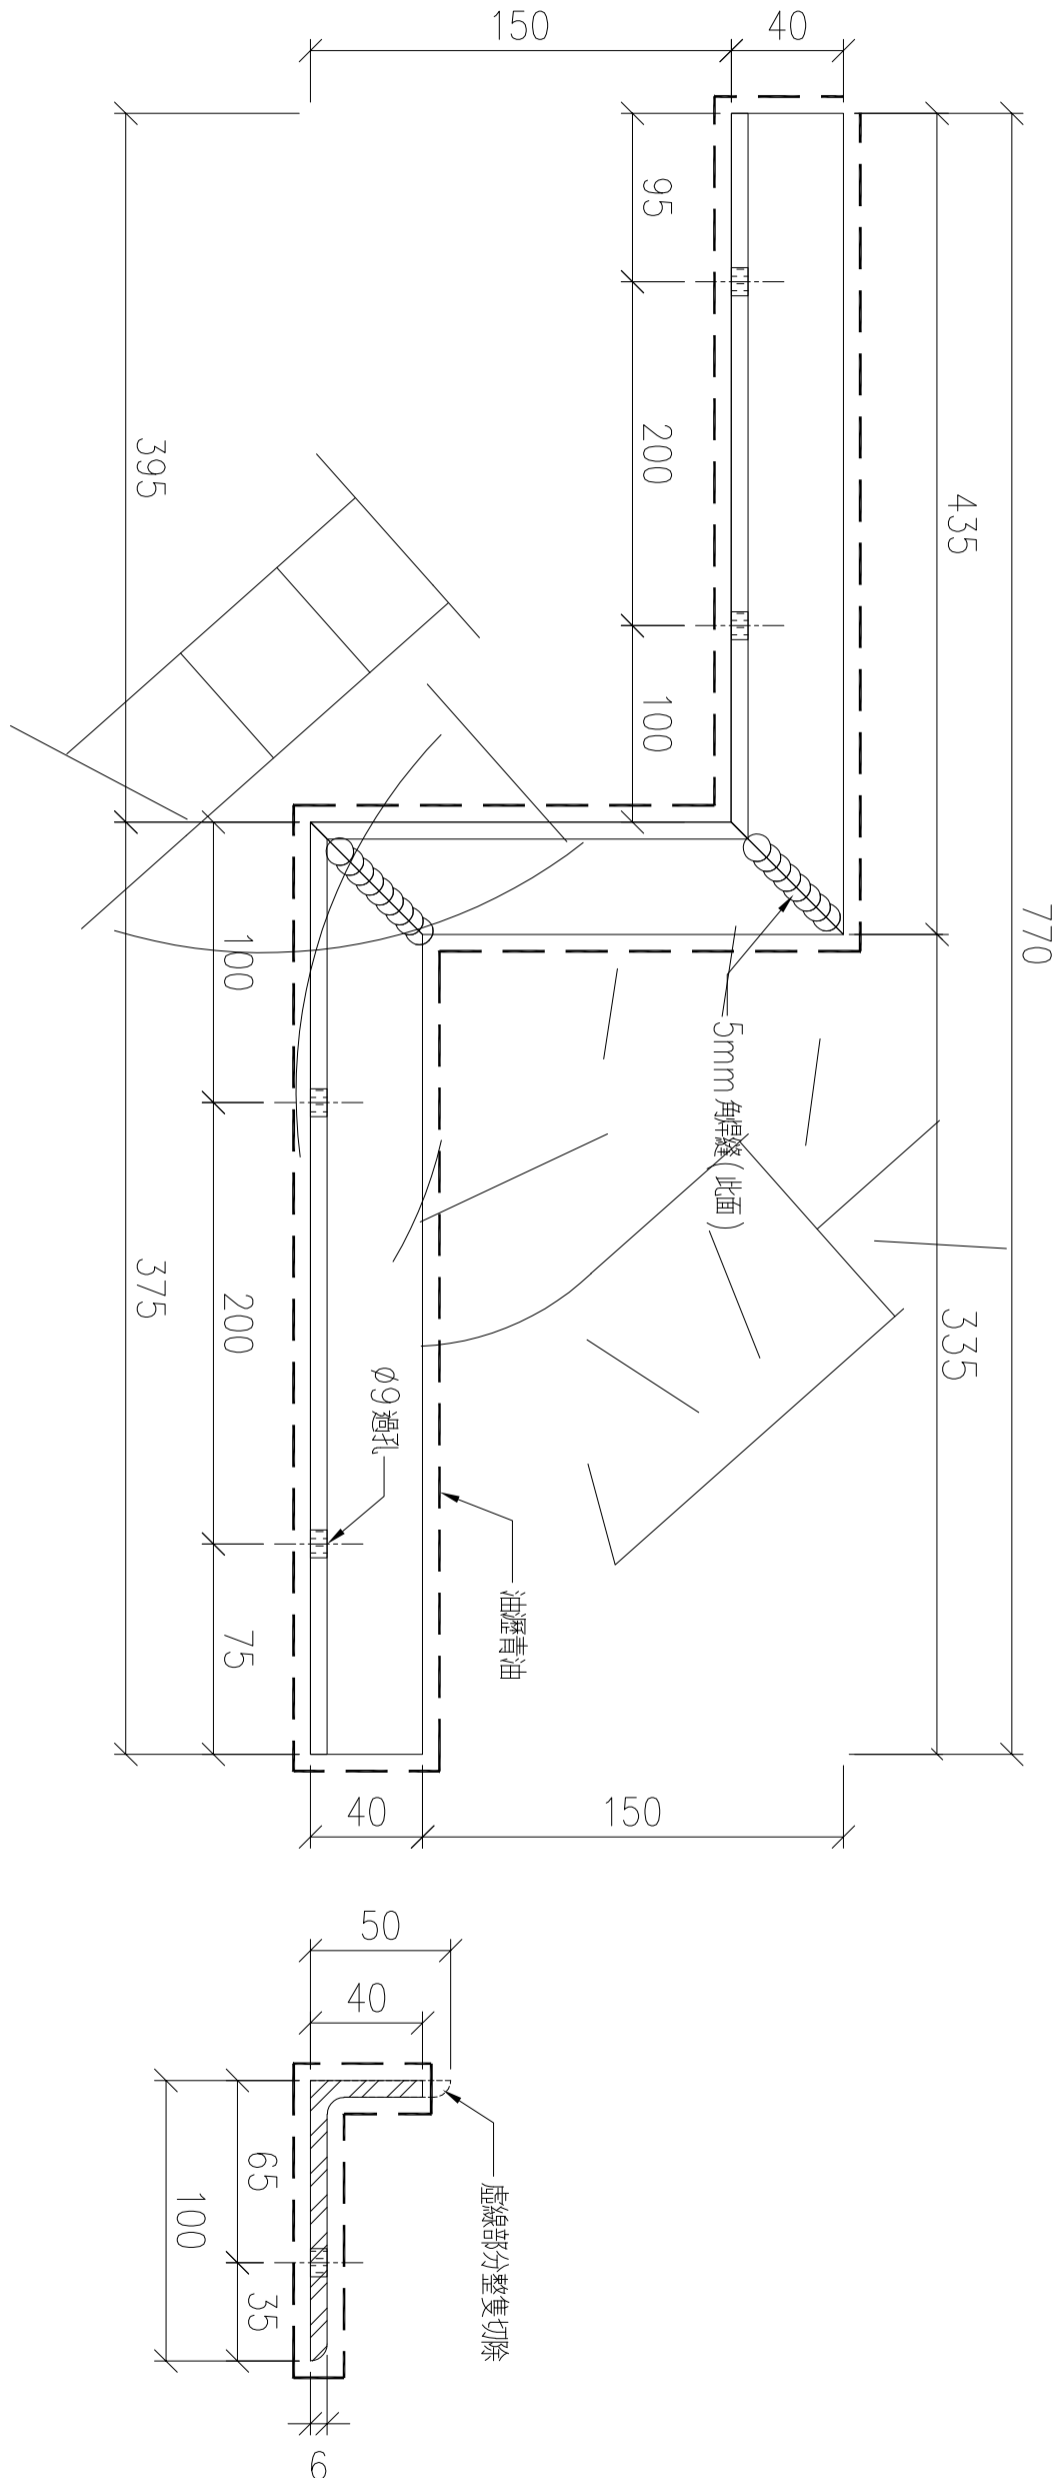

序號	物料編號	數量	使用位置	樓層
01	T5-MS-819	1	見派位圖	T5 FLAT E,F 11/F
02				
03				

名稱	角鋼加工圖	制圖	LHR	2022.2.10	修改		
材料	100x50x6mm厚角鋼 (S275)	復核	-	-	日期		
顏色	熱浸鋅	批准			圖號	J853-CE-MS5-15	

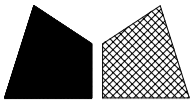


工程號

J853

地盤


錦上路

送地盤

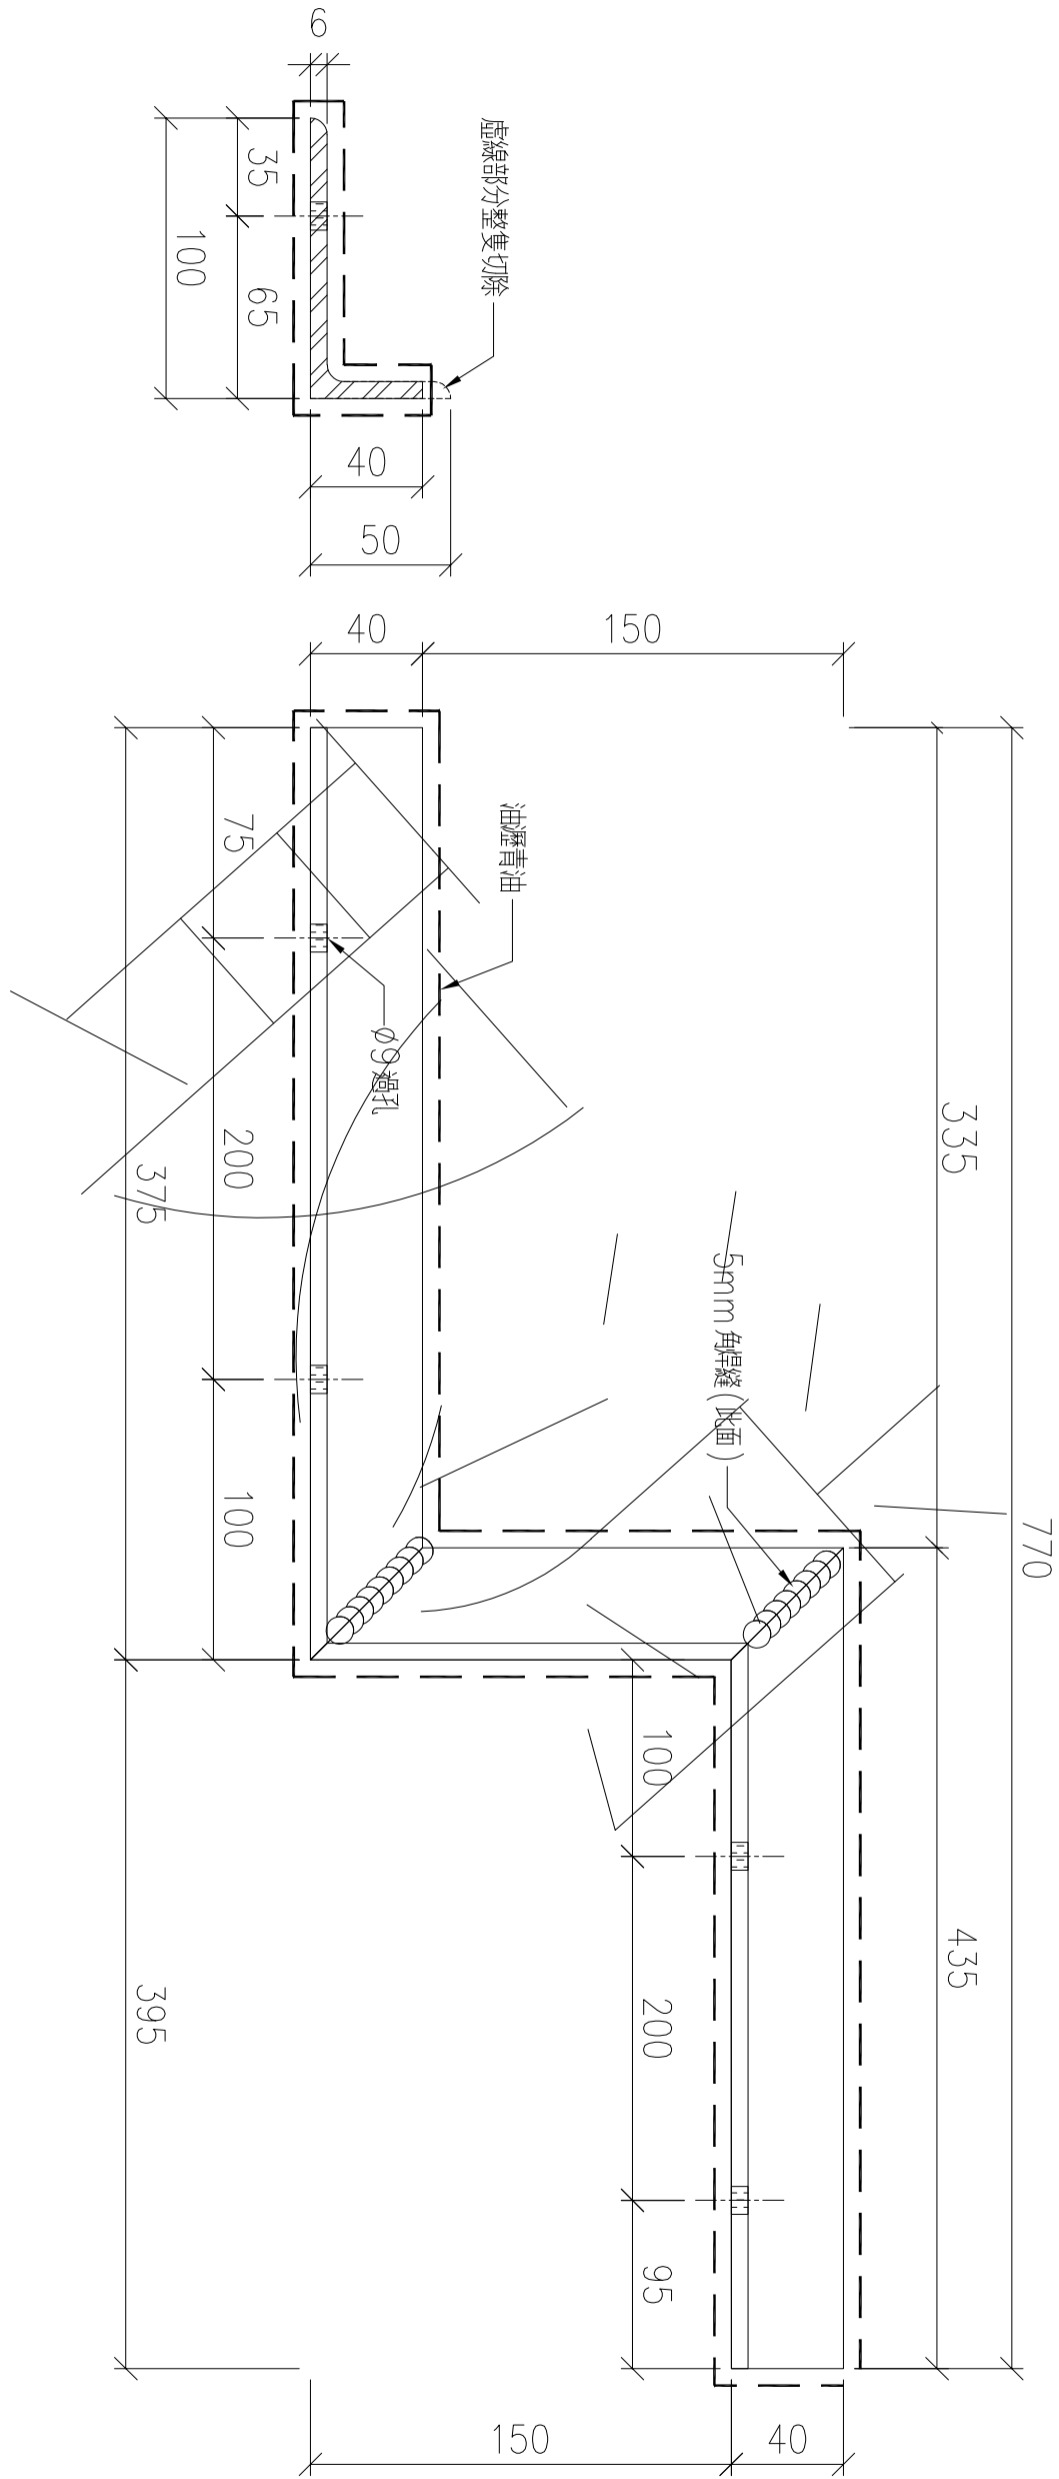

序號	物料編號	數量	使用位置	樓層
01	T5-MS-820	1	見派位圖	T5 FLAT E,F 11/F
02				
03				

名稱	角鋼加工圖	制圖	LHR	2022.2.10	修改		
材料	100x50x6mm厚角鋼 (S275)	復核	-	-	日期		
顏色	熱浸鋅	批准			圖號	J853-CE-MS5-16	

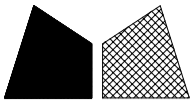


工程號

J853

地盤


錦上路

送地盤

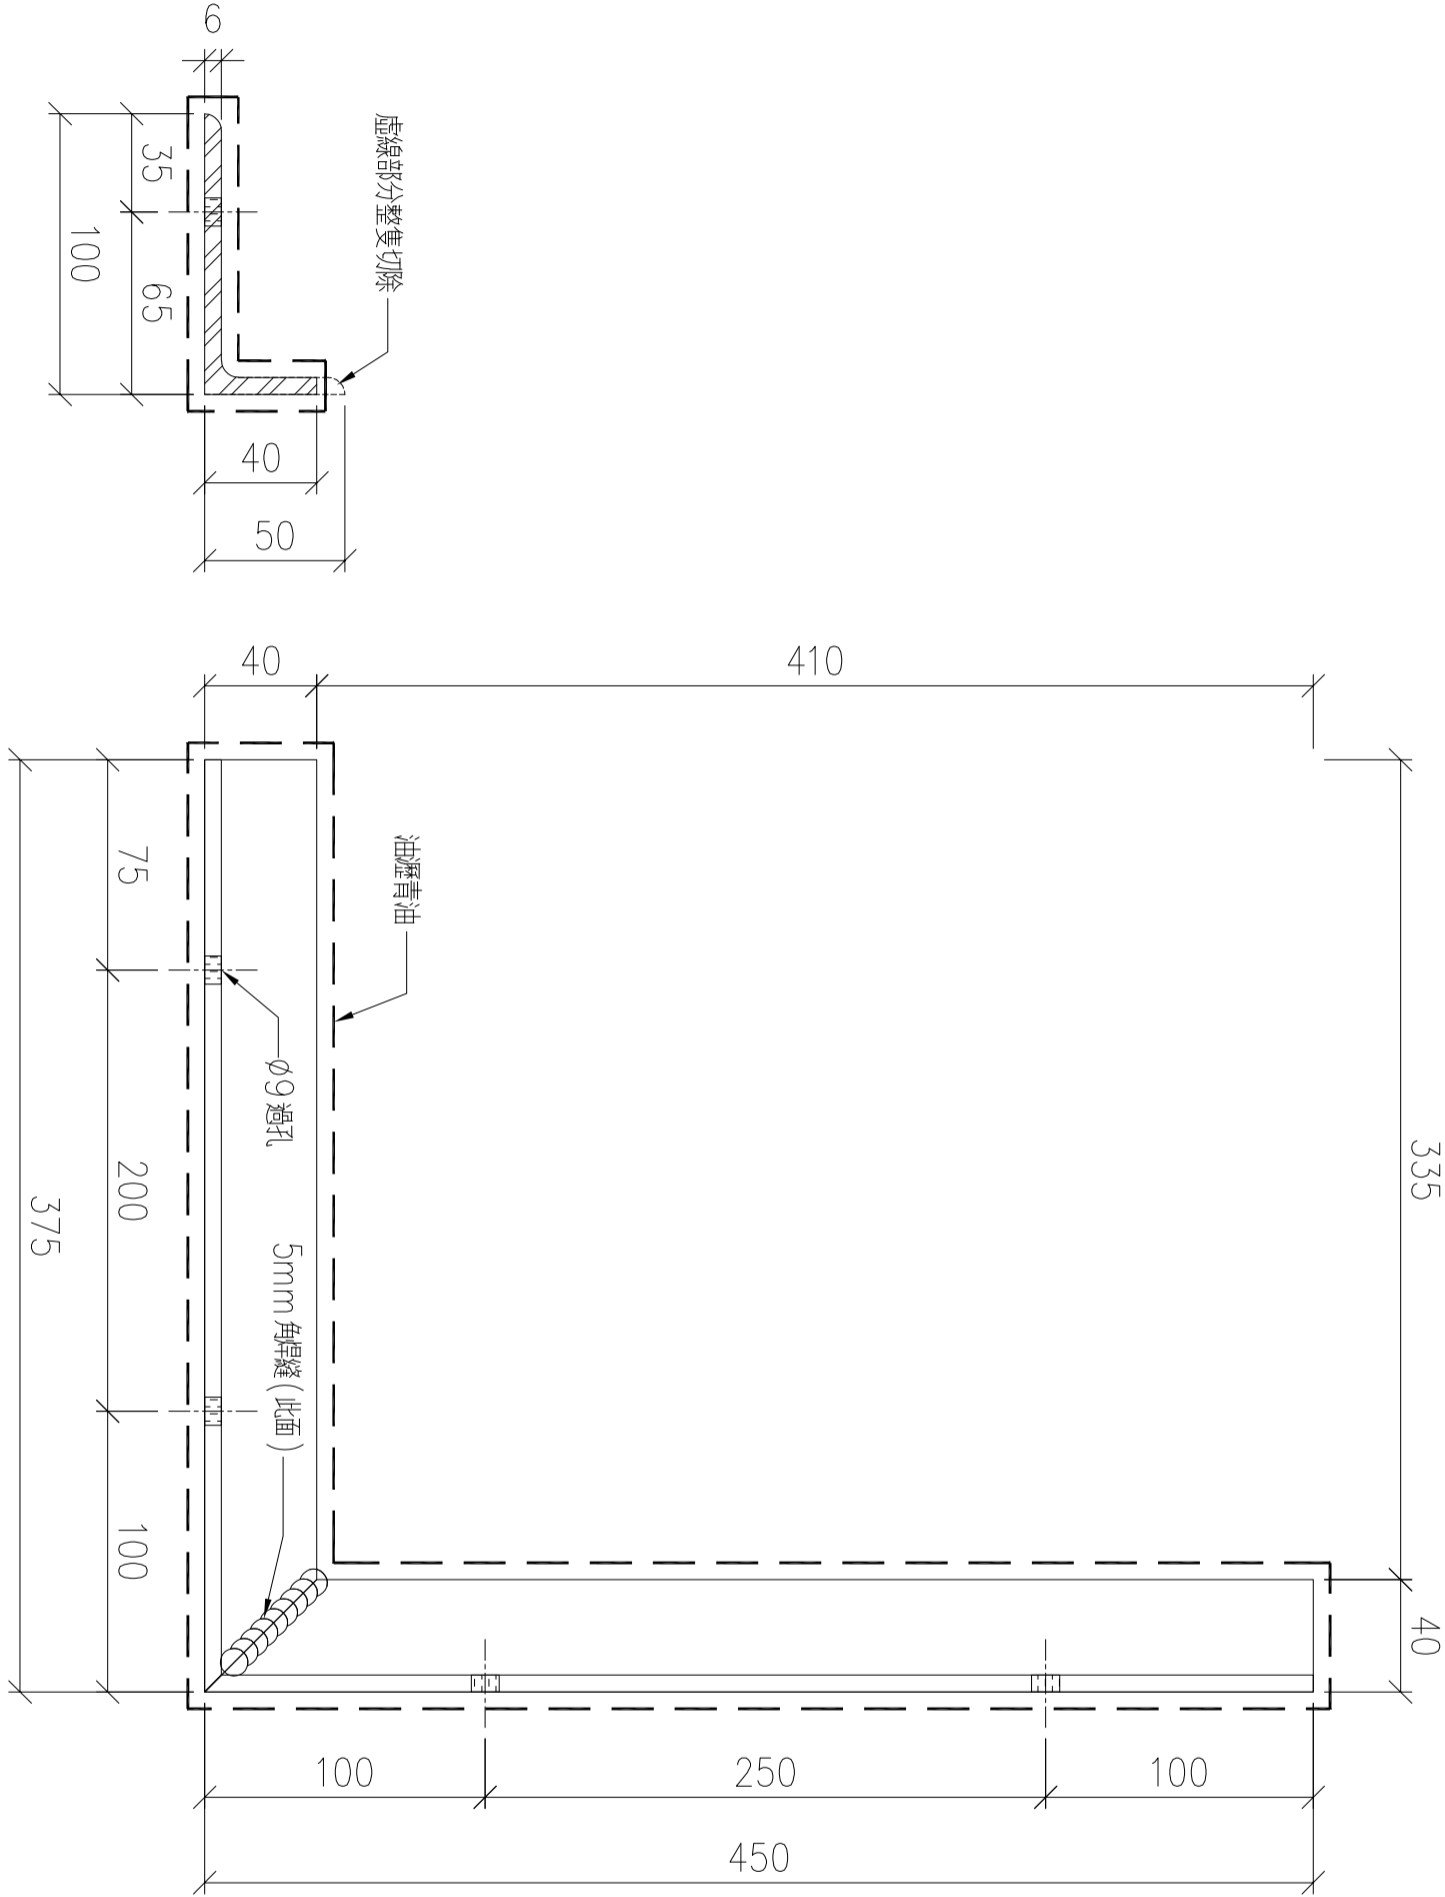

序號	物料編號	數量	使用位置	樓層
01	T5-MS-855	1	見派位圖	T5 FLAT B 17/F

名稱	角鋼加工圖	制圖	LHR	2022.7.31	修改		
材料	100x50x6mm厚角鋼 (S275)	復核	-	-	日期		
顏色	熱浸鋅	批准			圖號	J853-CE-MS5-17A	

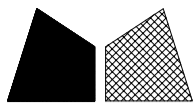



工程號

J853

地盤


錦上路

送地盤

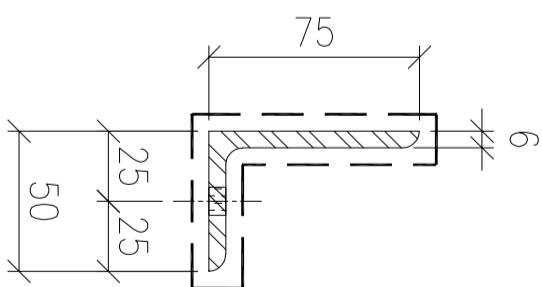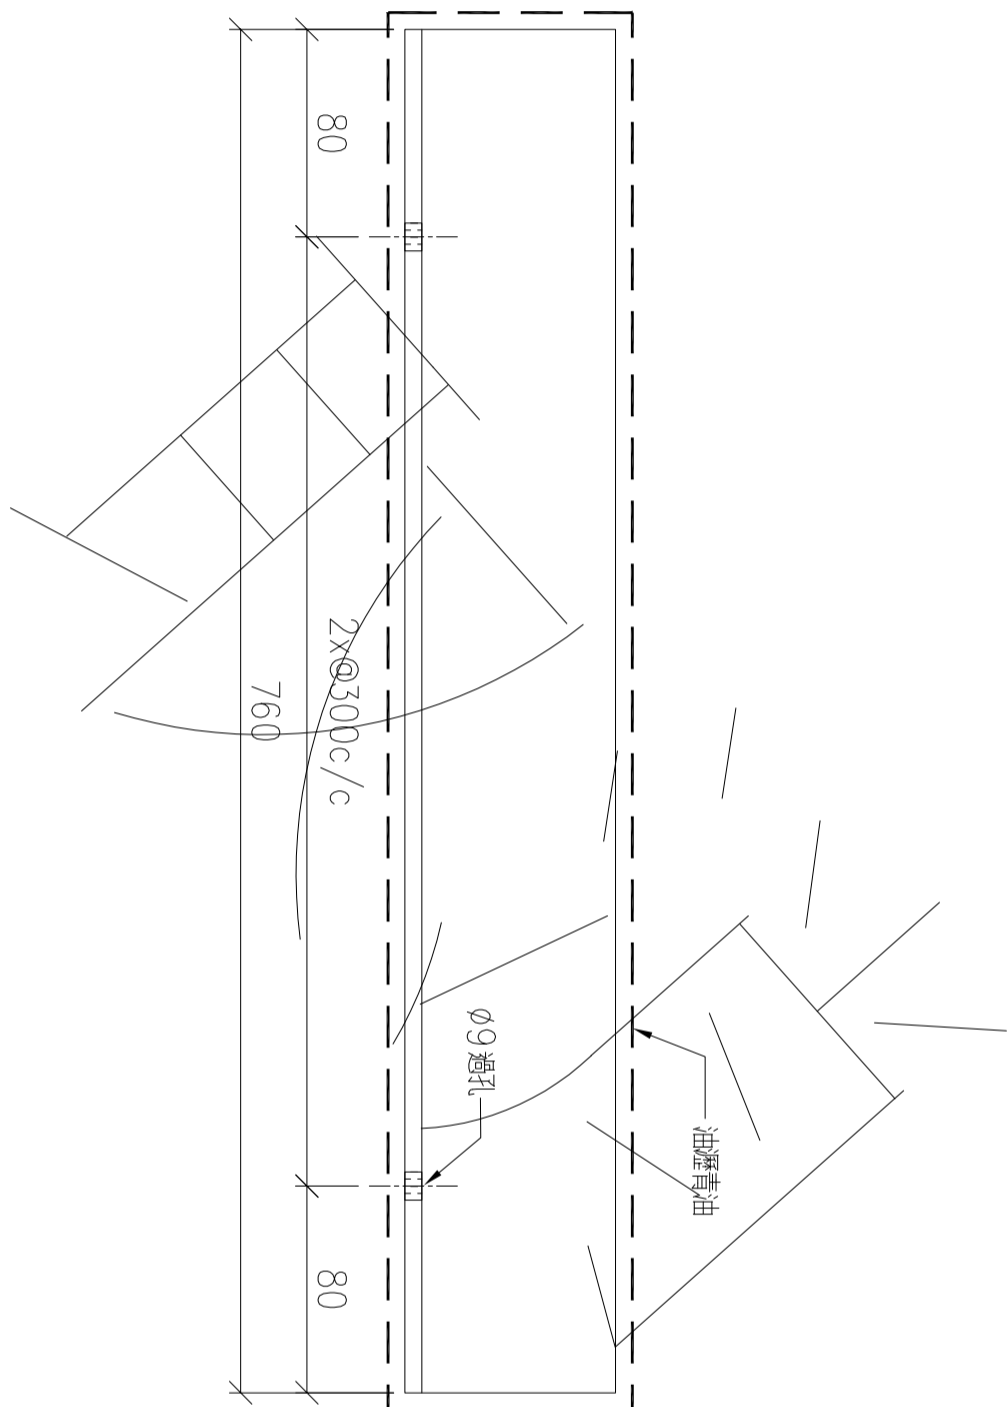

序號	物料編號	數量	使用位置	樓層
01	T5-MS-904	1	見派位圖	T5 FLAT D 11/F
02				
03				

名稱	角鋼加工圖	制圖	LHR	2022.3.10	修改		
材料	75x50x6mm厚角鋼 (S275)	復核	-	-	日期		
顏色	熱浸鋅	批准			圖號	J853-CE-MS5-21	

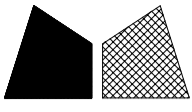



工程號

J853

地盤


錦上路

送地盤

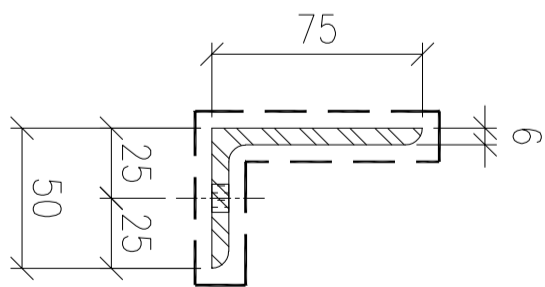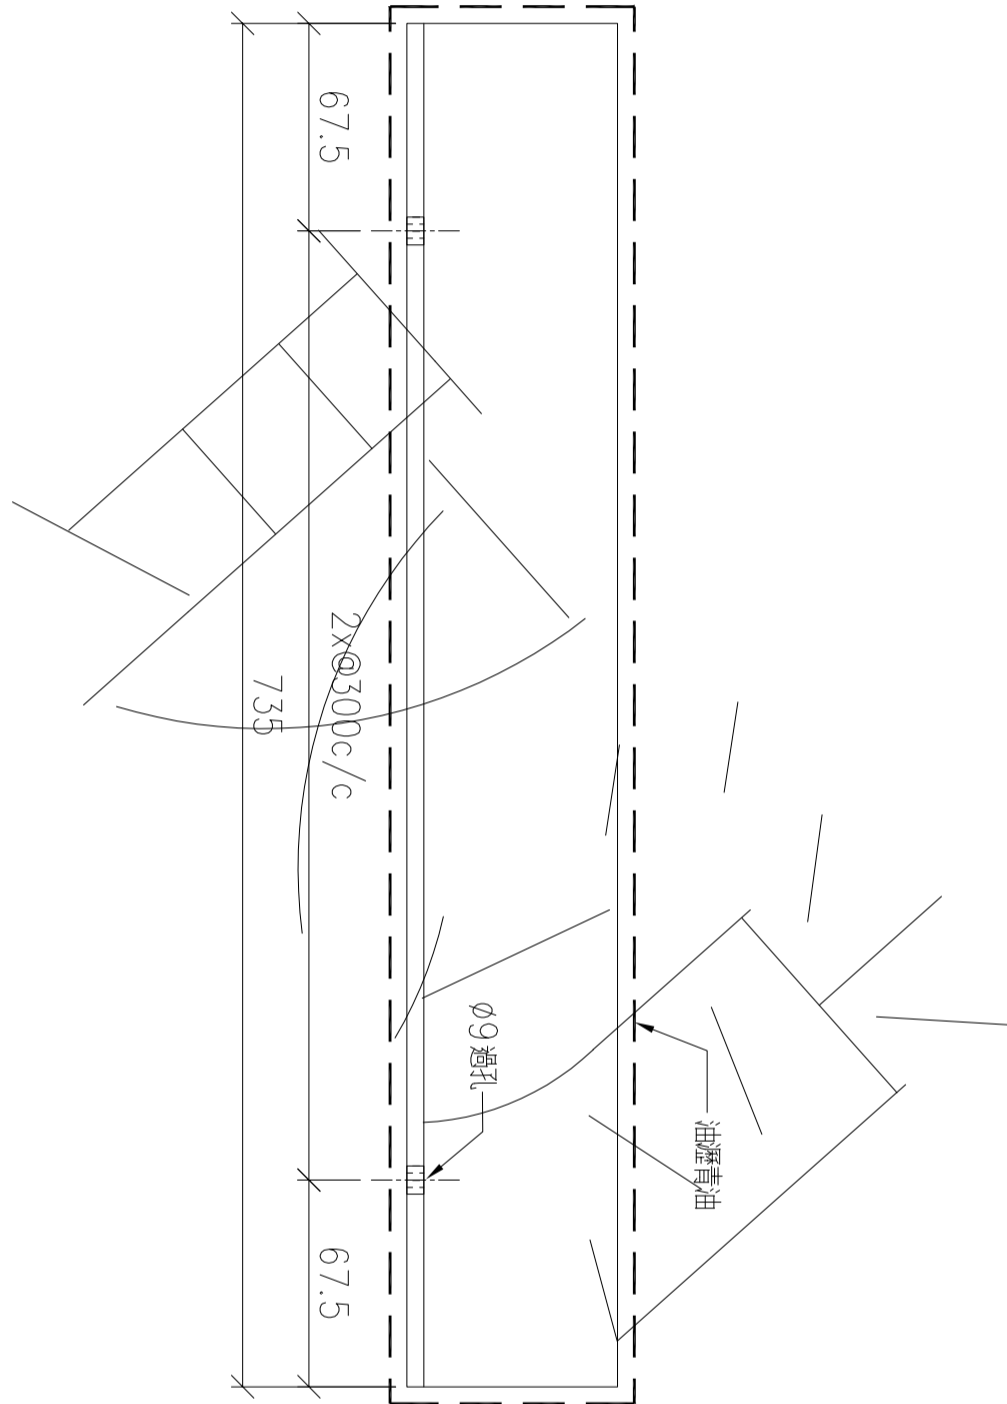

序號	物料編號	數量	使用位置	樓層
01	T5-MS-906	1	見派位圖	T5 FLAT F 11/F
02				
03				

名稱	角鋼加工圖	制圖	LHR	2022.3.10	修改		
材料	75x50x6mm厚角鋼 (S275)	復核	-	-	日期		
顏色	熱浸鋅	批准			圖號	J853-CE-MS5-23	

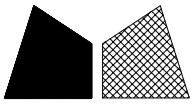

美特鋁質 有限公司
MIDI Aluminium Fabricator Ltd.



工程號

J853

地盤


錦上路

送地盤

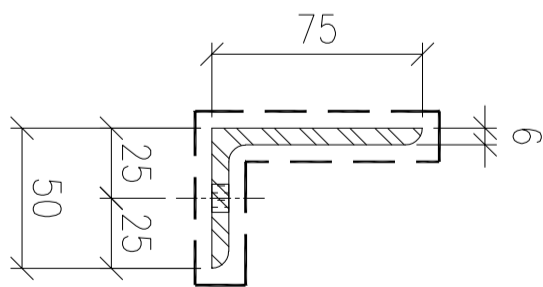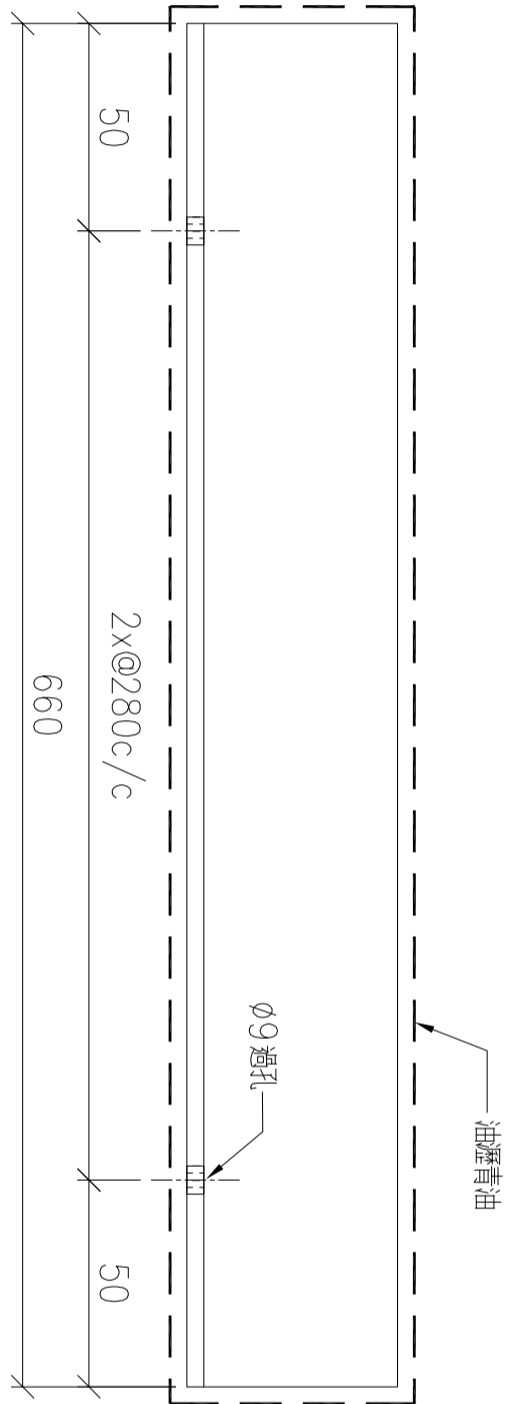

序號	物料編號	數量	使用位置	樓層
01	I5-MS-907	16	見派位圖	I5 FLAT A 17~25/F
02				
03				

名稱	角鋼加工圖	制圖	LHR	2022.3.10	修改	A	B
材料	75x50x6mm厚角鋼 (S275)	復核	-	-	日期	2022.3.21	2022.7.31
顏色	熱浸鋅	批准			圖號	J853-CE-MS5-24	

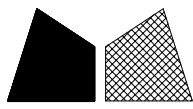



工程號

J853

地盤


錦上路

送地盤

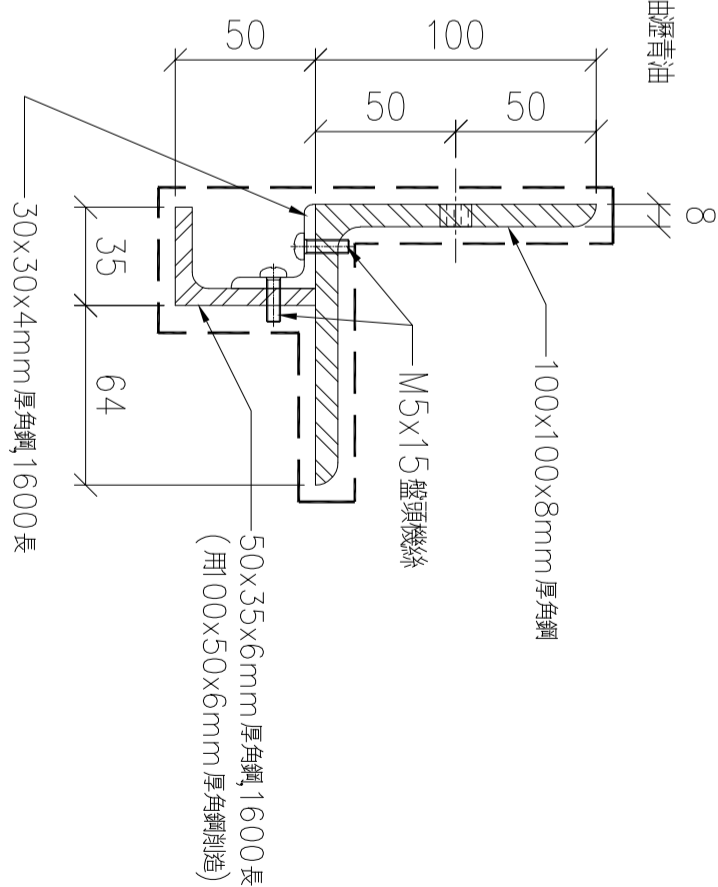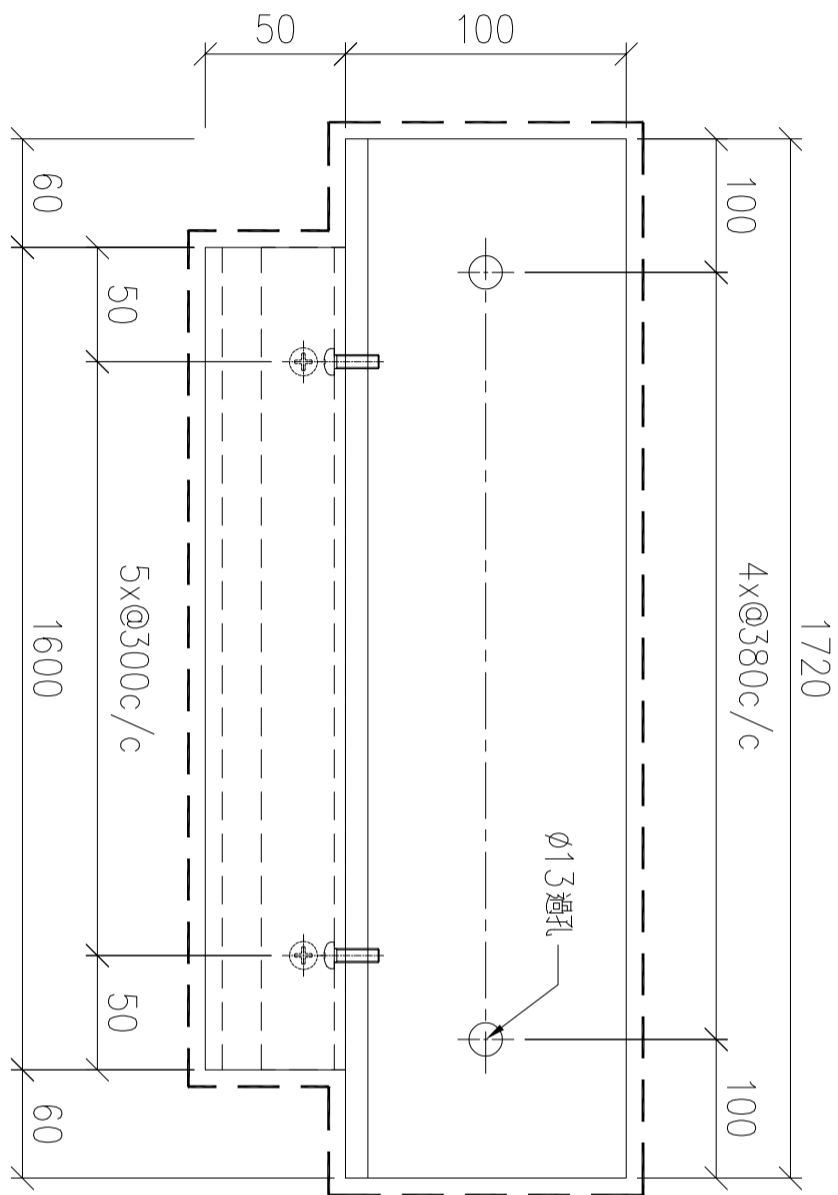

序號	物料編號	數量	使用位置	樓層
01	T5-MS-911	11	見派位圖	T5 FLAT E 12~25/F
02				
03				

名稱	角鋼加工圖	制圖	LHR	2022.3.23	修改	A
材料	-	復核	-	-	日期	2022.8.2
顏色	熱浸鋅	批准			圖號	J853-CE-MS5-28

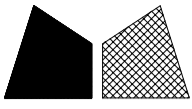

工程號



J853

地盤

錦上路


送地盤

新增

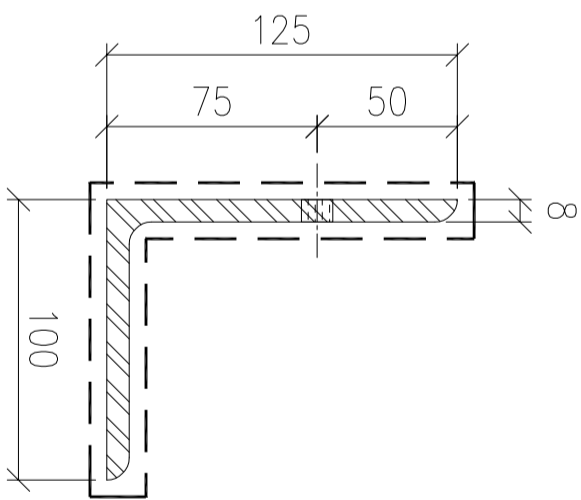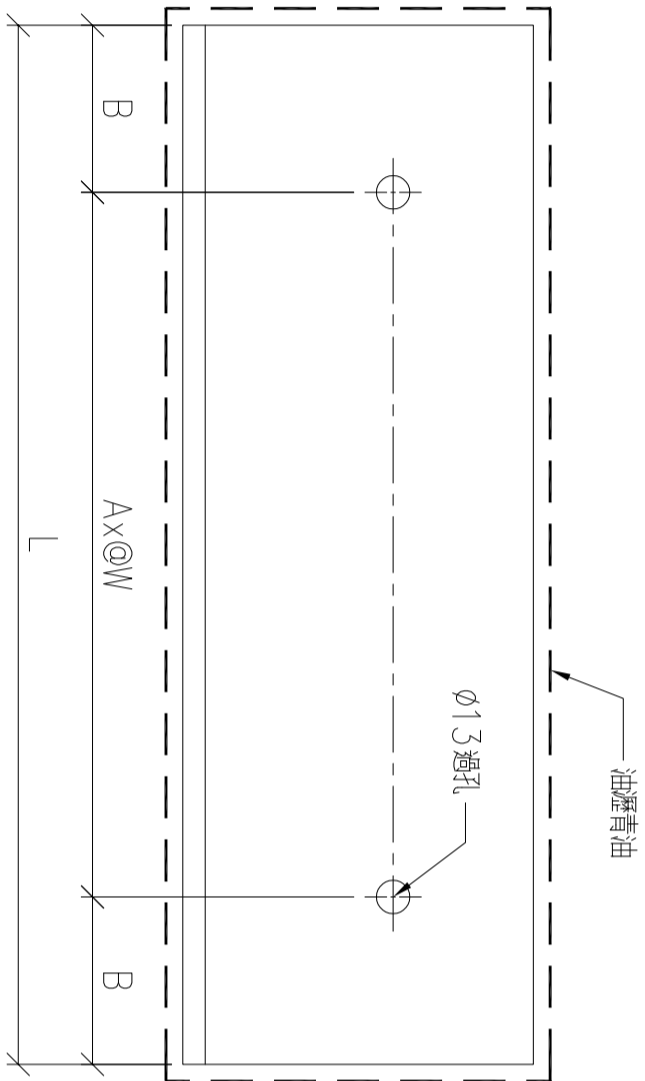

序號	物料編號	A	W	B	L	數量	使用位置	樓層
01	T5-MS-101	4	475	85	2070	2	見派位圖	T5 FLAT C 11/F
02	T5-MS-102	2	500	140	1280	2	見派位圖	T5 FLAT C 11/F
03	T5-MS-103	2	350	85	870	2	見派位圖	T5 FLAT D 11/F
04	T5-MS-104	2	350	65	830	2	見派位圖	T5 FLAT D 11/F
05	T5-MS-105	5	470	85	2520	2	見派位圖	T5 FLAT D 11/F
06	T5-MS-106	1	500	90	680	2	見派位圖	T5 FLAT D 11/F
07	T5-MS-107	3	500	135	1770	1	見派位圖	T5 FLAT E 11/F
08	T5-MS-108	1	475	90	655	1	見派位圖	T5 FLAT E 11/F
09	T5-MS-110	4	500	135	2270	2	見派位圖	T5 FLAT E,F 11/F
10	T5-MS-111	5	450	85	2420	2	見派位圖	T5 FLAT E,F 11/F
11	T5-MS-112	2	350	90	880	2	見派位圖	T5 FLAT E,F 11/F
12	T5-MS-115	2	375	85	920	2	見派位圖	T5 FLAT F 11/F
13	T5-MS-116	2	300	95	790	2	見派位圖	T5 FLAT F 11/F

名稱	角鋼加工圖	制圖	LHR	2022.7.31	修改	
材料	125x100x8mm厚角鋼 (S275)	復核	-	-	日期	
顏色	熱浸鋅	批准			圖號	J853-CE-MS5-29

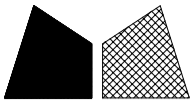

工程號



J853

地盤

錦上路


送地盤

新增

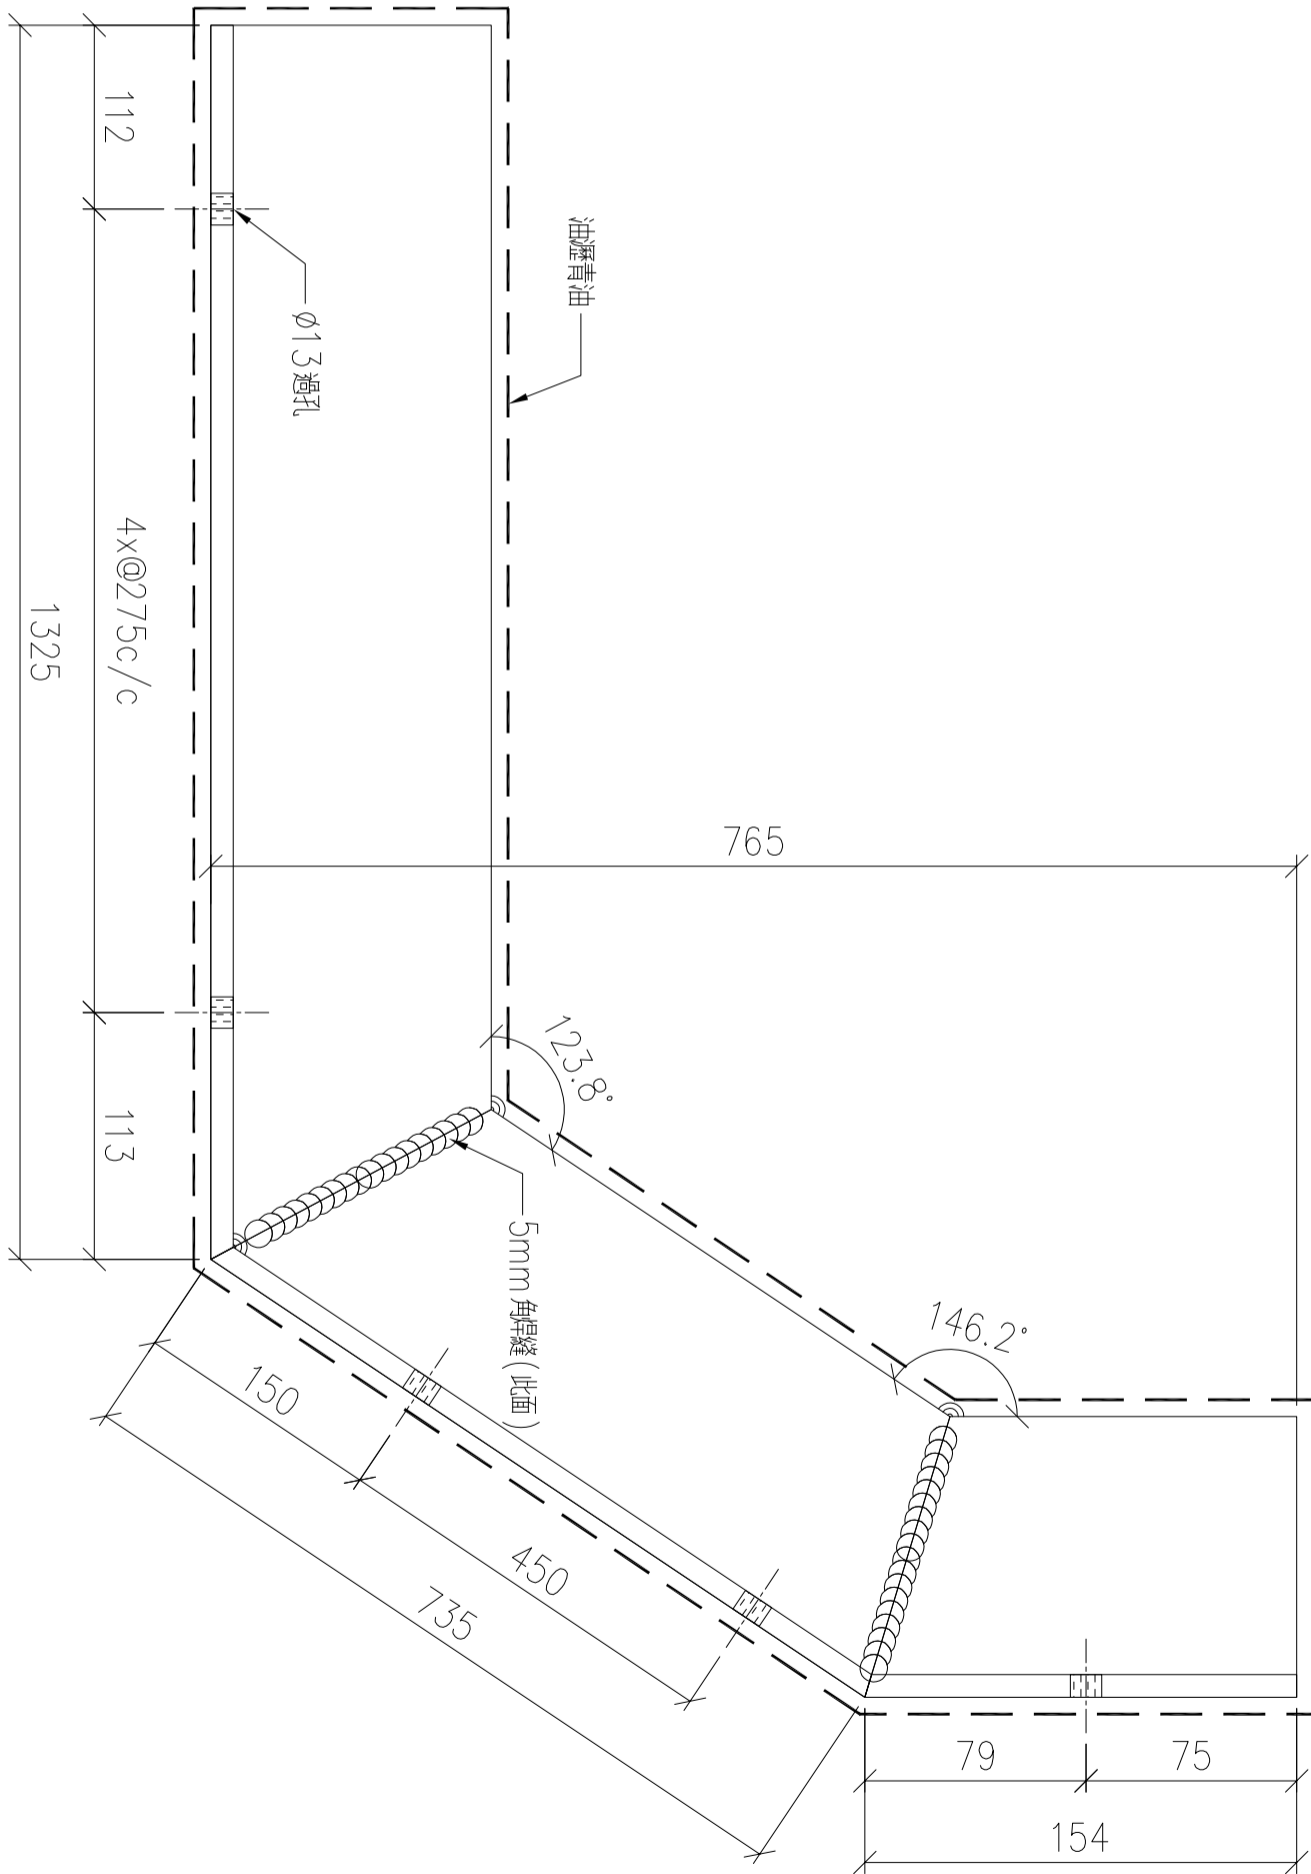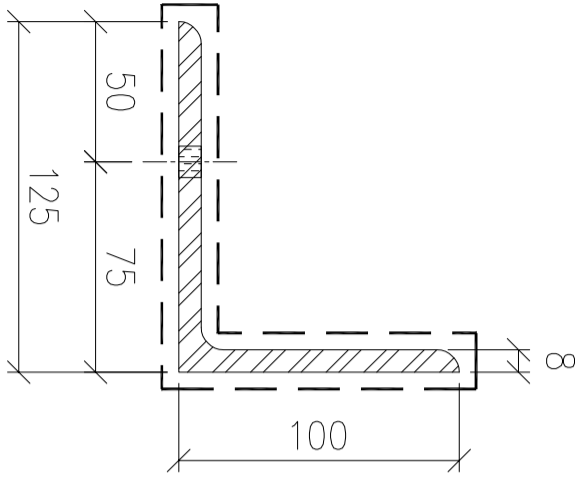

序號	物料編號	數量	使用位置	樓層
01	T5-MS-109	1	見派位圖	T5 FLAT E 11/F

名稱	角鋼加工圖	制圖	LHR	2022.7.31	修改		
材料	125x100x8mm厚角鋼 (S275)	復核	-	-	日期		
顏色	熱浸鋅	批准			圖號	J853-CE-MS5-30	

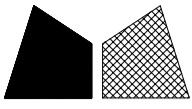

工程號


J853

地盤

錦上路


送地盤

新增

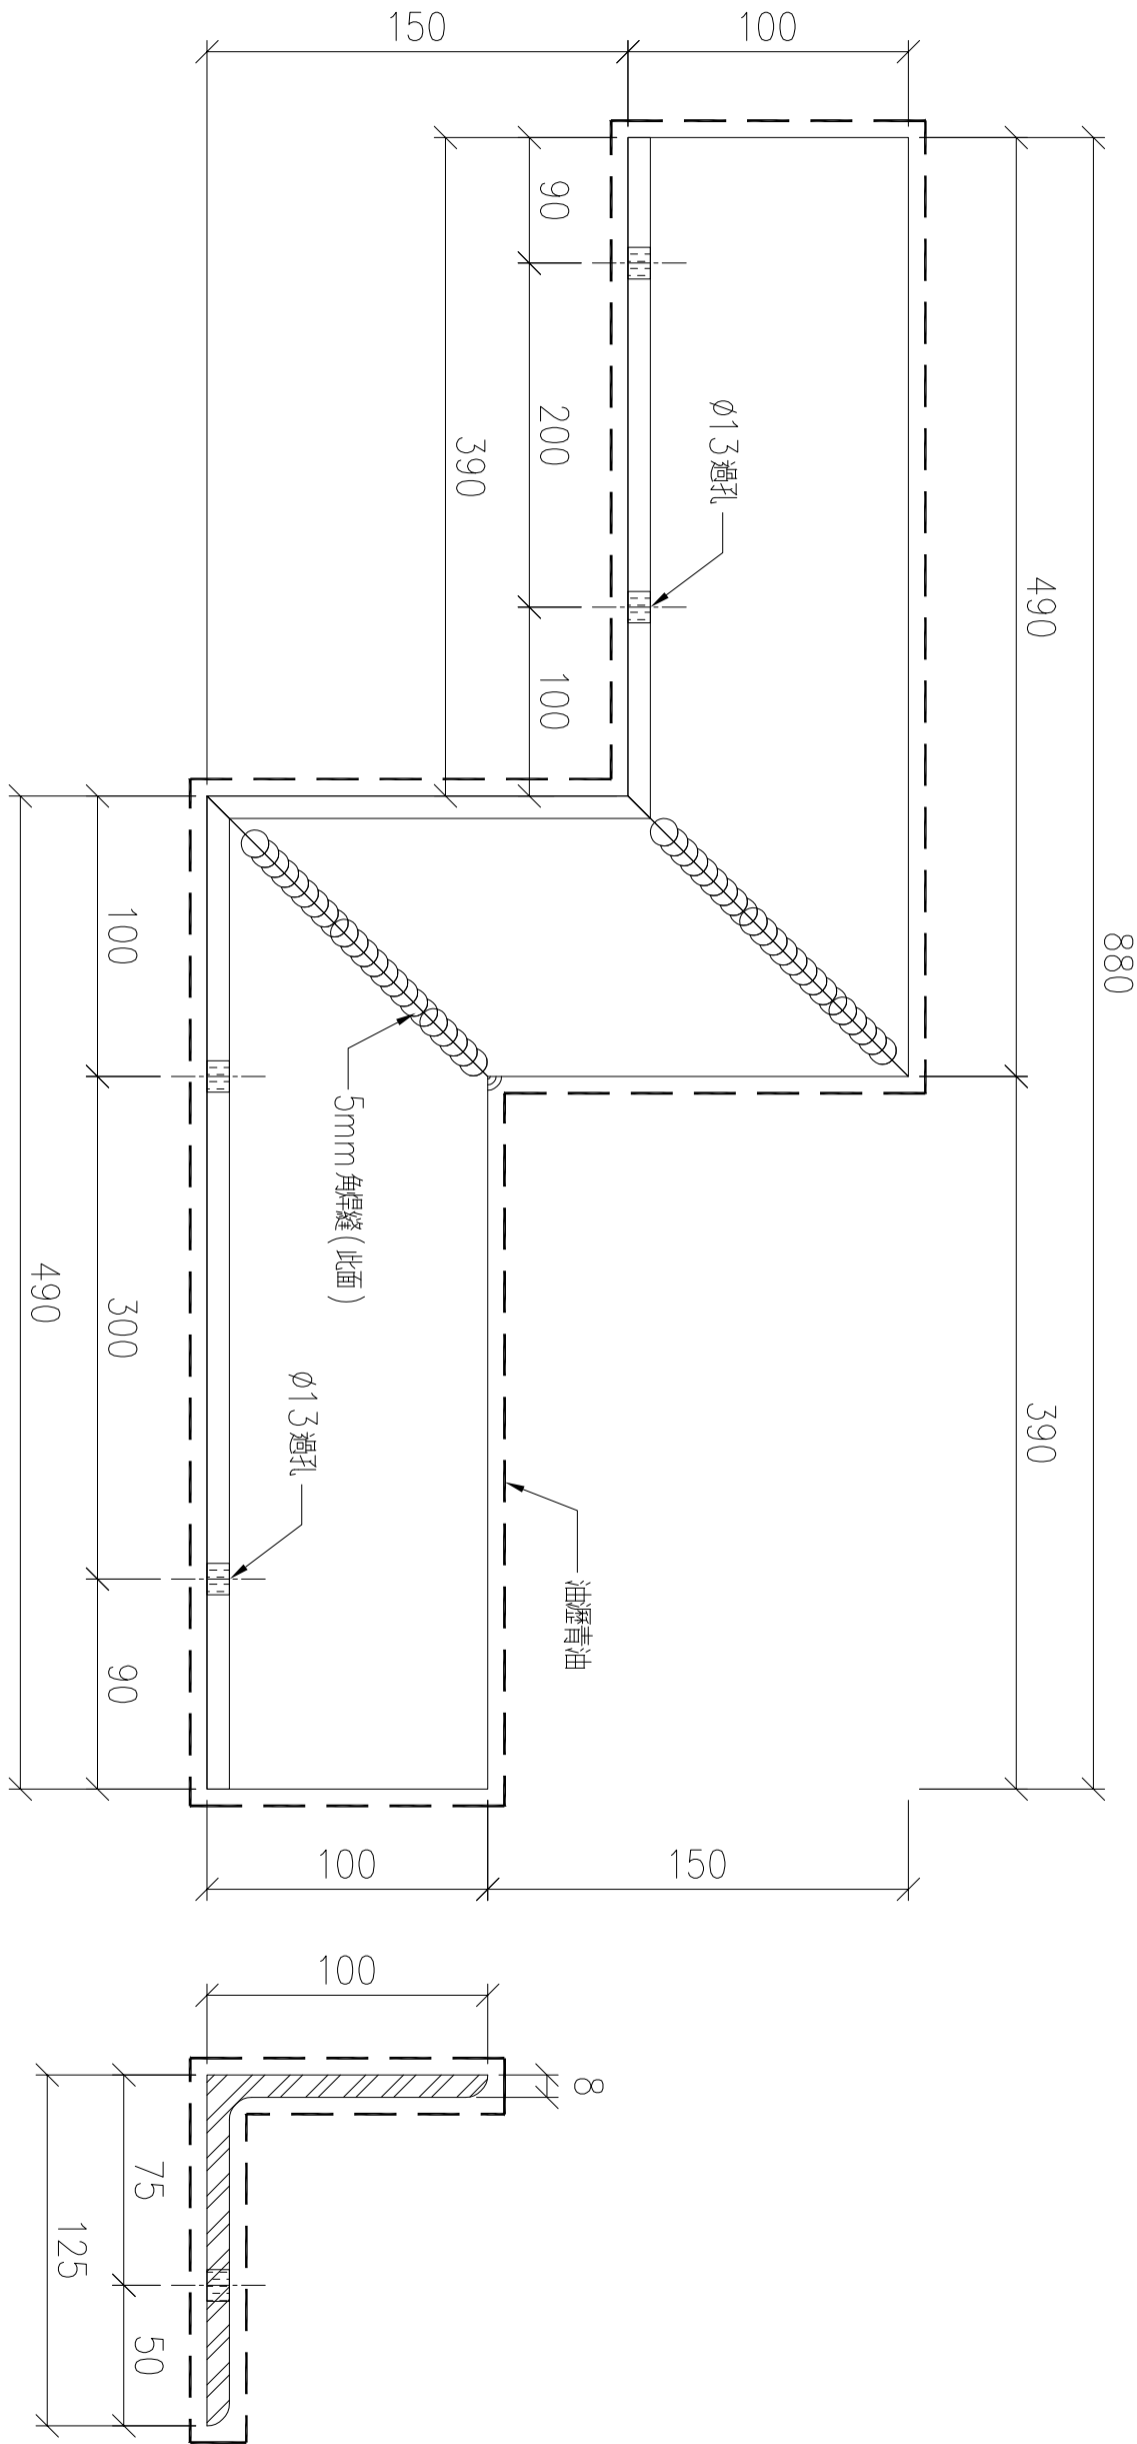

序號	物料編號	數量	使用位置	樓層
01	T5-MS-113	1	見派位圖	T5 FLAT E,F 11/F

名稱	角鋼加工圖	制圖	LHR	2022.7.31	修改		
材料	125x100x8mm厚角鋼 (S275)	復核	-	-	日期		
顏色	熱浸鋅	批准			圖號	J853-CE-MS5-31	

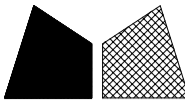

美特鋁質 有限公司
MIDI Aluminium Fabricator Ltd.

工程號


J853

地盤

錦上路


送地盤

新增

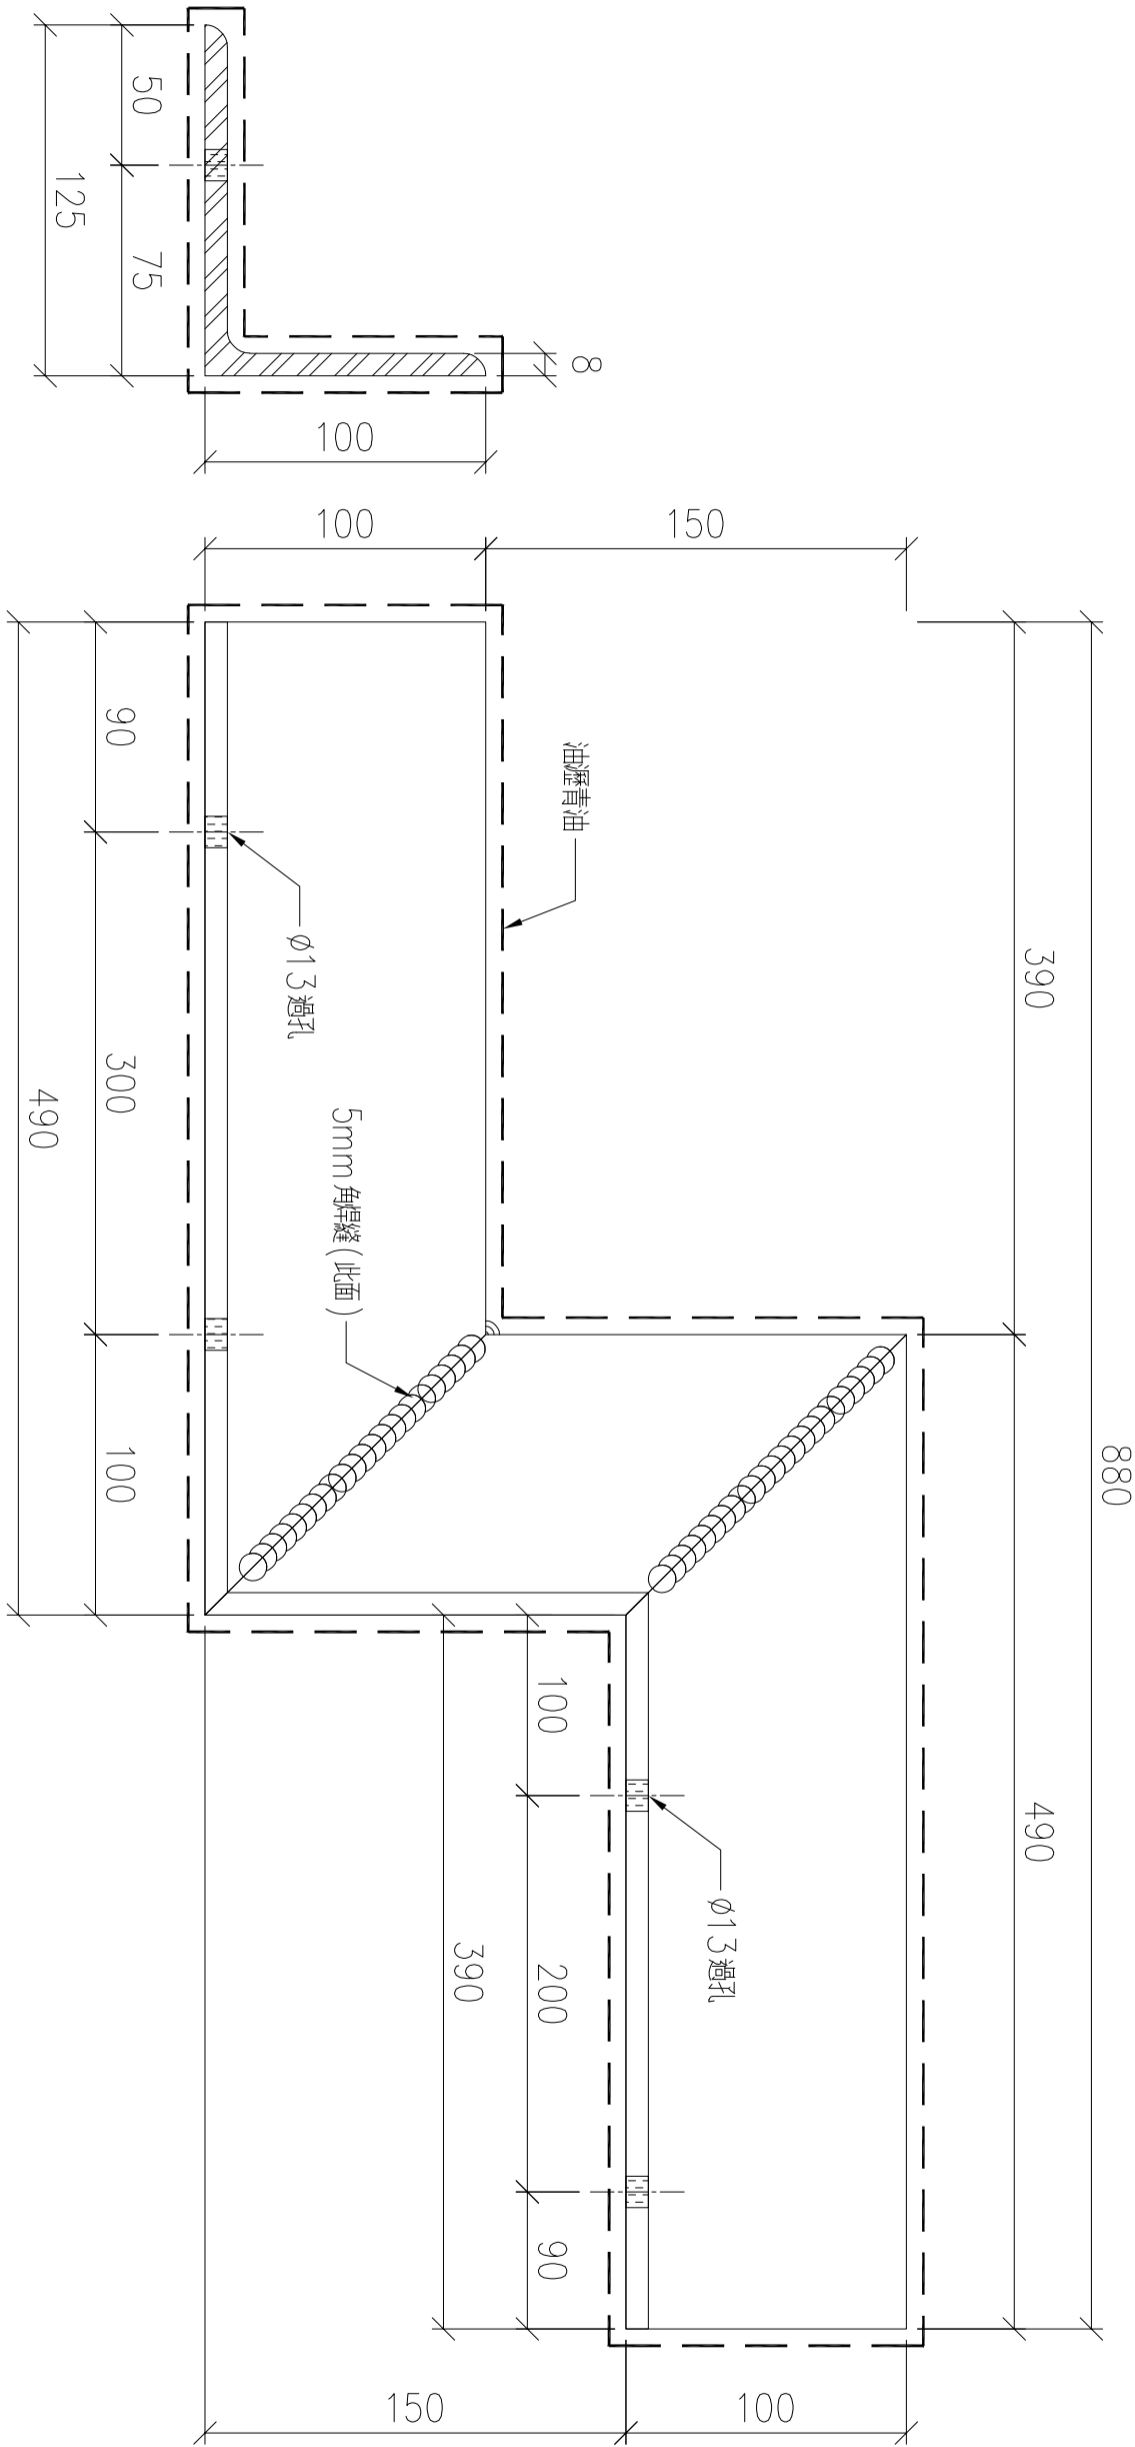

序號	物料編號	數量	使用位置	樓層
01	T5-MS-114	1	見派位圖	T5 FLAT E, F 11/F

名稱	角鋼加工圖	制圖	LHR	2022.7.31	修改		
材料	125x100x8mm厚角鋼 (S275)	復核	-	-	日期		
顏色	熱浸鋅	批准			圖號	J853-CE-MS5-32	

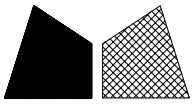

工程號



J853

地盤

錦上路


送地盤

新增

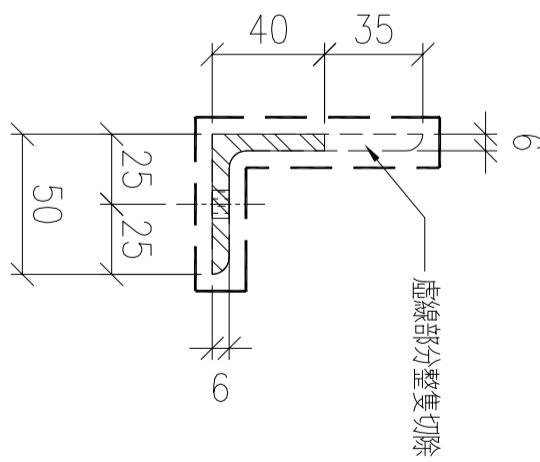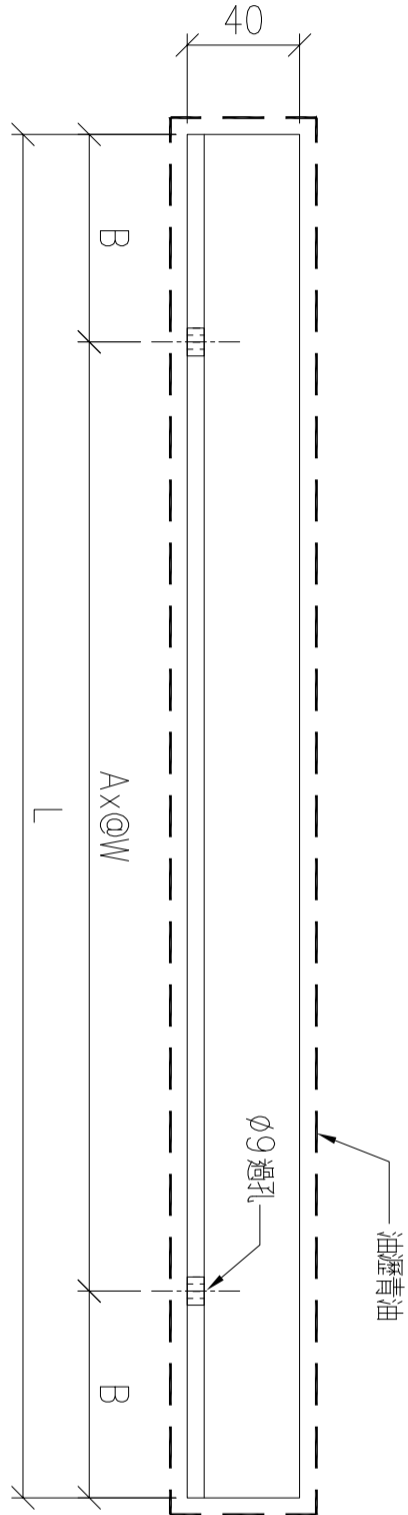

序號	物料編號	A	W	B	L	數量	使用位置	樓層
01	T5-MS-951	2	280	50	660	1	見派位圖	T5 FLAT D 11/F
02	T5-MS-952	2	300	80	760	1	見派位圖	T5 FLAT D 11/F
03	T5-MS-953	2	300	67.5	735	1	見派位圖	T5 FLAT F 11/F

名稱	角鋼加工圖	制圖	LHR	2022.7.31	修改		
材料	75x50x6mm厚角鋼 (S275)	復核	-	-	日期		
顏色	熱浸鋅	批准			圖號	J853-CE-MS5-33	

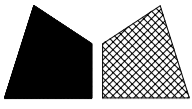

美特鋁質 有限公司
MIDI Aluminium Fabricator Ltd.

工程號



J853

地盤

錦上路

送地盤

新增

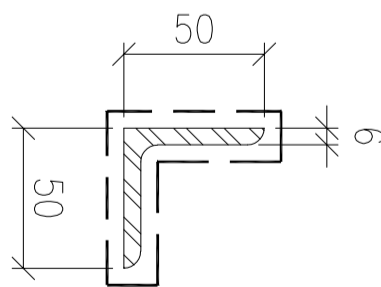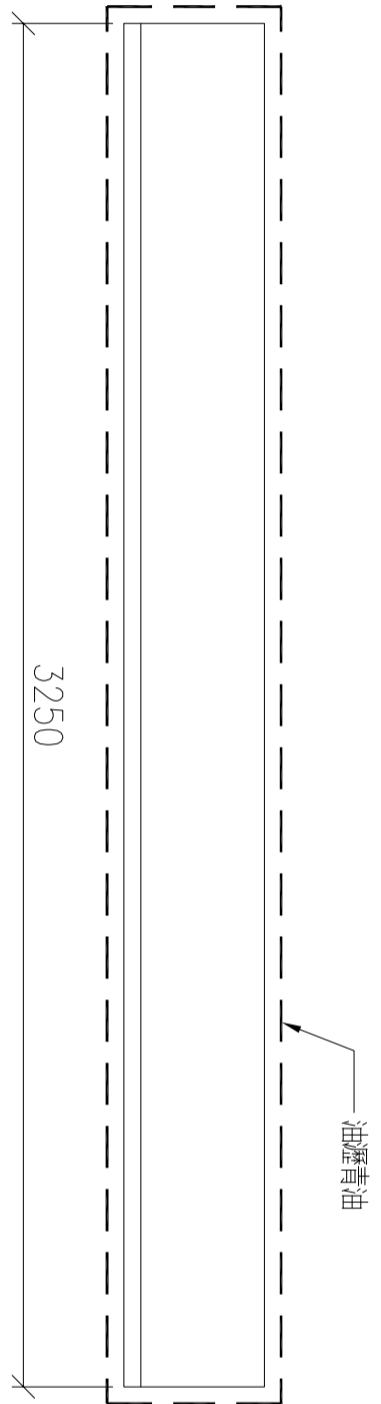

序號	物料編號	數量	使用位置	樓層
01	T5-MS-990	1	見派位圖	T5 FLAT B 17/F

名稱	角鋼加工圖	制圖	LHR	2022.7.31	修改		
材料	50x50x6mm厚角鋼 (S275)	復核	-	-	日期		
顏色	熱浸鋅	批准			圖號	J853-CE-MS5-34	

CEILING MARK	TYPE	FLAT	FLOOR(S)	TOTAL
ALC-505A/75C	NORMAL	C	11/F	1

B.O. REF. :

CLIENT :
SHIMAO GROUP HOLDINGS LIMITED

ARCHITECT :
WONG TUNG & PARTNERS LIMITED
ARCHITECTS & PLANNERS

MAIN CONTRACTOR :
協興建築有限公司
HWP HING CONSTRUCTION CO. LTD

STRUCTURAL ENGINEER :

ICMA C M WONG & ASSOCIATES LTD
黃志明建築工程師有限公司

FAÇADE CONSULTANT:

WEINHARDT

NOTE :
1. ALL DIMENSIONS ARE IN mm.
2. ALL ELEVATIONS ARE VIEWED FROM OUTSIDE.
3. ALL DIMENSIONS TO BE VERIFIED ON SITE BEFORE FABRICATION.

LEGEND :

- X1 --- DETAIL MARK NO.
X001 --- REFER SHEET NO.
1. F.F.L. --- FINISHED FLOOR LEVEL
2. S.F.L. --- STRUCTURAL FLOOR LEVEL
3. (R) --- REVERSED DETAIL
4. --- 3mm THK. ALUM. CEILING

NO.	DATE	REVISION SUBJECT TO ARCHITECT COMMENT	BY
B	28/07/2022	REVISION SUBJECT TO ARCHITECT COMMENT	LHR
A	04/01/2022	REVISION SUBJECT TO ARCHITECT COMMENT	LHR

JOB NO. : J-853

PROJECT :
PROPOSED RESIDENTIAL DEVELOPMENT AT N.K.I.L. 6542
YIN PING ROAD
KOWLOON




TITLE :
ALUM. CEILING FOR ALC-505A OF LIV./DIN. AT TOWER 5 FLAT C (11/F)

DATE : 06-AUG-21 SCALE : 1 : 40 (A3)

DRAWN BY : LHR CHECKED BY :

MIDI ALUMINIUM FABRICATOR LTD.
Units 6-8, Sunny Industrial Centre, 1/F
610 Cho Kwo Ling Road, Kowloon
Tel:23489211-4 Fax:85227272666

DWG NO. : J853-SD-ALC-4506 REV. : B

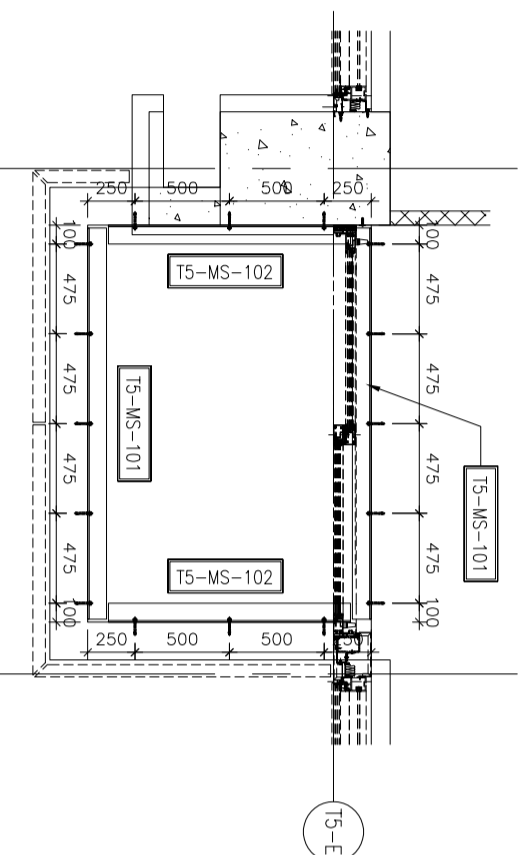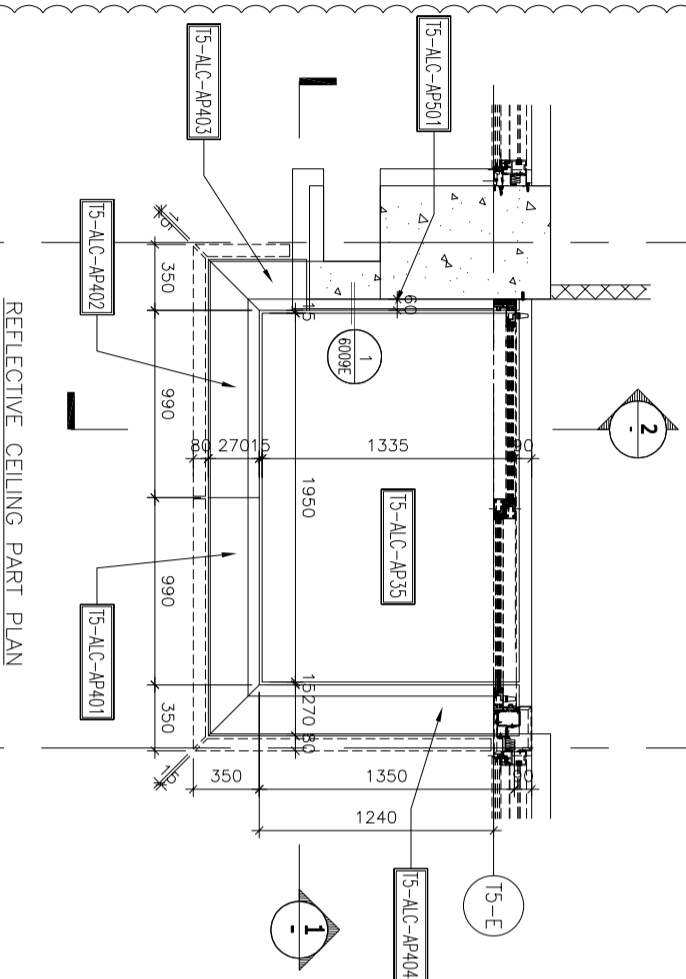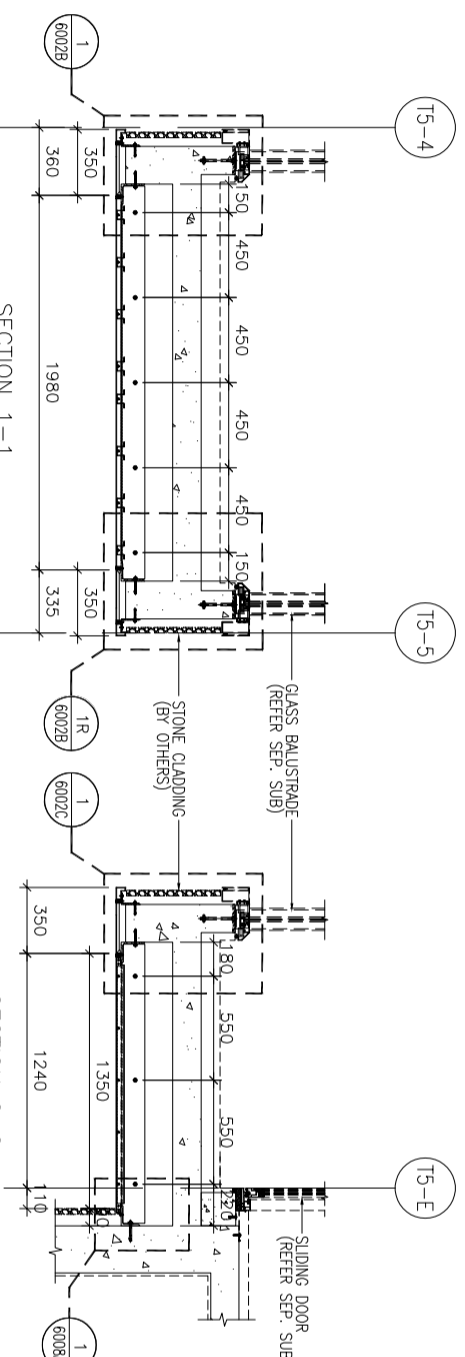

PART PLAN FOR STEEL FRAME & FIXING

CEILING MARK	TYPE	FLAT	FLOOR(S)	TOTAL
ALC-506A/75D	NORMAL	D	11/F	1

B.O. REF. :

CLIENT :

**SHIMAO GROUP
HOLDINGS LIMITED**

ARCHITECT :

WONG TUNG & PARTNERS LIMITED
ARCHITECTS & PLANNERS

MAIN CONTRACTOR :

協興建築有限公司
HP HING CONSTRUCTION CO. LTD

STRUCTURAL ENGINEER :

CGMA C M WONG & ASSOCIATES LTD
黃志明建築工程師有限公司

FAÇADE CONSULTANT :




MEINHARDT

NOTE :

1. ALL DIMENSIONS ARE IN mm.
2. ALL ELEVATIONS ARE VIEWED FROM OUTSIDE.
3. ALL DIMENSIONS TO BE VERIFIED ON SITE BEFORE FABRICATION.

LEGEND :

- X1 --- DETAIL MARK NO.
X001 --- REFER SHEET NO.
1. F.F.L. --- FINISHED FLOOR LEVEL
 2. S.F.L. --- STRUCTURAL FLOOR LEVEL
 3. (R) --- REVERSED DETAIL
 4. [] --- 3mm THK. ALUM. CEILING

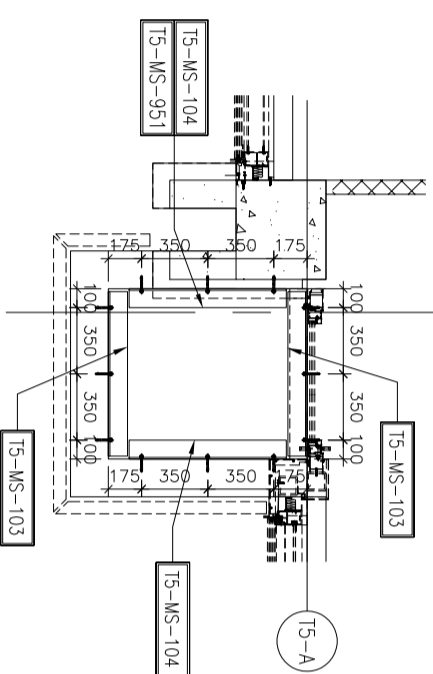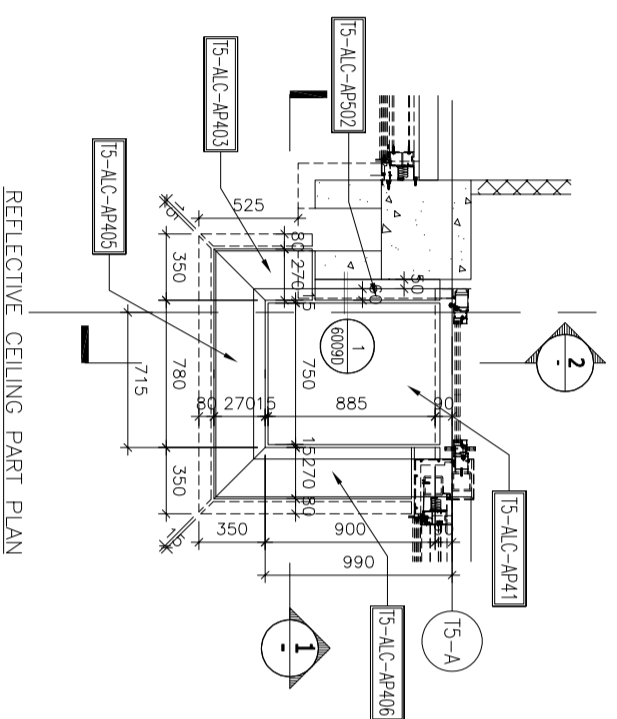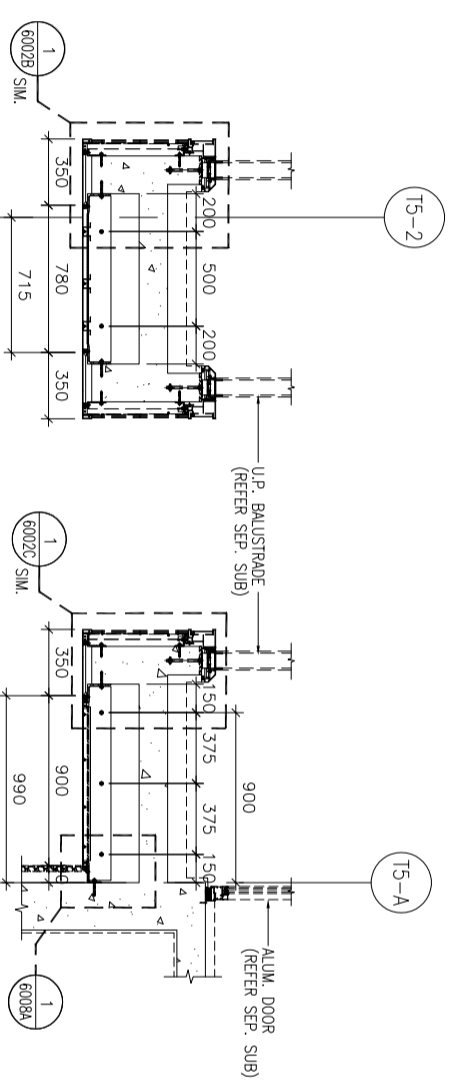

NO.	DATE	REVISION SUBJECT TO ARCH/COMMENT	BY
B	28/07/2022	REVISION SUBJECT TO ARCH/COMMENT	LHR
A	04/01/2022	REVISION SUBJECT TO ARCH/COMMENT	LHR

JOB NO. : J-853

PROJECT : PROPOSED RESIDENTIAL
DEVELOPMENT AT N.K.I.L. 6542
YIN PING ROAD
KOWLOON

TITLE :

ALUM. CEILING FOR
ALC-506A OF MASTER ENSUITE
AT TOWER 5 FLAT D (11/F)

DATE : 06-AUG-21 SCALE : 1 : 40 (A3)




DRAWN BY : LHR CHECKED BY :

美特鋁質有限公司
MIDI ALUMINIUM FABRICATOR LTD.
Units 6-8, Sunny Industrial Centre, 1/F
610 Cho Kwo Ling Road, Kowloon
Tel:23489211-4 Fax:8522727666

DWG NO. : J853-SD-ALC-4508 REV. : B

CEILING MARK	TYPE	FLAT	FLOOR(S)	TOTAL
ALC-507A/75D	NORMAL	D	11/F	1

B.O. REF. :

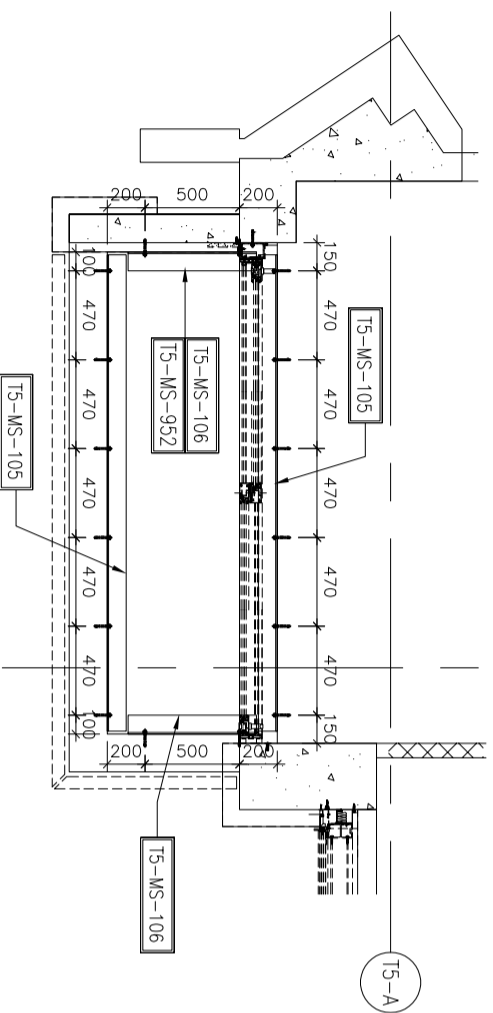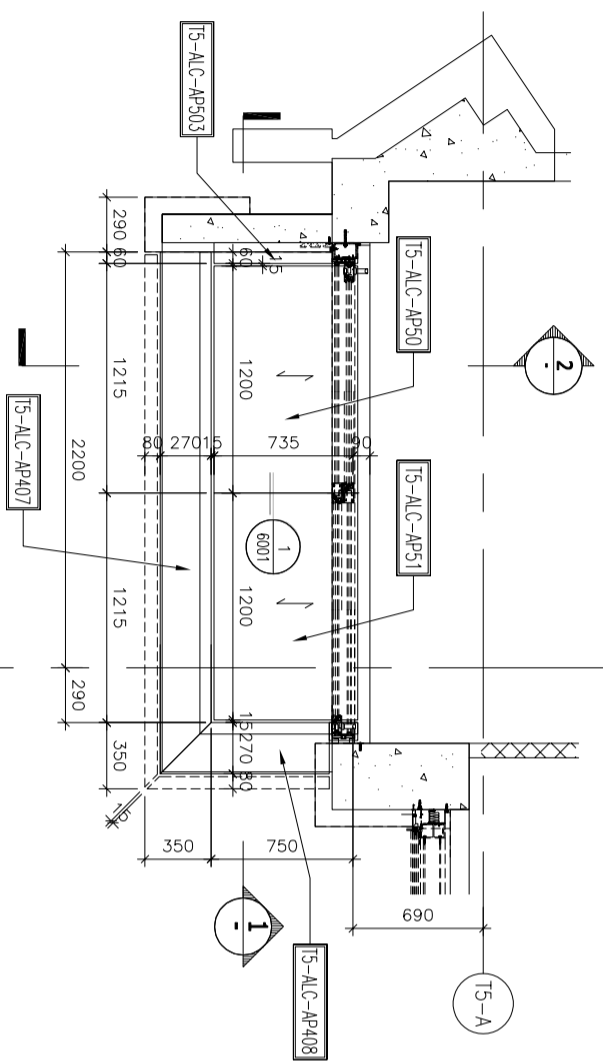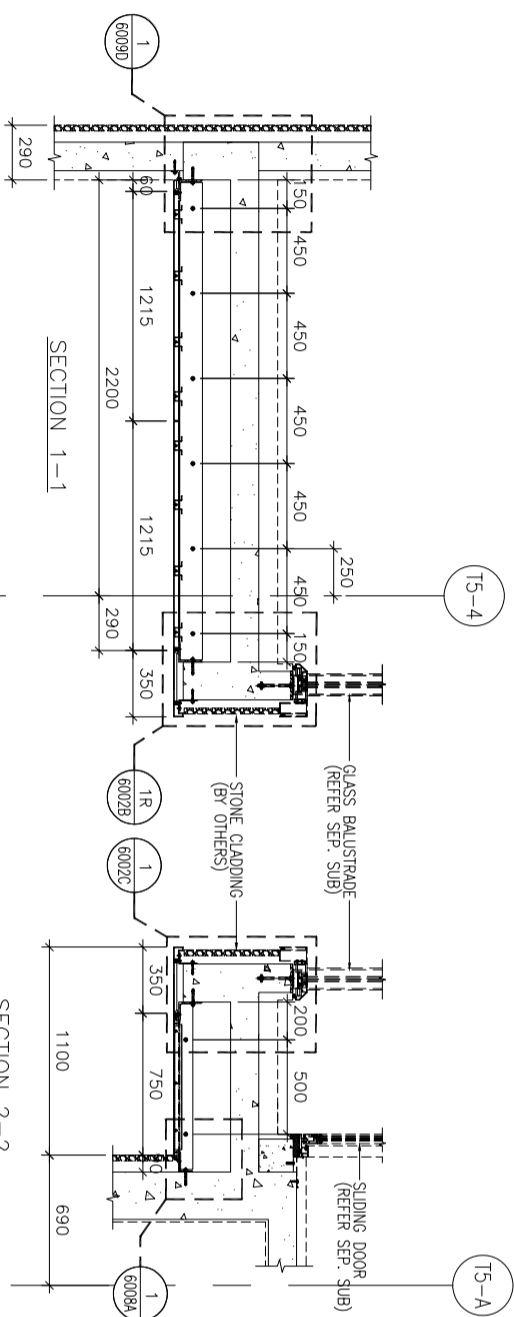

PART PLAN FOR STEEL FRAME & FIXING

REFLECTIVE CEILING PART PLAN

NO.	DATE	REVISION SUBJECT TO ARCH/COMMENT	BY
B	28/07/2022	REVISION SUBJECT TO ARCH/COMMENT	LHR
A	04/01/2022	REVISION SUBJECT TO ARCH/COMMENT	LHR

NO.	DATE	REVISION SUBJECT TO ARCH/COMMENT	BY
J	06-AUG-21	SCALE : 1 : 40 (A3)	LHR

JOB NO. : J-853
 PROJECT : PROPOSED RESIDENTIAL DEVELOPMENT AT N.K.I.L. 6542 YIN PING ROAD KOWLOON
 TITLE : ALUM. CEILING FOR ALC-507A OF LIV./DIN. AT TOWER 5 FLAT D (11/F)

DATE : 06-AUG-21 SCALE : 1 : 40 (A3)
 DRAWN BY : LHR CHECKED BY :

MIDI ALUMINIUM FABRICATOR LTD.
 Units 6-8, Sunny Industrial Centre, 1/F
 610 Cho Kwo Ling Road, Kowloon
 Tel:23489211-4 Fax:8522727666
 DWG NO. : J853-SD-ALC-4510 REV. : B

CLIENT : SHIMAO GROUP HOLDINGS LIMITED

ARCHITECT : WONG TUNG & PARTNERS LIMITED ARCHITECTS & PLANNERS



MAIN CONTRACTOR : 協興建築有限公司
 HIP HING CONSTRUCTION CO. LTD

STRUCTURAL ENGINEER :

ICMA C M WONG & ASSOCIATES LTD
 黃志明建築工程師有限公司

FAÇADE CONSULTANT :



NOTE :
 1. ALL DIMENSIONS ARE IN mm.
 2. ALL ELEVATIONS ARE VIEWED FROM OUTSIDE.
 3. ALL DIMENSIONS TO BE VERIFIED ON SITE BEFORE FABRICATION.

LEGEND :

- X1 --- DETAIL MARK NO.
- X001 --- REFER SHEET NO.
- 1. F.F.L. --- FINISHED FLOOR LEVEL
- 2. S.F.L. --- STRUCTURAL FLOOR LEVEL
- 3. (R) --- REVERSED DETAIL
- 4. [Pattern] --- 3mm THK. ALUM CEILING

CEILING MARK	TYPE	FLOOR(S)	TOTAL
ALC-508/15E	NORMAL	12/F~25/F	11

B.O. REF. :

CLIENT :

**SHIMAO GROUP
HOLDINGS LIMITED**

ARCHITECT :

WONG TUNG & PARTNERS LIMITED
ARCHITECTS & PLANNERS

MAIN CONTRACTOR :

協興建築有限公司
HIP HING CONSTRUCTION CO. LTD

STRUCTURAL ENGINEER :

ICMA C M WONG & ASSOCIATES LTD
黃志明建築工程師有限公司

FAÇADE CONSULTANT :

MEINHARDT

NOTE :

1. ALL DIMENSIONS ARE IN mm.
2. ALL ELEVATIONS ARE VIEWED FROM OUTSIDE.
3. ALL DIMENSIONS TO BE VERIFIED ON SITE BEFORE FABRICATION.

LEGEND :

- X1 --- DETAIL MARK NO.
X001 --- REFER SHEET NO.
1. F.F.L. --- FINISHED FLOOR LEVEL
 2. S.F.L. --- STRUCTURAL FLOOR LEVEL
 3. (R) --- REVERSED DETAIL
 4. --- 3mm THK. ALUM. CEILING

NO.	DATE	REVISION	BY

JOB NO. : J-853

PROJECT : PROPOSED RESIDENTIAL
DEVELOPMENT AT N.K.I.L. 6542
YIN PING ROAD
KOWLOON

TITLE :

ALUM. CEILING FOR
ALC-508 OF MASTER ENSUITE
AT TOWER 5 FLAT E




(12/F~25/F) (EXCEPT 13/F, 14/F, 24/F)

DATE : 06-AUG-21 SCALE : 1 : 40 (A3)

DRAWN BY : LHR CHECKED BY :

美特鋁質有限公司
MIDI ALUMINIUM FABRICATOR LTD.
Units 6-8, Sunny Industrial Centre, 1/F
610 Cho Kwo Ling Road, Kowloon
Tel: 23489211-4 Fax: (852) 2727666

DWG NO. : J853-SD-ALC-4511 REV. : -

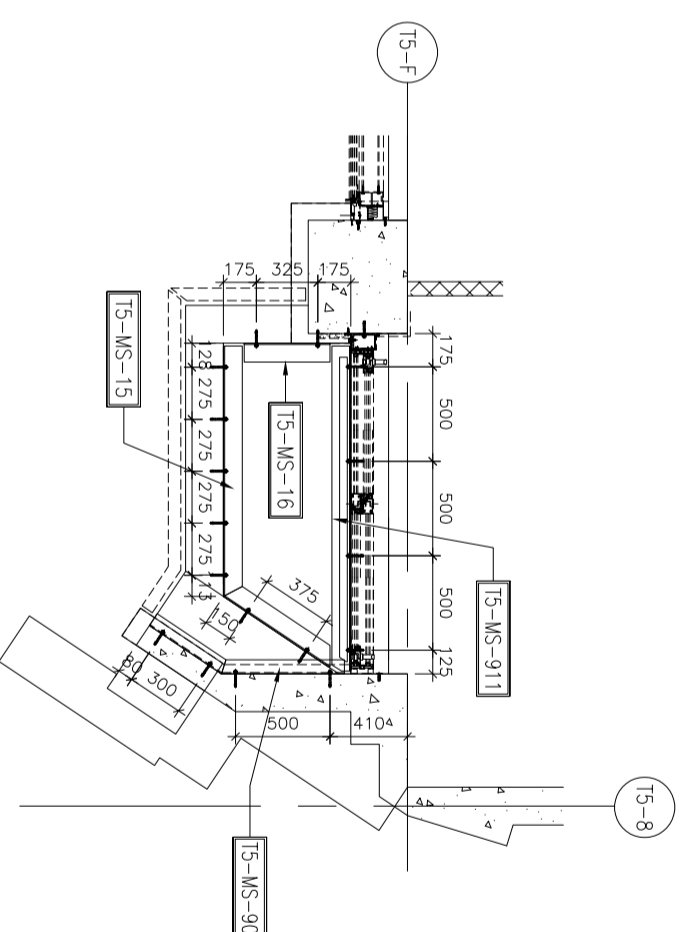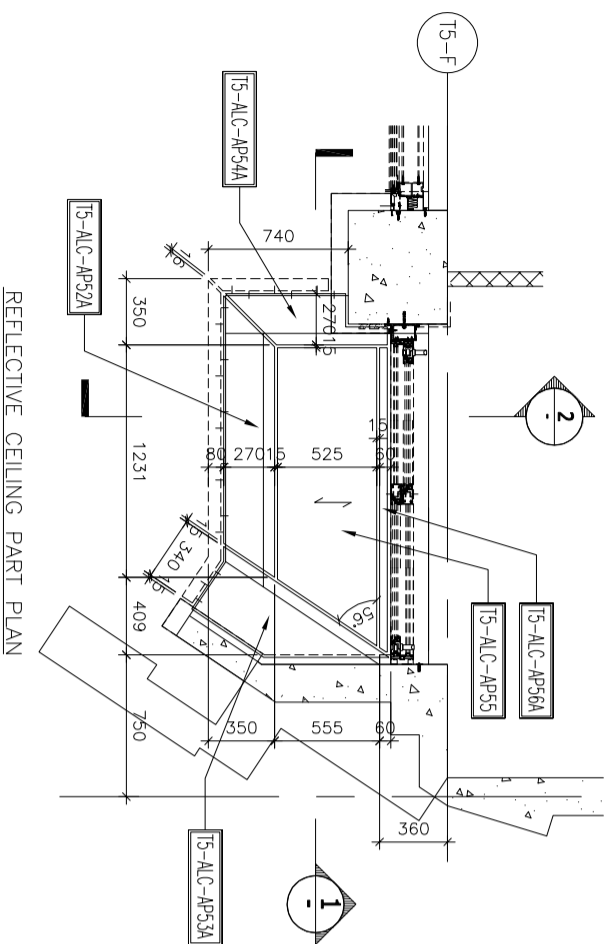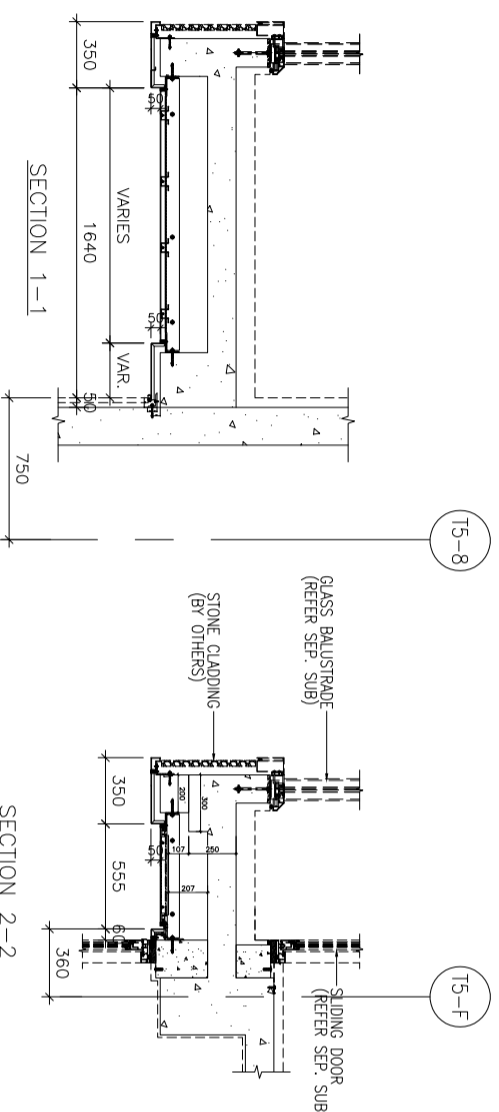

PART PLAN FOR STEEL FRAME & FIXING

REFLECTIVE CEILING PART PLAN

CEILING MARK	TYPE	FLAT	FLOOR(S)	TOTAL
ALC-508B/TSE	NORMAL	E	26/F	1

B.O. REF. :

CLIENT :

**SHIMAO GROUP
HOLDINGS LIMITED**

ARCHITECT :
WONG TUNG & PARTNERS LIMITED
ARCHITECTS & PLANNERS



MAIN CONTRACTOR :
協興建築有限公司
HIP HING CONSTRUCTION CO. LTD

STRUCTURAL ENGINEER :

ICMA C M WONG & ASSOCIATES LTD
黃志明建築工程師有限公司

FAÇADE CONSULTANT:

MEINHARDT

NOTE :

1. ALL DIMENSIONS ARE IN mm.
2. ALL ELEVATIONS ARE VIEWED FROM OUTSIDE.
3. ALL DIMENSIONS TO BE VERIFIED ON SITE BEFORE FABRICATION.

LEGEND :

- X1 --- DETAIL MARK NO.
- X001 --- REFER SHEET NO.
- 1. F.F.L. --- FINISHED FLOOR LEVEL
- 2. S.F.L. --- STRUCTURAL FLOOR LEVEL
- 3. (R) --- REVERSED DETAIL
- 4. [Hatched Box] --- 3mm THK. ALUM. CEILING

NO.	DATE	REVISION	BY

JOB NO. : J-853

PROJECT : PROPOSED RESIDENTIAL
DEVELOPMENT AT N.K.I.L. 6542
YIN PING ROAD
KOWLOON

TITLE :



ALUM. CEILING FOR
ALC-508B OF MASTER ENSUITE
AT TOWER 5 FLAT E
(26/F)

DATE : 06-AUG-21 SCALE : 1 : 40 (A3)

DRAWN BY : LHR CHECKED BY :

美特鋁質有限公司
MIDI ALUMINIUM FABRICATOR LTD.
Units 6-8, Sunny Industrial Centre, 1/F
610 Cho Kwo Ling Road, Kowloon
Tel: 23489211-4 Fax: (852) 27272666

DWG NO. : J853-SD-ALC-4511A REV. : -

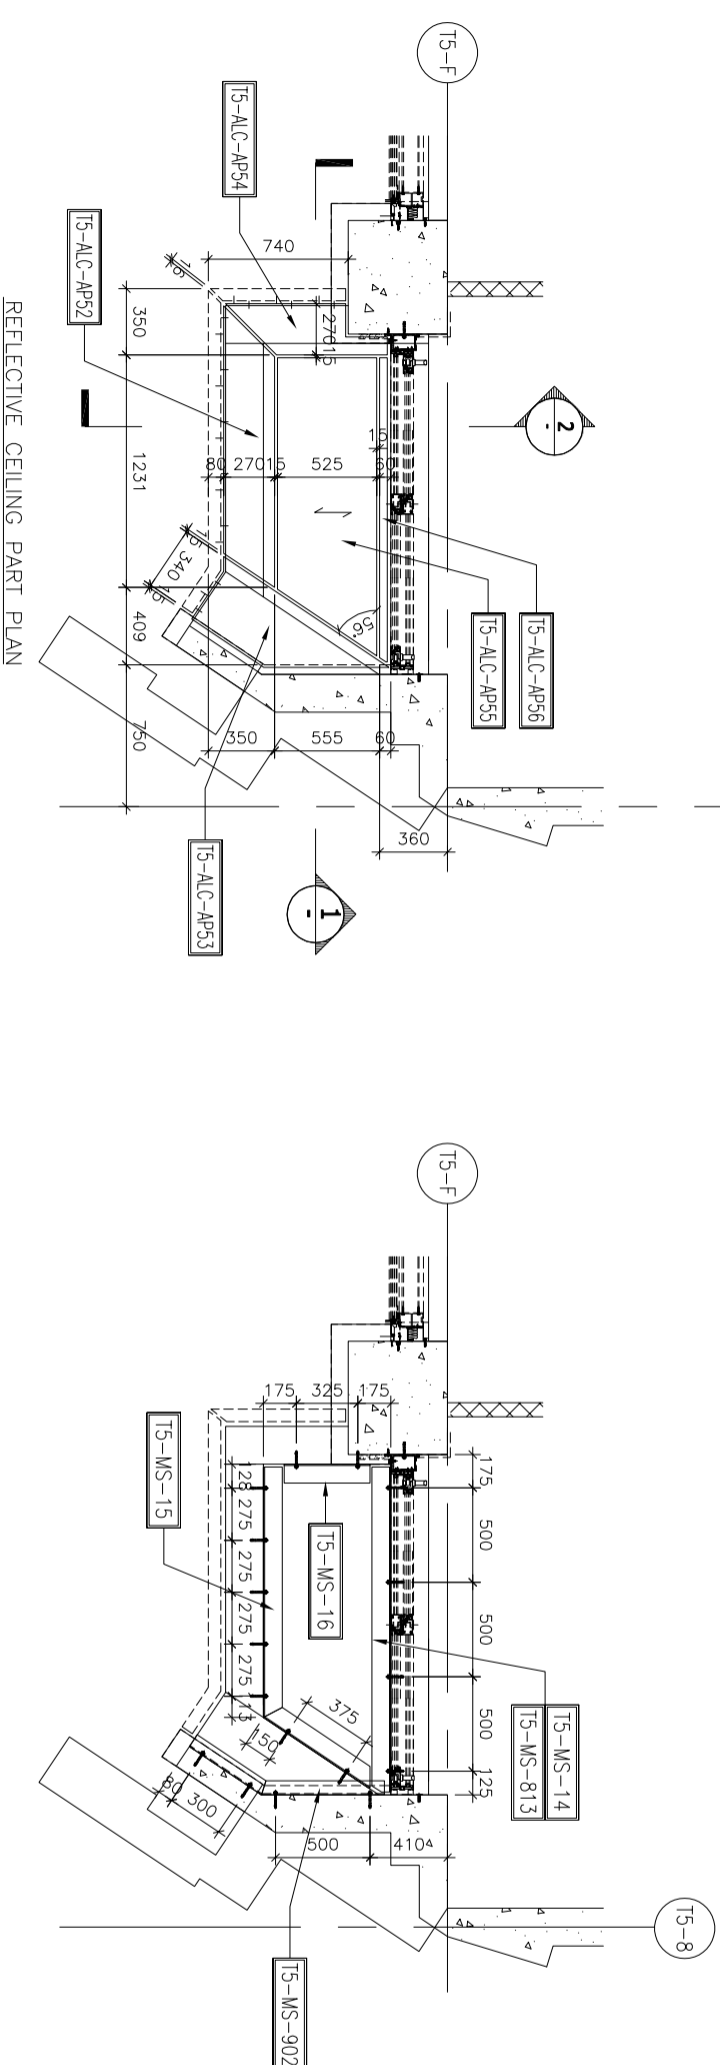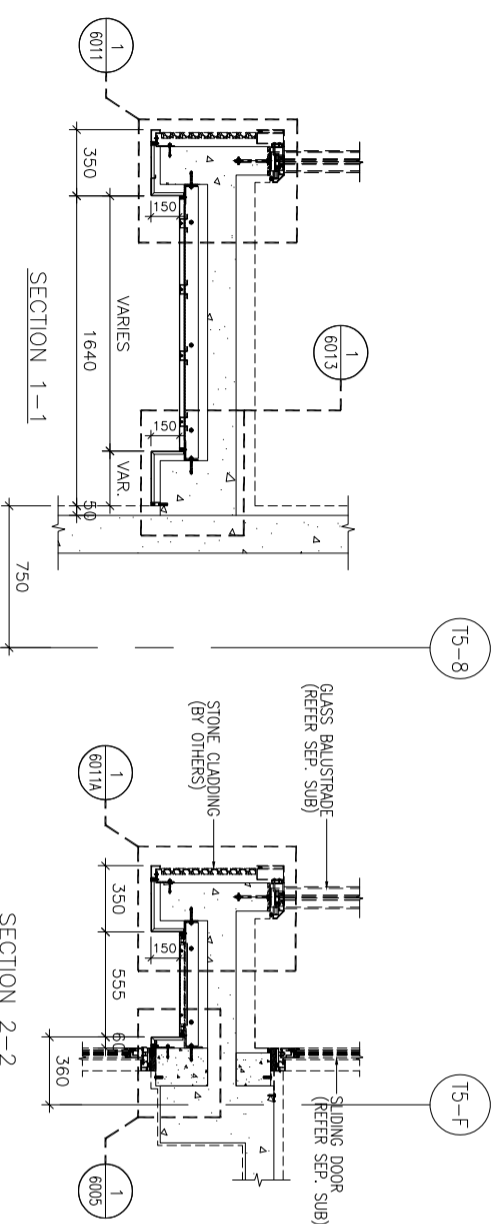

PART PLAN FOR STEEL FRAME & FIXING

REFLECTIVE CEILING PART PLAN

CEILING MARK	TYPE	FLAT	FLOOR(S)	TOTAL
ALC-508A/TSE	NORMAL	E	11/F	1

B.O. REF. :

CLIENT :

**SHIMAO GROUP
HOLDINGS LIMITED**

ARCHITECT :
WONG TUNG & PARTNERS LIMITED
ARCHITECTS & PLANNERS



MAIN CONTRACTOR :
協興建築有限公司
HIP HING CONSTRUCTION CO. LTD

STRUCTURAL ENGINEER :

ICMA C M WONG & ASSOCIATES LTD
黃志明建築工程師有限公司

FAÇADE CONSULTANT :

MEINHARDT

NOTE :

1. ALL DIMENSIONS ARE IN mm.
2. ALL ELEVATIONS ARE VIEWED FROM OUTSIDE.
3. ALL DIMENSIONS TO BE VERIFIED ON SITE BEFORE FABRICATION.

LEGEND :

- X1 --- DETAIL MARK NO.
X001 --- REFER SHEET NO.
1. F.F.L. --- FINISHED FLOOR LEVEL
 2. S.F.L. --- STRUCTURAL FLOOR LEVEL
 3. (R) --- REVERSED DETAIL
 4. [Pattern] --- 3mm THK. ALUM. CEILING

NO.	DATE	REVISION SUBJECT TO ARCH/COMMENT	BY
B	28/07/2022	REVISION SUBJECT TO ARCH/COMMENT	LHR
A	04/07/2022	REVISION SUBJECT TO ARCH/COMMENT	LHR

JOB NO. : J-853

PROJECT : PROPOSED RESIDENTIAL
DEVELOPMENT AT N.K.I.L. 6542
YIN PING ROAD
KOWLOON

TITLE :


ALUM. CEILING FOR
ALC-508A OF MASTER ENSUITE
AT TOWER 5 FLAT E (11/F)

DATE : 06-AUG-21 SCALE : 1 : 40 (A3)

DRAWN BY : LHR CHECKED BY :

美特鋁質有限公司
MIDI ALUMINIUM FABRICATOR LTD.
Units 6-8, Sunny Industrial Centre, 1/F
610 Cho Kwo Ling Road, Kowloon
Tel:23489211-4 Fax:85227272666

DWG NO. : J853-SD-ALC-4512 REV. : B

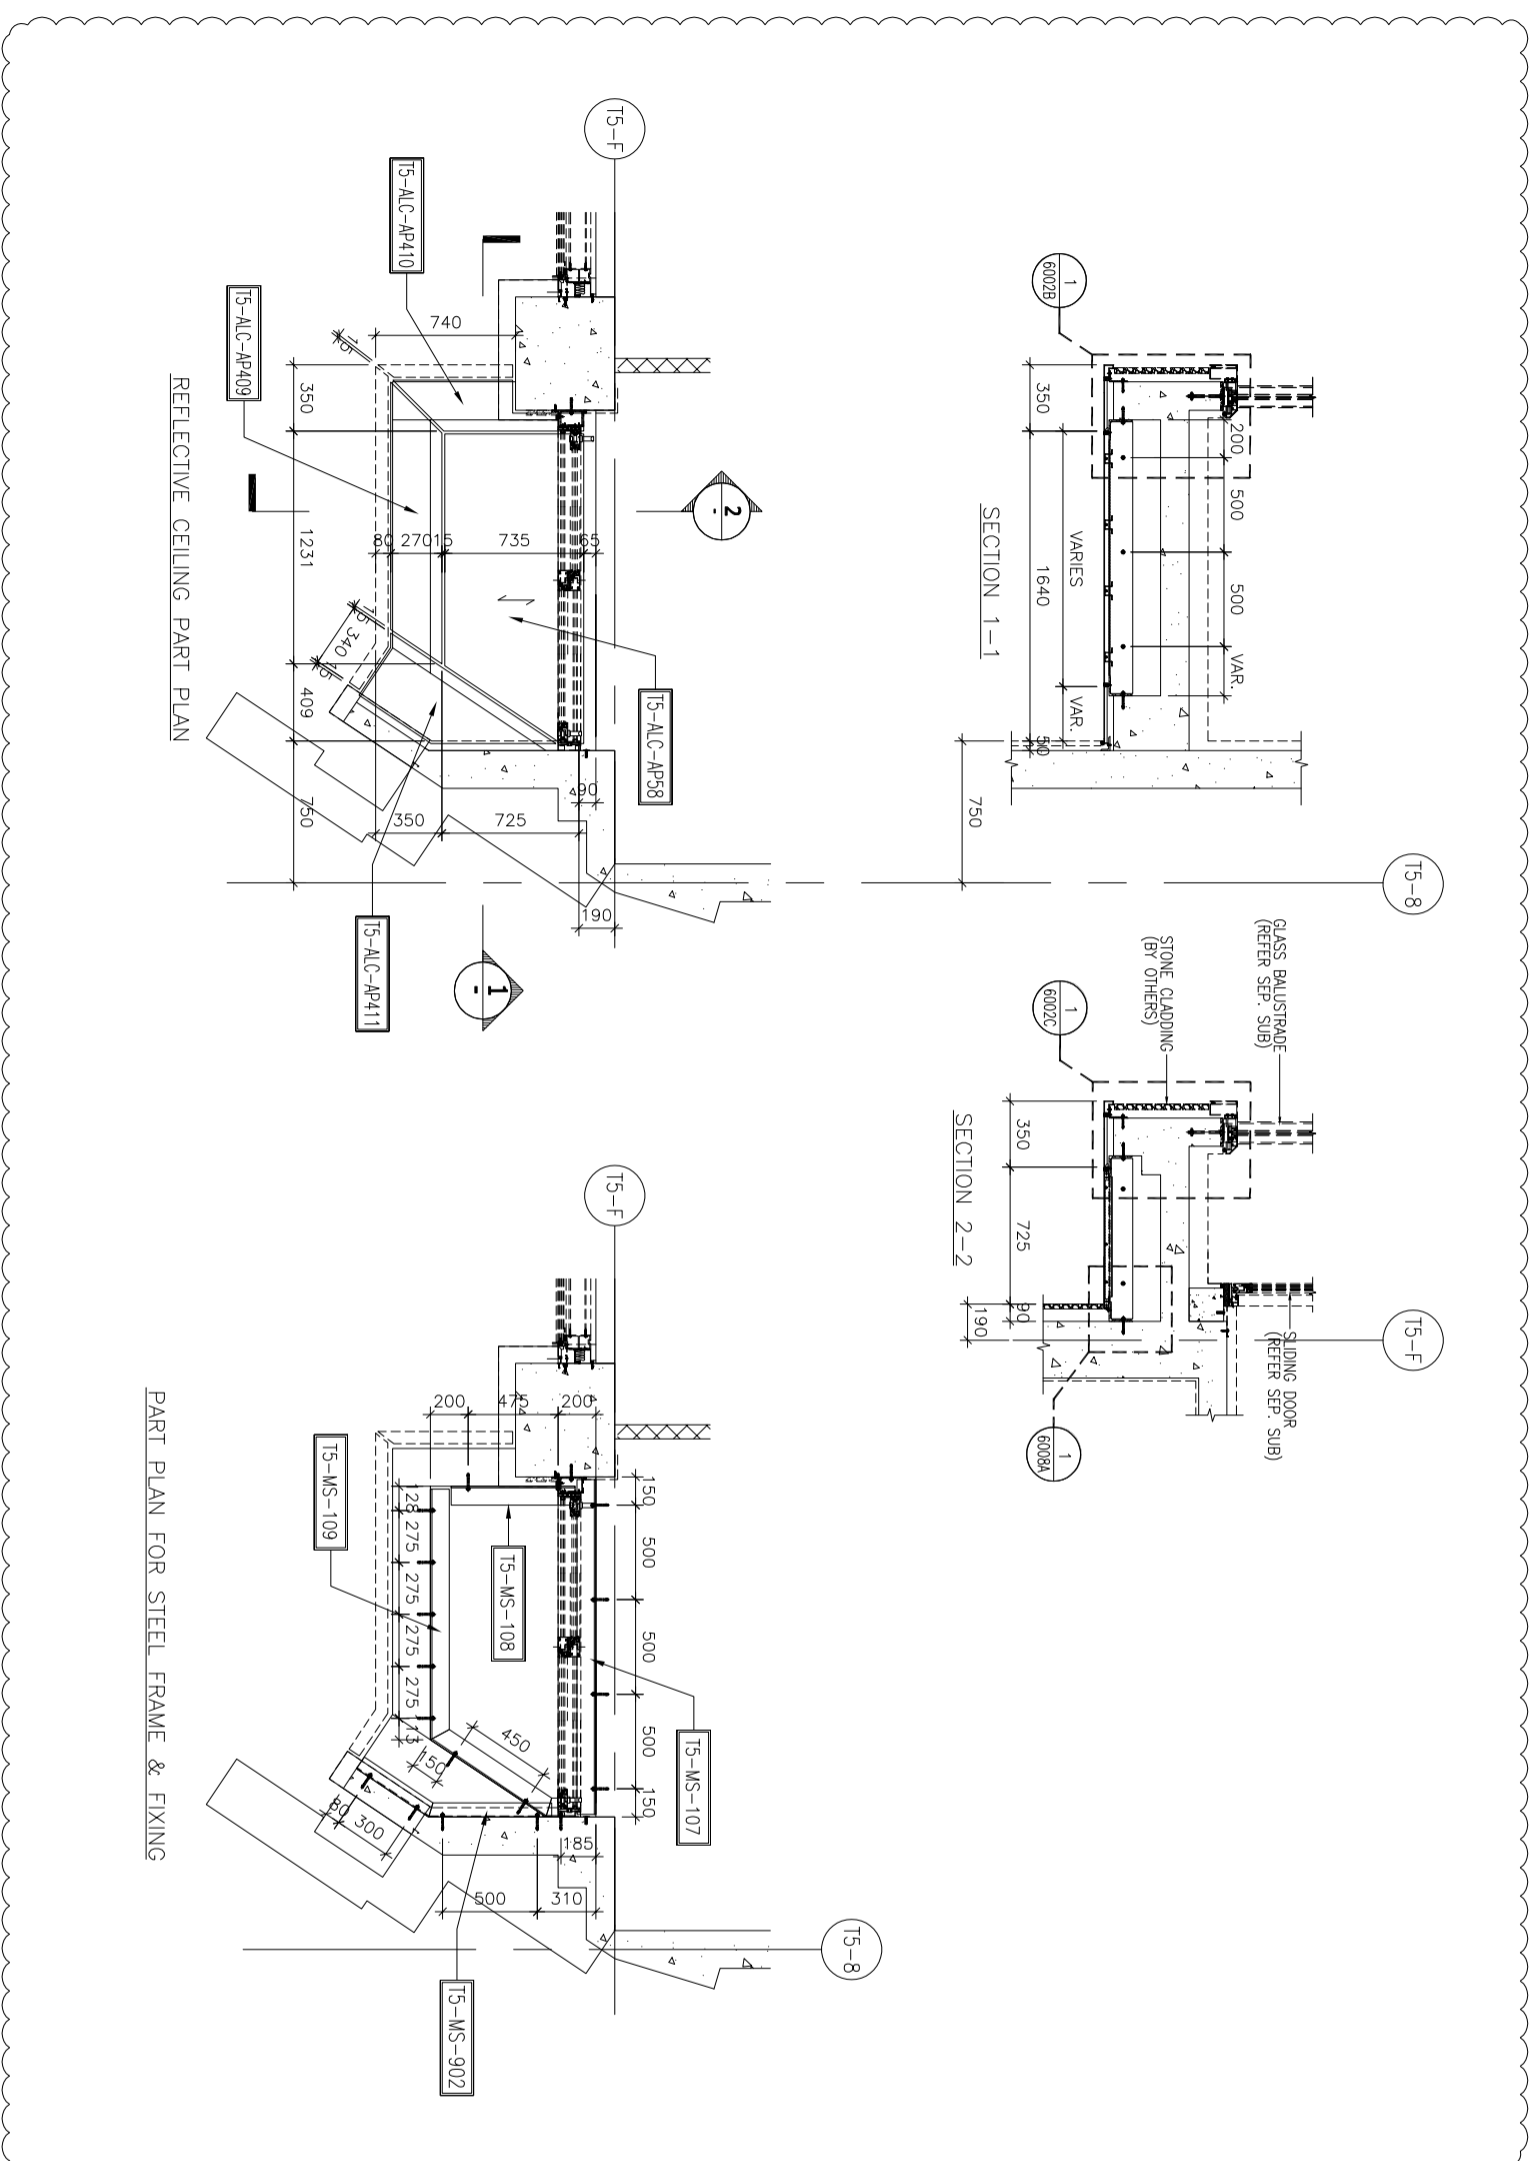

REFLECTIVE CEILING PART PLAN

PART PLAN FOR STEEL FRAME & FIXING

CEILING MARK	TYPE	FLAT	FLOOR(S)	TOTAL
ALC-510A/TSF	NORMAL	F	11/F	1

B.O. REF. :

CLIENT :
SHIMAO GROUP HOLDINGS LIMITED

ARCHITECT :
WONG TUNG & PARTNERS LIMITED
ARCHITECTS & PLANNERS



MAIN CONTRACTOR :
協興建築有限公司
HIP HING CONSTRUCTION CO. LTD

STRUCTURAL ENGINEER :

ICMA C M WONG & ASSOCIATES LTD
黃志明建築工程師有限公司

FAÇADE CONSULTANT :


MEINHARDT

NOTE :

1. ALL DIMENSIONS ARE IN mm.
2. ALL ELEVATIONS ARE VIEWED FROM OUTSIDE.
3. ALL DIMENSIONS TO BE VERIFIED ON SITE BEFORE FABRICATION.

LEGEND :

- X1 --- DETAIL MARK NO.
X001 --- REFER SHEET NO.
1. F.F.L. --- FINISHED FLOOR LEVEL
 2. S.F.L. --- STRUCTURAL FLOOR LEVEL
 3. (R) --- REVERSED DETAIL
 4. [Pattern] --- 3mm THK. ALUM. CEILING

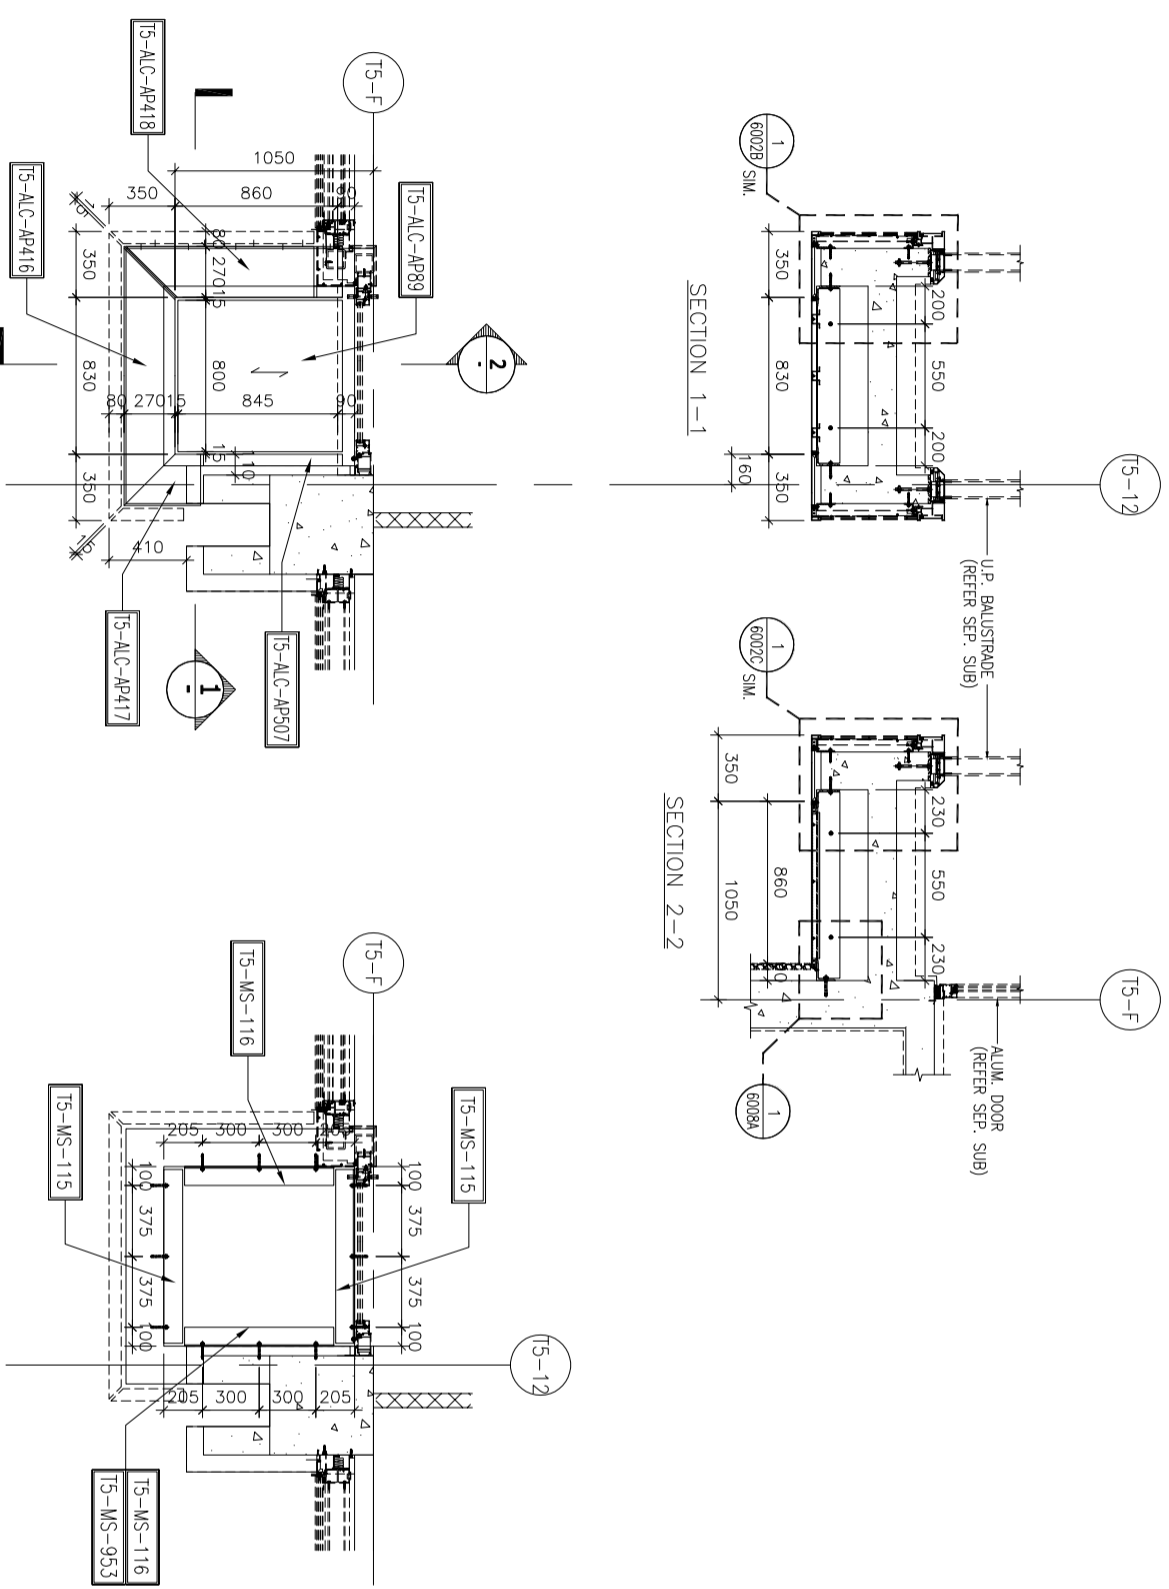

REFLECTIVE CEILING PART PLAN

PART PLAN FOR STEEL FRAME & FIXING

NO.	DATE	REVISION SUBJECT TO ARCH/COMMENT	BY
B	28/07/2022	REVISION SUBJECT TO ARCH/COMMENT	LHR
A	04/01/2022	REVISION SUBJECT TO ARCH/COMMENT	LHR

JOB NO. : J-853

PROJECT :
PROPOSED RESIDENTIAL DEVELOPMENT AT N.K.I.L. 6542
YIN PING ROAD
KOWLOON

TITLE :
ALUM. CEILING FOR ALC-510A OF MASTER ENSUITE AT TOWER 5 FLAT F (11/F)


DATE : 06-AUG-21 SCALE : 1 : 40 (A3)

DRAWN BY : LHR CHECKED BY :

MIDI ALUMINIUM FABRICATOR LTD.
Units 6-8, Sunny Industrial Centre, 1/F
610 Cho Kwo Ling Road, Kowloon
Tel:23489211-4 Fax:8522727666
DWG NO. : J853-SD-ALC-4516 REV. : B


CEILING MARK	TYPE	FLAT	FLOOR(S)	TOTAL
ALC-513/758	NORMAL	B	18/F~28/F	8

B.O. REF. :

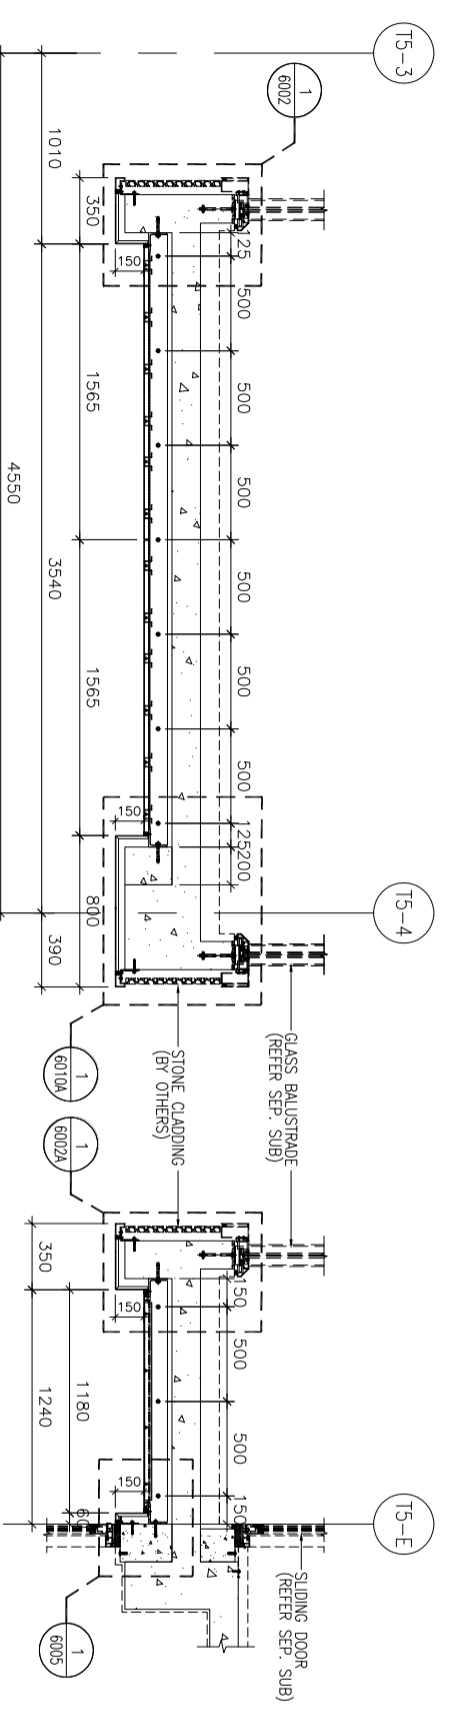


SECTION 1-1

SECTION 2-2

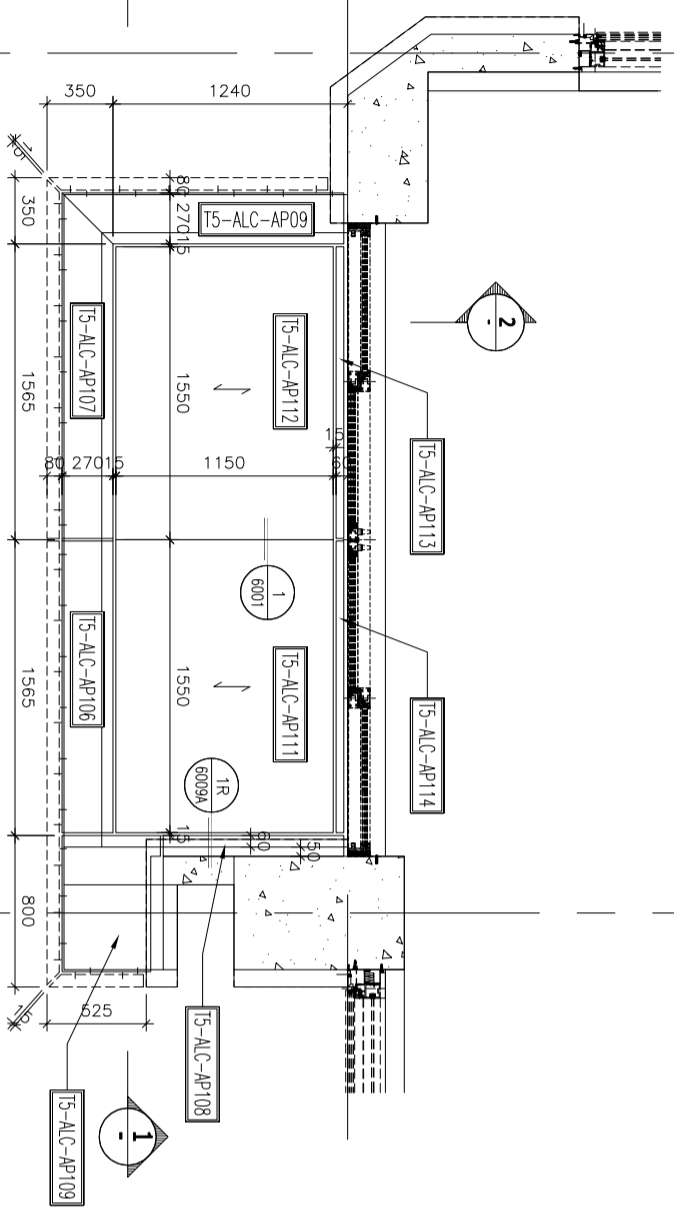

REFLECTIVE CEILING PART PLAN

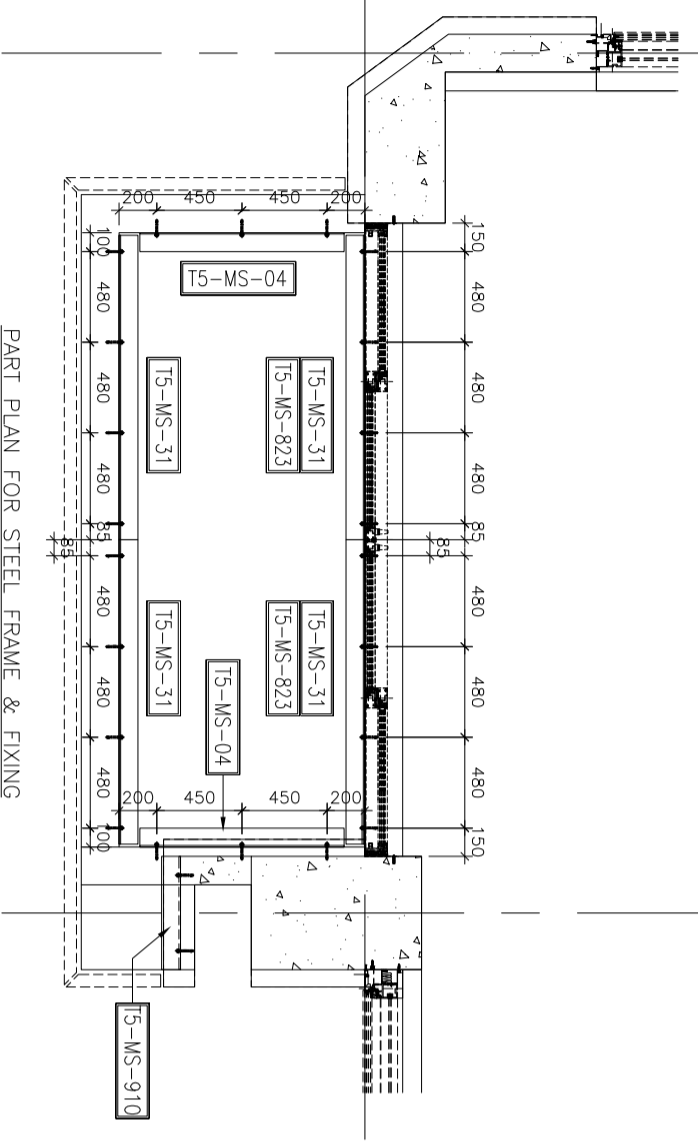

PART PLAN FOR STEEL FRAME & FIXING

NO.	DATE	REVISION SUBJECT TO ARCHITECT COMMENT	BY
B	28/07/2022	REVISION SUBJECT TO ARCHITECT COMMENT	LHR
A	04/01/2022	REVISION SUBJECT TO ARCHITECT COMMENT	LHR

JOB NO. : J-853

PROJECT : PROPOSED RESIDENTIAL DEVELOPMENT AT N.K.I.L. 6542 YIN PING ROAD KOWLOON

TITLE : ALUM. CEILING FOR ALC-513 OF LV./DIN. AT TOWER 5 FLAT B (18/F~28/F) (EXCEPT 24/F)

DATE : 06-AUG-21 SCALE : 1 : 40 (A3)

DRAWN BY : LHR CHECKED BY :



Units 6-8, Sunny Industrial Centre, 1/F
610 Che Kwo Ling Road, Kowloon
Tel:23489211-4 Fax:8522727666

DWG NO. : J853-SD-ALC-4519 REV. : B

CLIENT : SHIMAO GROUP HOLDINGS LIMITED

ARCHITECT : WONG TUNG & PARTNERS LIMITED ARCHITECTS & PLANNERS

MAIN CONTRACTOR : 協興建築有限公司 HIP HING CONSTRUCTION CO. LTD

STRUCTURAL ENGINEER : C M WONG & ASSOCIATES LTD 黃志明建築工程師有限公司

FAÇADE CONSULTANT : WEINHARDT


NOTE : 1. ALL DIMENSIONS ARE IN mm. 2. ALL ELEVATIONS ARE VIEWED FROM OUTSIDE. 3. ALL DIMENSIONS TO BE VERIFIED ON SITE BEFORE FABRICATION.

LEGEND : X1 -- DETAIL MARK NO. X201 -- REFER SHEET NO.


1. F.F.L. -- FINISHED FLOOR LEVEL
2. S.F.L. -- STRUCTURAL FLOOR LEVEL
3. (R) -- REVERSED DETAIL
4. [Pattern] -- 3mm THK. ALUM CEILING

CEILING MARK	TYPE	FLAT	FLOOR(S)	TOTAL
ALC-513A/TSB	NORMAL	B	17/F	1


B.O. REF. :

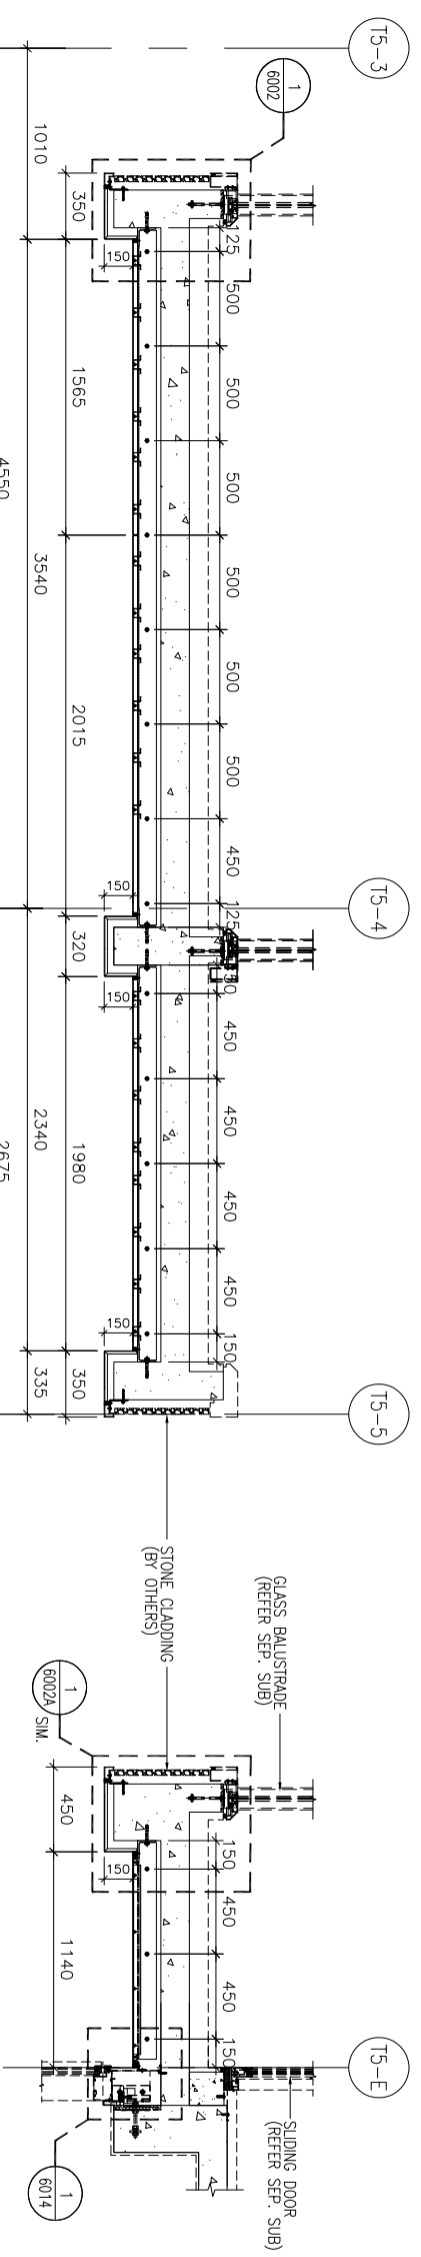


SECTION 1-1

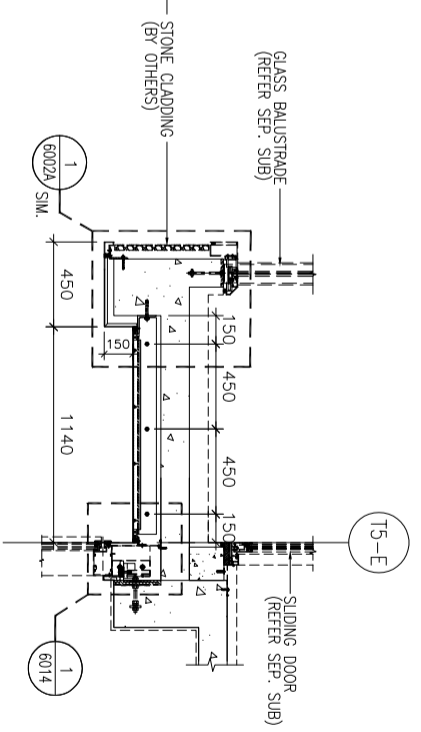


SECTION 2-2

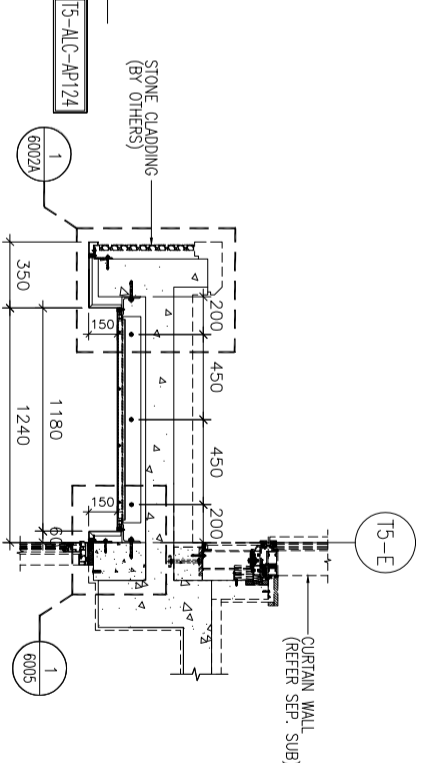

SECTION 3-3

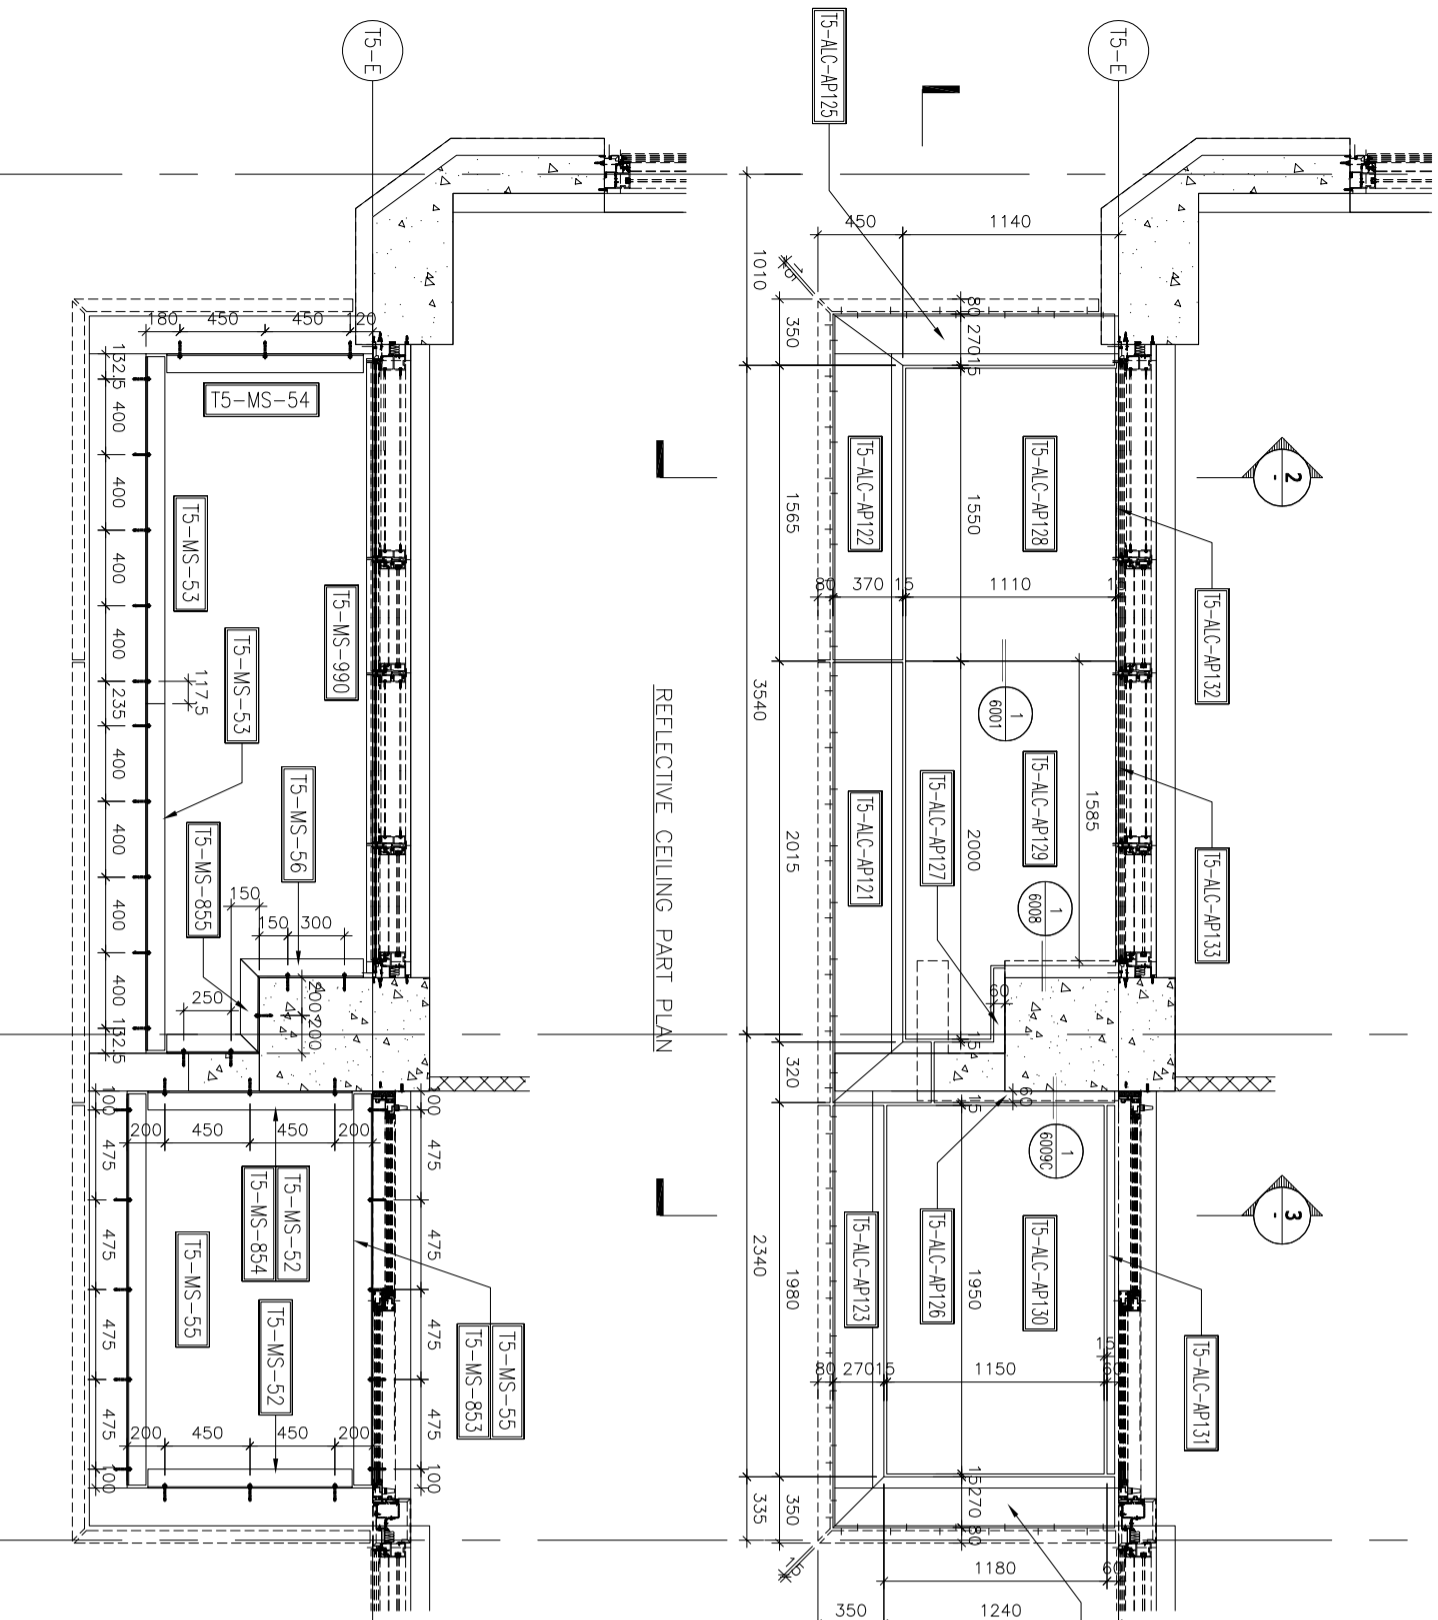

REFLECTIVE CEILING PART PLAN

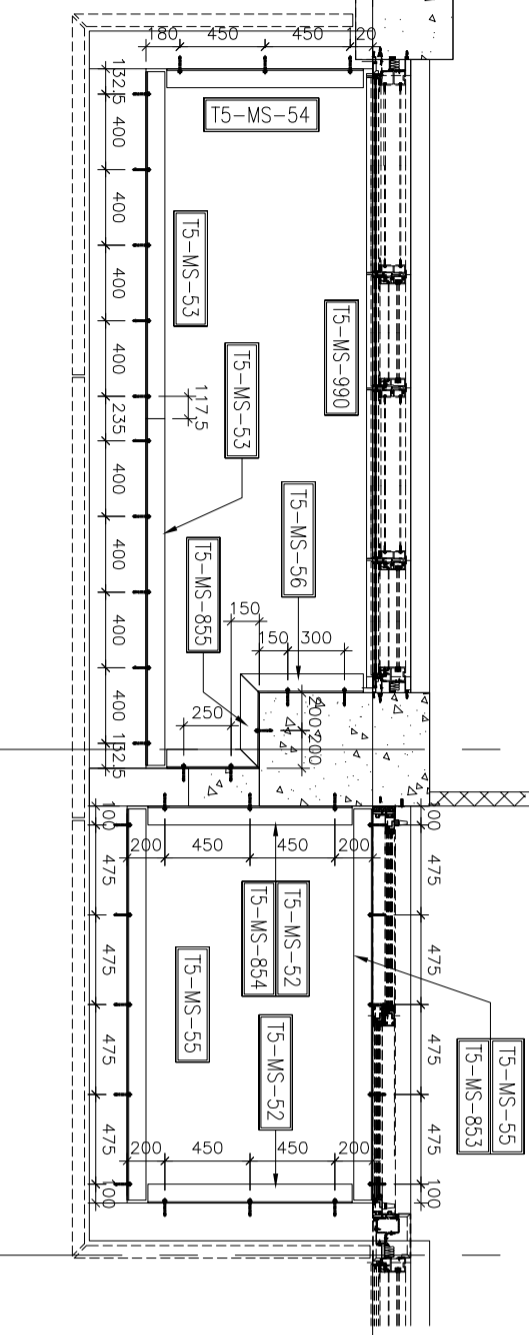

PART PLAN FOR STEEL FRAME & FIXING

新增

CLIENT : SHIMAO GROUP HOLDINGS LIMITED

ARCHITECT : WONG TUNG & PARTNERS LIMITED ARCHITECTS & PLANNERS

MAIN CONTRACTOR : 協興建築有限公司 HWP HING CONSTRUCTION CO. LTD

STRUCTURAL ENGINEER : C M WONG & ASSOCIATES LTD 黃志明建築工程師有限公司





FAÇADE CONSULTANT : WEINHARDT

NOTE :
 1. ALL DIMENSIONS ARE IN mm.
 2. ALL ELEVATIONS ARE VIEWED FROM OUTSIDE.
 3. ALL DIMENSIONS TO BE VERIFIED ON SITE BEFORE FABRICATION.
 LEGEND :
 X1 --- DETAIL MARK NO.
 X001 --- REFER SHEET NO.
 1. F.F.L. --- FINISHED FLOOR LEVEL
 2. S.F.L. --- STRUCTURAL FLOOR LEVEL
 3. (R) --- REVERSED DETAIL
 4. [Hatched Box] --- 3mm THK ALUM CEILING

NO.	DATE	REVISION	BY
JOB NO. :	J-853		
PROJECT :	PROPOSED RESIDENTIAL DEVELOPMENT AT N.K.I.L. 6542 YIN PING ROAD KOWLOON		
TITLE :	ALUM. CEILING FOR ALC-513A OF LIV./DIN. AT TOWER 5 FLAT B (17/F)		
DATE :	29-JUL-22	SCALE :	1 : 40 (A3)
DRAWN BY :	LHR	CHECKED BY :	
Units 6-8, Sunny Industrial Centre, 1/F 610 Che Kwo Ling Road, Kowloon Tel:23489211-4 Fax:85227272666 DWG NO. : J853-SD-ALC-4520 REV. : B			

CEILING MARK	TYPE	F.LAT	FLOOR(S)	TOTAL
ALC-512A/75A	NORMAL	A	26/F	1

B.O. REF :

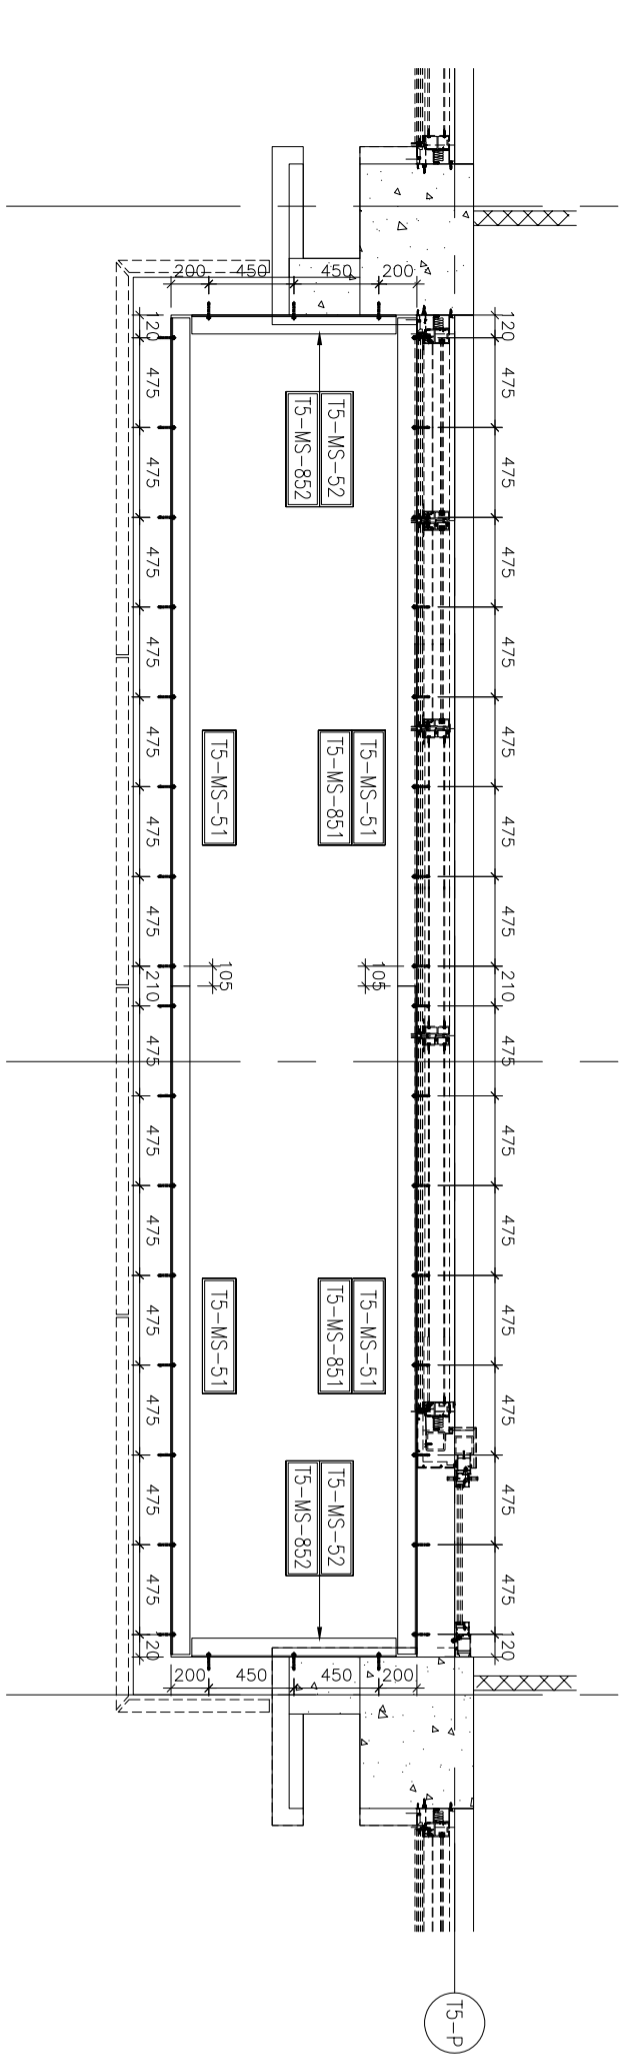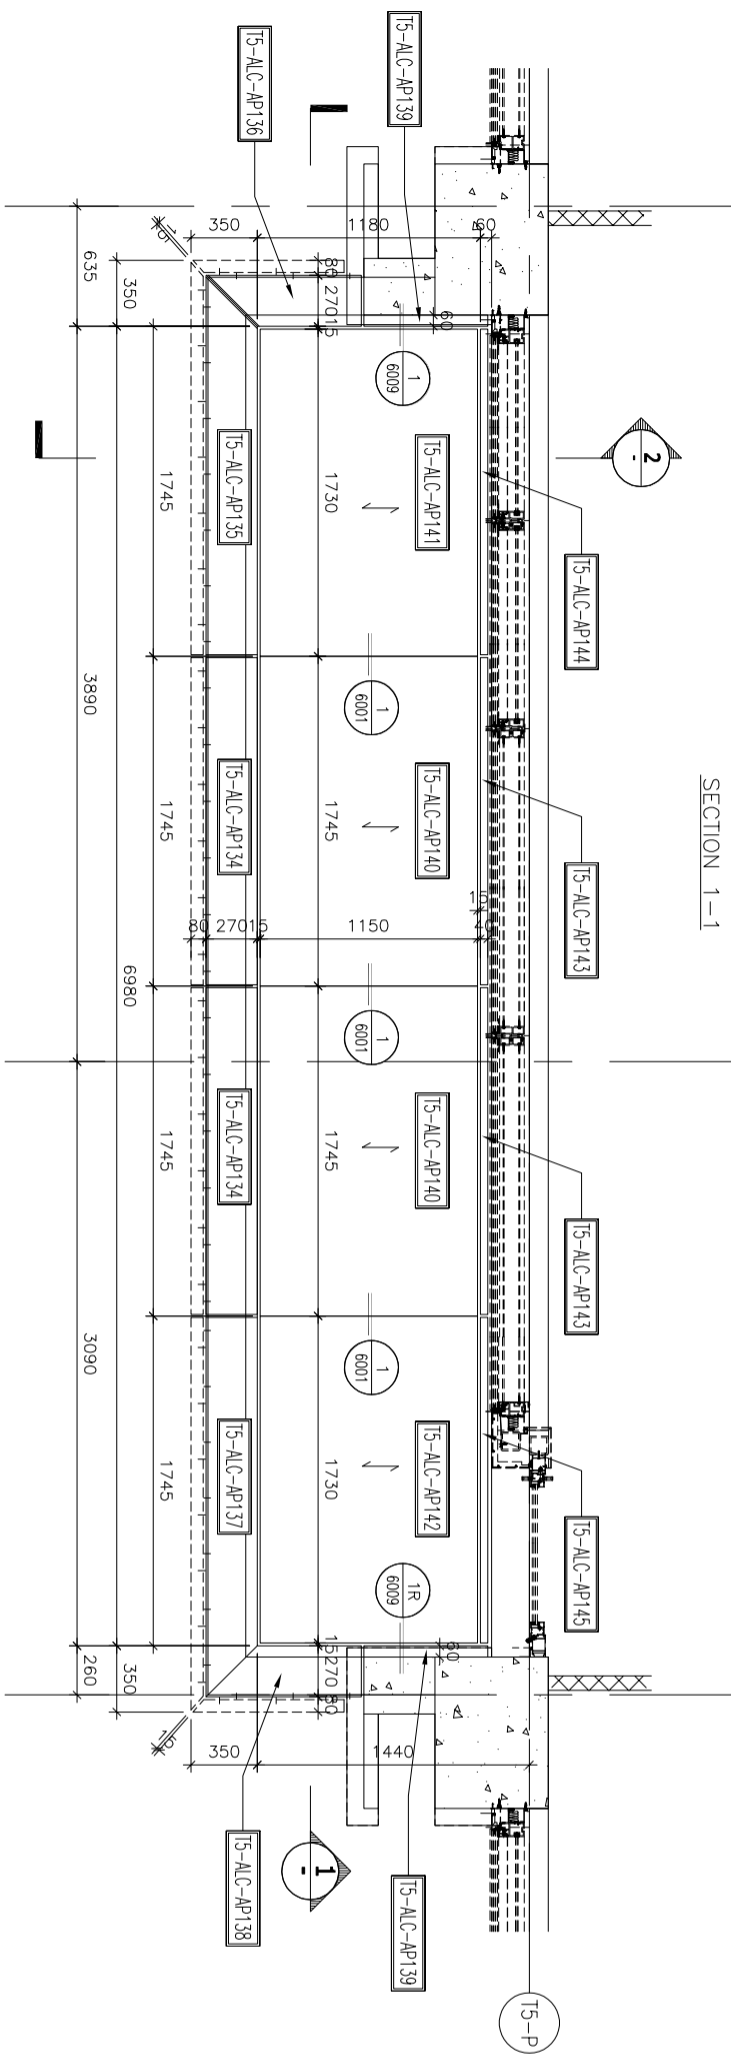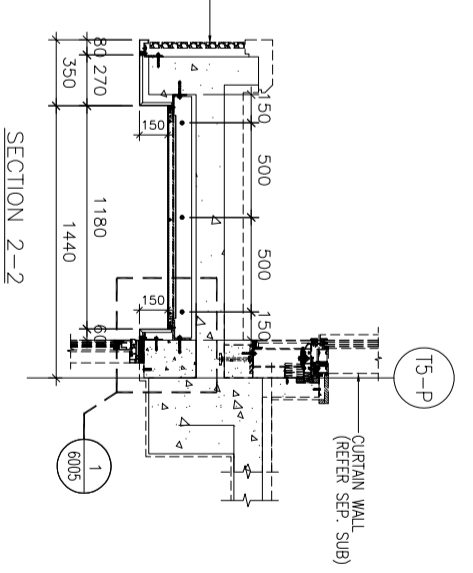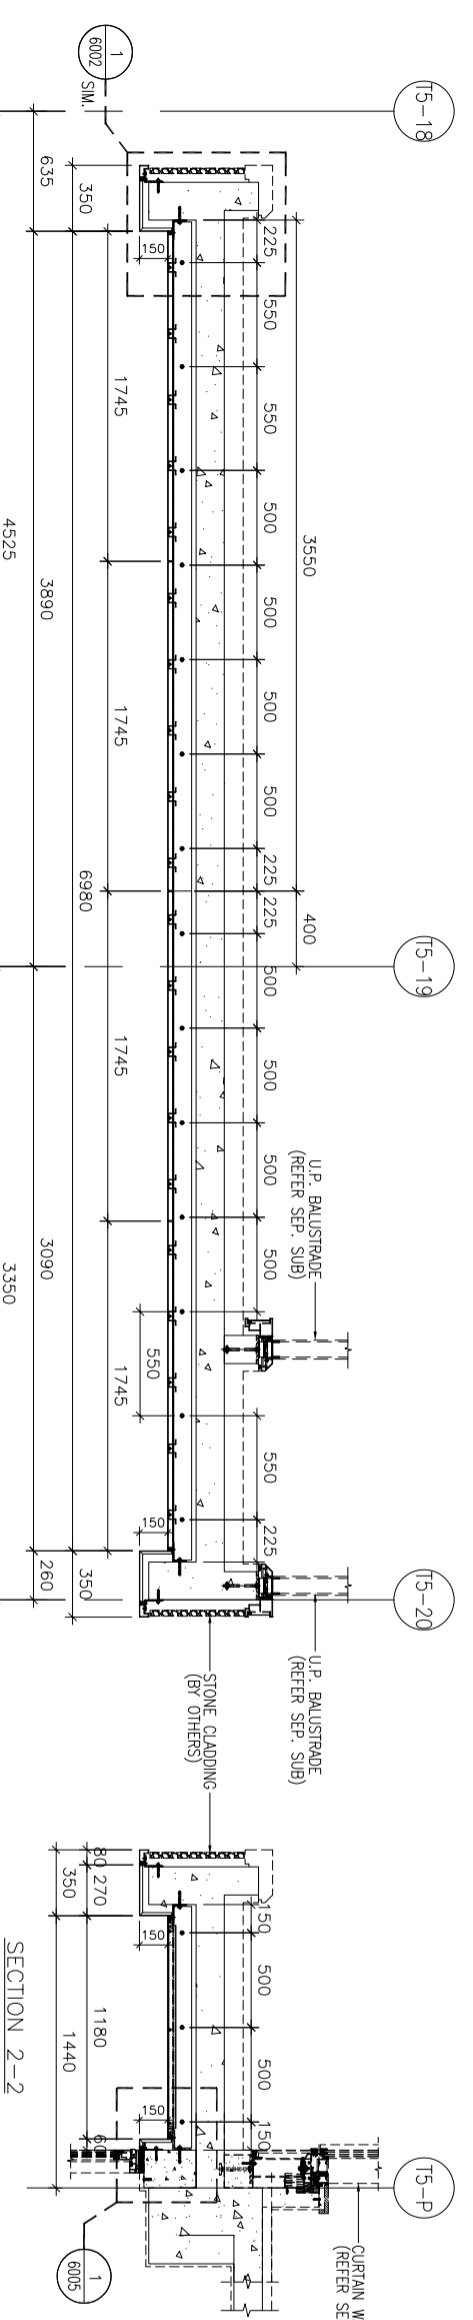

新增

CLIENT :
SHIMAO GROUP HOLDINGS LIMITED

ARCHITECT :
WONG TUNG & PARTNERS LIMITED
ARCHITECTS & PLANNERS

MAIN CONTRACTOR :
協興建築有限公司
HIP HING CONSTRUCTION CO. LTD

STRUCTURAL ENGINEER :
ICMA C M WONG & ASSOCIATES LTD
黃志明建築工程師有限公司

FAÇADE CONSULTANT :
WEINHARDT

NOTE :
1. ALL DIMENSIONS ARE IN mm.
2. ALL ELEVATIONS ARE VIEWED FROM OUTSIDE.
3. ALL DIMENSIONS TO BE VERIFIED ON SITE BEFORE FABRICATION.

LEGEND :
X1 --- DETAIL MARK NO.
X001 --- REFER SHEET NO.

1. F.F.L. --- FINISHED FLOOR LEVEL
2. S.F.L. --- STRUCTURAL FLOOR LEVEL
3. (R) --- REVERSED DETAIL
4. --- 3mm THK. ALUM. CEILING

NO. DATE REVISION BY

JOB NO. : J-853

PROJECT : PROPOSED RESIDENTIAL DEVELOPMENT AT N.K.I.L. 6542 YIN PING ROAD KOWLOON

TITLE : ALUM. CEILING FOR ALC-512A OF LIV./DIN. AT TOWER 5 FLAT A (26/F)

DATE : 29-JUL-22 SCALE : 1 : 40 (A3)

DRAWN BY : LHR CHECKED BY :

美特鋁質有限公司
MIDI ALUMINIUM FABRICATOR LTD.
Units 6-8, Sunny Industrial Centre, 1/F
610 Che Kwo Ling Road, Kowloon
Tel: 23489211-4 Fax: (852) 27727666

DWG NO. : J853-SD-ALC-4521 REV. : B

PART PLAN FOR STEEL FRAME & FIXING