

工程指示 / 要求簡箋 ENGINEER INSTRUCTIONS(E.I.)

工程指示編號:	EI- 4869C	修改版本:	C
	HK- 1528		
工程編號:	J 853	工程名稱:	大窩坪 (延坪道)
收件人:	生統	發件人:	Lai Sik Hung
工程項目:	T1及T7 幕牆單元背板生產 大貨 (修訂C:T1修改分格高度及避地台碼位)	日期:	05/09/2022

<input type="checkbox"/> 原合約工程包	<input type="checkbox"/> 原合約工程加 / 減賬 QT-	<input type="checkbox"/> 新工程報價 QT-
---------------------------------	--	------------------------------------

信件批核號碼/圖紙參考編號:	批核模具圖紙編號:
客戶指示附件:	管理內部批簽署:

<input type="checkbox"/> 初步鋁料 B.M.	<input type="checkbox"/> 加工拆圖, 然後生產	<input type="checkbox"/> 尺寸表
<input type="checkbox"/> 正式鋁料 B.M.	<input type="checkbox"/> 技術上資料/指示	<input type="checkbox"/> 報價
<input type="checkbox"/> 配件 B.M.	<input type="checkbox"/> 樣辦或貨品說明書	<input type="checkbox"/> 分判合約
<input type="checkbox"/> 其他:		

內容: 修訂C : T1修改分格高度及避地台碼位

T1及T7 幕牆單元背板生產 大貨
17樓以上待另行通知才生產

完成上列要求日期: 26/09/2022

國內

<input type="checkbox"/> 生產技術總監	<input type="checkbox"/> 連附件	<input checked="" type="checkbox"/> 技術部	<input checked="" type="checkbox"/> 連附件	<input type="checkbox"/> 生產部	<input type="checkbox"/> 連附件
<input type="checkbox"/> 採購部	<input type="checkbox"/> 連附件	<input checked="" type="checkbox"/> 生產統籌部	<input checked="" type="checkbox"/> 連附件	<input type="checkbox"/> 報關組	<input type="checkbox"/> 連附件
<input type="checkbox"/> 質檢部	<input type="checkbox"/> 連附件	<input type="checkbox"/> 會計部	<input type="checkbox"/> 連附件	<input type="checkbox"/> 機械設計部	<input type="checkbox"/> 連附件
<input checked="" type="checkbox"/> 香港辦	<input checked="" type="checkbox"/> 連附件	<input type="checkbox"/> 其他:			

<input type="checkbox"/> 行政部	<input type="checkbox"/> 連附件	<input type="checkbox"/> 會計部	<input type="checkbox"/> 連附件	<input type="checkbox"/> 統籌部	<input type="checkbox"/> 連附件	<input type="checkbox"/> 工程部	<input type="checkbox"/> 連附件
<input type="checkbox"/> 採購部	<input type="checkbox"/> 連附件	<input type="checkbox"/> QS部	<input type="checkbox"/> 連附件	<input type="checkbox"/> 地盤管理	<input type="checkbox"/> 連附件	<input type="checkbox"/> 維修部	<input type="checkbox"/> 連附件

*發件人簽署:

鴻

*組別成員批核簽署:

Wan 7/9/2022
Wan

傳遞編號:

項目經理簽署:

圖則登記表

DRAWING REGISTER

工程名稱 Project Title:		九龍延坪道 大貨 (T1座)幕牆背板		接收日期 Receiving Date (適用於客戶圖則)						
工程編號 Project No:		J-853		年						
				月						
				日						
分發予 Distributed To				發出日期 Issued Date						
				年	22	22				
				月	4	9				
				日	14	2				
圖則編號 Drg. No.	圖則名稱 Drawing Title	修訂編號 Revision No.								
DBP-14k	背板拆圖	1a	-	新增						
DBP-06k(2)	背板拆圖	2a	-	新增						
DBP-06c	背板拆圖	3a	-	新增						
DBP-06L	梗窗背板拆圖	4a	-	新增						
DBP-111L	轉角梗窗背板拆圖	5a	-	新增						
DBP-06	背板拆圖	1	-	A						
DBP-6-SJ	背板拆圖數據表	2	-	A						
DBP-12d	背板拆圖	3	-	A						
DBP-06a	背板拆圖	4	-	A						
DBP-06a-SJ	背板拆圖數據表	5	-	A						
DBP-06b	背板拆圖	6	-	取消						
DBP-06k	背板拆圖	7	-	取消						
DBP-06x	背板拆圖	8	-	A						
DBP-06x-SJ	背板拆圖數據表	9	-	A						
DBP-115L	梗窗背板拆圖	10	-	-						
DBP-15	轉角生窗背板拆圖	11	-	A						
DBP-109	轉角梗窗背板拆圖	12	-	A						
DBP-111	轉角梗窗背板拆圖	13	-	A						
DBP-41	轉角生窗背板拆圖	14	-	A						
DBP-15K	轉角生窗背板拆圖	15	-	A						
DBP-109K	轉角梗窗背板拆圖	16	-	A						
DBP-111a	轉角梗窗背板拆圖	17	-	A						
DBP-41a	轉角生窗背板拆圖	18	-	A						
DBP-115R	梗窗背板拆圖	19	-	-						
J853-SD-CW-4101	背板位置图	20	-	A						
J853-SD-CW-4102	背板位置图	21	-	A						
J853-SD-CW-4103	背板位置图	22	-	A						
J853-SD-CW-4104	背板位置图	23	-	A						
J853-SD-CW-4105	背板位置图	24	-	A						
J853-SD-CW-4106	背板位置图	25	-	A						

美特鋁質 MIDI Aluminium Fabricator Ltd.		工程號: J-853		計算: 陳敬聰		日期: 2022.04.13		送呈:							
廠用鋁背板B.M.表		地盤名稱: 延坪道住宅		核對: 謝永林		日期: 2022.09.02		副本:							
項目類別: 修正版次:		A 2022.9.2		批准:		日期:		A/C Code:							
		總V.F.: 452.13		總重量: 3114.39											
序號	修改內容	鋁板圖號	鋁板名稱	顏色	實用	後備	總數	總重量	單件展開面積m ²	單件V.F. m ³	展開面積m ²	單件V.F. m ³	位置	樓層	類型
1		DBP-6	2mm厚鋁板	UCT542049SC-3(淺灰)	45		45	144.81	26.718	0.42	18.979	0.42	J853-SD-CW-4101	5/F-21/F	標準層
2	取消(原957.5)	DBP-6	2mm厚鋁板	UCT542049SC-3(淺灰)	0		0	0.00	0.000	0.00	0.000	0.00	J853-SD-CW-4101	22/F	標準層
3		DBP-6	2mm厚鋁板	UCT542049SC-3(淺灰)	45		45	144.81	26.718	0.42	18.979	0.42	J853-SD-CW-4101	5/F-21/F	標準層
4	取消(原957.5)	DBP-6	2mm厚鋁板	UCT542049SC-3(淺灰)	0		0	0.00	0.000	0.00	0.000	0.00	J853-SD-CW-4101	22/F	標準層
5		DBP-6	2mm厚鋁板	UCT542049SC-3(淺灰)	1		1	3.22	0.594	0.42	0.422	0.42	J853-SD-CW-4103	23/F	標準層
6		DBP-6	2mm厚鋁板	UCT542049SC-3(淺灰)	30		30	96.54	17.812	0.42	12.653	0.42	J853-SD-CW-4104	5/F-21/F	標準層
7		DBP-6	2mm厚鋁板	UCT542049SC-3(淺灰)	3		3	9.65	1.781	0.42	1.265	0.42	J853-SD-CW-4106	23/F	標準層
8		DBP-10	2mm厚鋁板	UCT542049SC-3(淺灰)	1		1	3.48	0.641	0.46	0.463	0.46	J853-SD-CW-4104	23/F	標準層
9		DBP-13	2mm厚鋁板	UCT542049SC-3(淺灰)	30		30	158.43	29.230	0.76	22.655	0.76	J853-SD-CW-4104	5/F-21/F	標準層
10	取消(原957.5)	DBP-13	2mm厚鋁板	UCT542049SC-3(淺灰)	0		0	0.00	0.000	0.00	0.000	0.00	J853-SD-CW-4106	23/F	標準層
11		DBP-14	2mm厚鋁板	UCT542049SC-3(淺灰)	14		14	82.24	15.173	0.85	11.914	0.85	J853-SD-CW-4102	6/F-21/F	標準層
12		DBP-20	2mm厚鋁板	UCT542049SC-3(淺灰)	28		28	118.99	21.953	0.59	16.477	0.59	J853-SD-CW-4102	6/F-21/F	標準層
13		DBP-23	2mm厚鋁板	UCT542049SC-3(淺灰)	16		16	72.12	13.306	0.63	10.082	0.63	J853-SD-CW-4103	5/F-22/F	標準層
14	取消(原957.5)	DBP-25	2mm厚鋁板	UCT542049SC-3(淺灰)	0		0	0.00	0.000	0.00	0.000	0.00	J853-SD-CW-4106	23/F	標準層
15		DBP-30	2mm厚鋁板	UCT542049SC-3(淺灰)	1		1	5.02	0.927	0.71	0.713	0.71	J853-SD-CW-4106	23/F	標準層
16		DBP-101	2mm厚鋁板	UCT542049SC-3(淺灰)	15		15	122.73	22.643	1.22	18.360	1.22	J853-SD-CW-4101	5/F-21/F	標準層
17	取消一個	DBP-102	2mm厚鋁板	UCT542049SC-3(淺灰)	15		15	165.27	30.493	1.68	25.236	1.68	J853-SD-CW-4101	5/F-21/F	標準層
18	取消二個	DBP-103	2mm厚鋁板	UCT542049SC-3(淺灰)	14		14	154.25	28.460	1.68	23.554	1.68	J853-SD-CW-4101	6/F-21/F	標準層
19		DBP-104	2mm厚鋁板	UCT542049SC-3(淺灰)	15		15	122.73	22.643	1.22	18.360	1.22	J853-SD-CW-4101	5/F-21/F	標準層
20		DBP-105	2mm厚鋁板	UCT542049SC-3(淺灰)	3		3	28.22	5.207	1.42	4.266	1.42	J853-SD-CW-4102	23/F	標準層
21		DBP-107	2mm厚鋁板	UCT542049SC-3(淺灰)	28		28	277.82	51.259	1.51	42.148	1.51	J853-SD-CW-4102	6/F-21/F	標準層
22		DBP-108	2mm厚鋁板	UCT542049SC-3(淺灰)	1		1	5.87	1.084	0.85	0.851	0.85	J853-SD-CW-4102	5/F	標準層
23		DBP-110	2mm厚鋁板	UCT542049SC-3(淺灰)	15		15	128.72	23.749	1.29	19.329	1.29	J853-SD-CW-4103	5/F-21/F	標準層
24		DBP-112	2mm厚鋁板	UCT542049SC-3(淺灰)	15		15	80.37	14.829	0.77	11.515	0.77	J853-SD-CW-4104	5/F-21/F	標準層
25		DBP-114	2mm厚鋁板	UCT542049SC-3(淺灰)	3		3	31.31	5.778	1.59	4.766	1.59	J853-SD-CW-4104	23/F	標準層
26		DBP-114	2mm厚鋁板	UCT542049SC-3(淺灰)	30		30	313.14	57.775	1.59	47.660	1.59	J853-SD-CW-4104	5/F-21/F	標準層
27		DBP-115	2mm厚鋁板	UCT542049SC-3(淺灰)	1		1	6.57	1.212	0.96	0.964	0.96	J853-SD-CW-4104	23/F	標準層
28		DBP-117	2mm厚鋁板	UCT542049SC-3(淺灰)	1		1	8.76	1.617	1.32	1.318	1.32	J853-SD-CW-4104	23/F	標準層
29		DBP-118	2mm厚鋁板	UCT542049SC-3(淺灰)	15		15	76.31	14.080	0.72	10.858	0.72	J853-SD-CW-4104	5/F-21/F	標準層
30		DBP-119	2mm厚鋁板	UCT542049SC-3(淺灰)	15		15	56.97	10.512	0.52	7.733	0.52	J853-SD-CW-4104	5/F-21/F	標準層

美特鋁質 MIDI Aluminium Fabricator Ltd.		工程號: J-853		計算: 陳敬聰		日期: 2022.04.13		送呈:							
廠用鋁背板B.M.表		地盤名稱: 延坪道住宅		核對: 謝永林		日期: 2022.09.02		副本:							
項目類別: 修正版次:		項目類別: T1座幕牆背板		批准:		日期:		A/C Code:							
		A 2022.9.2		總V.F.: 452.13		總重量: 3114.39									
序號	修改內容	鋁板圖號	鋁板名稱	顏色	實用	後備	總數	總重量	單件展開面積m ²	單件V.F. m ²	總展開面積 m ²	單件V.F. m ²	位置	樓層	類型
31		DBP-120	2mm厚鋁板	UCT542049SC-3(淺灰)	1		1	2.96	0.55	0.38	0.546	0.38	J853-SD-CW-4104	23/F	標準層
32		DBP-124	2mm厚鋁板	UCT542049SC-3(淺灰)	1		1	6.52	1.20	0.96	1.203	0.955	J853-SD-CW-4106	23/F	標準層
33		DBP-12d	2mm厚鋁板	UCT542049SC-3(淺灰)	2		2	7.47	0.69	0.51	1.378	1.010	J853-SD-CW-4105	23/F	標準層雙掛碼
34		DBP-12d	2mm厚鋁板	UCT542049SC-3(淺灰)	2		2	7.47	0.69	0.51	1.378	1.010	J853-SD-CW-4105	23/F	標準層雙掛碼
35		DBP-20d	2mm厚鋁板	UCT542049SC-3(淺灰)	2		2	8.50	0.78	0.59	1.568	1.177	J853-SD-CW-4102	5/F	標準層雙掛碼
36		DBP-107d	2mm厚鋁板	UCT542049SC-3(淺灰)	2		2	19.84	1.83	1.51	3.661	3.011	J853-SD-CW-4102	5/F	標準層雙掛碼
37		DBP-112d	2mm厚鋁板	UCT542049SC-3(淺灰)	1		1	5.36	0.99	0.77	0.989	0.768	J853-SD-CW-4104	5/F	標準層雙掛碼
38		DBP-121d	2mm厚鋁板	UCT542049SC-3(淺灰)	3		3	25.28	1.55	1.26	4.664	3.791	J853-SD-CW-4105	23/F	標準層雙掛碼
39		DBP-122d	2mm厚鋁板	UCT542049SC-3(淺灰)	2		2	17.27	1.59	1.30	3.186	2.594	J853-SD-CW-4105	23/F	標準層雙掛碼
40		DBP-123d	2mm厚鋁板	UCT542049SC-3(淺灰)	1		1	8.66	1.60	1.30	1.598	1.301	J853-SD-CW-4105	23/F	標準層雙掛碼
41	原1007.5改657.5	DBP-6X	2mm厚鋁板	UCT542049SC-3(淺灰)	2		2	4.40	0.41	0.27	0.811	0.538	J853-SD-CW-4104	22/F	特式層
42	原1007.5改657.5	DBP-13X	2mm厚鋁板	UCT542049SC-3(淺灰)	2		2	7.22	0.67	0.48	1.331	0.964	J853-SD-CW-4104	22/F	特式層
43	原1007.5改657.5	DBP-20X	2mm厚鋁板	UCT542049SC-3(淺灰)	2		2	5.81	0.54	0.38	1.071	0.751	J853-SD-CW-4102	22/F	特式層
44	原1007.5改657.5	DBP-107X	2mm厚鋁板	UCT542049SC-3(淺灰)	2		2	13.56	1.25	0.96	2.501	1.922	J853-SD-CW-4102	22/F	特式層
45	原1007.5改657.5	DBP-114X	2mm厚鋁板	UCT542049SC-3(淺灰)	2		2	14.26	1.32	1.01	2.631	2.028	J853-SD-CW-4104	22/F	特式層
46	原1007.5改657.5	DBP-118X	2mm厚鋁板	UCT542049SC-3(淺灰)	1		1	3.48	0.64	0.46	0.641	0.462	J853-SD-CW-4104	22/F	特式層
47	原1007.5改657.5	DBP-119X	2mm厚鋁板	UCT542049SC-3(淺灰)	1		1	2.59	0.48	0.33	0.479	0.329	J853-SD-CW-4104	22/F	特式層
48		DBP-6a	2mm厚鋁板	UCT542049SC-3(淺灰)	2		2	3.27	0.30	0.19	0.604	0.370	J853-SD-CW-4106	25/F	特式層
49		DBP-10a	2mm厚鋁板	UCT542049SC-3(淺灰)	2		2	3.54	0.33	0.20	0.652	0.407	J853-SD-CW-4104	25/F	特式層
50		DBP-12a	2mm厚鋁板	UCT542049SC-3(淺灰)	1		1	1.90	0.35	0.22	0.350	0.222	J853-SD-CW-4102	25/F	特式層
51		DBP-12a	2mm厚鋁板	UCT542049SC-3(淺灰)	1		1	1.90	0.35	0.22	0.350	0.222	J853-SD-CW-4104	25/F	特式層
52		DBP-12a	2mm厚鋁板	UCT542049SC-3(淺灰)	2		2	3.80	0.35	0.22	0.701	0.444	J853-SD-CW-4105	25/F	特式層
53		DBP-12a	2mm厚鋁板	UCT542049SC-3(淺灰)	2		2	3.80	0.35	0.22	0.701	0.444	J853-SD-CW-4105	25/F	特式層
54		DBP-13a	2mm厚鋁板	UCT542049SC-3(淺灰)	2		2	5.37	0.50	0.33	0.991	0.663	J853-SD-CW-4104	25/F	特式層
55		DBP-13a	2mm厚鋁板	UCT542049SC-3(淺灰)	1		1	2.69	0.50	0.33	0.496	0.332	J853-SD-CW-4106	25/F	特式層
56	原分格865改965	DBP-25a	2mm厚鋁板	UCT542049SC-3(淺灰)	1		1	2.59	0.48	0.32	0.479	0.319	J853-SD-CW-4106	25/F	特式層
57		DBP-26a	2mm厚鋁板	UCT542049SC-3(淺灰)	2		2	4.85	0.45	0.29	0.894	0.590	J853-SD-CW-4102	25/F	特式層
58		DBP-105a	2mm厚鋁板	UCT542049SC-3(淺灰)	1		1	4.78	0.88	0.62	0.883	0.624	J853-SD-CW-4102	25/F	特式層
59		DBP-106a	2mm厚鋁板	UCT542049SC-3(淺灰)	1		1	2.95	0.54	0.37	0.544	0.368	J853-SD-CW-4102	25/F	特式層
60		DBP-113a	2mm厚鋁板	UCT542049SC-3(淺灰)	1		1	3.47	0.64	0.44	0.641	0.441	J853-SD-CW-4104	25/F	特式層

美特鋁質 MIDI Aluminium Fabricator Ltd.		工程號: J-853		計算: 陳敏聰		日期: 2022.04.13		送呈:							
廠用鋁背板B.M.表		地盤名稱: 延坪道住宅		核對: 謝永林		日期: 2022.09.02		副本:							
修改版次:		項目類別: TI座幕牆背板		批准:		日期:		A/C Code:							
		A 2022.9.2		總V.F.: 452.13		總重量: 3114.39									
序號	修改內容	鋁板圖號	鋁板名稱	顏色	實用	後備	總數	總重量	單件展開面積 m ²	總展開面積 m ²	單件V.F. m ²	總V.F. m ²	位置	樓層	類型
61		DBP-114a	2mm厚鋁板	UCT542049SC-3(淺灰)	1	1	1	5.31	0.980	0.980	0.70	0.698	J853-SD-CW-4104	25/F	特式層
62		DBP-115a	2mm厚鋁板	UCT542049SC-3(淺灰)	1	1	1	3.34	0.617	0.617	0.42	0.423	J853-SD-CW-4104	25/F	特式層
63		DBP-116a	2mm厚鋁板	UCT542049SC-3(淺灰)	1	1	1	4.19	0.774	0.774	0.54	0.542	J853-SD-CW-4104	25/F	特式層
64		DBP-121a	2mm厚鋁板	UCT542049SC-3(淺灰)	3	3	3	12.86	2.373	7.119	0.55	1.665	J853-SD-CW-4105	25/F	特式層
65		DBP-122a	2mm厚鋁板	UCT542049SC-3(淺灰)	2	2	2	8.78	1.620	3.240	0.57	1.139	J853-SD-CW-4105	25/F	特式層
66		DBP-123a	2mm厚鋁板	UCT542049SC-3(淺灰)	1	1	1	4.40	0.813	0.813	0.57	0.571	J853-SD-CW-4105	25/F	特式層
67		DBP-124a	2mm厚鋁板	UCT542049SC-3(淺灰)	1	1	1	3.32	0.612	0.612	0.42	0.419	J853-SD-CW-4106	25/F	特式層
68		DBP-126a	2mm厚鋁板	UCT542049SC-3(淺灰)	1	1	1	4.13	0.762	0.762	0.53	0.533	J853-SD-CW-4106	25/F	特式層
69	取消(原390)	DBP-6b	2mm厚鋁板	UCT542049SC-3(淺灰)	0	0	0	0.00	0.000	0.000	0.00	0.000	J853-SD-CW-4101	23/F	特式層
70	取消(原390)	DBP-6b	2mm厚鋁板	UCT542049SC-3(淺灰)	0	0	0	0.00	0.000	0.000	0.00	0.000	J853-SD-CW-4101	23/F	特式層
71	取消(原390)	DBP-102b	2mm厚鋁板	UCT542049SC-3(淺灰)	0	0	0	0.00	0.000	0.000	0.00	0.000	J853-SD-CW-4101	23/F	特式層
72	取消(原390)	DBP-103b	2mm厚鋁板	UCT542049SC-3(淺灰)	0	0	0	0.00	0.000	0.000	0.00	0.000	J853-SD-CW-4101	22/F	特式層
73	取消(原340)	DBP-6k	2mm厚鋁板	UCT542049SC-3(淺灰)	0	0	0	0.00	0.000	0.000	0.00	0.000	J853-SD-CW-4101	22/F	特式層
74	取消(原340)	DBP-6k	2mm厚鋁板	UCT542049SC-3(淺灰)	0	0	0	0.00	0.000	0.000	0.00	0.000	J853-SD-CW-4101	22/F	特式層
75	取消(原340)	DBP-6k	2mm厚鋁板	UCT542049SC-3(淺灰)	0	0	0	0.00	0.000	0.000	0.00	0.000	J853-SD-CW-4103	25/F	特式層
76	取消(原340)	DBP-14k	2mm厚鋁板	UCT542049SC-3(淺灰)	0	0	0	0.00	0.000	0.000	0.00	0.000	J853-SD-CW-4102	22/F	特式層
77	取消(原340)	DBP-101k	2mm厚鋁板	UCT542049SC-3(淺灰)	0	0	0	0.00	0.000	0.000	0.00	0.000	J853-SD-CW-4101	22/F	特式層
78	取消(原340)	DBP-104k	2mm厚鋁板	UCT542049SC-3(淺灰)	0	0	0	0.00	0.000	0.000	0.00	0.000	J853-SD-CW-4101	22/F	特式層
79	取消(原340)	DBP-110k	2mm厚鋁板	UCT542049SC-3(淺灰)	0	0	0	0.00	0.000	0.000	0.00	0.000	J853-SD-CW-4103	22/F	特式層
80	取消(原340)	DBP-112k	2mm厚鋁板	UCT542049SC-3(淺灰)	0	0	0	0.00	0.000	0.000	0.00	0.000	J853-SD-CW-4104	22/F	特式層
81	原340改585	DBP-115L	2mm厚鋁板	UCT542049SC-3(淺灰)	2	2	2	35.44	6.539	13.078	2.83	5.661	J853-SD-CW-4104	23/F-25/F	全榭窗
82		DBP-15	2mm厚鋁板	UCT542049SC-3(淺灰)	15	15	15	93.95	17.334	260.010	0.92	13.840	J853-SD-CW-4103	5/F-21/F	轉角生窗
83		DBP-41	2mm厚鋁板	UCT542049SC-3(淺灰)	1	1	1	5.15	0.951	0.951	0.74	0.743	J853-SD-CW-4103	23/F	轉角生窗
84		DBP-109	2mm厚鋁板	UCT542049SC-3(淺灰)	15	15	15	125.01	23.064	348.060	1.27	19.010	J853-SD-CW-4103	5/F-21/F	轉角榭窗
85		DBP-111	2mm厚鋁板	UCT542049SC-3(淺灰)	1	1	1	9.24	1.704	1.704	1.41	1.413	J853-SD-CW-4103	23/F	轉角榭窗
86	原340改585	DBP-15k	2mm厚鋁板	UCT542049SC-3(淺灰)	1	1	1	3.81	0.703	0.703	0.51	0.510	J853-SD-CW-4103	22/F	轉角特式層
87	原340改490	DBP-41a	2mm厚鋁板	UCT542049SC-3(淺灰)	1	1	1	2.62	0.484	0.484	0.33	0.326	J853-SD-CW-4103	25/F	轉角特式層
88	原340改585	DBP-109k	2mm厚鋁板	UCT542049SC-3(淺灰)	1	1	1	5.07	0.936	0.936	0.70	0.701	J853-SD-CW-4103	22/F	轉角特式層
89	原340改490	DBP-111a	2mm厚鋁板	UCT542049SC-3(淺灰)	1	1	1	4.70	0.867	0.867	0.62	0.621	J853-SD-CW-4103	25/F	轉角特式層
90		DBP-115R	2mm厚鋁板	EC-DG-D33423-ZDI (閃粉古銅)	2	2	2	32.00	5.903	11.806	2.84	5.670	J853-SD-CW-4104	23/F-25/F	全榭窗

美特鋁質 MIDI Aluminium Fabricator Ltd.		工程號: J-853		計算: 陳敬聰		日期: 2022.04.13		送呈:							
廠用鋁背板B.M.表		地盤名稱: 延坪道住宅		核對: 謝永林		日期: 2022.09.02		副本:							
修改版次: A 2022.9.2		項目類別: T1座幕牆背板		批准:		日期:		A/C Code:							
		總V.F.: 452.13		總重量: 3114.39											
序號	修改內容	鋁板圖號	鋁板名稱	顏色	實用	後備	總數	總重量	單件展開面積m ²	總展開面積m ²	單件V.F. m ²	總V.F. m ²	位置	樓層	類型
91	新增	DBP-103d	2mm厚鋁板	UCT542049SC-3(淺灰)	1		1	11.02	2.03	2.033	1.68	1.682	J853-SD-CW-4101	5/F	標準層雙掛碼
92	新增	DBP-13d	2mm厚鋁板	UCT542049SC-3(淺灰)	1		1	5.28	0.97	0.974	0.76	0.755	J853-SD-CW-4101	23/F	標準層雙掛碼
93	新增	DBP-25d	2mm厚鋁板	UCT542049SC-3(淺灰)	1		1	5.10	0.94	0.941	0.73	0.726	J853-SD-CW-4101	23/F	標準層雙掛碼
94	原340改490	DBP-6a	2mm厚鋁板	UCT542049SC-3(淺灰)	1		1	1.64	0.30	0.302	0.19	0.185	J853-SD-CW-4101	25/F	特式層
95	原340改585	DBP-14k	2mm厚鋁板	UCT542049SC-3(淺灰)	1		1	3.57	0.66	0.659	0.47	0.471	J853-SD-CW-4101	22/F	特式層
96	原340改585	DBP-110k	2mm厚鋁板	UCT542049SC-3(淺灰)	1		1	5.22	0.96	0.963	0.71	0.713	J853-SD-CW-4101	22/F	特式層
97	原340改585	DBP-112k	2mm厚鋁板	UCT542049SC-3(淺灰)	1		1	3.26	0.60	0.602	0.42	0.425	J853-SD-CW-4101	22/F	特式層
98	原390改585	DBP-6k	2mm厚鋁板	UCT542049SC-3(淺灰)	2		2	3.92	0.36	0.723	0.23	0.467	J853-SD-CW-4101	23/F	特式層
99	原390改585	DBP-6k	2mm厚鋁板	UCT542049SC-3(淺灰)	2		2	3.92	0.36	0.723	0.23	0.467	J853-SD-CW-4101	23/F	特式層
100	原390改585	DBP-102k	2mm厚鋁板	UCT542049SC-3(淺灰)	1		1	6.70	1.24	1.237	0.93	0.931	J853-SD-CW-4101	23/F	特式層
101	原390改585	DBP-103k	2mm厚鋁板	UCT542049SC-3(淺灰)	1		1	6.70	1.24	1.237	0.93	0.931	J853-SD-CW-4101	23/F	特式層
102	原340改585	DBP-6k(2)	2mm厚鋁板	UCT542049SC-3(淺灰)	1		1	1.96	0.36	0.361	0.23	0.233	J853-SD-CW-4101	22/F	特式層
103	原340改585	DBP-6k(2)	2mm厚鋁板	UCT542049SC-3(淺灰)	1		1	1.96	0.36	0.361	0.23	0.233	J853-SD-CW-4101	22/F	特式層
104	原340改585	DBP-101k	2mm厚鋁板	UCT542049SC-3(淺灰)	1		1	4.98	0.92	0.919	0.68	0.677	J853-SD-CW-4101	22/F	特式層
105	原340改585	DBP-104k	2mm厚鋁板	UCT542049SC-3(淺灰)	1		1	4.98	0.92	0.919	0.68	0.677	J853-SD-CW-4101	22/F	特式層
106	原957.5改1007.5	DBP-6c	2mm厚鋁板	UCT542049SC-3(淺灰)	2		2	6.77	0.62	1.250	0.45	0.894	J853-SD-CW-4101	22/F	特式層
107	原957.5改1007.5	DBP-6c	2mm厚鋁板	UCT542049SC-3(淺灰)	2		2	6.77	0.62	1.250	0.45	0.894	J853-SD-CW-4101	22/F	特式層
108	原957.5改1007.5	DBP-102c	2mm厚鋁板	UCT542049SC-3(淺灰)	1		1	11.60	2.14	2.140	1.78	1.783	J853-SD-CW-4101	22/F	特式層
109	原957.5改1007.5	DBP-103c	2mm厚鋁板	UCT542049SC-3(淺灰)	1		1	11.60	2.14	2.140	1.78	1.783	J853-SD-CW-4101	22/F	特式層
110	新增	DBP-6L	2mm厚鋁板	UCT542049SC-3(淺灰)	1		1	2.49	0.46	0.460	0.31	0.313	J853-SD-CW-4103	23/F	特式層
111	新增	DBP-6L	2mm厚鋁板	UCT542049SC-3(淺灰)	2		2	4.98	0.46	0.919	0.31	0.626	J853-SD-CW-4106	23/F	特式層
112	新增	DBP-124L	2mm厚鋁板	UCT542049SC-3(淺灰)	1		1	5.05	0.93	0.931	0.71	0.709	J853-SD-CW-4106	23/F	特式層
113	新增	DBP-111L	2mm厚鋁板	UCT542049SC-3(淺灰)	1		1	7.68	1.42	1.417	1.12	1.117	J853-SD-CW-4103	23/F	轉角特式層
統計:							527	3114.39	574.61	1.417	1.12	452.13			




美特鋁質有限公司
MIDI Aluminium Fabricator Ltd.

依據EI4949修改分格高度



工程號 J-853 地盤 延坪道住宅

序號	物料編號	W	數量	EQ	M	X	N	位置	分格尺寸	樓層	樓層數	每層數量	備註
1	DBP-14k	1011	1	55.5	300	x	3	J853-SD-CW-4102	1115	22/F	1	1	原340改585
2	DBP-110k	1536	1	143.0	250	x	5	J853-SD-CW-4103	1640	22/F	1	1	原340改585
3	DBP-112k	911	1	80.5	250	x	3	J853-SD-CW-4104	1015	22/F	1	1	原340改585
4	DBP-6k	496	2	98.0	300	x	1	J853-BD-CW-4101	600	23/F	1	2	原390改585
5	DBP-6k	496	2	98.0	300	x	1	J853-BD-CW-4101	600	23/F	1	2	原390改585
6	DBP-102k	2008.5	1	104.3	300	x	6	J853-BD-CW-4101	2112.5	23/F	1	1	原390改585
7	DBP-103k	2008.5	1	104.3	300	x	6	J853-BD-CW-4101	2112.5	23/F	1	1	原390改585
總數:			9										

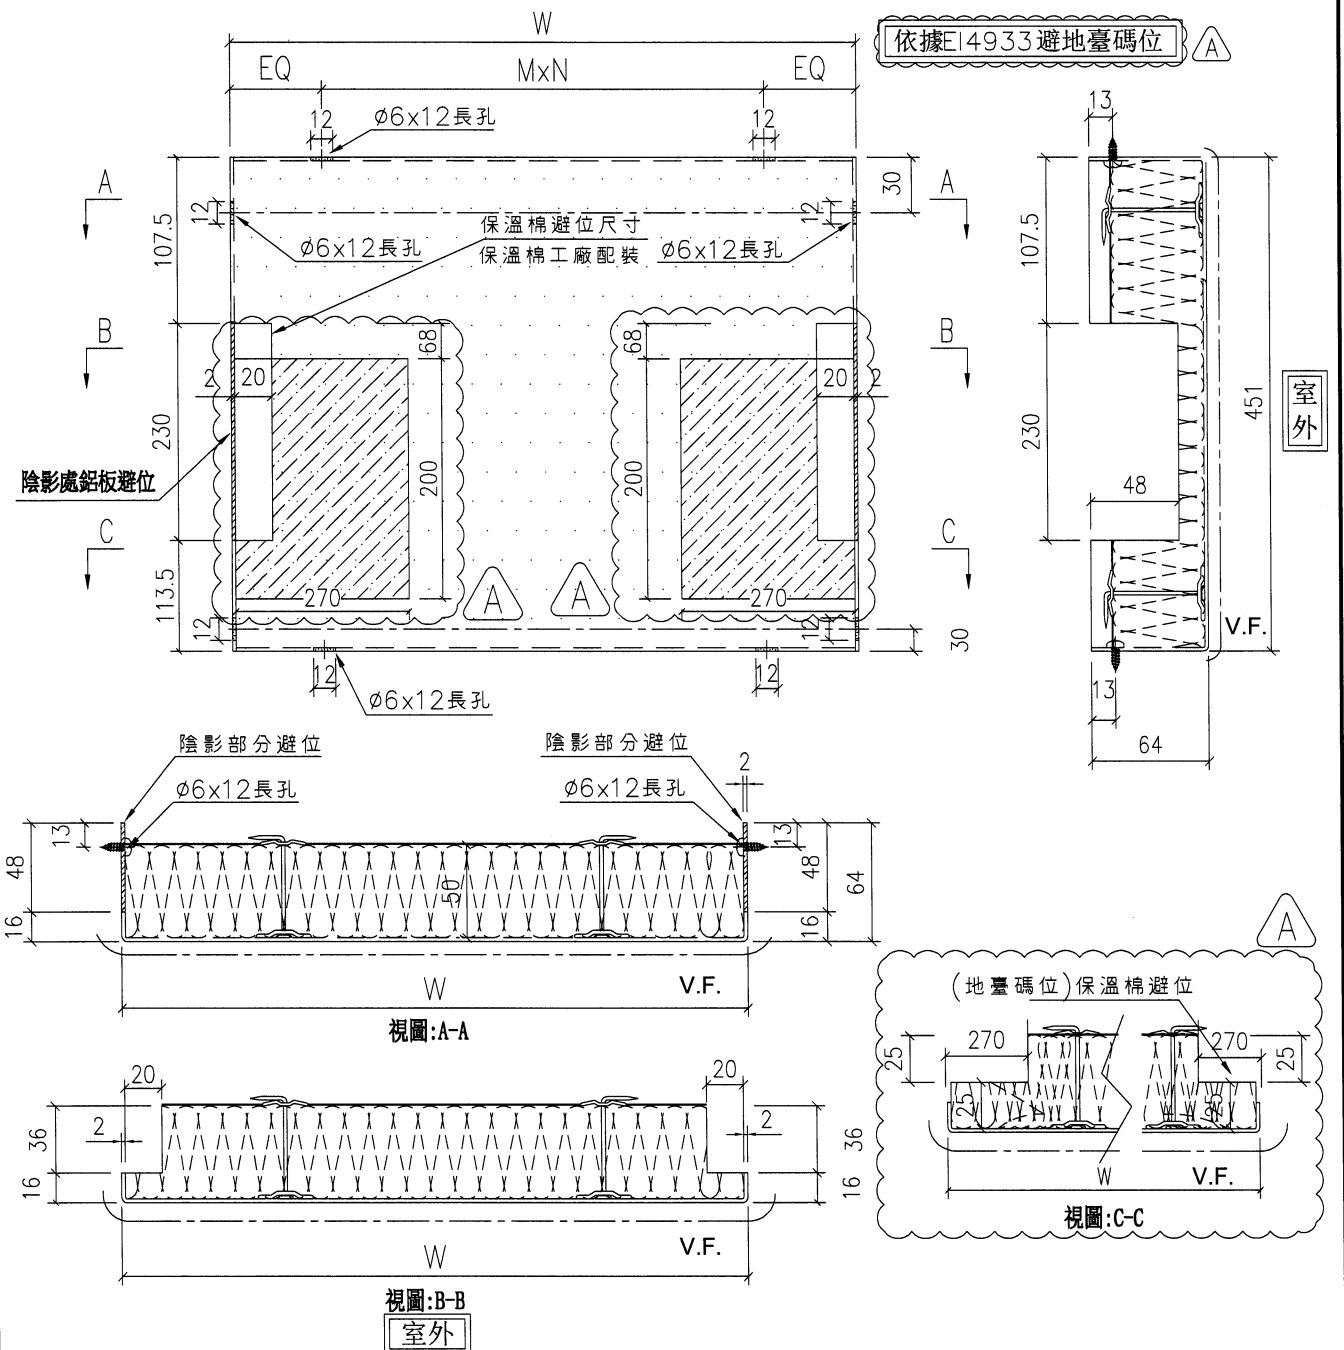

名稱	背板拆圖	制圖	陳敏聰	2022.04.13	修改	新增	
材料	2mm 鋁板	復核	謝永林	2022.04.14	日期	2022.09.02	
顏色	UCT542049SC-3(淺灰)	批准	Daniel		圖號	DBP-14k	




美特鋁質有限公司

依據EI4949修改分格高度



序號	物料編號	W	數量	EQ	M	X	N	位置	分格尺寸	樓層	樓層數	每層數量	備註
1	DBP-6k(2)	496	1	98.0	300	x	1	J853-BD-CW-4101	600	22/F	1	1	原340改585
2	DBP-6k(2)	496	1	98.0	300	x	1	J853-BD-CW-4101	600	22/F	1	1	原340改585
3	DBP-101k	1458.5	1	129.3	300	x	4	J853-BD-CW-4101	1562.5	22/F	1	1	原340改585
4	DBP-104k	1458.5	1	129.3	300	x	4	J853-BD-CW-4101	1562.5	22/F	1	1	原340改585
總數:			4										

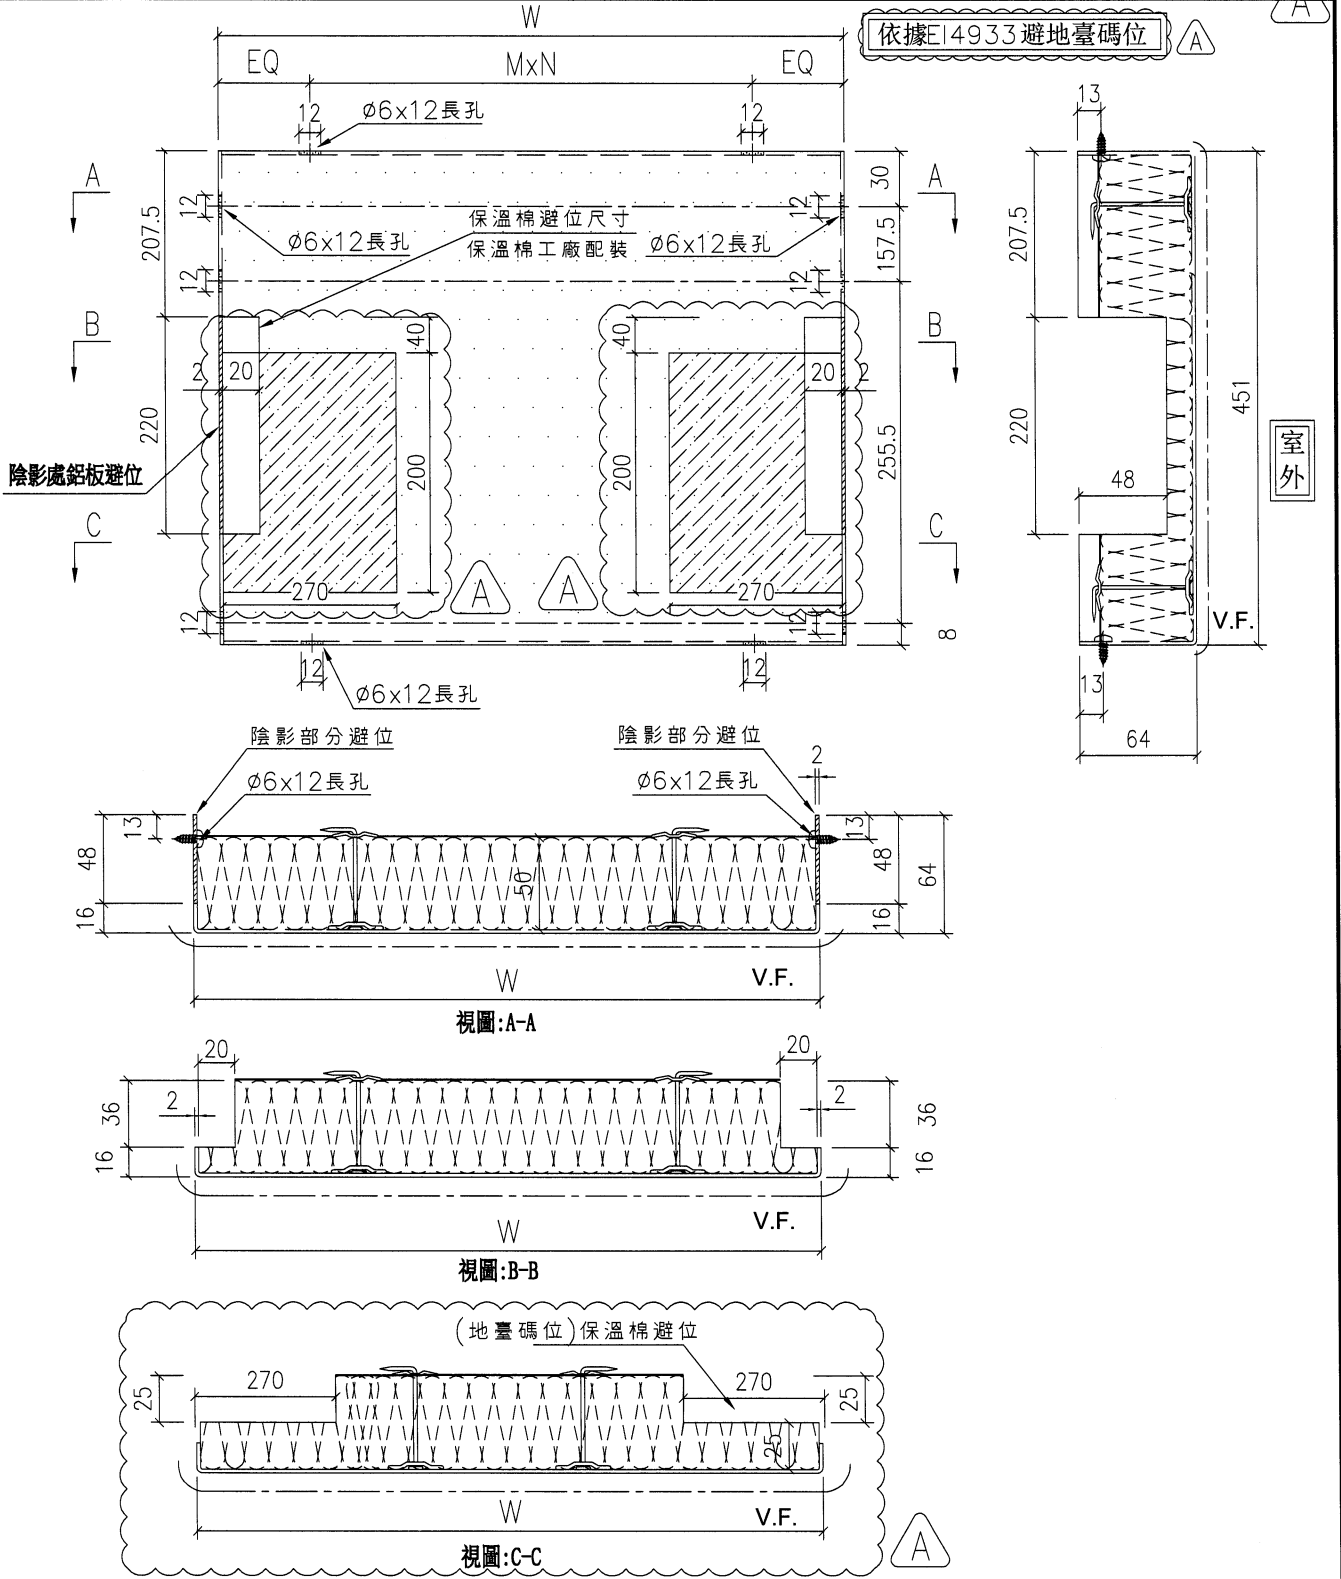

名稱	背板拆圖	制圖	陳敏聰	2022.04.13	修改	新增	
材料	2mm鋁板	復核	謝永林	2022.04.14	日期	2022.09.02	
顏色	UCT542049SC-3(淺灰)	批准	Daniel		圖號	DBP-06k(2)	



美特鋁質有限公司
MIDI Aluminium Fabricator Ltd.

依據EI4933避地臺碼位




工程號 J-853 地盤 延坪道住宅

依據EI4949修改分格高度



序號	物料編號	W	數量	EQ	M	X	N	位置	分格尺寸	樓層	樓層數	每層數量	備註
1	DBP-6c	496	2	98.0	300	x	1	J853-BD-CW-4101	600	22/F	1	2	原957.5改1007.5
2	DBP-6c	496	2	98.0	300	x	1	J853-BD-CW-4101	600	22/F	1	2	原957.5改1007.5
3	DBP-102c	2008.5	1	104.3	300	x	6	J853-BD-CW-4101	2112.5	22/F	1	1	原957.5改1007.5
4	DBP-103c	2008.5	1	104.3	300	x	6	J853-BD-CW-4101	2112.5	22/F	1	1	原957.5改1007.5
總數:			6										

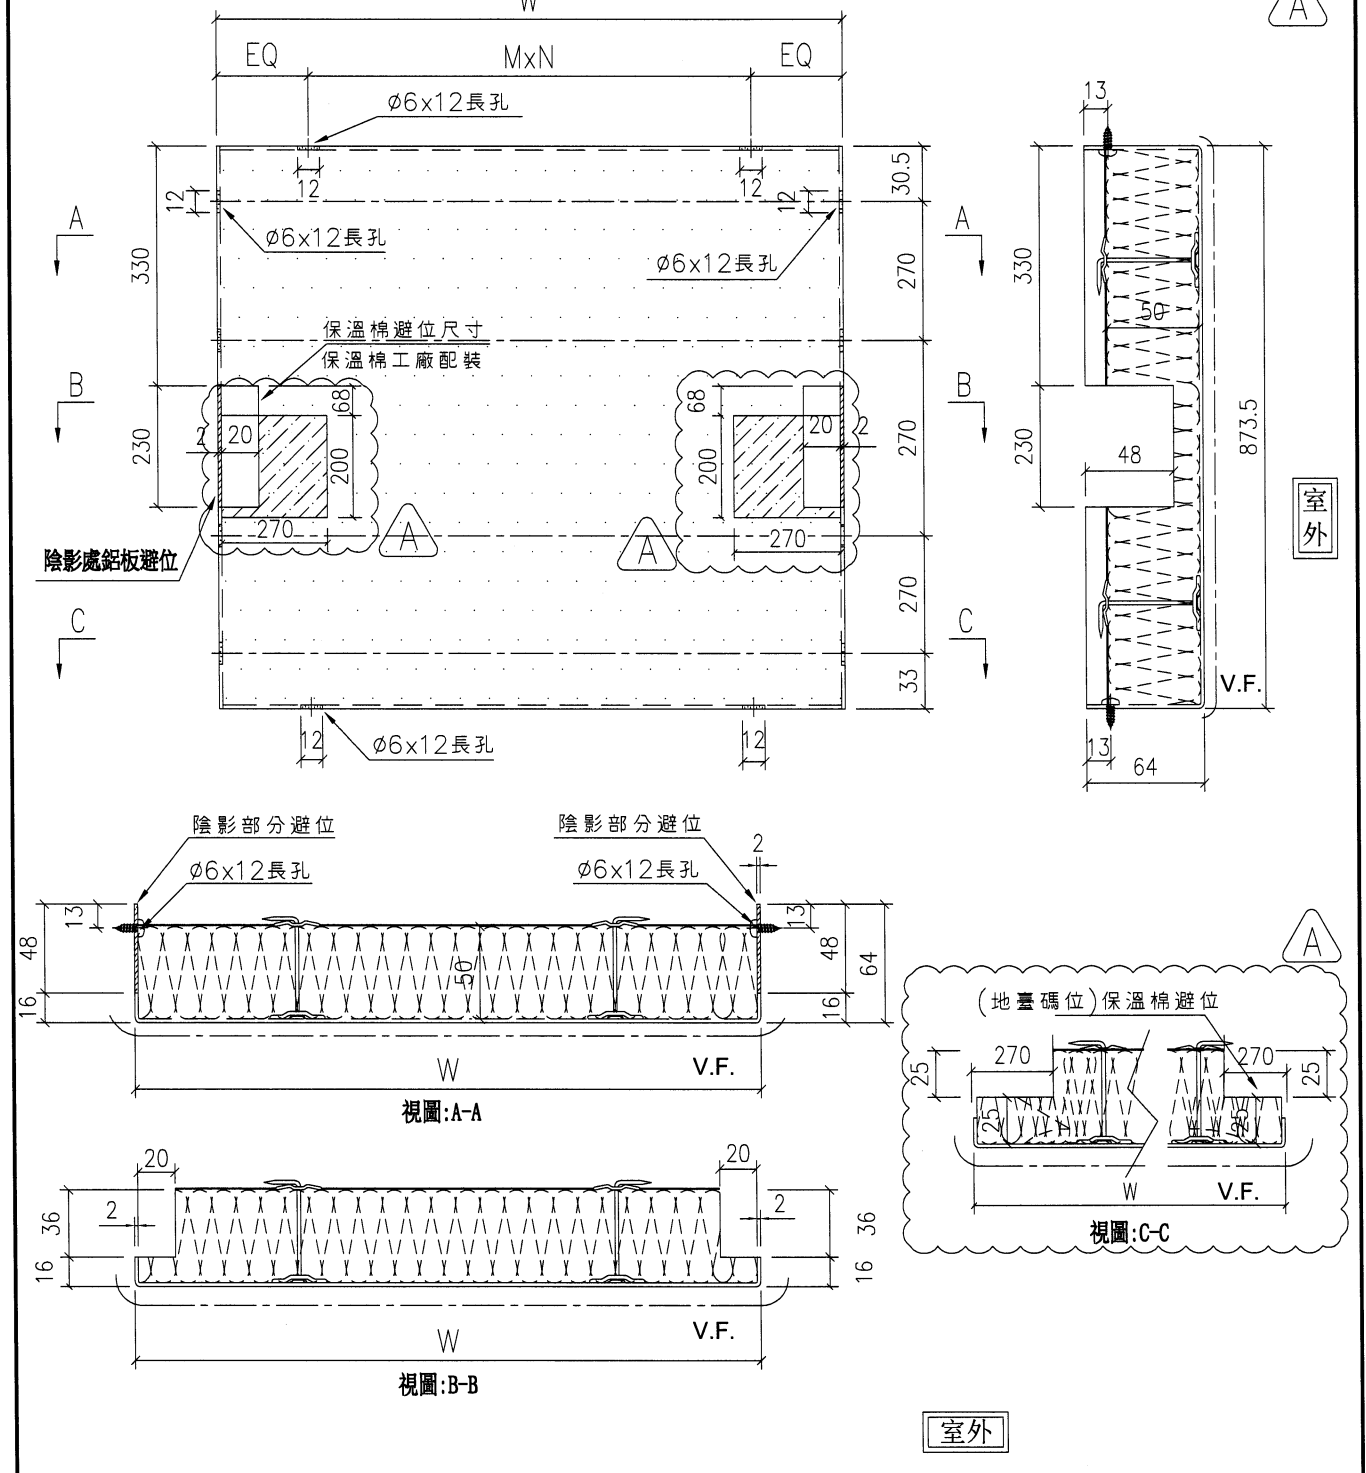

名稱	背板拆圖	制圖	陳敏聰	2022.04.13	修改	新增	
材料	2mm鋁板	復核	謝永林	2022.04.14	日期	2022.09.02	
顏色	UCT542049SC-3(淺灰)	批准	Daniel		圖號	DBP-06c	

EG-DWG3




美特鋁質有限公司
 MIDI Aluminium Fabricator Ltd.

依據E14949修改分格高度



工程號 J-853 地盤 延坪道住宅

序號	物料編號	W	數量	EQ	M	X	N	位置	分格尺寸	樓層	樓層數	每層數量	備註
1	DBP-6L	496	1	98.0	300	x	1	J853-SD-CW-4103	600	23/F	1	1	新增
2	DBP-6L	496	2	98.0	300	x	1	J853-SD-CW-4106	600	23/F	1	2	新增
3	DBP-124L	1136	1	118.0	300	x	3	J853-SD-CW-4106	1240	23/F	1	1	新增
總數:			4										

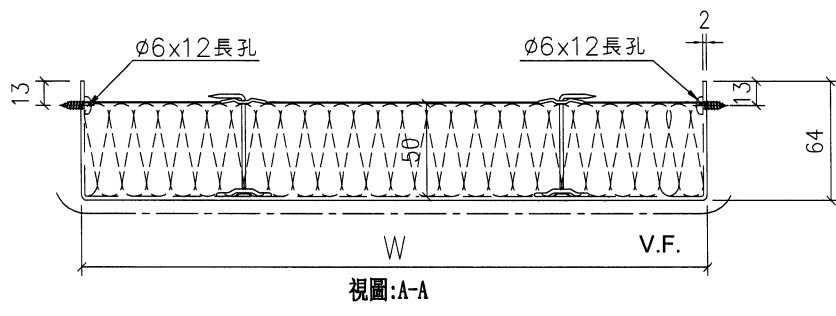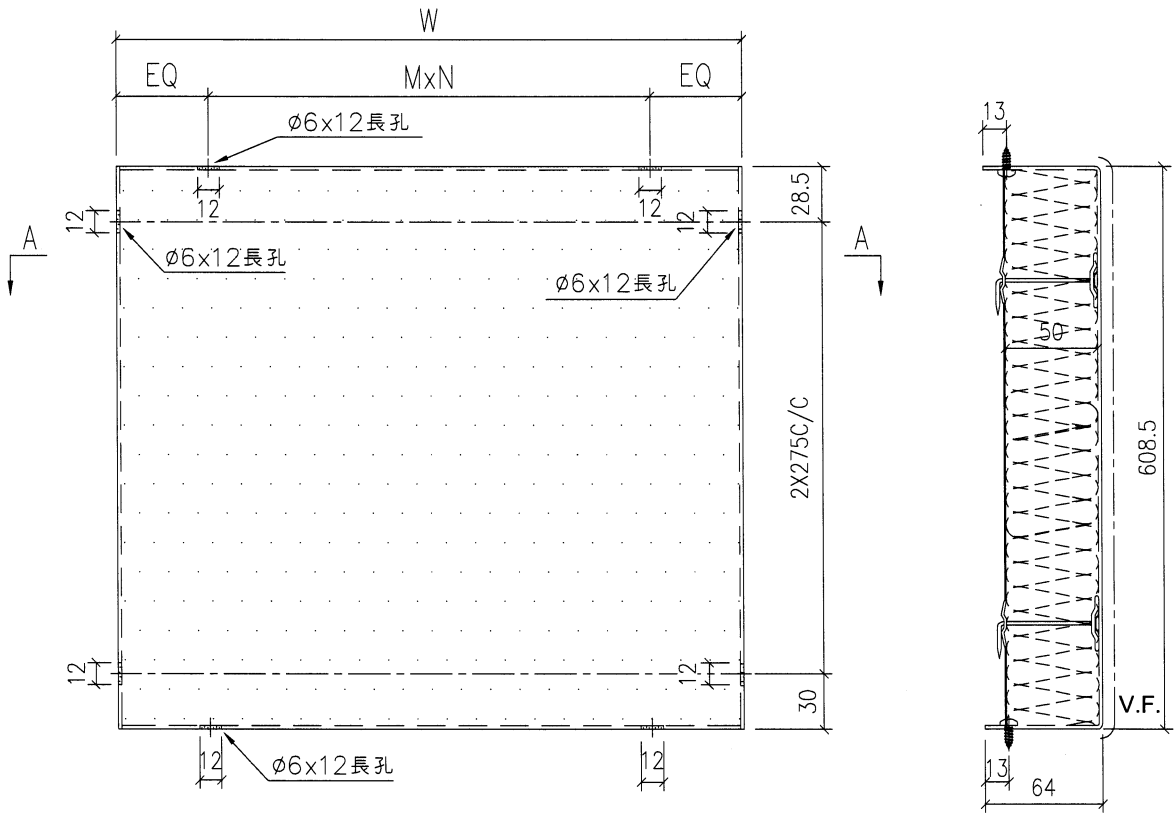

視圖:A-A

室外

室外

名稱	梗窗背板拆圖	制圖	陳敏聰	2022.04.13	修改	新增	
材料	2mm鋁板	復核	謝永林	2022.04.14	日期	2022.09.02	
顏色	UCT542049SC-3(淺灰)	批准	Daniel		圖號	DBP-06L	

EG-DWG3






美特鋁質有限公司
MIDI Aluminium Fabricator Ltd.

依據E14949修改分格高度




工程號 J-853 地盤 延坪道住宅

物料編號	W	數量	EQ	M	X	N	位置	分格尺寸	樓層	樓層數	每層數量	備註
DBP-111L	1685.5	1	92.8	300	x	5	J853-SD-CW-4103	1900	23/F	1	1	新增

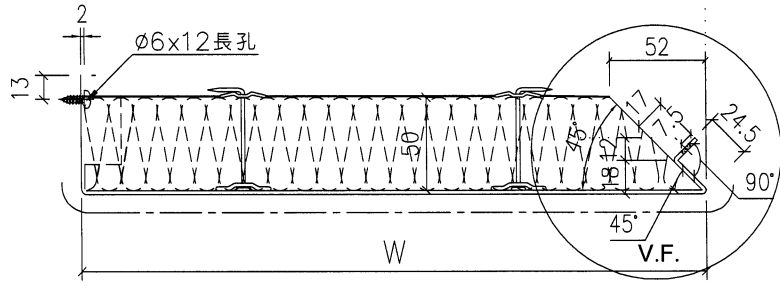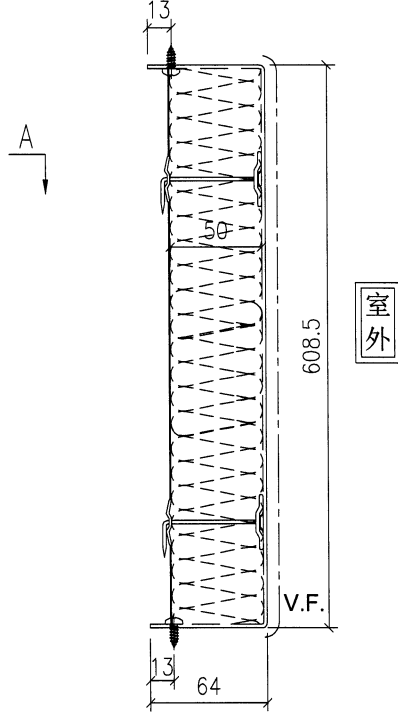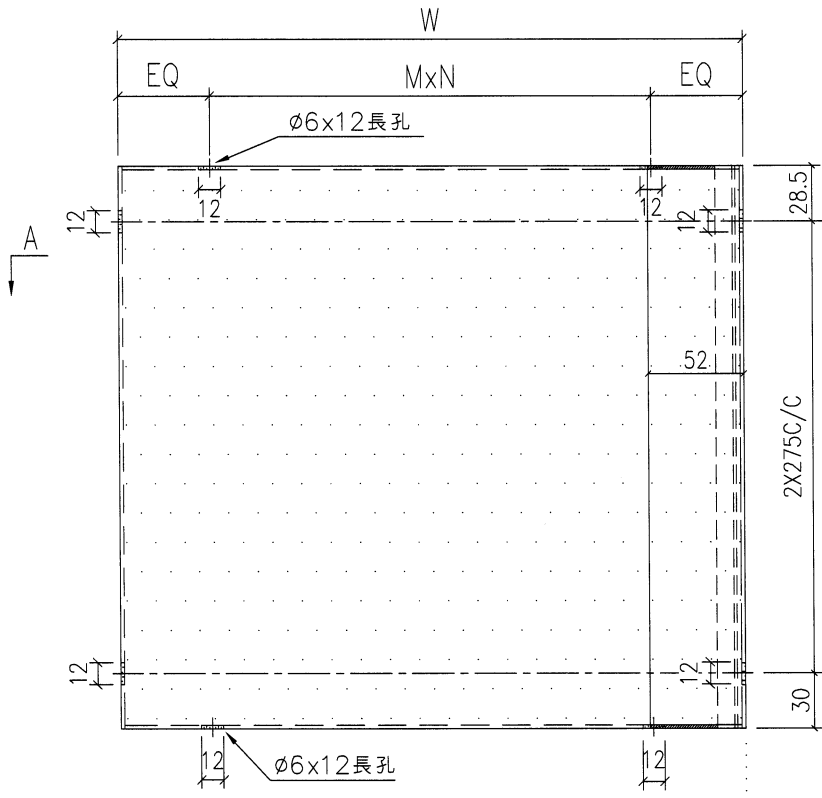

視圖:A-A


室外

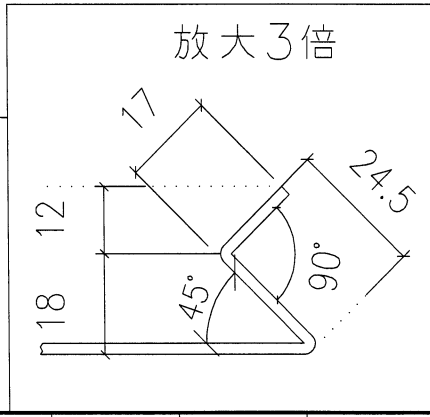

名稱	轉角樑窗背板拆圖	制圖	陳敏聰	2022.04.13	修改	新增	
材料	2mm鋁板	復核	謝永林	2022.04.14	日期	2022.09.02	
顏色	UCT542049SC-3(淺灰)	批准	Daniel		圖號	DBP-111L	



依據E14933避地臺碼位

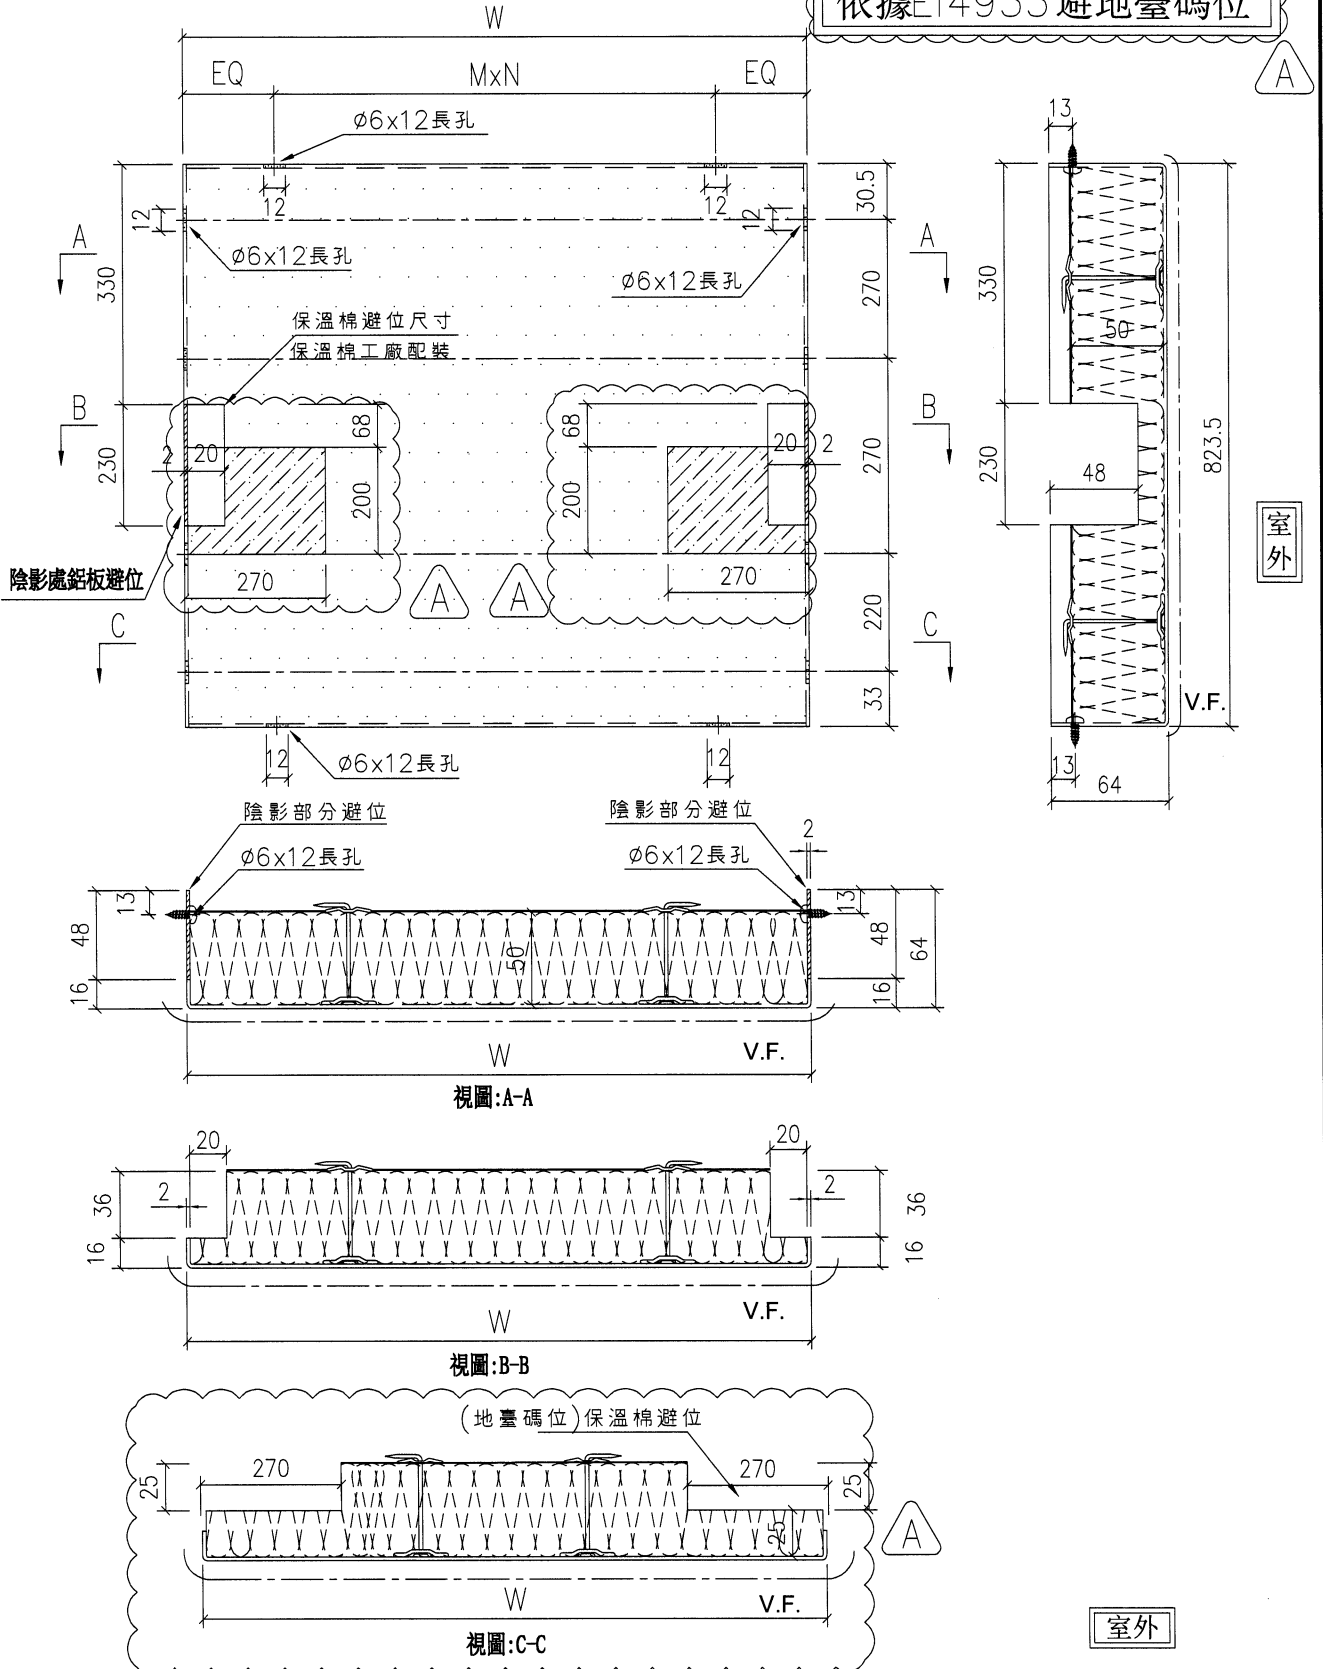

名稱	背板拆圖	制圖	陳敏聰	2022.04.13	修改	A	
材料	2mm鋁板	復核	謝永林	2022.04.14	日期	2022.09.02	
顏色	UCT542049SC-3(淺灰)	批准	Daniel		圖號	DBP-06	

EG-DWG3



美特鋁質有限公司
MIDI Aluminium Fabricator Ltd.

依據E14949修改分格高度



工程號		J-853		地盤		延坪道住宅							
序號	物料編號	W	數量	EQ	M	X	N	位置	分格尺寸	樓層	樓層數	每層數量	備註
1	DBP-6	496	45	98.0	300	x	1	J853-BD-CW-4101	600	5/F-21/F	15	3	A
2	DBP-6	496	0	98.0	300	x	1	J853-BD-CW-4101	600	22/F	1	2	取消
3	DBP-6	496	45	98.0	300	x	1	J853-BD-CW-4101	600	5/F-21/F	15	3	
4	DBP-6	496	0	98.0	300	x	1	J853-BD-CW-4101	600	22/F	1	2	取消
5	DBP-6	496	1	98.0	300	x	1	J853-SD-CW-4103	600	23/F	1	1	A
6	DBP-6	496	30	98.0	300	x	1	J853-SD-CW-4104	600	5/F-21/F	15	2	
7	DBP-6	496	3	98.0	300	x	1	J853-SD-CW-4106	600	23/F	1	3	
8	DBP-10	546	1	73.0	200	x	2	J853-SD-CW-4104	650	23/F	1	1	
9	DBP-13	896	30	73.0	250	x	3	J853-SD-CW-4104	1000	5/F-21/F	15	2	
10	DBP-13	896	0	73.0	250	x	3	J853-SD-CW-4106	1000	23/F	1	1	取消
11	DBP-14	1011	14	55.5	300	x	3	J853-SD-CW-4102	1115	6/F-21/F	14	1	A
12	DBP-20	696	28	48.0	300	x	2	J853-SD-CW-4102	800	6/F-21/F	14	2	
13	DBP-23	746	16	73.0	300	x	2	J853-SD-CW-4103	850	5/F-22/F	16	1	
14	DBP-25	761	0	80.5	300	x	2	J853-SD-CW-4106	865	23/F	1	1	取消
15	DBP-30	846	1	123.0	300	x	2	J853-SD-CW-4106	950	23/F	1	1	A
16	DBP-101	1458.5	15	129.3	300	x	4	J853-BD-CW-4101	1562.5	5/F-21/F	15	1	
17	DBP-102	2008.5	15	104.3	300	x	6	J853-BD-CW-4101	2112.5	5/F-21/F	15	1	取消一個
18	DBP-103	2008.5	14	104.3	300	x	6	J853-BD-CW-4101	2112.5	6/F-21/F	14	1	取消二個
19	DBP-104	1458.5	15	129.3	300	x	4	J853-BD-CW-4101	1562.5	5/F-21/F	15	1	A
20	DBP-105	1696	3	98.0	300	x	5	J853-SD-CW-4102	1800	23/F	1	3	
21	DBP-107	1796	28	148.0	300	x	5	J853-SD-CW-4102	1900	6/F-21/F	14	2	
22	DBP-108	1011	1	55.5	300	x	3	J853-SD-CW-4102	1115	5/F	1	1	
23	DBP-110	1536	15	143.0	250	x	5	J853-SD-CW-4103	1640	5/F-21/F	15	1	
24	DBP-112	911	14	80.5	250	x	3	J853-SD-CW-4104	1015	6/F-21/F	14	1	
25	DBP-114	1896	3	48.0	300	x	6	J853-SD-CW-4104	2000	23/F	1	3	
26	DBP-114	1896	30	48.0	300	x	6	J853-SD-CW-4104	2000	5/F-21/F	15	2	
27	DBP-115	1146	1	123.0	300	x	3	J853-SD-CW-4104	1250	23/F	1	1	
28	DBP-117	1571	1	35.5	300	x	5	J853-SD-CW-4104	1675	23/F	1	1	
29	DBP-118	858.5	15	129.3	300	x	2	J853-SD-CW-4104	962.5	5/F-21/F	15	1	
30	DBP-119	608.5	15	54.3	250	x	2	J853-SD-CW-4104	712.5	5/F-21/F	15	1	
31	DBP-120	446	1	73.0	300	x	1	J853-SD-CW-4104	550	23/F	1	1	
32	DBP-124	1136	1	118.0	300	x	3	J853-SD-CW-4106	1240	23/F	1	1	
總數：		401											

名稱	背板拆圖數據表	制圖	陳敏聰	2022.04.13	修改	A	
材料	2mm鋁板	復核	謝永林	2022.04.14	日期	2022.09.02	
顏色	UCT542049SC-3(淺灰)	批准	Daniel		圖號	DBP-6-SJ	

序號	物料編號	W	數量	EQ	M	X	N	位置	分格尺寸	樓層	樓層數	每層數量	備註
1	DBP-12d	596	2	48.0	250	x	2	J853-SD-CW-4105	700	23/F	1	2	
2	DBP-12d	596	2	48.0	250	x	2	J853-SD-CW-4105	700	23/F	1	2	
3	DBP-20d	696	2	48.0	300	x	2	J853-SD-CW-4102	800	5/F	1	2	
4	DBP-107d	1796	2	148.0	300	x	5	J853-SD-CW-4102	1900	5/F	1	2	
5	DBP-112d	911	1	80.5	250	x	3	J853-SD-CW-4104	1015	5/F	1	1	
6	DBP-121d	1506	3	128.0	250	x	5	J853-SD-CW-4105	1610	23/F	1	3	
7	DBP-122d	1546	2	148.0	250	x	5	J853-SD-CW-4105	1650	23/F	1	2	
8	DBP-123d	1551	1	150.5	250	x	5	J853-SD-CW-4105	1655	23/F	1	1	A
9	DBP-103d	2008.5	1	104.3	300	x	6	J853-BD-CW-4101	2112.5	5/F	1	1	新增
10	DBP-13d	896	1	73.0	250	x	3	J853-SD-CW-4106	1000	23/F	1	1	新增
11	DBP-25d	861	1	130.5	300	x	2	J853-SD-CW-4106	965	23/F	1	1	新增


總數：18

注：DBP-103d如果已加工就重做

依據E14439A修改鋁板掛碼避位

依據E14949修改分格高度

依據E14933避地臺碼位

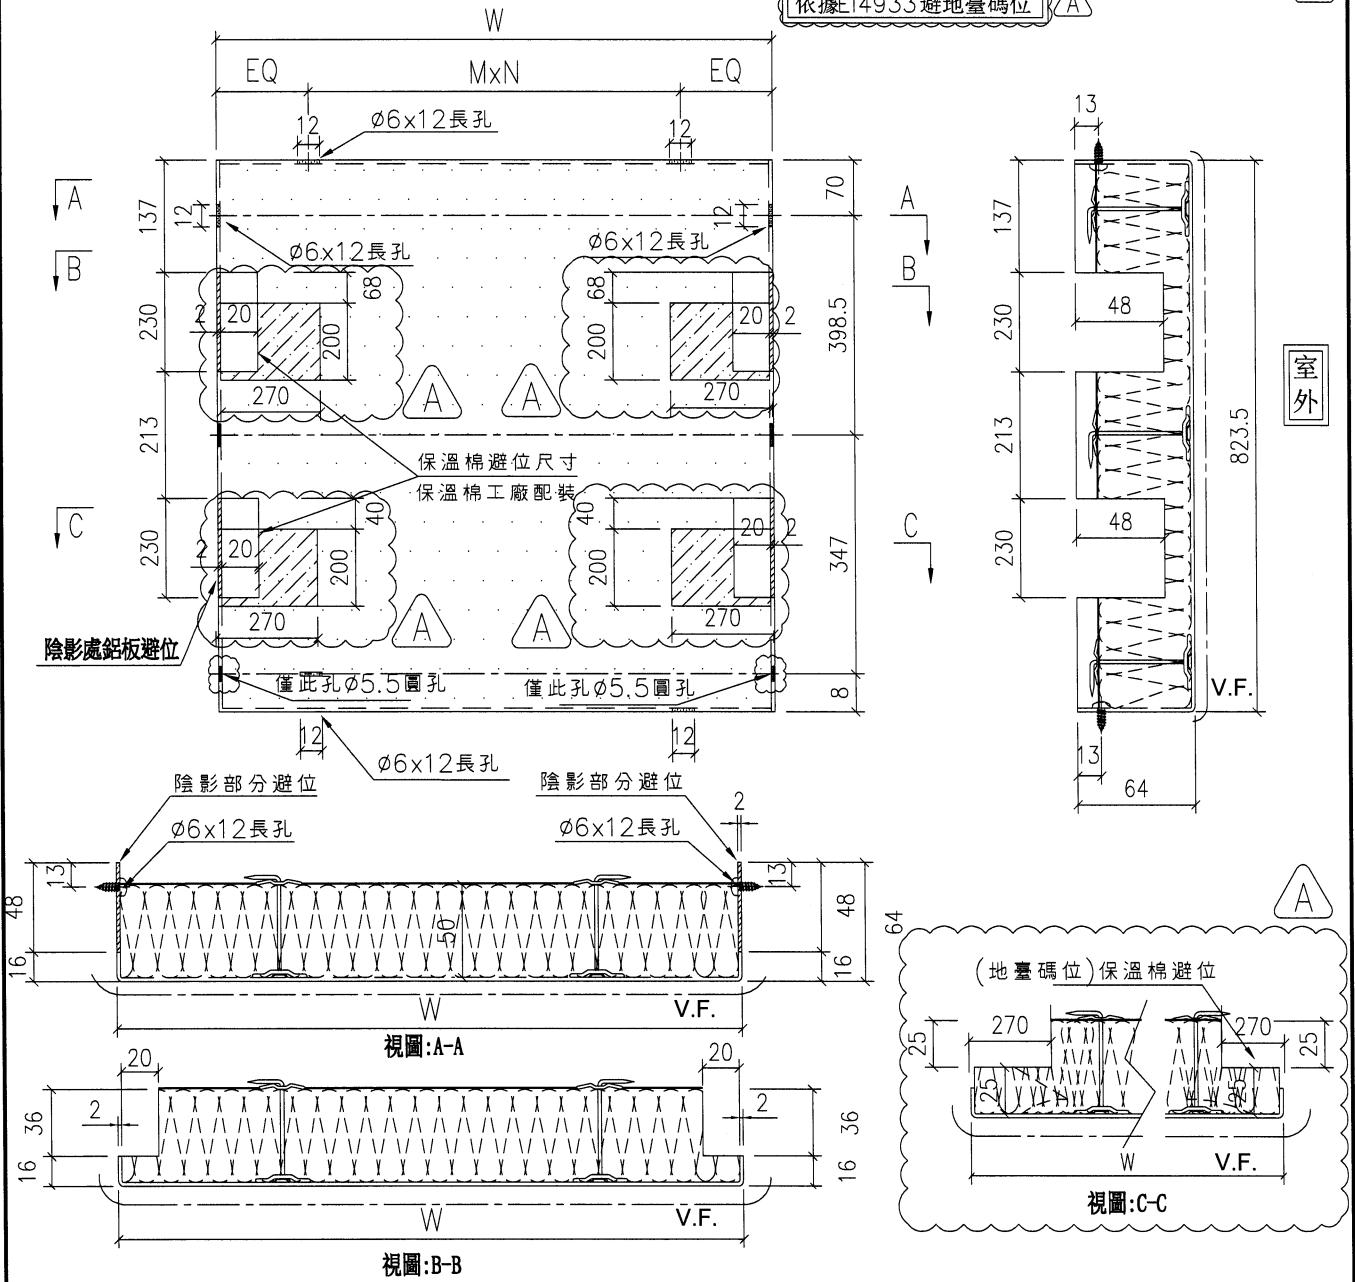

名稱	背板拆圖	制圖	陳敏聰	2022.04.13	修改	A	
材料	2mm鋁板	復核	謝永林	2022.04.14	日期	22.09.02	
顏色	UCT542049SC-3(淺灰)	批准	Daniel		圖號	DBP-12d	



美特鋁質有限公司
MIDI Aluminium Fabricator Ltd.

依據E14949修改分格高度



工程號 J-853 地盤 延坪道住宅

序號	物料編號	W	數量	EQ	M	X	N	位置	分格尺寸	樓層	樓層數	每層數量	備註
1	DBP-6a	496	2	98.0	300	x	1	J853-SD-CW-4106	600	25/F	1	2	
2	DBP-10a	546	2	73.0	200	x	2	J853-SD-CW-4104	650	25/F	1	2	
3	DBP-12a	596	1	48.0	250	x	2	J853-SD-CW-4102	700	25/F	1	1	
4	DBP-12a	596	1	48.0	250	x	2	J853-SD-CW-4104	700	25/F	1	1	
5	DBP-12a	596	2	48.0	250	x	2	J853-SD-CW-4105	700	25/F	1	2	
6	DBP-12a	596	2	48.0	250	x	2	J853-SD-CW-4105	700	25/F	1	2	
7	DBP-13a	896	2	73.0	250	x	3	J853-SD-CW-4104	1000	25/F	1	2	
8	DBP-13a	896	1	73.0	250	x	3	J853-SD-CW-4106	1000	25/F	1	1	
9	DBP-25a	861	1	130.5	300	x	2	J853-SD-CW-4106	965	25/F	1	1	原分格865改965
10	DBP-26a	796	2	98.0	300	x	2	J853-SD-CW-4102	900	25/F	1	2	
11	DBP-105a	1696	1	98.0	300	x	5	J853-SD-CW-4102	1800	25/F	1	1	
12	DBP-106a	996	1	48.0	300	x	3	J853-SD-CW-4102	1100	25/F	1	1	
13	DBP-113a	1196	1	98.0	250	x	4	J853-SD-CW-4104	1300	25/F	1	1	
14	DBP-114a	1896	1	48.0	300	x	6	J853-SD-CW-4104	2000	25/F	1	1	
15	DBP-115a	1146	1	123.0	300	x	3	J853-SD-CW-4104	1250	25/F	1	1	
16	DBP-116a	1471	1	135.5	300	x	4	J853-SD-CW-4104	1575	25/F	1	1	
17	DBP-121a	1506	3	128.0	250	x	5	J853-SD-CW-4105	1610	25/F	1	3	
18	DBP-122a	1546	2	148.0	250	x	5	J853-SD-CW-4105	1650	25/F	1	2	
19	DBP-123a	1551	1	150.5	250	x	5	J853-SD-CW-4105	1655	25/F	1	1	
20	DBP-124a	1136	1	118.0	300	x	3	J853-SD-CW-4106	1240	25/F	1	1	
21	DBP-126a	1446	1	123.0	300	x	4	J853-SD-CW-4106	1550	25/F	1	1	
22	DBP-6a	496	1	98.0	300	x	1	J853-SD-CW-4103	600	25/F	1	1	原340改490
總數:			31										


?待定, ¹/₆₀₀₇ 節點與立面掛碼位不符, 香港確定

名稱	背板拆圖數據表	制圖	陳敏聰	2022.04.13	修改	A	
材料	2mm鋁板	復核	謝永林	2022.04.14	日期	2022.09.02	
顏色	UCT542049SC-3(淺灰)	批准	Daniel		圖號	DBP-6a-SJ	



工程號	J-853	地盤	延坪道住宅
-----	-------	----	-------

序號	物料編號	W	數量	EQ	M	X	N	位置	分格尺寸	樓層	樓層數	每層數量	備註
1	DBP-6b	496	2	98.0	300	x	1	J853-SD-CW-4101	600	23/F	1	2	原390改585
2	DBP-6b	496	2	98.0	300	x	1	J853-SD-CW-4101	600	23/F	1	2	原390改585
3	DBP-102b	2008.5	1	104.3	300	x	6	J853-SD-CW-4101	2112.5	23/F	1	1	原390改585
4	DBP-103b	2008.5	1	104.3	300	x	6	J853-SD-CW-4101	2112.5	23/F	1	1	原390改585
總數：			6										

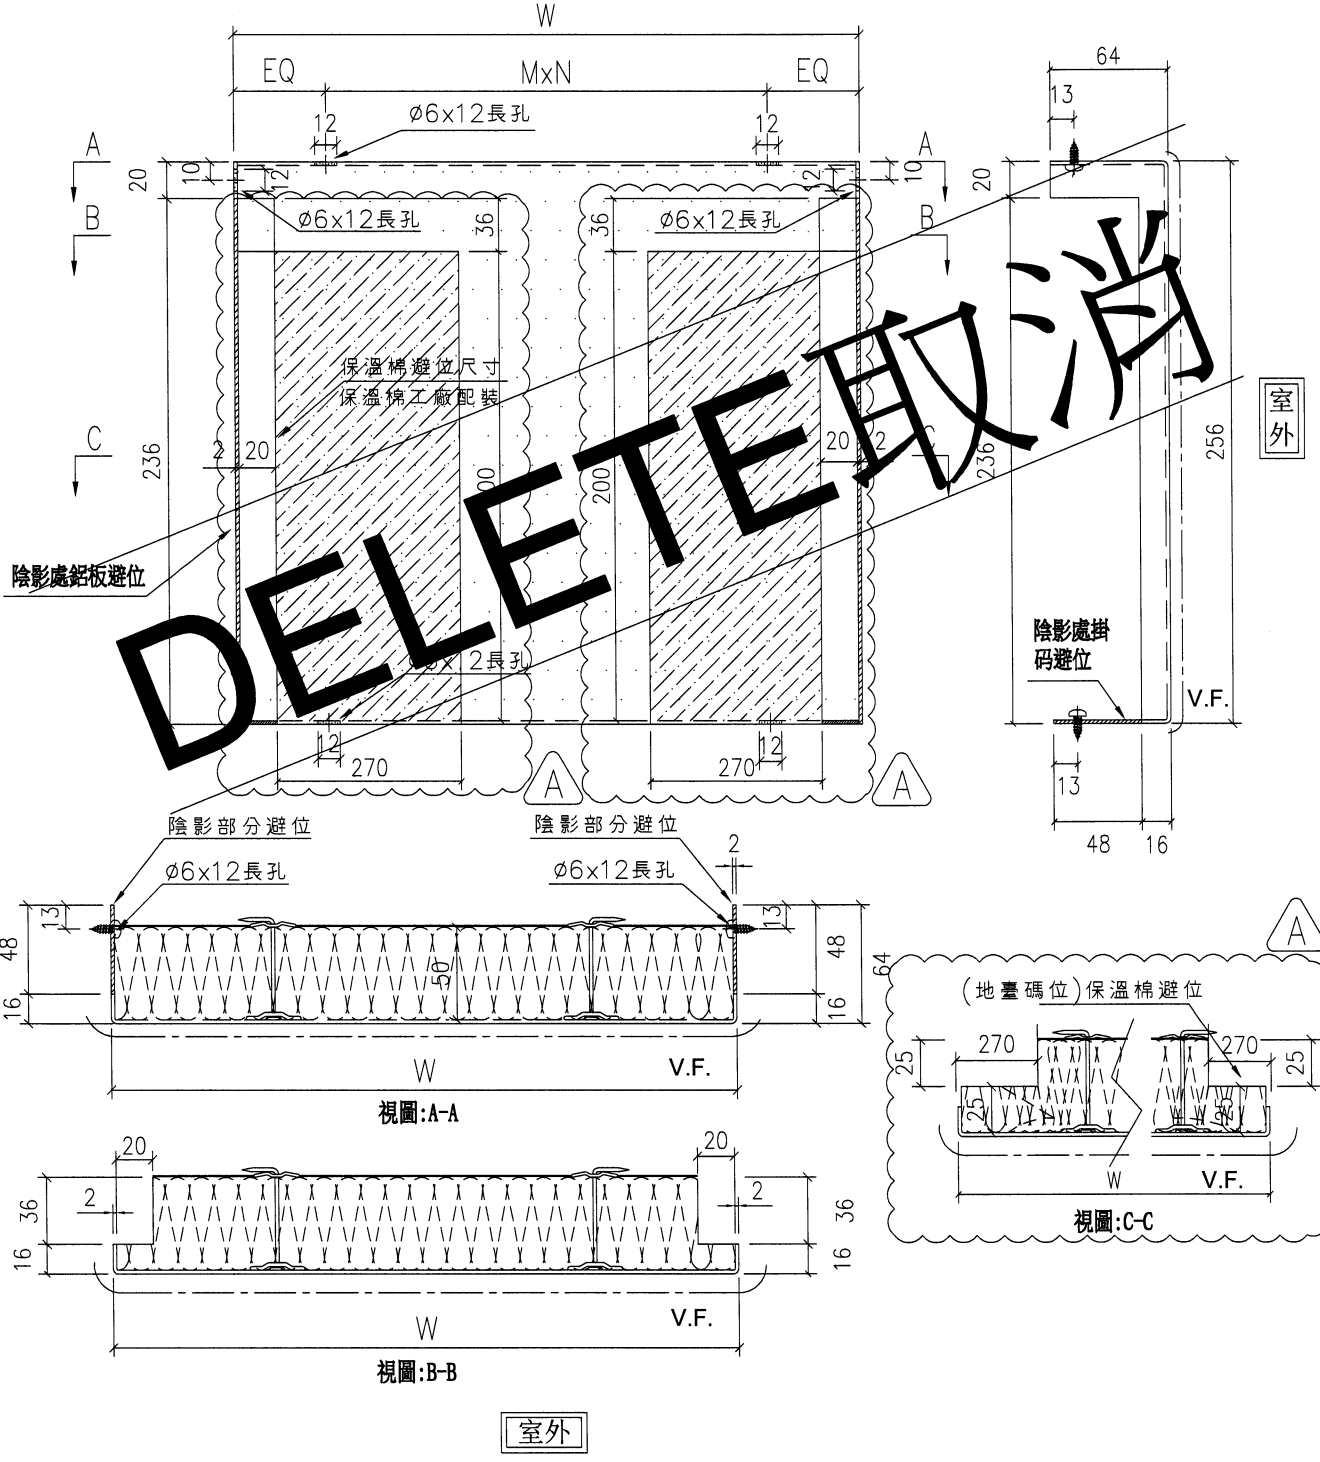

名稱	背板拆圖	制圖	陳敏聰	2022.04.13	修改	取消	
材料	2mm鋁板	復核	謝永林	2022.04.14	日期	2022.09.02	
顏色	UCT542049SC-3(淺灰)	批准	Daniel		圖號	DBP-06b	




美特鋁質有限公司
MIDI Aluminium Fabricator Ltd.

依據E14933避地臺碼位




工程號 J-853 地盤 延坪道住宅

序號	物料編號	W	數量	EQ	M	X	N	位置	分格尺寸	樓層	樓層數	每層數量	備註
1	DBP-6k	496	1	98.0	300	x	1	J853-SD-CW-4101	600	22/F	1	1	原340改585
2	DBP-6k	496	1	98.0	300	x	1	J853-SD-CW-4101	600	22/F	1	1	原340改585
3	DBP-6k	496	1	98.0	300	x	1	J853-SD-CW-4103	600	25/F	1	1	原340改490
4	DBP-14k	1011	1	55.5	300	x	3	J853-SD-CW-4102	1115	22/F	1	1	原340改585
5	DBP-101k	1458.5	1	129.3	300	x	4	J853-SD-CW-4101	1562.5	22/F	1	1	原340改585
6	DBP-104k	1458.5	1	129.3	300	x	4	J853-SD-CW-4101	1562.5	22/F	1	1	原340改585
7	DBP-110k	1536	1	143.0	250	x	5	J853-SD-CW-4103	1640	22/F	1	1	原340改585
8	DBP-112k	911	1	80.5	250	x	3	J853-SD-CW-4104	1015	22/F	1	1	原340改585
總數：			8										

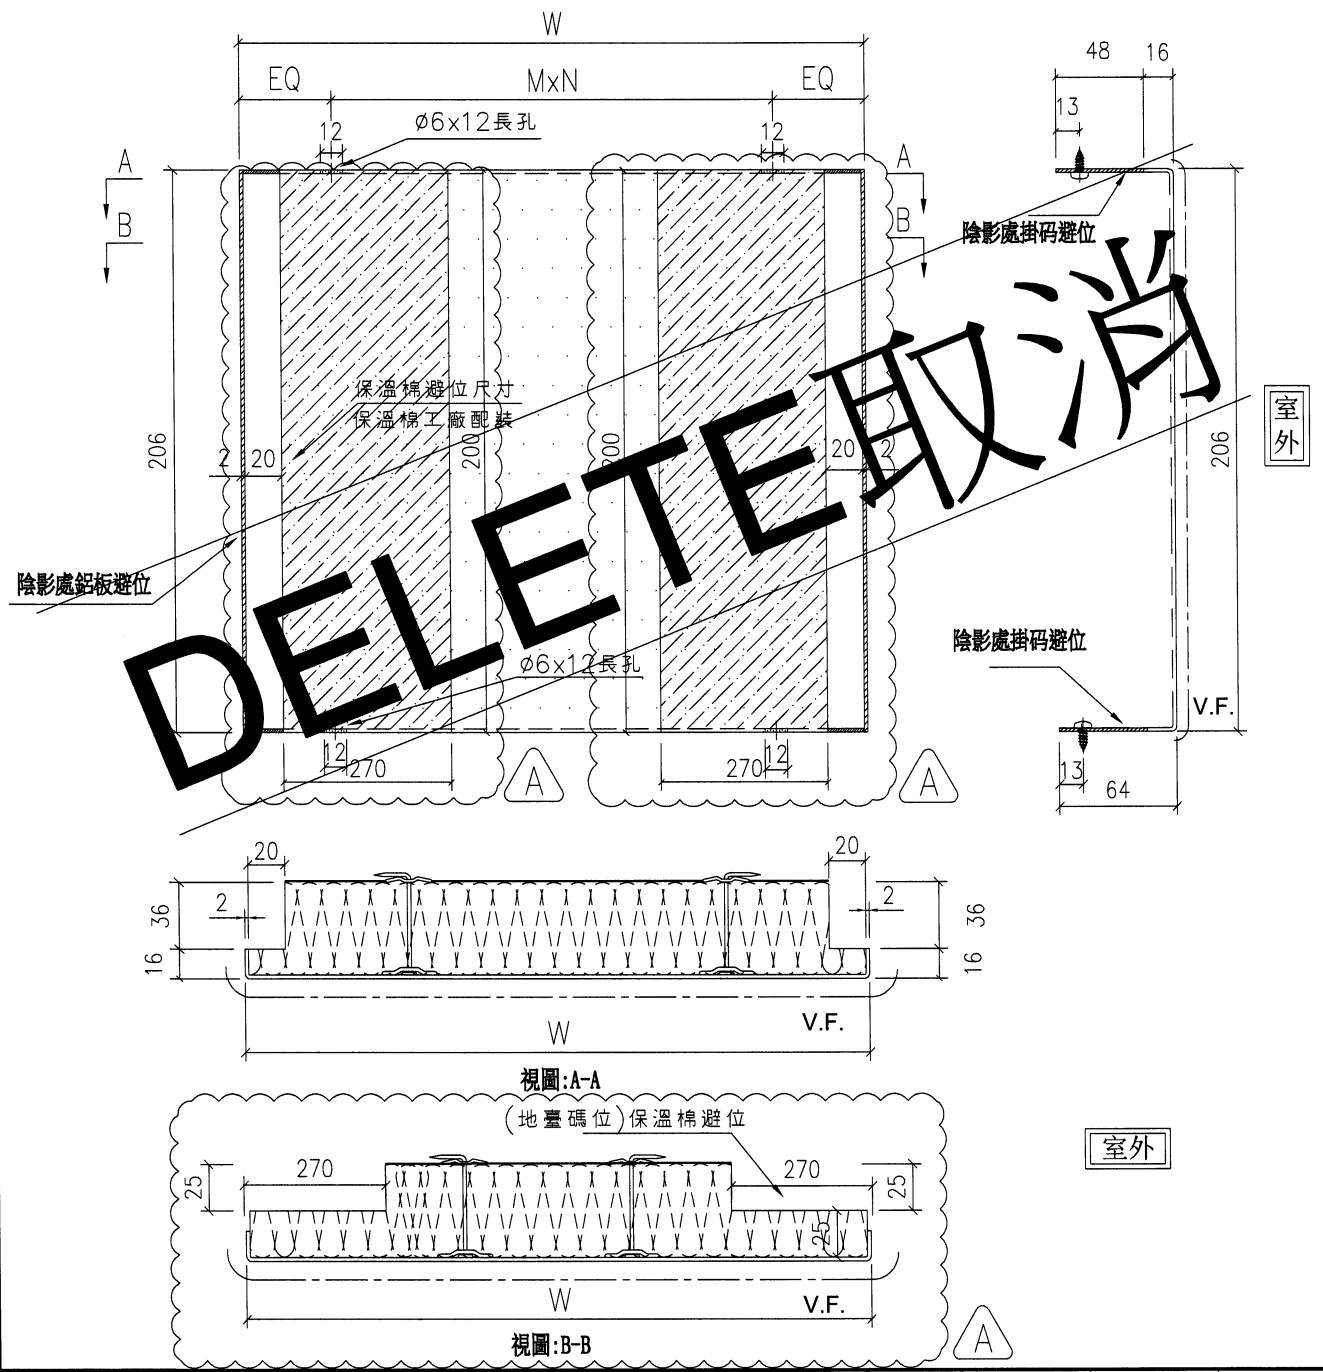

名稱	背板拆圖	制圖	陳敏聰	2022.04.13	修改	取消	
材料	2mm鋁板	復核	謝永林	2022.04.14	日期	2022.09.02	
顏色	UCT542049SC-3(淺灰)	批准	Daniel		圖號	DBP-06k	

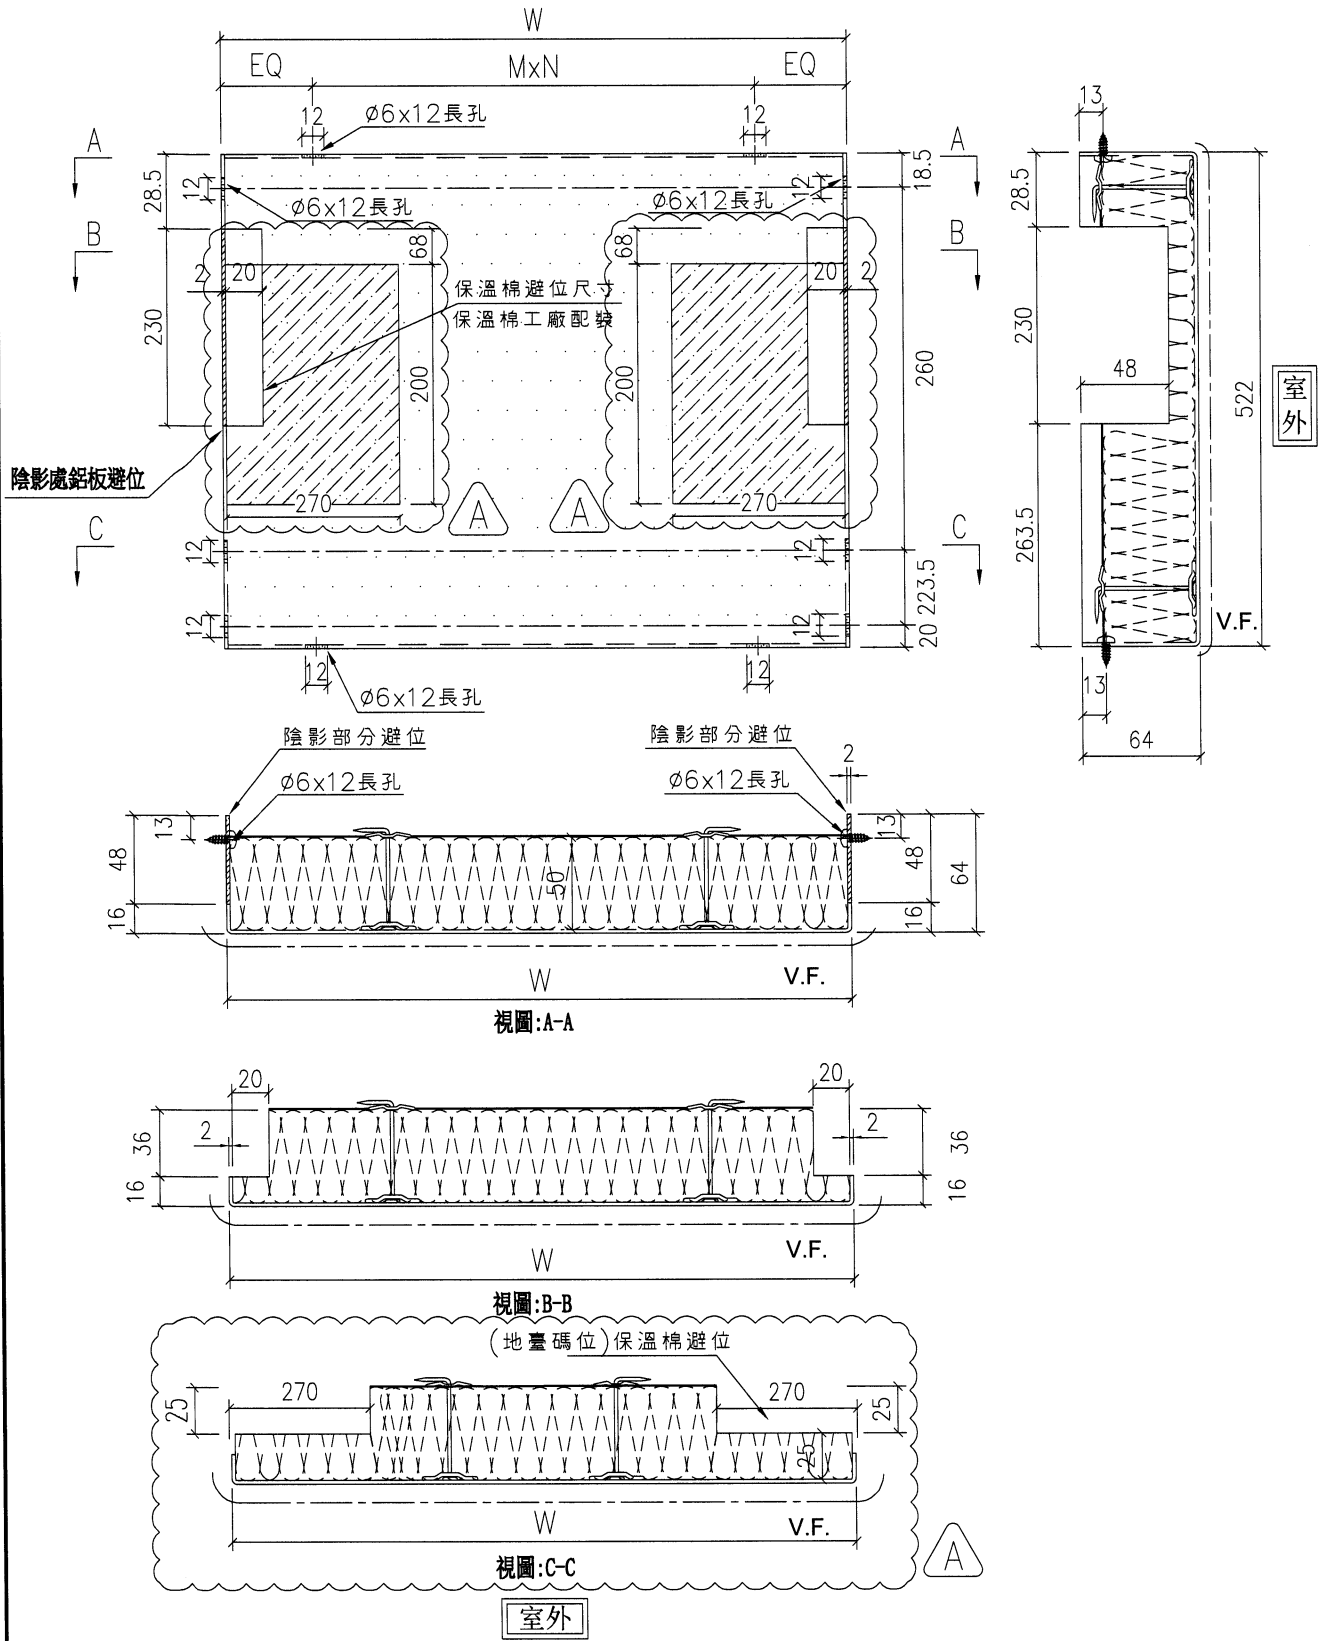

名稱	背板拆圖	制圖	陳敏聰	2022.04.13	修改	A	
材料	2mm鋁板	復核	謝永林	2022.04.14	日期	2022.09.02	
顏色	UCT542049SC-3(淺灰)	批准	Daniel		圖號	DBP-06x	

EG-DWG3



美特鋁質有限公司
MIDI Aluminium Fabricator Ltd.

依據E14949修改分格高度



工程號 J-853 地盤 延坪道住宅

序號	物料編號	W	數量	EQ	M	X	N	位置	分格尺寸	樓層	樓層數	每層數量	備註
1	DBP-6X	496	2	98.0	300	x	1	J853-SD-CW-4104	600	22/F	1	2	原1007.5改657.5
2	DBP-13X	896	2	73.0	250	x	3	J853-SD-CW-4104	1000	22/F	1	2	原1007.5改657.5
3	DBP-20X	696	2	48.0	300	x	2	J853-SD-CW-4102	800	22/F	1	2	原1007.5改657.5
4	DBP-107X	1796	2	148.0	300	x	5	J853-SD-CW-4102	1900	22/F	1	2	原1007.5改657.5
5	DBP-114X	1896	2	48.0	300	x	6	J853-SD-CW-4104	2000	22/F	1	2	原1007.5改657.5
6	DBP-118X	858.5	1	129.3	300	x	2	J853-SD-CW-4104	962.5	22/F	1	1	原1007.5改657.5
7	DBP-119X	608.5	1	54.3	250	x	2	J853-SD-CW-4104	712.5	22/F	1	1	原1007.5改657.5
總數:			12										




名稱	背板拆圖數據表	制圖	陳敏聰	2022.04.13	修改	A	
材料	2mm鋁板	復核	謝永林	2022.04.14	日期	2022.09.02	
顏色	UCT542049SC-3(淺灰)	批准	Daniel		圖號	DBP-06x-SJ	

A

工程號 J-853 地盤 延坪道住宅

物料編號	W	數量	EQ	M	X	N	位置	分格尺寸	樓層	樓層數	每層數量	備註
DBP-15	1097	15	98.5	300	x	3	J853-SD-CW-4103	1315	5/F-21/F	15	1	

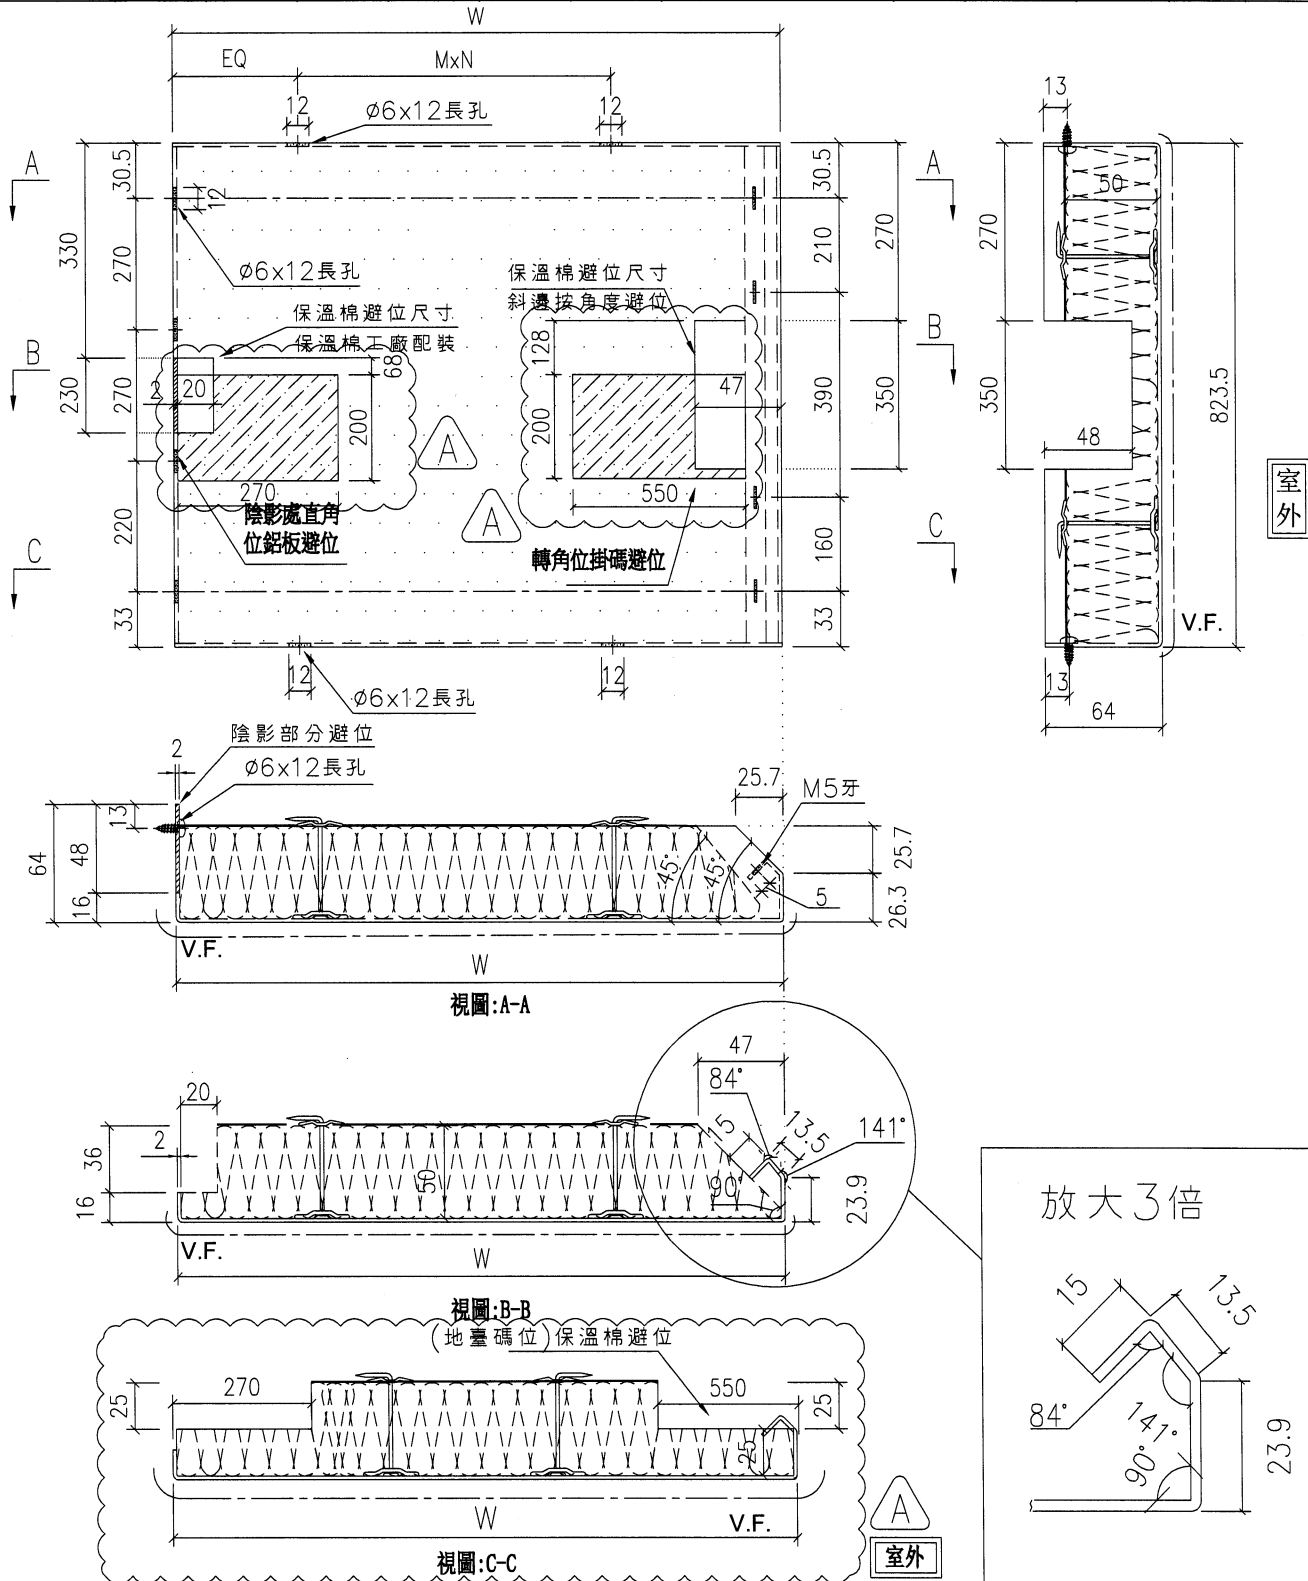

名稱	轉角生窗背板拆圖	制圖	陳敏聰	2022.04.13	修改	A		
材料	2mm鋁板	復核	謝永林	2022.04.14	日期	2022.09.02		
顏色	UCT542049SC-3(淺灰)	批准	Daniel		圖號	DBP-15		




美特鋁質有限公司
MIDI Aluminium Fabricator Ltd.

依據E14933避地臺碼位



工程號 J-853 地盤 延坪道住宅

物料編號	W	數量	EQ	M	X	N	位置	分格尺寸	樓層	樓層數	每層數量	備註
DBP-109	1510.5	15	130.3	250	x	5	J853-SD-CW-4103	1725	5/F-21/F	15	1	

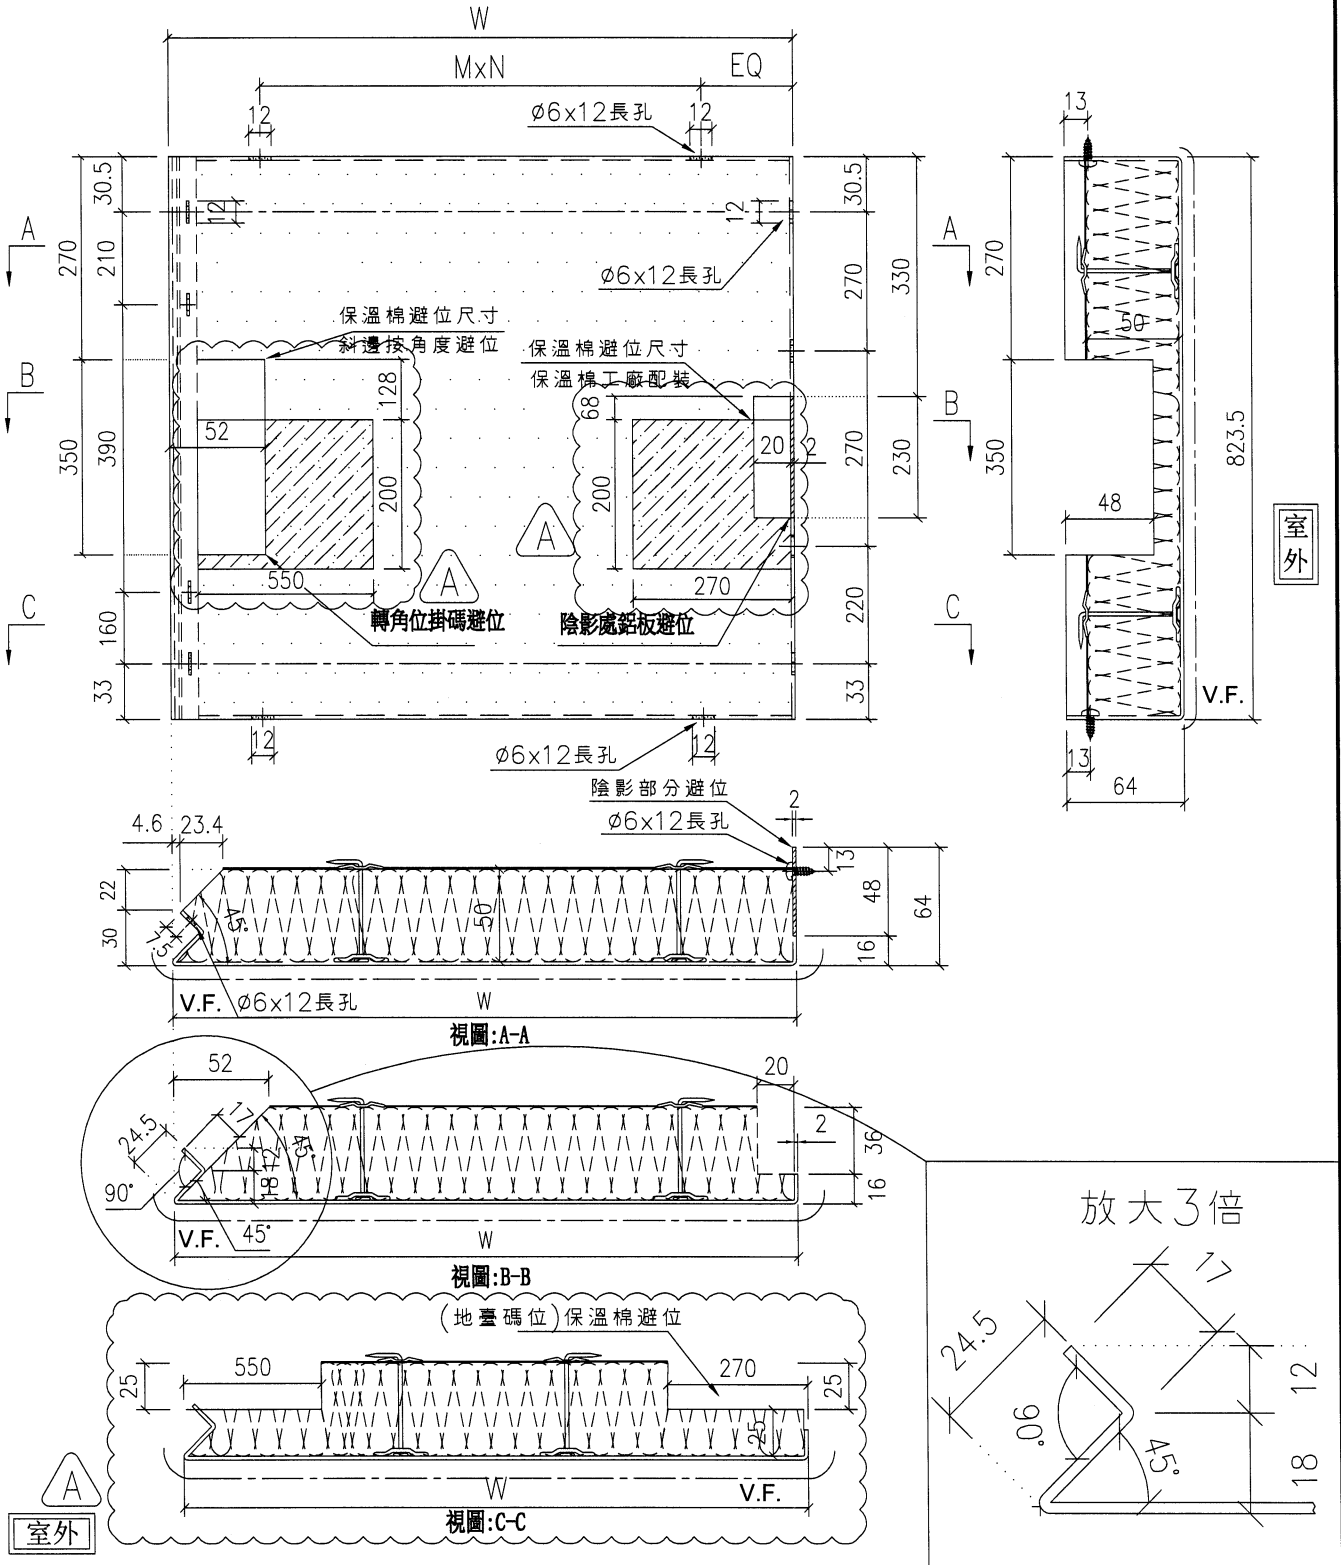

名稱	轉角梗窗背板拆圖	制圖	陳敏聰	2022.04.13	修改	A	
材料	2mm鋁板	復核	謝永林	2022.04.14	日期	2022.09.02	
顏色	UCT542049SC-3(淺灰)	批准	Daniel		圖號	DBP-109	




美特鋁質有限公司
MIDI Aluminium Fabricator Ltd.

依據E14933避地臺碼位



工程號 J-853 地盤 延坪道住宅

物料編號	W	數量	EQ	M	X	N	位置	分格尺寸	樓層	樓層數	每層數量	備註
DBP-111	1685.5	1	92.8	300	x	5	J853-SD-CW-4103	1900	23/F	1	1	

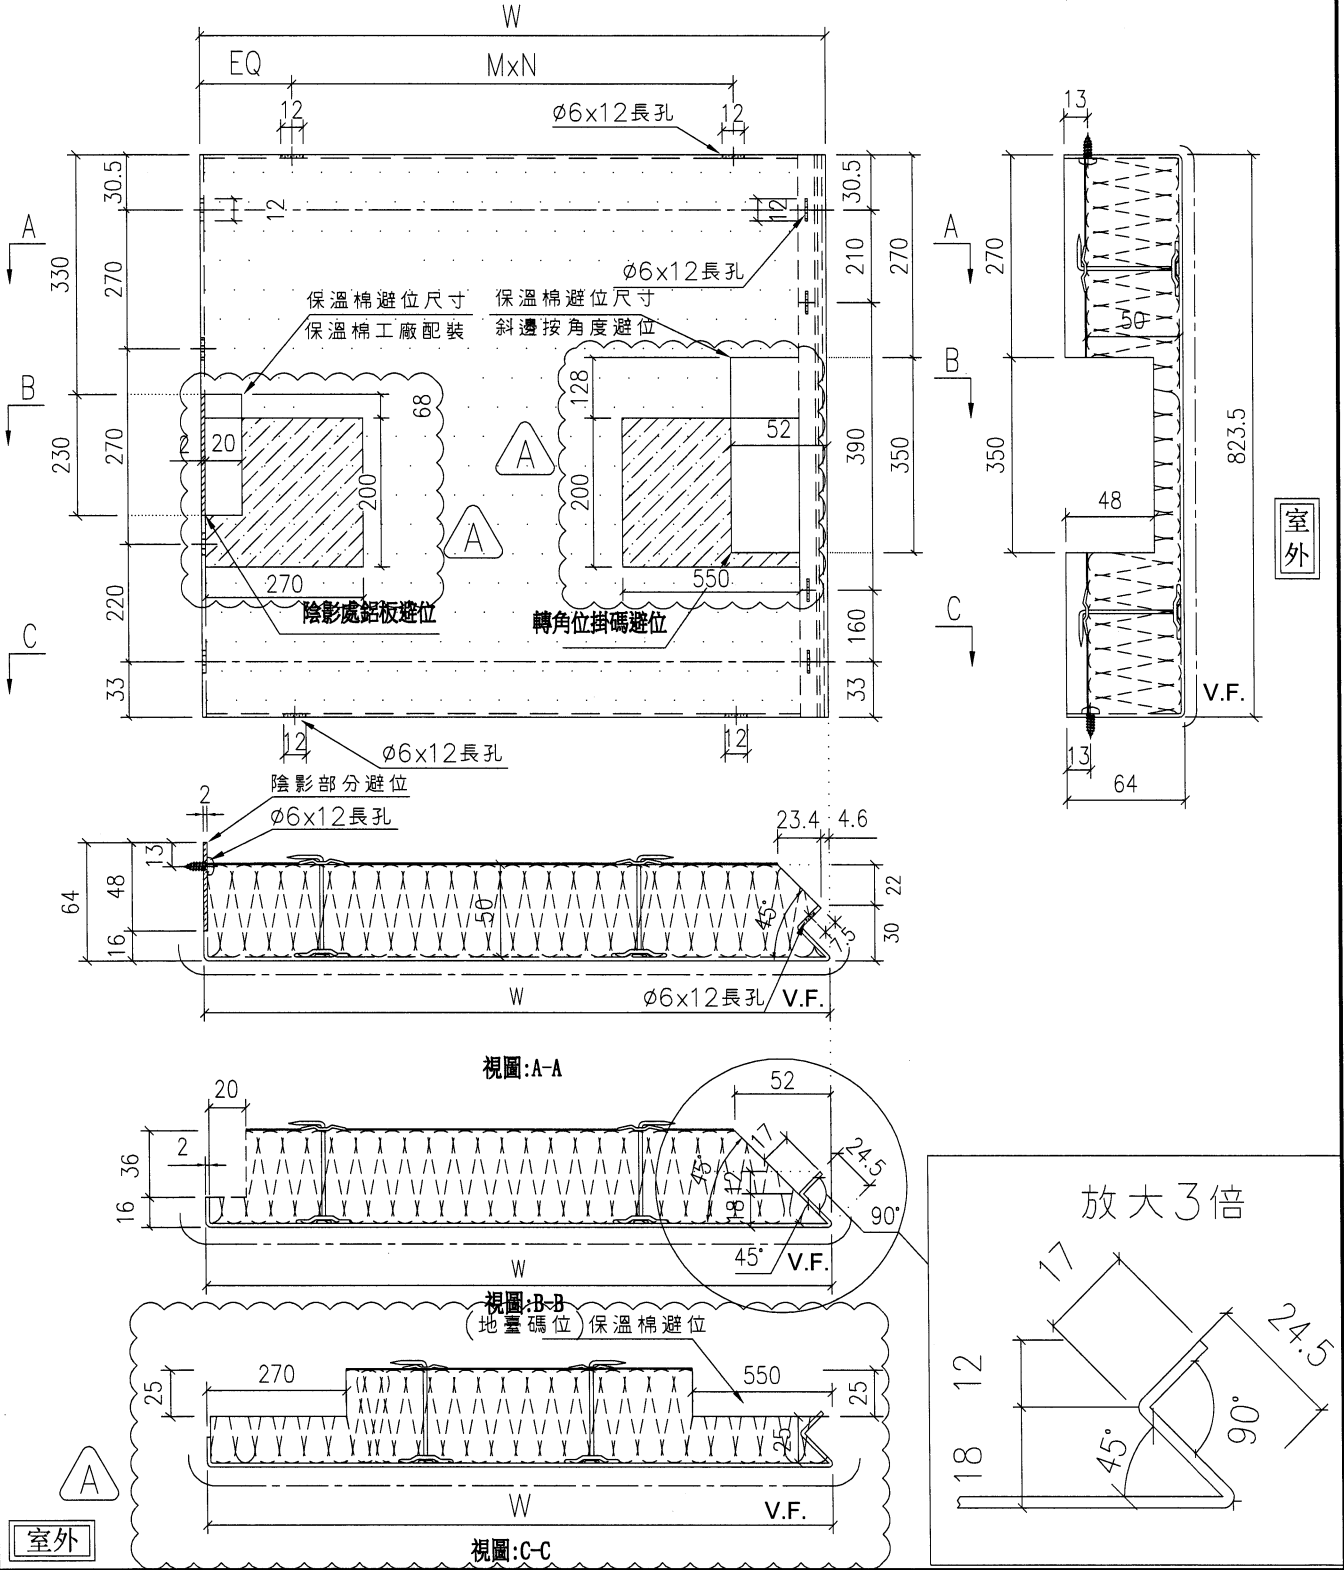

名稱	轉角樑窗背板折圖	制圖	陳敏聰	2022.04.13	修改	A	
材料	2mm鋁板	復核	謝永林	2022.04.14	日期	2022.09.02	
顏色	UCT542049SC-3(淺灰)	批准	Daniel		圖號	DBP-111	




美特鋁質有限公司
MIDI Aluminium Fabricator Ltd.

依據E14933避地臺碼位





工程號 J-853 地盤 延坪道住宅


物料編號	W	數量	EQ	M	X	N	位置	分格尺寸	樓層	樓層數	每層數量	備註
DBP-41	882	1	66.0	250	x	3	J853-SD-CW-4103	1100	23/F	1	1	

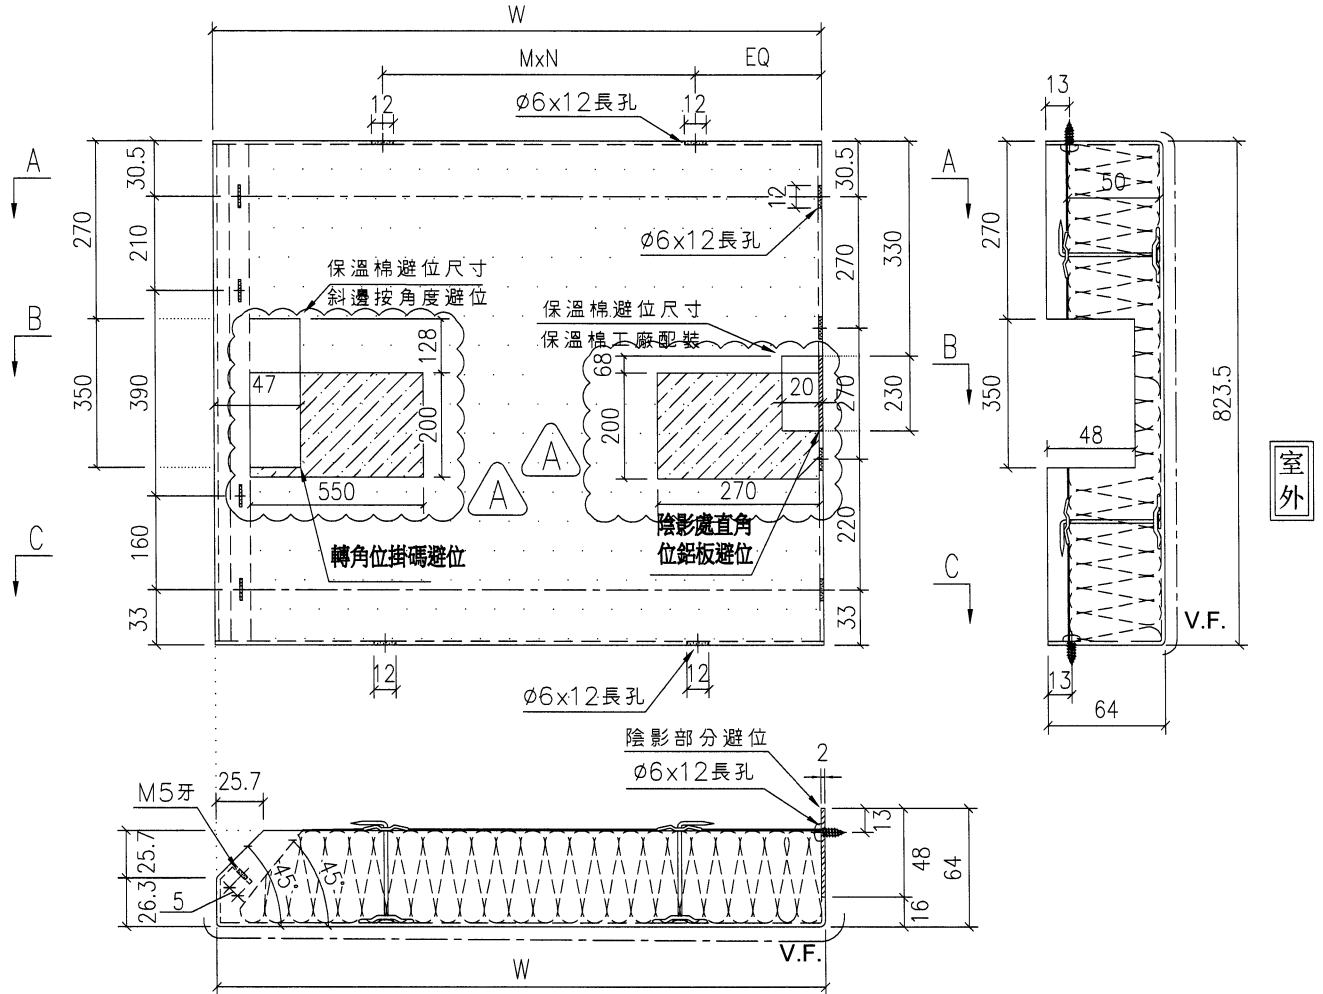

室外

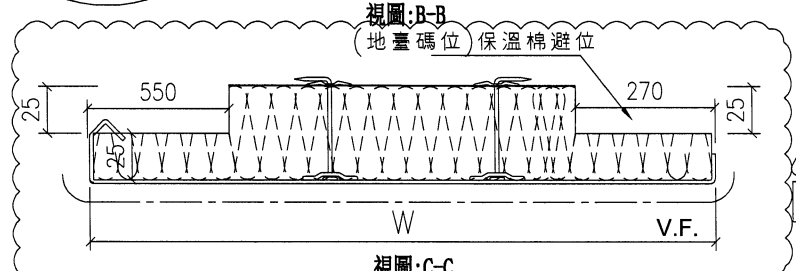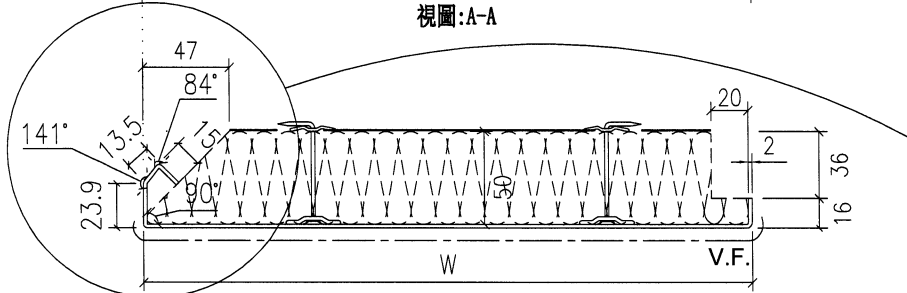

放大3倍

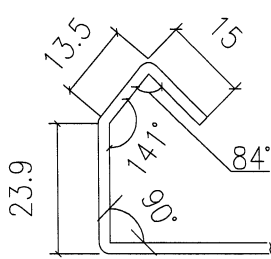


室外

名稱	轉角生窗背板拆圖	制圖	陳敏聰	2022.04.13	修改	A	
材料	2mm鋁板	復核	謝永林	2022.04.14	日期	2022.09.02	
顏色	UCT542049SC-3(淺灰)	批准	Daniel		圖號	DBP-41	

工程號 J-853 地盤 延坪道住宅

物料編號	W	數量	EQ	M	X	N	位置	分格尺寸	樓層	樓層數	每層數量	備註
DBP-15k	1097	1	98.5	300	x	3	J853-SD-CW-4103	1315	22/F	1	1	原340改585

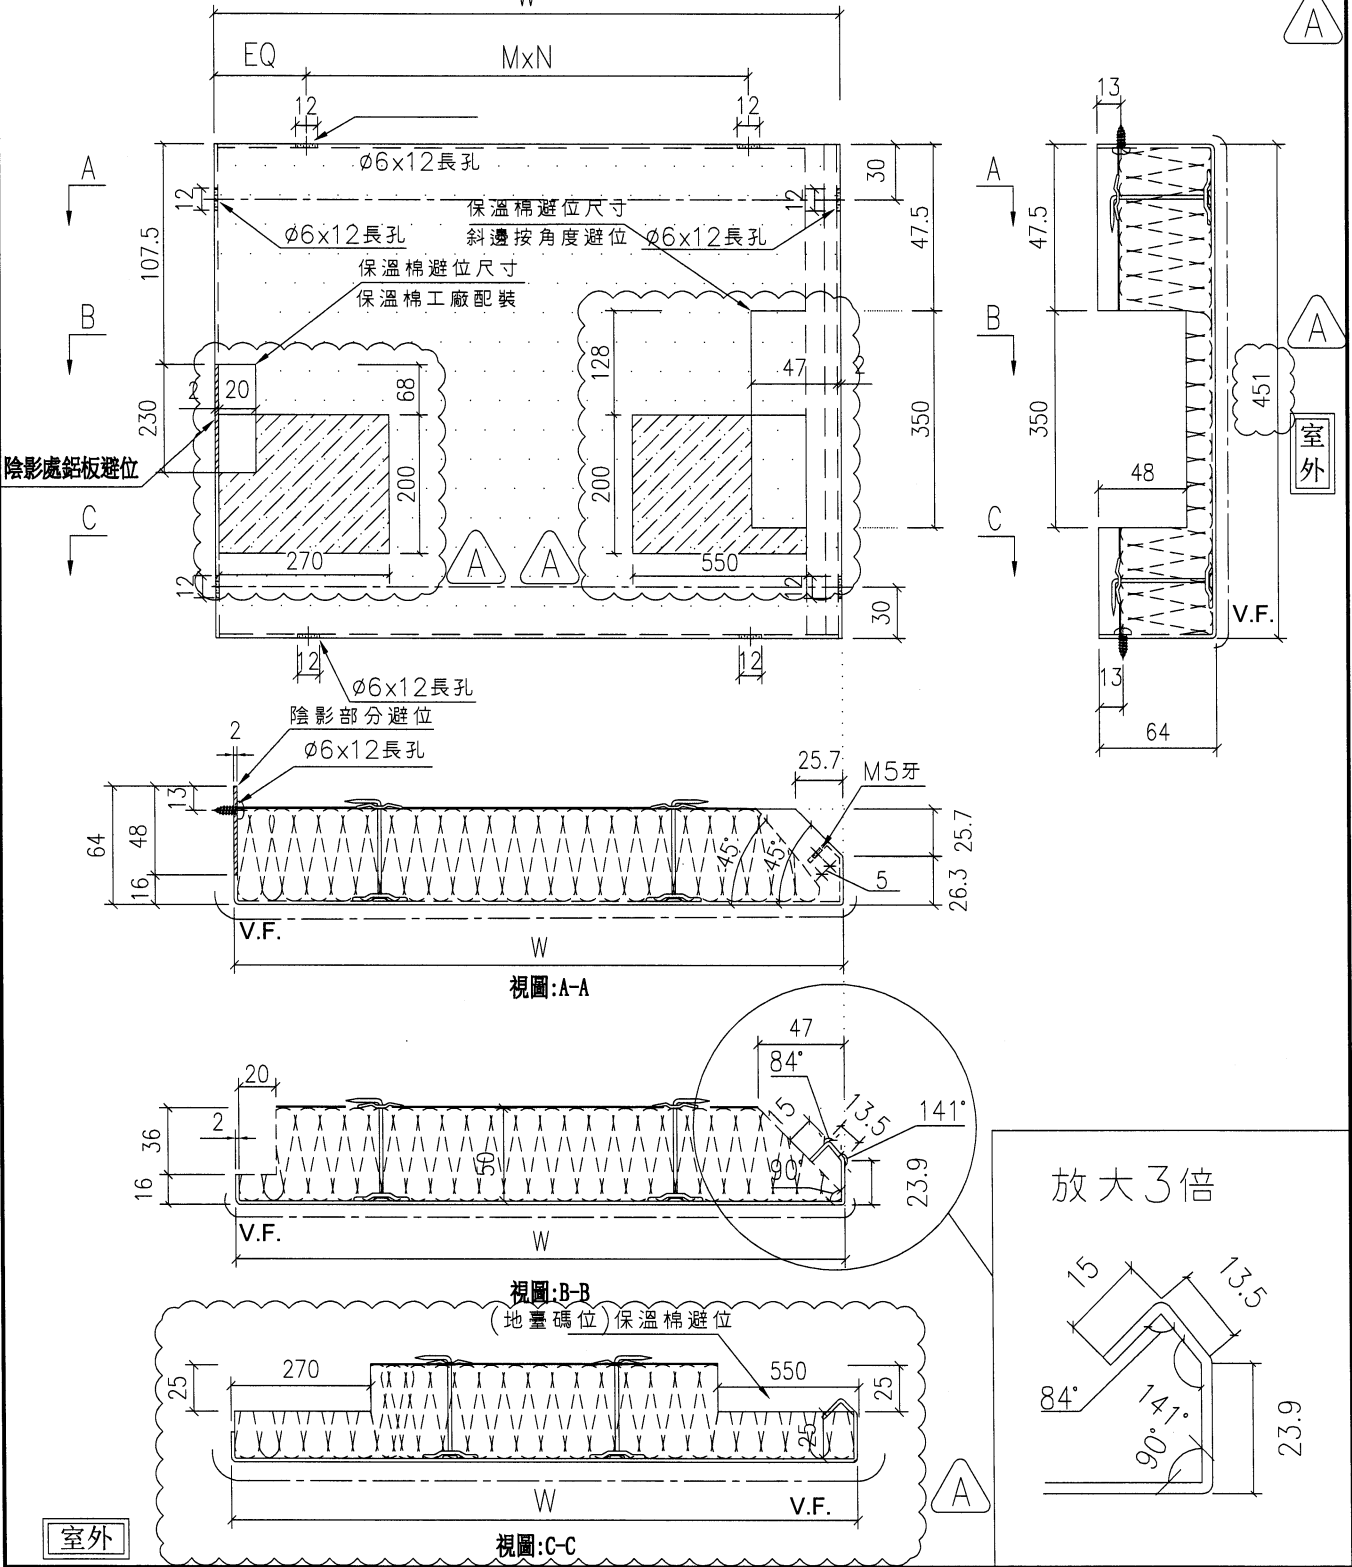

名稱	轉角生窗背板拆圖	制圖	陳敏聰	2022.04.13	修改	A	
材料	2mm鋁板	復核	謝永林	2022.04.14	日期	2022.09.02	
顏色	UCT542049SC-3(淺灰)	批准	Daniel		圖號	DBP-15k	



美特鋁質有限公司
MIDI Aluminium Fabricator Ltd.

依據E14933避地臺碼位




依據E14949修改分格高度



工程號 J-853 地盤 延坪道住宅

物料編號	W	數量	EQ	M	X	N	位置	分格尺寸	樓層	樓層數	每層數量	備註
DBP-109k	1510.5	1	130.3	250	x	5	J853-SD-CW-4103	1725	22/F	1	1	原340改585

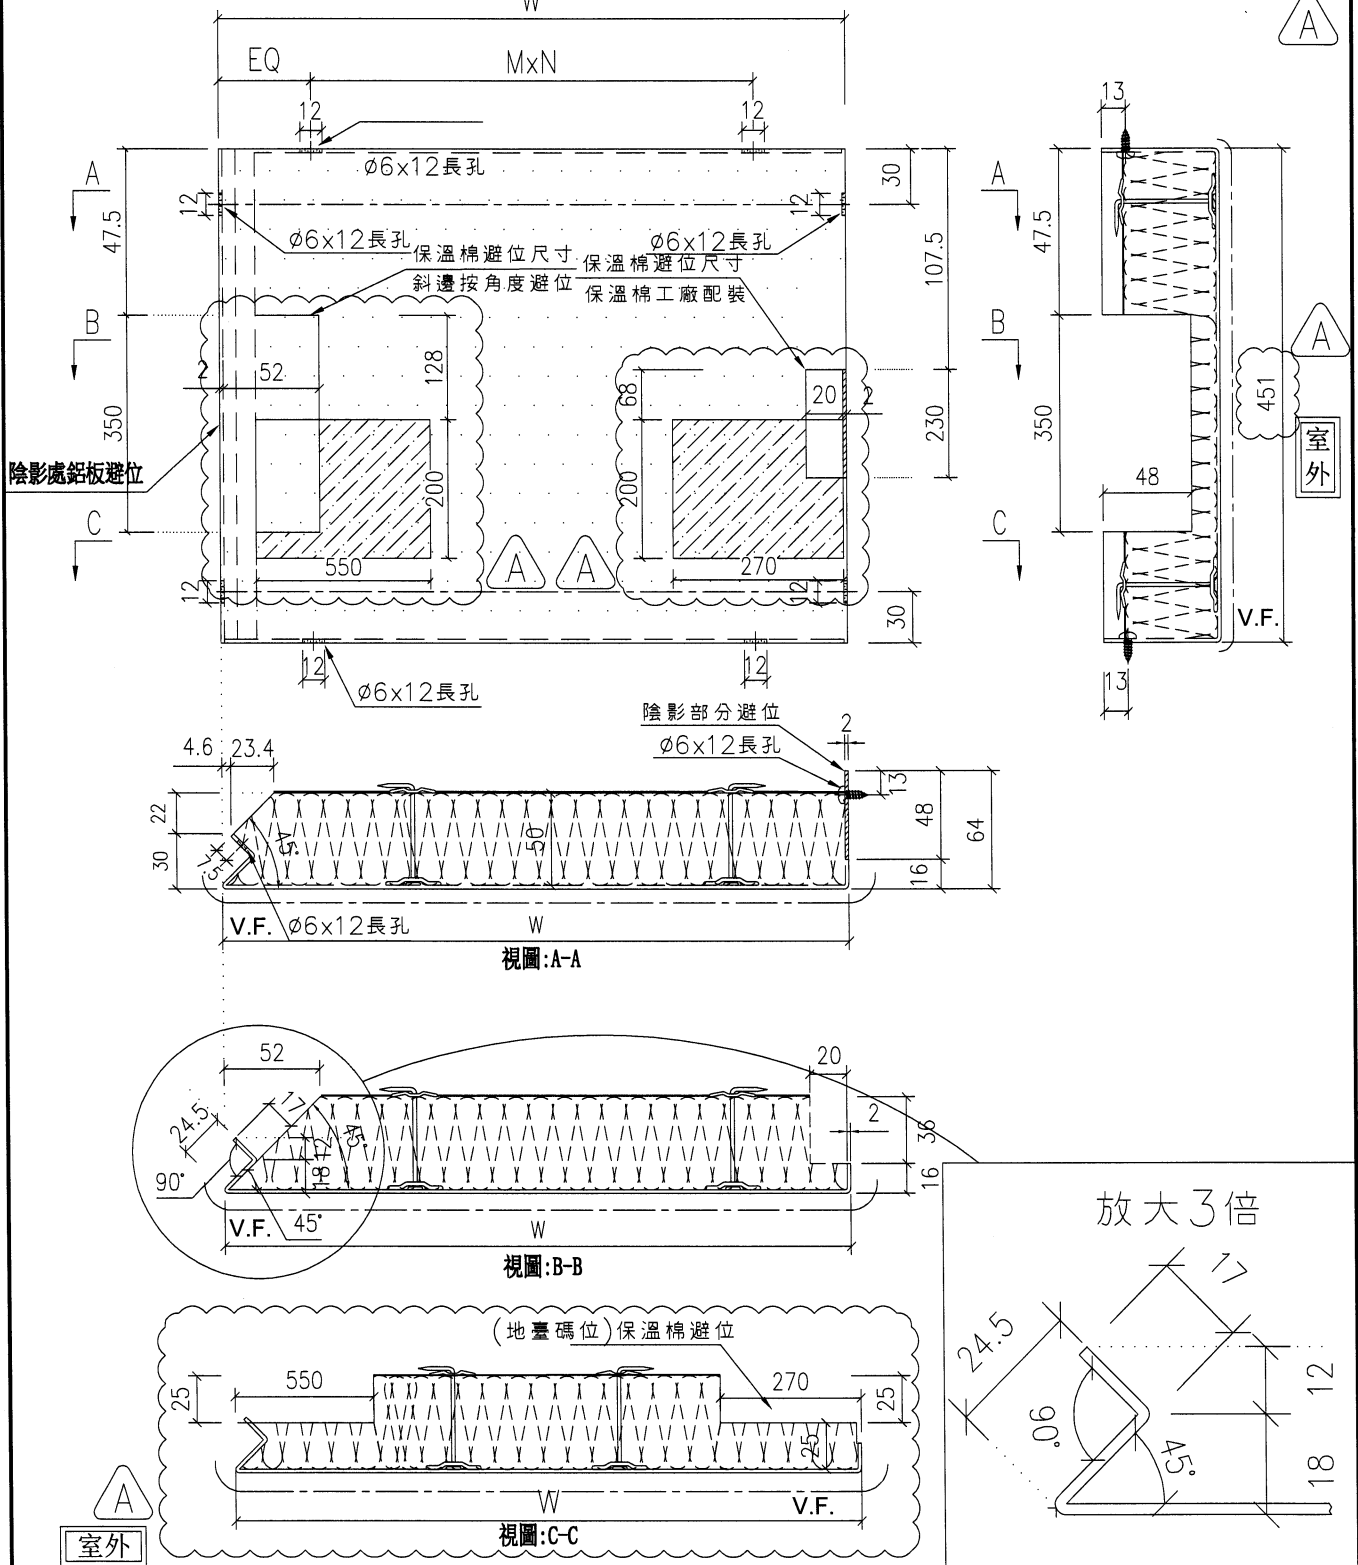

名稱	轉角梗窗背板拆圖	制圖	陳敏聰	2022.04.13	修改	A	
材料	2mm鋁板	復核	謝永林	2022.04.14	日期	2022.09.02	
顏色	UCT542049SC-3(淺灰)	批准	Daniel		圖號	DBP-109k	

美特鋁質有限公司
MIDI Aluminium Fabricator Ltd.

依據E14933避地臺碼位




工程號 J-853 地盤 延坪道住宅



依據E14949修改分格高度




物料編號	W	數量	EQ	M	X	N	位置	分格尺寸	樓層	樓層數	每層數量	備註
DBP-111a	1685.5	1	92.8	300	x	5	J853-SD-CW-4103	1900	25/F	1	1	原340改490

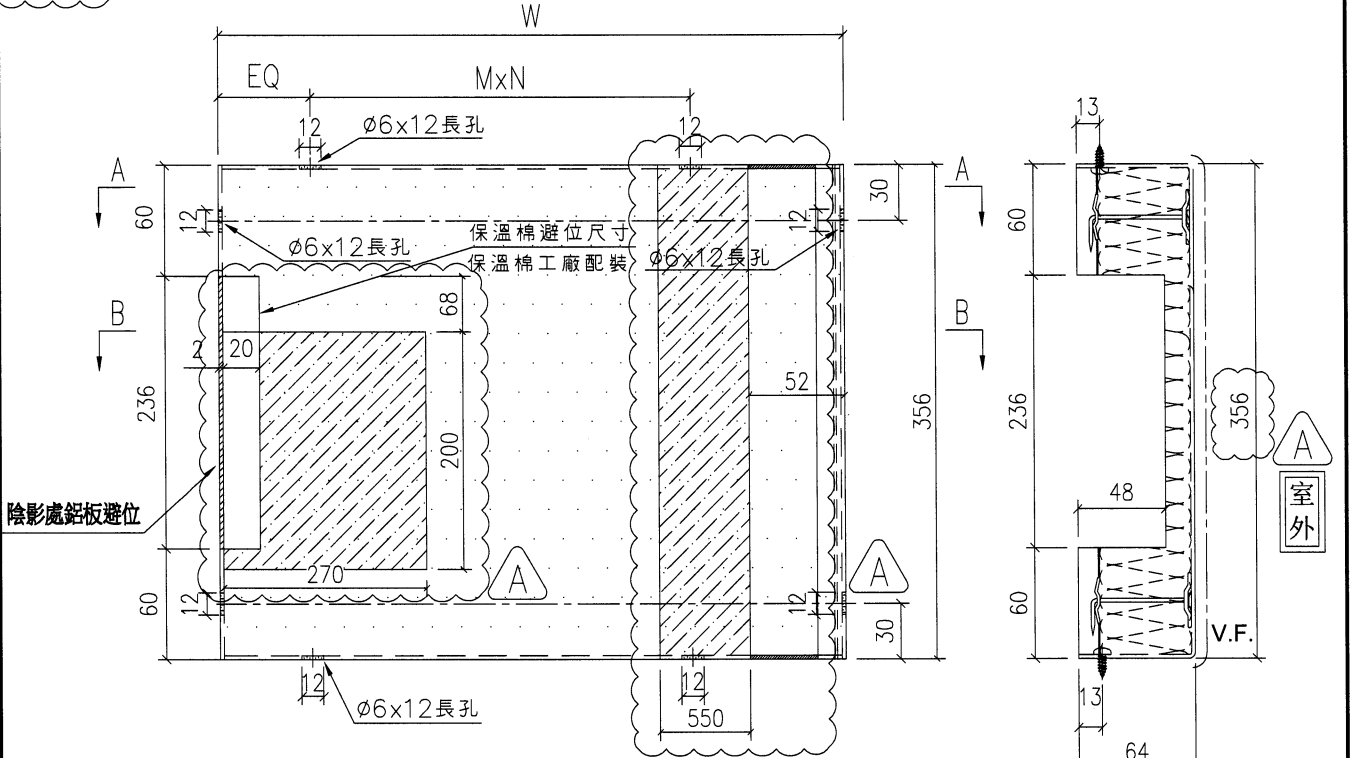

?待定, ¹/₆₀₀₇ 節點與立面掛碼位不符, 香港確定

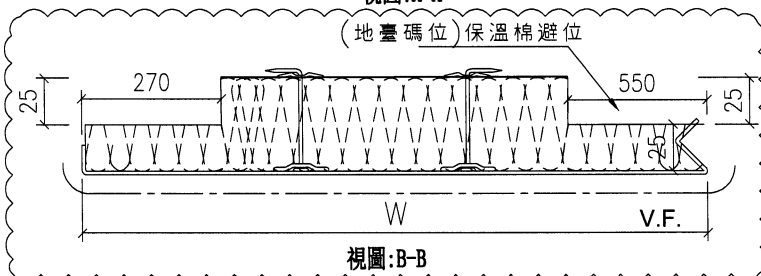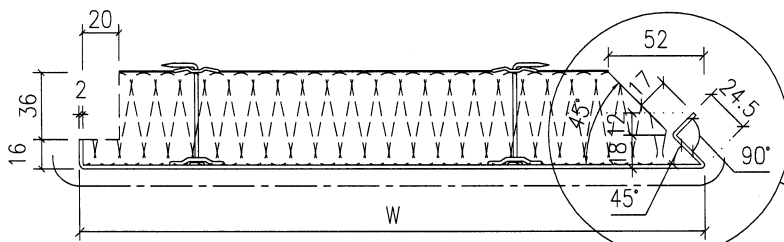

室外

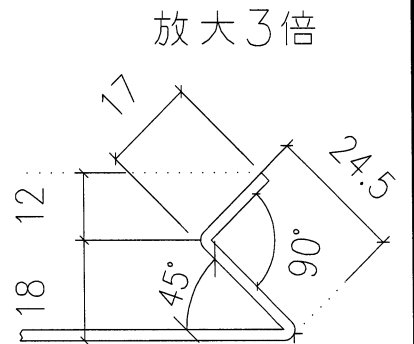

名稱	轉角梗窗背板拆圖	制圖	陳敏聰	2022.04.13	修改	A	
材料	2mm鋁板	復核	謝永林	2022.04.14	日期	2022.09.02	
顏色	UCT542049SC-3(淺灰)	批准	Daniel		圖號	DBP-111a	



美特鋁質有限公司
MIDI Aluminium Fabricator Ltd.

依據E14933避地臺碼位




依據E14949修改分格高度




工程號 J-853 地盤 延坪道住宅



物料編號	W	數量	EQ	M	X	N	位置	分格尺寸	樓層	樓層數	每層數量	備註
DBP-41a	882	1	66.0	250	x	3	J853-SD-CW-4103	1100	25/F	1	1	原340改490

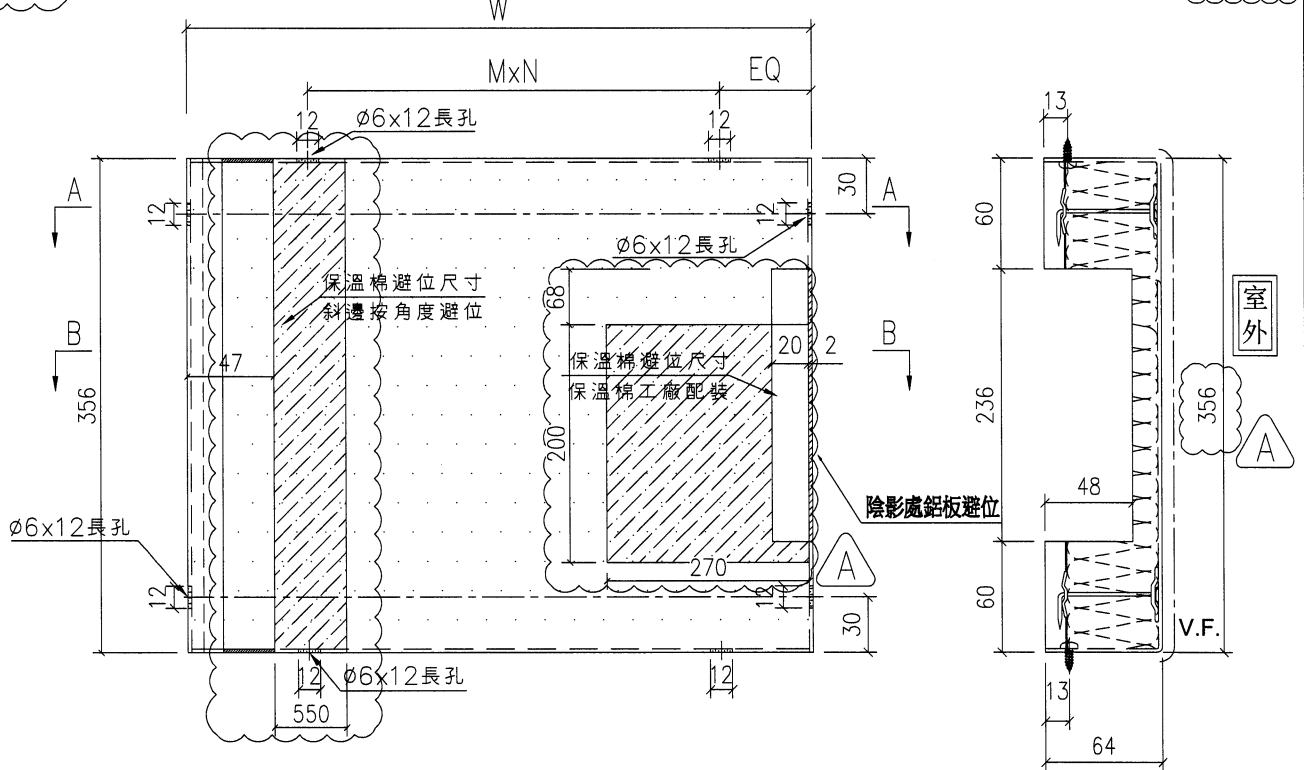

?待定, $\frac{1}{6007}$ 節點與立面掛碼位不符, 香港確定

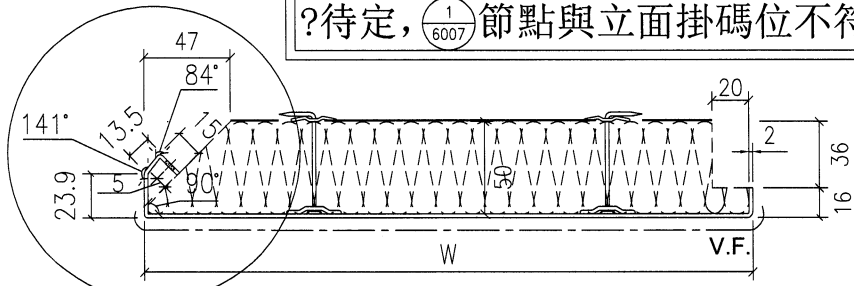


視圖:A-A

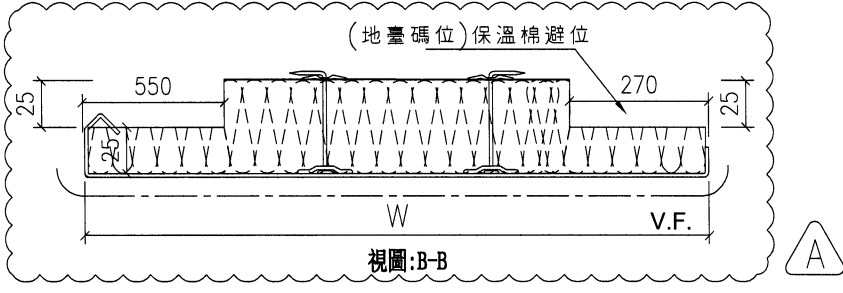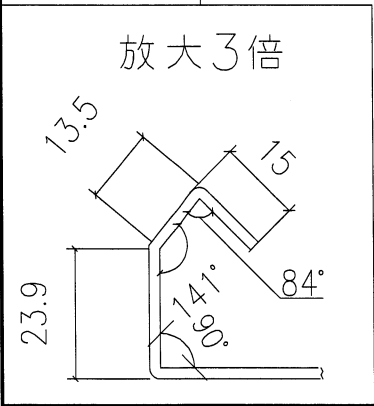

視圖:B-B

室外

名稱	轉角生窗背板拆圖	制圖	陳敏聰	2022.04.13	修改	A	
材料	2mm鋁板	復核	謝永林	2022.04.14	日期	2022.09.02	
顏色	UCT542049SC-3(淺灰)	批准	Daniel		圖號	DBP-41a	

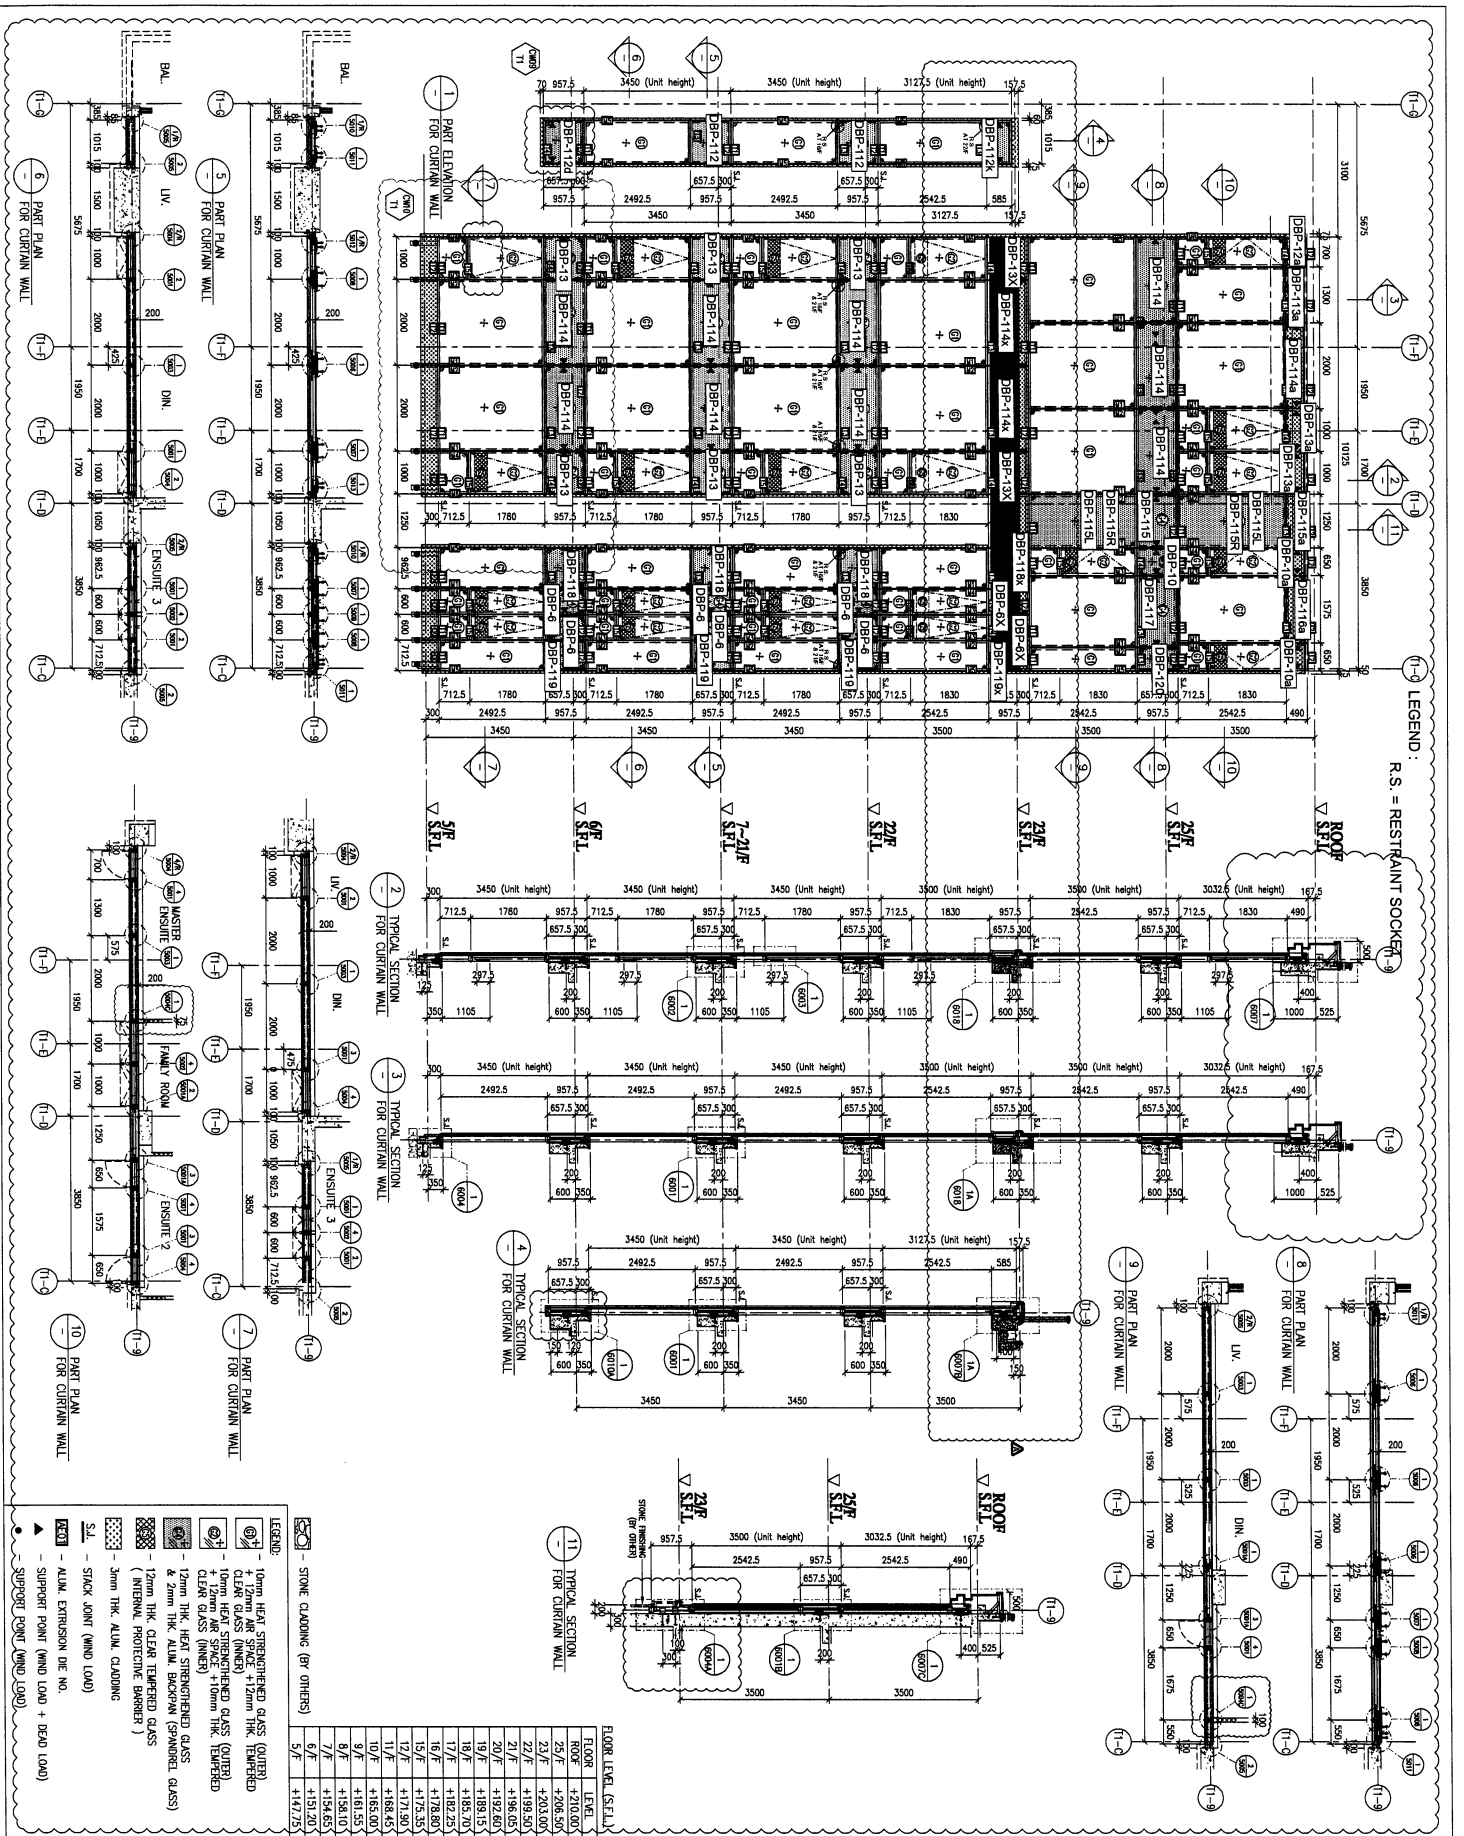

LEGEND:
RS = RESTRAINT SOCKET

LEGEND:

- 10mm HEAT STRENGTHENED GLASS (OUTER)
- 10mm HEAT STRENGTHENED GLASS (INNER)
- 10mm HEAT STRENGTHENED GLASS (OUTER) CLEAR GLASS (INNER)
- 12mm THK. ALUM. CLADDING (INTERNE PROTECTIVE BRUSH)
- 12mm THK. CLEAR TEMPERED GLASS
- 3mm THK. ALUM. CLADDING
- S.L. - STICK JOINT (WIND LOAD)
- ALUM. EXTRUSION DET. NO.
- SUPPORT POINT (WIND LOAD + DEAD LOAD)
- SUPPORT POINT (WIND LOAD)

FLOOR LEVEL (R.S.L.)

FLOOR	LEVEL
FLOOR	+10.000
ROOF	+206.505
	+203.000
	+22.000
	+196.505
	+192.600
	+189.105
	+185.200
	+182.250
	+178.800
	+175.350
	+171.900
	+168.450
	+165.000
	+161.550
	+158.100
	+154.650
	+151.200
	+147.750

CLIENT: SHIMAO GROUP HOLDINGS LIMITED

ARCHITECT: WONG TUNG & PARTNERS LIMITED

STRUCTURAL ENGINEER: C.M. WONG & ASSOCIATES LTD

MAIN CONTRACTOR: HIP HING CONSTRUCTION CO. LTD

PROJECT: PROPOSED RESIDENTIAL DEVELOPMENT AT R.K.A.L. 6542 THE PINE ROAD, KOWLOON

DATE: 18-MAR-21

SCALE: 1:60 (A1)

DESIGNED BY: LHR

CHECKED BY: J-853

REVISIONS:

NO.	DATE	REVISION SUBJECT TO THIS CHANGE	BY
1	18-03-2021	ISSUED FOR PERMIT	LHR

NOTE:

- ALL DIMENSIONS ARE IN mm.
- ALL ELEVATIONS ARE VIEWED FROM OUTSIDE.
- ALL DIMENSIONS TO BE VERIFIED ON SITE BEFORE FABRICATION.

LEGEND:



- 1. F.F.L. - FINISHED FLOOR LEVEL
- 2. S.F.L. - STRUCTURAL FLOOR LEVEL
- 3. R.F.L. - REVERSED DETAIL

DETAIL WORK NO.

- 1. F.F.L. - FINISHED FLOOR LEVEL
- 2. S.F.L. - STRUCTURAL FLOOR LEVEL
- 3. R.F.L. - REVERSED DETAIL

COMPANIES:

- SHIMAO GROUP HOLDINGS LIMITED**
- WONG TUNG & PARTNERS LIMITED**
- C.M. WONG & ASSOCIATES LTD**
- HIP HING CONSTRUCTION CO. LTD**
- NEUNHARDT**

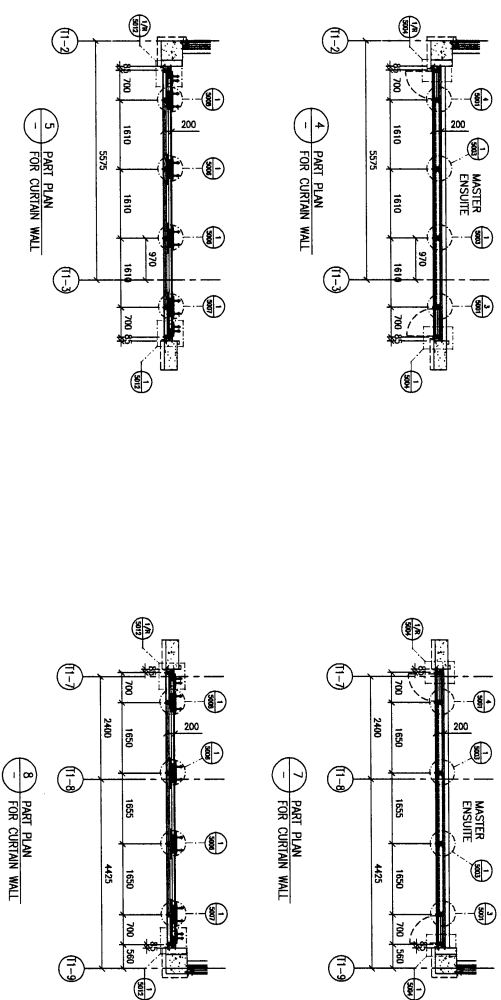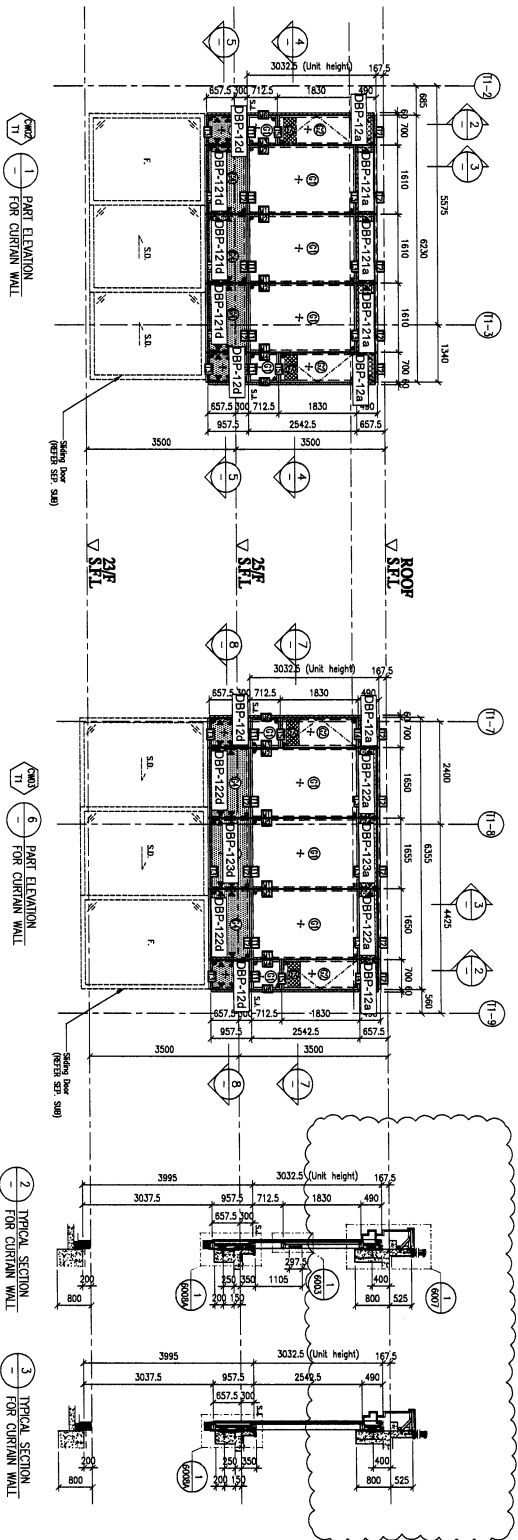

FLOOR LEVEL (S.F.L.)	
FLOOR LEVEL	+210.00
ROOF	+206.50
23/F	+203.00

- LEGEND:**
- 10mm HEAT STRENGTHENED GLASS (OUTER)
 - 12mm AIR SPACE + 12mm HEAT STRENGTHENED GLASS (INNER)
 - 10mm HEAT STRENGTHENED GLASS (OUTER) + 12mm AIR SPACE + 12mm HEAT STRENGTHENED GLASS (INNER)
 - 12mm HEAT STRENGTHENED GLASS (OUTER) + 12mm AIR SPACE + 12mm HEAT STRENGTHENED GLASS (INNER)
 - 12mm HEAT STRENGTHENED GLASS (OUTER) + 12mm AIR SPACE + 12mm HEAT STRENGTHENED GLASS (INNER) + 2mm THK CLEAR TEMPERED GLASS (INTERNAL PROTECTIVE BARRIER)
 - 3mm THK ALUM. CLADDING
 - S.J. - STICK JOINT (WIND LOAD)
 - EXT. - ALUM. EXTENSION (DE NO.)
 - SUPP. - SUPPORT POINT (WIND LOAD + DEAD LOAD)

DATE: 02-OCT-21 SCALE: 1:60 (A1)
 DRAWN BY: LHR CHECKED BY:
 PROJECT: PROPOSED RESIDENTIAL DEVELOPMENT AT N.K.I.L. 6542 YIN PING ROAD KOWLOON

TITLE: PART ELEVATION FOR CURTAIN WALL AT TOWER 1

DATE: 02-OCT-21 SCALE: 1:60 (A1)
 DRAWN BY: LHR CHECKED BY:
 PROJECT: PROPOSED RESIDENTIAL DEVELOPMENT AT N.K.I.L. 6542 YIN PING ROAD KOWLOON

TITLE: PART ELEVATION FOR CURTAIN WALL AT TOWER 1

SHIMAO GROUP HOLDINGS LIMITED

ARCHITECT: **WONG TUNG & PARTNERS LIMITED**

MAIN CONTRACTOR: **裕興建築有限公司 HIP HING CONSTRUCTION CO LTD**

STRUCTURAL ENGINEER: **CMA C M WONG & ASSOCIATES LTD 黃志明建築工程師有限公司**

FAÇADE CONSULTANT: **NEUNHARDT**

美特堅有限公司 MIDJI Aluminium Fabrication Ltd
 Unit 6-B, Sunny Industrial Centre, 1/F
 610 Cheong Cheong Street, Kowloon
 Tel: (852) 23921114 Fax: (852) 27277865
 DME NO.: J853-S0-CW-4105 REV.: A

NOTE:

- ALL DIMENSIONS ARE IN mm.
- ALL ELEVATIONS ARE VIEWED FROM OUTSIDE.
- ALL DIMENSIONS TO BE VERIFIED ON SITE BEFORE FABRICATION.

LEGEND:

- DETAIL MARK NO.
- SHEET NO.
- F.F.L. - FINISHED FLOOR LEVEL
- S.F.L. - STRUCTURAL FLOOR LEVEL
- REVERSED DETAIL

BD REF:

CLIENT : SHIMAO GROUP HOLDINGS LIMITED

ARCHITECT : WING YUNG & PARTNERS LIMITED

MAIN CONTRACTOR : 裕興建築有限公司
HIP HING CONSTRUCTION CO. LTD

STRUCTURAL ENGINEER : C.M WONG & ASSOCIATES LTD
莫志明建築工程師有限公司

FAÇADE CONSULTANT : MEINHARDT

NOTE :
1. ALL DIMENSIONS ARE IN mm.
2. ALL ELEVATIONS ARE VIEWED FROM OUTSIDE.
3. ALL DIMENSIONS TO BE VERIFIED ON SITE BEFORE FABRICATION.






LEGEND :
①1 - DETAIL MARK NO.
①1 - REBAR SHEET NO.
①1 - F.F.L. - FINISHED FLOOR LEVEL
2. S.F.L. - STRUCTURAL FLOOR LEVEL
3. (R) - REVERSED RAIN.

NO.	DATE	REVISION	BY
01			
02			
03			
PROJECT : PROPOSED RESIDENTIAL DEVELOPMENT AT N.K.I.L. 6542
YIN PING ROAD
KOWLOON

TITLE : PART ELEVATION FOR CURTAIN WALL AT TOWER 1

DATE : 02-OCT-21
SCALE : 1:60 (A1)
DRAWN BY : LHR
CHECKED BY :
MIDI 美特鋁質有限公司
MIDI Aluminium Fabrication Ltd.
Unit 6-B, Sunny Industrial Centre, 1/F
102-488271-4, Fax: (852)27727866
Unit 6-B, Sunny Industrial Centre, 1/F
102-488271-4, Fax: (852)27727866
DWG NO. : JB53-SD-CW-4106 | REV. : A

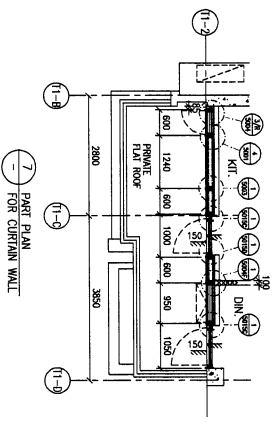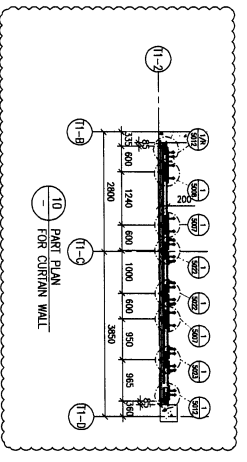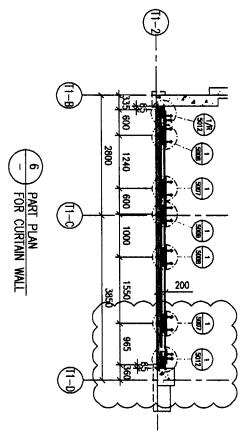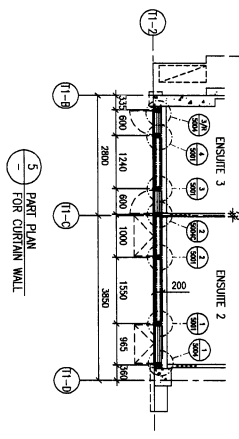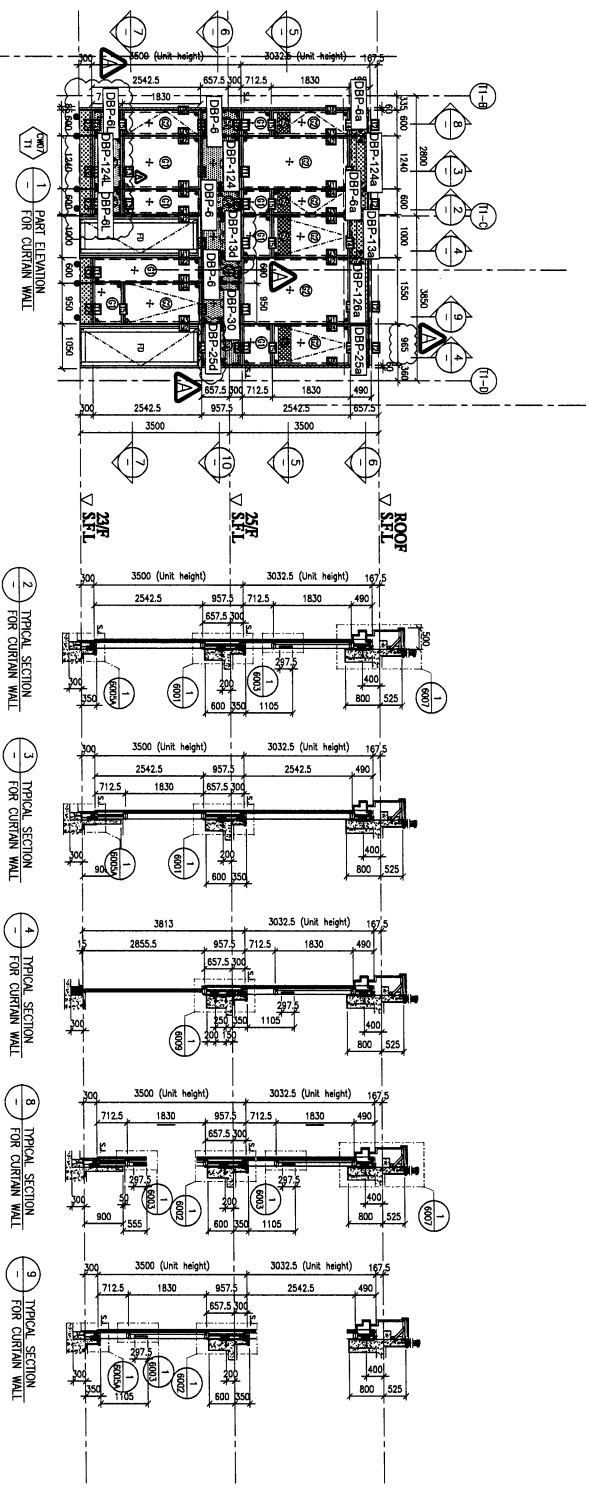

FLOOR LEVEL (S.F.L.)

FLOOR	LEVEl
ROOF	+210.00
29/F	+206.50
23/F	+203.00

LEGEND:

- ①1 - 10mm HEAT STRENGTHENED GLASS (OUTER) + 12mm AIR SPACE + 12mm THK. TEMPERED CLEAR GLASS (INNER)
- ①2 - 10mm HEAT STRENGTHENED GLASS (OUTER) + 12mm THK. HEAT STRENGTHENED CLEAR GLASS (INNER)
- ①3 - 12mm THK. HEAT STRENGTHENED GLASS & 2mm THK. ALUM. BACKWAX (SPANDREL GLASS) (INTERNAL PROTECTIVE BARRIER)
- ①4 - 3mm THK. ALUM. CLADDING
- S.L. - STACK JOINT (WIND LOAD)
- ①5 - ALUM. EXTENSION DUE NO.
- ▲ - SUPPORT POINT (WIND LOAD + DEAD LOAD)
- - SUPPORT POINT (WIND LOAD)