

工程指示 / 要求簡箋 ENGINEER INSTRUCTIONS(E.I.)

工程指示編號:	EI- 4893C	修改版本:	C
	HK-		
工程編號:	J 853	工程名稱:	大窩坪 (延坪道)
收件人:	Maggie Lor	發件人:	Lai Sik Hung
工程項目:	T5-T7 後裝窗邊碰幕牆位置 鐵件生產 (修訂C:先放行生產16/F以下樓層)	日期:	16/08/2022

<input type="checkbox"/> 原合約工程包	<input type="checkbox"/> 原合約工程加 / 減賬 QT-	<input type="checkbox"/> 新工程報價 QT-
---------------------------------	--	------------------------------------

信件批核號碼/圖紙參考編號:	批核模具圖紙編號:
客戶指示附件:	管理內部批簽署:

<input type="checkbox"/> 初步鋁料 B.M.	<input type="checkbox"/> 加工拆圖, 然後生產	<input type="checkbox"/> 尺寸表
<input type="checkbox"/> 正式鋁料 B.M.	<input type="checkbox"/> 技術上資料 / 指示	<input type="checkbox"/> 報價
<input type="checkbox"/> 配件 B.M.	<input type="checkbox"/> 樣辦或貨品說明書	<input type="checkbox"/> 分判合約
<input type="checkbox"/> 其他:		

內容: 修訂C: 先放行生產16/F以下樓層 修訂B: 先放行樣辦樓層 修訂A: 修改數量及派位圖 需驗焊100%目視 10%磁粉 驗焊報告名稱: Superstructure - Curtain Wall 需分座包裝
--

完成上列要求日期: 30/08/2022

國內

<input type="checkbox"/> 生產技術總監	<input type="checkbox"/> 連附件	<input type="checkbox"/> 技術部	<input type="checkbox"/> 連附件	<input type="checkbox"/> 生產部	<input type="checkbox"/> 連附件
<input type="checkbox"/> 採購部	<input type="checkbox"/> 連附件	<input type="checkbox"/> 生產統籌部	<input type="checkbox"/> 連附件	<input type="checkbox"/> 報關組	<input type="checkbox"/> 連附件
<input type="checkbox"/> 質檢部	<input type="checkbox"/> 連附件	<input type="checkbox"/> 會計部	<input type="checkbox"/> 連附件	<input type="checkbox"/> 機械設計部	<input type="checkbox"/> 連附件
<input type="checkbox"/> 香港辦	<input type="checkbox"/> 連附件	<input type="checkbox"/> 其他:			

<input type="checkbox"/> 行政部	<input type="checkbox"/> 連附件	<input type="checkbox"/> 會計部	<input type="checkbox"/> 連附件	<input type="checkbox"/> 統籌部	<input type="checkbox"/> 連附件	<input type="checkbox"/> 工程部	<input type="checkbox"/> 連附件
<input checked="" type="checkbox"/> 採購部	<input checked="" type="checkbox"/> 連附件	<input type="checkbox"/> QS部	<input type="checkbox"/> 連附件	<input type="checkbox"/> 地盤管理	<input type="checkbox"/> 連附件	<input type="checkbox"/> 維修部	<input type="checkbox"/> 連附件


*發件人簽署:		*組別成員批核簽署:	
傳遞編號:		項目經理簽署:	

16件以下先放行生產

美特鋁質有限公司 MIDI Aluminium Fabricator Ltd.		工程號:	J853	計算:	LHR	日期:	2022.07.14	送呈:				
		地盤名稱:	錦上路/延平道	核對:		日期:		副本:				
BM編號:		項目類別:	T5,T6,T7座后裝窗地盤用鐵件			修改:	A-20220720	總重量(kg):	17373.1			
序號	修改標示	配件圖號	物料編號	配件名稱	顏色	實用	後備	總數	單位	單件重量	總重量	修訂C放行數量
										KG		
1		J853-IW-ASS1-01	T5-GMS100-01	100*100*8通+100*65*6角組裝件	熱浸鋅	3	0	3	件	75.31	225.93	10件
2			T5-GMS100-02	100*100*8通+100*65*6角組裝件	熱浸鋅	5	0	5	件	79.66	398.30	3件
3			T5-GMS100-03	100*100*8通+100*65*6角組裝件	熱浸鋅	2	0	2	件	82.57	165.14	
4			T6-GMS100-01	100*100*8通+100*65*6角組裝件	熱浸鋅	38	0	38	件	75.31	2861.61	21件
5			T6-GMS100-02	100*100*8通+100*65*6角組裝件	熱浸鋅	11	0	11	件	79.66	876.29	5件
6			T6-GMS100-03	100*100*8通+100*65*6角組裝件	熱浸鋅	3	0	3	件	82.57	247.70	
7			T7-GMS100-01	100*100*8通+100*65*6角組裝件	熱浸鋅	13	0	13	件	75.31	978.97	8件
8			T7-GMS100-02	100*100*8通+100*65*6角組裝件	熱浸鋅	3	0	3	件	79.66	238.99	1件
9			T7-GMS100-03	100*100*8通+100*65*6角組裝件	熱浸鋅	1	0	1	件	82.57	82.57	
10		J853-IW-ASS1-02	T5-GMS100-04	100*100*8通+100*65*6角組裝件	熱浸鋅	17	0	17	件	75.31	1280.19	10件
11			T5-GMS100-05	100*100*8通+100*65*6角組裝件	熱浸鋅	3	0	3	件	79.66	238.99	3件
12			T5-GMS100-06	100*100*8通+100*65*6角組裝件	熱浸鋅	1	0	1	件	82.57	82.57	
13			T6-GMS100-04	100*100*8通+100*65*6角組裝件	熱浸鋅	10	0	10	件	75.31	753.06	5件
14			T6-GMS100-05	100*100*8通+100*65*6角組裝件	熱浸鋅	3	0	3	件	79.66	238.99	1件
15			T6-GMS100-06	100*100*8通+100*65*6角組裝件	熱浸鋅	1	0	1	件	82.57	82.57	
16			T7-GMS100-04	100*100*8通+100*65*6角組裝件	熱浸鋅	13	0	13	件	75.31	978.97	8件
17			T7-GMS100-05	100*100*8通+100*65*6角組裝件	熱浸鋅	2	0	2	件	79.66	159.33	1件
18			T7-GMS100-06	100*100*8通+100*65*6角組裝件	熱浸鋅	1	0	1	件	82.57	82.57	
19		J853-IW-ASS1-03	T5-GMS80-01	100*100*8通+100*10巴組裝件	熱浸鋅	23	0	23	件	37.39	859.97	10件
20			T5-GMS80-02	100*100*8通+100*10巴組裝件	熱浸鋅	5	0	5	件	39.37	196.85	3件
21			T5-GMS80-03	100*100*8通+100*10巴組裝件	熱浸鋅	2	0	2	件	40.69	81.38	
22			T6-GMS80-01	100*100*8通+100*10巴組裝件	熱浸鋅	38	0	38	件	37.39	1420.82	21件
23			T6-GMS80-02	100*100*8通+100*10巴組裝件	熱浸鋅	11	0	11	件	39.37	433.07	5件
24			T6-GMS80-03	100*100*8通+100*10巴組裝件	熱浸鋅	3	0	3	件	40.69	122.07	
25			T7-GMS80-01	100*100*8通+100*10巴組裝件	熱浸鋅	13	0	13	件	37.39	486.07	8件
26	A-增加數量		T7-GMS80-02	100*100*8通+100*10巴組裝件	熱浸鋅	5	0	5	件	39.37	196.85	1件
27			T7-GMS80-03	100*100*8通+100*10巴組裝件	熱浸鋅	1	0	1	件	40.69	40.69	
28		J853-IW-ASS1-04	T5-GMS80-04	100*100*8通+100*10巴組裝件	熱浸鋅	17	0	17	件	37.39	635.63	10件
29			T5-GMS80-05	100*100*8通+100*10巴組裝件	熱浸鋅	3	0	3	件	39.37	118.11	3件
31			T6-GMS80-04	100*100*8通+100*10巴組裝件	熱浸鋅	10	0	10	件	37.39	373.90	5件
32			T6-GMS80-05	100*100*8通+100*10巴組裝件	熱浸鋅	3	0	3	件	39.37	118.11	1件
33			T6-GMS80-06	100*100*8通+100*10巴組裝件	熱浸鋅	1	0	1	件	40.69	40.69	
34	A-減少數量		T7-GMS80-04	100*100*8通+100*10巴組裝件	熱浸鋅	13	0	13	件	37.39	486.07	8件
35	A-增加數量		T7-GMS80-05	100*100*8通+100*10巴組裝件	熱浸鋅	2	0	2	件	39.37	78.74	1件
36		T7-GMS80-06	100*100*8通+100*10巴組裝件	熱浸鋅	1	0	1	件	40.69	40.69		
37		J853-IW-ASS1-05	T5-GMS80-07	100*100*8通+100*10巴組裝件	熱浸鋅	1	0	1	件	38.71	38.71	
38		J853-IW-ASS1-06	T5-GMS80-08	100*100*8通+100*10巴組裝件	熱浸鋅	1	0	1	件	39.37	39.37	
39		J853-IW-ASS1-07	T5-GMS80-09	100*100*8通+100*10巴組裝件	熱浸鋅	1	0	1	件	38.05	38.05	
40	A-取消	J853-IW-ASS1-08	T7-GMS80-07	100*100*8通+100*10巴組裝件	熱浸鋅	0	0	0	件	36.73	0.00	
41	A-取消	J853-IW-ASS1-09	T7-GMS80-08	100*100*8通+100*10巴組裝件	熱浸鋅	0	0	0	件	38.05	0.00	
42		J853-CW-MS1-16	T5-GMS120-01	100*60*5通+60*110*60*5槽組裝件	熱浸鋅	1	0	1	件	47.53	47.53	
						總計		304	件		17373.13	

共152件

T5後裝窗-企鐵通派位圖

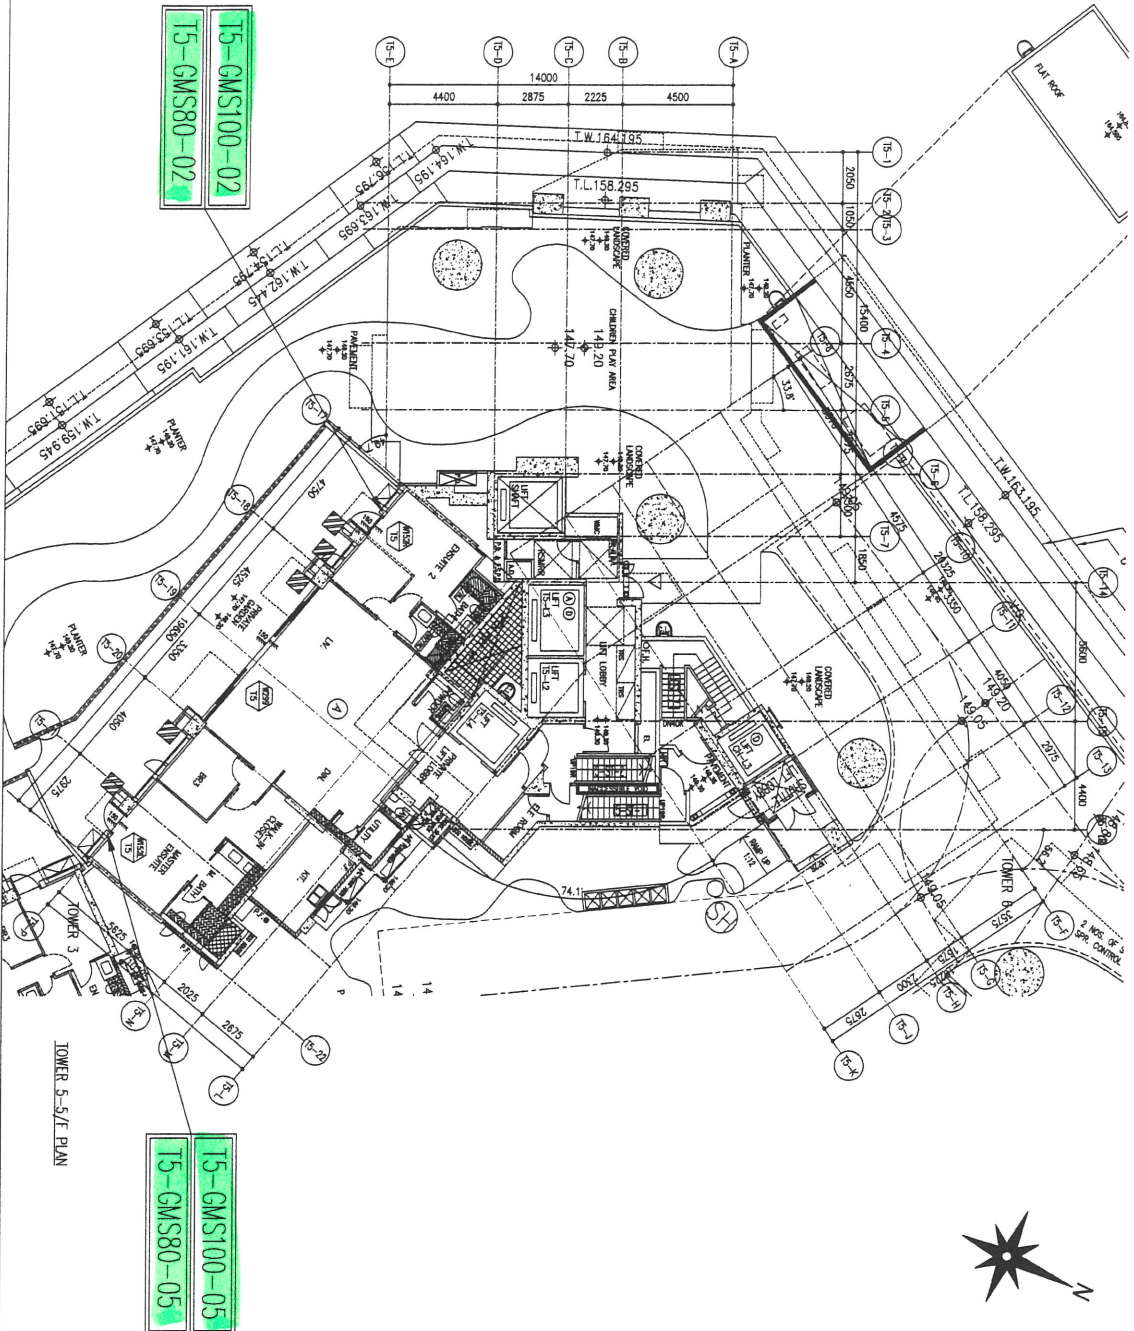

T5-GMS100-02
T5-GMS80-02

T5-GMS100-05
T5-GMS80-05

B.O. REF. :

CLIENT :

SHIMAO GROUP
HOLDINGS LIMITED

ARCHITECT :

HOPE YOUNG & PARTNERS LIMITED
HOPE YOUNG & PARTNERS LIMITED

MAIN CONTRACTOR :

協興建築有限公司
HPHING CONSTRUCTION CO LTD

STRUCTURAL ENGINEER :

C M WONG & ASSOCIATES LTD
黃志明建築工程師有限公司

FAÇADE CONSULTANT :

MEINHARDT

NOTE :

1. ALL DIMENSIONS ARE IN mm.
2. ALL ELEVATIONS ARE VIEWED FROM OUTSIDE.
3. ALL DIMENSIONS TO BE VERIFIED ON SITE BEFORE FABRICATION.

LEGEND :

1. F.F.L. --- FINISHED FLOOR LEVEL
2. S.F.L. --- STRUCTURAL FLOOR LEVEL
3. Ⓣ --- REVERSED DRINK

Ⓧ --- METAL MARK NO.
Ⓡ --- REFER SHEET NO.

DATE	16/12/2021	REVISION SUBJECT TO AMENDMENT	DATE
BY	29/1/2022	REVISION SUBJECT TO AMENDMENT	DATE
NO.	01	REVISION SUBJECT TO AMENDMENT	DATE
BY		REVISION	DATE

JOB NO. : J-853

PROJECT : PROPOSED RESIDENTIAL DEVELOPMENT KANLIL 6542 YAU PING ROAD KOWLOON

TITLE : 5/F LAYOUT PLAN FOR CURTAIN WALL AT TOWER 5

DATE : 29-MAR-21 SCALE : 1:80 (A1)


DRAWN BY : LHR CHECKED BY :

DATE : 29-MAR-21 SCALE : 1:80 (A1)

美特經貿有限公司
Mei Tak Economic & Trade Co., Ltd.
870 Cheung Kwan Road, Kowloon, H.K.
Tel: 23489711-4 Fax: (852) 27777865

PROJECT NO. : J853-SD-W-17051 REV. : B

T5後裝窗-企鐵通派位圖

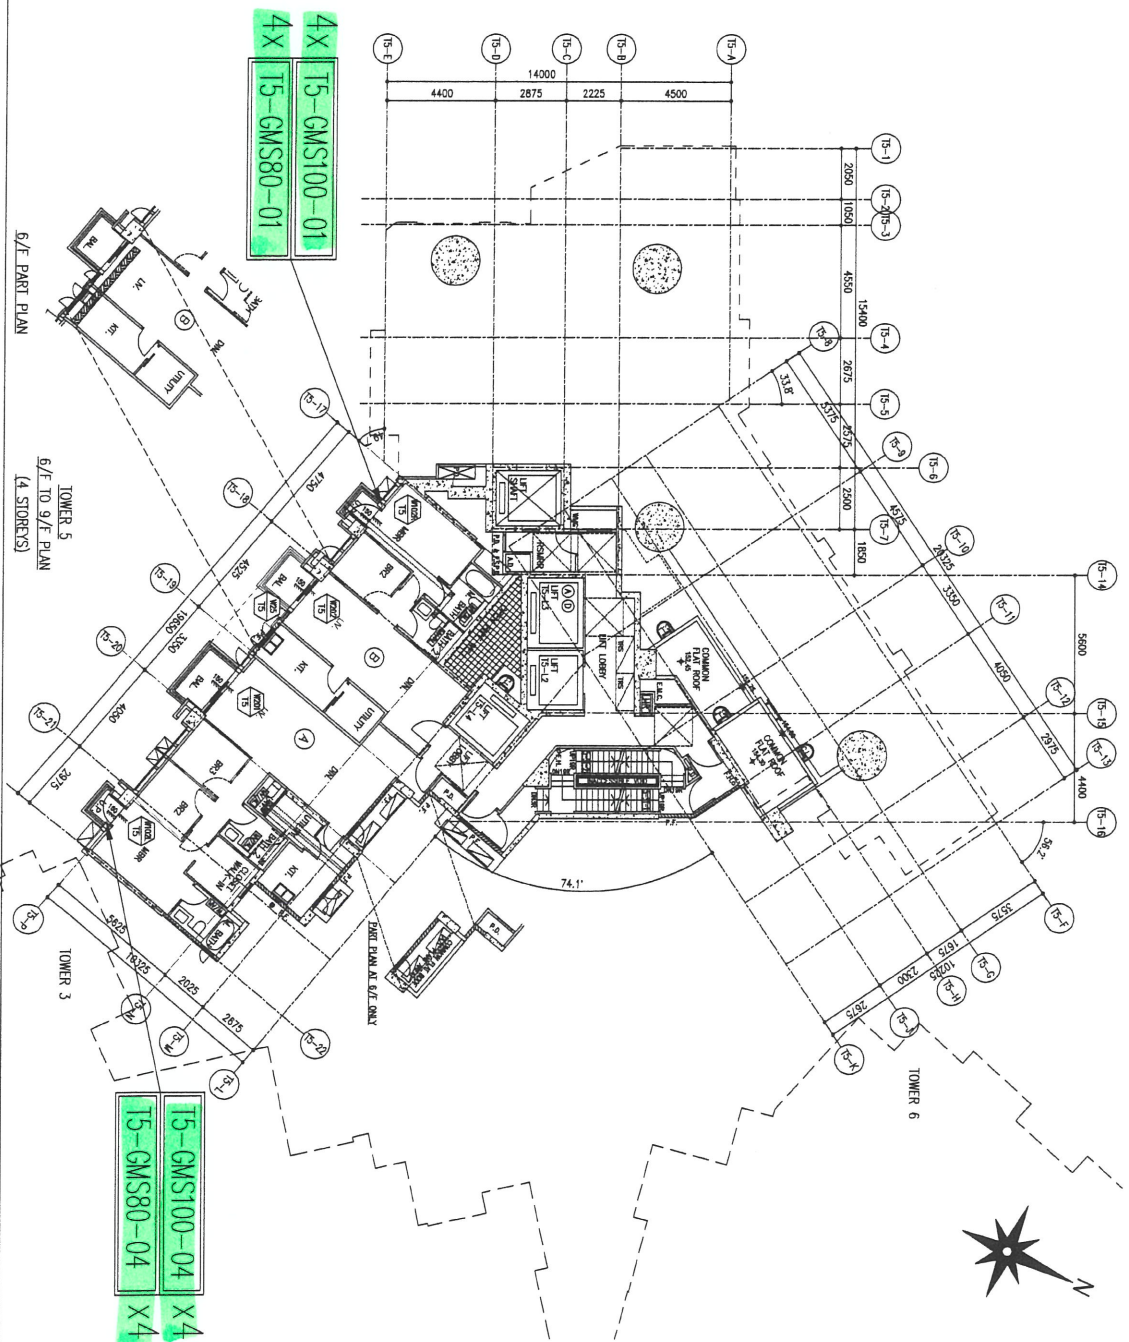

B.D. REF :

CLIENT :
SHIMAO GROUP HOLDINGS LIMITED

ARCHITECT :
WONG TUNG & PARTNERS LIMITED
WTF

MAIN CONTRACTOR :
協興建築有限公司
HIP HING CONSTRUCTION CO LTD

STRUCTURAL ENGINEER :
C M WONG & ASSOCIATES LTD
黃志輝建築工程師有限公司

FAÇADE CONSULTANT:
MEINHARDT

NOTE:
 1. ALL DIMENSIONS ARE IN mm.
 2. ALL DIMENSIONS ARE VERIFIED FROM OUTSIDE BEFORE FABRICATION.
 3. ALL DIMENSIONS TO BE VERIFIED ON SITE BEFORE FABRICATION.

LEGEND:
 (ST) METAL MARK NO.
 (S) REFER SHEET NO.
 1. F.F.L. -- FINISHED FLOOR LEVEL
 2. S.F.L. -- STRUCTURAL FLOOR LEVEL
 3. (R) -- REVERSED DRAWING


NO.	DATE	REVISION SUBJECT TO APPROVAL/COMMENT	BY
1	20/04/2021	REVISION SUBJECT TO APPROVAL/COMMENT	BY

JOB NO. : J-853
 PROJECT : PROPOSED RESIDENTIAL DEVELOPMENT 'MIDT1' KOWLOON KOWLOON

TITLE : 6/F TO 9/F LAYOUT PLAN FOR CURTAIN WALL AT TOWER 5

DATE : 29-MAR-21 SCALE : 1:80 (A1)
 DRAWN BY : LHR CHECKED BY :
美特經貿有限公司
 10th/F, 83, SLOAN ROAD, KOWLOON, HONG KONG
 810 Des Voeux Road, Kowloon, HK
 Tel: 23488711-4 Fax: (852) 27277855
 REG. NO. : 4553-50-W-L7052 | REG. : A

T5後裝窗-企鐵通派位圖

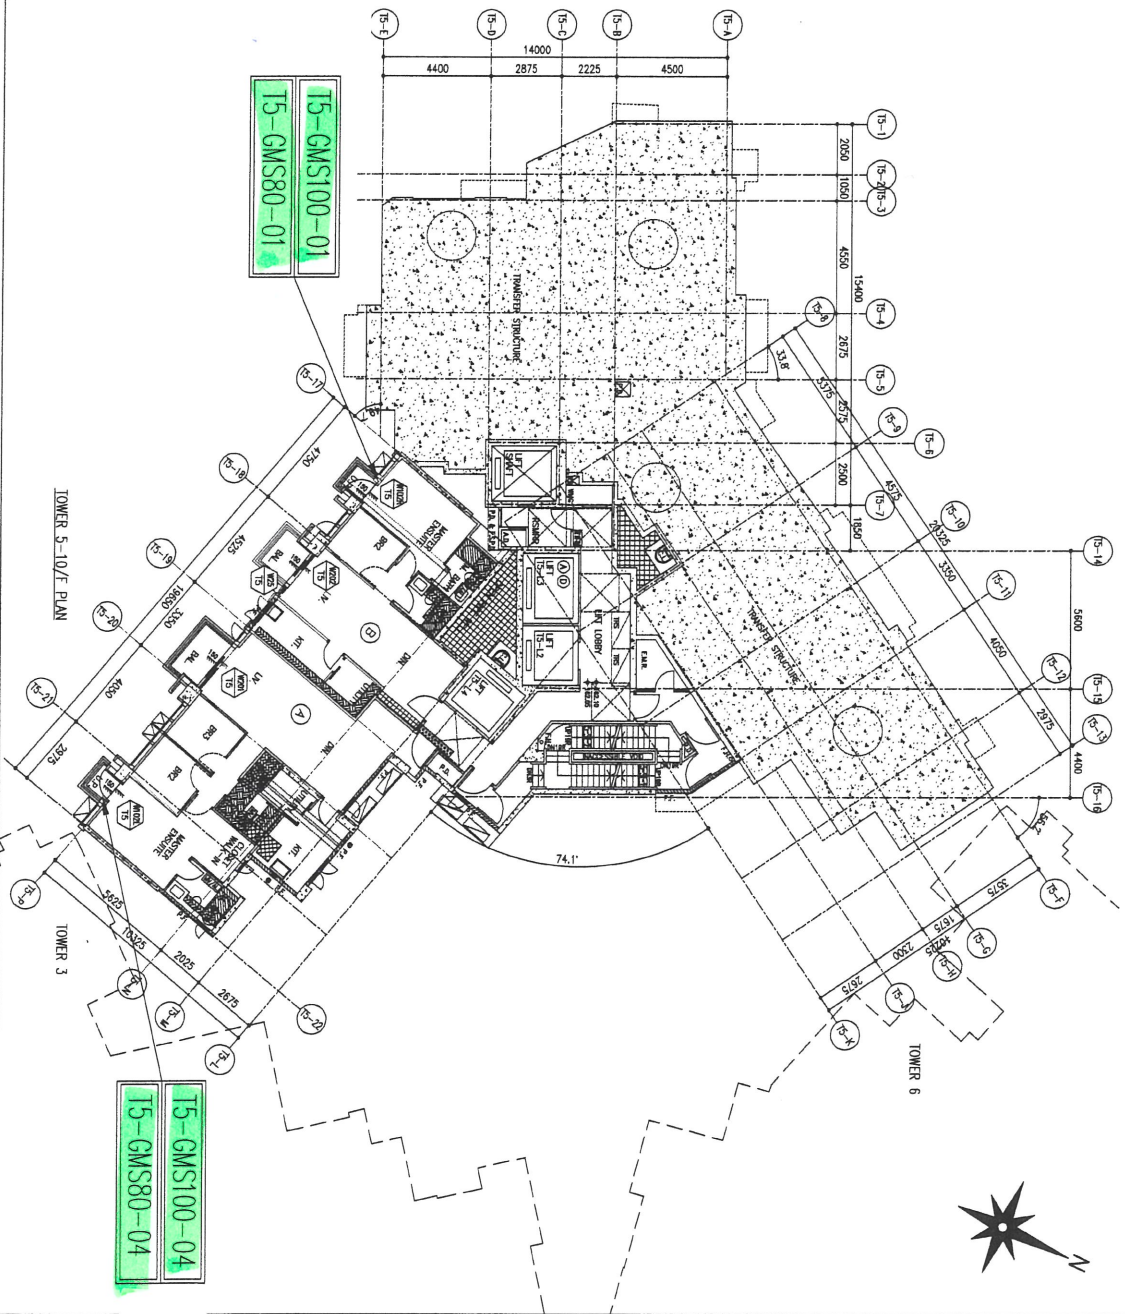

B.D. REF :

CLIENT :
SHIMAO GROUP HOLDINGS LIMITED

ARCHITECT :
WTF
 WONG TUNG & PARTNERS LIMITED
 ARCHITECTS & PLANNERS

MAIN CONTRACTOR :
怡興建築有限公司
 HEP HING CONSTRUCTION CO. LTD.

STRUCTURAL ENGINEER :
GMA
 C.M. WONG & ASSOCIATES LTD.
 黃志華建築工程師有限公司

FAÇADE CONSULTANT:
MEINHARDT

NOTE :
 1. DIMENSIONS ARE IN MM.
 2. ALL EXTENSIONS ARE VIEWED FROM OUTSIDE.
 3. ALL DIMENSIONS TO BE VERIFIED ON SITE BEFORE FABRICATION.

LEGEND :
 (X) DETAIL MARK NO.
 (S) REFER SHEET NO.
 1. F.F.L. --- FINISHED FLOOR LEVEL
 2. S.F.L. --- STRUCTURAL FLOOR LEVEL
 3. (R) --- REVERSED DETAIL

TITLE :
 10/F LAYOUT PLAN FOR CLUT WALL AT TOWER 5

DATE : 29-MAR-21 SCALE : 1:80 (A1)


DRAWN BY : UHR CHECKED BY :

JOB NO. : J-853

PROJECT : PROPOSED RESIDENTIAL DEVELOPMENT AT N.K.L.L. 6542 YIN PING ROAD KOWLOON

美特堅有限公司
 MIDJ ASSURANCE MANAGEMENT LTD.
 Unit 6-8, Sunny Industrial Centre, 1/F
 1423489111 1/F Tel: (852) 2727956
 DMC NO. : 0853-50-1W-L7083 REV. : A


T5後裝窗-企鐵通派位圖

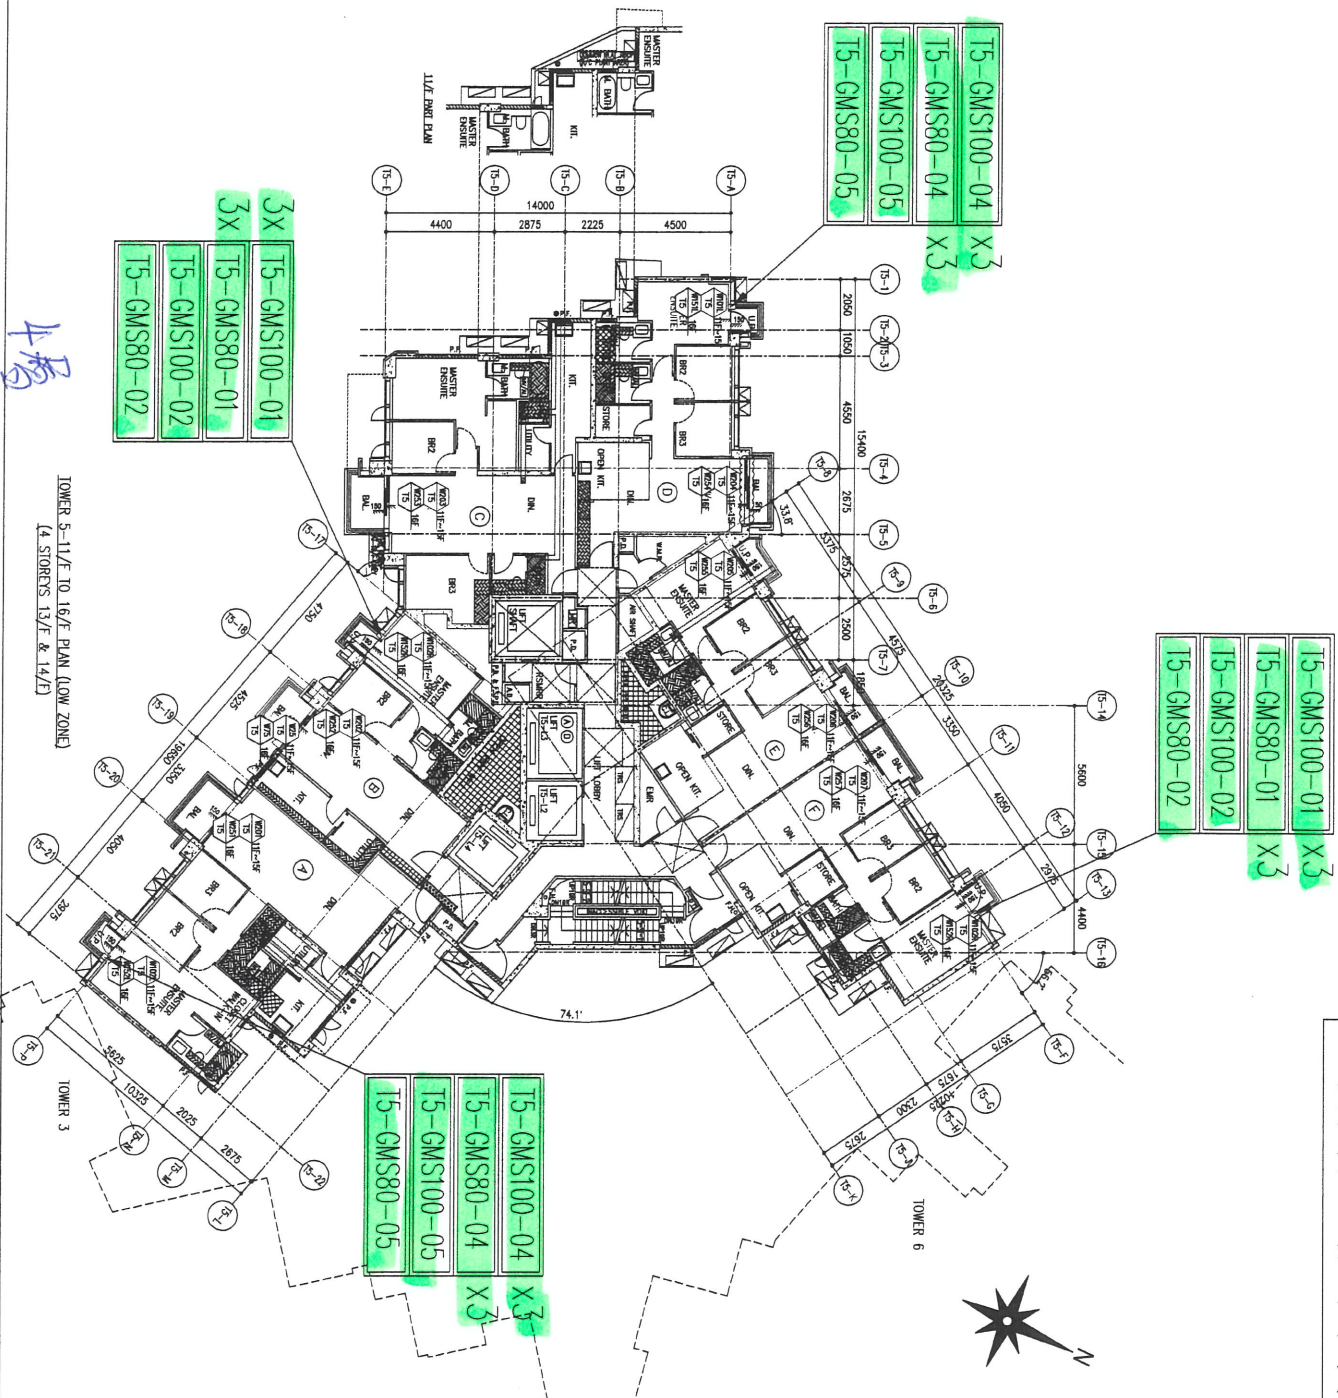

B.D. REF : CLIENT : SHIMAO GROUP HOLDINGS LIMITED	
MAIN CONTRACTOR : 協興建築有限公司 HING HING CONSTRUCTION CO. LTD.	
ARCHITECT : WONG TUNG & PARTNERS LIMITED WTF	
STRUCTURAL ENGINEER : C M WONG & ASSOCIATES LTD 黃志剛建築工程師有限公司	
FACADE CONSULTANT : MEINHARDT	
NOTE : 1. ALL DIMENSIONS ARE IN MM. 2. ALL ELEVATIONS ARE VIEWED FROM OUTSIDE. 3. ALL DIMENSIONS TO BE VERIFIED ON SITE BEFORE FABRICATION.	
LEGEND : 1. F.F.L. -- FINISHED FLOOR LEVEL 2. S.F.L. -- STRUCTURAL FLOOR LEVEL 3. Ⓣ -- REVERSED DETAIL (X) -- VEAL MARK NO. (X2) -- REFER SHEET NO.	
JOB NO. : J-853	DATE : 29-MAR-21
PROJECT : PROPOSED RESIDENTIAL DEVELOPMENT AT KUN LIL 6542 THE KUN LO ROAD KOWLOON	DRAWN BY : LHR CHECKED BY : DATE : 29-MAR-21
TITLE : 11/F TO 16/F LAYOUT PLAN AT TOWER 5	SCALE : 1:80 (A1)
DRAWING NO. : 453-5D-W-LP054 REV. : B	

黃志剛建築工程師有限公司
 WONG TUNG & PARTNERS LIMITED
 810 She Wan Road, Hong Kong, 1/F
 Tel: (852) 27771865
 Fax: (852) 27771865

T6,7後裝窗-企鐵通派位圖

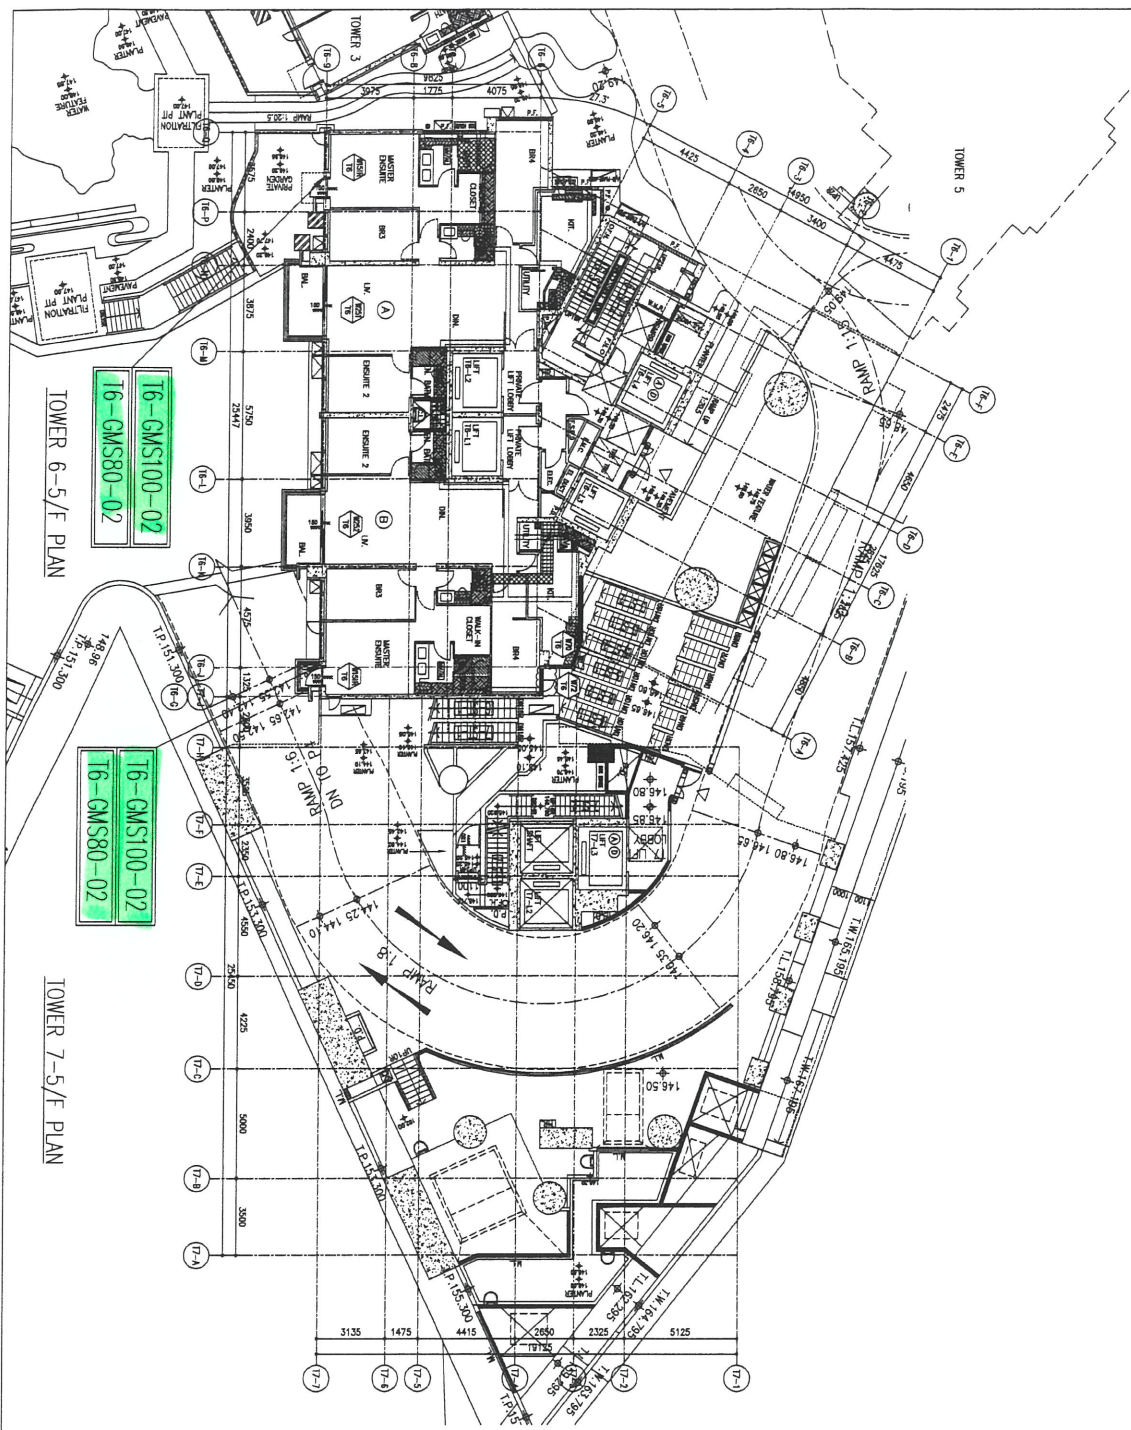

BD. REF :

CLIENT :


SHIMAO GROUP HOLDINGS LIMITED

ARCHITECT :



WONG TUNG & PARTNERS LIMITED

MAIN CONTRACTOR :

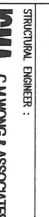


HP HING CONSTRUCTION CO LTD

STRUCTURAL ENGINEER :



C M WONG & ASSOCIATES LTD

FAÇADE CONSULTANT :

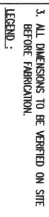

MENHARDT

NOTE :

1. ALL DIMENSIONS ARE IN mm.
2. ALL DIMENSIONS ARE VIEWED FROM OUTSIDE.
3. ALL DIMENSIONS TO BE VERIFIED ON SITE BEFORE FABRICATION.

LEGEND :

- (ST) - DETAIL MARK NO.
- (W) - REFER SHEET NO.

1. F.F.L. - FINISHED FLOOR LEVEL
2. S.F.L. - STRUCTURAL FLOOR LEVEL
3. (R) - REVERSED DETAIL

JOB NO. : J-8533

PROJECT : PROPOSED RESIDENTIAL DEVELOPMENT AT K.K.L. 6342 THE KOWLOON

TITLE : 5/F LAYOUT PLAN FOR CURTAIN WALL AT TOWER 6 & 7

DATE : 14-09-21 SCALE : 1:80 (A1)

DRAWN BY : UHR CHECKED BY :



美特經貿有限公司
MTR DEVELOPMENT INTERNATIONAL
610 Cheong Cheong Street, 1/F
Tel: 2468211-4 Fax: 65272715

JOB NO. : 0553-SP-W-19061 REV. : B

T6,7後裝窗-企鐵通派位圖



T6-GMS100-01
T6-GMS80-01

TOWER 6-6/F PLAN

T6-GMS100-01
T6-GMS80-01

TOWER 7-6/F PLAN

E.O. REF :

CLIENT :

SHIMAO GROUP
HOLDINGS LIMITED

ARCHITECT :



WONG TUNG & PARTNERS LIMITED

MAIN CONTRACTOR :



德興建築有限公司
SHIP HING CONSTRUCTION CO LTD

STRUCTURAL ENGINEER :



C M WONG & ASSOCIATES LTD
黃志輝建築工程師有限公司

FRAME CONSULTANT :



MENHARDT

NOTE :

1. ALL DIMENSIONS ARE IN mm.
 2. ALL ELEVATIONS ARE VIEWED FROM OUTSIDE.
 3. ALL DIMENSIONS TO BE VERIFIED ON SITE BEFORE FABRICATION.
- LEGEND :
- (S) - SEAL MARK NO.
 - (D) - REFER SHEET NO.
 - 1. F.F.L. - FINISHED FLOOR LEVEL
 - 2. S.F.L. - STRUCTURAL FLOOR LEVEL
 - 3. (R) - REVERSED DETAIL

NO.	DATE	REVISION SUBJECT TO MODIFICATION	BY
1	16/12/2021	REVISION SUBJECT TO MODIFICATION	UHR
2	20/01/2021	REVISION SUBJECT TO MODIFICATION	UHR
3		REVISION	UHR

JOB NO. : J-853

PROJECT : PROPOSED RESIDENTIAL
DEVELOPMENT AT N.K.I.L. 6542
YIN PING ROAD
KOWLOON

TITLE : 6/F LAYOUT PLAN
FOR CURTAIN WALL
AT TOWER 6 & 7

DATE : 14-APR-21 SCALE : 1:80 (A1)

DRAWN BY : UHR CHECKED BY :



美特堅有限公司
MTDI MTR DEVELOPMENT INTERNATIONAL LTD.
One E-B, Sunny Industrial Centre, 1/F
142-148B211-4 Road, Kowloon
TWS NO. : 0853-SI-W-LP062 REV. : 8

T6,7後裝窗-企鐵通派位圖



T6-GMS100-01 X2
T6-GMS80-01 X2

TOWER 6-7/F TO 8/F PLAN

T6-GMS100-01 X2
T6-GMS80-01 X2

TOWER 7-7/F TO 8/F PLAN

T7-GMS100-01 X2
T7-GMS80-01 X2

T7-GMS100-04 X2
T7-GMS80-04 X2

BLD. REF. :

CLIENT :

SHIMAO GROUP HOLDINGS LIMITED

ARCHITECT :

YONG TUNG & PARTNERS LIMITED

MAIN CONTRACTOR :

怡興建築有限公司
HP HING CONSTRUCTION CO LTD

STRUCTURAL ENGINEER :

C M WONG & ASSOCIATES LTD
黃志明建築工程師有限公司

FAÇADE CONSULTANT :

MEINHARDT

NOTE :

1. ALL DIMENSIONS ARE IN mm.
2. ALL ELEVATIONS ARE VIEWED FROM OUTSIDE.
3. ALL DIMENSIONS TO BE VERIFIED ON SITE BEFORE FABRICATION.

LEGEND :

- (X) DETAIL MARK NO.
- (X2) REFER SHEET NO.
- 1. F.F.L. --- FINISHED FLOOR LEVEL
- 2. S.F.L. --- STRUCTURAL FLOOR LEVEL
- 3. (R) --- REINFORCED DETAIL

JOB NO. : J-853

PROJECT : PROPOSED RESIDENTIAL DEVELOPMENT IN VILL. 6542 YIN PING ROAD KOWLOON

TITLE : 7/F TO 8/F LAYOUT PLAN AT TOWER 6 & 7

DATE : 14-APR-21 SCALE : 1:80 (A1)
DRAWN BY : LHR CHECKED BY :

YONG TUNG & PARTNERS LIMITED
510 Cheong Cheong Street, 17/F
Kowloon, Hong Kong
Tel: (852) 27721865
Fax: (852) 27721865

PROJECT NO. : J653-SD-W-17063 REV. : B

T6,7後裝窗-企職通派位圖



- 16-GMS100-04 ✓ X10.5
- 16-GMS80-04 ✓ X10.5
- 16-GMS100-05 ✓
- 16-GMS80-05 ✓
- 16-GMS100-06
- 16-GMS80-06
- 16-GMS80-08

- 16-GMS100-01 ✓ X10.5
- 16-GMS80-01 ✓ X10.5
- 16-GMS100-02 ✓
- 16-GMS80-02 ✓
- 16-GMS100-03
- 16-GMS80-03

- 16-GMS100-01 ✓ X10.5
- 16-GMS80-01 ✓ X10.5
- 16-GMS100-02 ✓
- 16-GMS80-02 ✓
- 16-GMS100-03
- 16-GMS80-03

TOWER 6-10/F TO 23/F PLAN
(12 STORES) (13/F & 14/F OMITTED)

- 16-GMS100-01 ✓ X10.5
- 16-GMS80-01 ✓ X10.5
- 16-GMS100-02 ✓
- 16-GMS80-02 ✓
- 16-GMS100-03
- 16-GMS80-03

TOWER 7-10/F TO 23/F PLAN
(12 STORES) (13/F & 14/F OMITTED)

- 17-GMS100-04 ✓ X10.5
- 17-GMS80-04 ✓ X10.5
- 17-GMS100-05 ✓
- 17-GMS80-05 ✓
- 17-GMS100-06
- 17-GMS80-06
- 17-GMS80-05

B.O. REF.:

CLIENT : SHIMAO GROUP HOLDINGS LIMITED

ARCHITECT : WONG TUNG & PARTNERS LIMITED

MAIN CONTRACTOR : 協興建築有限公司
HIP HING CONSTRUCTION CO LTD

STRUCTURAL ENGINEER : C M WONG & ASSOCIATES LTD
黃志利建築工程師有限公司

FAÇADE CONSULTANT : MENHARDT

NOTE:
1. ALL DIMENSIONS ARE IN mm.
2. ALL DIMENSIONS ARE VIEWED FROM OUTSIDE BEFORE FINISHING.
3. ALL DIMENSIONS TO BE VIEWED ON SITE BEFORE FINISHING.

LEGEND:
1. F.F.L. --- FINISHED FLOOR LEVEL
2. S.F.L. --- STRUCTURAL FLOOR LEVEL
3. --- REVERSED DIMEN.

REBAR MARK NO. (S)
REBAR SHEET NO. (X)

NO.	DATE	REVISION SUBJECT TO MODIFICATION	REVISED	REVISION
1	16/12/2021	REVISION SUBJECT TO MODIFICATION		
2	29/01/2022	REVISION SUBJECT TO MODIFICATION		

JOB NO. : J-853
PROJECT : PROPOSED RESIDENTIAL DEVELOPMENT AT N.K.H.L. 6542 THE KOWLOON KOWLOON

TITLE : 10/F TO 23/F LAYOUT PLAN FOR CURTAIN WALL AT TOWER 6 & 7
DATE : 14-APR-21 SCALE : 1:80 (A1)
DRAWN BY : LHR CHECKED BY :
MIDI 美特經貿有限公司
MIDI INTERNATIONAL MANAGEMENT LTD.
R10 Cheung Kowloon Centre, 1/F
Tel: 2389211-4 Fax: (852) 27277865

DMG NO. : 853-SD-W-L-7065 REV. : B