

工程指示 / 要求簡箋 ENGINEER INSTRUCTIONS(E.I.)

工程指示編號:	EI- 5165A	修改版本:	A
工程編號:	J 853	工程名稱:	大窩坪 (延坪道)
收件人:	Maggie Lor	發件人:	Lai Sik Hung
工程項目:	T2-T7 旭格趟門邊碰幕牆位置 鐵件生產 (修訂A: 按地盤要求將沒有陽臺位置的鐵料加長)	日期:	08/11/2022

<input type="checkbox"/> 原合約工程包	<input type="checkbox"/> 原合約工程加 / 減賬 QT-	<input type="checkbox"/> 新工程報價 QT-
---------------------------------	--	------------------------------------

信件批核號碼/圖紙參考編號:	批核模具圖紙編號:
客戶指示附件:	管理內部批簽署:

<input type="checkbox"/> 初步鋁料 B.M.	<input type="checkbox"/> 加工拆圖, 然後生產	<input type="checkbox"/> 尺寸表
<input type="checkbox"/> 正式鋁料 B.M.	<input type="checkbox"/> 技術上資料/指示	<input type="checkbox"/> 報價
<input type="checkbox"/> 配件 B.M.	<input type="checkbox"/> 樣辦或貨品說明書	<input type="checkbox"/> 分判合約
<input type="checkbox"/> 其他:		

內容: 修訂A: 按地盤要求將沒有陽臺位置的鐵料加長
T2-T7 旭格趟門邊碰幕牆位置 鐵件生產 請先生產16/F以下鐵件, 16/F以上待另行通知 需驗焊 100%目視 10%磁粉, 驗焊報告名稱: Superstructure - Curtain Wall 送地盤時需分座包裝
完成上列要求日期: 18/11/2022

國內

<input type="checkbox"/> 生產技術總監	<input type="checkbox"/> 連附件	<input type="checkbox"/> 技術部	<input type="checkbox"/> 連附件	<input type="checkbox"/> 生產部	<input type="checkbox"/> 連附件
<input type="checkbox"/> 採購部	<input type="checkbox"/> 連附件	<input type="checkbox"/> 生產統籌部	<input type="checkbox"/> 連附件	<input type="checkbox"/> 報關組	<input type="checkbox"/> 連附件
<input type="checkbox"/> 質檢部	<input type="checkbox"/> 連附件	<input type="checkbox"/> 會計部	<input type="checkbox"/> 連附件	<input type="checkbox"/> 機械設計部	<input type="checkbox"/> 連附件
<input type="checkbox"/> 香港辦	<input type="checkbox"/> 連附件	<input type="checkbox"/> 其他:			

<input type="checkbox"/> 行政部	<input type="checkbox"/> 連附件	<input type="checkbox"/> 會計部	<input type="checkbox"/> 連附件	<input type="checkbox"/> 統籌部	<input type="checkbox"/> 連附件	<input type="checkbox"/> 工程部	<input type="checkbox"/> 連附件
<input checked="" type="checkbox"/> 採購部	<input checked="" type="checkbox"/> 連附件	<input type="checkbox"/> QS部	<input type="checkbox"/> 連附件	<input type="checkbox"/> 地盤管理	<input type="checkbox"/> 連附件	<input type="checkbox"/> 維修部	<input type="checkbox"/> 連附件

*發件人簽署:		*組別成員批核簽署:	
傳遞編號:		項目經理簽署:	

圖則登記表 DRAWING REGISTER									
工程名稱 Project Title:		九龍延坪道 幕牆T2, T3, T5, T7-地盤用鐵件拆圖		接收日期 Receiving Date (適用於客戶圖則)					
工程編號 Project No:		J-853		發出日期 Issued Date					
分發予 Distributed To				年					
				月					
				日					
				年					
				月					
				日					
圖則編號 Drg. No.		圖則名稱 Drawing Title		修訂編號 Revision No.					
CW-DR-TJ01T		門邊固定頂部套心		1					
CW-DR-TJ01T(1)		門邊固定頂部套心		2					
CW-DR-TJ01L		門邊固定鐵件		3					
CW-DR-TJ01L(1)		門邊固定鐵件		4					
CW-DR-TJ01R		門邊固定鐵件		5					
CW-DR-TJ01R(1)		門邊固定鐵件		6					
J853-SD-CW-4204A		位置圖		7					
J853-SD-CW-4205		位置圖		8					
J853-SD-CW-4304A		位置圖		9					
J853-SD-CW-4305		位置圖		10					
J853-SD-CW-4503		位置圖		11					
J853-SD-CW-4505		位置圖		12					
J853-SD-CW-4603		位置圖		13					
J853-SD-CW-4604		位置圖		14					


美特鋁質有限公司 MIDI Aluminium Fabricator Ltd.		工程號：J-853	計算：黃瓊玉	日期：2022.9.29	送呈：胡哥
地盤名稱：延坪道		項目類別：地盤用門邊鐵件 (T2, T3, T5, T7)	核對：謝永林	日期：2022.9.30	副本：
地盤用鐵件B.M.表		A/C Code：2022.10.24(A版) (依據收地盤烟哥微信要求)	批准：	日期：	總重量：4524.53 KG
此BM依據拆圖資料計算					

序號	修改標示	鐵件邊號	物料編號	配件名稱	顏色	實用	後備	總數	單位	單件重量	總重量		備注
											KG	KG	
1			CW-DR-TJ01T	80x40x5鐵通	熱浸鋅	28	0	28	件	0.84	23.52		地盤用
2			CW-DR-TJ01T	80x40x5鐵通	熱浸鋅	16	0	16	件	0.84	13.44		地盤用
3			CW-DR-TJ01T	80x40x5鐵通	熱浸鋅	8	0	8	件	0.84	6.72		地盤用
4			CW-DR-TJ01T	80x40x5鐵通	熱浸鋅	2	0	2	件	0.84	1.68		地盤用
5			CW-DR-TJ01T	80x40x5鐵通	熱浸鋅	2	0	2	件	0.84	1.68		地盤用
6			CW-DR-TJ01T	80x40x5鐵通	熱浸鋅	28	0	28	件	0.84	23.52		地盤用
7			CW-DR-TJ01T	80x40x5鐵通	熱浸鋅	16	0	16	件	0.84	13.44		地盤用
8			CW-DR-TJ01T	80x40x5鐵通	熱浸鋅	8	0	8	件	0.84	6.72		地盤用
9			CW-DR-TJ01T	80x40x5鐵通	熱浸鋅	2	0	2	件	0.84	1.68		地盤用
10			CW-DR-TJ01T	80x40x5鐵通	熱浸鋅	2	0	2	件	0.84	1.68		地盤用
11			CW-DR-TJ01T	80x40x5鐵通	熱浸鋅	8	0	8	件	0.84	6.72		地盤用
12			CW-DR-TJ01T	80x40x5鐵通	熱浸鋅	3	0	3	件	0.84	2.52		地盤用
13			CW-DR-TJ01T	80x40x5鐵通	熱浸鋅	1	0	1	件	0.84	0.84		地盤用
14			CW-DR-TJ01T	80x40x5鐵通	熱浸鋅	1	0	1	件	0.84	0.84		地盤用
15			CW-DR-TJ01T	80x40x5鐵通	熱浸鋅	13	0	13	件	0.84	10.92		地盤用
16			CW-DR-TJ01T	80x40x5鐵通	熱浸鋅	13	0	13	件	0.84	10.92		地盤用
17			CW-DR-TJ01T	80x40x5鐵通	熱浸鋅	3	0	3	件	0.84	2.52		地盤用
18			CW-DR-TJ01T	80x40x5鐵通	熱浸鋅	1	0	1	件	0.84	0.84		地盤用
19			CW-DR-TJ01T	80x40x5鐵通	熱浸鋅	1	0	1	件	0.84	0.84		地盤用
20			CW-DR-TJ01T	80x40x5鐵通	熱浸鋅	1	0	1	件	0.84	0.84		地盤用
21			CW-DR-TJ01L	100x50x4鐵通/40x17x4鐵槽	熱浸鋅	14	0	14	件	27.51	385.09		地盤用
22			CW-DR-TJ01L	100x50x4鐵通/40x17x4鐵槽	熱浸鋅	8	0	8	件	27.51	220.05		地盤用
23	A:減數		CW-DR-TJ01aL	100x50x4鐵通/40x17x4鐵槽	熱浸鋅	3	0	3	件	29.11	87.32		地盤用
24			CW-DR-TJ01aL	100x50x4鐵通/40x17x4鐵槽	熱浸鋅	1	0	1	件	29.11	29.11		地盤用
25			CW-DR-TJ01bL	100x50x4鐵通/40x17x4鐵槽	熱浸鋅	1	0	1	件	30.17	30.17		地盤用
25a	A:新增		CW-DR-TJ01cL	100x50x4鐵通/40x17x4鐵槽	熱浸鋅	1	0	1	件	33.23	33.23		地盤用
26			CW-DR-TJ01L	100x50x4鐵通/40x17x4鐵槽	熱浸鋅	14	0	14	件	27.51	385.09		地盤用

美特鋁質有限公司 MIDI Aluminium Fabricator Ltd.		工程號：J-853	計算：黃瓊玉	日期：2022.9.29	送呈：胡哥
地盤名稱：延坪道		項目類別：地盤用門邊鐵件 (T2, T3, T5, T7)	核對：謝永林	日期：2022.9.30	副本：
地盤用鐵件B.M.表		批准：	日期：	日期：	總重量：4524.53 KG
A/C Code : 2022.10.24(A版) (依據收地盤炳哥微信要求)					
此BM依據拆圖資料計算					

序號	修改標示	鐵件邊號	物料編號	配件名稱	顏色	實用	後備	總數	單位	單件重量	總重量		備注
											KG	KG	
27			CW-DR-TJ01L	100x50x4鐵通/40x17x4鐵槽	熱浸鋅	8	0	8	件	27.51	220.05		地盤用
28	A:減數		CW-DR-TJ01aL	100x50x4鐵通/40x17x4鐵槽	熱浸鋅	3	0	3	件	29.11	87.32		地盤用
29			CW-DR-TJ01aL	100x50x4鐵通/40x17x4鐵槽	熱浸鋅	1	0	1	件	29.11	29.11		地盤用
30			CW-DR-TJ01bL	100x50x4鐵通/40x17x4鐵槽	熱浸鋅	1	0	1	件	30.17	30.17		地盤用
30a	A:新增		CW-DR-TJ01cL	100x50x4鐵通/40x17x4鐵槽	熱浸鋅	1	0	1	件	33.23	33.23		地盤用
31			CW-DR-TJ01L	100x50x4鐵通/40x17x4鐵槽	熱浸鋅	3	0	3	件	27.51	82.52		地盤用
32			CW-DR-TJ01aL	100x50x4鐵通/40x17x4鐵槽	熱浸鋅	1	0	1	件	29.11	29.11		地盤用
33			CW-DR-TJ01L	100x50x4鐵通/40x17x4鐵槽	熱浸鋅	13	0	13	件	27.51	357.59		地盤用
34			CW-DR-TJ01L	100x50x4鐵通/40x17x4鐵槽	熱浸鋅	13	0	13	件	27.51	357.59		地盤用
35			CW-DR-TJ01aL	100x50x4鐵通/40x17x4鐵槽	熱浸鋅	3	0	3	件	29.11	87.32		地盤用
36			CW-DR-TJ01aL	100x50x4鐵通/40x17x4鐵槽	熱浸鋅	1	0	1	件	29.11	29.11		地盤用
37			CW-DR-TJ01bL	100x50x4鐵通/40x17x4鐵槽	熱浸鋅	1	0	1	件	30.17	30.17		地盤用
38			CW-DR-TJ01bL	100x50x4鐵通/40x17x4鐵槽	熱浸鋅	1	0	1	件	30.17	30.17		地盤用
39			CW-DR-TJ01R	100x50x4鐵通/40x17x4鐵槽	熱浸鋅	14	0	14	件	27.51	385.09		地盤用
40			CW-DR-TJ01R	100x50x4鐵通/40x17x4鐵槽	熱浸鋅	8	0	8	件	27.51	220.05		地盤用
41	A:減數		CW-DR-TJ01aR	100x50x4鐵通/40x17x4鐵槽	熱浸鋅	3	0	3	件	29.11	87.32		地盤用
42			CW-DR-TJ01aR	100x50x4鐵通/40x17x4鐵槽	熱浸鋅	1	0	1	件	29.11	29.11		地盤用
43			CW-DR-TJ01bR	100x50x4鐵通/40x17x4鐵槽	熱浸鋅	1	0	1	件	30.17	30.17		地盤用
43a	A:新增		CW-DR-TJ01cR	100x50x4鐵通/40x17x4鐵槽	熱浸鋅	1	0	1	件	33.23	33.23		地盤用
44			CW-DR-TJ01R	100x50x4鐵通/40x17x4鐵槽	熱浸鋅	14	0	14	件	27.51	385.09		地盤用
45			CW-DR-TJ01R	100x50x4鐵通/40x17x4鐵槽	熱浸鋅	8	0	8	件	27.51	220.05		地盤用
46	A:減數		CW-DR-TJ01aR	100x50x4鐵通/40x17x4鐵槽	熱浸鋅	3	0	3	件	29.11	87.32		地盤用
47			CW-DR-TJ01aR	100x50x4鐵通/40x17x4鐵槽	熱浸鋅	1	0	1	件	29.11	29.11		地盤用
48			CW-DR-TJ01bR	100x50x4鐵通/40x17x4鐵槽	熱浸鋅	1	0	1	件	30.17	30.17		地盤用
48a	A:新增		CW-DR-TJ01cR	100x50x4鐵通/40x17x4鐵槽	熱浸鋅	1	0	1	件	33.23	33.23		地盤用
49			CW-DR-TJ01R	100x50x4鐵通/40x17x4鐵槽	熱浸鋅	8	0	8	件	27.51	220.05		地盤用
50			CW-DR-TJ01aR	100x50x4鐵通/40x17x4鐵槽	熱浸鋅	1	0	1	件	29.11	29.11		地盤用
51							總計	314	件	總重量	4524.53		

EG-DWG3

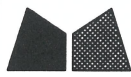

美特鋁質 有限公司
MIDI Aluminium Fabricator Ltd.

地盤用

工程號 J-853 地盤 延坪道

物料編號	L	L1	數量	樓層數	單層用量	分格尺寸	使用位置	樓層位置	座數
CW-DR-TJ01L	2588	2538	14	14	1	3150	J853-SD-CW-4204a	6/F-15/F, 17/F-22/F	T2
CW-DR-TJ01L	2588	2538	8	8	1	3150	J853-SD-CW-4205	6/F, 7/F-15/F	T2
CW-DR-TJ01aL	2738	2688	3	3	1	3300	J853-SD-CW-4204a	16/F, 25/F, 26/F	T2
CW-DR-TJ01aL	2738	2688	1	1	1	3300	J853-SD-CW-4205	16/F	T2
CW-DR-TJ01bL	2838	2788	1	1	1	3400	J853-SD-CW-4204a	23/F	T2
CW-DR-TJ01cL	3125	3075	1	1	1	3300	J853-SD-CW-4204a	5/F(加315)	T2
		合計	28						
CW-DR-TJ01L	2588	2538	14	14	1	3150	J853-SD-CW-4304a	6/F-15/F, 17/F-22/F	T3
CW-DR-TJ01L	2588	2538	8	8	1	3150	J853-SD-CW-4305	6/F, 7/F-15/F	T3
CW-DR-TJ01aL	2738	2688	3	3	1	3300	J853-SD-CW-4304a	16/F, 25/F, 26/F	T3
CW-DR-TJ01aL	2738	2688	1	1	1	3300	J853-SD-CW-4305	16/F	T3
CW-DR-TJ01bL	2838	2788	1	1	1	3400	J853-SD-CW-4304a	23/F	T3
CW-DR-TJ01cL	3125	3075	1	1	1	3300	J853-SD-CW-4304a	5/F (加315)	T3
		合計	28						
CW-DR-TJ01L	2588	2538	3	3	1	3150	J853-SD-CW-4505	11/F, 12/F, 15/F	T5
CW-DR-TJ01aL	2738	2688	1	1	1	3300	J853-SD-CW-4505	16/F	T5
		合計	4						
CW-DR-TJ01L	2588	2538	13	13	1	3150	J853-SD-CW-4604	7/F, 8/F-15/F, 17/F-22/F	T7
CW-DR-TJ01aL	2738	2688	1	1	1	3300	J853-SD-CW-4604	16/F	T7
CW-DR-TJ01bL	2838	2788	1	1	1	3400	J853-SD-CW-4604	23/F	T7
		合計	15						
		總計	75						

修訂A:

接收地盤炳哥微信要求:各座5/F
沒有陽臺位置的鋁門碰幕墻位鐵
料在底部加長315mm

名稱	門邊固定鐵件	制圖	黃瓊玉	2022.8.2	修改	A		
材料	100x50x4鐵通/40x17x4鐵槽	復核	謝永林	2022.8.3	日期	22.10.24		
顏色	熱浸鋅	批准			圖號	CW-DR-TJ01L(1)		

EG-DWG3



美特鋁質 有限公司
MIDI Aluminium Fabricator Ltd.

地盤用

工程號 J-853 地盤 延坪道

物料編號	L	L1	數量	樓層數	單層用量	分格尺寸	使用位置	樓層位置	座數
CW-DR-TJ01R	2588	2538	14	14	1	3150	J853-SD-CW-4204a	6/F-15/F, 17/F-22/F	T2
CW-DR-TJ01R	2588	2538	8	8	1	3150	J853-SD-CW-4205	6/F, 7/F-15/F	T2
CW-DR-TJ01aR	2738	2688	3	3	1	3300	J853-SD-CW-4204a	16/F, 25/F, 26/F	T2
CW-DR-TJ01aR	2738	2688	1	1	1	3300	J853-SD-CW-4205	16/F	T2
CW-DR-TJ01bR	2838	2788	1	1	1	3400	J853-SD-CW-4204a	23/F	T2
CW-DR-TJ01cR	3125	3075	1	1	1	3300	J853-SD-CW-4204a	5/F (加315)	T2
		合計	28						
CW-DR-TJ01R	2588	2538	14	14	1	3150	J853-SD-CW-4304a	6/F-15/F, 17/F-22/F	T3
CW-DR-TJ01R	2588	2538	8	8	1	3150	J853-SD-CW-4305	6/F, 7/F-15/F	T3
CW-DR-TJ01aR	2738	2688	3	3	1	3300	J853-SD-CW-4304a	16/F, 25/F, 26/F	T3
CW-DR-TJ01aR	2738	2688	1	1	1	3300	J853-SD-CW-4305	16/F	T3
CW-DR-TJ01bR	2838	2788	1	1	1	3400	J853-SD-CW-4304a	23/F	T3
CW-DR-TJ01cR	3125	3075	1	1	1	3300	J853-SD-CW-4304a	5/F (加315)	T3
		合計	28						
CW-DR-TJ01R	2588	2538	8	8	1	3150	J853-SD-CW-4503	6/F, 7/F-15/F	T5
CW-DR-TJ01aR	2738	2688	1	1	1	3300	J853-SD-CW-4503	16/F	T5
		合計	9						
CW-DR-TJ01R	2588	2538	13	13	1	3150	J853-SD-CW-4603	7/F-15/F, 17/F-22/F	T7
CW-DR-TJ01aR	2738	2688	3	3	1	3300	J853-SD-CW-4603	16/F, 25/F, 26/F	T7
CW-DR-TJ01bR	2838	2788	1	1	1	3400	J853-SD-CW-4603	23/F	T7
		合計	17						
		總計	82						

修訂 A

接收地盤炳哥微信要求: 各座5/F
沒有陽臺位置的鋁門碰幕牆位鐵
料在底部加長315mm

名稱	門邊固定鐵件	制圖	黃瓊玉	2022.8.2	修改	A		
材料	100x50x4鐵通/40x17x4鐵槽	復核	謝永林	2022.8.3	日期	22.10.24		
顏色	熱浸鋅	批准			圖號	CW-DR-TJ01R(1)		

B.D. REF. :

CLIENT :

SHIMAO GROUP HOLDINGS LIMITED

ARCHITECT :

WONG TUNG & PARTNERS LIMITED

MAIN CONTRACTOR :

協興建築有限公司
HIP HING CONSTRUCTION CO. LTD

STRUCTURAL ENGINEER :

CMA CM WONG & ASSOCIATES LTD
黃志明建築工程師有限公司

FAÇADE CONSULTANT :

MEINHARDT

NOTE :
1. DIMENSIONS ARE IN MM. FROM OUTSIDE.
2. ALL ELEVATIONS ARE TO BE KEPT ON SITE BEFORE FABRICATION.
LEGEND :

① - BEAM MARK NO.

② - REFER SHEET NO.

1. F.F.L. - FINISHED FLOOR LEVEL.

2. S.F.L. - STRUCTURAL FLOOR LEVEL.

3. ⌀ - REVERSED DETAIL.

JOB NO. : J-853

PROJECT : PROPOSED RESIDENTIAL DEVELOPMENT AT N.K.L.L. 6542

YIN PING ROAD KOWLOON

DATE : 22-OCT-21

SCALE : 1:60 (A1)

CHECKED BY :

SHIMAO GROUP HOLDINGS LIMITED

SHIMAO GROUP HOLDINGS LIMITED

修訂 A

按地盤要求：各座5/F沒有陽臺位置的鋁門碰幕墻位鐵料在底部加長315mm (2022.10.24)

FLOOR	LEVEL
ROOF	+210.00
26/F	+208.40
25/F	+206.80
24/F	+205.20
23/F	+203.60
22/F	+198.85
21/F	+193.70
20/F	+190.55
19/F	+187.40
18/F	+184.25
17/F	+181.10
16/F	+177.80
15/F	+174.65
14/F	+171.50
13/F	+168.35
12/F	+165.20
11/F	+162.05
10/F	+158.90
9/F	+155.75
8/F	+152.60
7/F	+149.45
6/F	+146.30
5/F	+143.15

- LEGEND :
- ① 10mm HEAT STRENGTHENED GLASS (OUTER) + 12mm AIR SPACE + 12mm THK. TEMPERED CLEAR GLASS (INNER)
 - ② 10mm HEAT STRENGTHENED GLASS (OUTER) + 12mm AIR SPACE + 10mm THK. TEMPERED CLEAR GLASS (INNER)
 - ③ 12mm THK. HEAT STRENGTHENED GLASS & 2mm THK. ALUM. BACKUP (SPANDREL GLASS)
 - ④ 12mm THK. CLEAR TEMPERED GLASS (INTERNAL PROTECTIVE BARRIER)
 - ⑤ 3mm THK. ALUM. CLADDING
 - S.J. - STACK JOINT (WIND LOAD)
 - ALUM. - ALUM. EXTRUSION (WIND LOAD)
 - ALUM. - ALUM. EXTRUSION (DE. NO. SUPPORT POINT (WIND LOAD + BEAD LOAD))
 - ▲ - SUPPORT POINT (WIND LOAD)

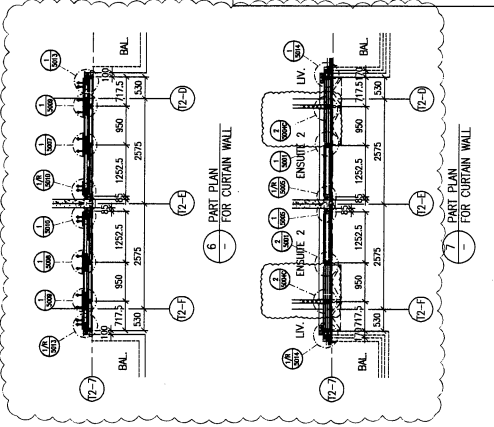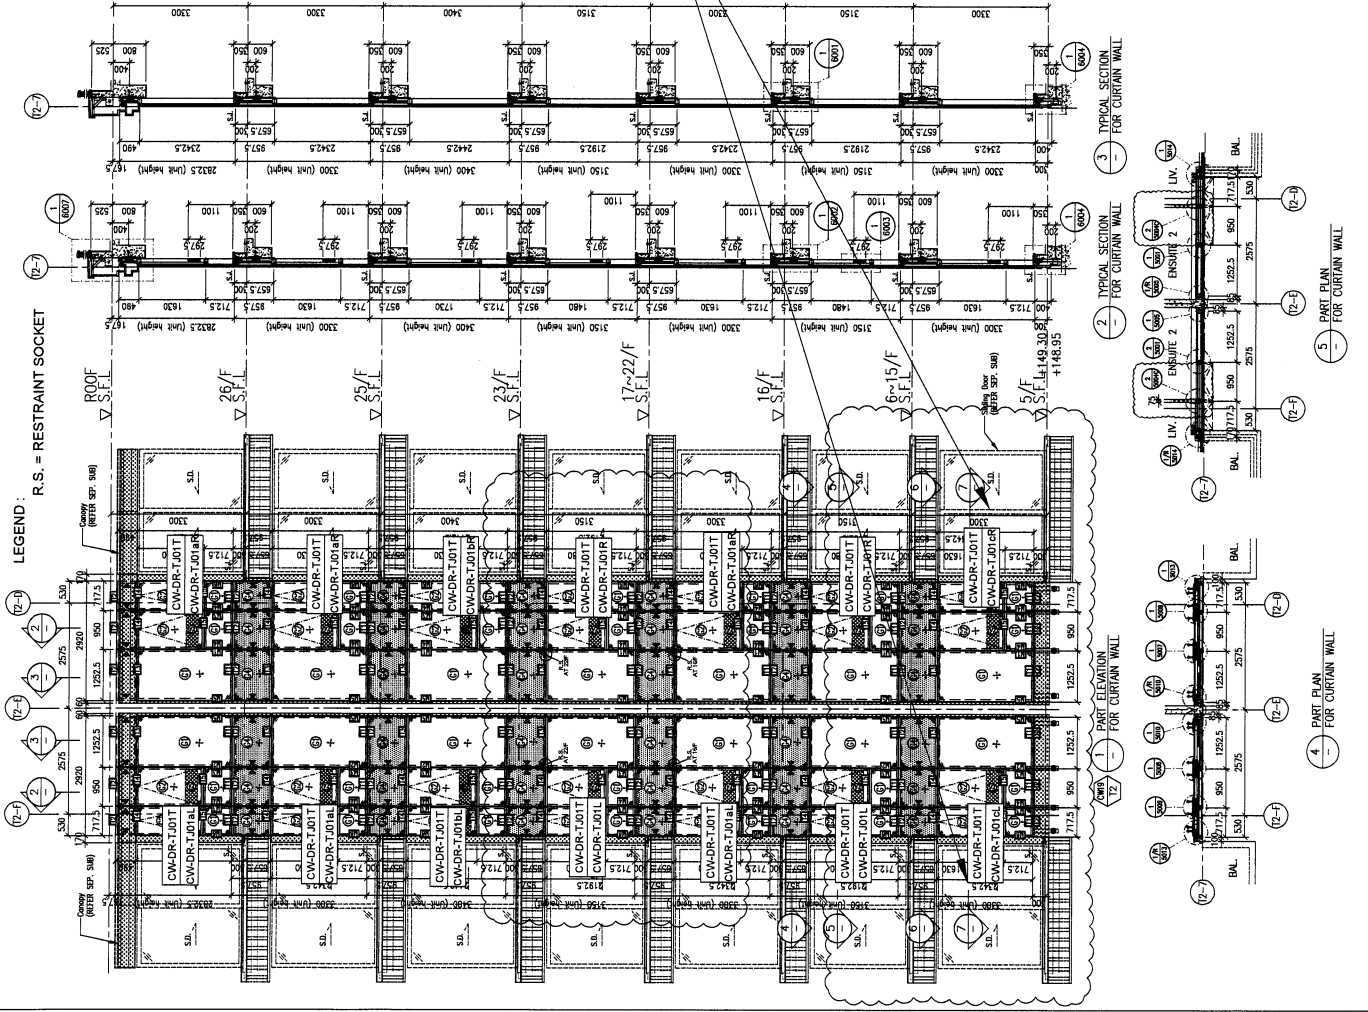

B.D. REF. :

CLIENT :

SHIMAO GROUP HOLDINGS LIMITED

ARCHITECT :

WONG TUNG & PARTNERS LIMITED



MAIN CONTRACTOR :

協興建築有限公司 HIP HING CONSTRUCTION CO LTD

STRUCTURAL ENGINEER :

CMA C M WONG & ASSOCIATES LTD 黃志明建築工程師有限公司

FAÇADE CONSULTANT :



NOTE :

1. ALL DIMENSIONS ARE IN mm.
2. ALL DIMENSIONS TO BE REVERSED ON SITE BEFORE FABRICATION.

LEGEND :

- ① - DENIAL MARK NO.
- ② - REFER SHEET NO.
- 1. F.F.L. --- FINISHED FLOOR LEVEL.
- 2. S.F.L. --- STRUCTURAL FLOOR LEVEL.
- 3. Ⓜ --- REVERSED DETAIL.

JOB NO. : J-853

PROJECT : PROPOSED RESIDENTIAL DEVELOPMENT AT N.K.L.L. 6542 YIN PING ROAD KOWLOON

TITLE : PART ELEVATION FOR CURTAIN WALL AT TOWER 3

DATE : 23-OCT-21 SCALE : 1:50 (A1)

DRAWN BY : LHR CHECKED BY :




Units E-8, Sunny Industrial Centre, 1/1 810 Cheong Cheong Road, Kowloon Tel: 23489211-4 Fax: (852) 777686

DWG NO. : J853-S0-CW-4304A REV. : A


修訂 A

按地盤要求:各座5/F沒有陽臺位置的鋁門碰幕墻位鐵料在底部加長315mm (2022.10.24)

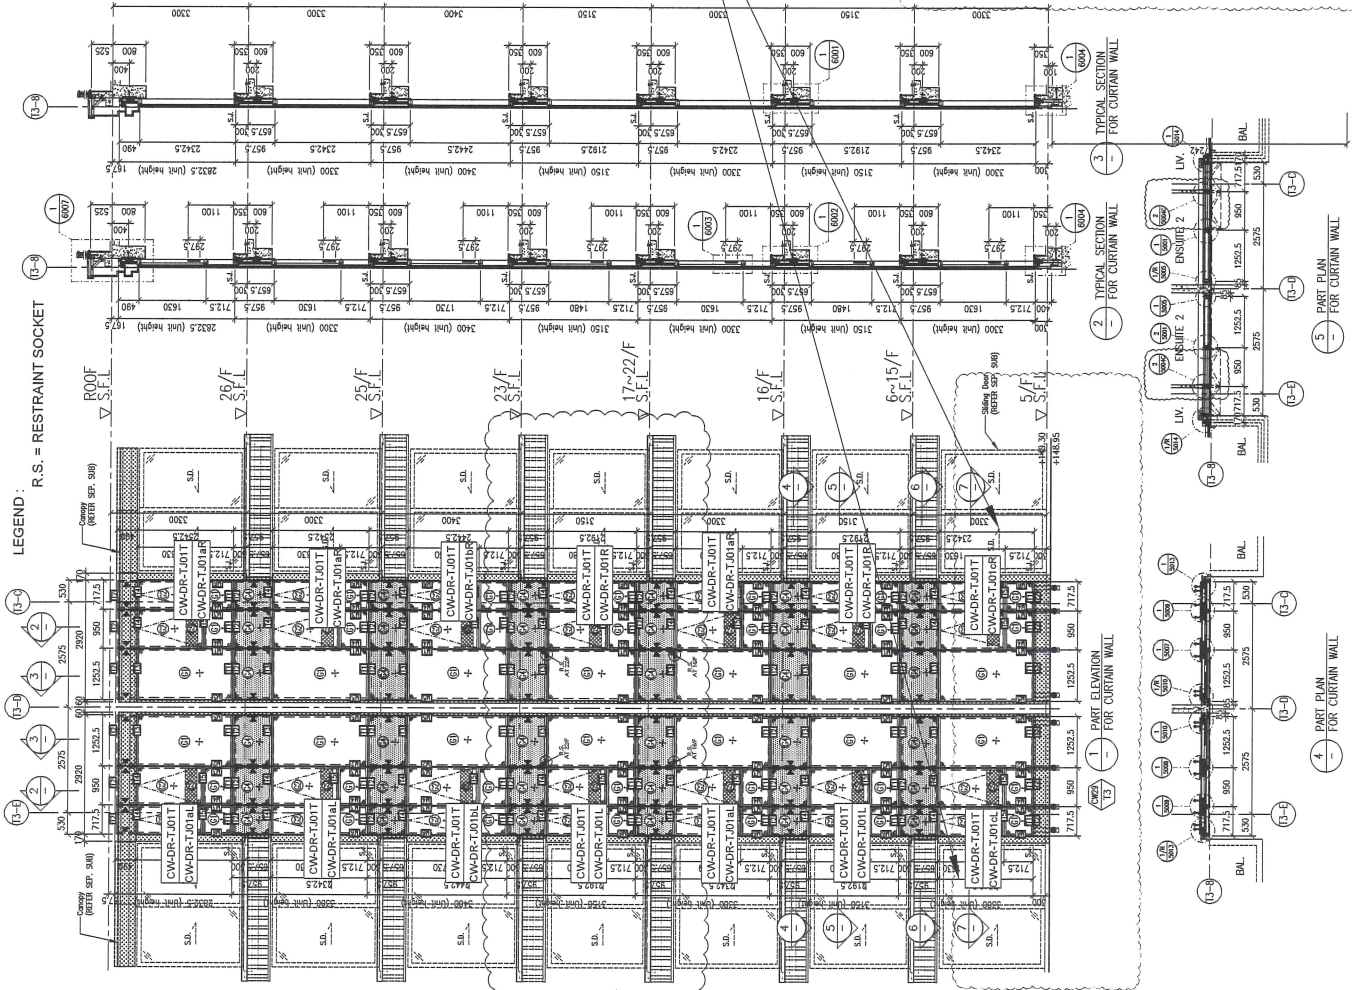

FLOOR LEVEL	LEVEL
ROOF	+210.00
26/F	+208.70
25/F	+200.00
24/F	+200.00
23/F	+198.85
22/F	+198.85
21/F	+193.70
20/F	+190.55
19/F	+187.40
18/F	+184.25
17/F	+181.10
16/F	+177.80
15/F	+174.65
12/F	+171.50
11/F	+168.35
10/F	+165.20
9/F	+162.05
8/F	+158.90
7/F	+155.75
6/F	+152.60
5/F	+149.45


- LEGEND :
- ① 10mm HEAT STRENGTHENED GLASS (OUTER) + 12mm AIR SPACE + 12mm THK. TEMPERED CLEAR GLASS STRENGTHENED GLASS (INNER)
 - ② 12mm THK. HEAT STRENGTHENED GLASS (OUTER) + 12mm AIR SPACE + 10mm THK. TEMPERED CLEAR GLASS (INNER)
 - ③ 12mm THK. HEAT STRENGTHENED GLASS & 2mm THK. ALUM. BACKWASH (SPANDREL GLASS)
 - ④ 12mm THK. CLEAR TEMPERED GLASS (INTERNAL PROTECTIVE BARBER)
 - ⑤ 3mm THK. ALUM. CLADDING
 - S.L. - STACK JOINT (WIND LOAD)
 - ALUM. EXTENSION DIE NO.
 - SUPPORT POINT (WIND LOAD + DEAD LOAD)
 - SUPPORT POINT (WIND LOAD)

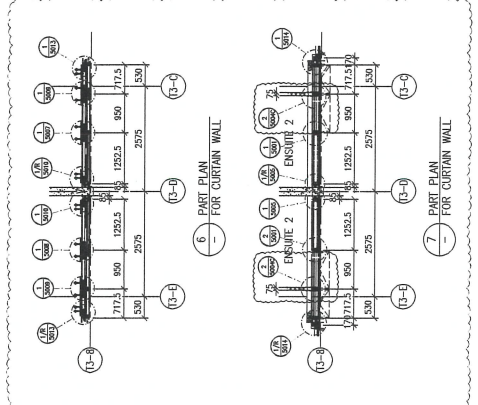

圖則登記表
DRAWING REGISTER




圖則登記表 DRAWING REGISTER		接收日期 Receiving Date (適用於客戶圖則)							
工程名稱 Project Title:	九龍延坪道 幕牆T6-地盤用鐵件拆圖	年							
工程編號 Project No:	J-853	月							
分發予 Distributed To		日							
		發出日期 Issued Date							
		年	22	22					
		月	9	10					
		日	29	24					
圖則編號 Drg. No.	圖則名稱 Drawing Title	修訂編號 Revision No.							
CW-DR-TJ01T	門邊固定頂部套心	1	-	-					
CW-DR-TJ01L	門邊固定鐵件	2	-	A					
CW-DR-TJ01R	門邊固定鐵件	3	-	A					
J853-SD-CW-4602	位置圖	4	-	A					

美特鋁質有限公司 MIDI Aluminium Fabricator Ltd.		工程號: J-853		計算: 黃瓊玉		日期: 2022.9.29		送呈: 胡哥				
地盤名稱: 延坪道		地盤名稱: 延坪道		核對: 謝永林		日期: 2022.9.30		副本:				
地盤用鐵件B.M.表		項目類別: 地盤用門邊鐵件(T6)		批准:		日期:		總重量: 1103.56 KG				
A/C Code: 2022.10.24(A版)		依據收地盤烟哥微信要求)										
此BM依據拆圖資料計算												
序號	修改標示	鐵件圖號	物料編號	配件名稱	顏色	實用	後備	總數	單位	單件重量	總重量	備注
1			CW-DR-TJ01T	80x40x5鐵通	熱浸鋅	38	0	38	件	0.84	31.92	地盤用
2			CW-DR-TJ01L	100x50x4鐵通/40x17x4鐵槽	熱浸鋅	14	0	14	件	27.51	385.09	地盤用
3	A: 新增		CW-DR-TJ01aL	100x50x4鐵通/40x17x4鐵槽	熱浸鋅	3	0	3	件	29.11	87.32	地盤用
4			CW-DR-TJ01bL	100x50x4鐵通/40x17x4鐵槽	熱浸鋅	1	0	1	件	30.17	30.17	地盤用
4a	A: 新增		CW-DR-TJ01cL	100x50x4鐵通/40x17x4鐵槽	熱浸鋅	1	0	1	件	33.23	33.23	地盤用
5			CW-DR-TJ01R	100x50x4鐵通/40x17x4鐵槽	熱浸鋅	14	0	14	件	27.51	385.09	地盤用
6	A: 新增		CW-DR-TJ01aR	100x50x4鐵通/40x17x4鐵槽	熱浸鋅	3	0	3	件	29.11	87.32	地盤用
7			CW-DR-TJ01bR	100x50x4鐵通/40x17x4鐵槽	熱浸鋅	1	0	1	件	30.17	30.17	地盤用
7a	A: 新增		CW-DR-TJ01cR	100x50x4鐵通/40x17x4鐵槽	熱浸鋅	1	0	1	件	33.23	33.23	地盤用
總計									76	總重量	1103.56	

 美特鋁質 有限公司 MIDI Aluminium Fabricator Ltd.				焊接示意件出地盤 地盤用				
工程號	J-853	地盤	延坪道					
物料編號	L	L1	數量	樓層數	單層用量	分格尺寸	使用位置	樓層位置
CW-DR-TJ01L	2588	2538	14	14	1	3150	J853-SD-CW-4602	6/F-15/F, 17-22/F
CW-DR-TJ01aL	2738	2688	3	3	1	3300	J853-SD-CW-4602	16/F, 25/F, 26F
CW-DR-TJ01bL	2838	2788	1	1	1	3400	J853-SD-CW-4602	23/F
CW-DR-TJ01cL	3125	3075	1	1	1	3300	J853-SD-CW-4602	5/F(加315)
合計			19					


接收地盤炳哥微信要求:各座5/F
 沒有陽臺位置的鋁門碰幕牆位鐵
 料在底部加長315mm

炳哥訂A

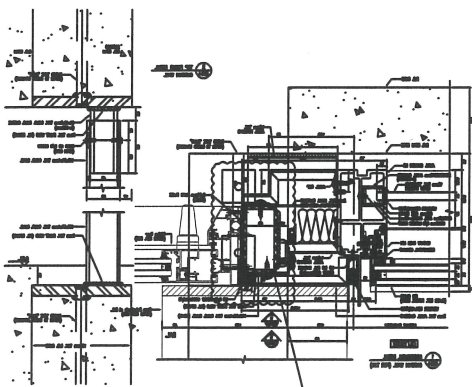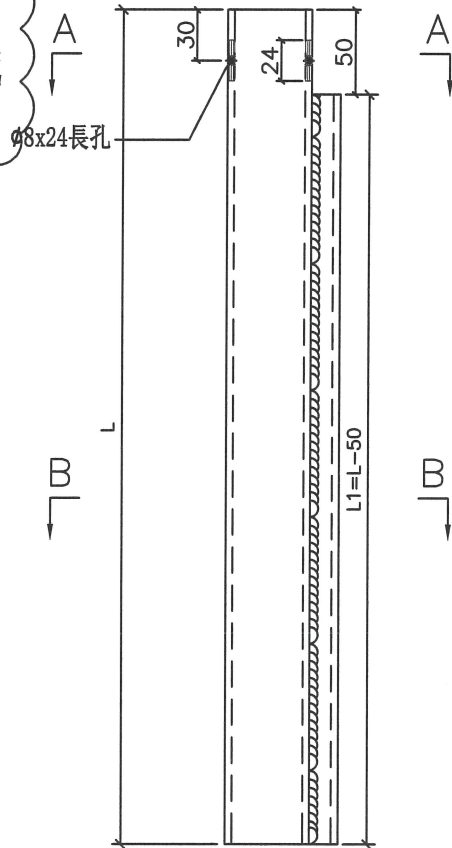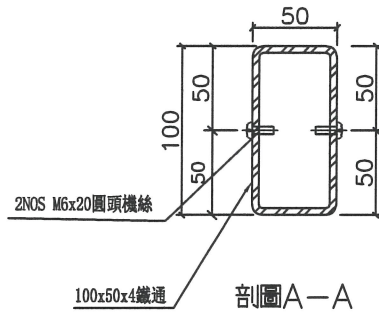

此件

安裝示意圖

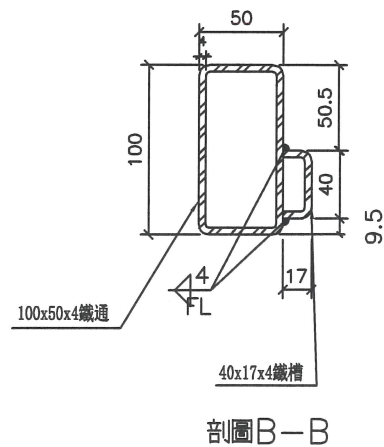


剖圖B-B

名稱	門邊固定鐵件	制圖	黃瓊玉	2022.07.27	修改	A	
材料	100x50x4鐵通/40x17x4鐵槽	復核	謝永林	2022.07.28	日期	22.10.24	
顏色	熱浸鋅	批准			圖號	CW-DR-TJ01L	

美特鋁質 有限公司 MIDI Aluminium Fabricator Ltd.	焊接示意件出地盤		
	地盤用		




工程號	J-853	地盤	延坪道
-----	-------	----	-----

物料編號	L	L1	數量	樓層數	單層用量	分格尺寸	使用位置	樓層位置
CW-DR-TJ01R	2588	2538	14	14	1	3150	J853-SD-CW-4602	6/F-15/F, 17-22/F
CW-DR-TJ01aR	2738	2688	3	3	1	3300	J853-SD-CW-4602	16/F, 25/F, 26F
CW-DR-TJ01bR	2838	2788	1	1	1	3400	J853-SD-CW-4602	23/F
CW-DR-TJ01cR	3125	3075	1	1	1	3300	J853-SD-CW-4602	5/F (加315)
		合計	19					

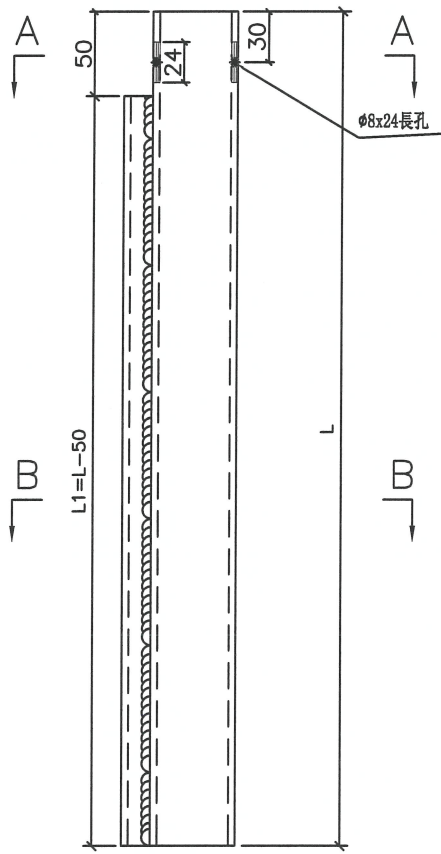

接收地盤炳哥微信要求: 各座5/F
 沒有陽臺位置的鋁門碰幕墻位鐵
 料在底部加長315mm

修訂A

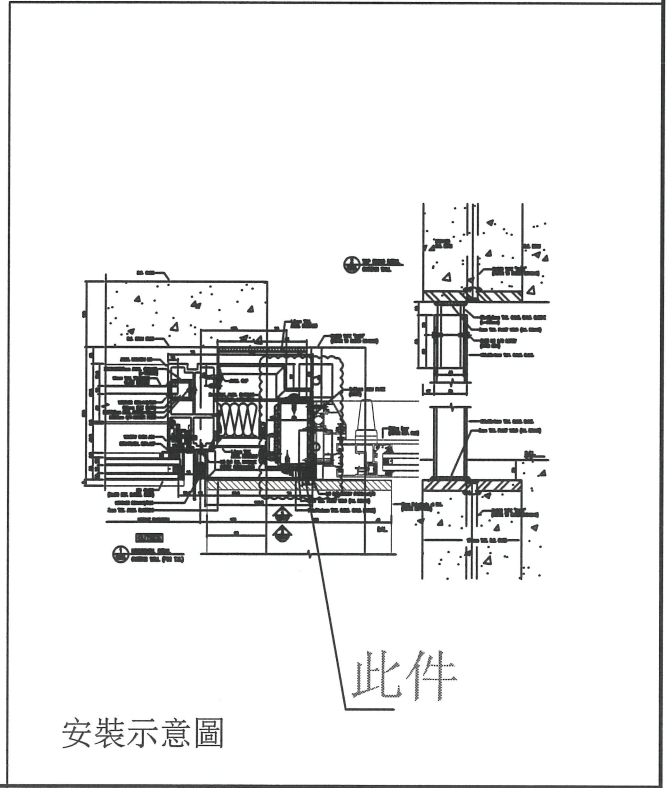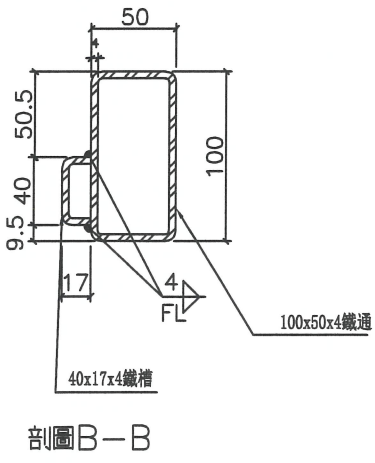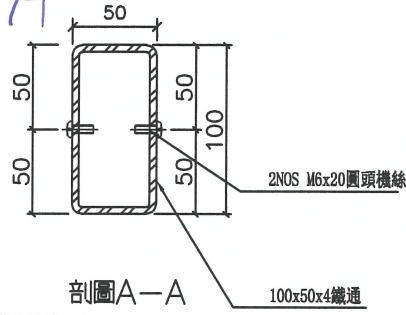

此件

安裝示意圖

名稱	門邊固定鐵件	制圖	黃瓊玉	2022.07.27	修改	A	
材料	100x50x4鐵通/40x17x4鐵槽	復核	謝永林	2022.07.28	日期	22.10.24	
顏色	熱浸鋅	批准			圖號	CW-DR-TJ01R	

B.D. REF. :

CLIENT : SHIMAO GROUP HOLDINGS LIMITED
 ARCHITECT : WONG TUNG & PARTNERS LIMITED
 MAIN CONTRACTOR : 協興建築有限公司
 HP HING CONSTRUCTION CO LTD
 STRUCTURAL ENGINEER : CMA CM WONG & ASSOCIATES LTD
 黃志明建築工程師有限公司
 FACADE CONSULTANT : MEINHARDT

NOTE :
 1. ALL DIMENSIONS ARE IN mm.
 2. ALL DIMENSIONS ARE TO FACE UNLESS OTHERWISE STATED.
 3. ALL DIMENSIONS TO BE REVERSED ON SITE BEFORE FABRICATION.

LEGEND :
 (AT) - DETAIL MARK NO.
 (RS) - REFER SHEET NO.
 1. F.F.L. --- FINISHED FLOOR LEVEL.
 2. S.F.L. --- STRUCTURAL FLOOR LEVEL.
 3. --- REVERSED DETAIL.

NO.	DATE	REVISION SUBJECT TO WHICH COMMENT REVERSED	BY
A	09-10-2021	REVISION SUBJECT TO ARCH. COMMENT	
B			
C			
D			
E			
F			
G			
H			
I			
J			
K			
L			
M			
N			
O			
P			
Q			
R			
S			
T			
U			
V			
W			
X			
Y			
Z			

JOB NO. : J-853
 PROJECT : PROPOSED RESIDENTIAL DEVELOPMENT AT N.K.L.L. 6542 YIN PING ROAD, KOWLOON

TITLE : PART ELEVATION FOR CURTAIN WALL AT TOWER 6 & 7
 DATE : 12-APR-21 SCALE : 1:60 (A1)
 DRAWN BY : LHR CHECKED BY :
 美特鋁質有限公司
 美特鋁質有限公司
 Units 6-8, Suning Industrial Centre, 7/F
 610 Chee Kwo Ling Road, Kowloon
 Tel: 23489211-4 Fax: (852) 7727666
 DWG NO. : J853-SD-CW-4602 REV. : A

FLOOR LEVEL (S.F.L.)	FLOOR LEVEL (F.F.L.)
ROOF	-210.00
26/F	-208.70
25/F	-207.40
24/F	-206.10
23/F	-204.80
22/F	-203.50
21/F	-202.20
20/F	-200.90
19/F	-199.60
18/F	-198.30
17/F	-197.00
16/F	-195.70
15/F	-194.40
14/F	-193.10
13/F	-191.80
12/F	-190.50
11/F	-189.20
10/F	-187.90
9/F	-186.60
8/F	-185.30
7/F	-184.00
6/F	-182.70
5/F	-181.40

按地盤要求:各座5F沒
 有陽臺位置的鋁門碰幕
 牆位鐵料在底部加長
 315mm (2022.10.24)

- LEGEND:
- ① 10mm HEAT STRENGTHENED GLASS (INNER)
 - ② 12mm AIR SPACE + 12mm THK. TEMPERED CLEAR HEAT STRENGTHENED GLASS (OUTER)
 - ③ 12mm HEAT STRENGTHENED GLASS (INNER)
 - ④ 12mm AIR SPACE + 10mm THK. TEMPERED CLEAR GLASS (INNER)
 - ⑤ 12mm THK. HEAT STRENGTHENED GLASS & 2mm THK. ALUM. BACKPAN (SPANDREL GLASS)
 - ⑥ 2mm THK. CLEAR TEMPERED GLASS (INTERNAL PROTECTIVE BARRIER)
 - ⑦ 3mm THK. ALUM. CLADDING
 - S.L. - STACK JOINT (WIND LOAD)
 - ALUM. - ALUM. EXTRUSION DIE NO.
 - SUPPORT POINT (WIND LOAD + DEAD LOAD)
 - SUPPORT POINT (WIND LOAD)

