

工程指示 / 要求簡箋 ENGINEER INSTRUCTIONS(E.I.)

工程指示編號:	EI- 5257	修改版本:	-
	HK- 1862		
工程編號:	J 853	工程名稱:	大窩坪 (延坪道)
收件人:	生統/ 謝永林	發件人:	Edwin Ho
工程項目:	幕牆圖紙更新	日期:	26/10/2022

<input type="checkbox"/> 原合約工程包	<input type="checkbox"/> 原合約工程加 / 減賬 QT-	<input type="checkbox"/> 新工程報價 QT-
---------------------------------	--	------------------------------------

信件批核號碼/圖紙參考編號:	批核模具圖紙編號:
客戶指示附件:	管理內部批簽署:

<input type="checkbox"/> 初步鋁料 B.M.	<input type="checkbox"/> 加工拆圖, 然後生產	<input type="checkbox"/> 尺寸表
<input type="checkbox"/> 正式鋁料 B.M.	<input type="checkbox"/> 技術上資料/指示	<input type="checkbox"/> 報價
<input checked="" type="checkbox"/> 配件 B.M.	<input type="checkbox"/> 樣辦或貨品說明書	<input type="checkbox"/> 分判合約
<input type="checkbox"/> 其他:		


內容: 請依附件資料, 更新幕牆圖紙。
完成上列要求日期: ASAP

國內

<input type="checkbox"/> 生產技術總監	<input type="checkbox"/> 連附件	<input type="checkbox"/> 技術部	<input type="checkbox"/> 連附件	<input type="checkbox"/> 生產部	<input type="checkbox"/> 連附件
<input type="checkbox"/> 採購部	<input type="checkbox"/> 連附件	<input checked="" type="checkbox"/> 生產統籌部	<input checked="" type="checkbox"/> 連附件	<input type="checkbox"/> 報關組	<input type="checkbox"/> 連附件
<input type="checkbox"/> 質檢部	<input type="checkbox"/> 連附件	<input type="checkbox"/> 會計部	<input type="checkbox"/> 連附件	<input type="checkbox"/> 機械設計部	<input type="checkbox"/> 連附件
<input type="checkbox"/> 香港辦	<input checked="" type="checkbox"/> 連附件	<input type="checkbox"/> 其他:			


香港

<input type="checkbox"/> 行政部	<input type="checkbox"/> 連附件	<input type="checkbox"/> 會計部	<input type="checkbox"/> 連附件	<input type="checkbox"/> 統籌部	<input type="checkbox"/> 連附件	<input type="checkbox"/> 工程部	<input type="checkbox"/> 連附件
<input type="checkbox"/> 採購部	<input type="checkbox"/> 連附件	<input type="checkbox"/> QS部	<input type="checkbox"/> 連附件	<input checked="" type="checkbox"/> 地盤管理	<input checked="" type="checkbox"/> 連附件	<input type="checkbox"/> 維修部	<input type="checkbox"/> 連附件

*發件人簽署: Edwin Ho	*組別成員批核簽署: 
傳遞編號:	項目經理簽署:

4303/1

M4 中正在死精的收口。

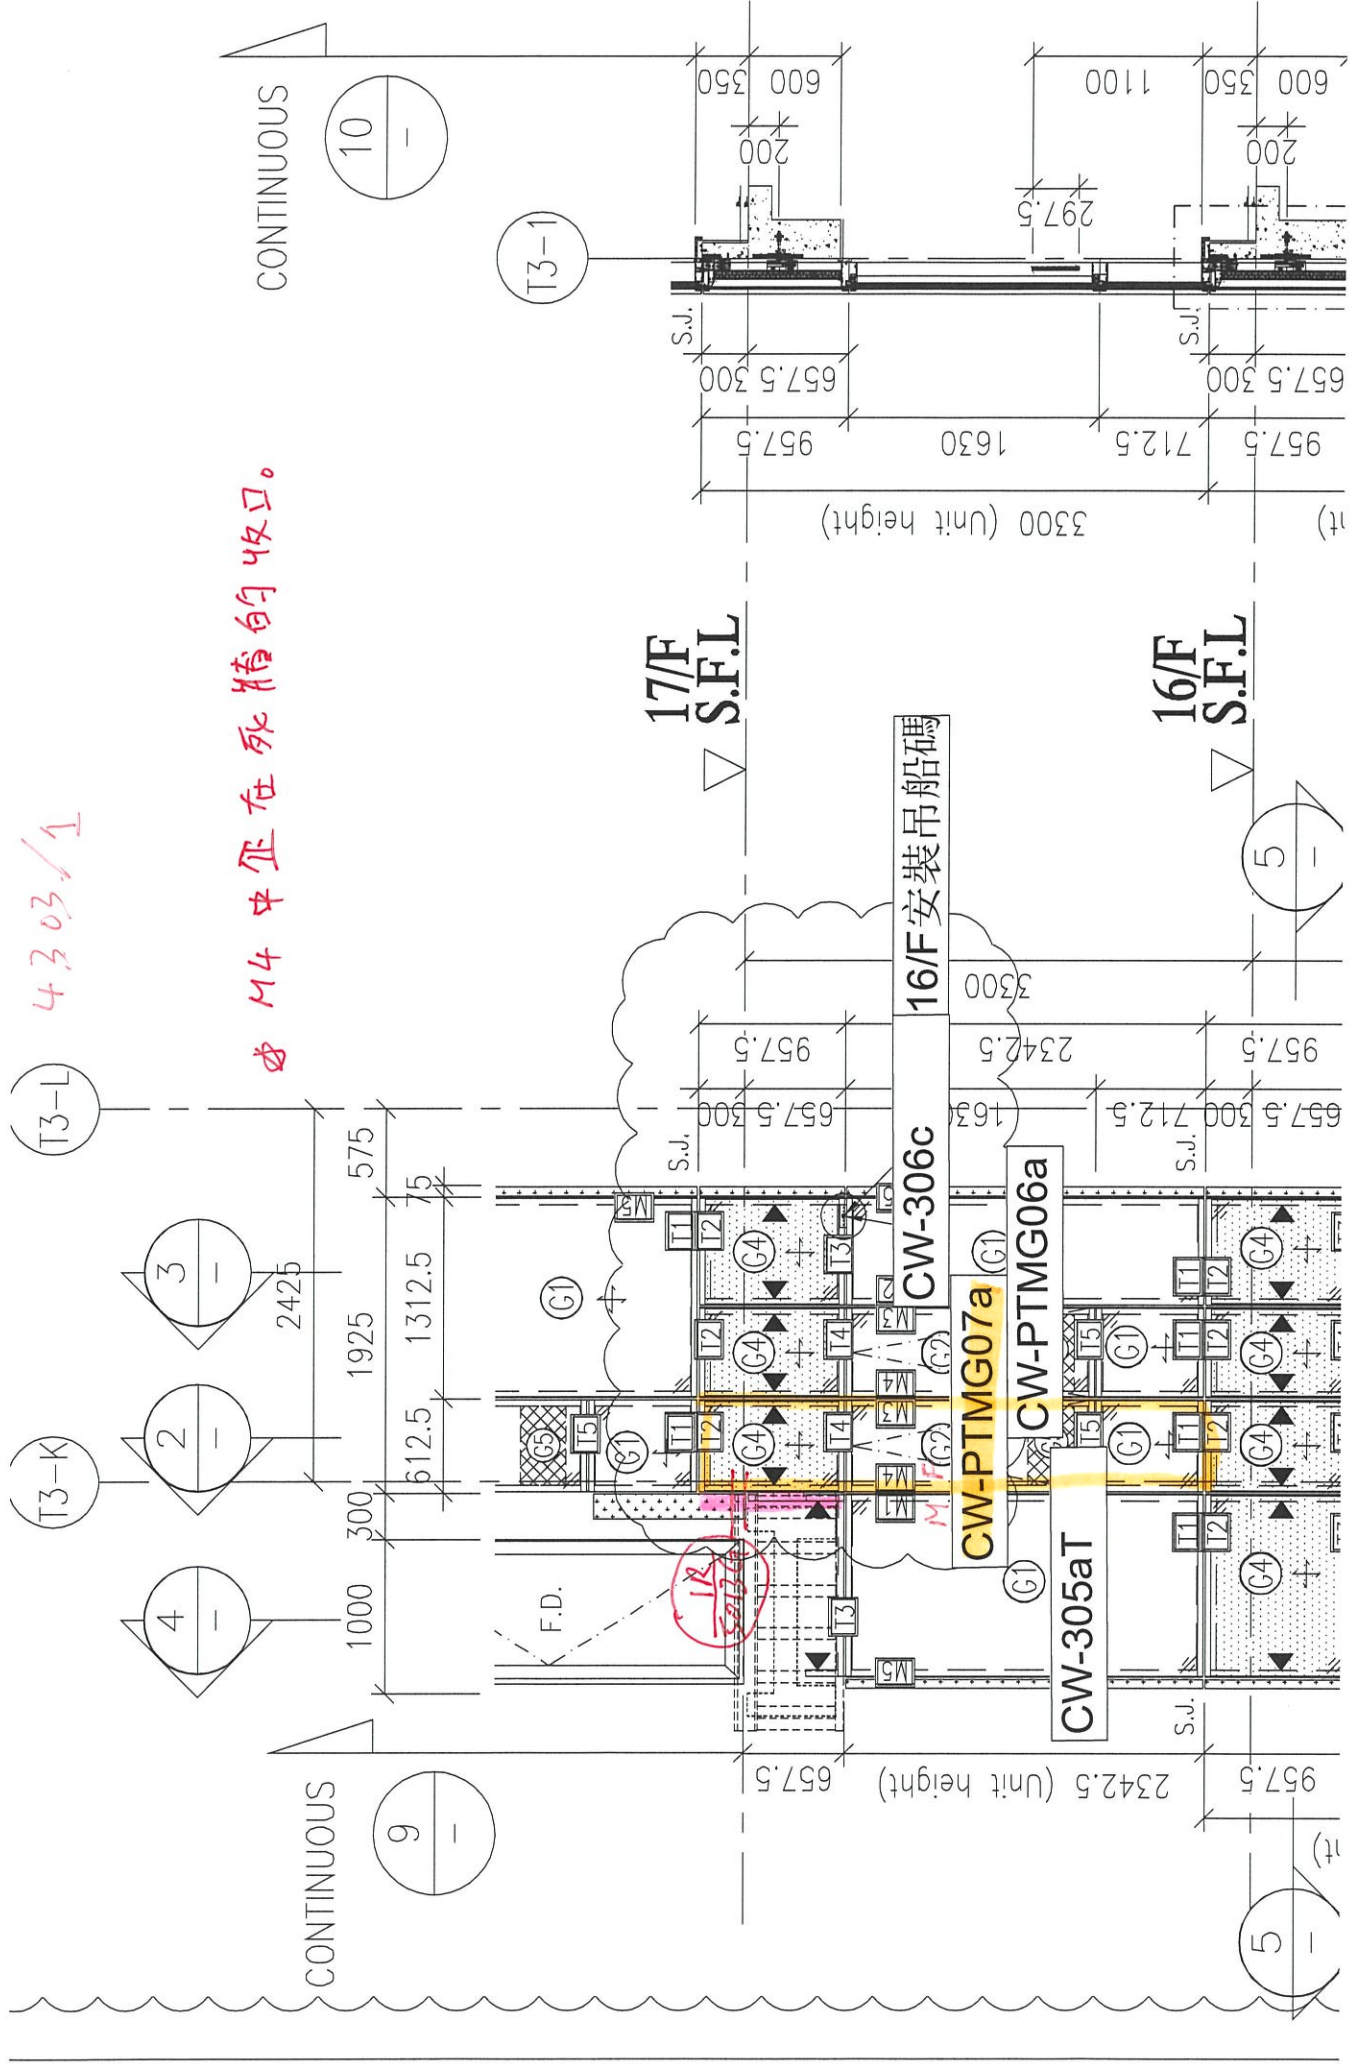

CONTINUOUS




T3-1

17/F S.F.L.

16/F S.F.L.


CONTINUOUS

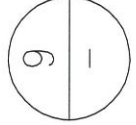

(t)

4502/1

- M3 中企在死牆的收口。
- 以及 17/F 以上 CW 和 F.D. 門的鋸板有別於 Typical 的，這是 350mm，因 CW 企料中比平時 遠多 50mm。

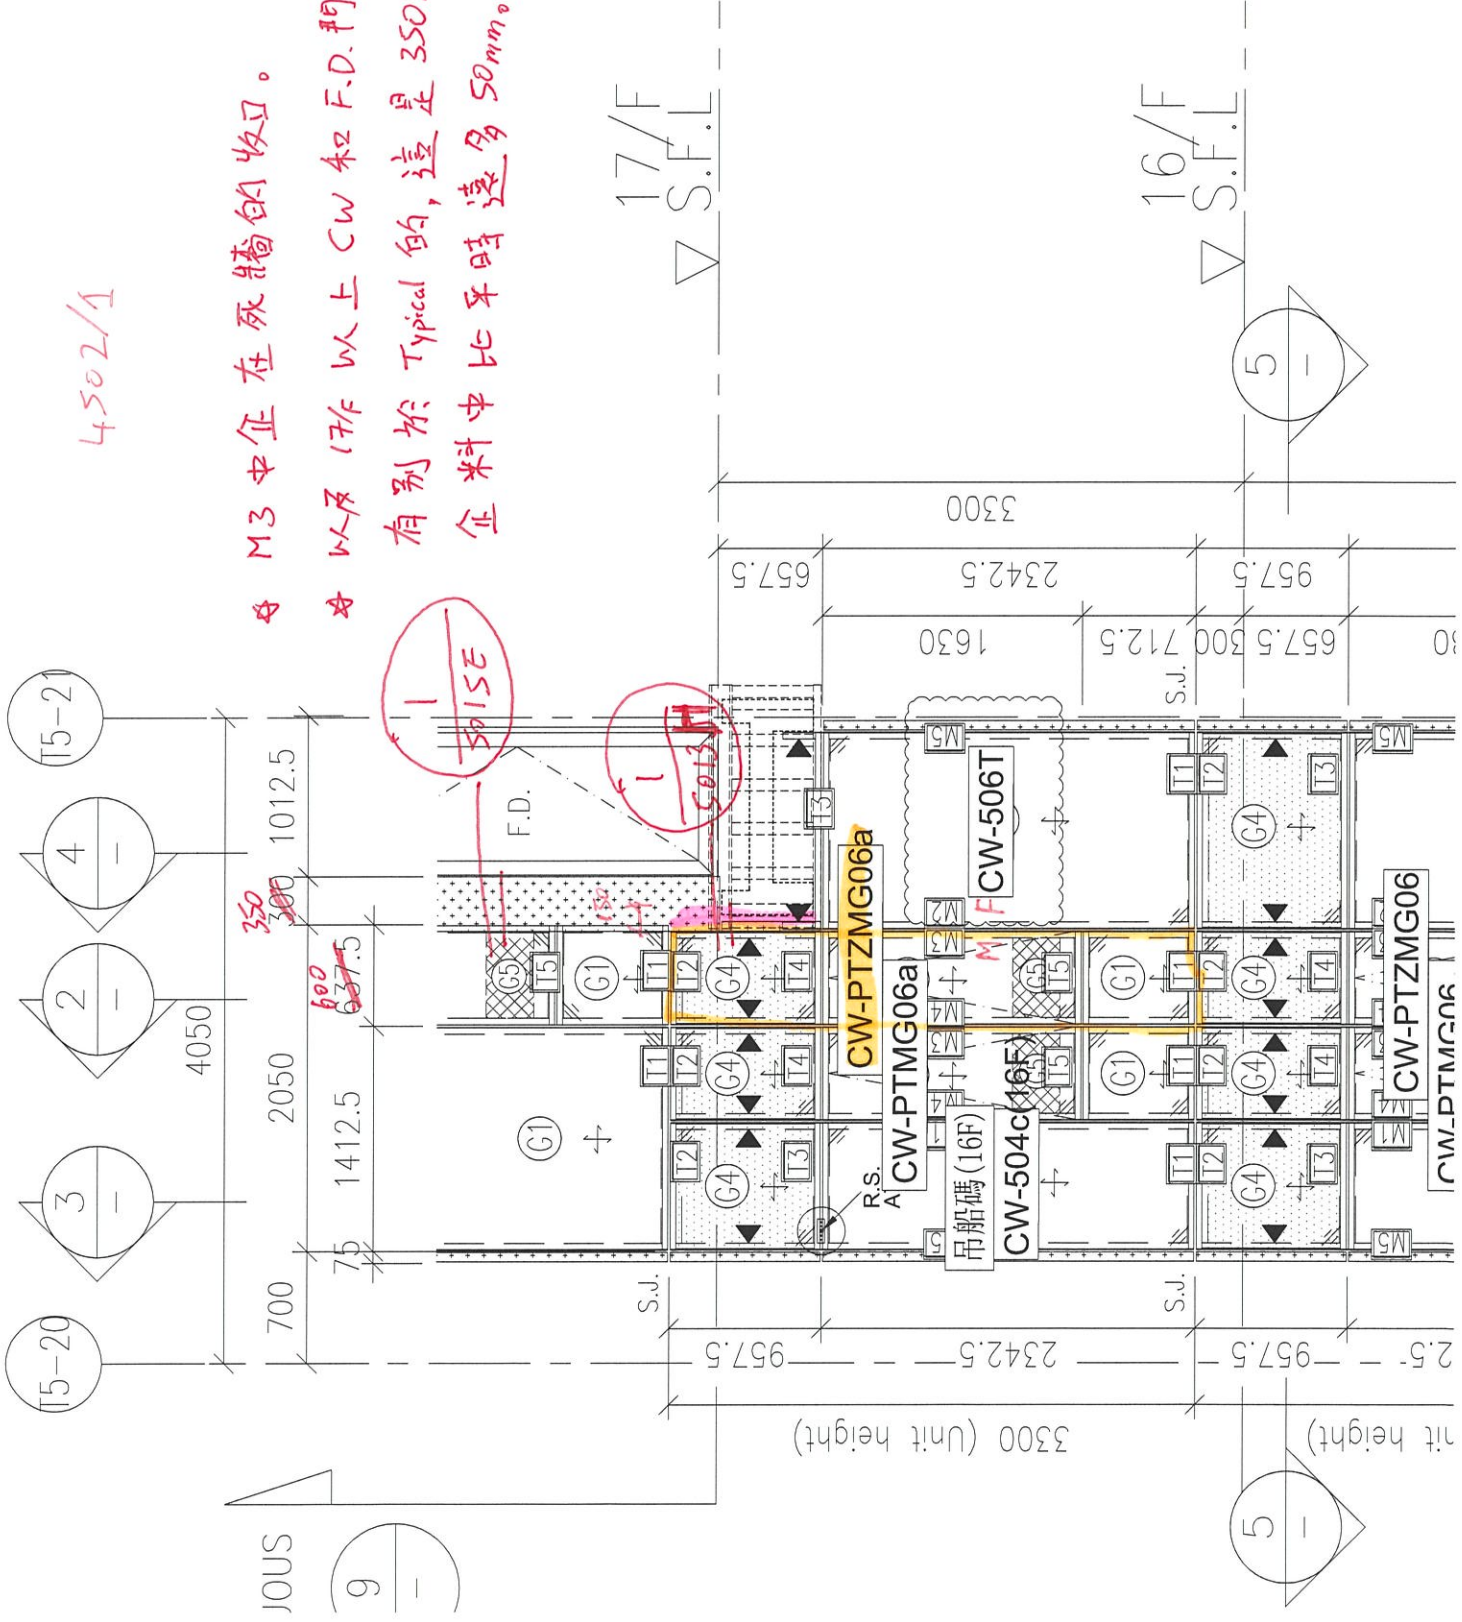

3300 (Unit height)

Unit height)

JOUS

9

5

B.D. REF :

CLIENT : SHIMAO GROUP HOLDINGS LIMITED

ARCHITECT : YONG TUNG & PARTNERS LIMITED ARCHITECTS & PLANNERS

MAIN CONTRACTOR : 協興建築有限公司 HIP-HING CONSTRUCTION CO LTD

STRUCTURAL ENGINEER : ICMA C M WONG & ASSOCIATES LTD 黃志明建築工程師有限公司

FAÇADE CONSULTANT: MEINHARDT

NOTE:

1. ALL DIMENSIONS ARE IN mm.
2. ALL ELEVATIONS ARE VIEWED FROM OUTSIDE.
3. BEFORE FABRICATION.

LEGEND:

DETAIL MARK NO. REFER SHEET NO.

1. F.F.L. --- FINISHED FLOOR LEVEL
2. S.F.L. --- STRUCTURAL FLOOR LEVEL
3. (R) --- REVERSED DETAIL

NO	DATE	REVISION SUBJECT TO REVL. CHANGE	BY

JOB NO. : J-853

PROJECT : PROPOSED RESIDENTIAL DEVELOPMENT AT N.K.I.L. 6542 YIN PING ROAD KOMLOON


TITLE : HORIZONTAL DETAIL FOR CURTAIN WALL

DATE : 20-APR-21 SCALE : 1:2 (A3)

DRAWN BY : LHR CHECKED BY :

MEINHARDT 美特銳有限公司
Units 6-8, Sunray Industrial Centre, 1/F
610 Che Kwo Ling Road, Kowloon
Tel: 2489211-4 Fax: (852) 7272666

DWG NO. : J853-SD-CW-5013C REV. : -

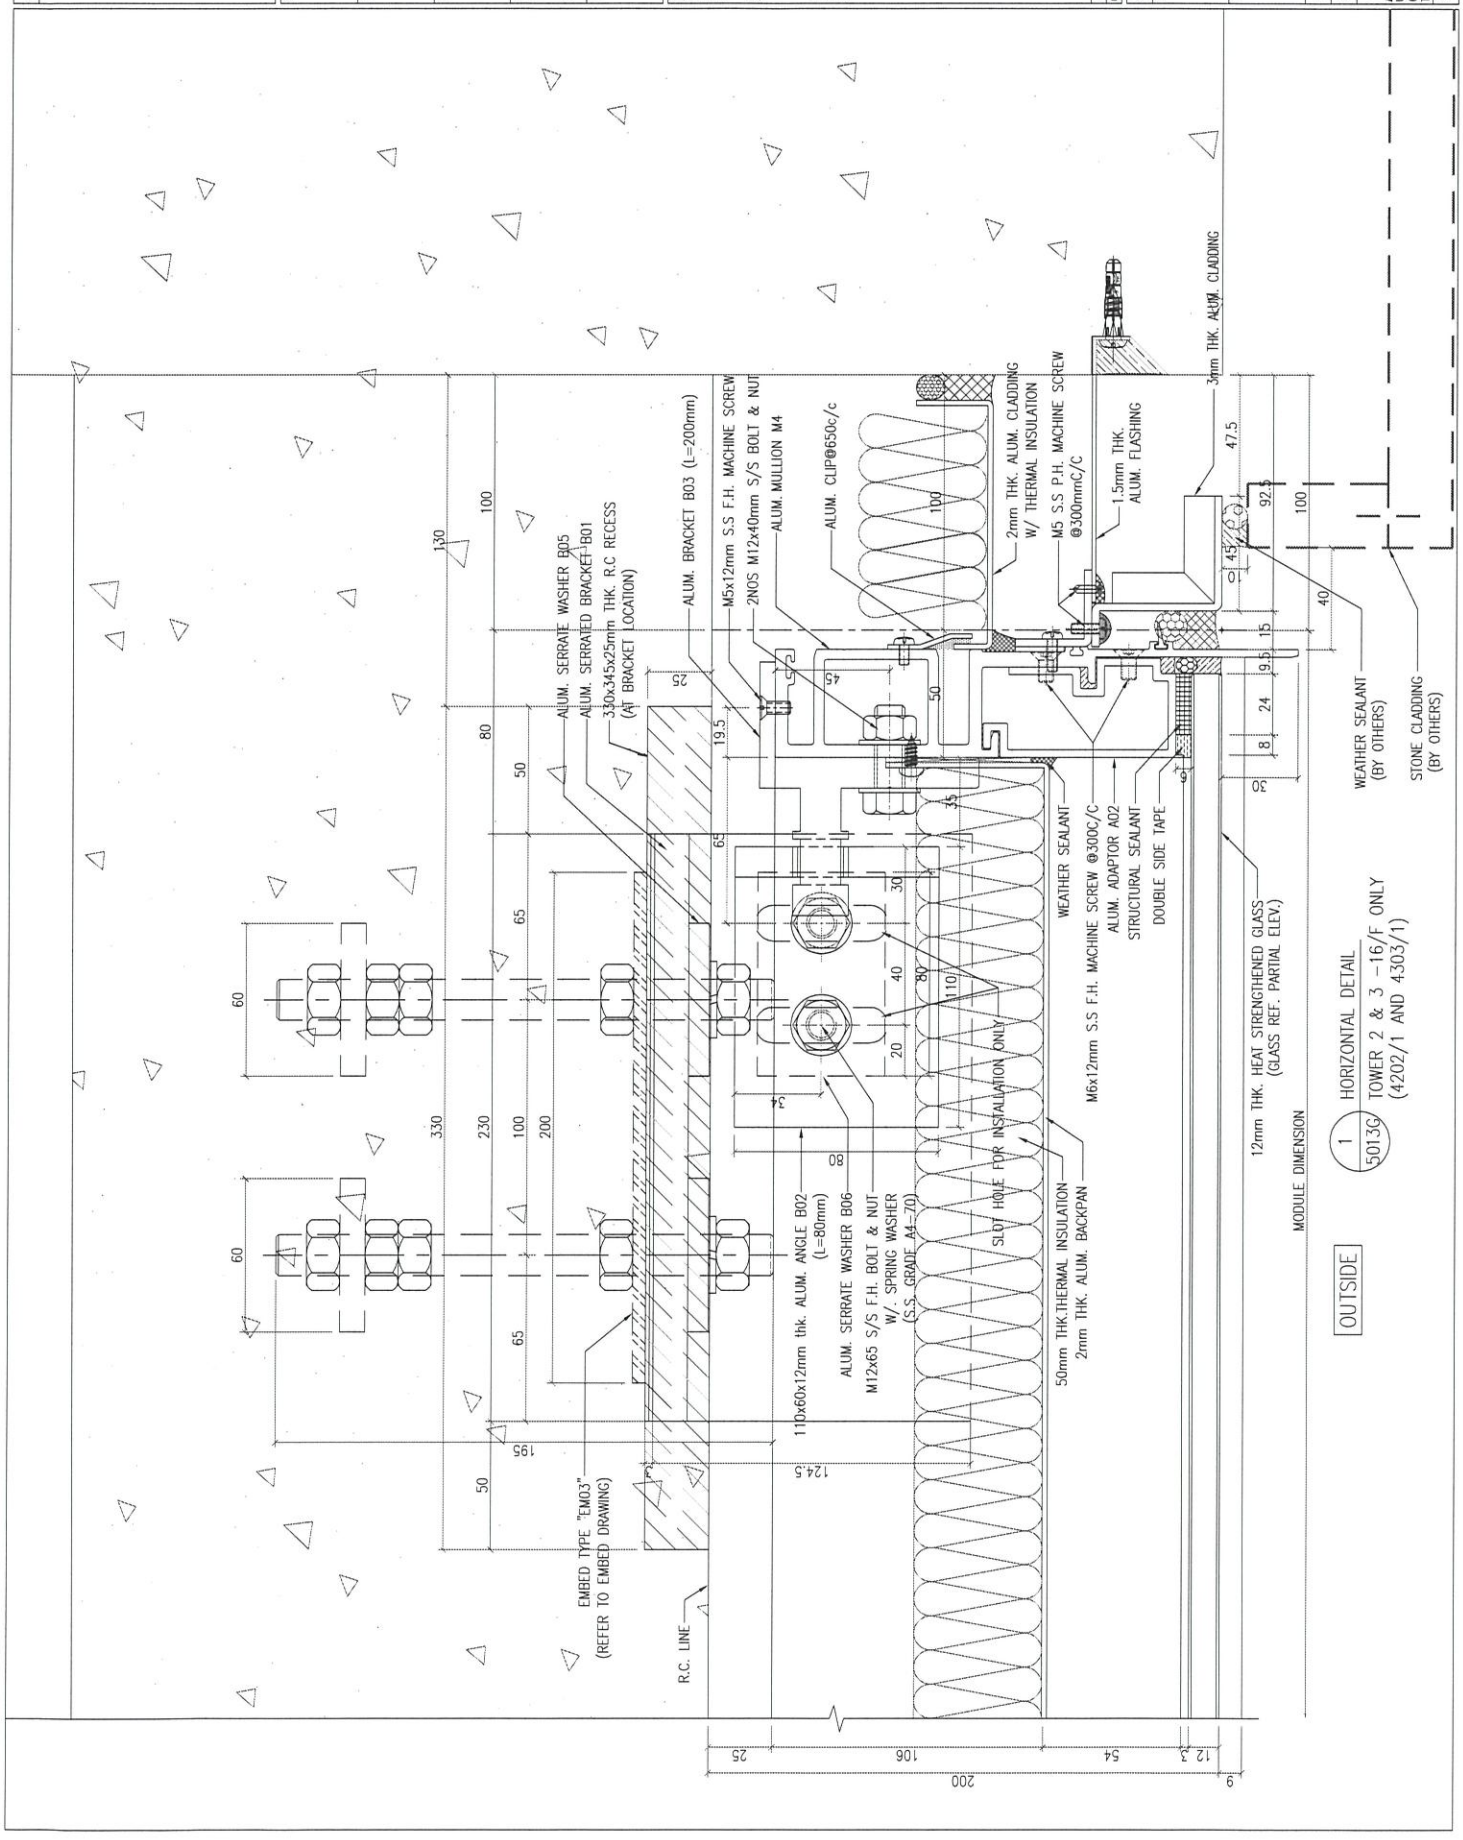

1 HORIZONTAL DETAIL
5013C
TOWER 2 & 3 -16/F ONLY
(4202/1 AND 4303/1)

OUTSIDE


MODULE DIMENSION

12mm THK. HEAT STRENGTHENED GLASS (GLASS REF. PARTIAL ELEV.)

WEATHER SEALANT (BY OTHERS)
STONE CLADDING (BY OTHERS)

B.D. REF :

CLIENT : SHIMAO GROUP HOLDINGS LIMITED ARCHITECT : YIN PING & PARTNERS LIMITED MAIN CONTRACTOR : 協興建築有限公司 SHIP HING CONSTRUCTION CO.LTD STRUCTURAL ENGINEER : ICMA C.M.WONG & ASSOCIATES LTD 黃志明建築工程師有限公司 FACADE CONSULTANT : MENYARDT	
NOTE: 1. ALL DIMENSIONS ARE IN mm. 2. ALL ELEVATIONS ARE VIEWED FROM OUTSIDE. 3. ALL DIMENSIONS TO BE VERIFIED ON SITE BEFORE FABRICATION. LEGEND: (1) DETAIL MARK NO. (2) REFER SHEET NO. 1. FEEL --- FINISHED FLOOR LEVEL. 2. SFL --- STRUCTURAL FLOOR LEVEL. 3. --- REVERSED DETAIL.	
JOB NO. : J-853 PROJECT : PROPOSED RESIDENTIAL DEVELOPMENT AT N.K.I.L. 6542 YIN PING ROAD KOWLOON TITLE : HORIZONTAL DETAIL FOR CURTAIN WALL	DATE : 20-APR-21 SCALE : 1:2 (A3) CHECKED BY : DRAWN BY : LHR DATE : 20-APR-21 SCALE : 1:2 (A3) CHECKED BY : DRAWN BY : LHR
DMC NO. : J853-SD-CW-5013J REV. : - 5013J TOWER 5-17/F~23/F (4502/1) 特銘實業有限公司 610 Che Kwo Ling Road, Kowloon Tel:22489211-4, Fax:(852)2727666	

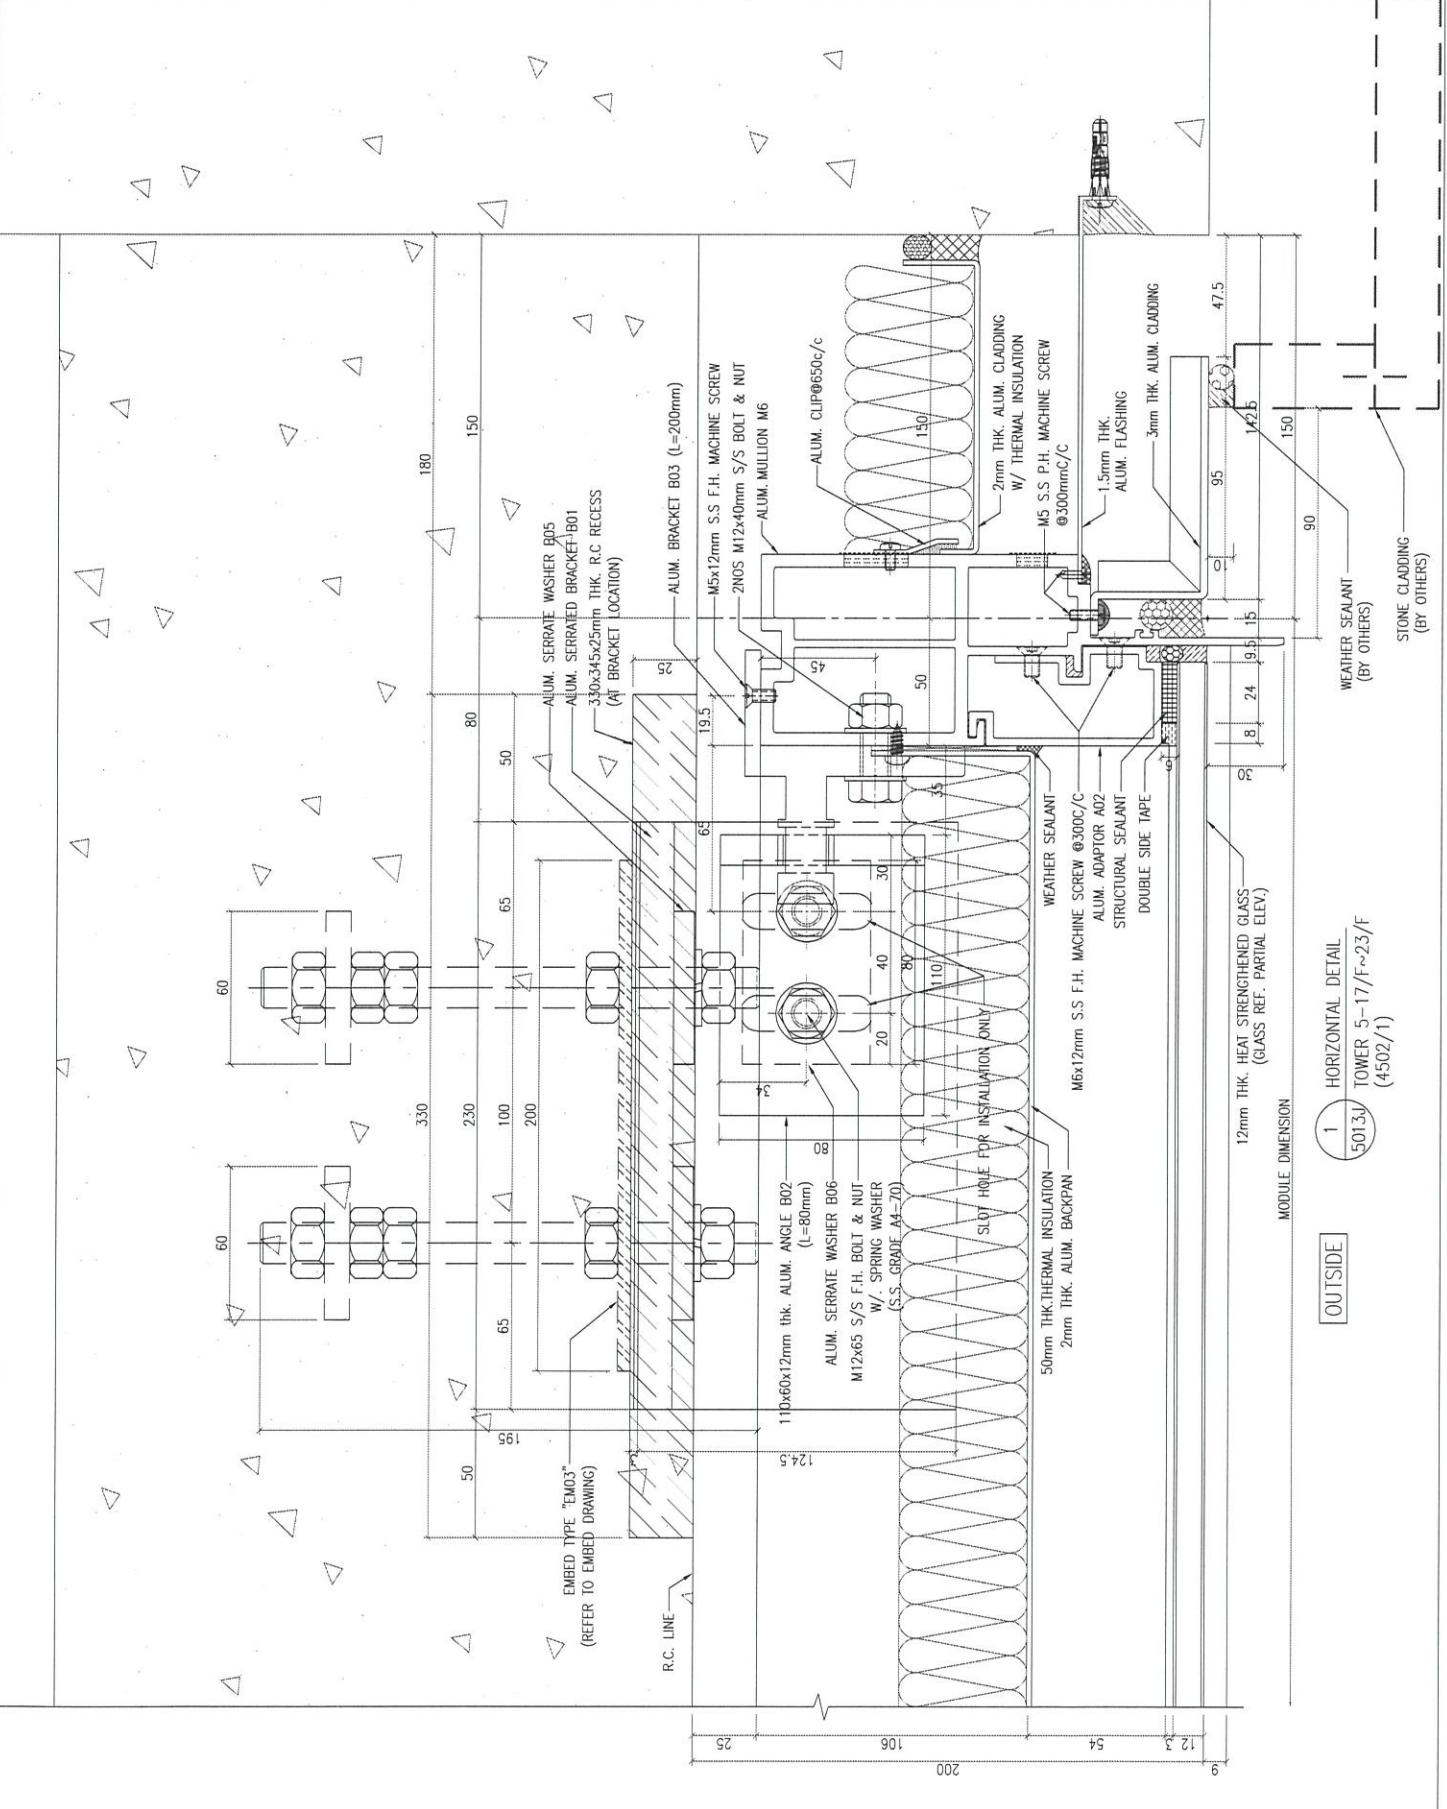

OUTSIDE

1 HORIZONTAL DETAIL
5013J TOWER 5-17/F~23/F
(4502/1)


MODULE DIMENSION

12mm THK. HEAT STRENGTHENED GLASS
(GLASS REF. PARTIAL ELEV.)

WEATHER SEALANT
(BY OTHERS)

STONE CLADDING
(BY OTHERS)

B.D. REF.:		CLIENT:	SHIMAO GROUP HOLDINGS LIMITED	ARCHITECT:	YONG TUNG & PARTNERS LIMITED ARCHITECTS & PLANNERS	MAIN CONTRACTOR:	協興建築有限公司 HIP HING CONSTRUCTION CO LTD	STRUCTURAL ENGINEER:	C.M WONG & ASSOCIATES LTD 黃志輝建築工程師有限公司	FACADE CONSULTANT:	MEINHARDT	NOTE:	1. ALL DIMENSIONS ARE IN mm. 2. ALL DIMENSIONS ARE VIEWED FROM OUTSIDE. 3. DIMENSIONS TO BE VERIFIED ON SITE BEFORE FABRICATION.	LEGEND:	DETAIL MARK NO. XT REFER SHEET NO. 1. FFL --- FINISHED FLOOR LEVEL 2. S.F.L --- STRUCTURAL FLOOR LEVEL 3. Ⓢ --- REVERSED DETAIL								
JOB NO.:	J-853	PROJECT:	PROPOSED RESIDENTIAL DEVELOPMENT AT N.K.I.L. 6542 YIN PING ROAD KOWLOON	TITLE:	HORIZONTAL DETAIL FOR CURTAIN WALL	DATE:	20-APR-21	SCALE:	1:2 (A3)	CHECKED BY:	LHR	DATE:	20-APR-21	SCALE:	1:2 (A3)	DRAWN BY:	LHR	CHECKED BY:	LHR	DWG NO.:	J853-S0-CW-5015E	REV.:	-

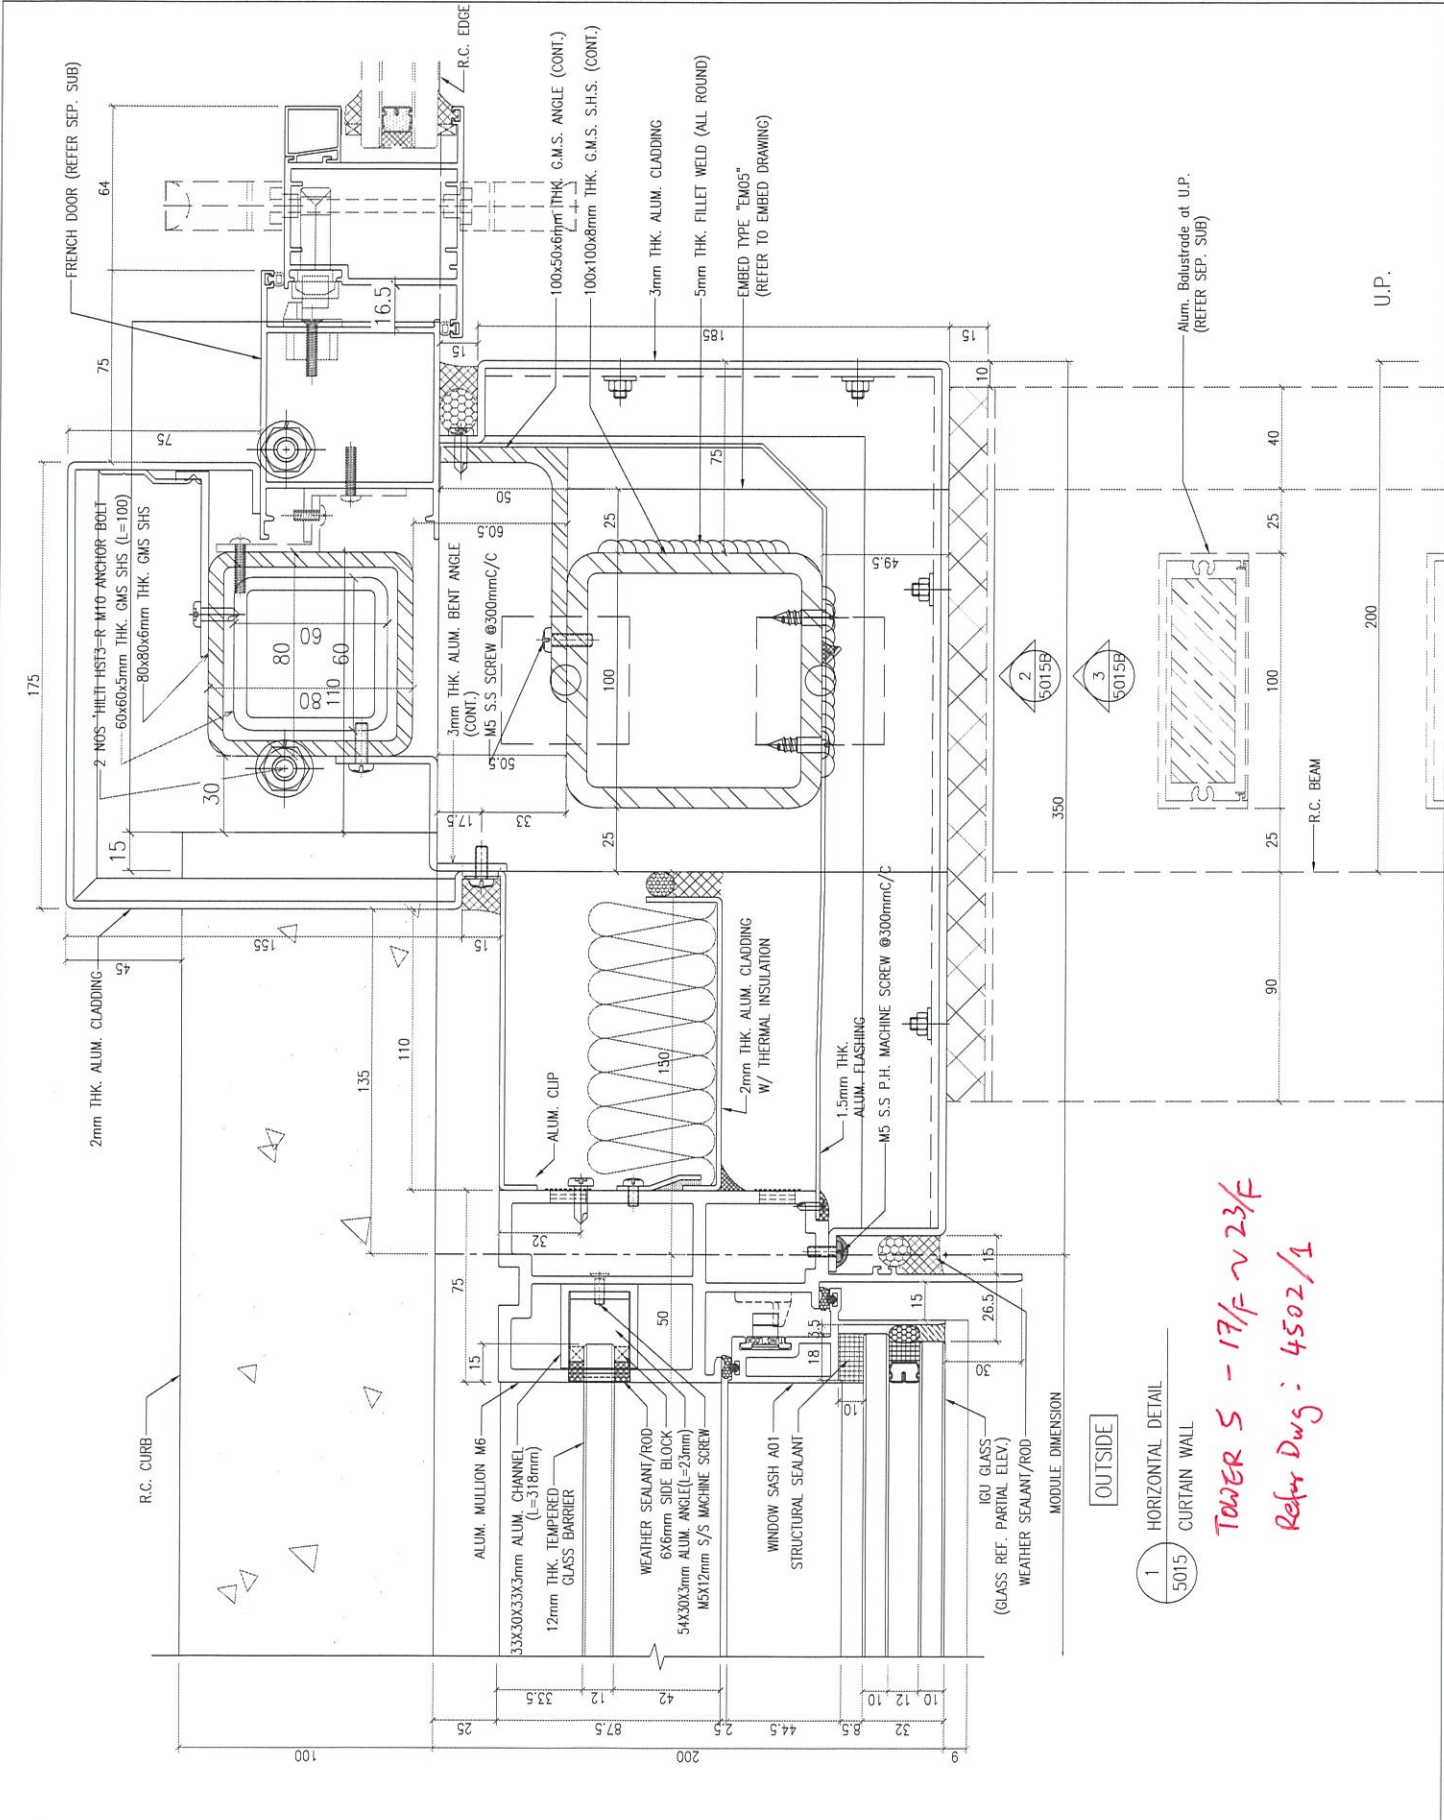

1 HORIZONTAL DETAIL
5015 CURTAIN WALL

TOWER 5 - 17/F ~ 23/F
Refer Dwg: 4502/1