



美特鋁質有限公司

MIDI ALUMINIUM FABRICATOR LTD.



工程指示 / 要求簡箋 ENGINEER INSTRUCTIONS(E.I.)

工程指示編號:	EI- 5429B	修改版本:	B
	HK- 0037		
工程編號:	J 853	工程名稱:	延坪道
收件人:	Maggie Lor/林仁安	發件人:	Adrian Tai
工程項目:	平台Window Wall 模具開模 (模圖更新)	日期:	09/01/2023

<input type="checkbox"/> 原合約工程包	<input type="checkbox"/> 原合約工程加 / 減脹 QT-	<input type="checkbox"/> 新工程報價 QT-
---------------------------------	--	------------------------------------

信件批核號碼/圖紙參考編號:	批核模具圖紙編號:
客戶指示附件:	管理內部批簽署:

<input type="checkbox"/> 初步鋁料 B.M.	<input type="checkbox"/> 加工拆圖, 然後生產	<input type="checkbox"/> 尺寸表
<input type="checkbox"/> 正式鋁料 B.M.	<input type="checkbox"/> 技術上資料/指示	<input type="checkbox"/> 報價
<input type="checkbox"/> 配件 B.M.	<input type="checkbox"/> 樣辦或貨品說明書	<input type="checkbox"/> 分判合約
<input type="checkbox"/> 其他:		

內容: 請按附件資料, 更新繪製模具(CHK 18299) X86405(B), 共一款。(附CAD檔圖一張)

完成上列要求日期: 16/01/2023

國內


<input type="checkbox"/> 生產技術總監	<input type="checkbox"/> 連附件	<input type="checkbox"/> 技術部	<input type="checkbox"/> 連附件	<input type="checkbox"/> 生產部	<input type="checkbox"/> 連附件
<input type="checkbox"/> 採購部	<input type="checkbox"/> 連附件	<input checked="" type="checkbox"/> 生產統籌部	<input checked="" type="checkbox"/> 連附件	<input type="checkbox"/> 報關組	<input type="checkbox"/> 連附件
<input type="checkbox"/> 質檢部	<input type="checkbox"/> 連附件	<input type="checkbox"/> 會計部	<input type="checkbox"/> 連附件	<input type="checkbox"/> 機械設計部	<input type="checkbox"/> 連附件
<input checked="" type="checkbox"/> 香港辦	<input checked="" type="checkbox"/> 連附件	<input type="checkbox"/> 其他:			

香港

<input type="checkbox"/> 行政部	<input type="checkbox"/> 連附件	<input type="checkbox"/> 會計部	<input type="checkbox"/> 連附件	<input type="checkbox"/> 統籌部	<input type="checkbox"/> 連附件	<input type="checkbox"/> 工程部	<input type="checkbox"/> 連附件
<input type="checkbox"/> 採購部	<input type="checkbox"/> 連附件	<input type="checkbox"/> QS部	<input type="checkbox"/> 連附件	<input type="checkbox"/> 地盤管理	<input type="checkbox"/> 連附件	<input type="checkbox"/> 維修部	<input type="checkbox"/> 連附件

*發件人簽署: Adrian Tai	*組別成員批核簽署:
傳遞編號:	項目經理簽署:

CUSTOMER	CUSTOMER APPROVAL	CUST PART NO.	PAF-01
		SECTION NO.	X86405 (B)
			ALUM. FEATURE 01

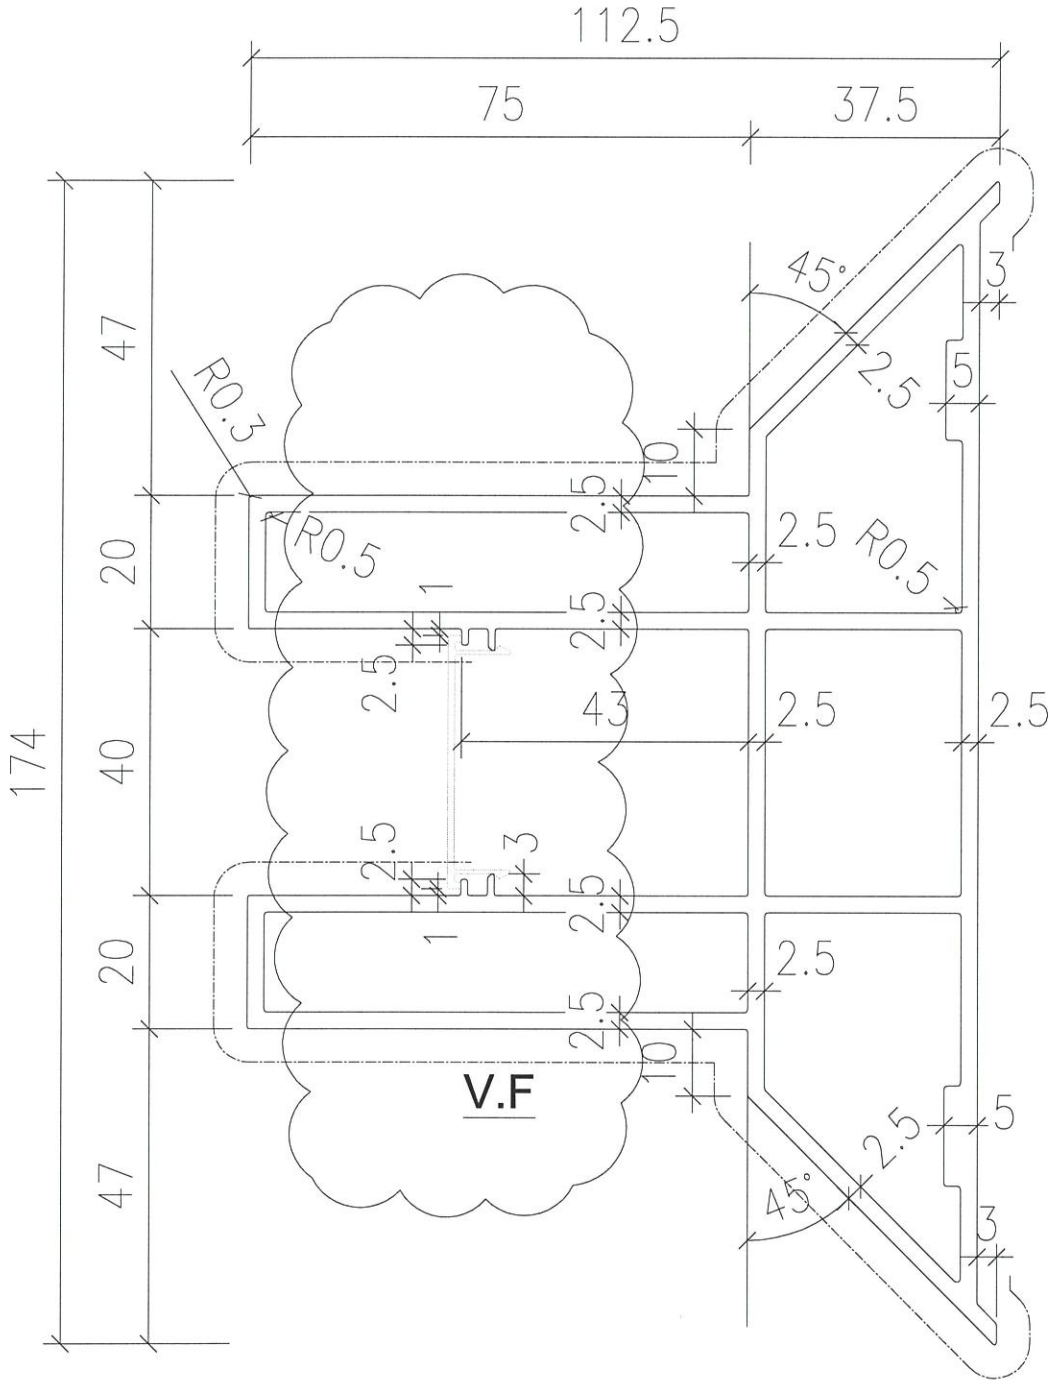

美特鋁質有限公司
承認圖面
日期 09/01/2023

SIGNATURE GRADEING	HIGH SIGNATURE GRADEING	C.C.DIA(MM)	Ø208					
AREA (SQ MM)	1959.29	UNSPECIFIED THICKNESS	PERIMETER (MM)	693.66	STANDARD	SCALE		1:1
MASS (KG/M)	5.310	UNSPECIFIED CORNERS	SURFACE AREA	528.08	ALLOY	6063-T6	VERSION	
COMPANY ISSUE		DRAWN	L	DATE	2021-06-22	APPELLATION		PAGE OF
		STANDARDIZATION		DATE				
		TO SIGN		DATE				
		AUDITING		DATE				
MODIFY FILE NO		SIGNATURE	DATE	APPROV				

 美特鋁質有限公司
MIDI Aluminium Fabricator Ltd.