



工程指示 / 要求簡箋 ENGINEER INSTRUCTIONS(E.I.)

工程指示編號:	EI- 5450 <i>A</i>	修改版本:	<i>A</i>
	HK- 2209		
工程編號:	J 853	工程名稱:	NKIL6542
收件人:	生統	發件人:	BearLam
工程項目:	T1-T7 旭格趟門底Z字型碼 <i>(修訂A: 確認材質及數量)</i>	日期:	09/12/2022

<input type="checkbox"/> 原合約工程包	<input type="checkbox"/> 原合約工程加 / 減賬 QT-	<input type="checkbox"/> 新工程報價 QT-
---------------------------------	--	------------------------------------

信件批核號碼/圖紙參考編號:	批核模具圖紙編號:
客戶指示附件:	管理內部批簽署:

<input type="checkbox"/> 初步鋁料 B.M.	<input type="checkbox"/> 加工拆圖, 然後生產	<input type="checkbox"/> 尺寸表
<input type="checkbox"/> 正式鋁料 B.M.	<input type="checkbox"/> 技術上資料/指示	<input type="checkbox"/> 報價
<input type="checkbox"/> 配件 B.M.	<input type="checkbox"/> 樣辦或貨品說明書	<input type="checkbox"/> 分判合約
<input type="checkbox"/> 其他:		

內容: 請根據附件資料在倉庫中尋求有沒有相近的設計庫存, 如沒有請安排生產, 請安排有關同事進行事前試裝/測試, 以便影響地盤的進度。

*修訂A: 確認材質=1.5mm厚GMS鉄板, 數量共8300隻*

完成上列要求日期: 10/12/2022



國內

<input type="checkbox"/> 生產技術總監	<input type="checkbox"/> 連附件	<input type="checkbox"/> 技術部	<input type="checkbox"/> 連附件	<input type="checkbox"/> 生產部	<input type="checkbox"/> 連附件
<input type="checkbox"/> 採購部	<input type="checkbox"/> 連附件	<input checked="" type="checkbox"/> 生產統籌部	<input checked="" type="checkbox"/> 連附件	<input type="checkbox"/> 報關組	<input type="checkbox"/> 連附件
<input checked="" type="checkbox"/> 質檢部	<input checked="" type="checkbox"/> 連附件	<input type="checkbox"/> 會計部	<input type="checkbox"/> 連附件	<input type="checkbox"/> 機械設計部	<input type="checkbox"/> 連附件
<input checked="" type="checkbox"/> 香港辦	<input checked="" type="checkbox"/> 連附件	<input checked="" type="checkbox"/> 其他: 轉少			

香港

<input type="checkbox"/> 行政部	<input type="checkbox"/> 連附件	<input type="checkbox"/> 會計部	<input type="checkbox"/> 連附件	<input type="checkbox"/> 統籌部	<input type="checkbox"/> 連附件	<input type="checkbox"/> 工程部	<input type="checkbox"/> 連附件
<input type="checkbox"/> 採購部	<input type="checkbox"/> 連附件	<input type="checkbox"/> QS部	<input type="checkbox"/> 連附件	<input type="checkbox"/> 地盤管理	<input type="checkbox"/> 連附件	<input type="checkbox"/> 維修部	<input type="checkbox"/> 連附件

*發件人簽署:	<i>Bear Lam</i>	*組別成員批核簽署:	<i>[Signature]</i>
傳遞編號:		項目經理簽署:	<i>[Signature]</i>

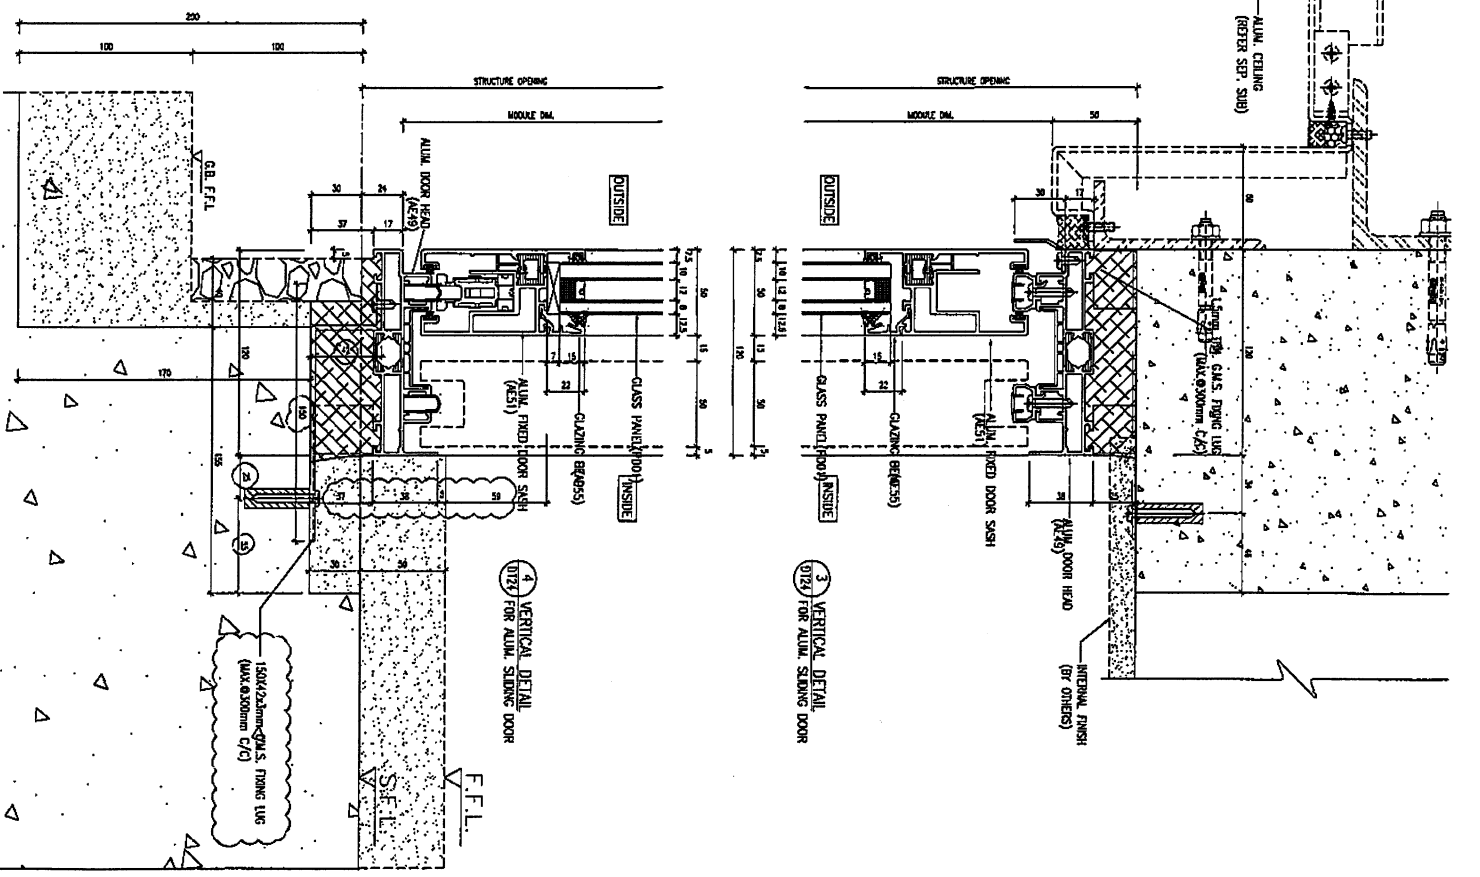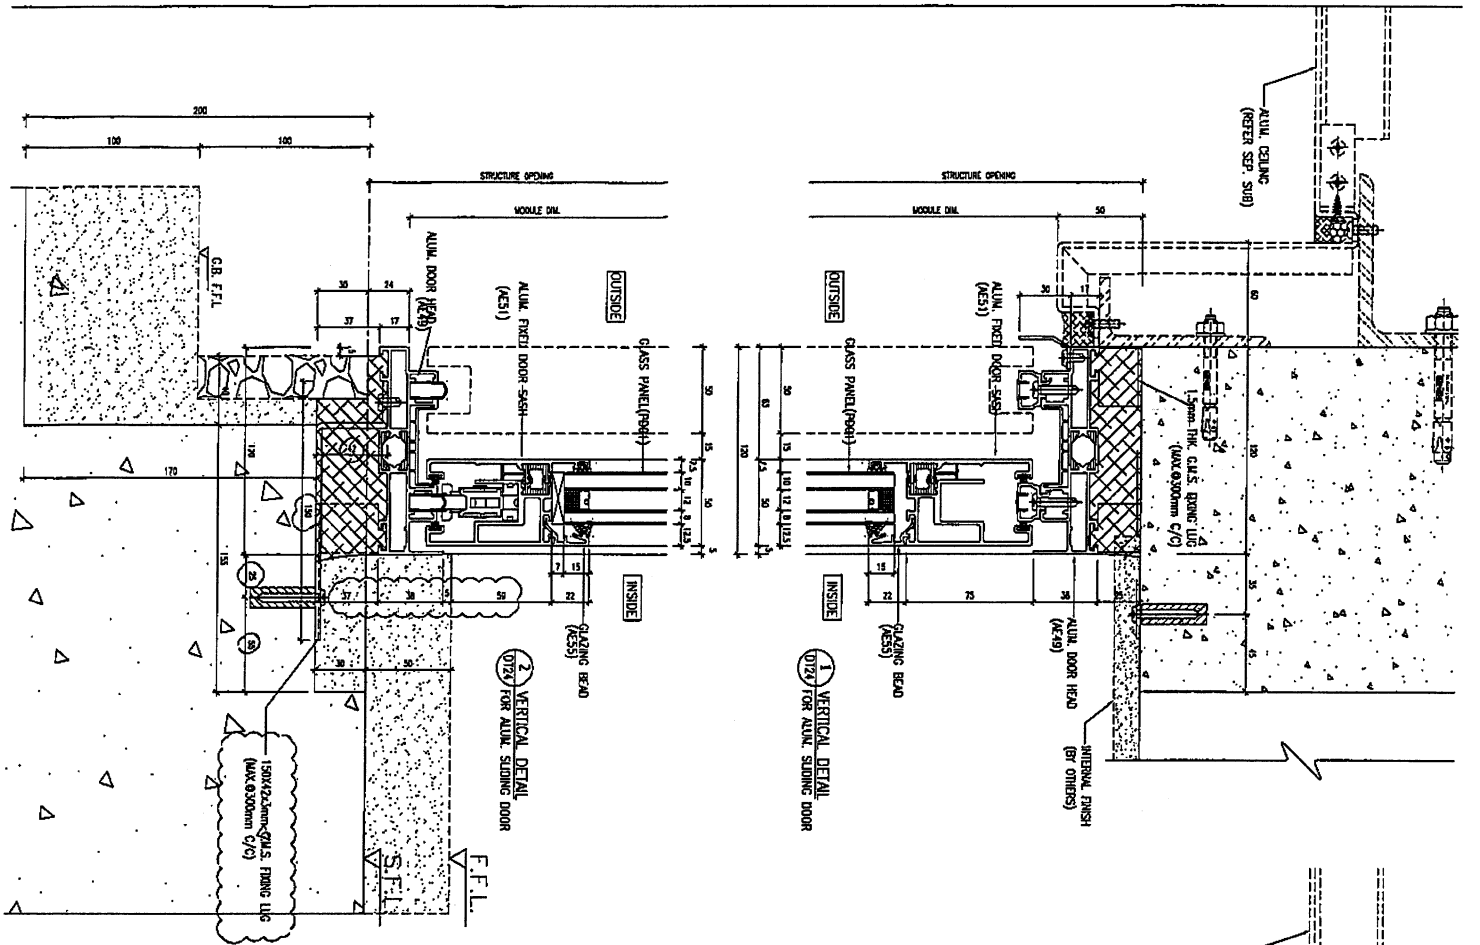

**B.L. REF :**

**CLIENT :**  
SHIMAO GROUP HOLDINGS LIMITED

**ARCHITECT :**  
C.M. WONG & ASSOCIATES LTD  
HIP HING CONSTRUCTION CO LTD

**MAIN CONTRACTOR :**  
協興建築有限公司  
HIP HING CONSTRUCTION CO LTD

**STRUCTURAL ENGINEER :**  
C.M. WONG & ASSOCIATES LTD  
黃志明建築工程師有限公司

**FACE CONSULTANT :**  
MENYHARDT

**DATE :**  
1. ALL DIMENSIONS ARE IN mm.  
2. ALL DIMENSIONS ARE VERIFIED FROM OUTSIDE.  
3. ALL DIMENSIONS TO BE VERIFIED ON SITE BEFORE PROCEEDING.

**LEGEND :**

1. F.F.L. - FINISHED FLOOR LEVEL  
2. S.F.L. - STRUCTURE FLOOR LEVEL  
3. P. - PROPOSED FINISH  
4. A. - FINISH LOCATION  
5. A. - FINISH LOC COORDINATE  
6. CLASS LEGEND

Q101 - 10mm x 12mm AG CP#110mm THK. LSLU  
Q105 - 10mm x 12mm AG CP#110mm THK. LSLU  
Q106 - 10mm x 12mm THK. TP  
Q107 - 10mm x 12mm AG CP#120mm THK. LSLU  
Q108 - 10mm x 12mm AG CP#120mm THK. LSLU  
Q109 - 10mm x 12mm AG CP#110mm THK. LSLU

NO.	REV.	DESCRIPTION	DATE
1	1	ISSUED FOR TENDER	17/07/2021
2	2	REVISED TO REFLECT CHANGES	18/07/2021
3	3	REVISED TO REFLECT CHANGES	19/07/2021

**JOB NO. :** J-MS3

**PROJECT :**  
PROPOSED RESIDENTIAL DEVELOPMENT AT N.K.L.L. 6512 YAN PING ROAD KOWLOON

**TITLE :**  
TYPICAL DETAILS FOR SLIDING DOOR

**DATE :** 03-07-21 **SCALE :** 1:3 (A3)

**DRAWN BY :** A.C. **CHECKED BY :**

**MEYHARDT**  
11th Floor, 51 MIDLAND AVENUE, YAU COI CENTRE, 11/F  
810 Cheong Chee Road, #04-01/02, Singapore 469011  
Tel: +65 6339 2272  
Fax: +65 6339 2277

**MEYHARDT**  
11th Floor, 51 MIDLAND AVENUE, YAU COI CENTRE, 11/F  
810 Cheong Chee Road, #04-01/02, Singapore 469011  
Tel: +65 6339 2272  
Fax: +65 6339 2277

S.D. REF :

CLIENT : SHIMAO GROUP HOLDINGS LIMITED

ARCHITECT : YONG TUNG & PARTNERS LIMITED



MAIN CONTRACTOR : 昆利建築有限公司  
HIP HING CONSTRUCTION CO LTD

STRUCTURAL ENGINEER : CMA  
C.M. WONG & ASSOCIATES LTD  
昆明地產建築師有限公司

ENGINE CONSULTING




NOTE :

1. ALL DIMENSIONS ARE IN MM.
2. ALL ELEVATIONS ARE VIEWED FROM OUTSIDE.
3. ALL DIMENSIONS TO BE VERIFIED ON SITE BEFORE FABRICATION.

LEGEND :

- ① DETAIL NAME NO.  
② REFER SHEET NO.
1. F.F.L. — FINISHED FLOOR LEVEL.
  2. S.F.L. — STRUCTURAL FLOOR LEVEL.
  3. Ⓞ — ROUNDED CORNER.
  4. △ — POINT LOCATION.
  5. CLASS LEGEND FOR LUG LOCATION
  6. CLASS LEGEND FOR LUG LOCATION
- CL01 — 10mm x 12mm AIR CPT-10mm THK. I.C.L.L.  
 CL02 — 10mm x 12mm AIR CPT-10mm THK. I.C.L.L.  
 CL03 — 10mm x 12mm AIR CPT-10mm THK. I.C.L.L.  
 CL04 — 12mm THK. T.P.  
 CL05 — 10mm x 12mm AIR CPT-10mm THK. I.C.L.L.  
 CL06 — 10mm x 12mm AIR CPT-10mm THK. I.C.L.L.  
 PP01 — 10mm T.P. x 12mm AIR CPT-10mm T.P.  
 CL07 — 10mm x 12mm AIR CPT-10mm THK. I.C.L.L.  
 CL08 — 10mm x 12mm AIR CPT-10mm THK. I.C.L.L.

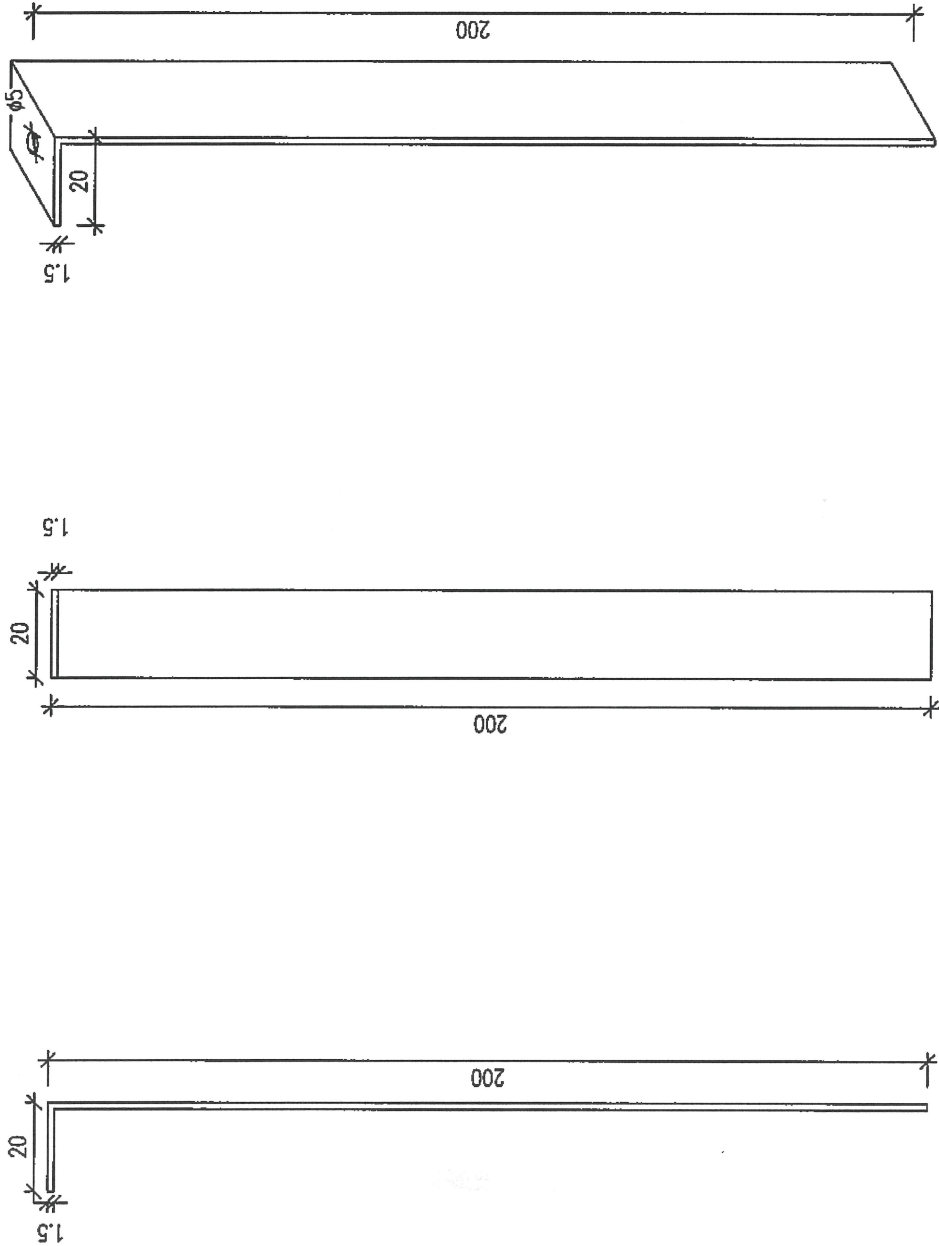

③ PERSPECTIVE

② DETAIL SECTION

① DETAIL SECTION

A: 用1.5mm全數增加GMS

JOB NO. :	4-853
PROJECT :	PROPOSED RESIDENTIAL DEVELOPMENT AT N.K.111, 65-42 YIM PING ROAD, KOWLOON
TITLE :	DEMO DETAILS FOR FINING LUG
DATE :	03-OCT-22
SCALE :	1 : 3 (A3)
DRAWN BY :	A.C.
CHECKED BY :	
DATE :	
REV. NO. :	

昆利建築有限公司  
 Hip Hing Construction Co., Ltd.  
 610 Cheong Cheong Street, Kowloon  
 Tel: 25250611-4 Fax: 2525177005