



工程指示 / 要求簡箋 ENGINEER INSTRUCTIONS(E.I.)

工程指示編號:	EI- 5450	修改版本:	-
	HK- 2204		
工程編號:	J 853	工程名稱:	NKIL6542
收件人:	生統	發件人:	BearLam
工程項目:	T1-T7 旭格趟門底Z字型碼	日期:	09/12/2022

<input type="checkbox"/> 原合約工程包	<input type="checkbox"/> 原合約工程加 / 減賬 QT-	<input type="checkbox"/> 新工程報價 QT-
---------------------------------	--	------------------------------------

信件批核號碼/圖紙參考編號:	批核模具圖紙編號:
客戶指示附件:	管理內部批簽署:

<input type="checkbox"/> 初步鋁料 B.M.	<input type="checkbox"/> 加工拆圖, 然後生產	<input type="checkbox"/> 尺寸表
<input type="checkbox"/> 正式鋁料 B.M.	<input type="checkbox"/> 技術上資料/指示	<input type="checkbox"/> 報價
<input type="checkbox"/> 配件 B.M.	<input type="checkbox"/> 樣辦或貨品說明書	<input type="checkbox"/> 分判合約
<input type="checkbox"/> 其他:		

內容: 請根據附件資料在倉庫中尋求有沒有相近的設計庫存, 如沒有請安排生產, 請安排有關同事進行事前試裝/測試, 以便影響地盤的進度。

完成上列要求日期: 10/12/2022



國內

<input type="checkbox"/> 生產技術總監	<input type="checkbox"/> 連附件	<input type="checkbox"/> 技術部	<input type="checkbox"/> 連附件	<input type="checkbox"/> 生產部	<input type="checkbox"/> 連附件
<input type="checkbox"/> 採購部	<input type="checkbox"/> 連附件	<input checked="" type="checkbox"/> 生產統籌部	<input checked="" type="checkbox"/> 連附件	<input type="checkbox"/> 報關組	<input type="checkbox"/> 連附件
<input checked="" type="checkbox"/> 質檢部	<input checked="" type="checkbox"/> 連附件	<input type="checkbox"/> 會計部	<input type="checkbox"/> 連附件	<input type="checkbox"/> 機械設計部	<input type="checkbox"/> 連附件
<input checked="" type="checkbox"/> 香港辦	<input checked="" type="checkbox"/> 連附件	<input checked="" type="checkbox"/> 其他: 峰少			


香港

<input type="checkbox"/> 行政部	<input type="checkbox"/> 連附件	<input type="checkbox"/> 會計部	<input type="checkbox"/> 連附件	<input type="checkbox"/> 統籌部	<input type="checkbox"/> 連附件	<input type="checkbox"/> 工程部	<input type="checkbox"/> 連附件
<input type="checkbox"/> 採購部	<input type="checkbox"/> 連附件	<input type="checkbox"/> QS部	<input type="checkbox"/> 連附件	<input type="checkbox"/> 地盤管理	<input type="checkbox"/> 連附件	<input type="checkbox"/> 維修部	<input type="checkbox"/> 連附件


*發件人簽署:	<i>Bear Lam</i>	*組別成員批核簽署:	
傳遞編號:		項目經理簽署:	

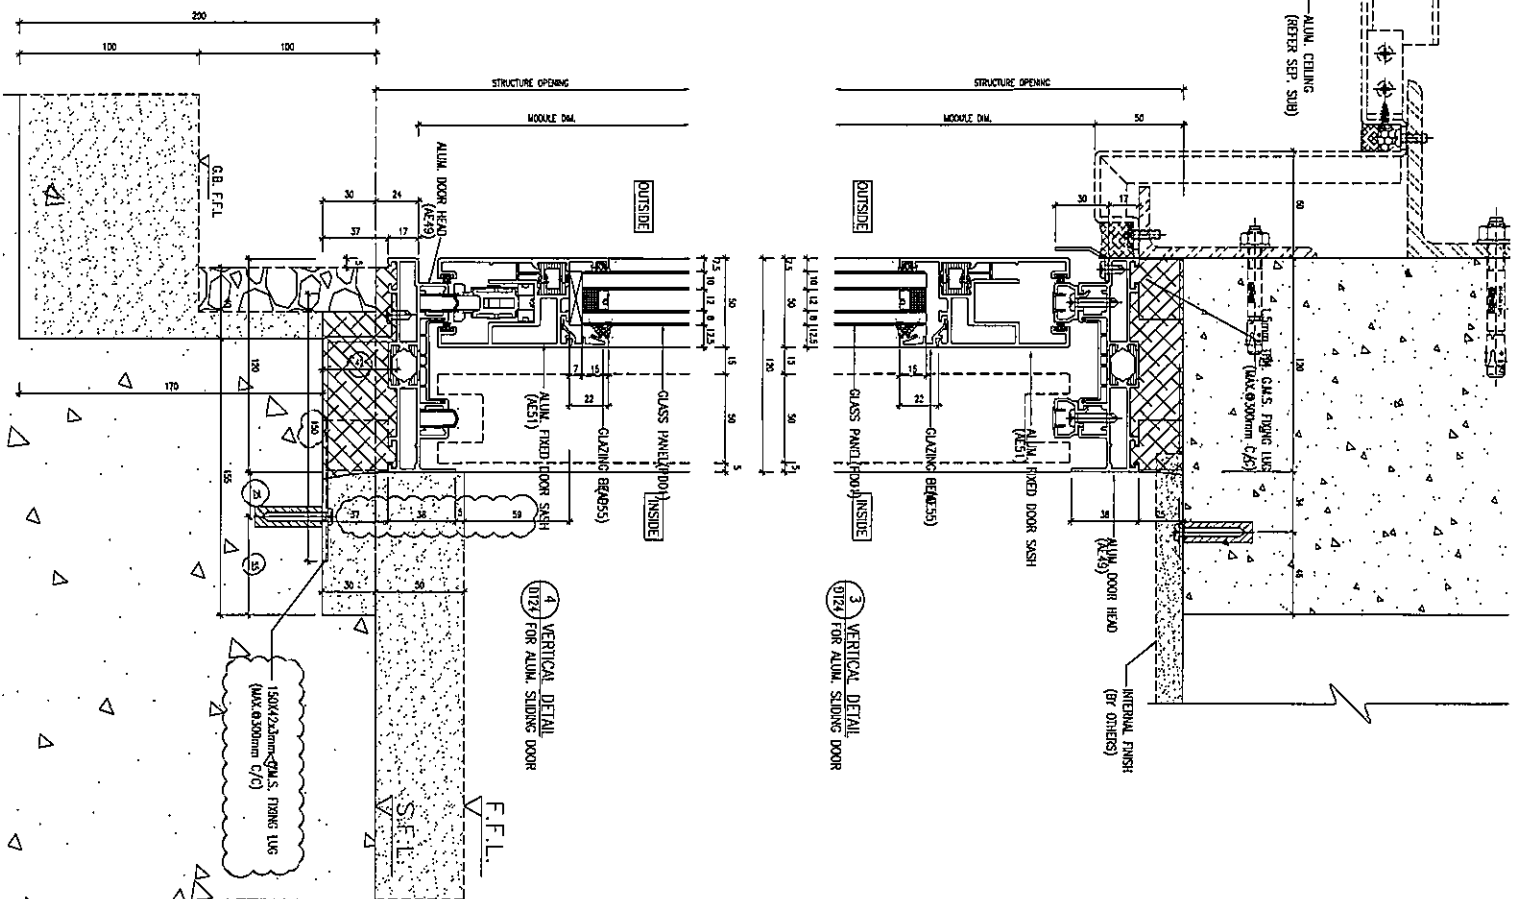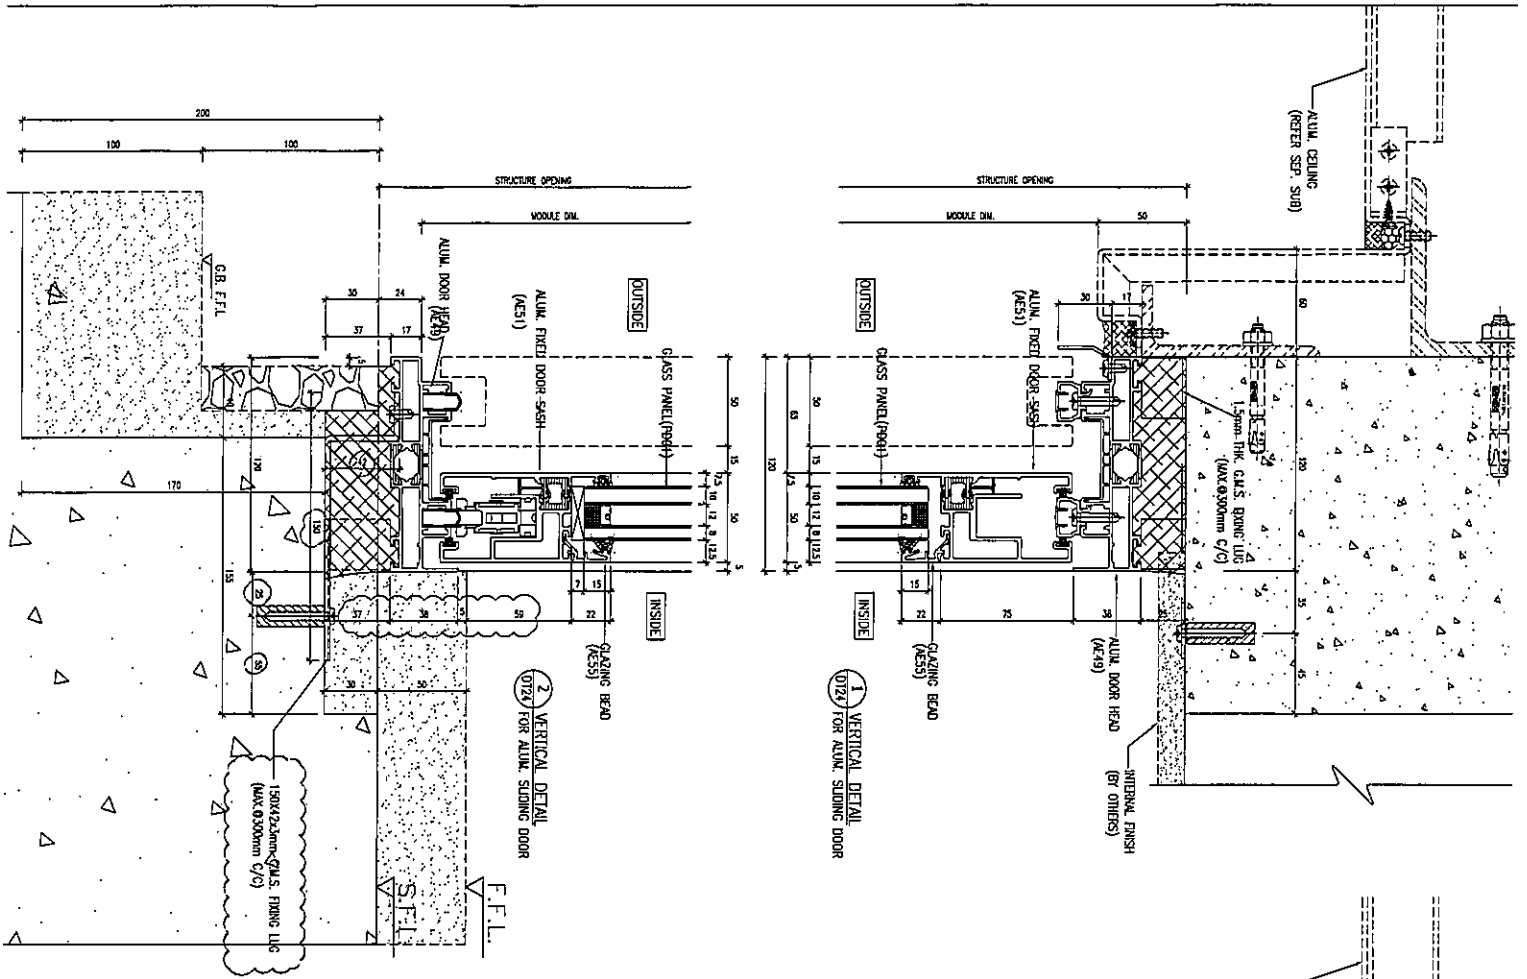


BLD. REF. : CLIENT : SHIMAO GROUP HOLDINGS LIMITED ARCHITECT : WFP ARCHITECTS & ENGINEERS LIMITED MAIN CONTRACTOR : 協興建築有限公司 PWP HING CONSTRUCTION CO. LTD STRUCTURAL ENGINEER : CMA C.M.WONG & ASSOCIATES LTD 黃志明建築工程師有限公司 FACADE CONSULTANT : WEINHARDT	
NOTE : 1. ALL DIMENSIONS ARE IN MM. 2. ALL DIMENSIONS ARE VIEWED FROM COURSE BEFORE FABRICATION. LEGEND : (A/E) DETAIL WORK NO. (P/04) REFER SHEET NO.	
1. F.F.L. — FINISHED FLOOR LEVEL 2. S.F.L. — STRUCTURAL FLOOR LEVEL 3. — REVERSED DIMEN. 4. ▲ — IRONING LOCATION 5. ▲ — IRONING LUG LOCATION 6. GLASS HEADS Q101 — 10mmx12mm AG CP+10mm THK. LG.LU. Q102 — 10mmx12mm AG CP+10mm THK. LG.LU. Q103 — 10mmx12mm AG CP+10mm THK. LG.LU. Q104 — 10mmx12mm AG CP+10mm THK. LG.LU. Q105 — 10mmx12mm AG CP+10mm THK. LG.LU. Q106 — 10mmx12mm AG CP+10mm THK. LG.LU. Q107 — 10mmx12mm AG CP+10mm THK. LG.LU. Q108 — 10mmx12mm AG CP+10mm THK. LG.LU.	
DATE : 21/07/2022 BY : A.C. DATE : 19/07/2022 BY : A.C.	DATE : 21/07/2022 BY : A.C. DATE : 19/07/2022 BY : A.C.
JOB NO. : J-853 PROJECT : PROPOSED RESIDENTIAL DEVELOPMENT AT K.K.LL 6542 YIN PING ROAD KOWLOON TITLE : TYPICAL DETAILS FOR SLIDING DOOR DATE : 01-APR-21 SCALE : 1 : 3 (A3) DRWING BY : A.C. CHECKED BY :	
COMPANY : 美特鋁業有限公司 MIDT Aluminium Fabrication Sdn. Bhd. 610 Che Koo Ling Road, Kowloon HK23489211-4 Tel: (852) 27277655 DMS NO. : J853-SO-W-0724 REV. : D	

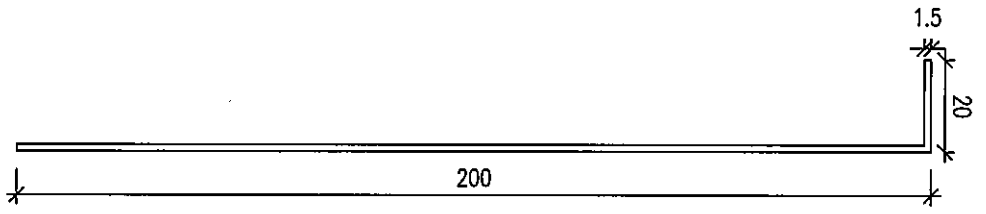

1- DETAIL SECTION

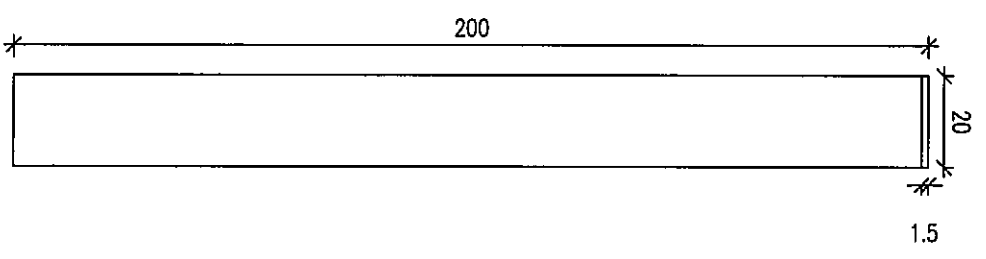

2- DETAIL SECTION

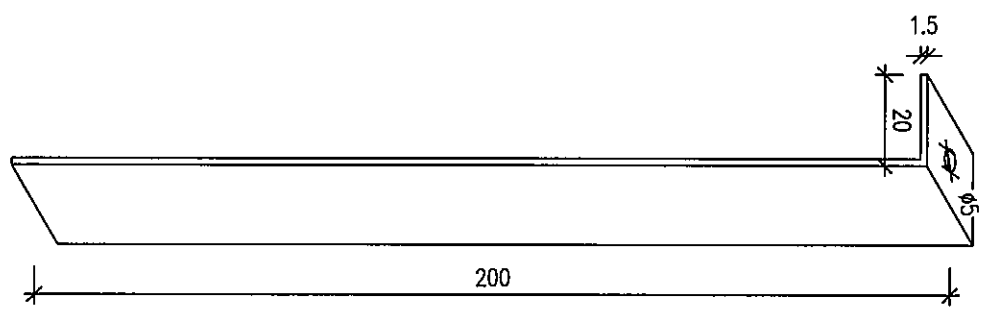

3- PERSPECTIVE

BA. REF :

CLIENT :
SHIMAO GROUP
HOLDINGS LIMITED

ARCHITECT :
YIM HING & PARTNERS LIMITED
YH

MAIN CONTRACTOR :
亞興建築有限公司
YIP HING CONSTRUCTION CO. LTD.

STRUCTURAL ENGINEER :
CMA CHANONG & ASSOCIATES LTD
223 號 德輔道中 11 樓 1101 室

PROJECT CONSULTING :
WENHART

NOTE :
1. ALL DIMENSIONS ARE IN mm.
2. ALL ELEVATIONS ARE VIEWED FROM OUTSIDE.
3. ALL DIMENSIONS TO BE VIEWED ON SITE.
GENERAL INFORMATION.

LEGEND :
1. FEEL - FINISHED FLOOR LEVEL
2. SFC - FINISHED FLOOR LEVEL
3. SFC - FINISHED FLOOR LEVEL
4. ▲ - FINISH LINE LOCATION
5. 2.000 - FINISH LINE LOCATION
6. 2.000 - FINISH LINE LOCATION

JOB NO. : J-553	PROJECT : PROPOSED RESIDENTIAL DEVELOPMENT AT N.K.L.L. 6542 YIN HING ROAD KOWLOON
DATE : 03-OCT-22	SCALE : 1 : 3 (AS)
DRAWN BY : A.C.	CHECKED BY :
<p>YIM HING & PARTNERS LIMITED 11/F, 223 DEFOU ROAD, KOWLOON TEL: 24268111 FAX: 24272778</p>	
REV. NO. : -	REV. : -