


浴室只
有一個
SECTION
DETAIL

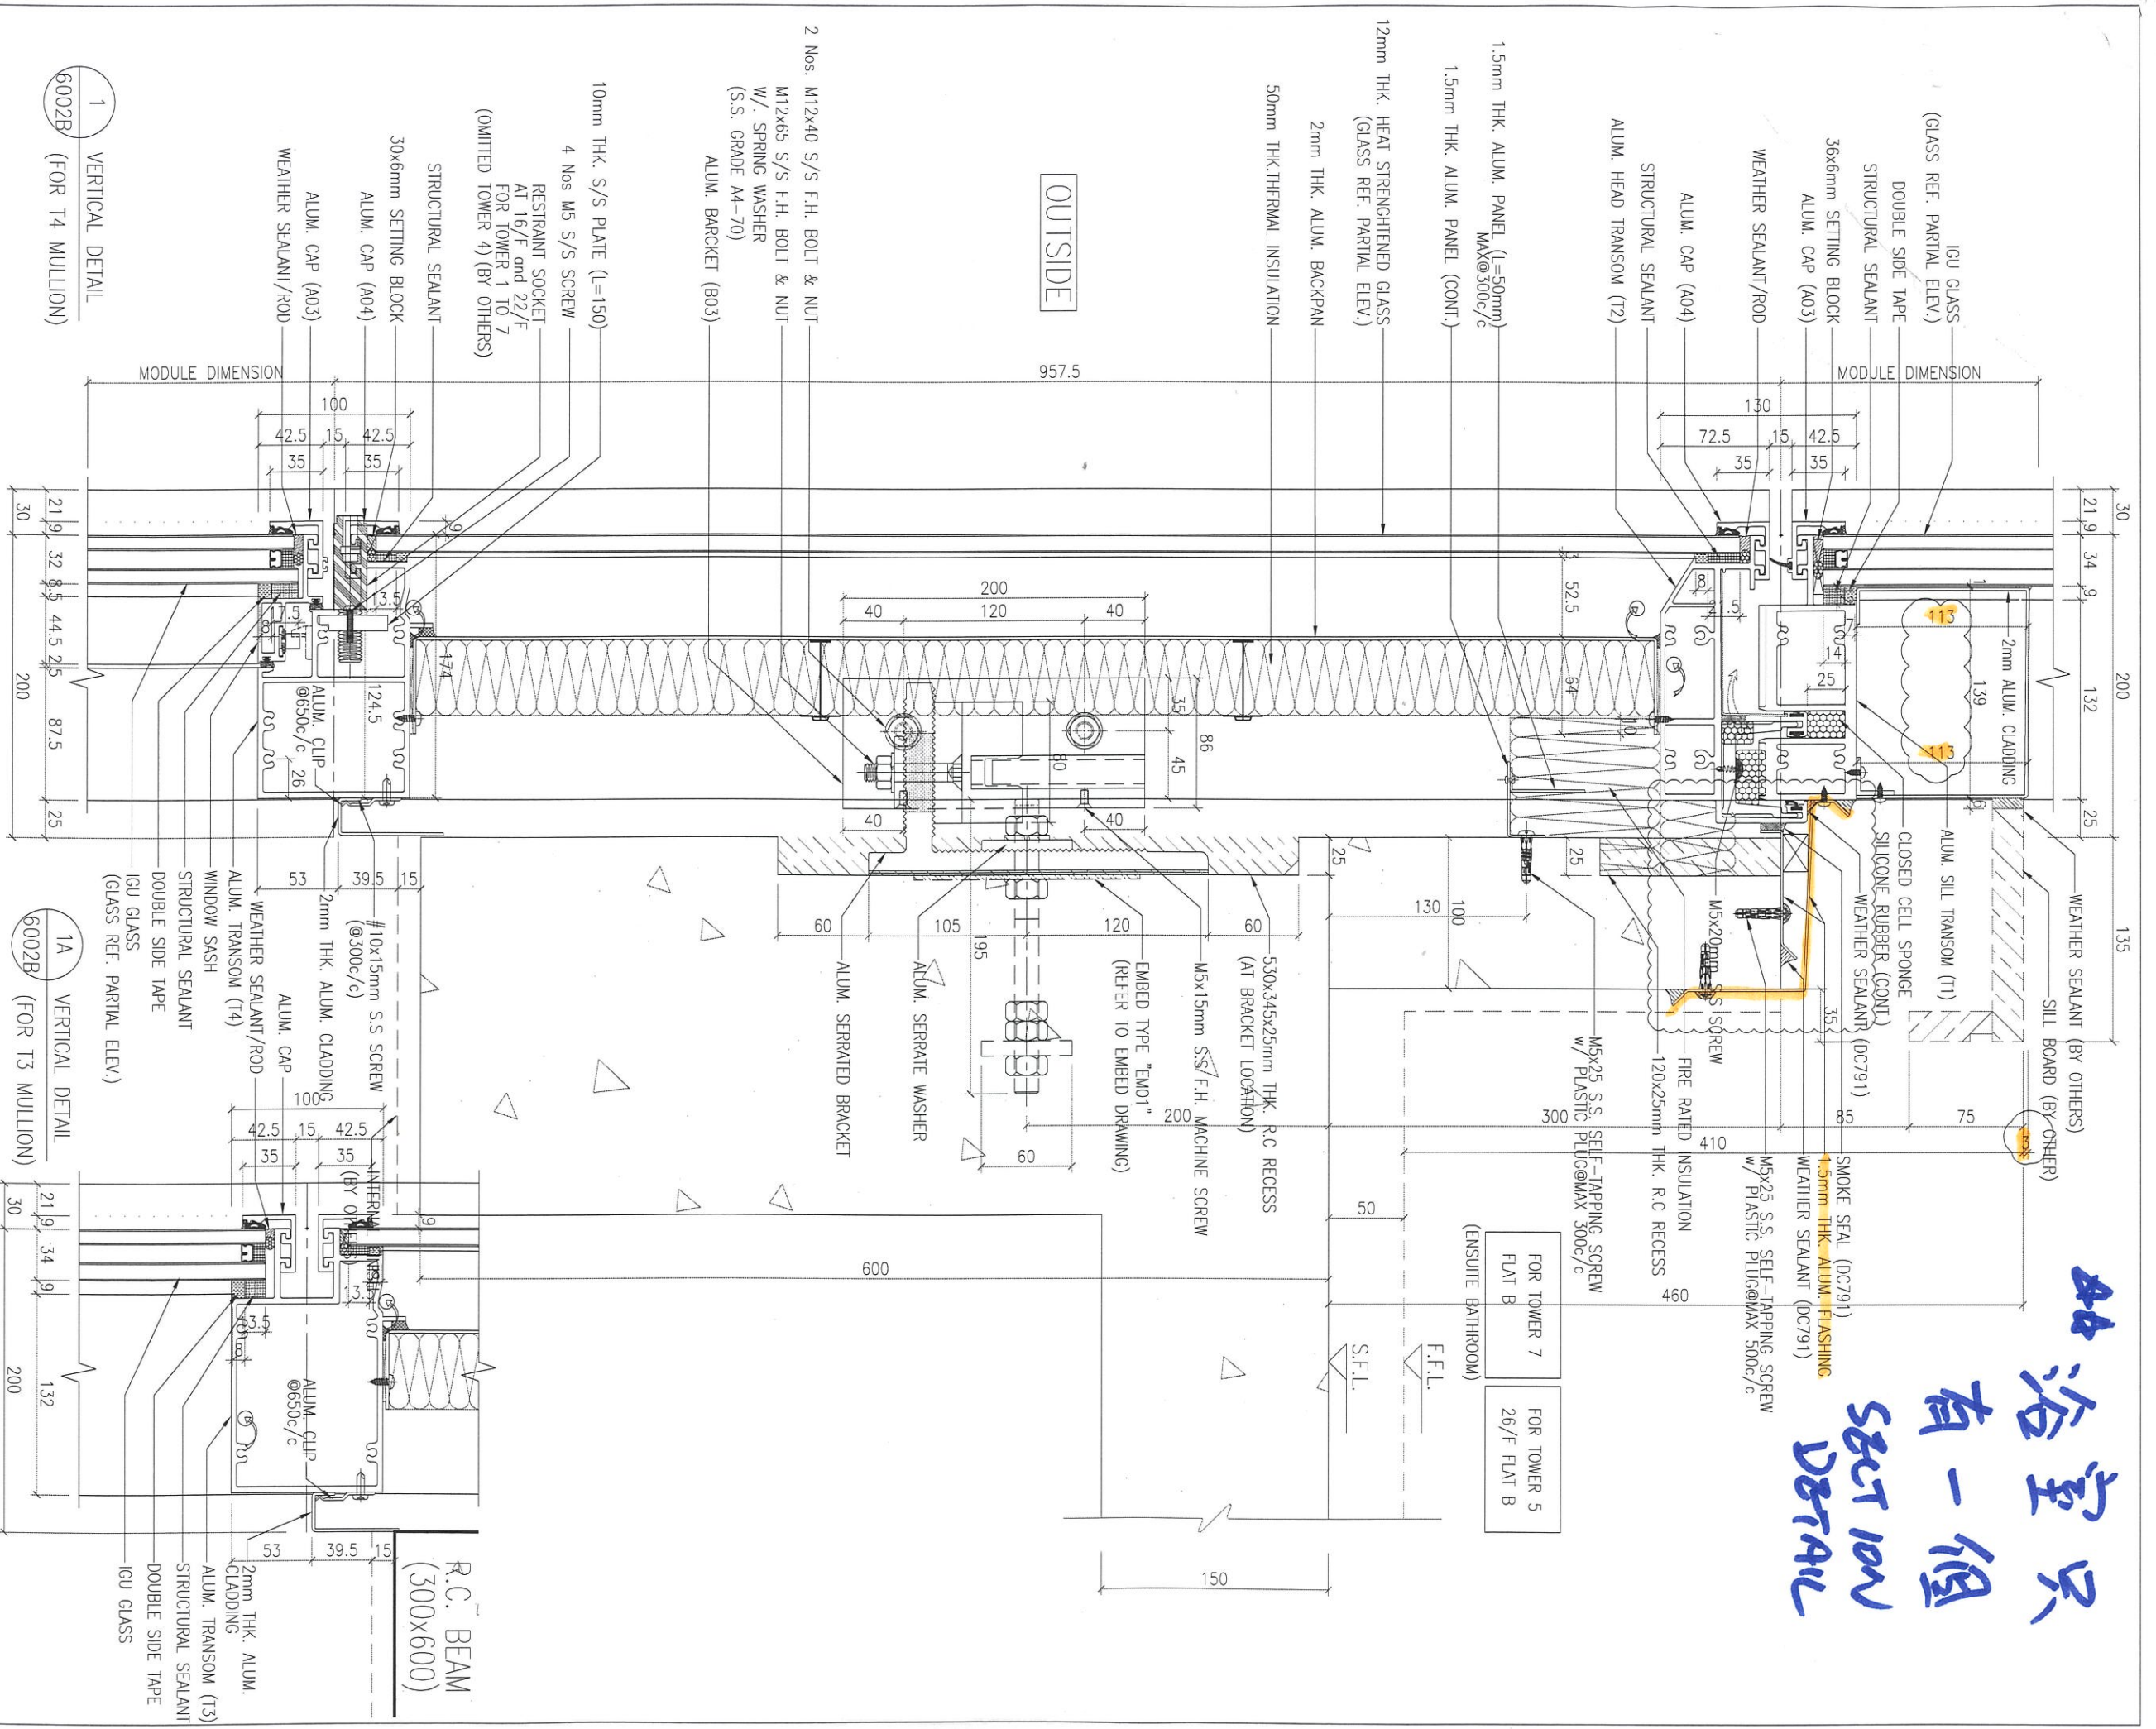

CLIENT: SHIMAO GROUP HOLDINGS LIMITED

ARCHITECT: WONG TUNG & PARTNERS LIMITED ARCHITECTS & PLANNERS

MAIN CONTRACTOR: HIP HING CONSTRUCTION CO LTD 協興建築有限公司

STRUCTURAL ENGINEER: C M WONG & ASSOCIATES LTD 黃志明建築工程師有限公司

FAÇADE CONSULTANT: MEIN-HARDT

LEGEND:

- 1. F.F.L. -- FINISHED FLOOR LEVEL
- 2. S.F.L. -- STRUCTURAL FLOOR LEVEL
- 3. -- REVERSED DETAIL

NOTE:

- 1. ALL DIMENSIONS ARE IN mm.
- 2. ALL ELEVATIONS ARE VIEWED FROM OUTSIDE BEFORE FABRICATION.
- 3. DETAIL MARK NO. REFER SHEET NO.

PROJECT: PROPOSED RESIDENTIAL DEVELOPMENT AT N.K.L.L. 6542 YIN PING ROAD KOWLOON

TITLE: VERTICAL DETAIL FOR CURTAIN WALL

DATE: 20-APR-21
SCALE: 1:4 (A3)

DRAWN BY: LHR
CHECKED BY: (A3)


REVISIONS:

NO.	DATE	REVISION
A	05-10-2021	REVISION SUBJECT TO ARCH. COMMENT

JOB NO.: J-853
PROPOSED RESIDENTIAL DEVELOPMENT AT N.K.L.L. 6542 YIN PING ROAD KOWLOON


UNITS 6-8, SUNRAY INDUSTRIAL CENTRE, 1/F
MIDI ALUMINIUM FABRICATOR LTD. 美特鋁業有限公司
610 Cho Kwong Road, Kowloon
Tel: 23489211-4 Fax: (852) 27272666
DWG NO.: J853-SD-CW-6002B
REV.: A

FILE PATH: T:\Jobs\J-853\1. Submission\1. Shop Drawing\Curtain Wall\9th Shopdrawing\6. VERTICAL DETAILS\6001-6013 Vertical detail_20221011.dwg, 03/03/23 11:20:14
FILE NAME: \HK330\apeos\Port-IV 6080

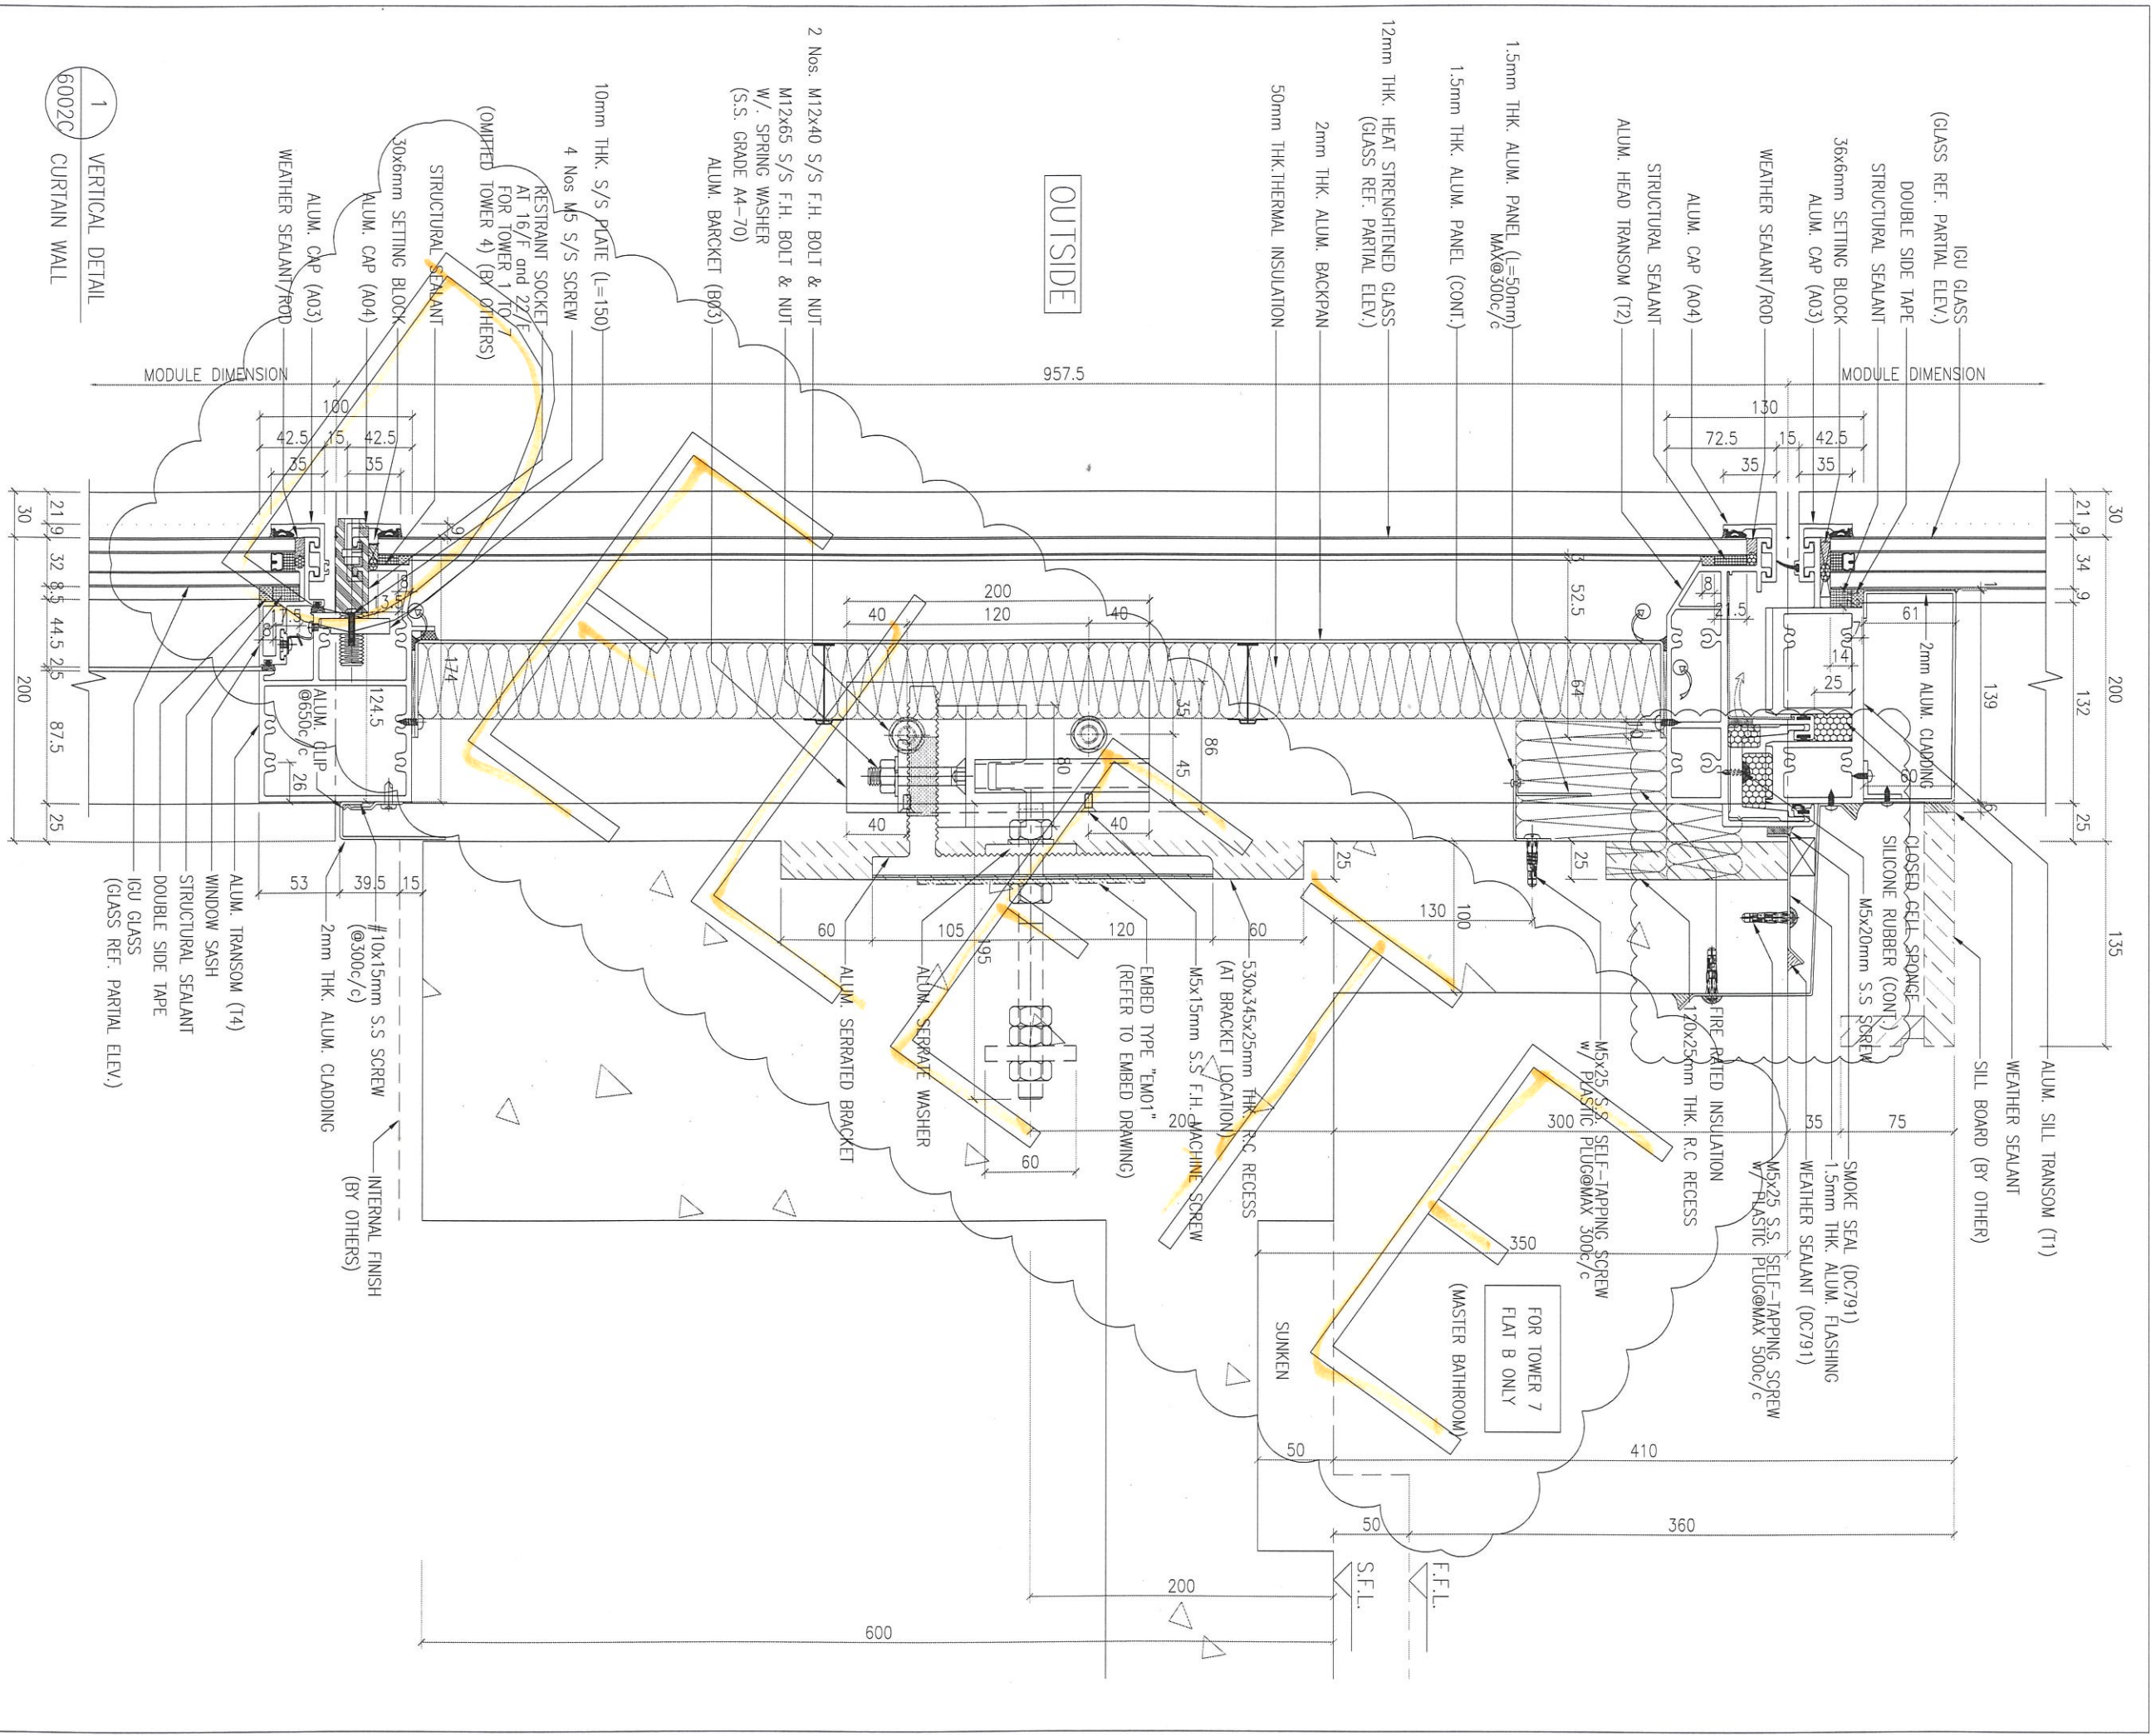

1 VERTICAL DETAIL
6002C CURTAIN WALL

B.D. REF :	
CLIENT : SHIMAO GROUP HOLDINGS LIMITED	
ARCHITECT : WONG TUNG & PARTNERS LIMITED ARCHITECTS & PLANNERS	
MAIN CONTRACTOR : 協興建築有限公司 HIP HING CONSTRUCTION CO LTD	
STRUCTURAL ENGINEER : C M WONG & ASSOCIATES LTD 黃志明建築工程師有限公司	
FAÇADE CONSULTANT : MEIN-HARDT	
NOTE : 1. ALL DIMENSIONS ARE IN mm. 2. ALL ELEVATIONS ARE VIEWED FROM OUTSIDE. 3. ALL DIMENSIONS TO BE VERIFIED ON SITE BEFORE FABRICATION.	
LEGEND : ① DETAIL MARK NO. ② REFER SHEET NO. ③ F.F.L. -- FINISHED FLOOR LEVEL ④ S.F.L. -- STRUCTURAL FLOOR LEVEL ⑤ -- REVERSED DETAIL	
PROJECT : PROPOSED RESIDENTIAL DEVELOPMENT AT N.K.I.L. 6542 YIN PING ROAD KOWLOON	
JOB NO. : J-853	
TITLE : VERTICAL DETAIL FOR CURTAIN WALL	
DATE : 20-APR-21	SCALE : 1:4 (A3)
DRAWN BY : LHR	CHECKED BY :
MIDI ALUMINIUM FABRICATOR LTD. 美特鋁業有限公司 Units 6-8, Sunray Industrial Centre, 1/F 610 Cha Kwo Ling Road, Kowloon Tel: 23489211-4 Fax: (852) 27272666	
DWG NO. : J853-SD-CW-6002C	REV. : A

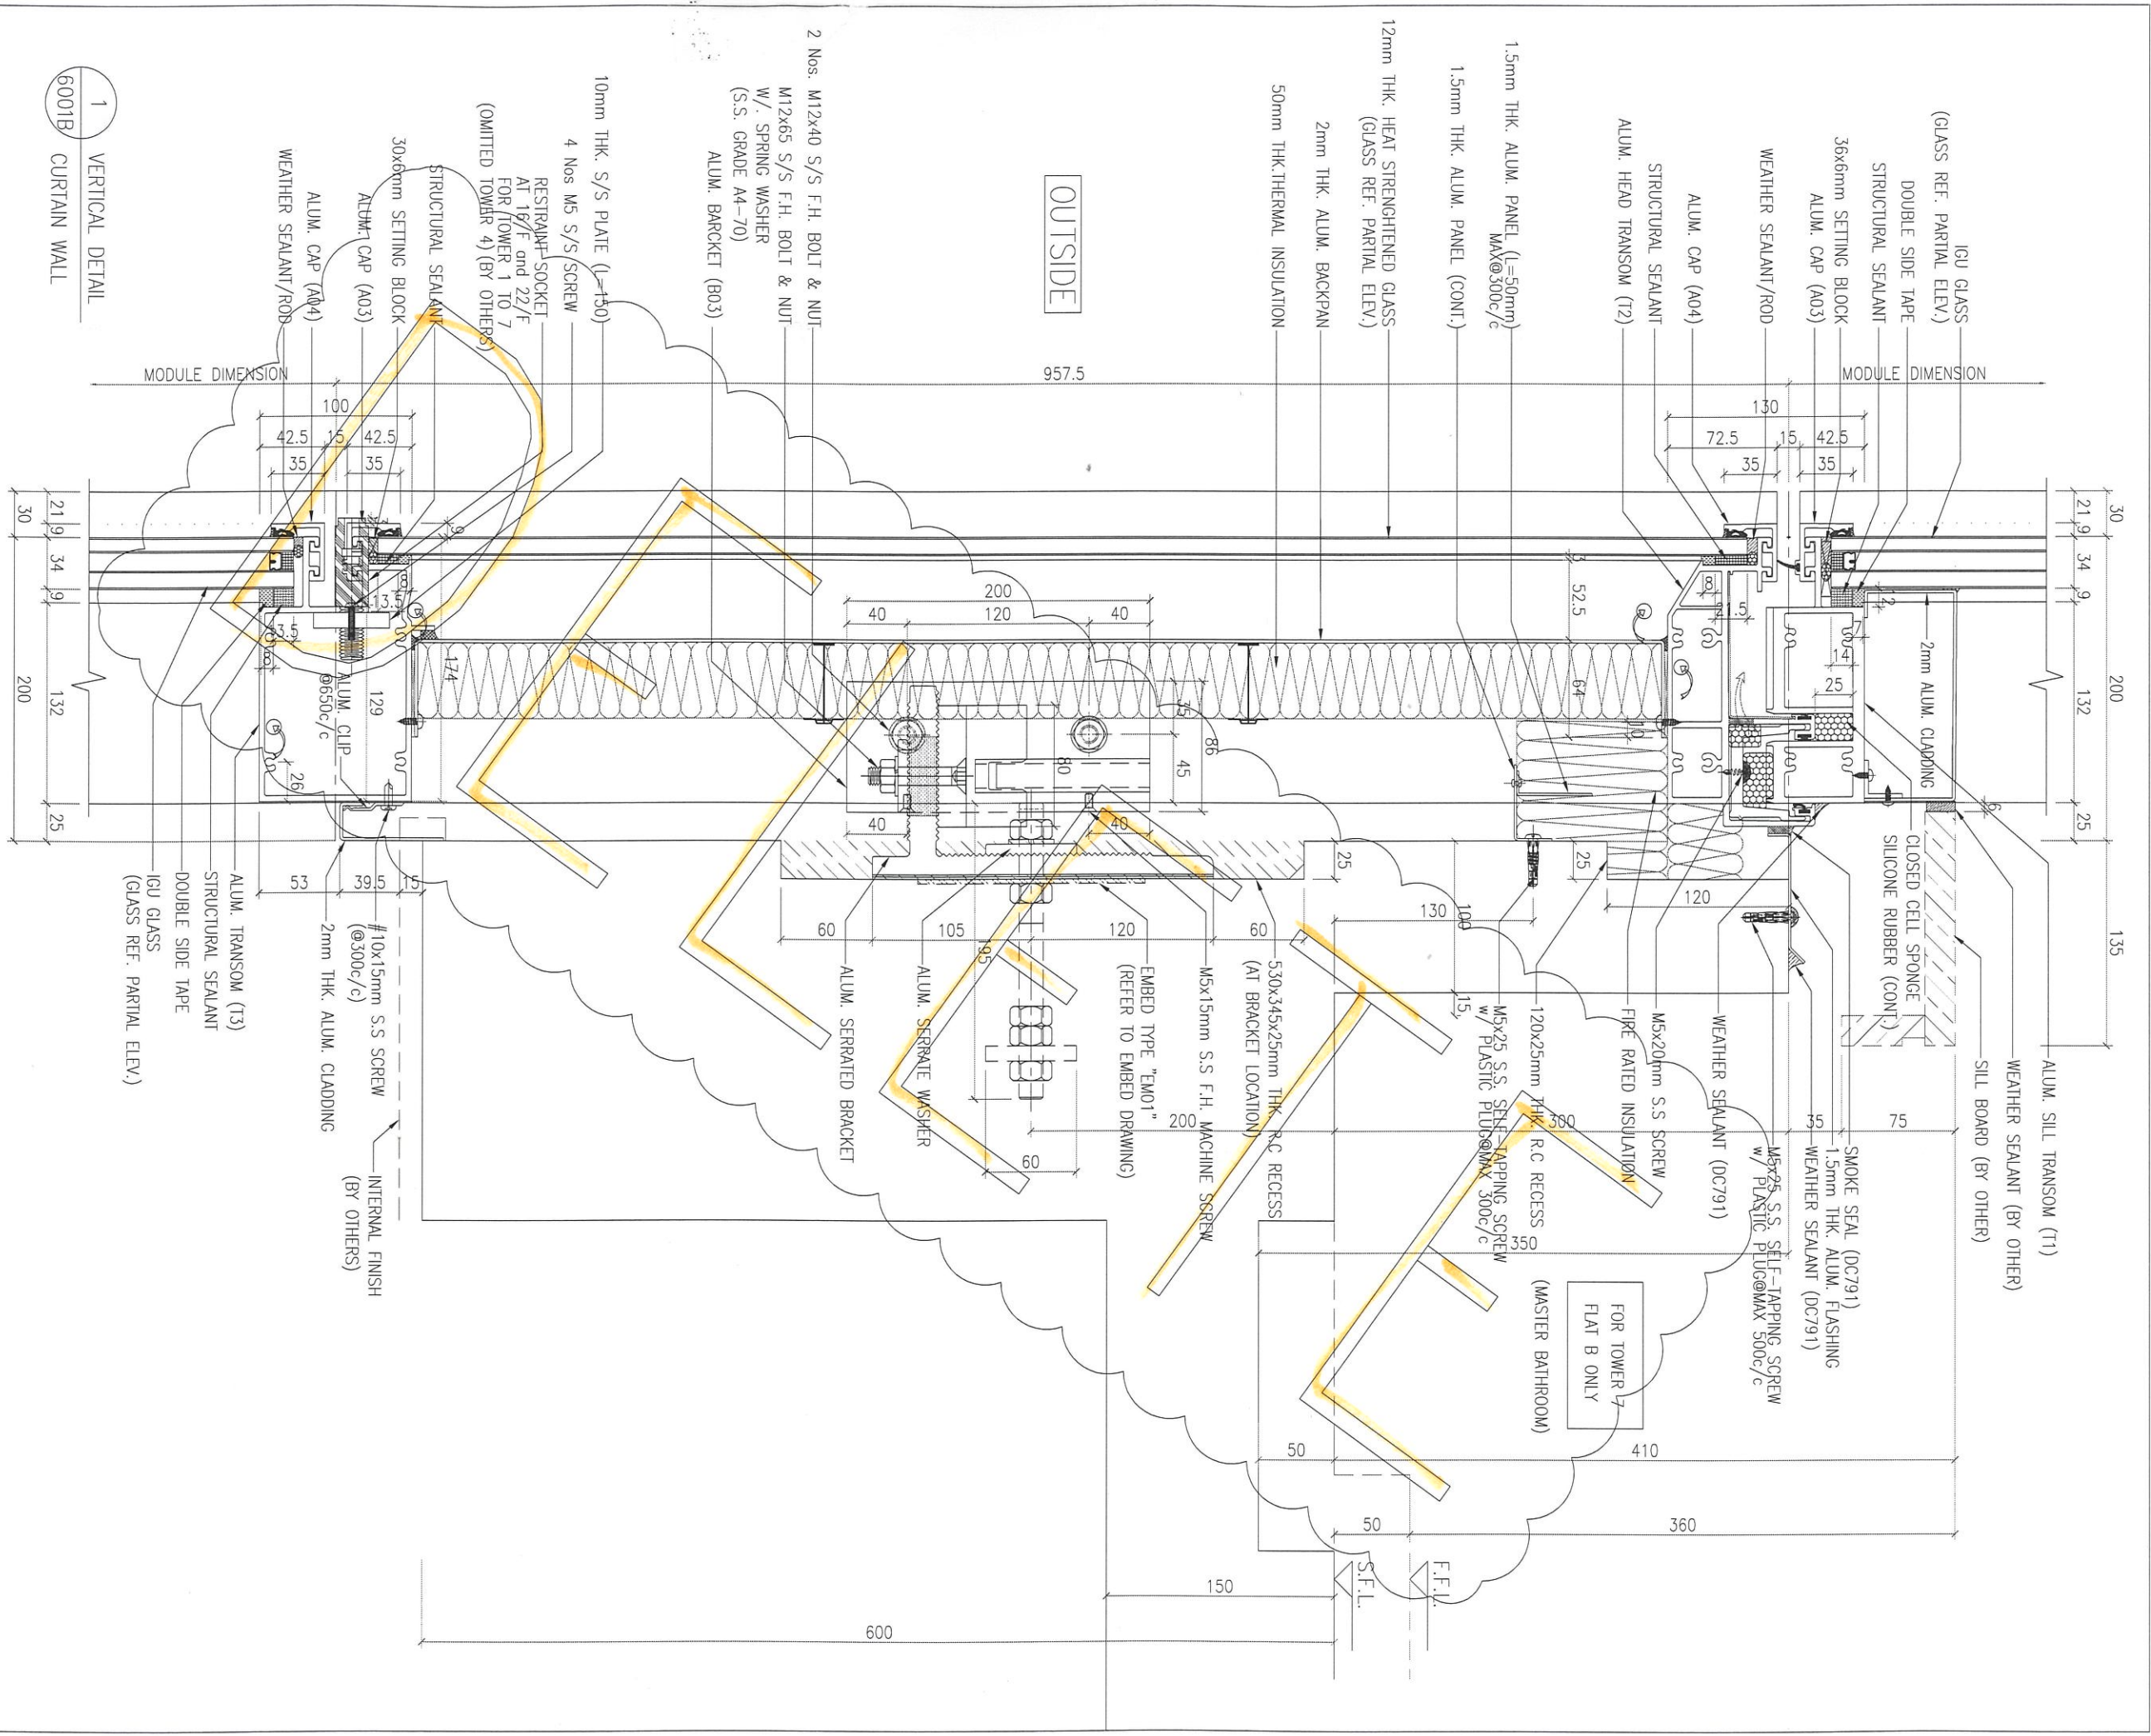

1 VERTICAL DETAIL
6001B
CURTAIN WALL

JOB NO. : J-853		PROJECT : PROPOSED RESIDENTIAL DEVELOPMENT AT N.K.I.L. 6542 YIN PING ROAD KOWLOON		TITLE : VERTICAL DETAIL FOR CURTAIN WALL	
DATE : 20-APR-21		SCALE : 1:4 (A3)		DRAWN BY : LHR	
DWG NO. : J853-SD-CW-6001B		REV. : A		MIDI ALUMINIUM FABRICATOR LTD. Units 6-8, Sunray Industrial Centre, 1/F 610 Cho Kwo Ling Road, Kowloon Tel: 23489211-4 Fax: (852) 27272666	

REVISION SUBJECT TO ARCH. COMMENT		NO.		DATE	
A		05-10-2021			
LEGEND:					
NOTE:					
1. ALL DIMENSIONS ARE IN mm.					
2. ALL ELEVATIONS ARE VIEWED FROM OUTSIDE.					
3. ALL DIMENSIONS TO BE VERIFIED ON SITE BEFORE FABRICATION.					
1. F.F.L. -- FINISHED FLOOR LEVEL					
2. S.F.L. -- STRUCTURAL FLOOR LEVEL					
3. (R) -- REVERSED DETAIL					
1. F.F.L. -- FINISHED FLOOR LEVEL					
2. S.F.L. -- STRUCTURAL FLOOR LEVEL					
3. (R) -- REVERSED DETAIL					
1. F.F.L. -- FINISHED FLOOR LEVEL					
2. S.F.L. -- STRUCTURAL FLOOR LEVEL					
3. (R) -- REVERSED DETAIL					

CLIENT : SHIMAO GROUP HOLDINGS LIMITED

ARCHITECT : WONG TUNG & PARTNERS LIMITED ARCHITECTS & PLANNERS

MAIN CONTRACTOR : 協興建築有限公司 HIP HING CONSTRUCTION CO LTD

STRUCTURAL ENGINEER : C M WONG & ASSOCIATES LTD 黃志明建築工程師有限公司

FAÇADE CONSULTANT : MEIN-HARDT

B.D. REF :