



工程指示 / 要求簡箋 ENGINEER INSTRUCTIONS(E.I.)

工程指示編號:	EI- 5711	修改版本:	- A
	HK- /		
工程編號:	J 853	工程名稱:	延坪道
收件人:	Maggie Lor	發件人:	Joe Chan
工程項目:	Podium Ceiling & Cladding Feature項目 地盤用鐵件 (Part 1 第二批) 修改	日期:	23/02/2023

<input checked="" type="checkbox"/> 原合約工程包	<input type="checkbox"/> 原合約工程加 / 減脹 QT-	<input type="checkbox"/> 新工程報價 QT-
--	--	------------------------------------

信件批核號碼/圖紙參考編號:	批核模具圖紙編號:
客戶指示附件:	管理內部批簽署:

<input type="checkbox"/> 初步鋁料 B.M.	<input type="checkbox"/> 加工拆圖, 然後生產	<input type="checkbox"/> 尺寸表
<input type="checkbox"/> 正式鋁料 B.M.	<input type="checkbox"/> 技術上資料/指示	<input type="checkbox"/> 報價
<input type="checkbox"/> 配件 B.M.	<input type="checkbox"/> 樣辦或貨品說明書	<input type="checkbox"/> 分判合約
<input type="checkbox"/> 其他:		

內容: 修改 A: 底橫通 修改開墜位置.  
  
(1+20頁)




完成上列要求日期: 13/03/2023

國內


<input type="checkbox"/> 生產技術總監	<input type="checkbox"/> 連附件	<input type="checkbox"/> 技術部	<input type="checkbox"/> 連附件	<input type="checkbox"/> 生產部	<input type="checkbox"/> 連附件
<input type="checkbox"/> 採購部	<input type="checkbox"/> 連附件	<input type="checkbox"/> 生產統籌部	<input type="checkbox"/> 連附件	<input type="checkbox"/> 報關組	<input type="checkbox"/> 連附件
<input type="checkbox"/> 質檢部	<input type="checkbox"/> 連附件	<input type="checkbox"/> 會計部	<input type="checkbox"/> 連附件	<input type="checkbox"/> 機械設計部	<input type="checkbox"/> 連附件
<input type="checkbox"/> 香港辦	<input type="checkbox"/> 連附件	<input type="checkbox"/> 其他:			

香港

<input type="checkbox"/> 行政部	<input type="checkbox"/> 連附件	<input type="checkbox"/> 會計部	<input type="checkbox"/> 連附件	<input type="checkbox"/> 統籌部	<input type="checkbox"/> 連附件	<input type="checkbox"/> 工程部	<input type="checkbox"/> 連附件
<input type="checkbox"/> 採購部	<input type="checkbox"/> 連附件	<input type="checkbox"/> QS部	<input type="checkbox"/> 連附件	<input checked="" type="checkbox"/> 地盤管理	<input checked="" type="checkbox"/> 連附件	<input type="checkbox"/> 維修部	<input type="checkbox"/> 連附件

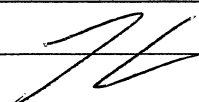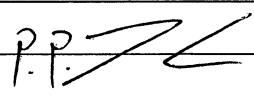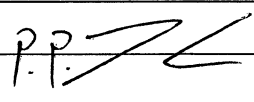*發件人簽署:		*組別成員批核簽署:	
傳遞編號: 1		項目經理簽署:	

①

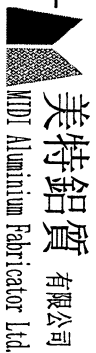


美特鋁質有限公司  
MTD Aluminium Fabricator Ltd.  
地盘鐵件BM表

工程號:	J853 T7 6/F	計算:	李傳鵬	日期:	6/2/2023	送呈:
地盘名稱:	香港延坪道	核對:	練松文	日期:	6/2/2023	副本:
項目類別:	天花	批准:	陳梓豪	日期:	6/2/2023	
BM編號:		A/C Code:	2023/02/06	鐵件總重量KG:	14124.74	
修改版次:						

序號	修改內容	鐵件圖號	鐵件名稱	顏色	實用	後備	總數	單位	單件 (kg)	總重量 (kg)	備注
1		T7-BK01-01	250*200*10鋼板	熱浸鋅	115	0	115	件	3.925	451.375	
2		T7-BK01-02	75*50*5 角鐵 (L=200)	熱浸鋅	20	0	20	件	1.505	30.100	
3		T7-BK02-01	100*50*6 角鐵 (L=3000)	熱浸鋅	35	0	35	件	20.520	718.200	
4		T7-BK02-02	75*50*5 角鐵 (L=3000)	熱浸鋅	18	0	18	件	16.680	300.240	
5		T7-BK11-01	150*150*10鋼板+50*50*10鋼板	熱浸鋅	95	0	95	件	1.963	186.485	
6		T7-BK11-02	150*150*10鋼板+50*50*10鋼板	熱浸鋅	6	0	6	件	1.963	11.778	
7		T7-BK11-03	150*150*10鋼板+50*50*10鋼板	熱浸鋅	2	0	2	件	1.963	3.926	
8		T7-BK12-01	150*150*10鋼板+150*160*10鋼板	熱浸鋅	2	0	2	件	3.650	7.301	
9		T7-BK21-01	40*40*5 角鐵 (L=3000)	熱浸鋅	13	0	13	件	8.910	115.830	
10		T7-BK31-01	200*100*10角鋼+65*165*10鋼板	熱浸鋅	60	0	60	件	36.450	2187.000	
11		T7-MS01-01	40*40*5方通 + 200*100*10鋼板	熱浸鋅	150	0	150	件	4.682	702.240	
12		T7-MS02-01	40*40*5方通	熱浸鋅	42	0	42	件	15.960	670.320	
13		T7-MS03-01	40*40*5方通	熱浸鋅	1	0	1	件	27.015	27.015	
14		T7-MS03-02	40*40*5方通	熱浸鋅	1	0	1	件	16.556	16.556	
15		T7-MS03-03	40*40*5方通	熱浸鋅	1	0	1	件	14.518	14.518	
16		T7-MS03-04	40*40*5方通	熱浸鋅	1	0	1	件	26.393	26.393	
17		T7-MS03-05	40*40*5方通	熱浸鋅	1	0	1	件	16.215	16.215	
18		T7-MS03-06	40*40*5方通	熱浸鋅	1	0	1	件	14.103	14.103	
19		T7-MS03-07	40*40*5方通	熱浸鋅	2	0	2	件	14.736	29.473	

②

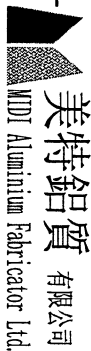


美特鋁質有限公司  
MTD Aluminium Fabricator Ltd.  
地盘鐵件BM表


工程號:	J853 T7 6/F	計算:	李傳鵬	日期:	6/2/2023	送呈:
地盘名稱:	香港延坪道	核對:	練松文	日期:	6/2/2023	副本:
項目類別:	天花	批准:	陳梓豪	日期:	6/2/2023	
BM編號:		修改版次:		鐵件總重量KG:	14124.74	
		A/C Code:	2023/02/06			

序號	修改內容	鐵件圖號	鐵件名稱	顏色	實用	後備	總數	單位	單件 (kg)	總重量 (kg)	備注
20		T7-MS03-08	40*40*5方通	熱浸鋅	2	0	2	件	12.779	25.557	
21		T7-MS04-01	40*40*5方通	熱浸鋅	1	0	1	件	73.741	73.741	
22		T7-MS04-02	40*40*5方通	熱浸鋅	1	0	1	件	46.428	46.428	
23		T7-MS04-03	40*40*5方通	熱浸鋅	1	0	1	件	39.155	39.155	
24		T7-MS04-04	40*40*5方通	熱浸鋅	1	0	1	件	72.107	72.107	
25		T7-MS04-05	40*40*5方通	熱浸鋅	1	0	1	件	45.507	45.507	
26		T7-MS04-06	40*40*5方通	熱浸鋅	1	0	1	件	38.304	38.304	
27		T7-MS11-01	40*40*5方通	熱浸鋅	1	0	1	件	9.347	9.347	
28		T7-MS11-02	40*40*5方通	熱浸鋅	1	0	1	件	7.751	7.751	
29		T7-MS12-01	40*40*5方通	熱浸鋅	23	0	23	件	12.741	293.052	
30		T7-MS13-01	40*40*5方通	熱浸鋅	1	0	1	件	8.352	8.352	
31		T7-MS13-02	40*40*5方通	熱浸鋅	1	0	1	件	11.997	11.997	
32		T7-MS13-03	40*40*5方通	熱浸鋅	1	0	1	件	8.778	8.778	
33		T7-MS13-04	40*40*5方通	熱浸鋅	1	0	1	件	8.789	8.789	
34		T7-MS13-05	40*40*5方通	熱浸鋅	1	0	1	件	7.108	7.108	
35		T7-MS14-01	40*40*5方通	熱浸鋅	1	0	1	件	10.262	10.262	
36		T7-MS14-02	40*40*5方通	熱浸鋅	1	0	1	件	7.953	7.953	
37		T7-MS14-03	40*40*5方通	熱浸鋅	1	0	1	件	7.735	7.735	
38		T7-MS15-01	40*40*5方通	熱浸鋅	1	0	1	件	13.960	13.960	

3

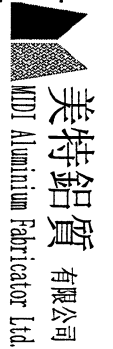		工程號: J853 T7 6/F	計算:	李傳鵬	日期:	6/2/2023	送呈:				
地盘鐵件BM表		地盘名稱: 香港延坪道	核對:	練松文	日期:	6/2/2023	副本:				
BM編號:		項目類別: 天花	批准:	陳梓豪	日期:	6/2/2023					
修改版次:		A/C Code : 2023/02/06	鐵件總重量KG:		14124.74						
序號	修改內容	鐵件圖號	鐵件名稱	顏色	實用	後備	總數	單位	單件 (kg)	總重量 (kg)	備注
39		T7-MS15-02	40*40*5方通	熱浸鋅	1	0	1	件	13.960	13.960	
40		T7-MS15-03	40*40*5方通	熱浸鋅	1	0	1	件	17.184	17.184	
41		T7-MS15-04	40*40*5方通	熱浸鋅	1	0	1	件	17.184	17.184	
42		T7-MS16-01	40*40*5方通	熱浸鋅	1	0	1	件	16.864	16.864	
43		T7-MS16-02	40*40*5方通	熱浸鋅	1	0	1	件	15.864	15.864	
44		T7-MS17-01	40*40*5方通	熱浸鋅	1	0	1	件	7.416	7.416	
45		T7-MS17-02	40*40*5方通	熱浸鋅	1	0	1	件	6.693	6.693	
46		T7-MS18-01	40*40*5方通	熱浸鋅	2	0	2	件	15.588	31.175	
47		T7-MS18-02	40*40*5方通	熱浸鋅	2	0	2	件	20.360	40.719	
48		T7-MS19-01	40*40*5方通	熱浸鋅	1	0	1	件	18.673	18.673	
49		T7-ST01-01	60*60*5方通+50*50*5方通+75*50*6角鋼	熱浸鋅	38	0	38	件	12.410	471.565	
50		T7-ST01-02	60*60*5方通+50*50*5方通+75*50*6角鋼	熱浸鋅	1	0	1	件	14.231	14.231	
51		T7-ST02-01	60*60*5方通+50*50*5方通+100*100*6.3方通+75*50*6角鋼	熱浸鋅	7	0	7	件	45.127	315.891	
52		<del>T7-ST02-01</del>	<del>60*60*5方通+50*50*5方通+100*100*6.3方通+75*50*6角鋼</del>	<del>熱浸鋅</del>	<del>7</del>	<del>0</del>	<del>7</del>	<del>件</del>	<del>47.211</del>	<del>330.478</del>	
53		T7-ST02-02	60*60*5方通+50*50*5方通+100*100*6.3方通+75*50*6角鋼	熱浸鋅	1	0	1	件	47.211	47.211	
54		T7-ST02-03	60*60*5方通+50*50*5方通+100*100*6.3方通+75*50*6角鋼	熱浸鋅	3	0	3	件	48.757	146.270	
55		T7-ST03-01	60*60*5方通+50*50*5方通+75*50*6角鋼+100*75*6角鋼+50*50*5角鋼	熱浸鋅	3	0	3	件	42.057	126.170	
56		T7-ST04-01	60*60*5方通+50*50*5方通+100*100*6.3方通+75*50*6角鋼	熱浸鋅	30	0	30	件	44.826	1344.775	
57		T7-ST05-01	60*60*5方通+50*50*5方通+75*50*6角鋼+100*75*6角鋼+50*50*5角鋼+100*100*6.3方通	熱浸鋅	6	0	6	件	74.413	446.479	

(4)

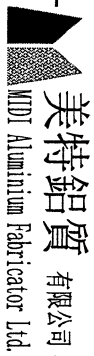


美特鋁質有限公司  
MTD Aluminium Fabricator Ltd.  
地盤鐵件BM表

工程號:	J853 T7 6/F	計算:	李傳鵬	日期:	6/2/2023	送呈:
地盤名稱:	香港延坪道	核對:	練松文	日期:	6/2/2023	副本:
項目類別:	天花	批准:	陳梓豪	日期:	6/2/2023	
BM編號:		A/C Code :	2023/02/06	鐵件總重量KG :	14124.74	
修改版次:						

序號	修改內容	鐵件圖號	鐵件名稱	顏色	實用	後備	總數	單位	單件 (kg)	總重量 (kg)	備注
58		T7-ST11-01	100*100*6.3方通+50*50*5方通	熱浸鋅	45	0	45	件	33.964	1528.362	
59		T7-TM01-01	40*40*5方通	熱浸鋅	12	0	12	件	15.933	191.201	
60		T7-TM02-01	40*40*5方通	熱浸鋅	2	0	2	件	12.938	25.876	
61		T7-TM02-02	40*40*5方通	熱浸鋅	1	0	1	件	5.171	5.171	
62		T7-TM02-03	40*40*5方通	熱浸鋅	1	0	1	件	5.889	5.889	
63		T7-TM02-04	40*40*5方通	熱浸鋅	1	0	1	件	10.204	10.204	
64		T7-TM02-05	40*40*5方通	熱浸鋅	1	0	1	件	11.890	11.890	
65		T7-TM02-06	40*40*5方通	熱浸鋅	1	0	1	件	9.103	9.103	
66		T7-TM02-07	40*40*5方通	熱浸鋅	1	0	1	件	12.486	12.486	
67		T7-TM02-08	40*40*5方通	熱浸鋅	1	0	1	件	14.109	14.109	
68		T7-TM02-09	40*40*5方通	熱浸鋅	1	0	1	件	18.487	18.487	
69		T7-TM03-01	40*40*5方通	熱浸鋅	1	0	1	件	15.593	15.593	
70		T7-TM03-02	40*40*5方通	熱浸鋅	1	0	1	件	17.742	17.742	
71		T7-TM03-03	40*40*5方通	熱浸鋅	1	0	1	件	19.982	19.982	
72		T7-TM03-04	40*40*5方通	熱浸鋅	1	0	1	件	6.171	6.171	
73		T7-TM03-05	40*40*5方通	熱浸鋅	1	0	1	件	8.411	8.411	
74		T7-TM03-06	40*40*5方通	熱浸鋅	1	0	1	件	18.540	18.540	
75		T7-TM03-07	40*40*5方通	熱浸鋅	1	0	1	件	11.571	11.571	
76		T7-TM03-08	40*40*5方通	熱浸鋅	1	0	1	件	7.086	7.086	

(5)

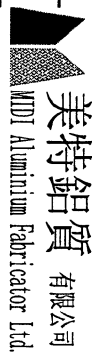


美特鋁質有限公司  
MTD Aluminium Fabricator Ltd.

地盘鐵件BM表

BM編號:	工程號:	J853 T7 6/F	計算:	李傳鵬	日期:	6/2/2023	送呈:
	地盘名稱:	香港延坪道	核對:	練松文	日期:	6/2/2023	副本:
	項目類別:	天花	批准:	陳梓豪	日期:	6/2/2023	
	修改版次:		A/C Code : 2023/02/06		鐵件總重量KG :	14124.74	

序號	修改內容	鐵件圖號	鐵件名稱	顏色	實用	後備	總數	單位	單件 (kg)	總重量 (kg)	備注
77		T7-TM04-01	40*40*5方通	熱浸鋅	1	0	1	件	10.353	10.353	
78		T7-TM04-02	40*40*5方通	熱浸鋅	1	0	1	件	6.980	6.980	
79		T7-TM04-03	40*40*5方通	熱浸鋅	1	0	1	件	6.134	6.134	
80		T7-TM04-04	40*40*5方通	熱浸鋅	1	0	1	件	4.432	4.432	
81		T7-TM04-05	40*40*5方通	熱浸鋅	1	0	1	件	9.363	9.363	
82		T7-TM04-06	40*40*5方通	熱浸鋅	1	0	1	件	15.189	15.189	
83		T7-TM04-07	40*40*5方通	熱浸鋅	1	0	1	件	22.972	22.972	
84		T7-TM04-08	40*40*5方通	熱浸鋅	1	0	1	件	23.530	23.530	
85		T7-TM04-09	40*40*5方通	熱浸鋅	1	0	1	件	21.876	21.876	
86		T7-TM04-10	40*40*5方通	熱浸鋅	1	0	1	件	16.455	16.455	
87		T7-TM04-11	40*40*5方通	熱浸鋅	1	0	1	件	10.736	10.736	
88		T7-TM04-12	40*40*5方通	熱浸鋅	1	0	1	件	6.804	6.804	
89		T7-TM04-13	40*40*5方通	熱浸鋅	1	0	1	件	4.261	4.261	
90		T7-TM04-14	40*40*5方通	熱浸鋅	1	0	1	件	11.491	11.491	
91		T7-TM04-15	40*40*5方通	熱浸鋅	1	0	1	件	10.496	10.496	
92		T7-TM04-16	40*40*5方通	熱浸鋅	1	0	1	件	10.044	10.044	
93		T7-TM04-17	40*40*5方通	熱浸鋅	4	0	4	件	10.012	40.049	
94	A	T7-TM05-01	40*40*5方通	熱浸鋅	51	0	51	件	4.362	222.482	
95	A	T7-TM05-02	40*40*5方通	熱浸鋅	47	0	47	件	4.575	215.034	

16

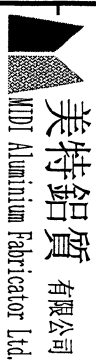


美特鋁質有限公司  
MDT Aluminium Fabricator Ltd.  
地盘鐵件BM表

工程號:	J853 T7 6/F	計算:	李傳鵬	日期:	6/2/2023	送呈:
地盘名稱:	香港延坪道	核對:	練松文	日期:	6/2/2023	副本:
項目類別:	天花	批准:	陳梓豪	日期:	6/2/2023	
BM編號:		A/C Code :	2023/02/06	鐵件總重量KG :	14124.74	
修改版次:						

序號	修改內容	鐵件圖號	鐵件名稱	顏色	實用	後備	總數	單位	單件 (kg)	總重量 (kg)	備注
96	A	T7-TM05-03	40*40*5方通	熱浸鋅	16	0	16	件	9.629	154.067	
97	A	T7-TM05-04	40*40*5方通	熱浸鋅	6	0	6	件	8.565	51.391	
98	A	T7-TM06-01	40*40*5方通	熱浸鋅	1	0	1	件	9.757	9.757	
99	A	T7-TM06-02	40*40*5方通	熱浸鋅	1	0	1	件	8.805	8.805	
100	A	T7-TM06-03	40*40*5方通	熱浸鋅	1	0	1	件	7.389	7.389	
101	A	T7-TM06-04	40*40*5方通	熱浸鋅	1	0	1	件	6.905	6.905	
102	A	T7-TM06-05	40*40*5方通	熱浸鋅	1	0	1	件	5.953	5.953	
103	A	T7-TM06-06	40*40*5方通	熱浸鋅	1	0	1	件	9.746	9.746	
104	A	T7-TM06-07	40*40*5方通	熱浸鋅	1	0	1	件	8.794	8.794	
105	A	T7-TM06-08	40*40*5方通	熱浸鋅	1	0	1	件	7.368	7.368	
106	A	T7-TM06-09	40*40*5方通	熱浸鋅	1	0	1	件	6.884	6.884	
107	A	T7-TM06-10	40*40*5方通	熱浸鋅	1	0	1	件	5.937	5.937	
108	A	T7-TM06-11	40*40*5方通	熱浸鋅	1	0	1	件	9.789	9.789	
109	A	T7-TM06-12	40*40*5方通	熱浸鋅	1	0	1	件	8.831	8.831	
110	A	T7-TM06-13	40*40*5方通	熱浸鋅	1	0	1	件	7.405	7.405	
111	A	T7-TM06-14	40*40*5方通	熱浸鋅	1	0	1	件	6.927	6.927	
112	A	T7-TM06-15	40*40*5方通	熱浸鋅	1	0	1	件	5.974	5.974	
113	A	T7-TM06-16	40*40*5方通	熱浸鋅	1	0	1	件	9.714	9.714	
114	A	T7-TM06-17	40*40*5方通	熱浸鋅	1	0	1	件	8.868	8.868	

17

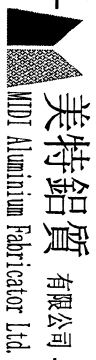


美特鋁質有限公司  
MTD Aluminium Fabricator Ltd.  
地盘鐵件BM表

工程號:	J853 T7 6/F	計算:	李傳鵬	日期:	6/2/2023	送呈:
地盘名稱:	香港延坪道	核對:	繻松文	日期:	6/2/2023	副本:
項目類別:	天花	批准:	陳梓豪	日期:	6/2/2023	
BM編號:		A/C Code :	2023/02/06	鐵件總重量KG :	14124.74	
修改版次:						

序號	修改內容	鐵件圖號	鐵件名稱	顏色	實用	後備	總數	單位	單件 (kg)	總重量 (kg)	備注
115	A	T7-TM06-18	40*40*5方通	熱浸鋅	1	0	1	件	7.613	7.613	
116	A	T7-TM06-19	40*40*5方通	熱浸鋅	1	0	1	件	7.182	7.182	
117	A	T7-TM06-20	40*40*5方通	熱浸鋅	1	0	1	件	6.336	6.336	
118	A	T7-TM06-21	40*40*5方通	熱浸鋅	1	0	1	件	9.672	9.672	
119	A	T7-TM06-22	40*40*5方通	熱浸鋅	1	0	1	件	8.773	8.773	
120	A	T7-TM06-23	40*40*5方通	熱浸鋅	1	0	1	件	7.437	7.437	
121	A	T7-TM06-24	40*40*5方通	熱浸鋅	1	0	1	件	6.980	6.980	
122	A	T7-TM06-25	40*40*5方通	熱浸鋅	1	0	1	件	6.081	6.081	
123	A	T7-TM06-26	40*40*5方通	熱浸鋅	1	0	1	件	9.980	9.980	
124	A	T7-TM06-27	40*40*5方通	熱浸鋅	1	0	1	件	8.884	8.884	
125	A	T7-TM06-28	40*40*5方通	熱浸鋅	1	0	1	件	7.246	7.246	
126	A	T7-TM06-29	40*40*5方通	熱浸鋅	1	0	1	件	6.687	6.687	
127	A	T7-TM06-30	40*40*5方通	熱浸鋅	1	0	1	件	5.586	5.586	
128	A	T7-TM06-31	40*40*5方通	熱浸鋅	1	0	1	件	10.672	10.672	
129	A	T7-TM06-32	40*40*5方通	熱浸鋅	1	0	1	件	9.571	9.571	
130	A	T7-TM06-33	40*40*5方通	熱浸鋅	1	0	1	件	7.932	7.932	
131	A	T7-TM06-34	40*40*5方通	熱浸鋅	1	0	1	件	7.368	7.368	
132	A	T7-TM06-35	40*40*5方通	熱浸鋅	1	0	1	件	6.267	6.267	
133	A	T7-TM07-01	40*40*5方通	熱浸鋅	3	0	3	件	10.640	31.920	

8

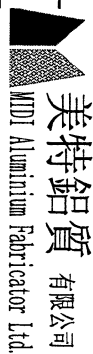


美特鋁質 有限公司  
MTD Aluminium Fabricator Ltd.  
地盘鐵件BM表

工程號:	J853 T7 6/F	計算:	李傳鵬	日期:	6/2/2023	送呈:
地盘名稱:	香港延坪道	核對:	練松文	日期:	6/2/2023	副本:
項目類別:	天花	批准:	陳梓豪	日期:	6/2/2023	
BM編號:		A/C Code :	2023/02/06	鐵件總重量KG :	14124.74	
修改版次:						

序號	修改內容	鐵件圖號	鐵件名稱	顏色	實用	後備	總數	單位	單件 (kg)	總重量 (kg)	備注
134	A	T7-TM07-02	40*40*5方通	熱浸鋅	3	0	3	件	9.533	28.600	
135	A	T7-TM07-03	40*40*5方通	熱浸鋅	3	0	3	件	8.422	25.265	
136	A	T7-TM07-04	40*40*5方通	熱浸鋅	3	0	3	件	6.767	20.301	
137	A	T7-TM07-05	40*40*5方通	熱浸鋅	3	0	3	件	6.203	18.609	
138	A	T7-TM07-06	40*40*5方通	熱浸鋅	3	0	3	件	5.091	15.274	
139	A	T7-TM07-07	40*40*5方通	熱浸鋅	1	0	1	件	10.097	10.097	
140	A	T7-TM07-08	40*40*5方通	熱浸鋅	1	0	1	件	9.198	9.198	
141	A	T7-TM07-09	40*40*5方通	熱浸鋅	1	0	1	件	8.305	8.305	
142	A	T7-TM07-10	40*40*5方通	熱浸鋅	1	0	1	件	6.969	6.969	
143	A	T7-TM07-11	40*40*5方通	熱浸鋅	1	0	1	件	6.512	6.512	
144	A	T7-TM07-12	40*40*5方通	熱浸鋅	1	0	1	件	5.613	5.613	
145	A	T7-TM07-13	40*40*5方通	熱浸鋅	1	0	1	件	10.113	10.113	
146	A	T7-TM07-14	40*40*5方通	熱浸鋅	1	0	1	件	9.267	9.267	
147	A	T7-TM07-15	40*40*5方通	熱浸鋅	1	0	1	件	8.422	8.422	
148	A	T7-TM07-16	40*40*5方通	熱浸鋅	1	0	1	件	7.166	7.166	
149	A	T7-TM07-17	40*40*5方通	熱浸鋅	1	0	1	件	6.735	6.735	
150	A	T7-TM07-18	40*40*5方通	熱浸鋅	1	0	1	件	5.895	5.895	
151	A	T7-TM07-19	40*40*5方通	熱浸鋅	1	0	1	件	10.560	10.560	
152	A	T7-TM07-20	40*40*5方通	熱浸鋅	1	0	1	件	9.517	9.517	

(9)

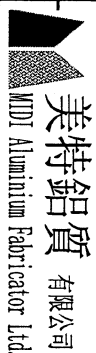


美特鋁質有限公司  
MTD Aluminium Fabricator Ltd.  
地盘鐵件BIM表

工程號:	J853 T7 6/F	計算:	李傳鵬	日期:	6/2/2023	送呈:
地盘名稱:	香港延坪道	核對:	練松文	日期:	6/2/2023	副本:
項目類別:	天花	批准:	陳梓豪	日期:	6/2/2023	
BIM編號:		修改版次:		A/C Code :	2023/02/06	
			鐵件總重量KG :		14124.74	

序號	修改內容	鐵件圖號	鐵件名稱	顏色	實用	後備	總數	單位	單件重量(kg)	總重量(kg)	備注
153	A	T7-TM07-21	40*40*5方通	熱浸鋅	1	0	1	件	8.475	8.475	
154	A	T7-TM07-22	40*40*5方通	熱浸鋅	1	0	1	件	6.921	6.921	
155	A	T7-TM07-23	40*40*5方通	熱浸鋅	1	0	1	件	6.389	6.389	
156	A	T7-TM07-24	40*40*5方通	熱浸鋅	1	0	1	件	5.347	5.347	
157		T7-TM11-01	40*40*5方通	熱浸鋅	2	0	2	件	15.933	31.867	
158		T7-TM11-02	40*40*5方通	熱浸鋅	1	0	1	件	15.933	15.933	
159		T7-TM11-03	40*40*5方通	熱浸鋅	1	0	1	件	15.933	15.933	
160		T7-TM11-04	40*40*5方通	熱浸鋅	1	0	1	件	15.933	15.933	
161		T7-TM12-01	40*40*5方通	熱浸鋅	1	0	1	件	18.285	18.285	
162		T7-TM12-02	40*40*5方通	熱浸鋅	9	0	9	件	17.380	156.424	
163		T7-TM12-03	40*40*5方通	熱浸鋅	1	0	1	件	17.380	17.380	
164		T7-TM12-04	40*40*5方通	熱浸鋅	1	0	1	件	17.380	17.380	
165		T7-TM12-05	40*40*5方通	熱浸鋅	8	0	8	件	17.380	139.044	
166		T7-TM12-06	40*40*5方通	熱浸鋅	7	0	7	件	17.380	121.663	
167		T7-TM13-01	40*40*5方通	熱浸鋅	1	0	1	件	17.380	17.380	
168		T7-TM13-02	40*40*5方通	熱浸鋅	1	0	1	件	10.768	10.768	
169		T7-TM13-03	40*40*5方通	熱浸鋅	1	0	1	件	16.614	16.614	
170		T7-TM13-04	40*40*5方通	熱浸鋅	1	0	1	件	19.280	19.280	
6		T7-TM13-05	40*40*5方通	熱浸鋅	6	0	6	件	8.970	53.817	

10

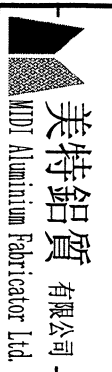

美特鋁質有限公司  
MDT Aluminium Fabricator Ltd.  
地盘鐵件BIM表

工程號:	J853 T7 6/F	計算:	李傳鵬	日期:	6/2/2023	送呈:
地盘名稱:	香港延坪道	核對:	練松文	日期:	6/2/2023	副本:
項目類別:	天花	批准:	陳梓豪	日期:	6/2/2023	
BIM編號:		A/C Code :	2023/02/06	鐵件總重量KG :	14124.74	
修改版次:						

序號	修改內容	鐵件圖號	鐵件名稱	顏色	實用	後備	總數	單位	單件重量(kg)	總重量(kg)	備注
172		T7-TM13-06	40*40*5方通	熱浸鋅	6	0	6	件	15.093	90.557	
173		T7-TM13-07	40*40*5方通	熱浸鋅	4	0	4	件	15.093	60.371	
174		T7-TM13-08	40*40*5方通	熱浸鋅	1	0	1	件	15.093	15.093	
175		T7-TM13-09	40*40*5方通	熱浸鋅	1	0	1	件	16.412	16.412	
176		T7-TM13-10	40*40*5方通	熱浸鋅	1	0	1	件	16.412	16.412	
177		T7-TM13-11	40*40*5方通	熱浸鋅	1	0	1	件	15.987	15.987	
178		T7-TM13-12	40*40*5方通	熱浸鋅	1	0	1	件	16.545	16.545	
179		T7-TM13-13	40*40*5方通	熱浸鋅	1	0	1	件	19.610	19.610	
180		T7-TM13-14	40*40*5方通	熱浸鋅	1	0	1	件	20.014	20.014	
181	A	T7-TM14-01	40*40*5方通	熱浸鋅	1	0	1	件	10.560	10.560	
182	A	T7-TM14-02	40*40*5方通	熱浸鋅	1	0	1	件	5.613	5.613	
183	A	T7-TM14-03	40*40*5方通	熱浸鋅	1	0	1	件	9.246	9.246	
184	A	T7-TM14-04	40*40*5方通	熱浸鋅	1	0	1	件	4.299	4.299	
185	A	T7-TM14-05	40*40*5方通	熱浸鋅	1	0	1	件	3.027	3.027	
186	A	T7-TM14-06	40*40*5方通	熱浸鋅	1	0	1	件	2.394	2.394	
187	A	T7-TM14-07	40*40*5方通	熱浸鋅	1	0	1	件	9.347	9.347	
188	A	T7-TM14-08	40*40*5方通	熱浸鋅	1	0	1	件	8.076	8.076	
189	A	T7-TM14-09	40*40*5方通	熱浸鋅	1	0	1	件	5.575	5.575	
190	A	T7-TM14-10	40*40*5方通	熱浸鋅	1	0	1	件	3.878	3.878	


(11)

美特鋁質有限公司 MOT Aluminium Fabricator Ltd.		工程號:	J853 T7 6/F	計算:	李傳鵬	日期:	6/2/2023	送呈:			
地盤鐵件BM表		地盤名稱:	香港延坪道	核對:	練松文	日期:	6/2/2023	副本:			
BM編號:		項目類別:	天花	批准:	陳梓豪	日期:	6/2/2023				
修改內容:		修改版次:		A/C Code:	2023/02/06	鐵件總重量KG:		14124.74			
序號	修改內容	鐵件圖號	鐵件名稱	顏色	實用	後備	總數	單位	單件 (kg)	總重量 (kg)	備注
191	A	T7-TM14-11	40*40*5方通	熱浸鋅	1	0	1	件	4.804	4.804	
192	A	T7-TM14-12	40*40*5方通	熱浸鋅	1	0	1	件	2.293	2.293	
193	A	T7-TM14-13	40*40*5方通	熱浸鋅	1	0	1	件	1.553	1.553	
194	A	T7-TM14-14	40*40*5方通	熱浸鋅	1	0	1	件	5.277	5.277	
195	A	T7-TM14-15	40*40*5方通	熱浸鋅	1	0	1	件	7.161	7.161	
196	A	T7-TM14-16	40*40*5方通	熱浸鋅	1	0	1	件	11.140	11.140	
197	A	T7-TM14-17	40*40*5方通	熱浸鋅	1	0	1	件	8.826	8.826	
198	A	T7-TM14-18	40*40*5方通	熱浸鋅	1	0	1	件	7.272	7.272	
199	A	T7-TM14-19	40*40*5方通	熱浸鋅	1	0	1	件	6.448	6.448	
200	A	T7-TM14-20	40*40*5方通	熱浸鋅	1	0	1	件	4.166	4.166	
201	A	T7-TM14-21	40*40*5方通	熱浸鋅	1	0	1	件	2.532	2.532	
202							1082			14124.744	



13



REV.	CHECKED DATE BY	PART NUMBER	Dim. A	Dim. B	Dim. C	Dim. D	Dim. E	Dim. F	Dim. G	QTY	Inv. Code	ASSEMBLE ON PARTS	EXTR. DRAWING PART DRAWING
-		T7-TM05-03	1810.0							16			
-		T7-TM05-04	1610.0							6			

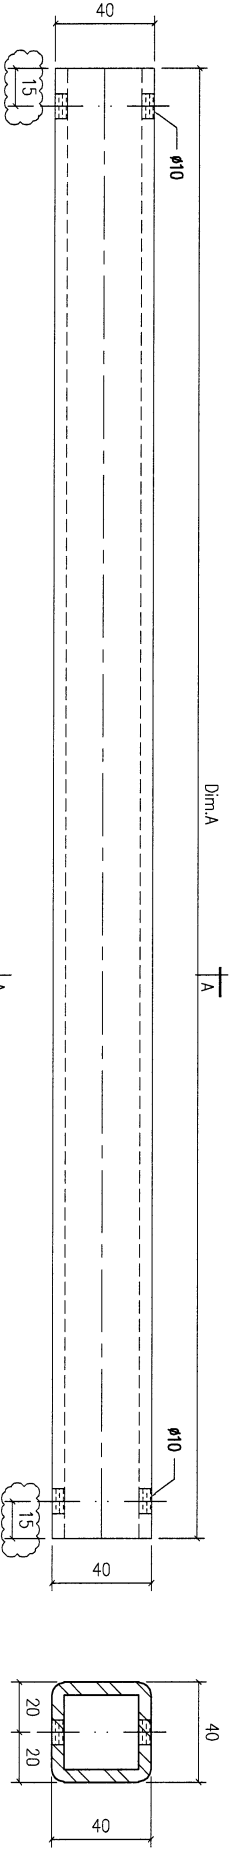

VS = VISIBLE SURFACE  
ALL DIMENSIONS IN MILLIMETRES

REV.	DATE	AMENDMENT	REVISED BY	<b>美特鋁質有限公司</b> MIDI ALUMINIUM FABRICATOR LTD. Units 6-8, Sunray Industrial Centre, 1/F 610 Cha Kwo Ling Road, Kowloon Tel: 23489211-4 Fax: (852) 27727666				JOB NO.	J853	DRAWING TITLE		鐵料加工圖 (橫通)	40x40x5mm THK. GMS. SHS.	DRAWING NO.	T7-TM05	SHT.	2 of 2	REV.	A
				FACTORY	W/CENTRE	CUT ENDS	FINISH	熱浸	POST PAINT	PART			REF: 8/8001						
				01	MOCK/STOCK/FAB	N/A			PRE PAINT	SUB ASSEM.									
				Standard	X X . = ±1	Angle	±1'		SCALE	TRACK TYPE									
				Tolerances	X X . X = ±0.5	Squareness	±1'	DATE	1:2	S.....									
							2/21/2023	DRAWN											
								YEUNG											

REV.	CHECKED DATE BY	PART NUMBER	Dim. A	Dim. B	Dim. C	Dim. D	Dim. E	Dim. F	Dim. G	QTY	Inv. Code	ASSEMBLE ON PARTS	EXTR. DRAWING PART DRAWING
-		T7-TM06-01	1834			10750				1			
-		T7-TM06-02	1655			9730				1			
-		T7-TM06-03	1389			8210				1			
-		T7-TM06-04	1298			7690				1			
-		T7-TM06-05	1119			6670				1			
-		T7-TM06-06	1832			10750				1			
-		T7-TM06-07	1653			9730				1			
-		T7-TM06-08	1385			8210				1			
-		T7-TM06-09	1294			7690				1			
-		T7-TM06-10	1116			6670				1			

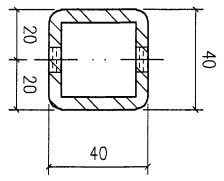
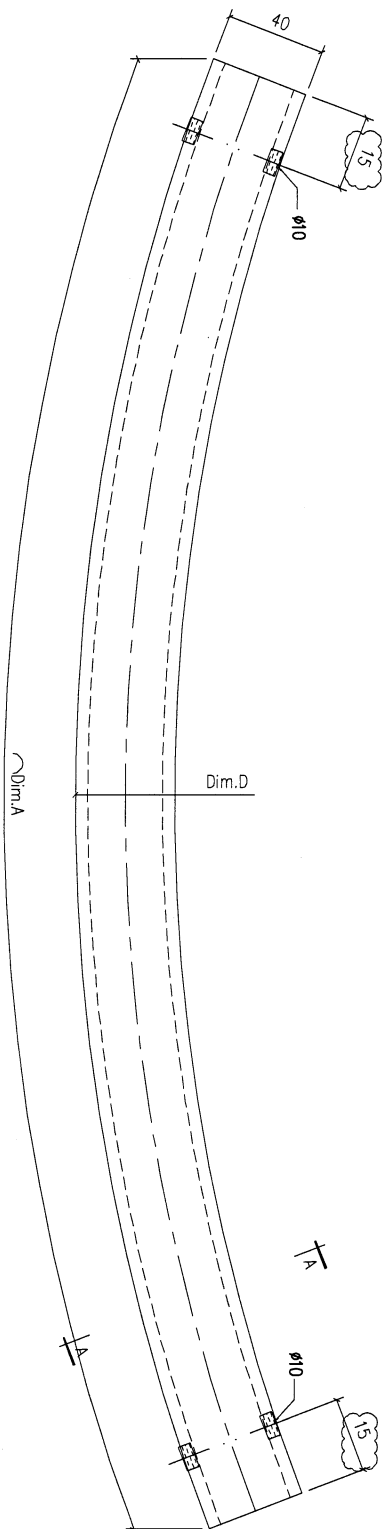


VS = VISIBLE SURFACE  
ALL DIMENSIONS IN MILLIMETRES

REV.	DATE	AMENDMENT	REVISED BY	<b>美特鋁質有限公司</b> MIDI ALUMINIUM FABRICATOR LTD. Units 6-8, Sunray Industrial Centre, 1/F 610, Cha Kwo Ling Road, Kowloon Tel: 23489211-4 Fax: (852) 27727666				JOB NO. <b>J853</b>	DRAWING TITLE <b>鐵料加工圖 (樣通)</b> <b>40x40x5mm THK. GMS. SIS.</b>	DRAWING NO. <b>T7-TM06</b>	SHEET <b>1 of 4</b>	REV. <b>A</b>
				FACTORY <b>01</b>	W/CENTRE MOK/SOK/FAB	CUT ENDS <b>N/A</b>	FINISH	POST PAINT PRE PAINT	PART SUB ASSEM.	TRACK TYPE S.....		
				Standard Tolerances	X X . = ±1 X X . X = ±0.5	Angle Squareness	±1 ±1°	DATE <b>2/21/2023</b>	DRAWN <b>YEUNG</b>	SCALE <b>1:2</b>	REF: 7/7001	

15

REV.	CHECKED DATE BY	PART NUMBER	Dim. A	Dim. B	Dim. C	Dim. D	Dim. E	Dim. F	Dim. G	QTY	Inv. Code	ASSEMBLE ON PARTS	EXTN. DRAWING PART DRAWING
-		T7-TM06-11	1840			10750				1			
-		T7-TM06-12	1660			9730				1			
-		T7-TM06-13	1392			8210				1			
-		T7-TM06-14	1302			7690				1			
-		T7-TM06-15	1123			6670				1			
-		T7-TM06-16	1826			12050				1			
-		T7-TM06-17	1667			11030				1			
-		T7-TM06-18	1431			9510				1			
-		T7-TM06-19	1350			8990				1			
-		T7-TM06-20	1191			7970				1			

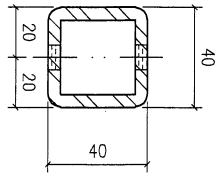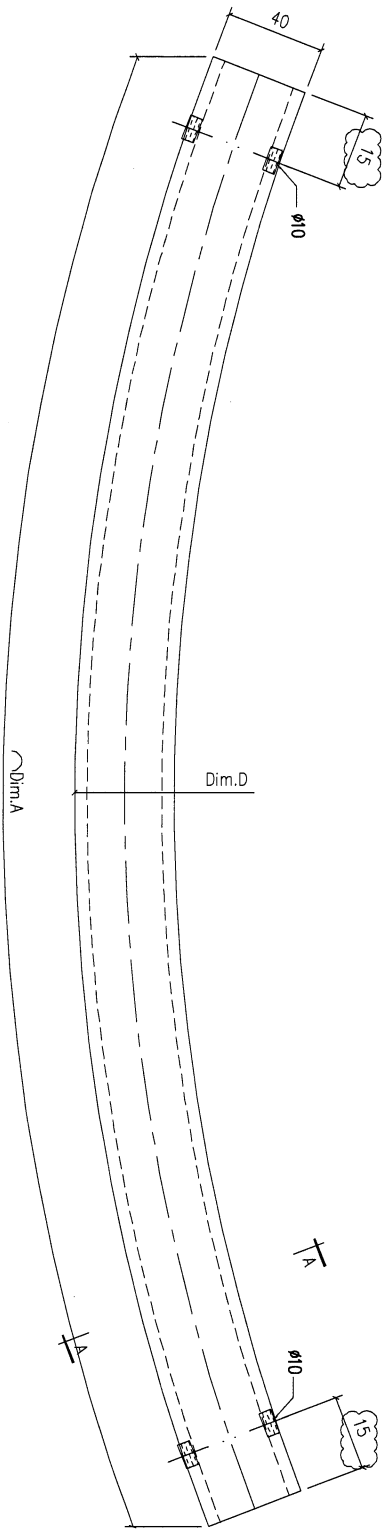


VS = VISIBLE SURFACE  
ALL DIMENSIONS IN MILLIMETRES

REV.	DATE	AMENDMENT	REVISED BY	<b>美特鋁質有限公司</b> MIDI ALUMINIUM FABRICATOR LTD. Units 6-8, Sunray Industrial Centre, 1/F 610 Cha Kwo Ling Road, Kowloon Tel: 23489211-4 Fax: (852) 2727666				PROJECT	JOB NO.	FACTORY	W/CENTRE	CUT ENDS	FINISH	DRAWN	POST PAINT	PART	SHT.	REV.		
A	21/02-23	-	-	Project J853-PODIUM ALUM CEILING & FEATURE CLADDING T7 7/F				J853	01	MOK/SOK/FAB	N/A			YEUNG	PRE PAINT	SUB ASSEM.	2 of 4	A		
DRAWING TITLE											鐵料加工圖 (橫通)		DRAWING NO.		T7-TM06		REF: 1/7001			
Standard											X X . = ±1		Angle		±1'		DATE		2/21/2023	
Tolerances											X X . X = ±0.5		Squareness		±1'		DATE		2/21/2023	
DIMENSIONS											40x40x5mm THK.		GMS SHS.							

16

REV.	CHECKED DATE BY	PART NUMBER	Dim. A	Dim. B	Dim. C	Dim. D	Dim. E	Dim. F	Dim. G	QTY	Inv. Code	ASSEMBLE ON PARTS	EXTR. DRAWING PART DRAWING
-		T7-TM06-21	1818			12050				1			
-		T7-TM06-22	1649			11030				1			
-		T7-TM06-23	1398			9510				1			
-		T7-TM06-24	1312			8990				1			
-		T7-TM06-25	1143			7970				1			
-		T7-TM06-26	1876			10750				1			
-		T7-TM06-27	1670			9730				1			
-		T7-TM06-28	1362			8210				1			
-		T7-TM06-29	1257			7690				1			
-		T7-TM06-30	1050			6670				1			


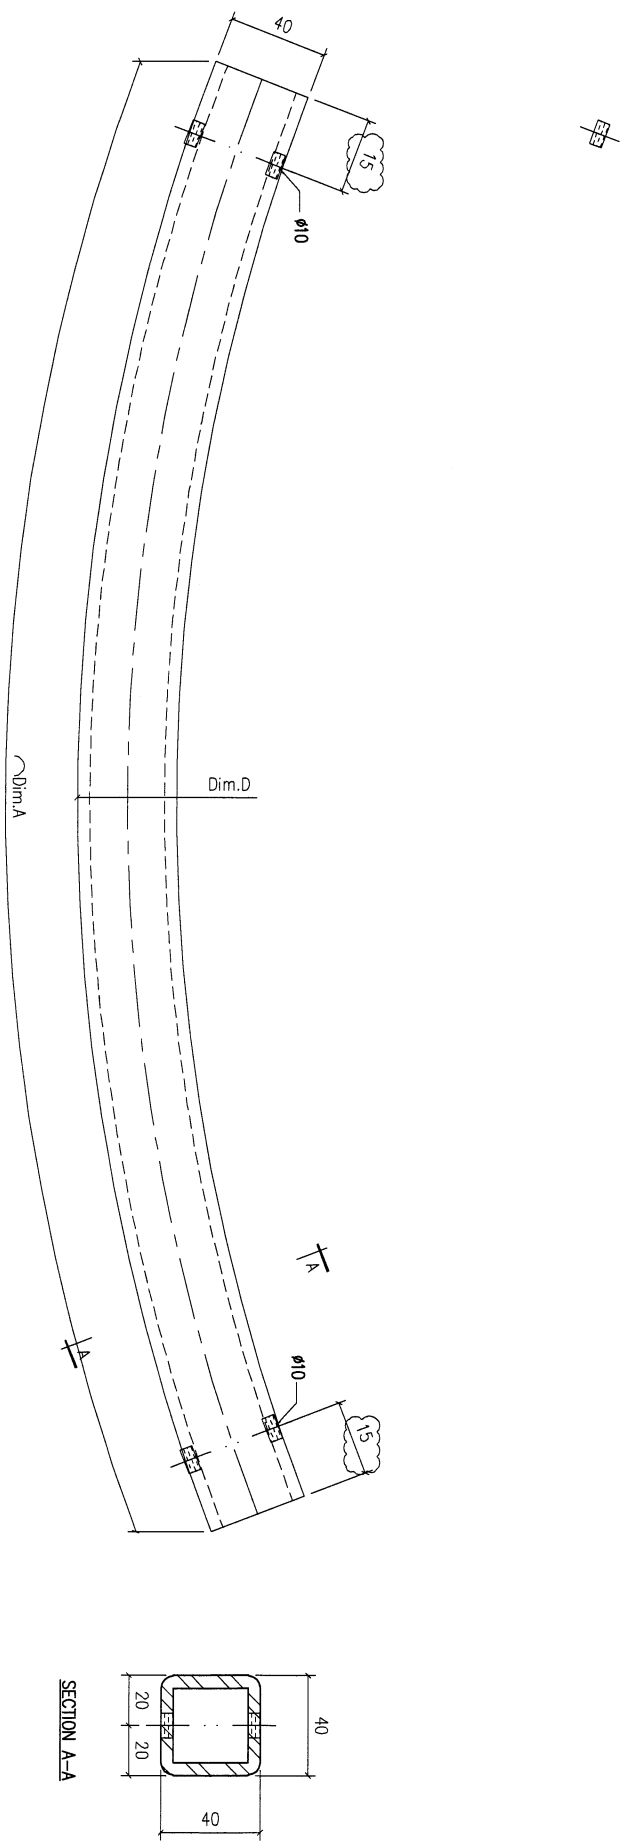


VS = VISIBLE SURFACE  
ALL DIMENSIONS IN MILLIMETRES

REV.	DATE	AMENDMENT	REVISED BY	<b>美特鋁質有限公司</b> MIDI ALUMINIUM FABRICATOR LTD. Units 6-8, Sunray Industrial Centre, 1/F 610 Cha Kwo Ling Road, Kowloon Tel:23489211-4 Fax:(852)27727666				JOB NO.	DRAWING TITLE		DATE	DRAWN	POST PAINT	PART	SHT.	REV.
A	21/02-23	-	-	PROJECT 1853-PODIUM ALUM CEILING & FEATURE CLADDING T7 7/F				J853	鐵料加工圖 (橫通) 40x40x5mm THK. GMS. SHS.		2/21/2023	YELUNG	SCALE 1:2	TRACK TYPE S....	3 of 4	A
				FACTORY	W./CENTRE	CUT ENDS	FINISH	熱浸		REF: 7/7001						
				01	MOCK/SOAK/FAB	N/A		PRE PAINT								
				Standard	X X . = ±1	Angle	±1'	SCALE								
				Tolerances	X X . X = ±0.5	Squareness	±1'	SCALE								

17

REV.	CHECKED CHK BY	PART NUMBER	Dim. A	Dim. B	Dim. C	Dim. D	Dim. E	Dim. F	Dim. G	QTY	Inv. Code	ASSEMBLE ON PARTS	EXTR. DRAWING PART DRAWING
-		T7-TM06-31	2006			10750				1			<input checked="" type="checkbox"/>
-		T7-TM06-32	1799			9730				1			<input type="checkbox"/>
-		T7-TM06-33	1491			8210				1			<input type="checkbox"/>
-		T7-TM06-34	1385			7690				1			<input type="checkbox"/>
-		T7-TM06-35	1178			6670				1			<input type="checkbox"/>

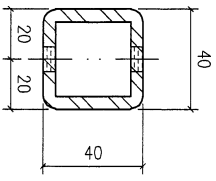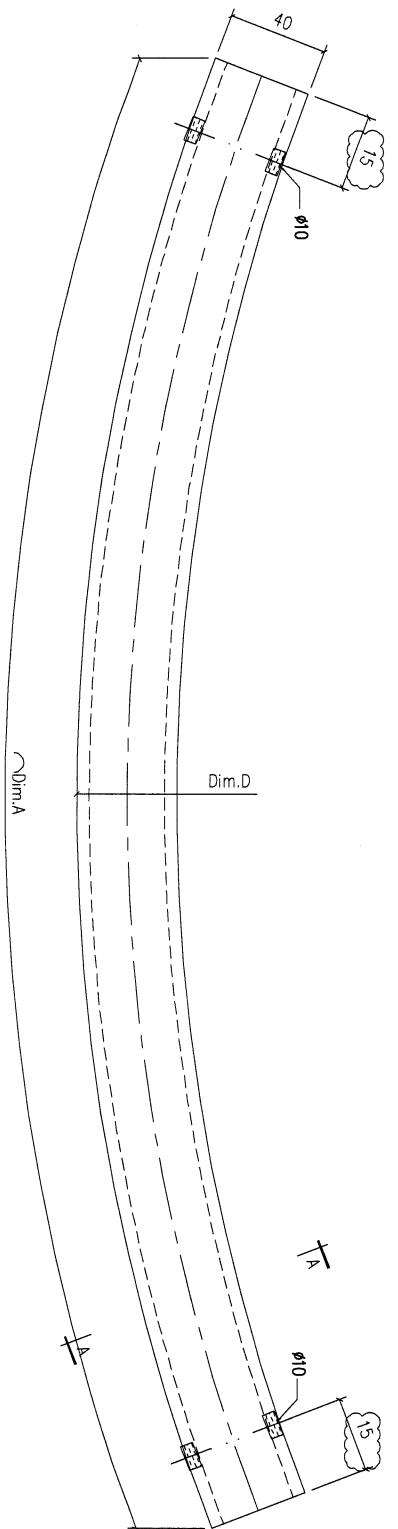


VS = VISIBLE SURFACE  
ALL DIMENSIONS IN MILLIMETRES

REV.	DATE	AMENDMENT	REVISED BY	<b>美特鋁質有限公司</b> MIDI ALUMINIUM FABRICATOR LTD. Units 6-8, Sunray Industrial Centre, 1/F 610 Cha Kwo Ling Road, Kowloon Tel: 23489211-4 Fax: (852) 27727866				PROJECT	JOB NO.	DRAWING TITLE		DRAWN	SCALE	PART	SHT.	REV.
A	21/02-23	-	-					J853-PODIUM ALUM. CEILING & FEATURE CLADDING T7 7/F	J853	鐵料加工圖 (橫通) 40x40x5mm THK. GMS. SHS.		YEUNG	1:2	TRUCK ASSEM.	4 of 4	A
				FACTORY	W/CENTRE	CUT ENDS	FINISH	POST PAINT		PART						
				01	MOK/SOK/FAB	N/A		PRE PAINT		SUB ASSEM.						
				Standard	X X . = ±1	Angle	±1'	DATE		DATE						
				Tolerances	X X . X = ±0.5	Squareness	±1'	2/21/2023		2/21/2023						
				DRAWING NO.		DRAWING NO.		T7-TM06		T7-TM06						
				REF: 7/7001		REF: 7/7001										

18


REV.	CHECKED DATE BY	PART NUMBER	Dim. A	Dim. B	Dim. C	Dim. D	Dim. E	Dim. F	Dim. G	QTY	Inv. Code	ASSEMBLE ON PARTS	EXTR. DRAWING PART DRAWING
-		T7-TM07-01	2000			11250				3			
-		T7-TM07-02	1792			10230				3			
-		T7-TM07-03	1583			9210				3			
-		T7-TM07-04	1272			7690				3			
-		T7-TM07-05	1166			7170				3			
-		T7-TM07-06	957			6150				3			
-		T7-TM07-07	1898			12550				1			
-		T7-TM07-08	1729			11530				1			
-		T7-TM07-09	1561			10510				1			
-		T7-TM07-10	1310			8990				1			
-		T7-TM07-11	1224			8470				1			
-		T7-TM07-12	1055			7450				1			

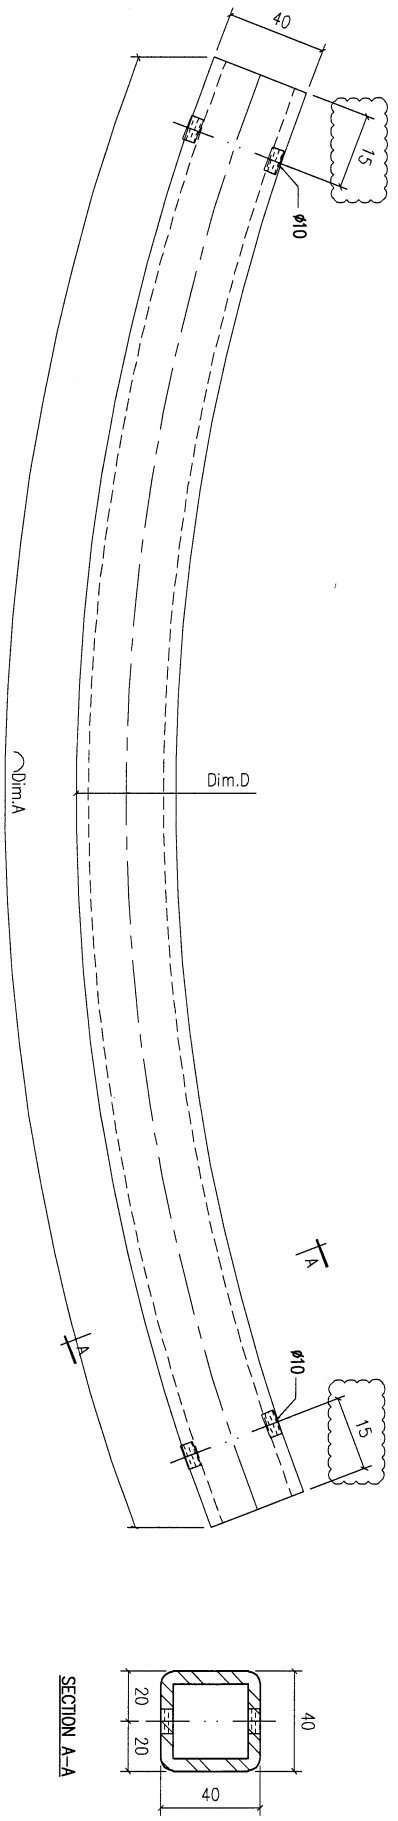

VS = VISIBLE SURFACE  
ALL DIMENSIONS IN MILLIMETRES

REV.	DATE	AMENDMENT	REVISED BY	<b>美特鋁質有限公司</b> MIDI ALUMINIUM FABRICATOR LTD. Units 6-8, Sunray Industrial Centre, 1/F, 610 Cha Kwo Ling Road, Kowloon Tel:23489211-4 Fax:(852)271727666				JOB NO.	J853	DRAWING TITLE		DRAWING NO.		SHT.	REV.
A	21/02-23	-	-	Project J853-PODIUM ALUM CEILING & FEATURE CLADDING T7 7/F				J853	鐵料加工圖(橫通)		T7-TM07		1 of 2	A	
				FACTORY	W/CENTRE	CUT ENDS	FINISH	POST PAINT	PART						
				01	MOE/SOE/FAB	N/A		PRE PAINT	SUB ASSEM.						
				Standard	X X . = ±1	Angle	±1'	SCALE	TRACK TYPE						
				Tolerances	X X . X = ±0.5	Squareness	±1'	1:2	S.....						
				DATE	2/21/2023										


REV.	CHECKED DATE BY	PART NUMBER	Dim. A	Dim. B	Dim. C	Dim. D	Dim. E	Dim. F	Dim. G	QTY	Inv. Code	ASSEMBLE ON PARTS	EXTR. DRAWING PART DRAWING
-		T7-TM07-13	1901			12550				1			
-		T7-TM07-14	1742			11530				1			
-		T7-TM07-15	1583			10510				1			
-		T7-TM07-16	1347			8990				1			
-		T7-TM07-17	1266			8470				1			
-		T7-TM07-18	1108			7450				1			
-		T7-TM07-19	1985			11250				1			
-		T7-TM07-20	1789			10230				1			
-		T7-TM07-21	1593			9210				1			
-		T7-TM07-22	1301			7690				1			
-		T7-TM07-23	1201			7170				1			
-		T7-TM07-24	1005			6150				1			

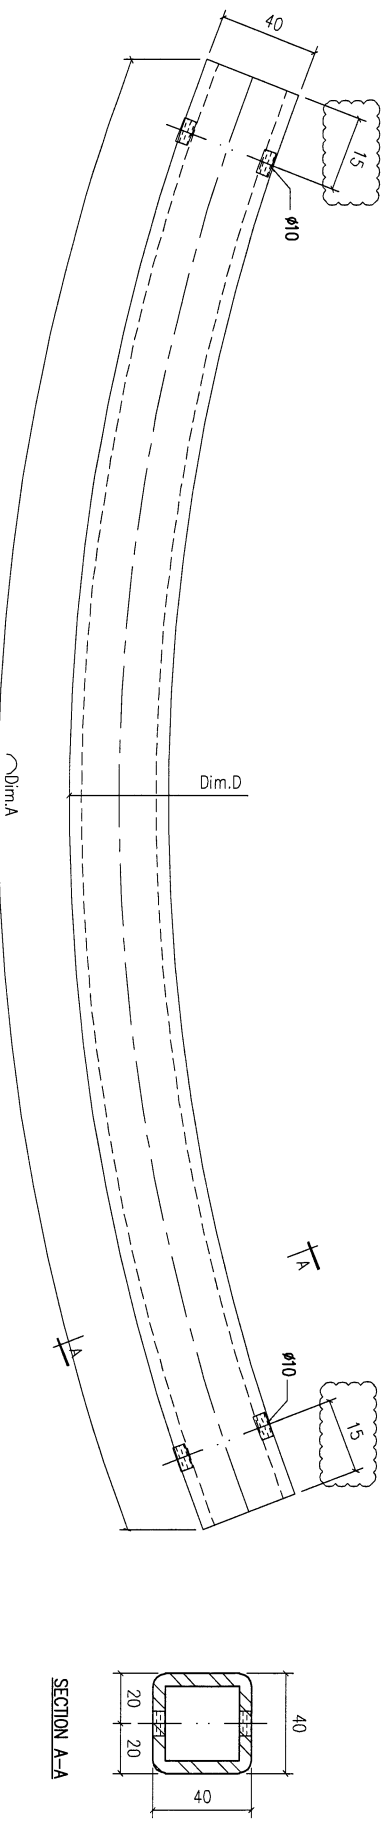

VS = VISIBLE SURFACE  
ALL DIMENSIONS IN MILLIMETRES

REV.	DATE	AMENDMENT	REVISED BY	<b>美特鋁質有限公司</b> MIDI ALUMINIUM FABRICATOR LTD. Units 6-8, Sunroy Industrial Centre, 1/F 610 Cha Kwo Ling Road, Kowloon Tel:23489211-4 Fax:(852)27727666				FACTORY	W/CENTRE	CUT ENDS	FINISH	DATE	DRAWN	POST PAINT	PART	SHT.	REV.
A	21/02-23	-	-	PROJECT	J853-PODIUM ALUM CEILING	JOB NO.	J853	Standard	X X . = ±1	Angle	±1°	2/21/2023	YELING	SCALE	1:2	TRACK TYPE	S.....
				PROJECT & FEATURE CLADDING T7 7/F DRAWING TITLE 鐵料加工圖 (橫通) 40x40x5mm THK. GMS. SHS.				Tolerances	X X . X = ±0.5	Squareness	±1°		DRAWING NO.	T7-TM07		2 of 2	A

REV.	CHECKED DATE BY	PART NUMBER	Dim. A	Dim. B	Dim. C	Dim. D	Dim. E	Dim. F	Dim. G	QTY	Inv. Code	ASSEMBLE ON PARTS	EXTR. DRAWING PART DRAWING
-		T7-TM14-01	1985.0							1			
-		T7-TM14-02	1055.0							1			
-		T7-TM14-03	1738.0							1			
-		T7-TM14-04	808.0							1			
-		T7-TM14-05	569.0							1			
-		T7-TM14-06	450.0							1			
-		T7-TM14-07	1757.0							1			
-		T7-TM14-08	1518.0							1			
-		T7-TM14-09	1048.0							1			
-		T7-TM14-10	729.0							1			
-		T7-TM14-11	903.0							1			
-		T7-TM14-12	431.0							1			
-		T7-TM14-13	292.0							1			
-		T7-TM14-14	992.0							1			
-		T7-TM14-15	1346.0							1			
-		T7-TM14-16	2094.0							1			
-		T7-TM14-17	1659.0							1			
-		T7-TM14-18	1367.0							1			
-		T7-TM14-19	1212.0							1			
-		T7-TM14-20	783.0							1			
-		T7-TM14-21	476.0							1			

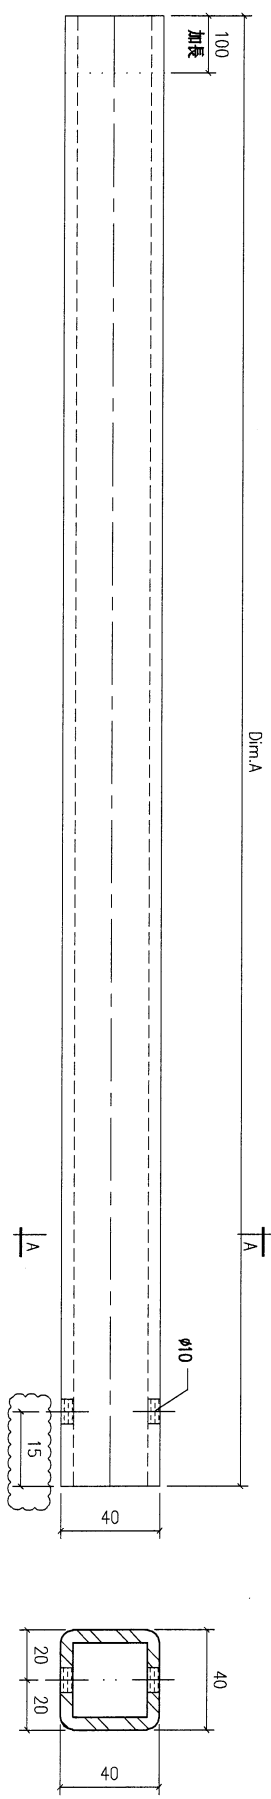

VS = VISIBLE SURFACE  
ALL DIMENSIONS IN MILLIMETRES

REV.	DATE	AMENDMENT	REVISED BY	<b>美特鋁質有限公司</b> MIDI ALUMINIUM FABRICATOR LTD. Units 6-8, Sunray Industrial Centre, 1/F 610 Cha Kwo Ling Road, Kowloon Tel:23489211-4 Fax:(852)27727666				JOB NO.	DRAWING TITLE	FACTORY	W/CENTRE	CUT ENDS	FINISH	DRAWN	POST PAINT	PART	SHT.	REV.
A	21/02-23	-	-	PROJECT 1853-PODIUM ALUM CEILING & FEATURE CLADDING T7 7/F				J853	鐵料加工圖 (接通) 40x40x5mm THK. GMS. SHS.	01	MOK/SOK/FAB	N/A		YEUNG	PRE PAINT	SUB ASSEM.	1 of 1	A
				Standard X X . = ±1 Tolerances X X . X = ±0.5 Angle ±1' Squareness ±1'								DATE	SCALE	TRACK TYPE				
				REF: 1877001								2/21/2023	1:2	S...				