

工程指示 / 要求簡箋 ENGINEER INSTRUCTIONS (E.I.)

工程指示編號:	EI- 5958	修改版本:	-
	HK-0660		
工程編號:	J 853	工程名稱:	延坪道
收件人:	生統 / 阿峰	發件人:	Joe Chan
工程項目:	T7, 23B 趟門修改	日期:	03/04/2023

<input checked="" type="checkbox"/> 原合約工程包	<input type="checkbox"/> 原合約工程加 / 減賬 QT-	<input type="checkbox"/> 新工程報價 QT-
--	--	------------------------------------

信件批核號碼/圖紙參考編號:	批核模具圖紙編號:
客戶指示附件:	管理內部批簽署:

<input type="checkbox"/> 初步鋁料 B.M.	<input type="checkbox"/> 加工拆圖, 然後生產	<input type="checkbox"/> 尺寸表
<input type="checkbox"/> 正式鋁料 B.M.	<input type="checkbox"/> 技術上資料/指示	<input type="checkbox"/> 報價
<input type="checkbox"/> 配件 B.M.	<input type="checkbox"/> 樣辦或貨品說明書	<input type="checkbox"/> 分判合約
<input type="checkbox"/> 其他:		

內容:	請按地盤覆數之 S.O. 生產 $\frac{W272}{T7}$ 之 趟門王。 一門框料已送地盤, 由工地自行修改
完成上列要求日期:	08/04/2023 ASAP


國內

<input type="checkbox"/> 生產技術總監	<input type="checkbox"/> 連附件	<input type="checkbox"/> 技術部	<input type="checkbox"/> 連附件	<input type="checkbox"/> 生產部	<input type="checkbox"/> 連附件
<input type="checkbox"/> 採購部	<input type="checkbox"/> 連附件	<input checked="" type="checkbox"/> 生產統籌部	<input checked="" type="checkbox"/> 連附件	<input type="checkbox"/> 報關組	<input type="checkbox"/> 連附件
<input type="checkbox"/> 質檢部	<input type="checkbox"/> 連附件	<input type="checkbox"/> 會計部	<input type="checkbox"/> 連附件	<input type="checkbox"/> 機械設計部	<input type="checkbox"/> 連附件
<input type="checkbox"/> 香港辦	<input type="checkbox"/> 連附件	<input type="checkbox"/> 其他:			

香港

<input type="checkbox"/> 行政部	<input type="checkbox"/> 連附件	<input type="checkbox"/> 會計部	<input type="checkbox"/> 連附件	<input type="checkbox"/> 統籌部	<input type="checkbox"/> 連附件	<input type="checkbox"/> 工程部	<input type="checkbox"/> 連附件
<input type="checkbox"/> 採購部	<input type="checkbox"/> 連附件	<input type="checkbox"/> QS部	<input type="checkbox"/> 連附件	<input checked="" type="checkbox"/> 地盤管理	<input checked="" type="checkbox"/> 連附件	<input type="checkbox"/> 維修部	<input type="checkbox"/> 連附件

*發件人簽署:		*組別成員批核簽署:	
傳遞編號:	HK0660 / 23	項目經理簽署:	

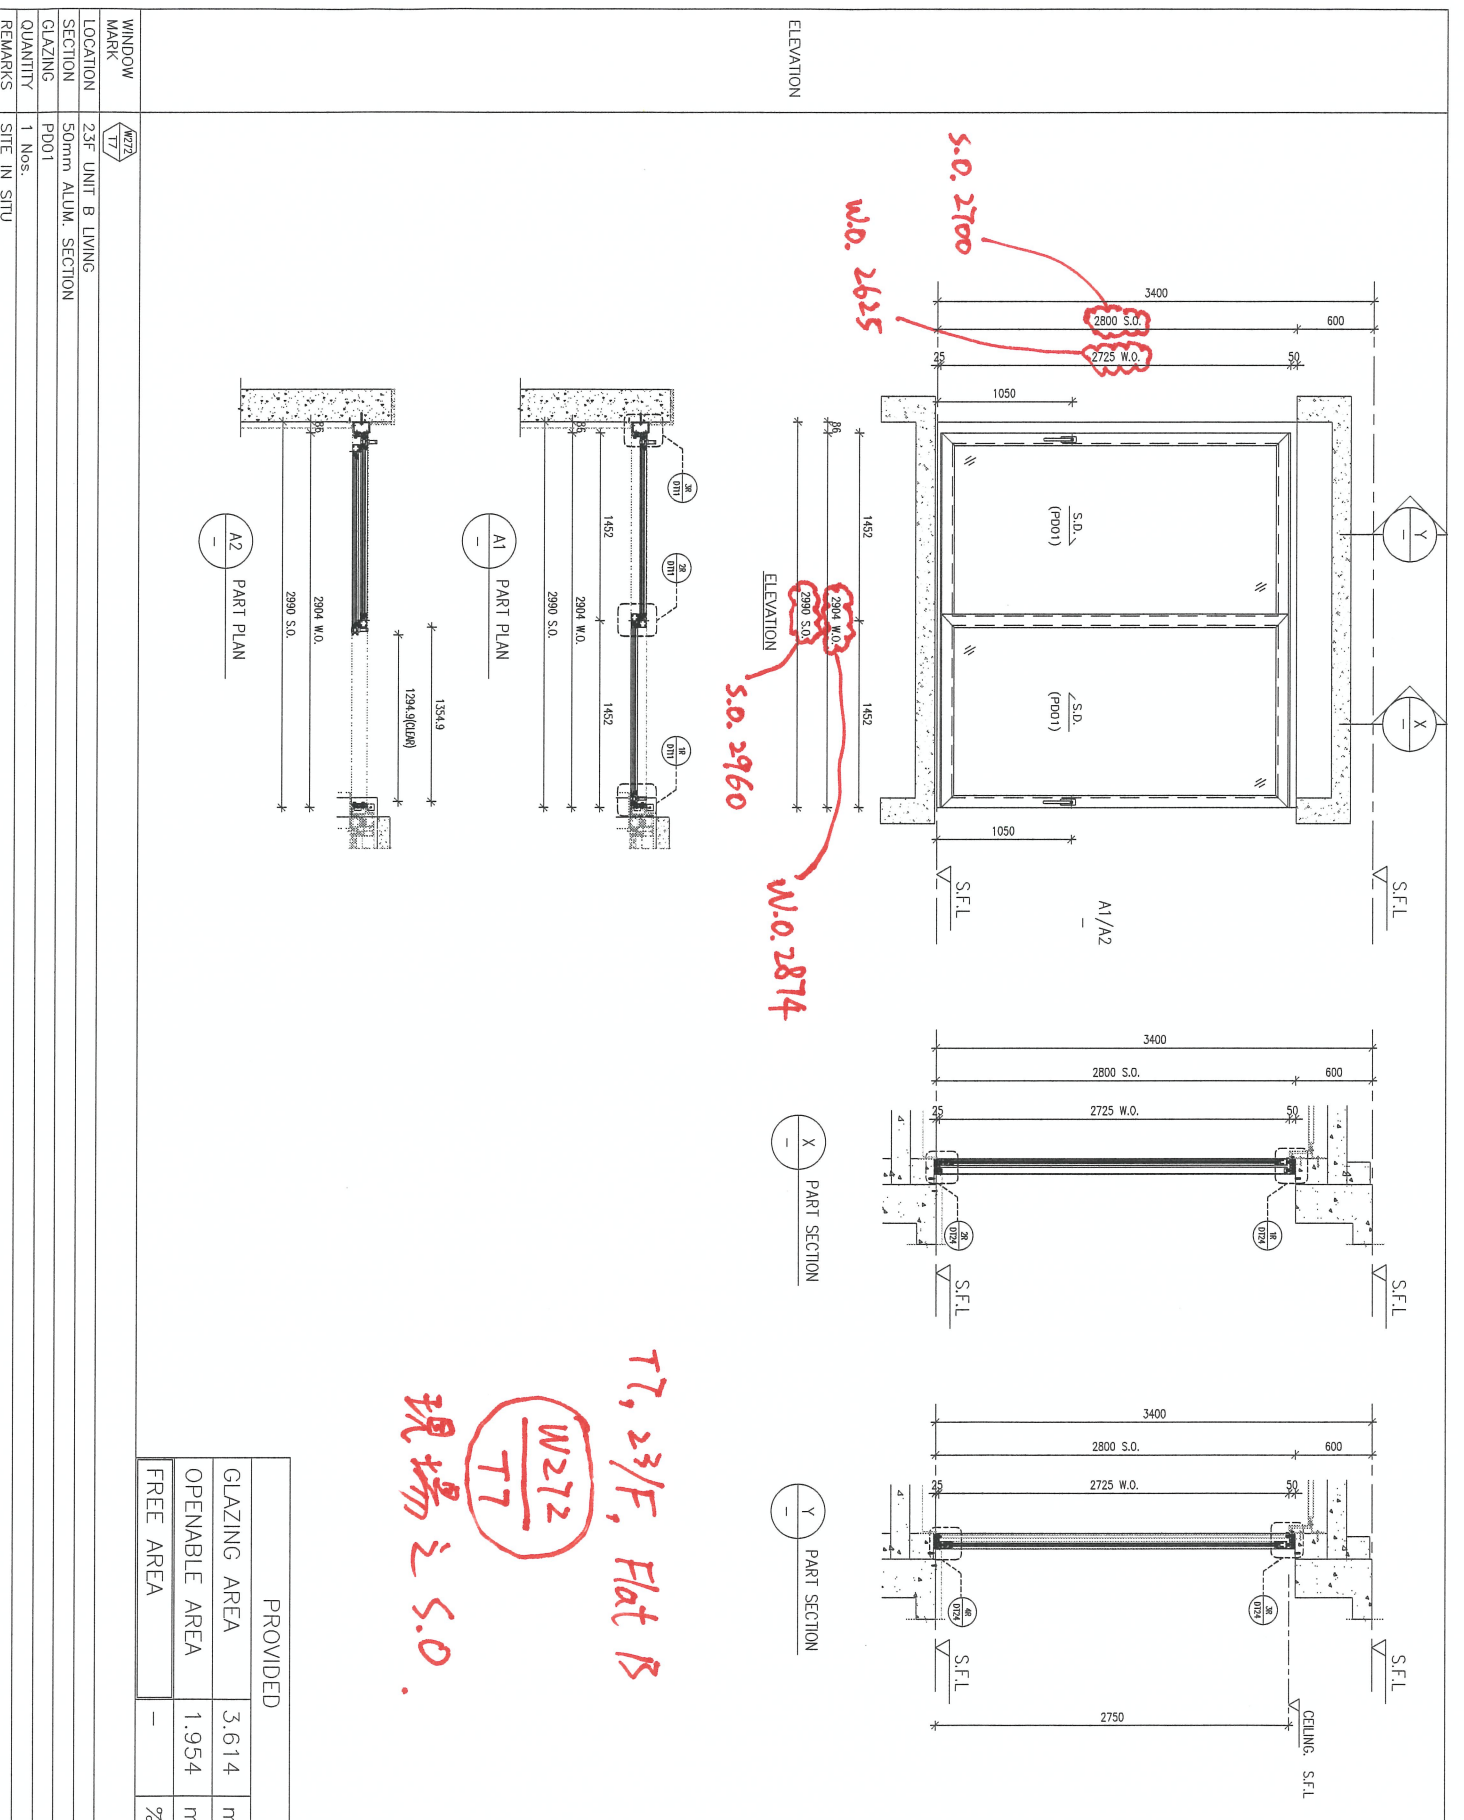

WINDOW MARK	W272
LOCATION	23/F UNIT B LIVING
SECTION	50mm ALUM. SECTION
GLAZING	PD01
QUANTITY	1 Nos.
REMARKS	SITE IN SITU

CLIENT : SHIMAO GROUP HOLDINGS LIMITED

ARCHITECT : HONG TUNG & PARTNERS LIMITED

MAIN CONTRACTOR : 協興建築有限公司
HP HING CONSTRUCTION CO LTD

STRUCTURAL ENGINEER : C M WONG & ASSOCIATES LTD

SITE IN SITU CONSULTANT : MENYHARDT Consulting Engineers

DATE : 16/04/2022

PROJECT : PROPOSED RESIDENTIAL DEVELOPMENT AT N.K.I.L. 6542 YIN PING ROAD KOWLOON

TITLE : WINDOW SCHEDULE FOR TOWER 7 ALUM. WINDOW

SCALE : 1:10

DATE : 03-APR-21

DRAWN BY : [Signature]

CHECKED BY : [Signature]

JOB NO. : J-853

REVISION SUBJECT TO APPROVAL

NO.	DATE	DESCRIPTION	BY
1	16/04/2022	ISSUED SUBJECT TO APPROVAL	[Signature]

NOTES :

- ALL DIMENSIONS ARE IN mm.
- ALL DIMENSIONS ARE MEASURED FROM OUTSIDE.
- ALL DIMENSIONS TO BE VERIFIED ON SITE BEFORE FABRICATION.

LEGEND :

1. F.F.L. --- FINISHED FLOOR LEVEL
2. S.F.L. --- STRUCTURAL FLOOR LEVEL
3. (P) --- REVERSED DETAIL
4. (X) --- FINISH LOCATION
5. Δ --- FINISH UIC LOCATION
6. QUASS LEGEND

GL01 --- 10mm+12mm AIR GP+10mm THK. IGUL
GL05 --- 10mm+12mm AIR GP+10mm THK. IGUL
GL06 --- 10mm+12mm AIR GP+12mm THK. IGUL
PD01 --- 10mm TP+12mm AIR GP+10mm TP
GL07 --- 10mm+12mm AIR GP+12mm THK. IGUL
GL08 --- 10mm+12mm AIR GP+10mm THK. IGUL

REMARKS : T7, 23/F, Flat B
現場之 S.O.