

工程指示 / 要求簡箋 ENGINEER INSTRUCTIONS(E.I.)

| | | | |
|---------|----------|-------|------------|
| 工程指示編號: | EI- 6233 | 修改版本: | - |
| | HK- / | | |
| 工程編號: | J 853 | 工程名稱: | 延坪道 |
| 收件人: | 林哥 | 發件人: | Joe Chan |
| 工程項目: | 趙門用螺絲 | 日期: | 23/05/2023 |

| | | |
|--|--|------------------------------------|
| <input checked="" type="checkbox"/> 原合約工程包 | <input type="checkbox"/> 原合約工程加 / 減賬 QT- | <input type="checkbox"/> 新工程報價 QT- |
|--|--|------------------------------------|

| | |
|----------------|-----------|
| 信件批核號碼/圖紙參考編號: | 批核模具圖紙編號: |
| 客戶指示附件: | 管理內部批簽署: |

| | | |
|------------------------------------|-------------------------------------|-------------------------------|
| <input type="checkbox"/> 初步鋁料 B.M. | <input type="checkbox"/> 加工拆圖, 然後生產 | <input type="checkbox"/> 尺寸表 |
| <input type="checkbox"/> 正式鋁料 B.M. | <input type="checkbox"/> 技術上資料/指示 | <input type="checkbox"/> 報價 |
| <input type="checkbox"/> 配件 B.M. | <input type="checkbox"/> 樣辦或貨品說明書 | <input type="checkbox"/> 分判合約 |
| <input type="checkbox"/> 其他: | | |

內容: 請訂購 M5 x 125 平頭機絲 150 粒 (A4-70)
送地盤 (用於趙門安裝).

完成上列要求日期: ASAP


國內

| | | | | | |
|---------------------------------|------------------------------|--------------------------------|------------------------------|--------------------------------|------------------------------|
| <input type="checkbox"/> 生產技術總監 | <input type="checkbox"/> 連附件 | <input type="checkbox"/> 技術部 | <input type="checkbox"/> 連附件 | <input type="checkbox"/> 生產部 | <input type="checkbox"/> 連附件 |
| <input type="checkbox"/> 採購部 | <input type="checkbox"/> 連附件 | <input type="checkbox"/> 生產統籌部 | <input type="checkbox"/> 連附件 | <input type="checkbox"/> 報關組 | <input type="checkbox"/> 連附件 |
| <input type="checkbox"/> 質檢部 | <input type="checkbox"/> 連附件 | <input type="checkbox"/> 會計部 | <input type="checkbox"/> 連附件 | <input type="checkbox"/> 機械設計部 | <input type="checkbox"/> 連附件 |
| <input type="checkbox"/> 香港辦 | <input type="checkbox"/> 連附件 | <input type="checkbox"/> 其他: | | | |


香港

| | | | | | | | |
|------------------------------|------------------------------|------------------------------|------------------------------|--|---|------------------------------|------------------------------|
| <input type="checkbox"/> 行政部 | <input type="checkbox"/> 連附件 | <input type="checkbox"/> 會計部 | <input type="checkbox"/> 連附件 | <input type="checkbox"/> 統籌部 | <input type="checkbox"/> 連附件 | <input type="checkbox"/> 工程部 | <input type="checkbox"/> 連附件 |
| <input type="checkbox"/> 採購部 | <input type="checkbox"/> 連附件 | <input type="checkbox"/> QS部 | <input type="checkbox"/> 連附件 | <input checked="" type="checkbox"/> 地盤管理 | <input checked="" type="checkbox"/> 連附件 | <input type="checkbox"/> 維修部 | <input type="checkbox"/> 連附件 |


| | | | |
|---------|--|------------|--|
| *發件人簽署: | | *組別成員批核簽署: | |
| 傳遞編號: | | 項目經理簽署: | |

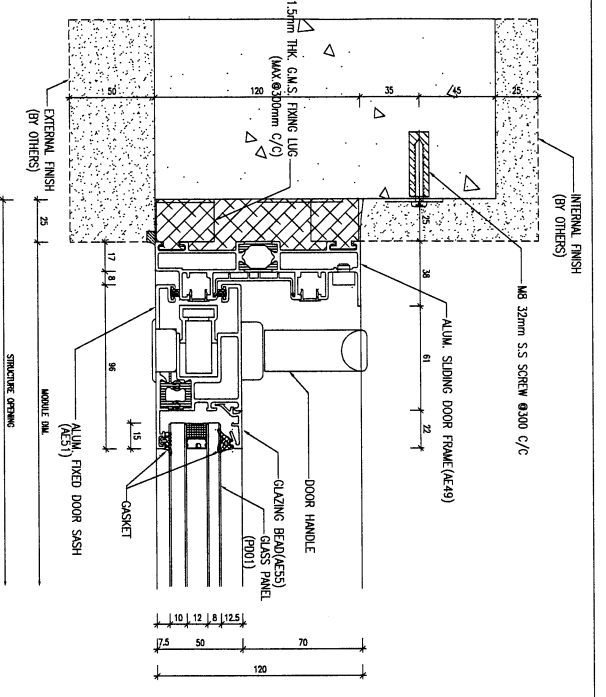

1 HORIZONTAL DETAIL
DT15 SLIDING DOOR

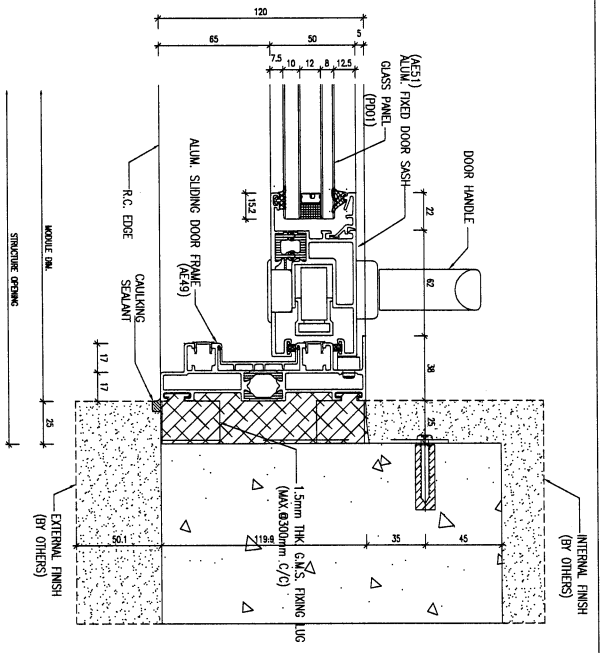

2 HORIZONTAL DETAIL
DT15 SLIDING DOOR

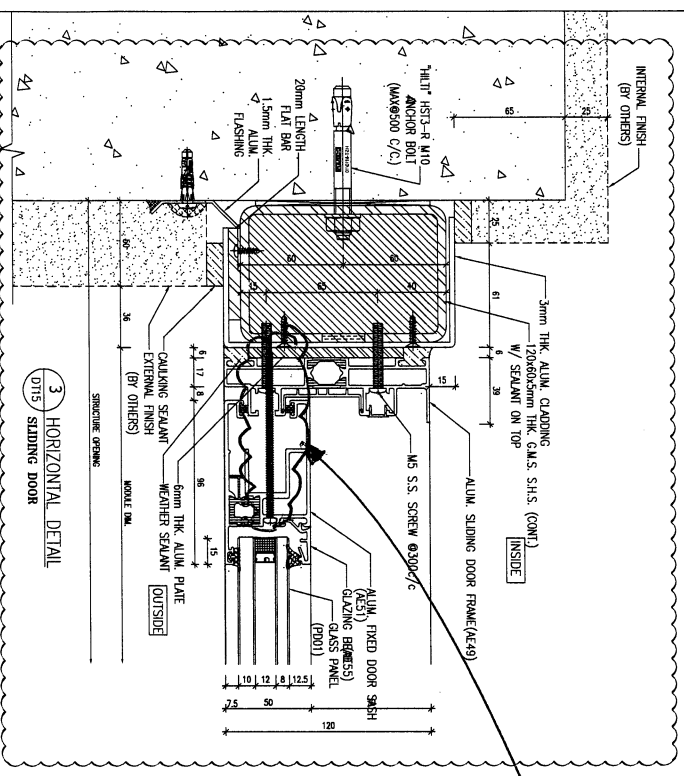

3 HORIZONTAL DETAIL
DT15 SLIDING DOOR

此螺絲
150粒
MS X 125 平頭螺絲

B.O. REF. :

CLIENT :

SHIMAO GROUP
HOLDINGS LIMITED

ARCHITECT :

YONG TING & PARTNERS LIMITED

MAIN CONTRACTOR :

協興建築有限公司
HIP HING CONSTRUCTION CO LTD

STRUCTURAL ENGINEER :

CGMA C.M WONG & ASSOCIATES LTD
黃志輝建築工程師有限公司

FRAME CONSULTANT :

WENHART

NOTE :
1. ALL DIMENSIONS ARE IN MM.
2. ALL ELEVATIONS ARE VIEWED FROM OUTSIDE.
3. ALL DIMENSIONS TO BE VERIFIED ON SITE BEFORE FABRICATION.

LEGEND :

- ① - DETAIL MARK NO.
- ② - REFER SHEET NO.
- 1. F.F.L. - FINISHED FLOOR LEVEL
- 2. S.F.L. - STRUCTURAL FLOOR LEVEL
- 3. - RESERVED DETAIL
- 4. - FRANK LOCATION
- 5. A, A' - FRANK LIG LOCATION
- 6. S.O.S. LEGEND
- S.O.1 - 10mm x 12mm HR GR4+10mm THK. L&U
- S.O.2 - 10mm x 12mm HR GR4+10mm THK. L&U
- S.O.3 - 10mm x 12mm HR GR4+12mm THK. L&U
- S.O.4 - 10mm x 12mm HR GR4+12mm THK. L&U
- S.O.5 - 10mm x 12mm HR GR4+12mm THK. L&U
- S.O.6 - 10mm x 12mm HR GR4+12mm THK. L&U
- S.O.7 - 10mm x 12mm HR GR4+12mm THK. L&U
- S.O.8 - 10mm x 12mm HR GR4+10mm THK. L&U

| NO. | DATE/REVISED | REVISION SUBJECT TO APPROVEMENT | DATE |
|-----|--------------|---------------------------------|------------|
| 1 | 16/12/2022 | REVISION SUBJECT TO APPROVEMENT | 16/12/2022 |
| 2 | 16/12/2022 | REVISION SUBJECT TO APPROVEMENT | 16/12/2022 |

JOB NO. : J-853
PROJECT : PROPOSED RESIDENTIAL DEVELOPMENT AT N.K.I.L. 6542 YIN PING ROAD KOWLOON

TITLE : TYPICAL DETAILS FOR SLIDING DOOR

DATE : 03-APR-21
SCALE : 1 : 3 (A3)
DRAWN BY : A.C.
CHECKED BY :

UNIT 6-8, SINGYI INDUSTRIAL CENTRE, 1/F
KOWLOON
YONG TING & PARTNERS LIMITED
TEL: 24248021
FAX: 24248022
WWW.YTP.COM.HK

DATE : 03-APR-21
SCALE : 1 : 3 (A3)
DRAWN BY : A.C.
CHECKED BY :
JOB NO. : J-853-SD-W-DT15
REV. : C