

工程指示 / 要求簡箋 ENGINEER INSTRUCTIONS(E.I.)

工程指示編號:	EI- 6811	修改版本:	-
	HK-2270		
工程編號:	J 853	工程名稱:	延坪道
收件人:	生統	發件人:	Joe Chan
工程項目:	T1, Flat A, 18~22/F 露台天花鋁板.	日期:	06/10/2023

<input type="checkbox"/> 原合約工程包	<input type="checkbox"/> 原合約工程加 / 減賬 QT-	<input type="checkbox"/> 新工程報價 QT-
---------------------------------	--	------------------------------------

信件批核號碼/圖紙參考編號:	批核模具圖紙編號:
客戶指示附件:	管理內部批簽署:

<input type="checkbox"/> 初步鋁料 B.M.	<input type="checkbox"/> 加工拆圖, 然後生產	<input type="checkbox"/> 尺寸表
<input type="checkbox"/> 正式鋁料 B.M.	<input type="checkbox"/> 技術上資料 / 指示	<input type="checkbox"/> 報價
<input type="checkbox"/> 配件 B.M.	<input type="checkbox"/> 樣辦或貨品說明書	<input type="checkbox"/> 分判合約
<input type="checkbox"/> 其他:		

內容: T1, Flat A (18~22/F) 露台天花鋁板, 由於現場鋁板錯色, 需補回正確顏色之鋁板.

完成上列要求日期: 20/10/2023


國內

<input type="checkbox"/> 生產技術總監	<input type="checkbox"/> 連附件	<input type="checkbox"/> 技術部	<input type="checkbox"/> 連附件	<input type="checkbox"/> 生產部	<input type="checkbox"/> 連附件
<input type="checkbox"/> 採購部	<input type="checkbox"/> 連附件	<input checked="" type="checkbox"/> 生產統籌部	<input checked="" type="checkbox"/> 連附件	<input type="checkbox"/> 報關組	<input type="checkbox"/> 連附件
<input type="checkbox"/> 質檢部	<input type="checkbox"/> 連附件	<input type="checkbox"/> 會計部	<input type="checkbox"/> 連附件	<input type="checkbox"/> 機械設計部	<input type="checkbox"/> 連附件
<input type="checkbox"/> 香港辦	<input type="checkbox"/> 連附件	<input type="checkbox"/> 其他:			

香港

<input type="checkbox"/> 行政部	<input type="checkbox"/> 連附件	<input type="checkbox"/> 會計部	<input type="checkbox"/> 連附件	<input checked="" type="checkbox"/> 統籌部	<input type="checkbox"/> 連附件	<input type="checkbox"/> 工程部	<input type="checkbox"/> 連附件
<input type="checkbox"/> 採購部	<input type="checkbox"/> 連附件	<input type="checkbox"/> QS部	<input type="checkbox"/> 連附件	<input checked="" type="checkbox"/> 地盤管理	<input checked="" type="checkbox"/> 連附件	<input type="checkbox"/> 維修部	<input type="checkbox"/> 連附件

*發件人簽署:		*組別成員批核簽署:	
傳遞編號:	HK2270/23	項目經理簽署:	

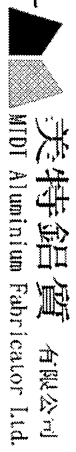

美特鋁質 有限公司
MTDI Aluminium Fabricator Ltd.

地盤用鋁板B.M.表

工程號: J853
地盤名稱: 延平道
項目類別: 天花鋁板 (T1) 補板
修改版次:


計算: JOE
核對: JOE

日期:
日期:
日期:

總重量: 224.47

送呈:
副本:
此B.M.依據**拆圖資料計算



序號	修改內容	鋁板圖號	鋁板名稱	顏色	實用	後備	總數	總重量	單件展開面積		總展開面積		備註	加工圖號
									平方米	平方米	平方米	平方米		
1		T1-ALC-AP54	3.0mm厚鋁板	ECW3D97528S-ZD1	5	0	5	74.940	1.844	9.218	1.638	8.188		J853-ALC-AP386
2		T1-ALC-AP55	3.0mm厚鋁板	ECW3D97528S-ZD1	5	0	5	74.766	1.839	9.196	1.634	8.168		J853-ALC-AP387
3		T1-ALC-AP56	3.0mm厚鋁板	ECW3D97528S-ZD1	5	0	5	74.766	1.839	9.196	1.634	8.168		J853-ALC-AP388
								總計:	15	224.47	27.61	24.52		

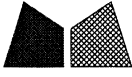

美特鋁質 有限公司
MIDI Aluminium Fabricator Ltd.


工程號 J853 地盤 錦上路

送批盤

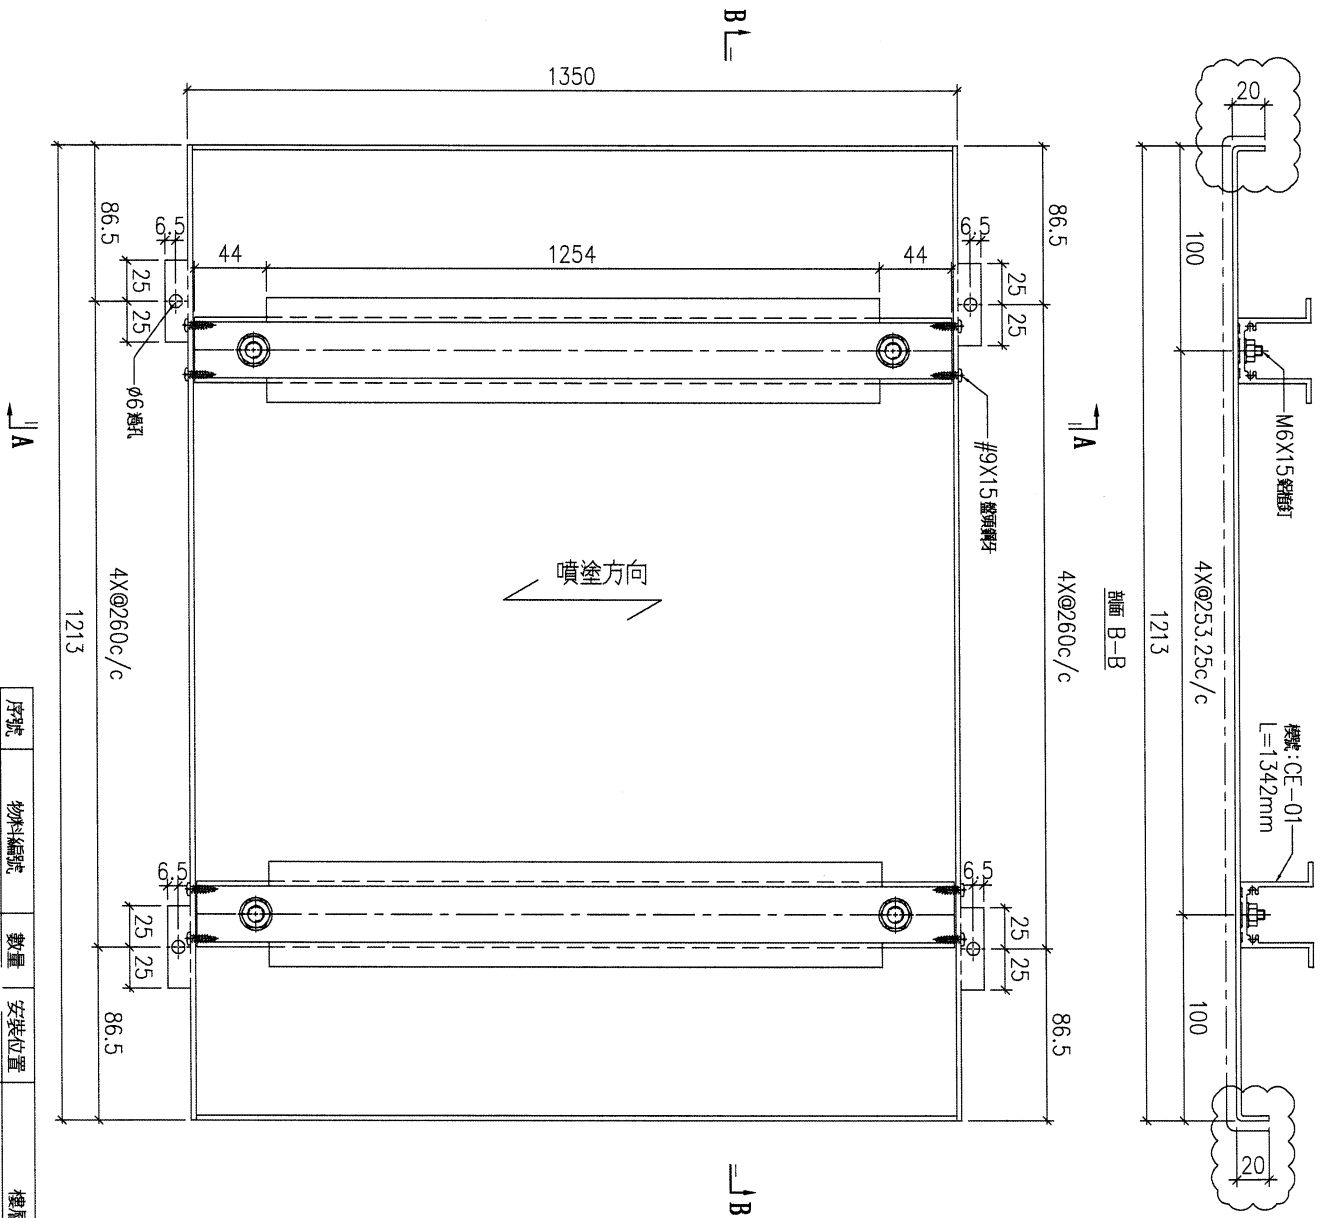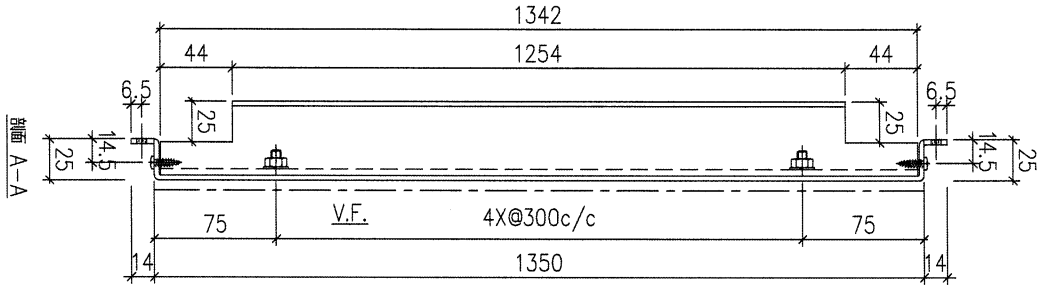

序號	物料編號	數量	安裝位置	樓層
01	T1-ALC-AP54	5	T1 FLAT A	18~22/F



名稱	天花鋁板加工圖	制圖	LHR	2022.3.29	修改	A
材料	3mm厚鋁板 (3003H14)	復核	-	-	日期	2022.5.26
顏色	ECW3D97528S-ZD1	批準			圖號	J853-ALC-AP386

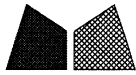

美特鋁質 有限公司
MIDI Aluminium Fabricator Ltd.


工程號 J853 地盤 錦上路

送地盤

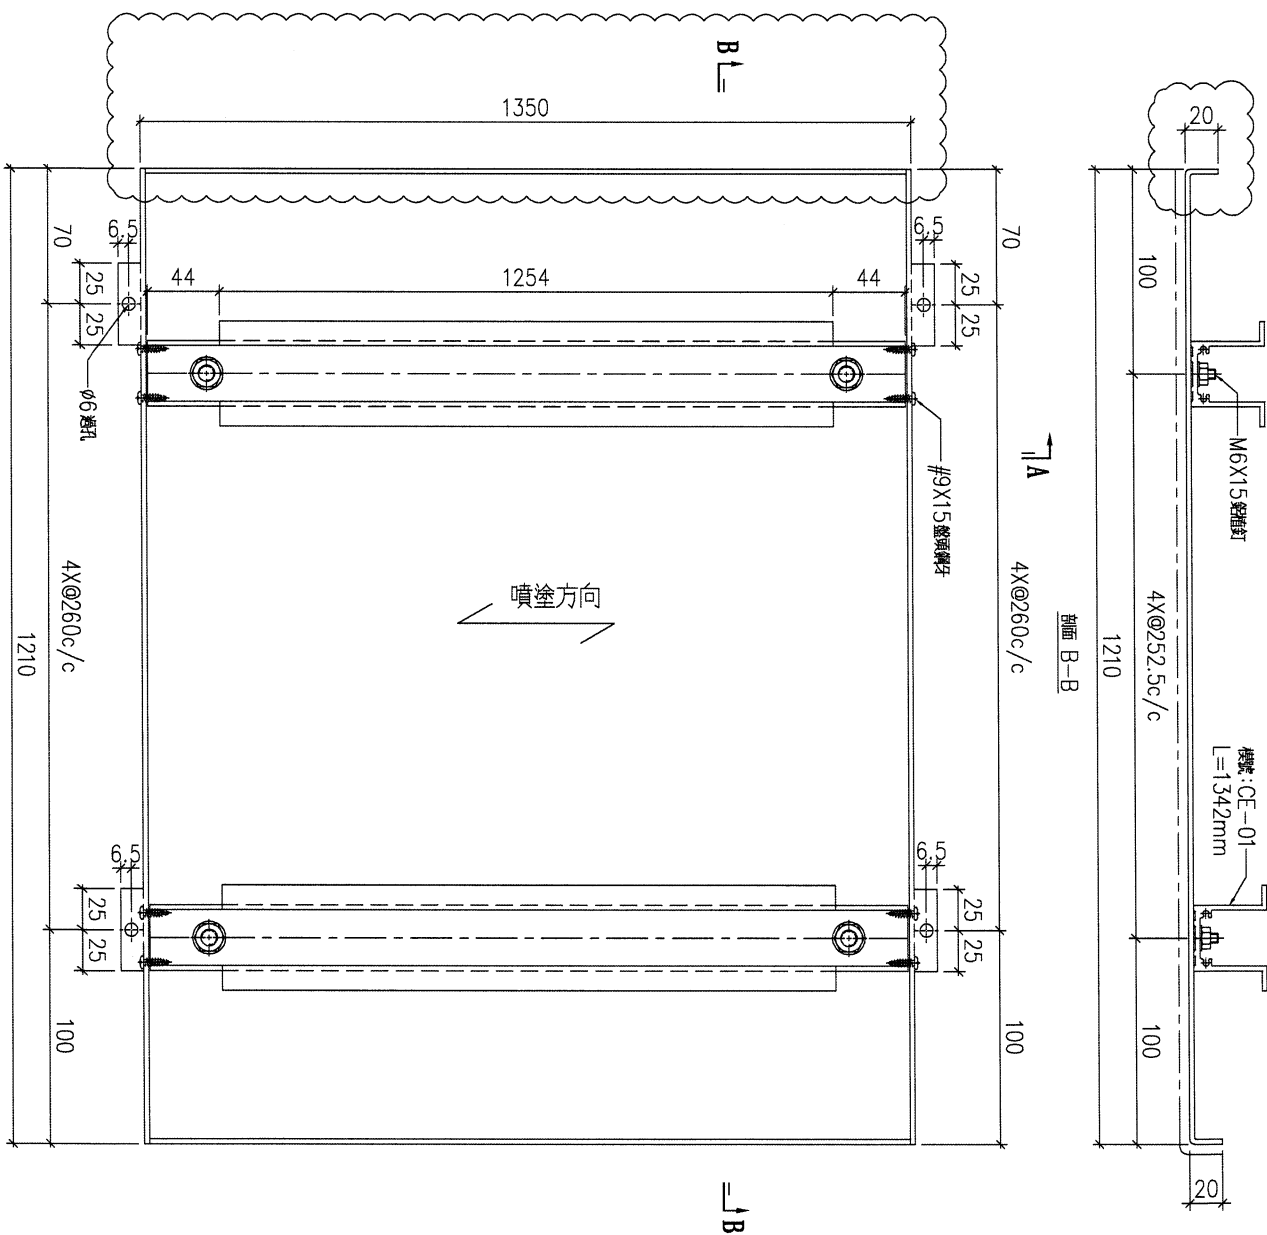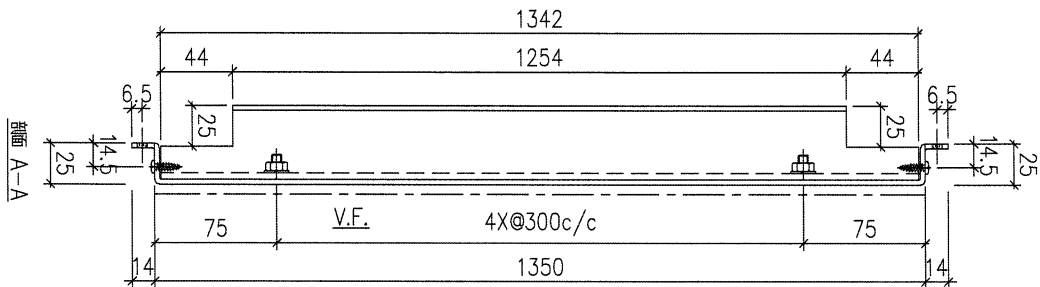

序號	物料編號	數量	安裝位置	樓層
01	T1-ALC-AP55	5	T1 FLAT A 18~22/F	

名稱	天花鋁板加工圖	制圖	LHR	2022.3.29	修改	A
材料	3mm厚鋁板 (3003H14)	復核	-	-	日期	2022.5.26
顏色	ECW3D97528S-ZD1	批准			圖號	J853-ALC-AP387

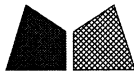

美特鋁質 有限公司
MIDI Aluminium Fabricator Ltd.



工程號

J853

地盤


錦上路

送地盤



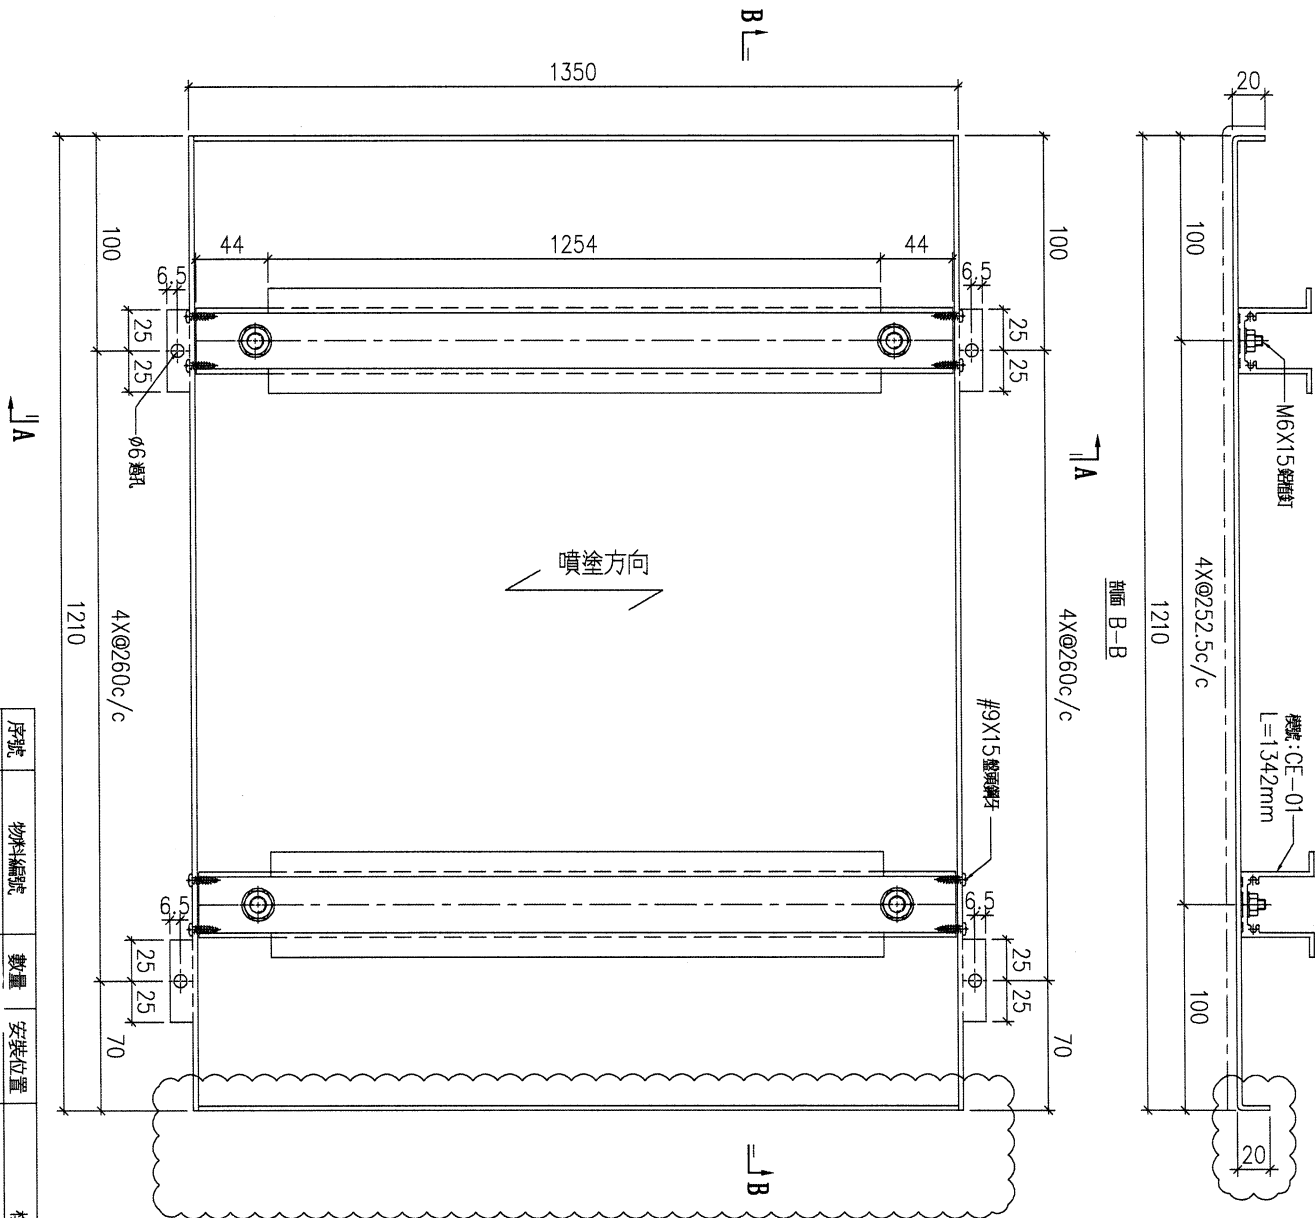
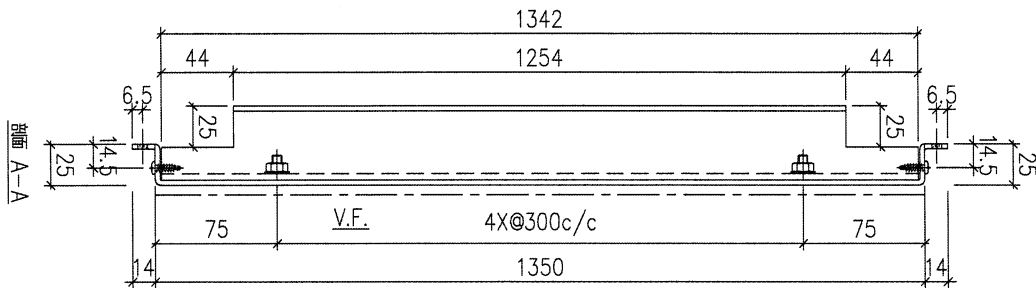


序號	物料編號	數量	安裝位置	樓層
01	T1-ALC-AP56	5	T1 FLAT A 18~22/F	

名稱	天花鋁板加工圖	制圖	LHR	2022.3.29	修改	A	
材料	3mm厚鋁板 (3003H14)	復核	-	-	日期	2022.5.26	
顏色	ECW3D975285-2D1	批准			圖號	J853-ALC-AP388	

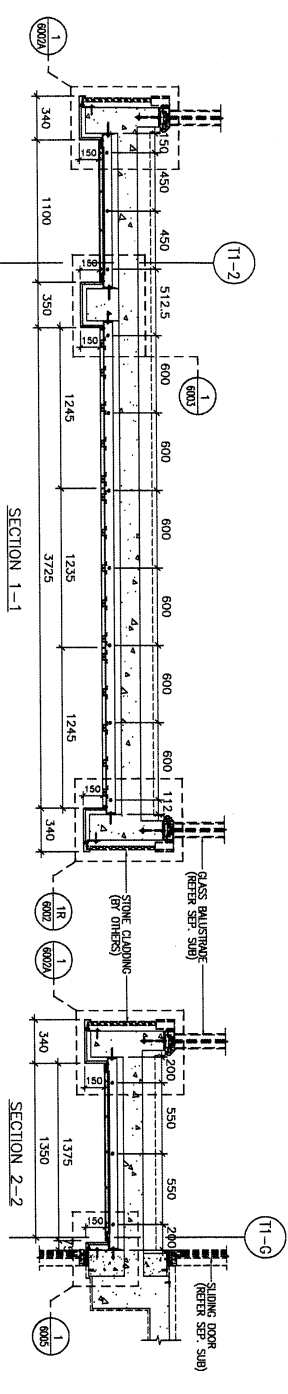

CEILING MARK	TYPE	FLOOR(S)	TOTAL
ALC-102/T1A	NORMAL	A	15

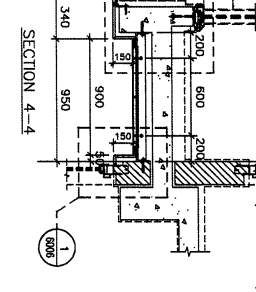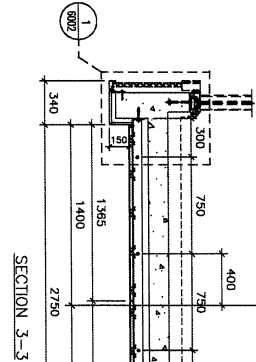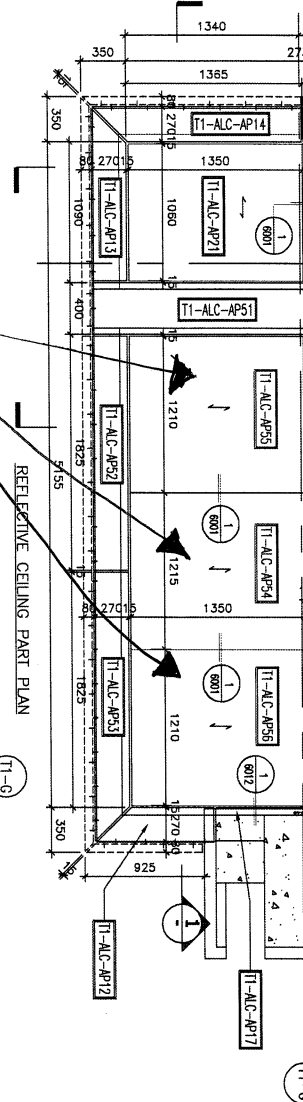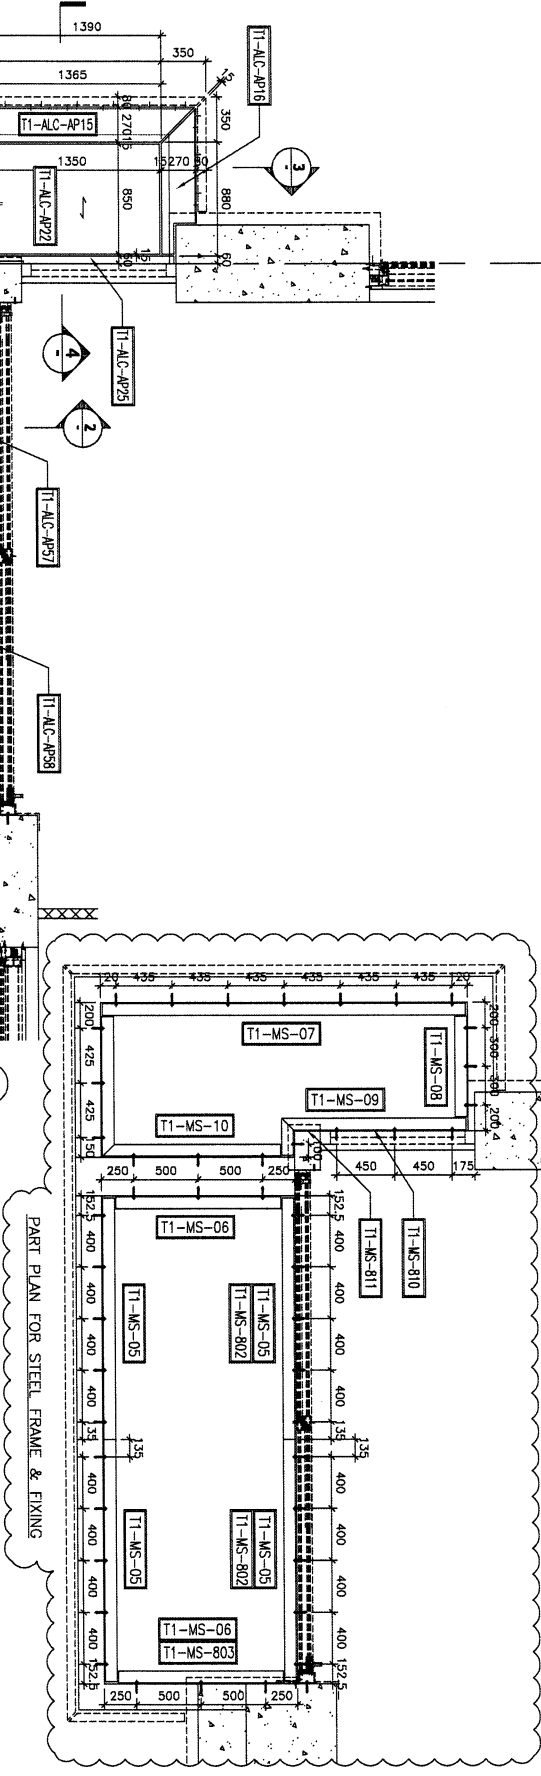

BL. REF. :

CLIENT :
SHIMAO GROUP HOLDINGS LIMITED
 協興建築有限公司
 HOP HING CONSTRUCTION CO LTD

ARCHITECT :
WTF
 WONG TUNG & PARTNERS LIMITED
 ARCHITECTS & PLANNERS

STRUCTURAL ENGINEER :
CMA
 C M WONG & ASSOCIATES LTD
 黃志明建築工程師有限公司
 FACILE CONSULTANT

MEINERDIT
 NOTE :
 1. ALL DIMENSIONS ARE IN MM.
 2. ALL DIMENSIONS ARE REFER FROM OUTSIDE FACE UNLESS SPECIFIED OTHERWISE.
 3. BEFORE FABRICATION.
 LEGEND :
 (X) DENAL MARK NO.
 (R) REFER SHEET NO.
 1. FEEL --- FINISHED FLOOR LEVEL.
 2. SEL --- STRUCTURAL FLOOR LEVEL.
 3. (R) --- REINFORCED DETAIL.
 4. (---) --- 3mm THK ALUM CEILING

JOB NO. : J-8533
 PROJECT : PROPOSED RESIDENTIAL DEVELOPMENT AT N.K.I.L. 6542 YIN PING ROAD KOWLOON
 TITLE : ALUM. CEILING FOR ALC-102 OF LW/DN. AT TOWER 1 FLAT A (6/F-22/F) (EXCEPT 13/F-14/F)
 DATE : 28-JUL-21 SCALE : 1 : 40 (A3)
 DRAWN BY : LHR CHECKED BY :
美特鋁質有限公司
 MIDT Aluminium Fabrication Ltd.
 110 Cheung Kwoon Road, Kowloon, H.K.
 Tel: 24989111-4 Fax: (852) 27727866
 PING NO. : 853-50-ALC-4102 REV. : -