

工程指示 / 要求簡箋 ENGINEER INSTRUCTIONS(E.I.)

|         |                               |       |           |
|---------|-------------------------------|-------|-----------|
| 工程指示編號: | EI- 7848                      | 修改版本: | -         |
|         | HK-0987                       |       |           |
| 工程編號:   | J 853                         | 工程名稱: | 延坪道       |
| 收件人:    | 生統                            | 發件人:  | Joe Chan  |
| 工程項目:   | Feature Wall (Phase 1)<br>補鋁板 | 日期:   | 28/5/2024 |

|                                 |  |                                    |
|---------------------------------|--|------------------------------------|
| <input type="checkbox"/> 原合約工程包 | <input type="checkbox"/> 原合約工程加 / 減賬 QT- | <input type="checkbox"/> 新工程報價 QT- |
|---------------------------------|--|------------------------------------|

|                |           |
|----------------|-----------|
| 信件批核號碼/圖紙參考編號: | 批核模具圖紙編號: |
| 客戶指示附件:        | 管理內部批簽署:  |

|                                    |                                     |                               |
|------------------------------------|-------------------------------------|-------------------------------|
| <input type="checkbox"/> 初步鋁料 B.M. | <input type="checkbox"/> 加工拆圖, 然後生產 | <input type="checkbox"/> 尺寸表  |
| <input type="checkbox"/> 正式鋁料 B.M. | <input type="checkbox"/> 技術上資料 / 指示 | <input type="checkbox"/> 報價   |
| <input type="checkbox"/> 配件 B.M.   | <input type="checkbox"/> 樣辦或貨品說明書   | <input type="checkbox"/> 分判合約 |
| <input type="checkbox"/> 其他:       |                                     |                               |

內容: 請依附件資料, 生產鋁板, 送地盤.

完成上列要求日期: 15/6/2024


國內

|                                 |                              |   |   |                                |                              |
|---------------------------------|------------------------------|---|---|--------------------------------|------------------------------|
| <input type="checkbox"/> 生產技術總監 | <input type="checkbox"/> 連附件 | <input type="checkbox"/> 技術部              | <input type="checkbox"/> 連附件            | <input type="checkbox"/> 生產部   | <input type="checkbox"/> 連附件 |
| <input type="checkbox"/> 採購部    | <input type="checkbox"/> 連附件 | <input checked="" type="checkbox"/> 生產統籌部 | <input checked="" type="checkbox"/> 連附件 | <input type="checkbox"/> 報關組   | <input type="checkbox"/> 連附件 |
| <input type="checkbox"/> 質檢部    | <input type="checkbox"/> 連附件 | <input type="checkbox"/> 會計部              | <input type="checkbox"/> 連附件            | <input type="checkbox"/> 機械設計部 | <input type="checkbox"/> 連附件 |
| <input type="checkbox"/> 香港辦    | <input type="checkbox"/> 連附件 | <input type="checkbox"/> 其他:              |   |                                |                              |

香港

|                              |                              |                              |                              |  |   |                              |                              |
|------------------------------|------------------------------|------------------------------|------------------------------|--|---|------------------------------|------------------------------|
| <input type="checkbox"/> 行政部 | <input type="checkbox"/> 連附件 | <input type="checkbox"/> 會計部 | <input type="checkbox"/> 連附件 | <input type="checkbox"/> 統籌部             | <input type="checkbox"/> 連附件            | <input type="checkbox"/> 工程部 | <input type="checkbox"/> 連附件 |
| <input type="checkbox"/> 採購部 | <input type="checkbox"/> 連附件 | <input type="checkbox"/> QS部 | <input type="checkbox"/> 連附件 | <input checked="" type="checkbox"/> 地盤管理 | <input checked="" type="checkbox"/> 連附件 | <input type="checkbox"/> 維修部 | <input type="checkbox"/> 連附件 |

|         |             |            |  |
|---------|-------------|------------|--|
| *發件人簽署: |             | *組別成員批核簽署: |  |
| 傳遞編號:   | HK0987 / 24 | 項目經理簽署:    |  |

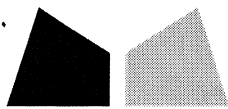

## 鋁材開料總表

工程號碼: J853 工程名稱: 延坪道

| 序號 | 鋁料編號     | 名稱 | 表面處理 |    | 開料長度 | 實用長料總數量 |       | 浪費率(%) |
|----|----------|----|------|----|------|---------|-------|--------|
|    |          |    | 顏色   | 層厚 |      | 支數      | 長度    |        |
| 1  | JMFG0078 |    |      |    | 6000 | 5       | 30000 | 27.43  |

送至: \_\_\_\_\_

由: \_\_\_\_\_

日期: \_\_\_\_\_

簡短說明: \_\_\_\_\_

共2頁 第1頁

打印日期: 28/5/2024 打印時間: 12:22

工程號碼: J853, 工程名稱: 延坪道

開料長度: 6000, 總長料支數: 5, 總開料支數: 9

鋁材開料清單 JMFG0078

鋸片厚度(mm): 4, 料頭尾總切除(mm): 20, 浪費率(%): 27.43



| 窗號     | 編號(用料狀況) | 實用長度(長料開數) | 需要<br>支數 | 開料<br>支數 | 長料<br>支數 | 餘料<br>支數 | 編號(剩餘長度) |
|--------|----------|------------|----------|----------|----------|----------|----------|
| AL-M01 | 1        | 2404.0     |          | 2        |          |          | 1164     |
| AL-M01 | 2        | 2404.0     |          | 2        |          |          | 1164     |
| AL-M01 | 3        | 2404.0     |          | 2        |          |          | 1164     |
| AL-M01 | 4        | 2404.0     |          | 2        |          |          | 1164     |
| AL-M01 | 5        | 2404.0     |          | 1        |          |          | 3572     |

地盤用鋁板B.M.表

|       |          |     |     |     |            |     |  |
|-------|----------|-----|-----|-----|------------|-----|--|
| 工程號:  | J-853    | 計算: | JOE | 日期: | 2024.05.30 | 送呈: |  |
| 地盤名稱: | 延坪路      | 核對: |     | 日期: |            | 副本: |  |
| 項目類別: | 特征牆(補鋁板) | 批准: |     | 日期: |            |     |  |

| 序號  | 修改內容 | 鋁板圖號      | 鋁板名稱   | 顏色                        | 實用 | 後備 | 總數 | 總重量    | 66.902 |       | 總重量:  | 119.76 | 備註欄 |
|-----|------|-----------|--------|---------------------------|----|----|----|--------|--------|-------|-------|--------|-----|
|     |      |           |        |                           |    |    |    |        | 單件展開面積 | 總展開面積 |       |        |     |
| 1   |      | FW1-AP01  | 3mm厚鋁板 | EC-DG-D334232-ZD1 (SS-01) | 9  | 0  | 9  | 13.861 | 0.189  | 1.705 | 0.189 | 1.705  | 廠組裝 |
| 2   |      | FW1-AP87B | 3mm厚鋁板 | EC-DG-D334232-ZD1 (SS-01) | 9  | 0  | 9  | 44.503 | 0.608  | 5.474 | 0.151 | 1.361  | 廠組裝 |
| 3   |      | FKP-M01   | 2mm厚鋁板 | EC-DG-D334232-ZD1 (SS-01) | 18 | 0  | 18 | 1.098  | 0.008  | 0.135 | 2.587 | 46.561 | 廠組裝 |
| 4   |      | FW1-AP85A | 3mm厚鋁板 | EC-DG-D334232-ZD1 (SS-01) | 6  | 0  | 6  | 60.300 | 1.236  | 7.417 | 2.879 | 17.276 |     |
| 5   |      |           |        |                           |    |    |    |        |        |       |       |        |     |
| 6   |      |           |        |                           |    |    |    |        |        |       |       |        |     |
| 7   |      |           |        |                           |    |    |    |        |        |       |       |        |     |
| 8   |      |           |        |                           |    |    |    |        |        |       |       |        |     |
| 總計: |      |           |        |                           | 42 | 0  | 42 | 120    | 2      | 15    | 6     | 67     |     |

|         |            |---------|------------|--|--------|--------|--------|----------|--------|--------|--------|---------|------|-----------|-------------------|--------|--|--------------------------|--|-----------|--|---|--|------|--|---|--|
| PROJECT |            | YIN PING ROAD KOWLOON FEATURE WALL (PHASE 1) |        |        |        | MATERIAL |        | 3mm 铝板 |        | COATING |      | PVF2      |                   | COLOUR |  | EC-DG-D334232-ZD1(SS-01) |  | MARK. NO. |  | - |  | QTY. |  | - |  |
| REV.    | CHANGED BY | PART NUMBER                                  | Dim. A | Dim. B | Dim. C | Dim. D   | Dim. E | Dim. F | Dim. G | Dim. H  | QTY. | Inv. Code | ASSEMBLE ON PARTS |        |  |                          |  |           |  |   |  |      |  |   |  |
| -       | -          | FW1-AP85A                                    | 357.5  | -      | -      | -        | -      | -      | -      | -       | 12   | -         | 注: 地盘用            |        |  |                          |  |           |  |   |  |      |  |   |  |
| -       | -          | -  | -      | -      | -      | -        | -      | -      | -      | -       | -    | -         | 注: 工地复尺           |        |  |                          |  |           |  |   |  |      |  |   |  |

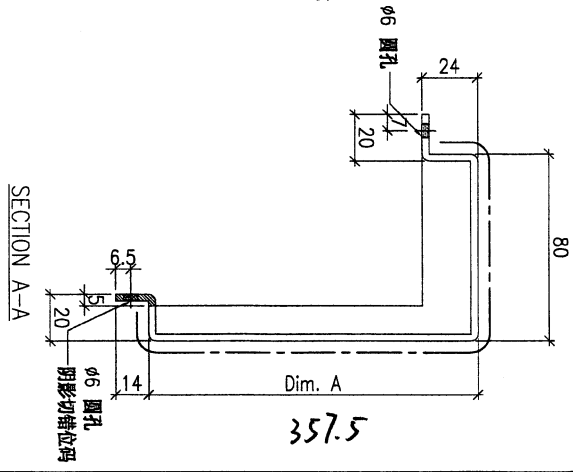
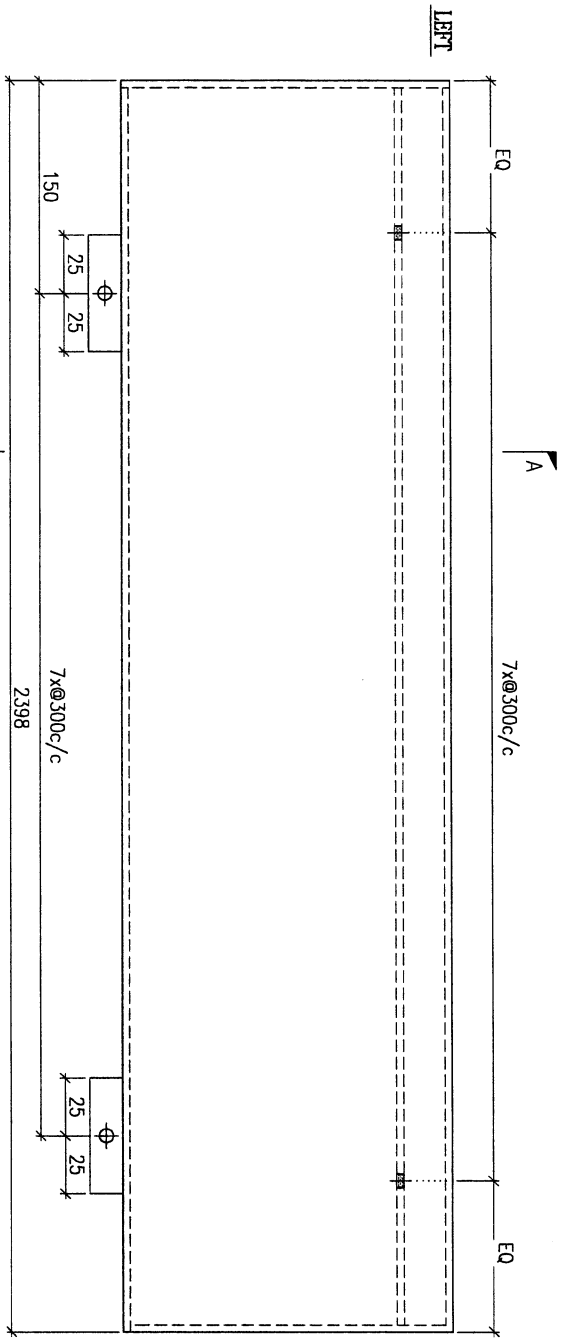


12件

|          |          |      |   |       |   |      |            |          |   |             |   |
|----------|----------|------|---|-------|---|------|------------|----------|---|-------------|---|
| DWG. NO. | FW1-AP85 | REV. | - | SCALE | - | DATE | 15-06-2023 | DRAWN BY | - | APPROVED BY | - |
|----------|----------|------|---|-------|---|------|------------|----------|---|-------------|---|

13





|         |         |---------|---------|-------------|--------|---|--------|--------|--------|----------|--------|--------|------|-----------|-------------------|--|--|---------|--------|------|--|--------|--|--------------------------|--|-----------|--|---|--|------|--|---|--|
| PROJECT |         |             |        | YIN PING ROAD KOWLOON<br>FEATURE WALL (PHASE 1) |        |        |        | MATERIAL |        |        |      | 2mm 铝封口片  |                   |  |  | COATING |        | PVF2 |  | COLOUR |  | EC-DG-0334232-ZD1(SS-01) |  | MARK. NO. |  | - |  | QTY. |  | - |  |
| REV.    | CHKD BY | PART NUMBER | Dim. A | Dim. B  | Dim. C | Dim. D | Dim. E | Dim. F   | Dim. G | Dim. H | QTY. | Inv. Code | ASSEMBLE ON PARTS |  |  |         | 注: 工厂用 |      |  |        |  |                          |  |           |  |   |  |      |  |   |  |
| -       |         | FKP-M01     | -      | -   | -      | -      | -      | -        | -      | -      | 18   |           |                   
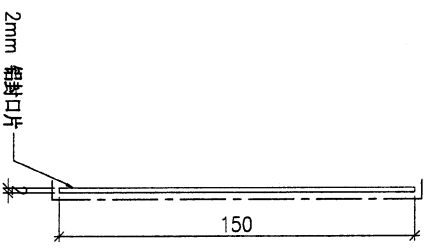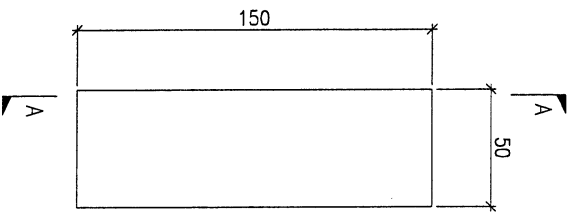

518 件

|          |  |         |  |      |  |   |  |       |  |   |  |      |  |            |  |          |  |   |  |             |  |   |  |
|----------|--|---------|--|------|--|---|--|-------|--|---|--|------|--|------------|--|----------|--|---|--|-------------|--|---|--|
| DWG. NO. |  | FKP-M01 |  | REV. |  | - |  | SCALE |  | - |  | DATE |  | 22-03-2023 |  | DRAWN BY |  | - |  | APPROVED BY |  | - |  |
|----------|--|---------|--|------|--|---|--|-------|--|---|--|------|--|------------|--|----------|--|---|--|-------------|--|---|--|


|         |            |---------|------------|---|--------|----------|--------|----------|--------|--------|--------|---------|------|-----------|-------------------|--------|--|---------------------------|--|-----------|--|---|--|------|--|---|--|
| PROJECT |            | YIN PING ROAD KOWLOON<br>FEATURE WALL (PHASE 1) |        |          |        | MATERIAL |        | 3mm 铝板 |        | COATING |      | PVF2      |                   | COLOUR |  | EC-DG-D334232-ZD1(SS-011) |  | MARK. NO. |  | - |  | QTY. |  | - |  |
| REV.    | CHANGED BY | PART NUMBER                                     | Dim. A | Dim. B   | Dim. C | Dim. D   | Dim. E | Dim. F | Dim. G | Dim. H  | QTY. | Inv. Code | ASSEMBLE ON PARTS |        |  |                           |  |           |  |   |  |      |  |   |  |
| -       | -          | FW1-AP87B                                       | 2404   | 7xø300/c | -      | -        | -      | -      | -      | -       | 9    | -         |                   |        |  |                           |  |           |  |   |  |      |  |   |  |
| 注: 地盘用  |            |   
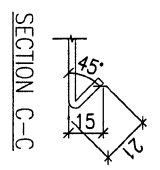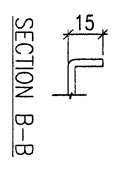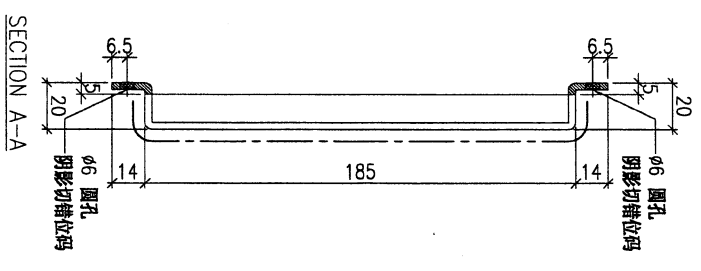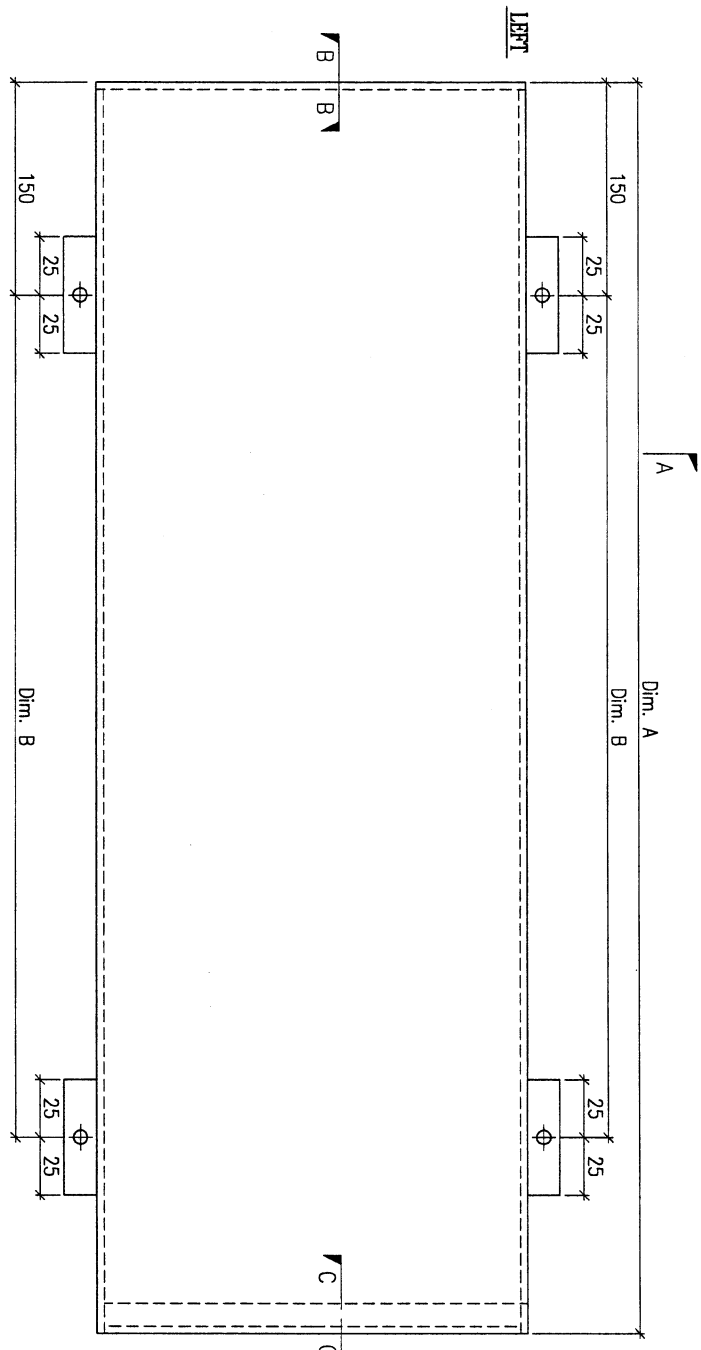

9 件

|          |  |          |  |      |  |       |  |      |  |          |  |             |  |
|----------|--|----------|--|------|--|-------|--|------|--|----------|--|-------------|--|
| DWG. NO. |  | FW1-AP87 |  | REV. |  | SCALE |  | DATE |  | DRAWN BY |  | APPROVED BY |  |
|----------|--|----------|--|------|--|-------|--|------|--|----------|--|-------------|--|

|         |         |             |        |   |        |        |        |          |        |        |      |           |                   |        |  |           |        |      |  |
|---------|---------|-------------|--------|---|--------|--------|--------|----------|--------|--------|------|-----------|-------------------|--------|--|-----------|--------|------|--|
| PROJECT |         |             |        | YIN PING ROAD KOWLOON<br>FEATURE WALL (PHASE 1) |        |        |        | MATERIAL |        |        |      | COATING   |                   | COLOUR |  | MARK. NO. |        | QTY. |  |
|         |         |             |        | 铝通&铝板组装图  |        |        |        | PVF2     |        | SS-01  |      |           |                   |        |  |           |        |      |  |
| REV.    | CHKD BY | PART NUMBER | Dim. A | Dim. B  | Dim. C | Dim. D | Dim. E | Dim. F   | Dim. G | Dim. H | QTY. | Inv. Code | ASSEMBLE ON PARTS |        |  |           | 注: 地盤用 |      |  |
| -       |         | FW1-UN01    | -      | -   | -      | -      | -      | -        | -      | -      | 9    |           |                   |        |  |           |        |      |  |

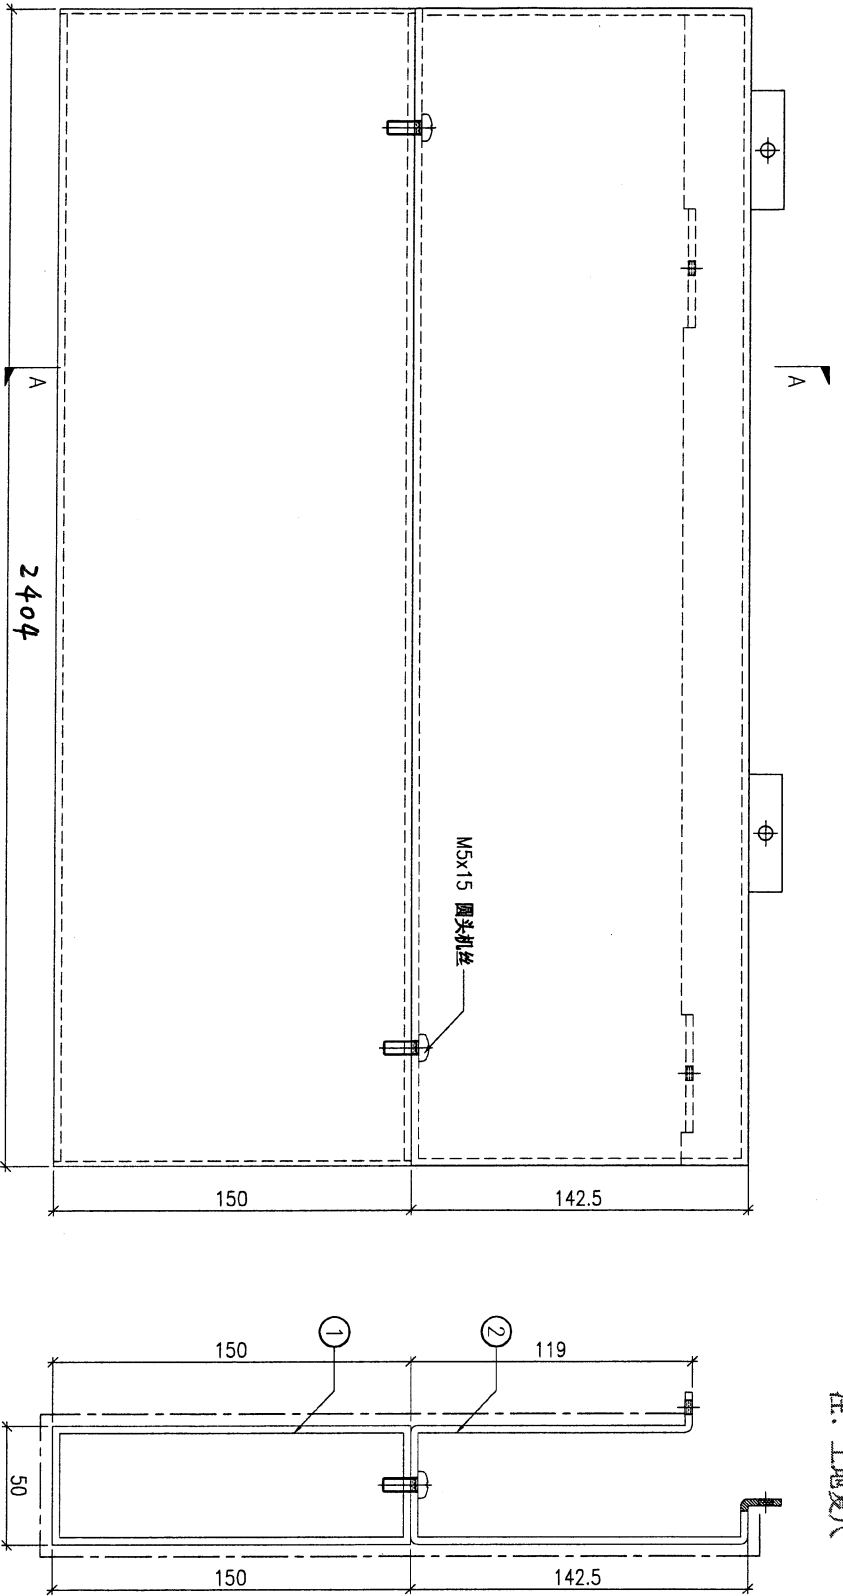

组装图




9件

|          |          |      |   |       |   |      |            |          |   |             |   |
|----------|----------|------|---|-------|---|------|------------|----------|---|-------------|---|
| DWG. NO. | FW1-UN01 | REV. | - | SCALE | - | DATE | 22-03-2023 | DRAWN BY | - | APPROVED BY | - |
|----------|----------|------|---|-------|---|------|------------|----------|---|-------------|---|

| 序号 | 构件编号     | 单组数量 |
|----|----------|------|
| ①  | AL-M01   | 1    |
| ②  | FW1-AP01 | 1    |

9

|         |            |---------|------------|--|--------|--------|--------|--------|--------|--------|--------|----------|------|------------------|-------------------|--|------------------|---------|---|--------|---|-----------|--|------|--|
| PROJECT |            | YIN PING ROAD KOWLOON FEATURE WALL (PHASE 1) |        |        |        |        |        |        |        | MATERIAL |      | 铝通加工图(JMF-G0078) |                   |  |                  | COATING |   | COLOUR |   | MARK. NO. |  | QTY. |  |
| REV.    | CHANGED BY | PART NUMBER                                  | Dim. A | Dim. B | Dim. C | Dim. D | Dim. E | Dim. F | Dim. G | Dim. H   | QTY. | Inv. Code        | ASSEMBLE ON PARTS |  | JMQ213457(SS-01) |         | - |        | - |           |  |      |  |
| -       |            | AL-M01                                       | -      | -      | -      | -      | -      | -      | -      | -        | 9    |                  |                   |  |                  |         |   |        |   |           |  |      |  |
|         |            |  |        |        |        |        |        |        |        |          |      | 注: 工厂用           |                   |  |                  |         |   |        |   |           |  |      |  |

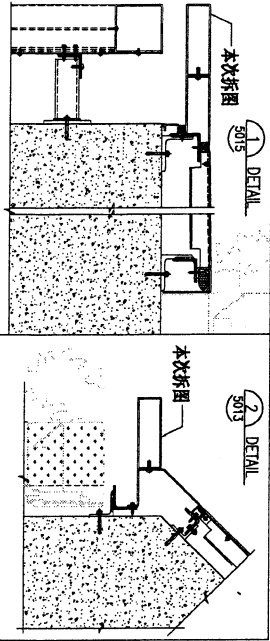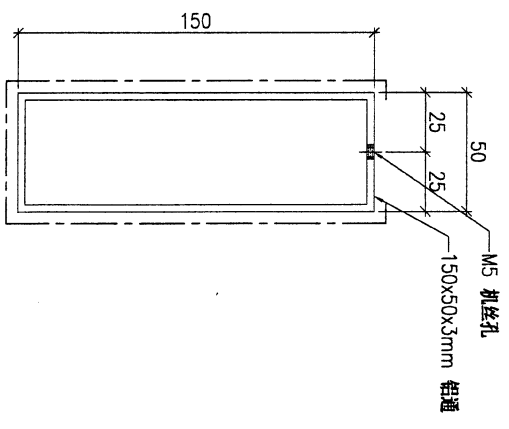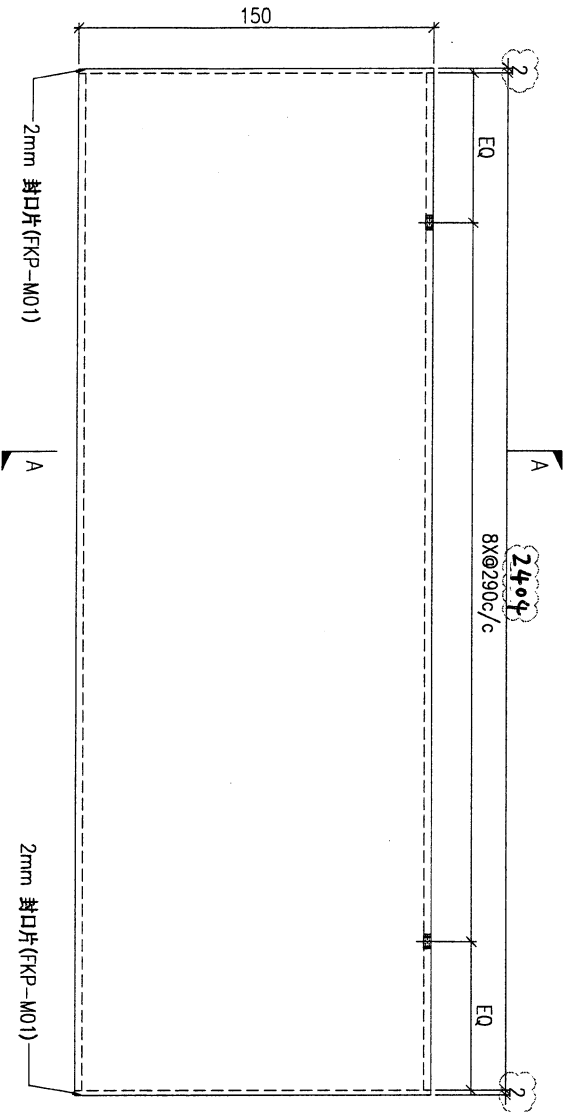

9 件

|          |  |      |  |       |  |            |  |          |  |             |  |
|----------|--|------|--|-------|--|------------|--|----------|--|-------------|--|
| DWG. NO. |  | REV. |  | SCALE |  | DATE       |  | DRAWN BY |  | APPROVED BY |  |
| AL-M01   |  | A    |  | -     |  | 22-03-2023 |  | -        |  | -           |  |

3

PROJECT: YIN PING ROAD KOWLOON FEATURE WALL (PHASE 1)

MATERIAL: 3mm 铝板




COATING: PVF2

COLOUR: EC-DG-D334232-ZD1(SS-01)

MARK. NO.:


QTY.:

| CHKD BY | PART NUMBER | Dim. A | Dim. B | Dim. C | Dim. D | Dim. E | Dim. F | Dim. G | Dim. H | QTY. | Inv. Code | ASSEMBLE ON PARTS | 注: 工厂用 |
|---------|-------------|--------|--------|--------|--------|--------|--------|--------|--------|------|-----------|-------------------|--------|
| -       | FW1-AP01    | -      | -      | -      | -      | -      | -      | -      | -      | 1    | -         | -                 | -      |

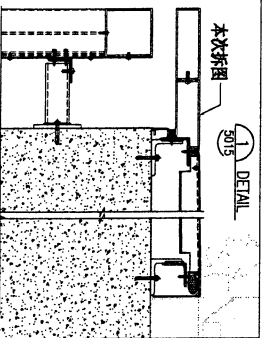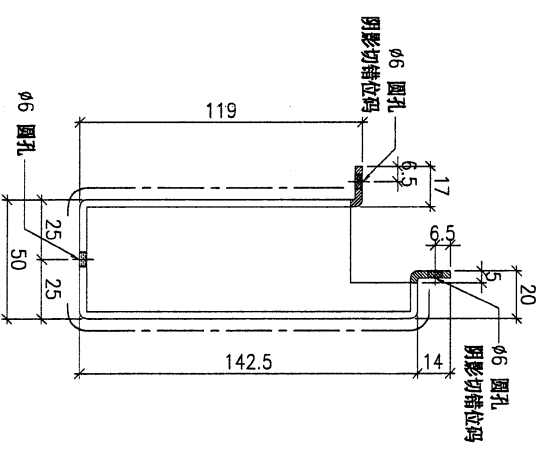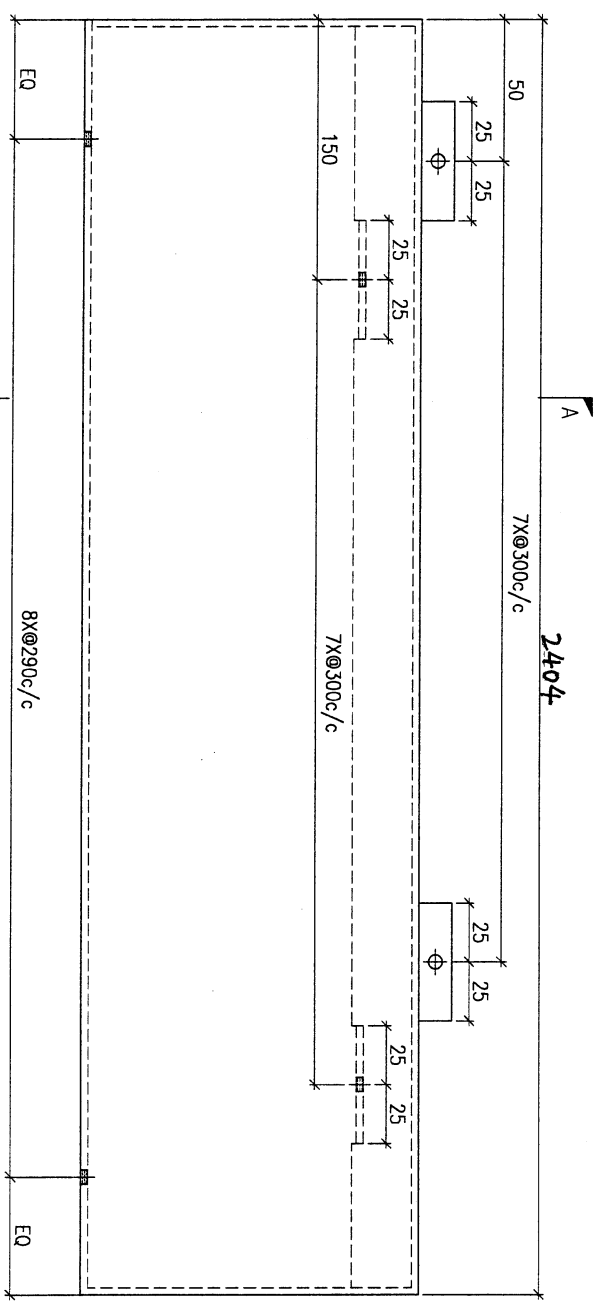

9件

|          |          |      |   |       |   |      |            |          |   |             |   |
|----------|----------|------|---|-------|---|------|------------|----------|---|-------------|---|
| DWG. NO. | FW1-AP01 | REV. | - | SCALE | - | DATE | 22-03-2023 | DRAWN BY | - | APPROVED BY | - |
|----------|----------|------|---|-------|---|------|------------|----------|---|-------------|---|

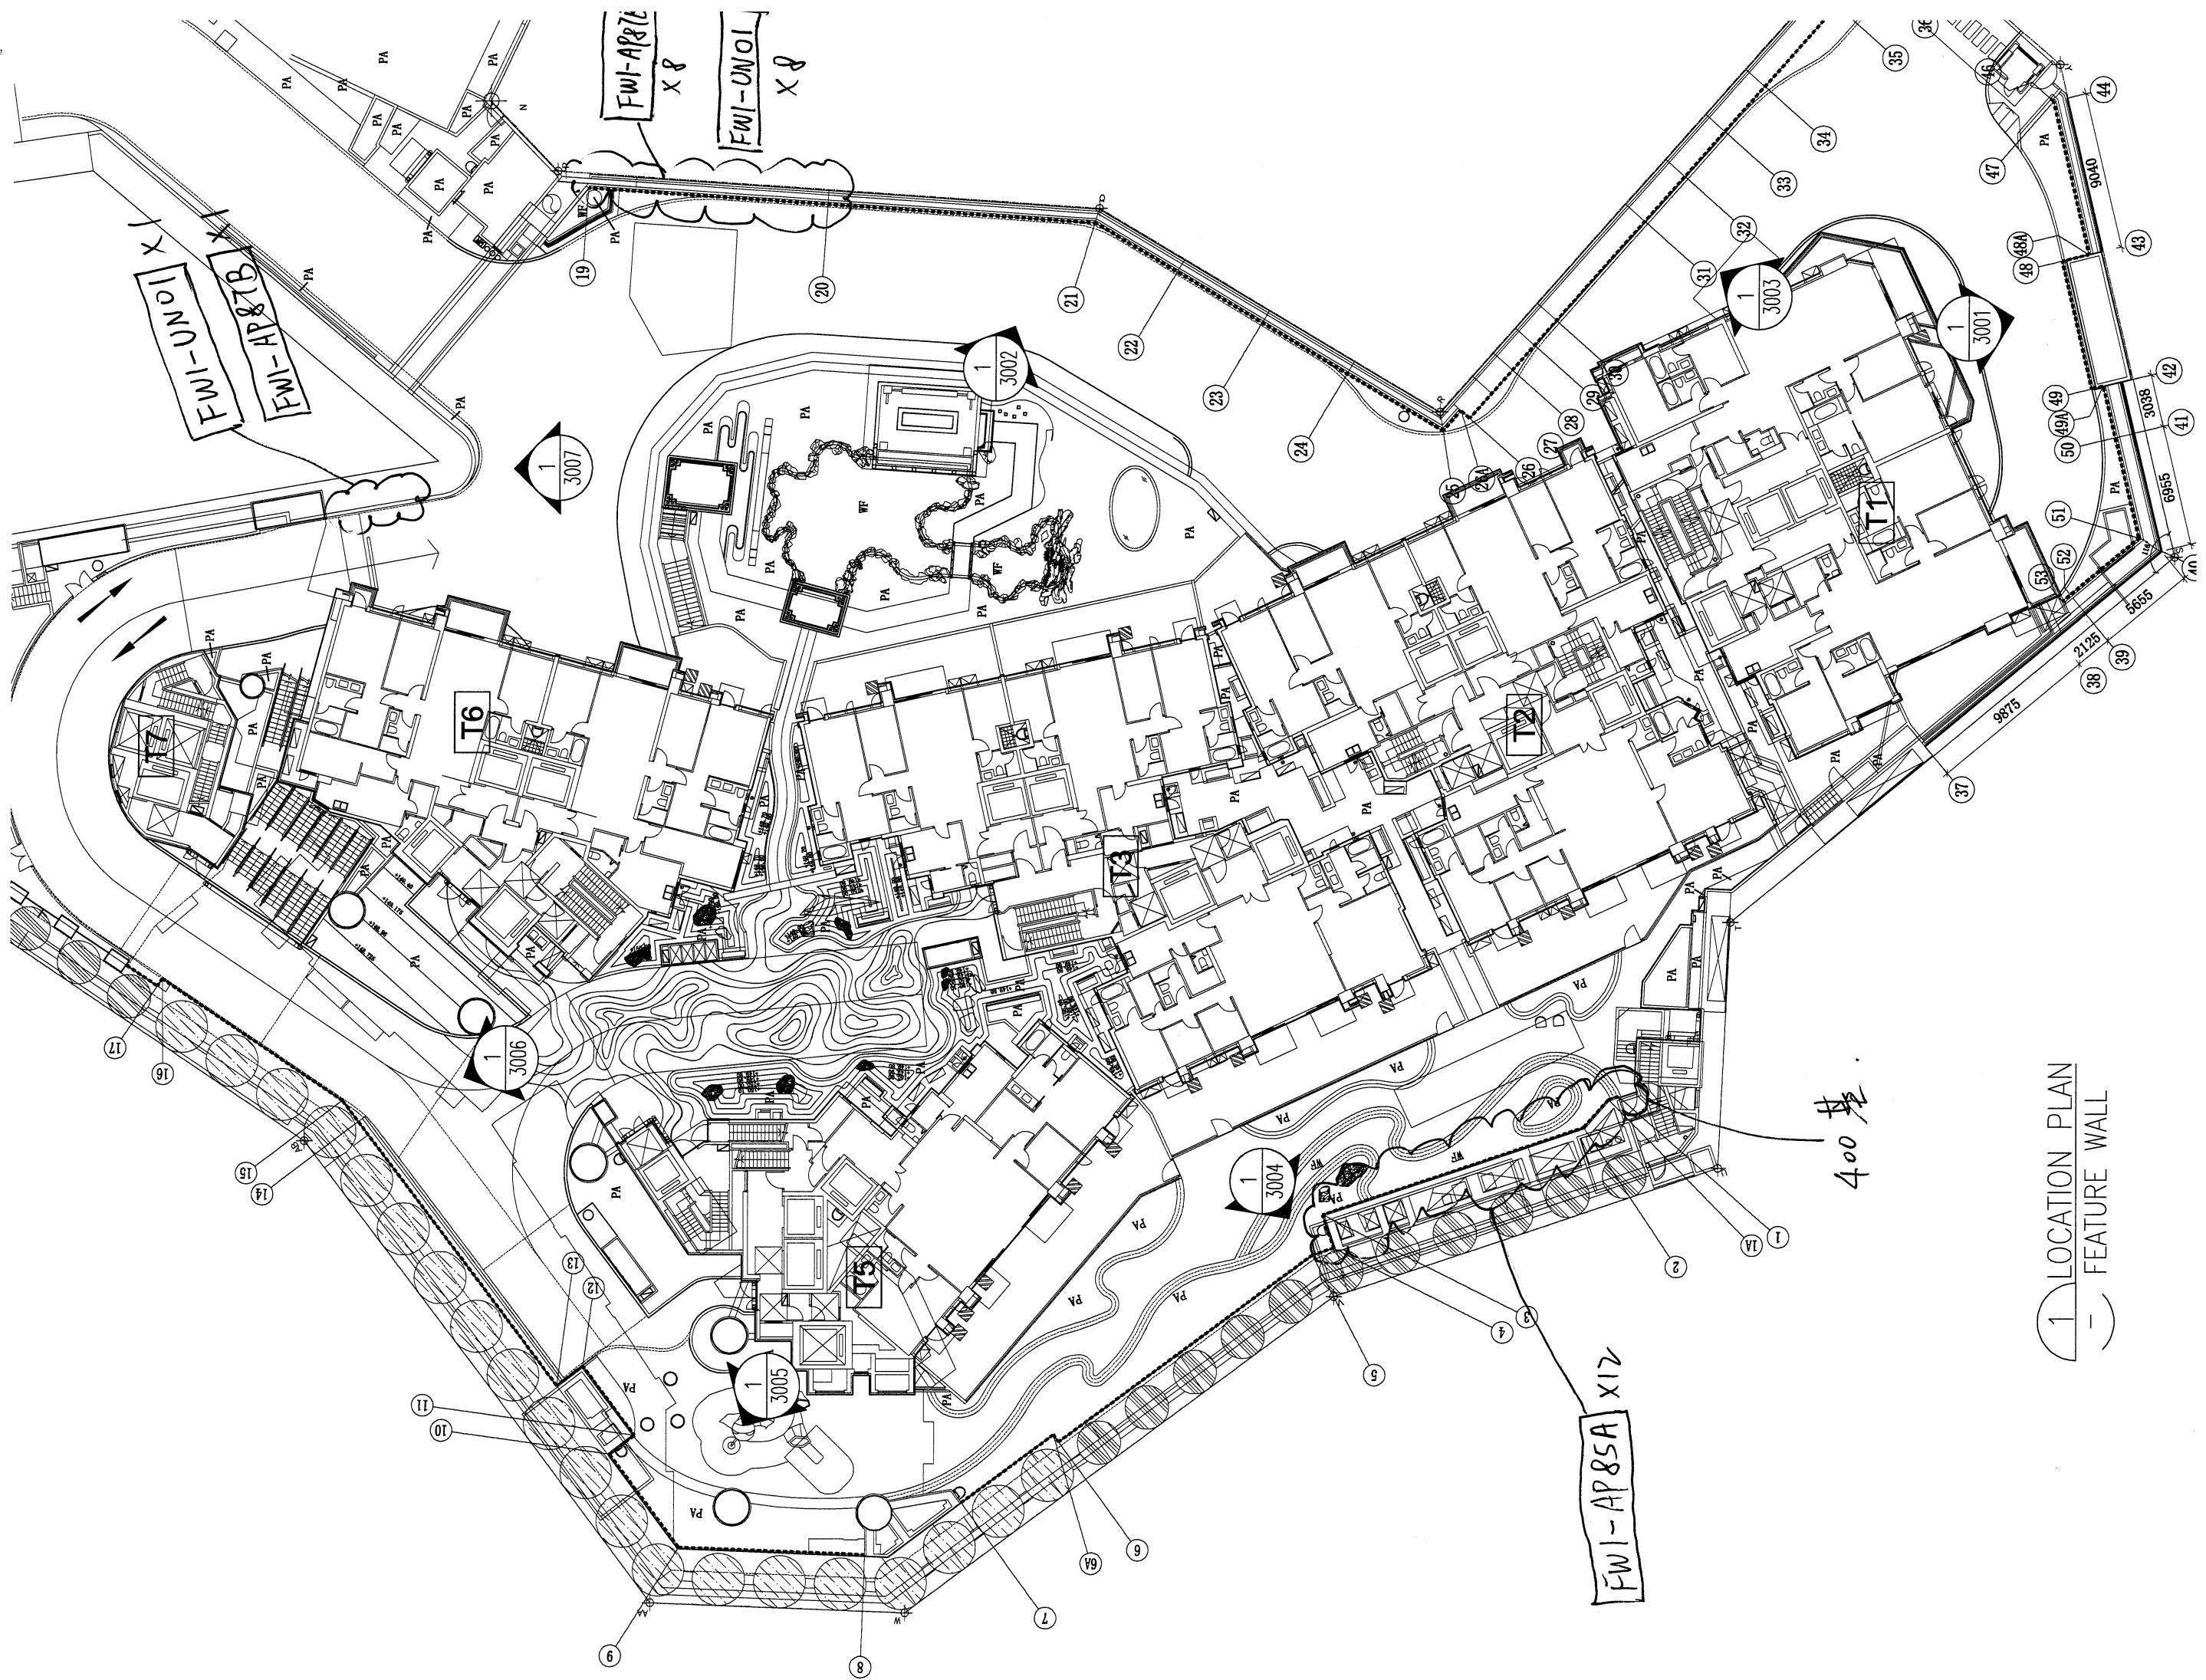

1 LOCATION PLAN  
 — FEATURE WALL

FWI-AP87C  
 X 8

FWI-UN01  
 X 8

FWI-UN01A  
 X 8

FWI-AP85A x12

400 米

1 3007

1 3002

1 3003

1 3001

1 3006

1 3004

1 3005

T6

T2

T5

17

16

14

15

12

13

10

11

9

8

7

6A

6

5

4

3

2

1A

1B

37

38

39

2125

5655

6955

3038

41

42

51

52

49

50

48

47

46

45

44

43

9040

35

34

33

13

12

11

10

9

8

7

6

5

4

3

2

1