

工程指示 / 要求簡箋 ENGINEER INSTRUCTIONS(E.I.)

工程指示編號:	EI- 8356	修改版本:	-
	HK-1733		
工程編號:	J 853	工程名稱:	延坪道
收件人:	生統	發件人:	Joe Chan
工程項目:	大樓平台 Glass Wall 執修鋁板.	日期:	23/9/2024

<input type="checkbox"/> 原合約工程包	<input type="checkbox"/> 原合約工程加 / 減賬 QT-	<input type="checkbox"/> 新工程報價 QT-
---------------------------------	--	------------------------------------

信件批核號碼/圖紙參考編號:	批核模具圖紙編號:
客戶指示附件:	管理內部批簽署:

<input type="checkbox"/> 初步鋁料 B.M.	<input type="checkbox"/> 加工拆圖, 然後生產	<input type="checkbox"/> 尺寸表
<input type="checkbox"/> 正式鋁料 B.M.	<input type="checkbox"/> 技術上資料/指示	<input type="checkbox"/> 報價
<input type="checkbox"/> 配件 B.M.	<input type="checkbox"/> 樣辦或貨品說明書	<input type="checkbox"/> 分判合約
<input type="checkbox"/> 其他:		

內容: 請依附件資料, 生產鋁板, 送地盤.

完成上列要求日期: 10/10/2024 ASAP.

國內

<input type="checkbox"/> 生產技術總監	<input type="checkbox"/> 連附件	<input type="checkbox"/> 技術部	<input type="checkbox"/> 連附件	<input type="checkbox"/> 生產部	<input type="checkbox"/> 連附件
<input type="checkbox"/> 採購部	<input type="checkbox"/> 連附件	<input checked="" type="checkbox"/> 生產統籌部	<input checked="" type="checkbox"/> 連附件	<input type="checkbox"/> 報關組	<input type="checkbox"/> 連附件
<input type="checkbox"/> 質檢部	<input type="checkbox"/> 連附件	<input type="checkbox"/> 會計部	<input type="checkbox"/> 連附件	<input type="checkbox"/> 機械設計部	<input type="checkbox"/> 連附件
<input type="checkbox"/> 香港辦	<input type="checkbox"/> 連附件	<input type="checkbox"/> 其他:			

香港




<input type="checkbox"/> 行政部	<input type="checkbox"/> 連附件	<input type="checkbox"/> 會計部	<input type="checkbox"/> 連附件	<input type="checkbox"/> 統籌部	<input type="checkbox"/> 連附件	<input type="checkbox"/> 工程部	<input type="checkbox"/> 連附件
<input type="checkbox"/> 採購部	<input type="checkbox"/> 連附件	<input type="checkbox"/> QS部	<input type="checkbox"/> 連附件	<input checked="" type="checkbox"/> 地盤管理	<input checked="" type="checkbox"/> 連附件	<input type="checkbox"/> 維修部	<input type="checkbox"/> 連附件

*發件人簽署:		*組別成員批核簽署:	
傳遞編號:	HK1733/24	項目經理簽署:	



美特鋁質有限公司
MIDI Aluminium Fabricator Ltd.

類別		物料號		
制圖	AN	2023/08/10	圖號	J853-4002-R03
修改		復核	數量	1
日期		批准	單件重量 (KG)	-

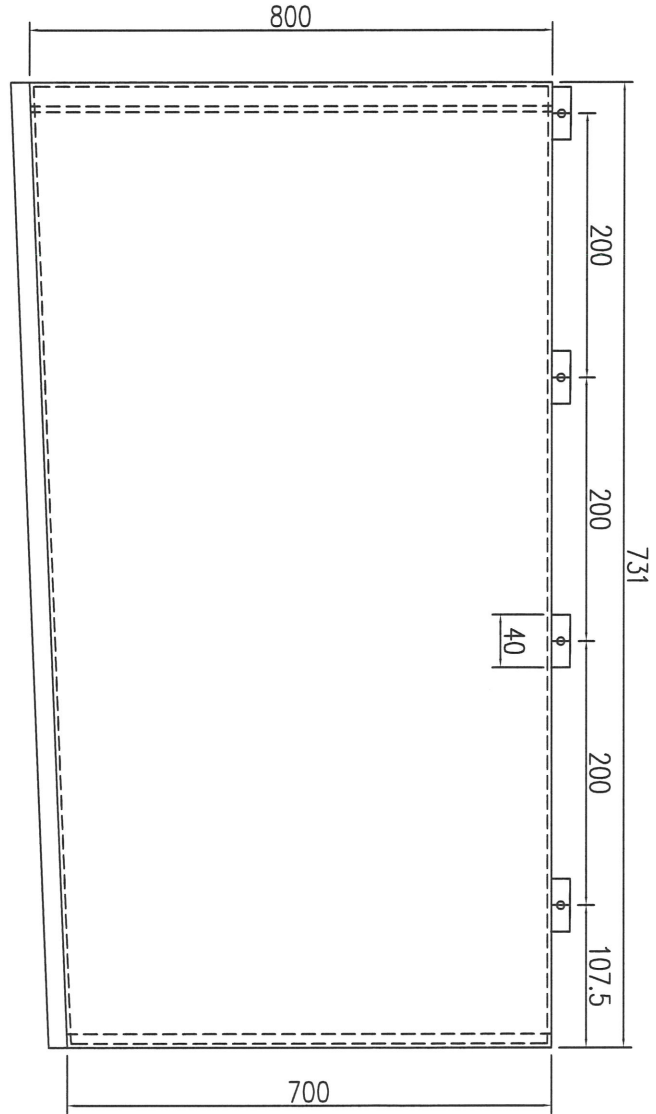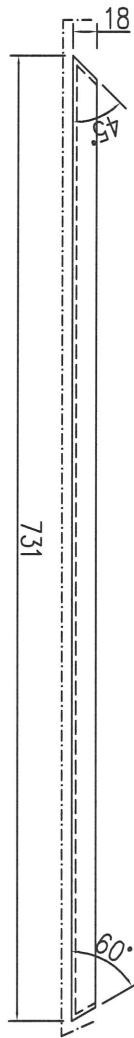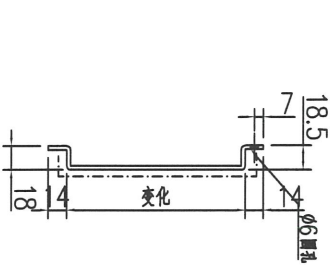


技术要求:

1. 鋁面板厚度3mm, 材質等級為 3003-H14;
2. 表面EC-DG-D334232-ZD1(9漆) "为噴漆面, 噴漆顏色号, 待定;"
3. 鋁板油漆要符合規範做附着力測試 (Pull out test);
4. 固定加強筋的鋁排要符合規範做撞擊測試 (Impact test);
5. 鋁板加工偏差要符合規範, 出廠要資檢, 加工完成后做好膜紙保护和貼示加工编号.

工程號	J853	地盤	香港延坪道 GLASS WALL	附件	
名稱	鋁板加工圖		採用		-
材料	3mm鋁板		地盤		
顏色	EC-DG-D334232-ZD1		工廠		


類別		物料號		
制圖	AN	2023/08/10	圖號	J853-4002-R04
修改			數量	1
日期			單件重量 (KG)	-

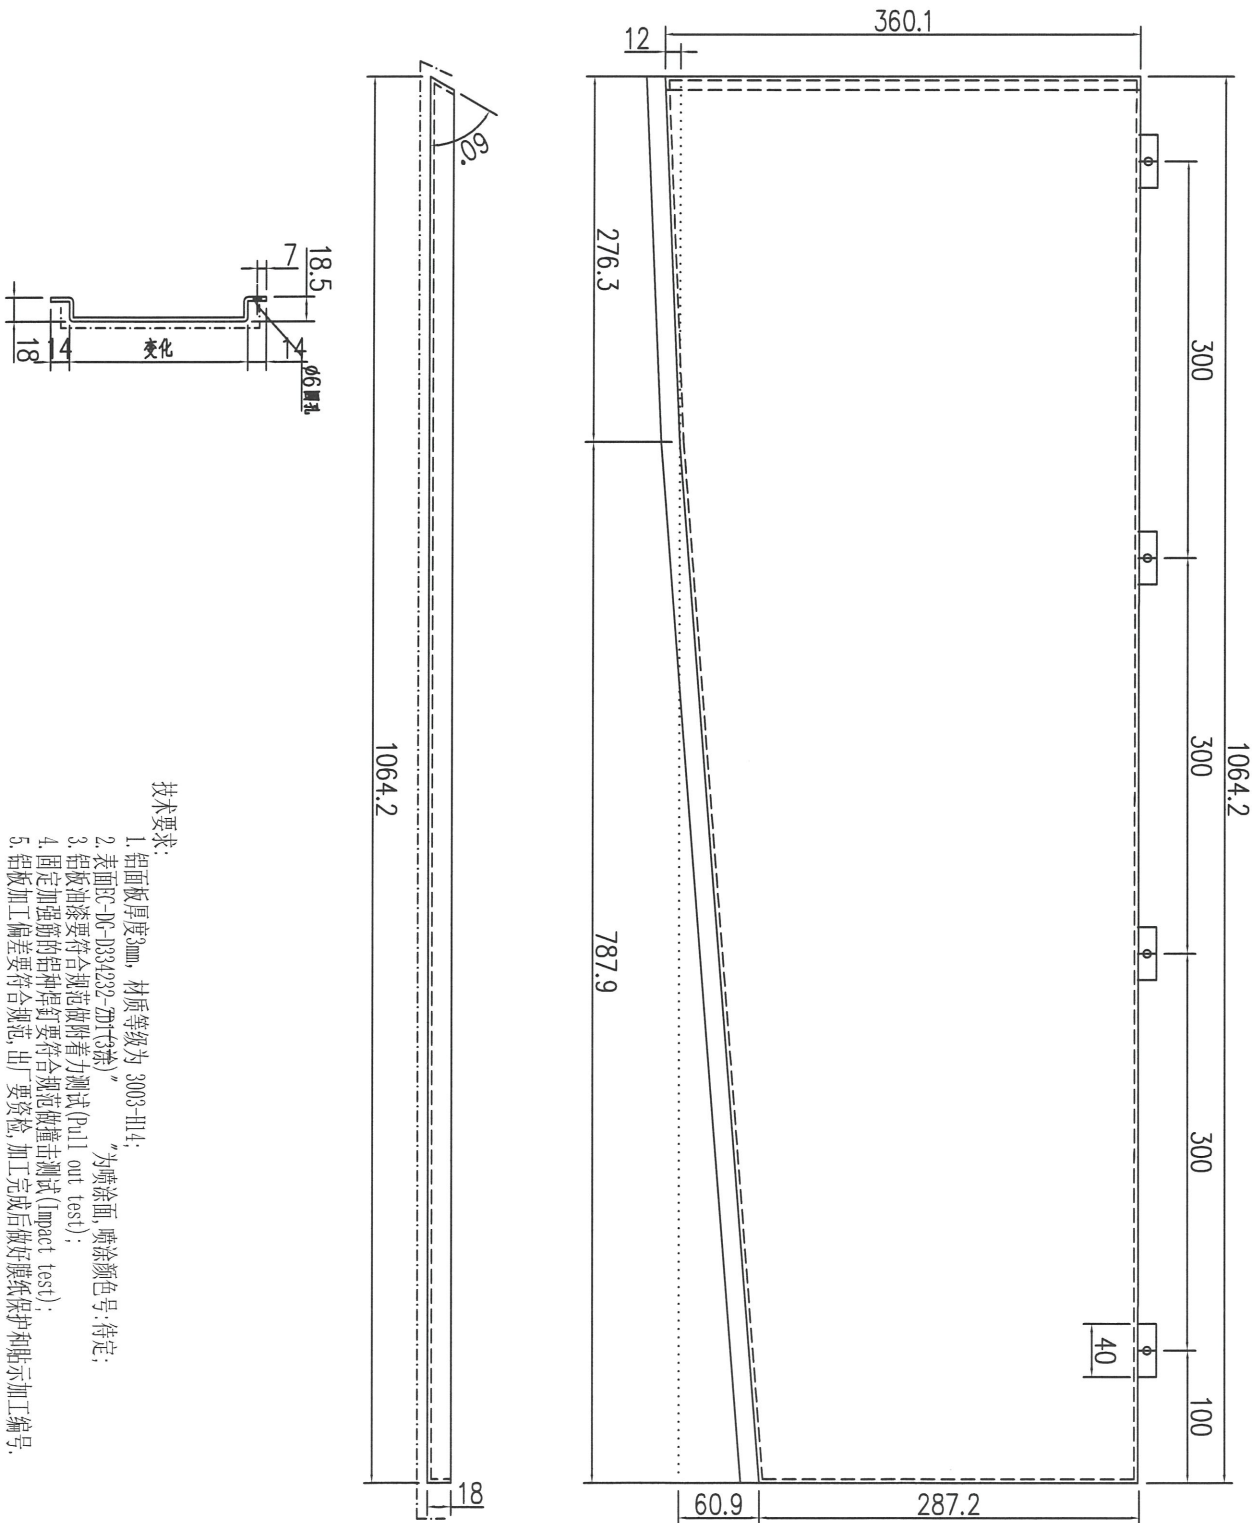

技术要求:



1. 鋁面板厚度3mm, 材質等級為 3003-H14;
2. 表面EC-DG-D334232-ZD1(噴漆) "为噴漆面, 噴漆顏色号, 待定;"
3. 鋁板油漆要符合規範做附着力測試 (Pull out test);
4. 固定加強筋的鋁種厚度和要符合規範做撞擊測試 (Impact test);
5. 鋁板加工偏差要符合規範, 出廠要資檢, 加工完成后做好膜紙保护和貼示加工編號.

工程號	J853	地盤	香港延坪道 GLASS WALL		附件	
名稱	鋁板加工圖		採用			
材料	3mm鋁板		地盤			
顏色	EC-DG-D334232-ZD1		工廠			

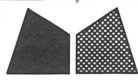

美特鋁質有限公司
MIDI Aluminium Fabricator Ltd.

類別		物料號		
制圖	AN	2023/08/10	圖號	J853-4003-T06
修改			數量	1
日期			單件重量 (KG)	-

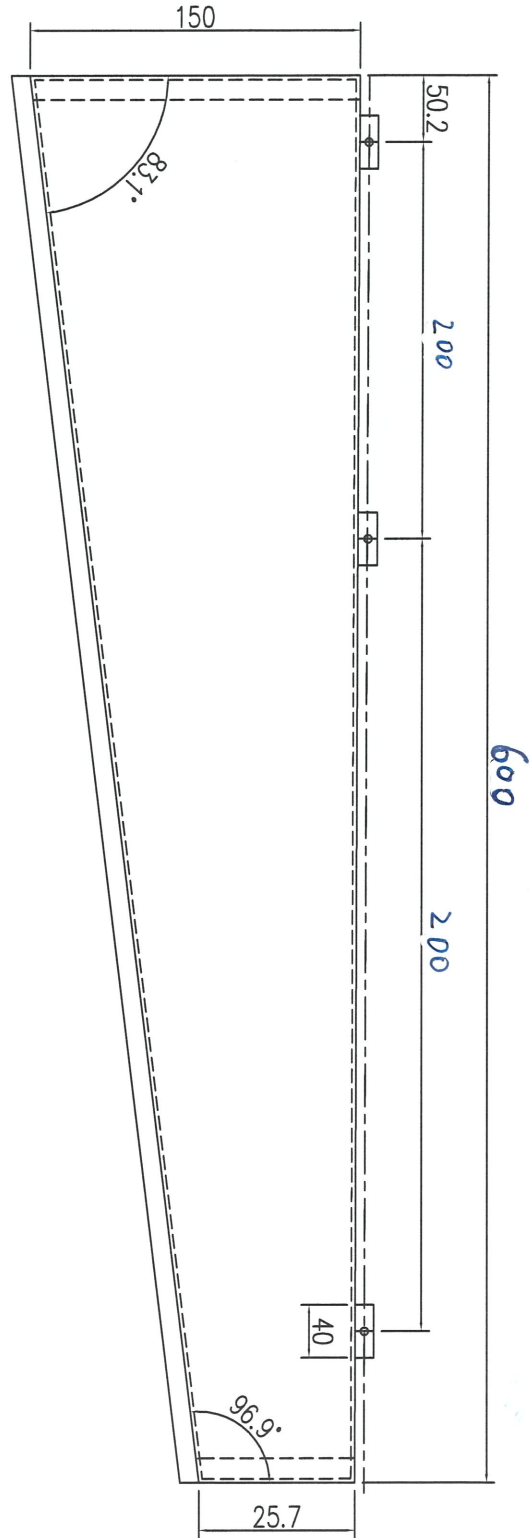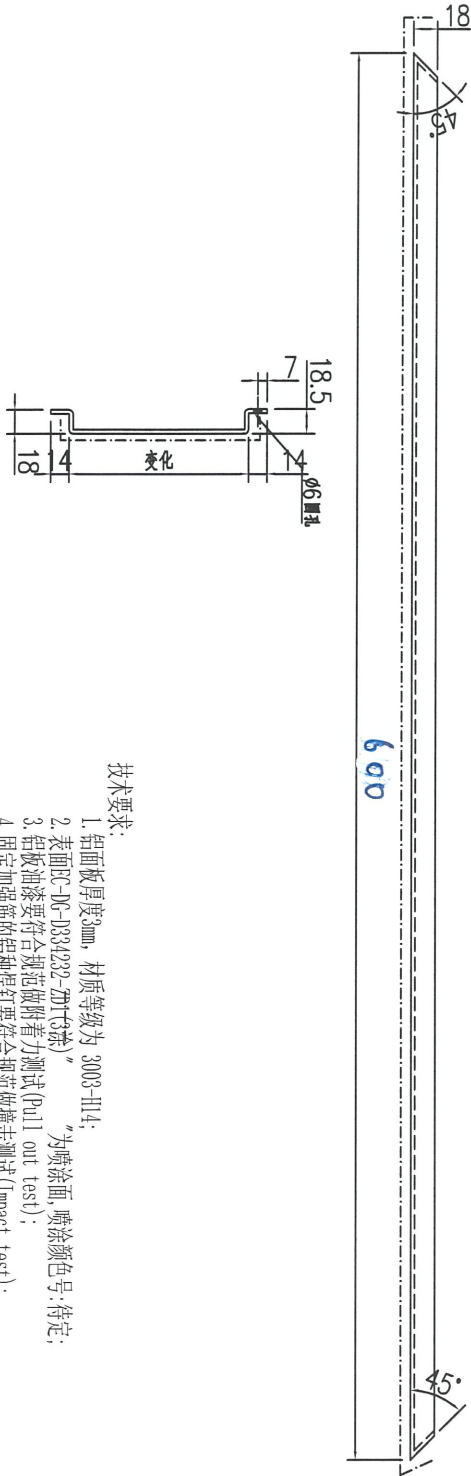

技术要求:


1. 铝面板厚度3mm, 材质等级为 3003-H14;
2. 表面EC-DG-D334232-ZD1(油漆) "为喷涂面, 喷涂颜色号, 待定;
3. 铝板油漆要符合规范做附着测试 (Pull out test);
4. 固定加强筋的铝种材料要符合规范做撞击测试 (Impact test);
5. 铝板加工偏差要符合规范, 出厂要质检, 加工完成后做好模纸保护和贴示加工编号.

工程號	J853	地盤	香港延坪道 GLASS WALL		附件	
名稱	铝板加工图		採用			
材料	3mm铝板		地盤			
顏色	EC-DG-D334232-ZD1		工廠			



美特鋁質有限公司
MIDI Aluminium Fabricator Ltd.


類別		物料號		
制圖	AN	2023/05/14	圖號	J853-4003-Z01
修改			數量	2
日期			單件重量 (KG)	-
			復核	-
			批准	-

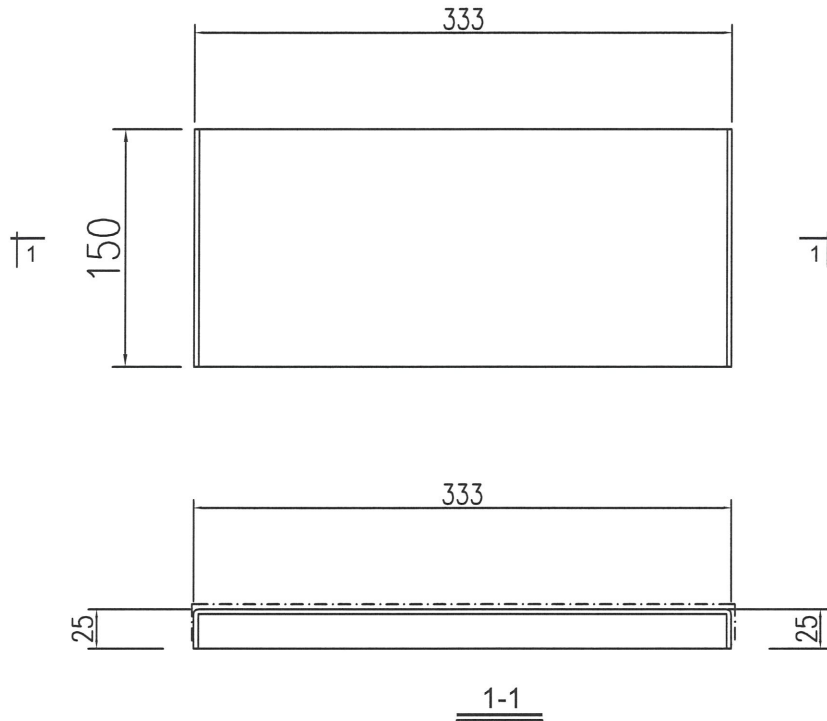

技术要求:



1. 铝面板厚度3mm, 材质等级为 3003-H14;
2. 表面氟碳喷涂(3涂)“----”为喷涂面, 喷涂颜色号: 待定;
3. 铝板油漆要符合规范做附着测试(Pull out test);
4. 固定加强筋的铝种焊钉要符合规范做撞击测试(Impact test);
5. 铝板加工偏差要符合规范, 出厂要质检, 加工完成后做好膜纸保护和贴示加工编号.

工程號	J853	地盤	香港延坪道 GLASS WALL		附 件	
名稱	铝板加工图		採	用		-
材料	3mm铝板		地盤			
顏色	氟碳喷涂		工廠			

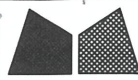

美特鋁質有限公司
MIDI Aluminium Fabricator Ltd.

類別		物料號		
制圖	AN	2023/08/10	圖號	J853-4004-Z88
修改			數量	2
日期			單件重量 (KG)	-
復核	—	—		
批准	—	—		

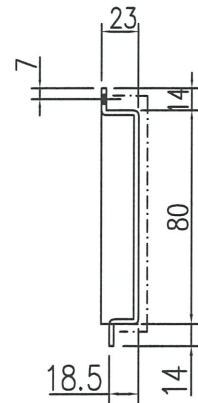
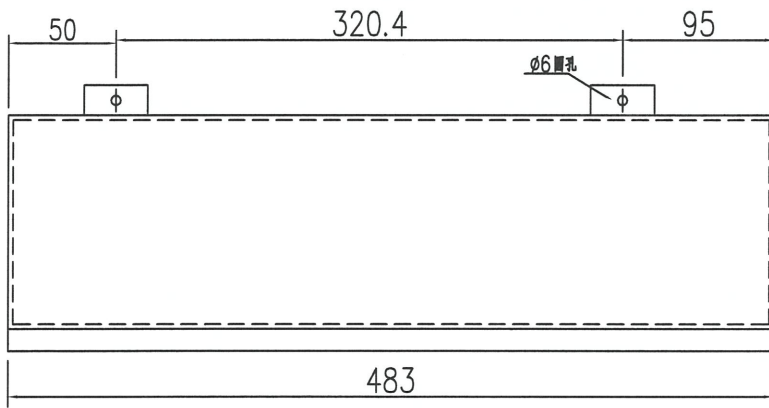


技术要求:

1. 鋁面板厚度3mm, 材質等級為 3003-H14;
2. 表面EC-DG-D334232-ZD1(3塗) " " 為噴塗面, 噴塗顏色號: 待定;
3. 鋁板油漆要符合規範做附着力測試 (Pull out test);
4. 固定加強筋的鋁種焊釘要符合規範做撞擊測試 (Impact test);
5. 鋁板加工偏差要符合規範, 出廠要資檢, 加工完成后做好膜紙保護和貼示加工編號.

工程號	J853	地盤	香港延坪道 GLASS WALL		附 件	
名稱	鋁板加工圖		採	用		—
材料	3mm鋁板		地盤			
顏色	EC-DG-D334232-ZD1		工廠			

類別		物料號		
制圖	AN	2023/05/14	圖號	J853-4004-H08
修改			數量	2
日期			單件重量 (KG)	-

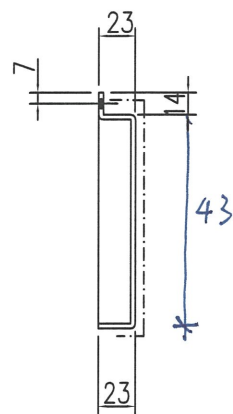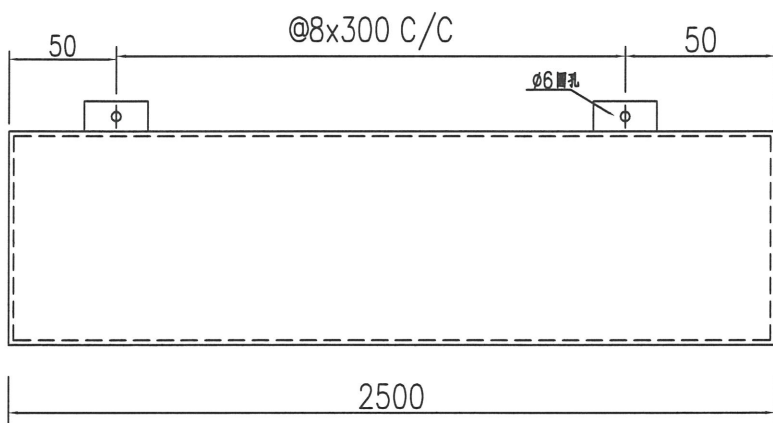


室內門頂

技术要求:


1. 铝面板厚度3mm, 材质等级为 3003-H14;
2. 表面氟碳喷涂(3涂)“-----”为喷涂面, 喷涂颜色号: 待定;
3. 铝板油漆要符合规范做附着力测试 (Pull out test);
4. 固定加强筋的铝种焊钉要符合规范做撞击测试 (Impact test);
5. 铝板加工偏差要符合规范, 出厂要资检, 加工完成后做好膜纸保护和贴示加工编号.

工程號	J853	地盤	香港延坪道 GLASS WALL		附 件	
名稱	铝板加工图		採	用		-
材料	3mm铝板		地盤			
顏色	EC-DG-D334232-ZD1		工廠			

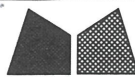


美特鋁質有限公司
MIDI Aluminium Fabricator Ltd.

類別		物料號		
制圖	AN	2023/08/10	圖號	J853-4008-Z88
修改			數量	2
日期			單件重量(KG)	-
			復核	-
			批准	-

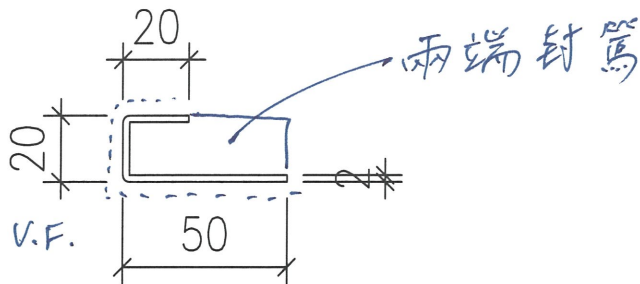


兩端封篤

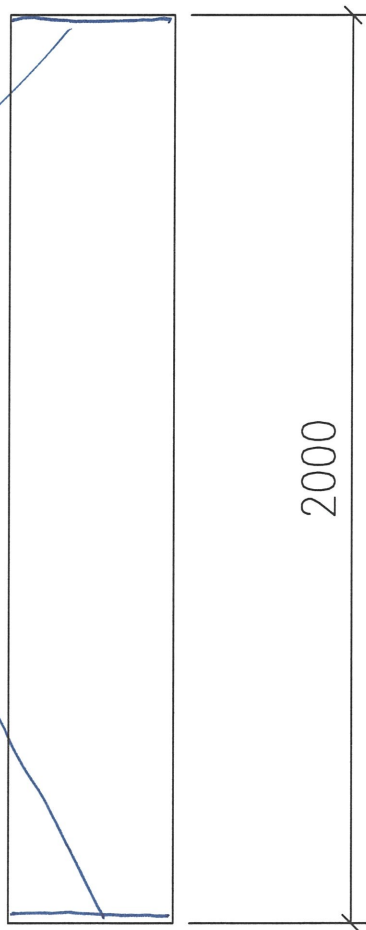


技术要求:


1. 鋁面板厚度3mm, 材質等級為 3003-H14;
2. 表面EC-DG-D334232-ZD1(3塗)" "為噴塗面, 噴塗顏色號: 待定;
3. 鋁板油漆要符合規範做附着力測試(Pull out test);
4. 固定加強筋的鋁種焊釘要符合規範做撞擊測試(Impact test);
5. 鋁板加工偏差要符合規範, 出廠要查驗, 加工完成后做好膜紙保护和貼示加工編號.

工程號	J853	地盤	香港延坪道 GLASS WALL		附 件	
名稱	鋁板加工圖		採	用		-
材料	3mm鋁板		地盤			
顏色	EC-DG-D334232-ZD1		工廠			

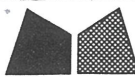 美特鋁質有限公司 MIDI Aluminium Fabricator Ltd.				類別		物料號	
修改				制圖	AN	2023/08/10	圖號
日期				復核	—	—	數量
				批准	—	—	單件重量 (KG)
							J853-4009Z01
							2
							—

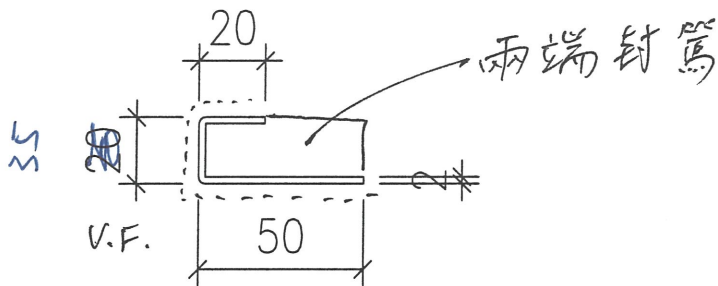


兩端封篤


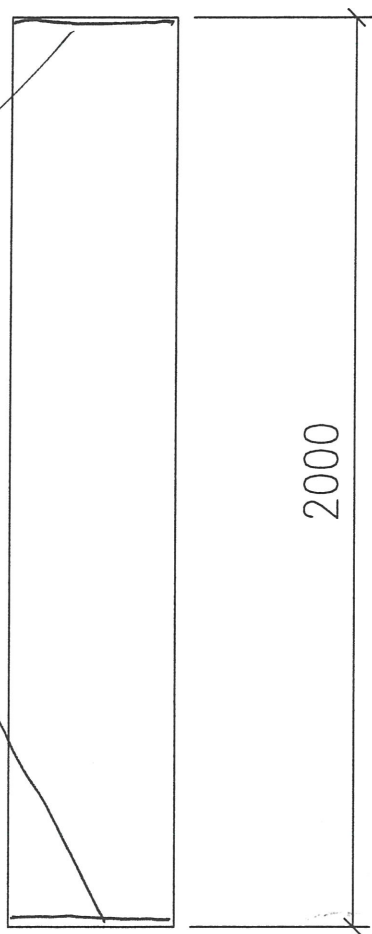


技术要求:

1. 鋁面板厚度3mm, 材質等級為 3003-H14;
2. 表面EC-DG-D334232-ZD1(3塗)" 為噴塗面, 噴塗顏色號: 待定;
3. 鋁板油漆要符合規範做附着力測試 (Pull out test);
4. 固定加強筋的鋁種焊釘要符合規範做撞擊測試 (Impact test);
5. 鋁板加工偏差要符合規範, 出廠要資檢, 加工完成后做好膜紙保护和貼示加工編號.

工程號	J853	地盤	香港延坪道 GLASS WALL	附件	
名稱	鋁板加工圖		採用		—
材料	3mm鋁板		地盤		
顏色	EC-DG-D334232-ZD1		工廠		

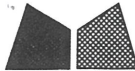 美特鋁質有限公司 MIDI Aluminium Fabricator Ltd.				類別		物料號		
修改				制圖	AN	2023/08/10	圖號	J853-4009-Z02
日期				復核	—	—	數量	2
				批准	—	—	單件重量 (KG)	—

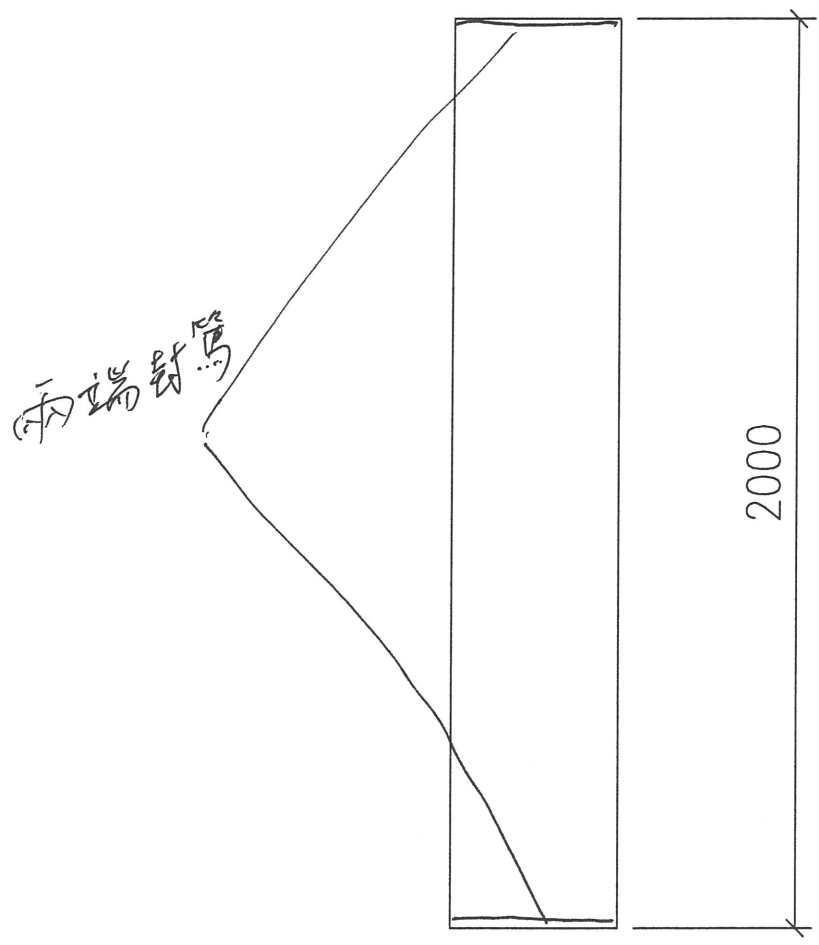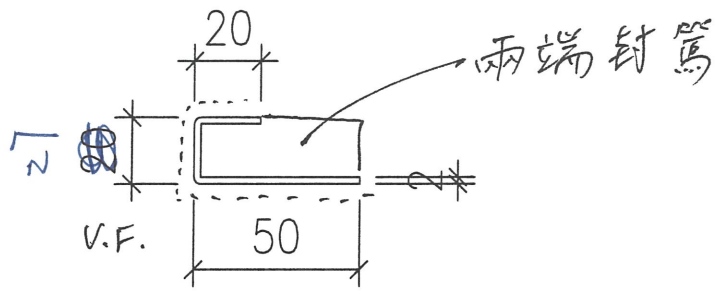

- 技术要求:
1. 鋁面板厚度3mm, 材質等級為 3003-H14;
 2. 表面EC-DG-D334232-ZD1(3塗)" 為噴塗面, 噴塗顏色號: 待定;
 3. 鋁板油漆要符合規範做附着力測試 (Pull out test);
 4. 固定加強筋的鋁種焊釘要符合規範做撞擊測試 (Impact test);
 5. 鋁板加工偏差要符合規範, 出廠要資檢, 加工完成后做好膜紙保护和貼示加工編號.

工程號	J853	地盤	香港延坪道 GLASS WALL	附件	
名稱	鋁板加工圖	採用			—
材料	3mm鋁板	地盤			
顏色	EC-DG-D334232-ZD1	工廠			

AS BUILT DRAWING

B.D. REF. :

CLIENT : SHIMAO GROUP HOLDINGS LIMITED



ARCHITECT : WONG TONG & PARTNERS LIMITED
Architects

MAIN CONTRIBUTOR :

STRUCTURAL ENGINEER : C M WONG & ASSOCIATES LTD
Consulting Engineers

FAÇADE CONSULTANT : MEINHARDT

NOTE :
1. ALL DIMENSIONS ARE IN mm.
2. ALL DIMENSIONS ARE VERIFIED FROM OUTSIDE.
3. BEFORE FABRICATION.
LEGEND :
[Symbol] DETAIL MARK NO.
[Symbol] REFER SHEET NO.
1. F.F.L.--FINISHED FLOOR LEVEL
2. S.F.L.--STRUCTURAL FLOOR LEVEL
3. [Symbol] --REVERSED DETAIL


CI = 10mm THK. HEAT STRENGTHENED GLASS
F1 = 12mm THK. SINGLE LAMINATED GLASS (SLG)
G2 = 12mm THK. CLEAR HEAT STRENGTHENED GLASS
G3 = 10mm THK. CLEAR LAMINATED GLASS (L1-12/99)
G4 = 10mm THK. CLEAR LAMINATED LAMINATED GLASS

NO.	DATE	REVISION
H	30/07/2024	REVISION SUBJECT TO RELOCATION
G	25/04/2023	REVISION SUBJECT TO RELOCATION
F	13/01/2023	REVISION SUBJECT TO RELOCATION
E	12/01/2023	GENERAL REVISION
D	29/11/2022	REVISION SUBJECT TO RELOCATION
C	09/09/2022	UPDATED DRAWING
B	27/7/2022	UPDATED DRAWING
A	25/5/2022	UPDATED DRAWING

JOB NO. : J-853
PROJECT : PROPOSED RESIDENTIAL DEVELOPMENT AT SHELL, 65#42 YIN PING ROAD, KOWLOON

TITLE : PART ELEVATION 3 OF PODIUM

DATE : 18-Mar-21 SCALE : 1:70
DRAWN BY : Ikon CHECKED BY :
MIDI 美持經貿有限公司
MIDI Architecture Associates Ltd
Suite 6-3, Sunny Industrial Centre, 1/F
162,248/211-4 Tel: (852)27272666
DWG NO. : 0553-CW-4003 REV. : H

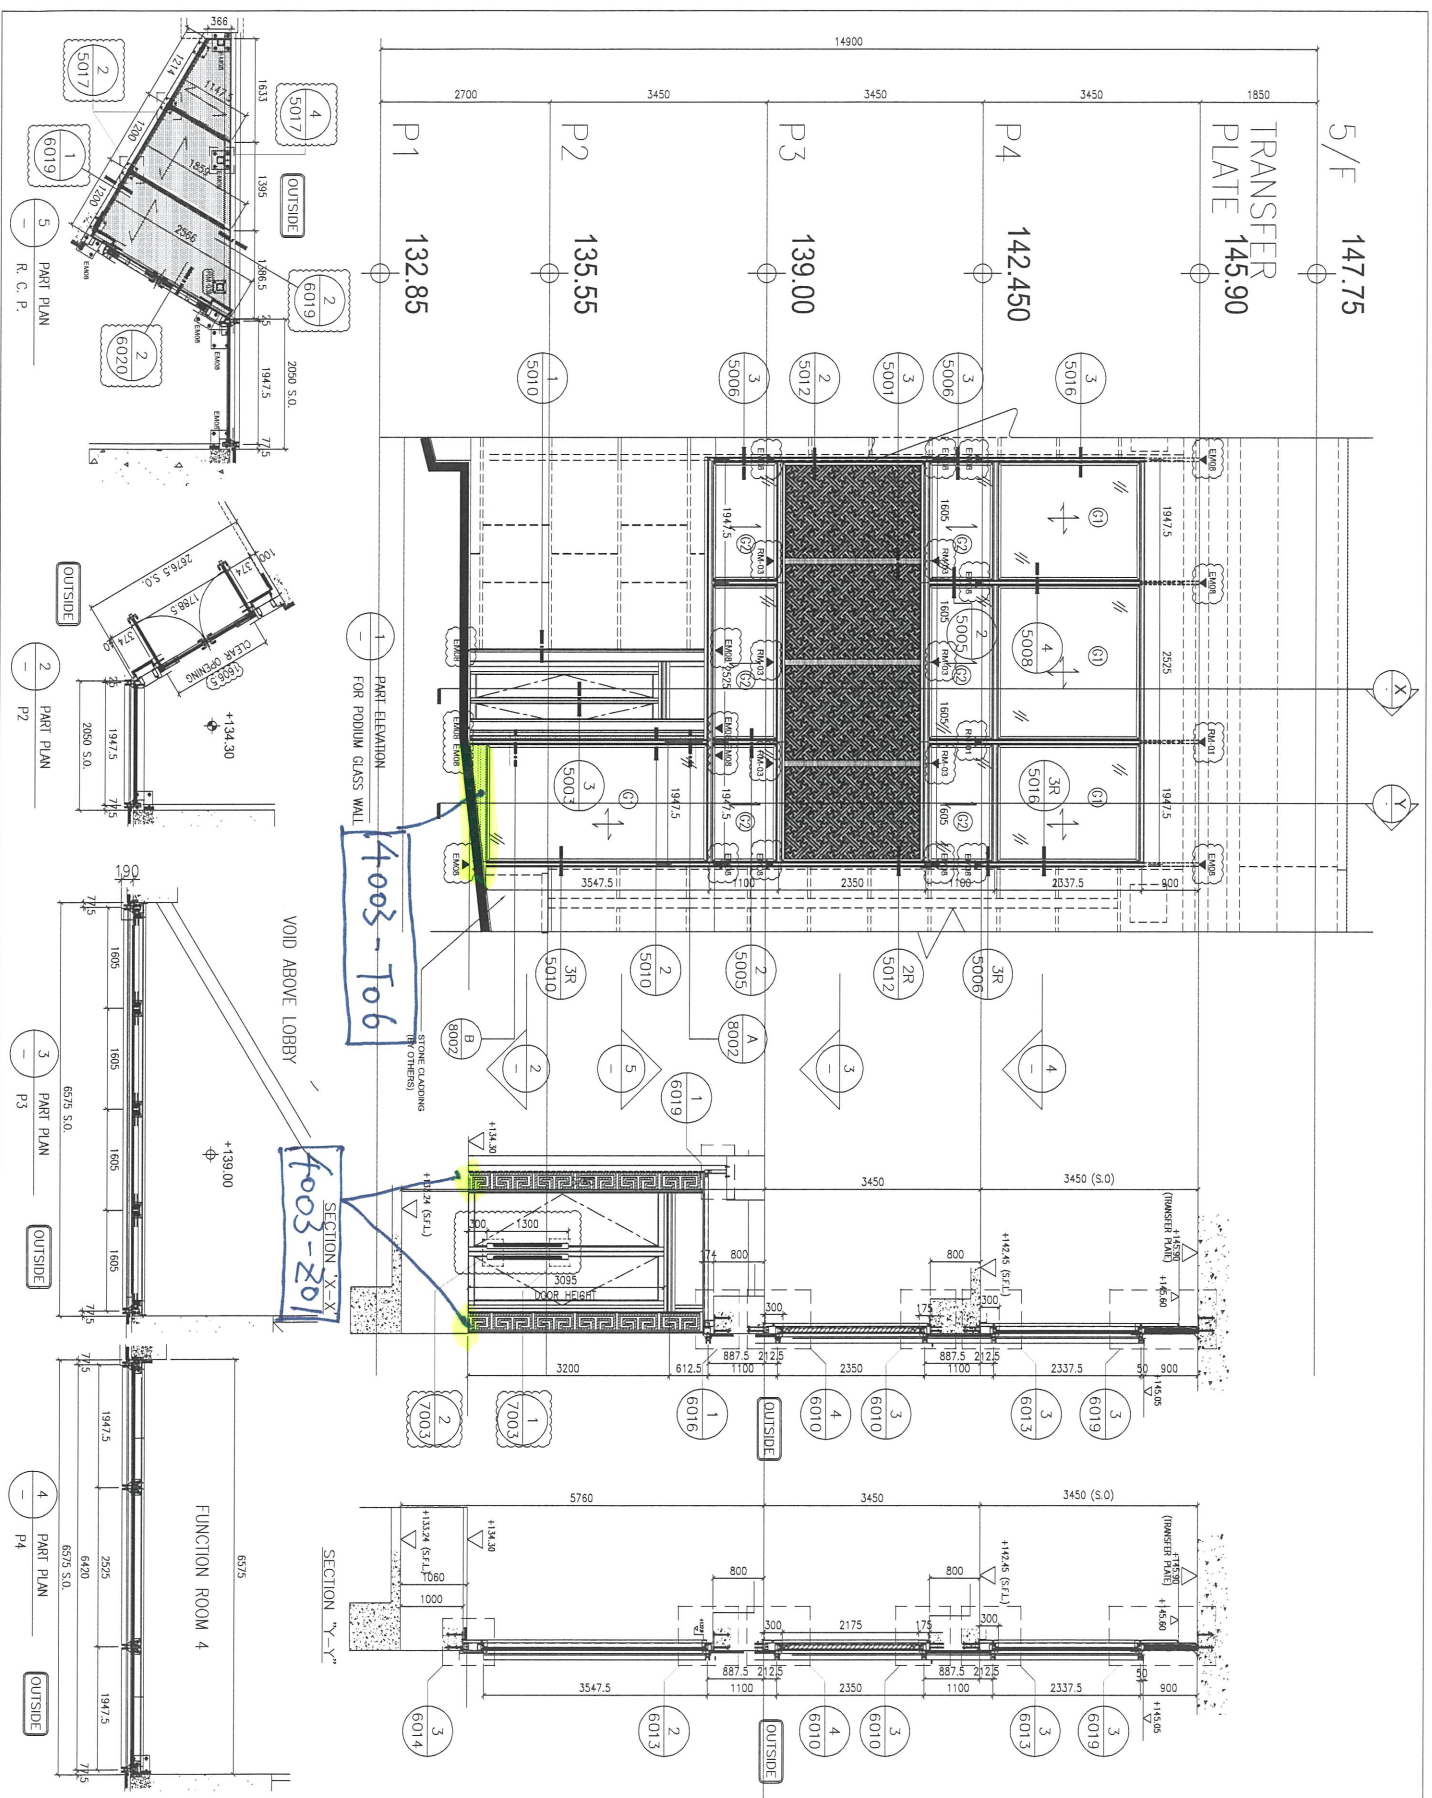

AS BUILT DRAWING

B.O. REF :

CLIENT :
SHIMAO GROUP
HOLDINGS LIMITED

ARCHITECT :
HONG TUNG & PARTNERS LIMITED
CONSULTING ENGINEERS

MAIN CONTRACTOR :

STRUCTURAL ENGINEER :
C M WONG & ASSOCIATES LTD
Consulting Engineers

FAÇADE CONSULTANT :
WEINHARDT

NOTE:


1. ALL DIMENSIONS ARE IN mm.
 2. ALL DIMENSIONS TO BE TAKEN FROM OUTSIDE.
 3. ALL DIMENSIONS TO BE TAKEN ON SITE BEFORE FABRICATION.
- LEGEND:
- Ø --- DETAIL MARK NO.
 - Ø --- REFER SHEET NO.
 - 1. F.F.L. --- FINISHED FLOOR LEVEL
 - 2. S.F.L. --- STRUCTURAL FLOOR LEVEL
 - 3. --- REVERSED DETAIL
- Ø1 = 10mm THK. HEAT STRENGTHENED GLASS
 Ø2 = 12mm THK. CLEAR HEAT STRENGTHENED GLASS
 Ø3 = 9mm THK. CLEAR TINTED GLASS (+25%)
 Ø4 = 10mm THK. CLEAR TINTED LAMINATED GLASS

NO.	DATE	BY	REVISION
A	25/5/2022		ISSUED DRAWING
B	27/7/2022		REVISED DRAWING
C	09/9/2022		REVISION SUBJECT TO ARCHITECTMENT
D	29/11/2022		REVISION SUBJECT TO ARCHITECTMENT
E	12/01/2023		GENERAL REVISION
F	13/03/2023		REVISION SUBJECT TO ARCHITECTMENT
G	25/04/2023		REVISION SUBJECT TO ARCHITECTMENT
H	30/07/2024		REVISION SUBJECT TO ARCHITECTMENT

PROJECT : PROPOSED RESIDENTIAL DEVELOPMENT AT NIKILL 6542 YIN PING ROAD KOWLOON

TITLE : PART ELEVATION 4 OF PODIUM

DATE : 18-Mar-21 SCALE : 1:30
 DRAWN BY : Iwan CHECKED BY :
美特銘實有限公司
 MIDY AUTOMATIC FASTENERS LTD.
 Unit 6-8, Sunny Industrial Centre, 1/F
 60-24Kwai Tin, 4/F, Tseung Kwan Oon
 LINC NO. : 0853-CW-4004 REV. : H

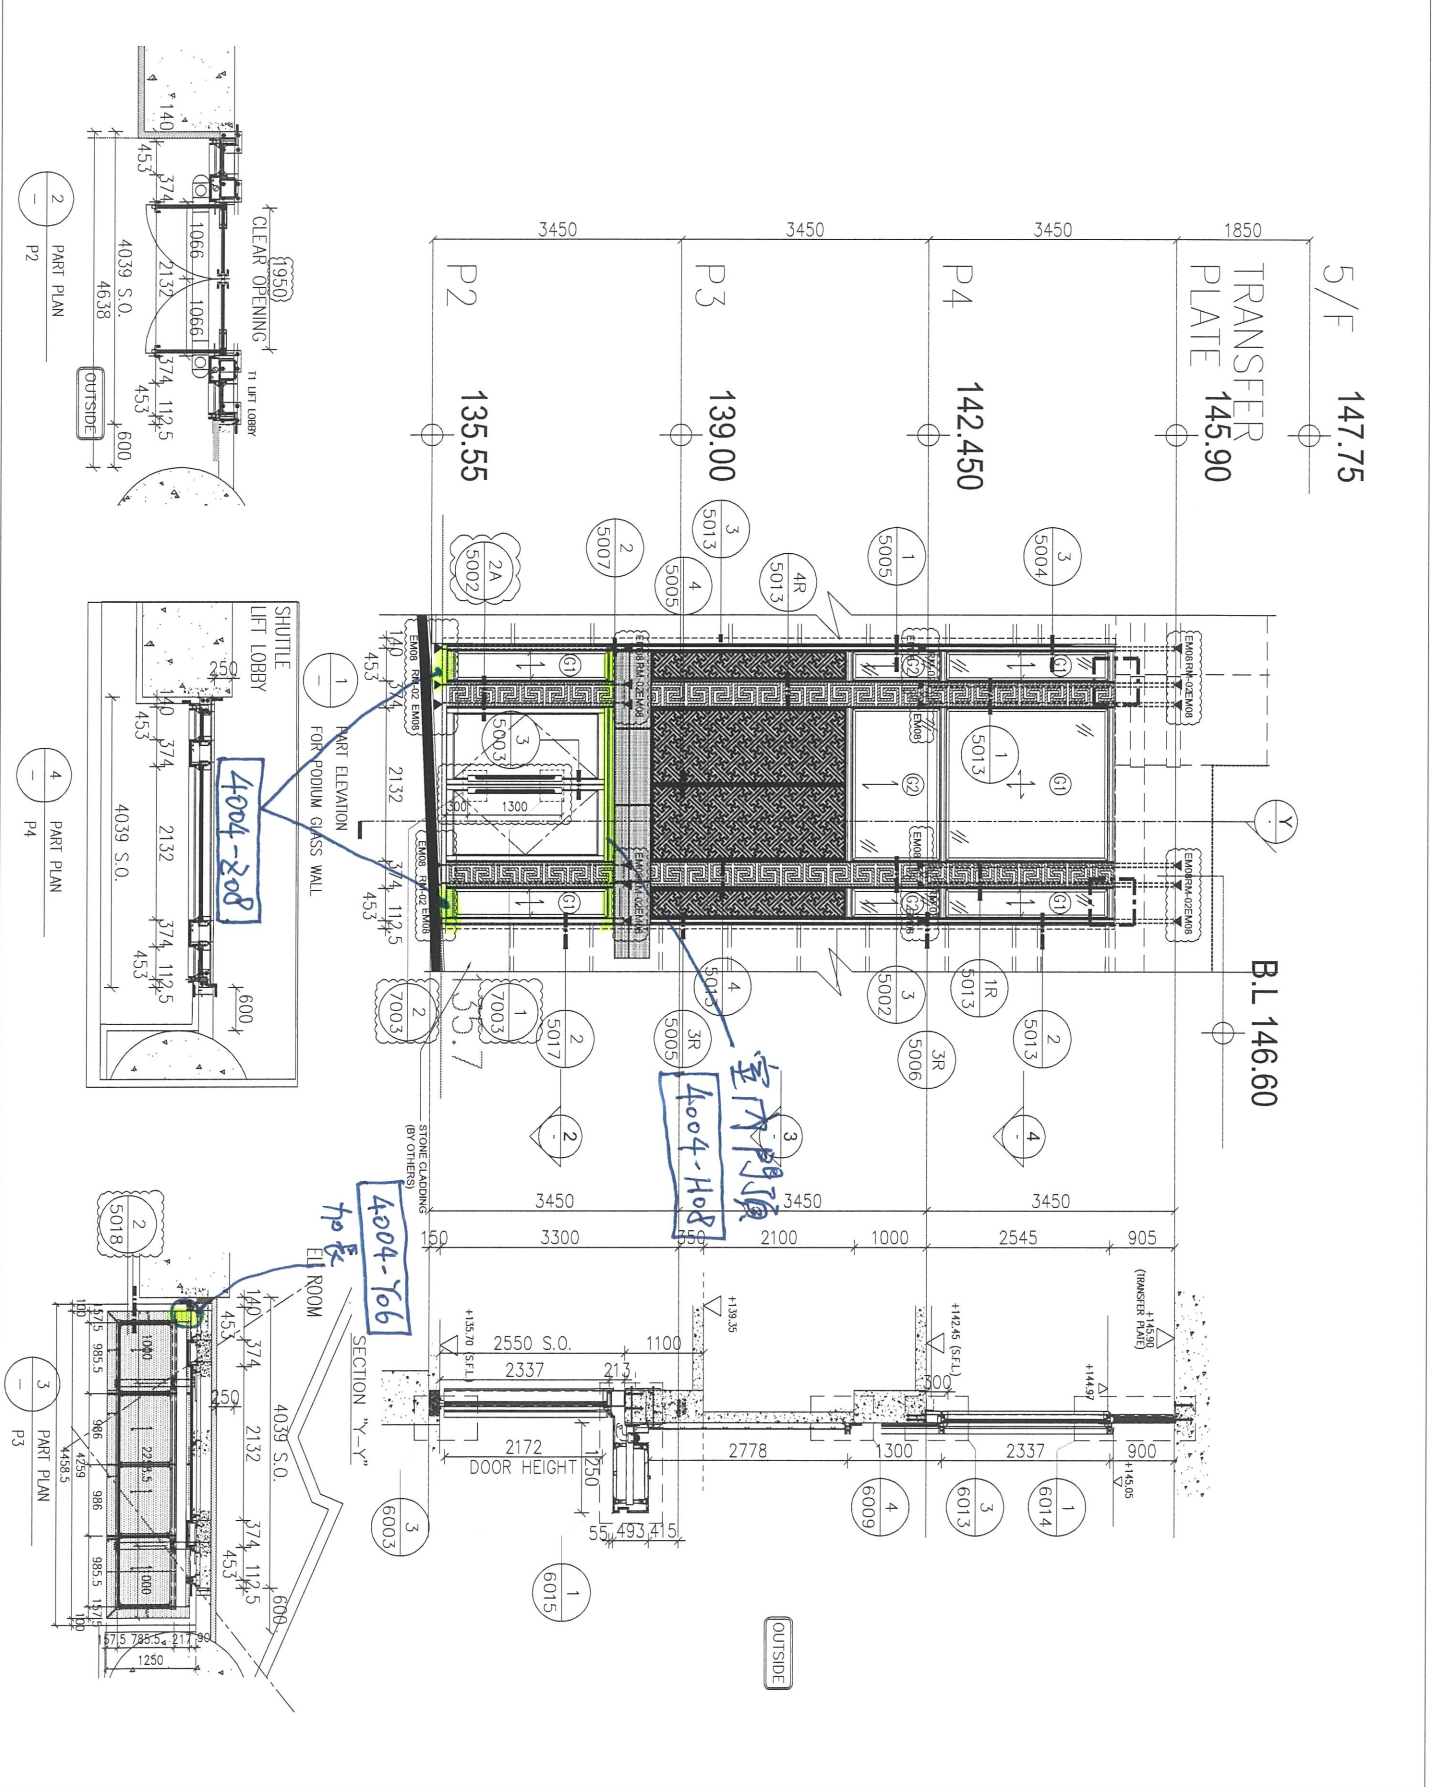

2 PART PLAN P2

4 PART PLAN P4

3 PART PLAN P3

AS BUILT DRAWING

CLIENT : SHIMAO GROUP HOLDINGS LIMITED

ARCHITECT : WPT
WONG PING TUNG & PARTNERS LIMITED

MAIN CONTRACTOR : C.M. WONG & ASSOCIATES LTD
Consulting Engineers

STRUCTURAL ENGINEER : C.M. WONG & ASSOCIATES LTD
Consulting Engineers

MEINHARDT


- NOTE :
1. ALL DIMENSIONS ARE IN mm.
 2. ALL DIMENSIONS ARE VERIFIED FROM OUTSIDE BEFORE FABRICATION.
 3. BEFORE FABRICATION.
- LEGEND :
- (X) DETAIL MARK NO.
 - (NO) REFER SHEET NO.
 - 1. F.F.L. -- FINISHED FLOOR LEVEL
 - 2. S.E.L. -- STRUCTURAL FLOOR LEVEL
 - 3. (R) -- REVERSED DETAIL
- G1 = 10mm THK. HEAT SENSITIVE GLASS
 G2 = 12mm THK. CLEAR INSULATED GLASS (IGU)
 G3 = 10mm THK. CLEAR INSULATED GLASS
 G4 = 10mm THK. CLEAR INSULATED GLASS
 G5 = 10mm THK. CLEAR INSULATED GLASS
 G6 = 10mm THK. CLEAR INSULATED GLASS

NO.	DATE	DESCRIPTION
H	30/07/2024	REVISION SUBJECT TO REVISION
G	25/06/2023	REVISION SUBJECT TO REVISION
F	13/03/2023	REVISION SUBJECT TO REVISION
E	12/01/2023	GENERAL REVISION
D	29/11/2022	REVISION SUBJECT TO REVISION
C	09/09/2022	UPDATED DRAWING
B	27/11/2022	UPDATED DRAWING
A	28/5/2022	UPDATED DRAWING
NO.	DATE	REVISION


JOB NO. : J-853
 PROJECT : PROPOSED RESIDENTIAL DEVELOPMENT AT INKILL, 6542 YIN PING ROAD KOWLOON

TITLE : PART ELEVATION 9 OF PODIUM

DATE : 18-Mar-21 SCALE : 1:70
 DRAWN BY : Ivan CHECKED BY :
 美特堅有限公司
 MIDT Architecture Institution Ltd
 10/F, 65-65, Sunny Road, Kowloon, H.K.
 Tel: 23489211-4 Fax: (852) 2727986
 DWG NO. : 8553-CW-4009 REV. : H

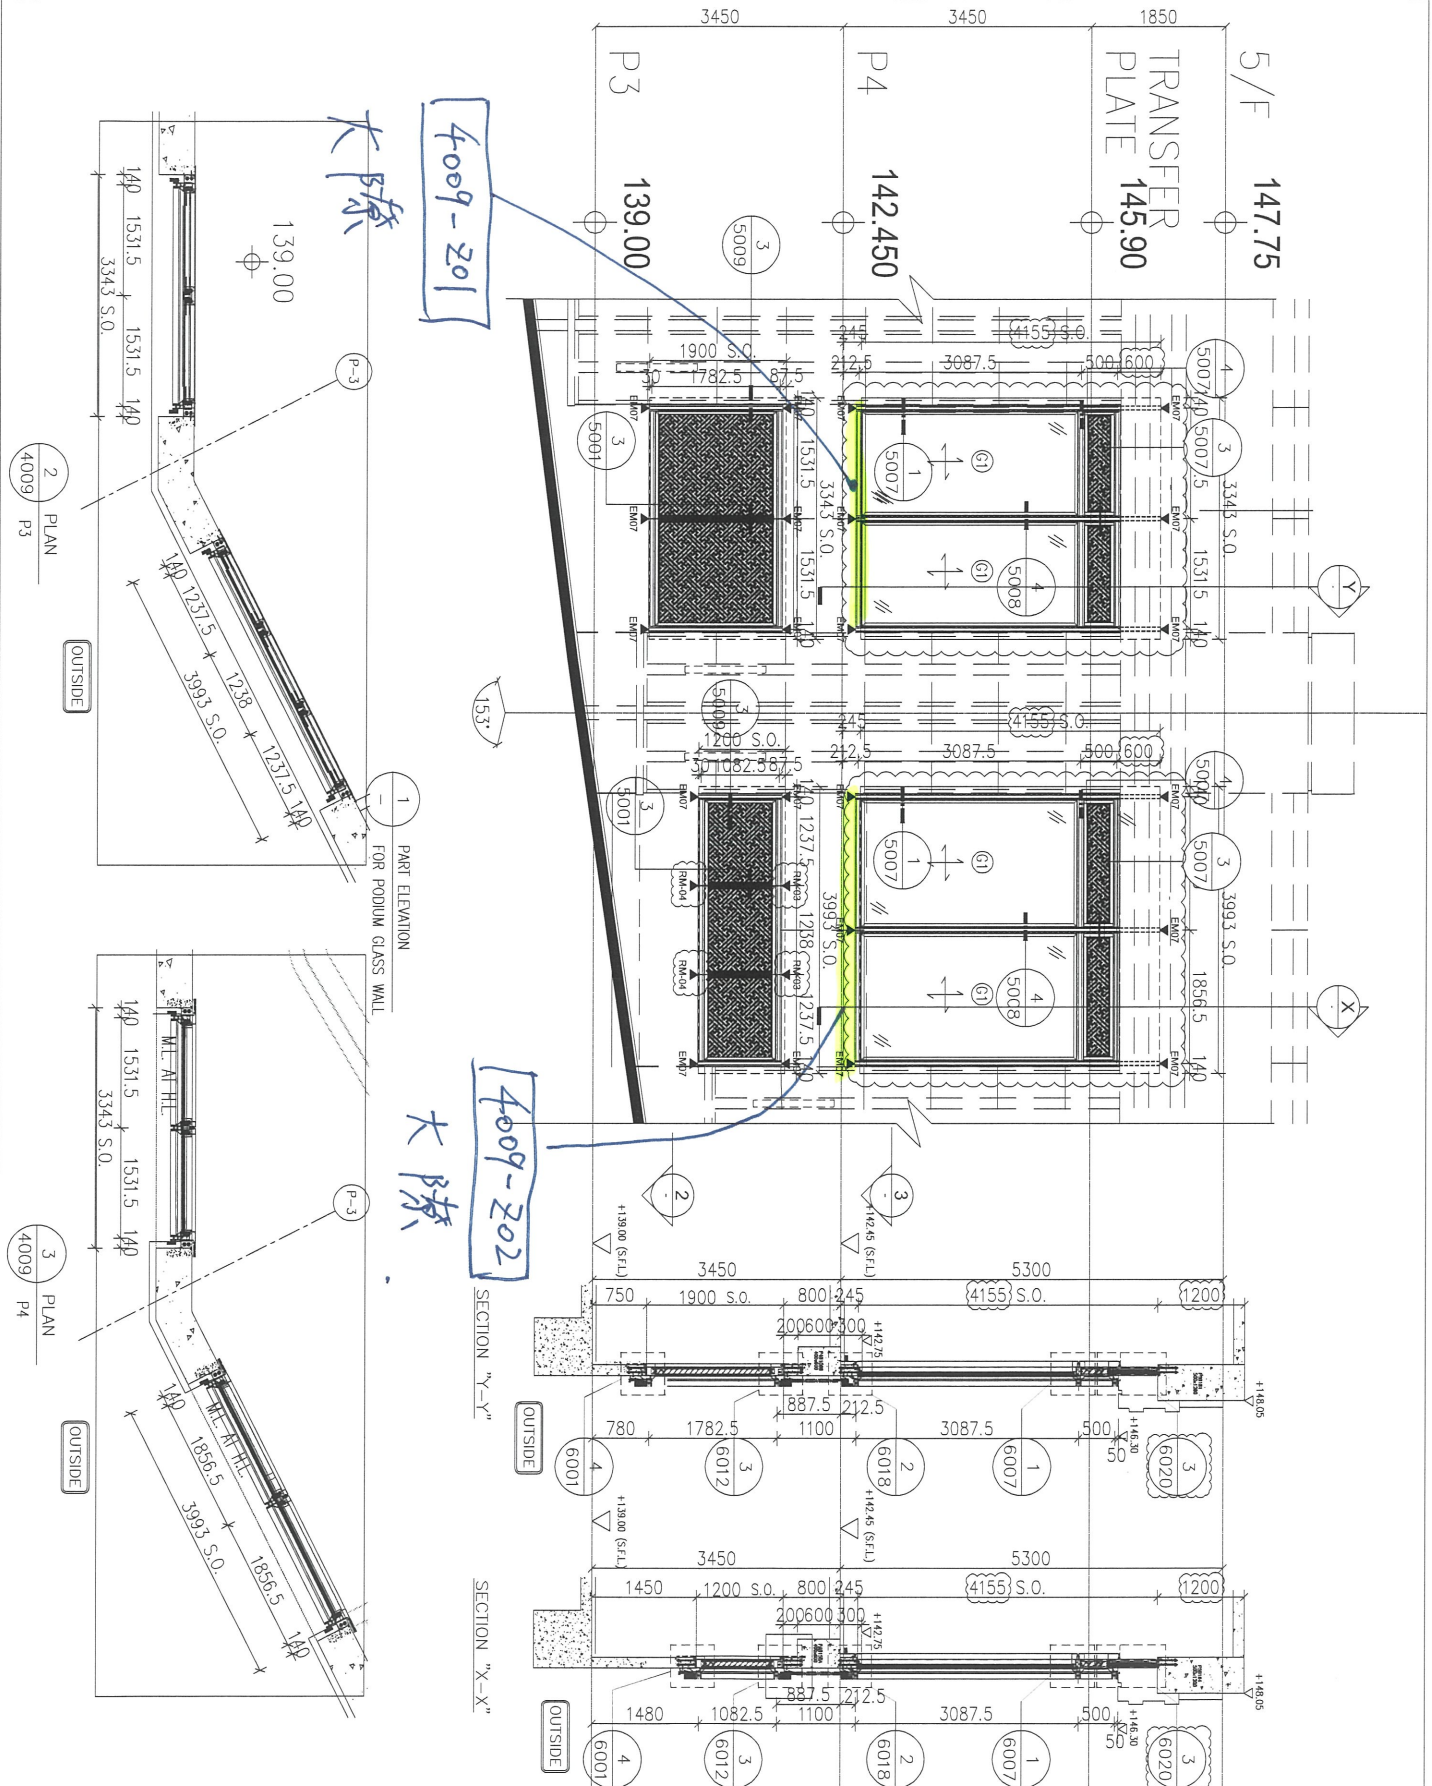

4002

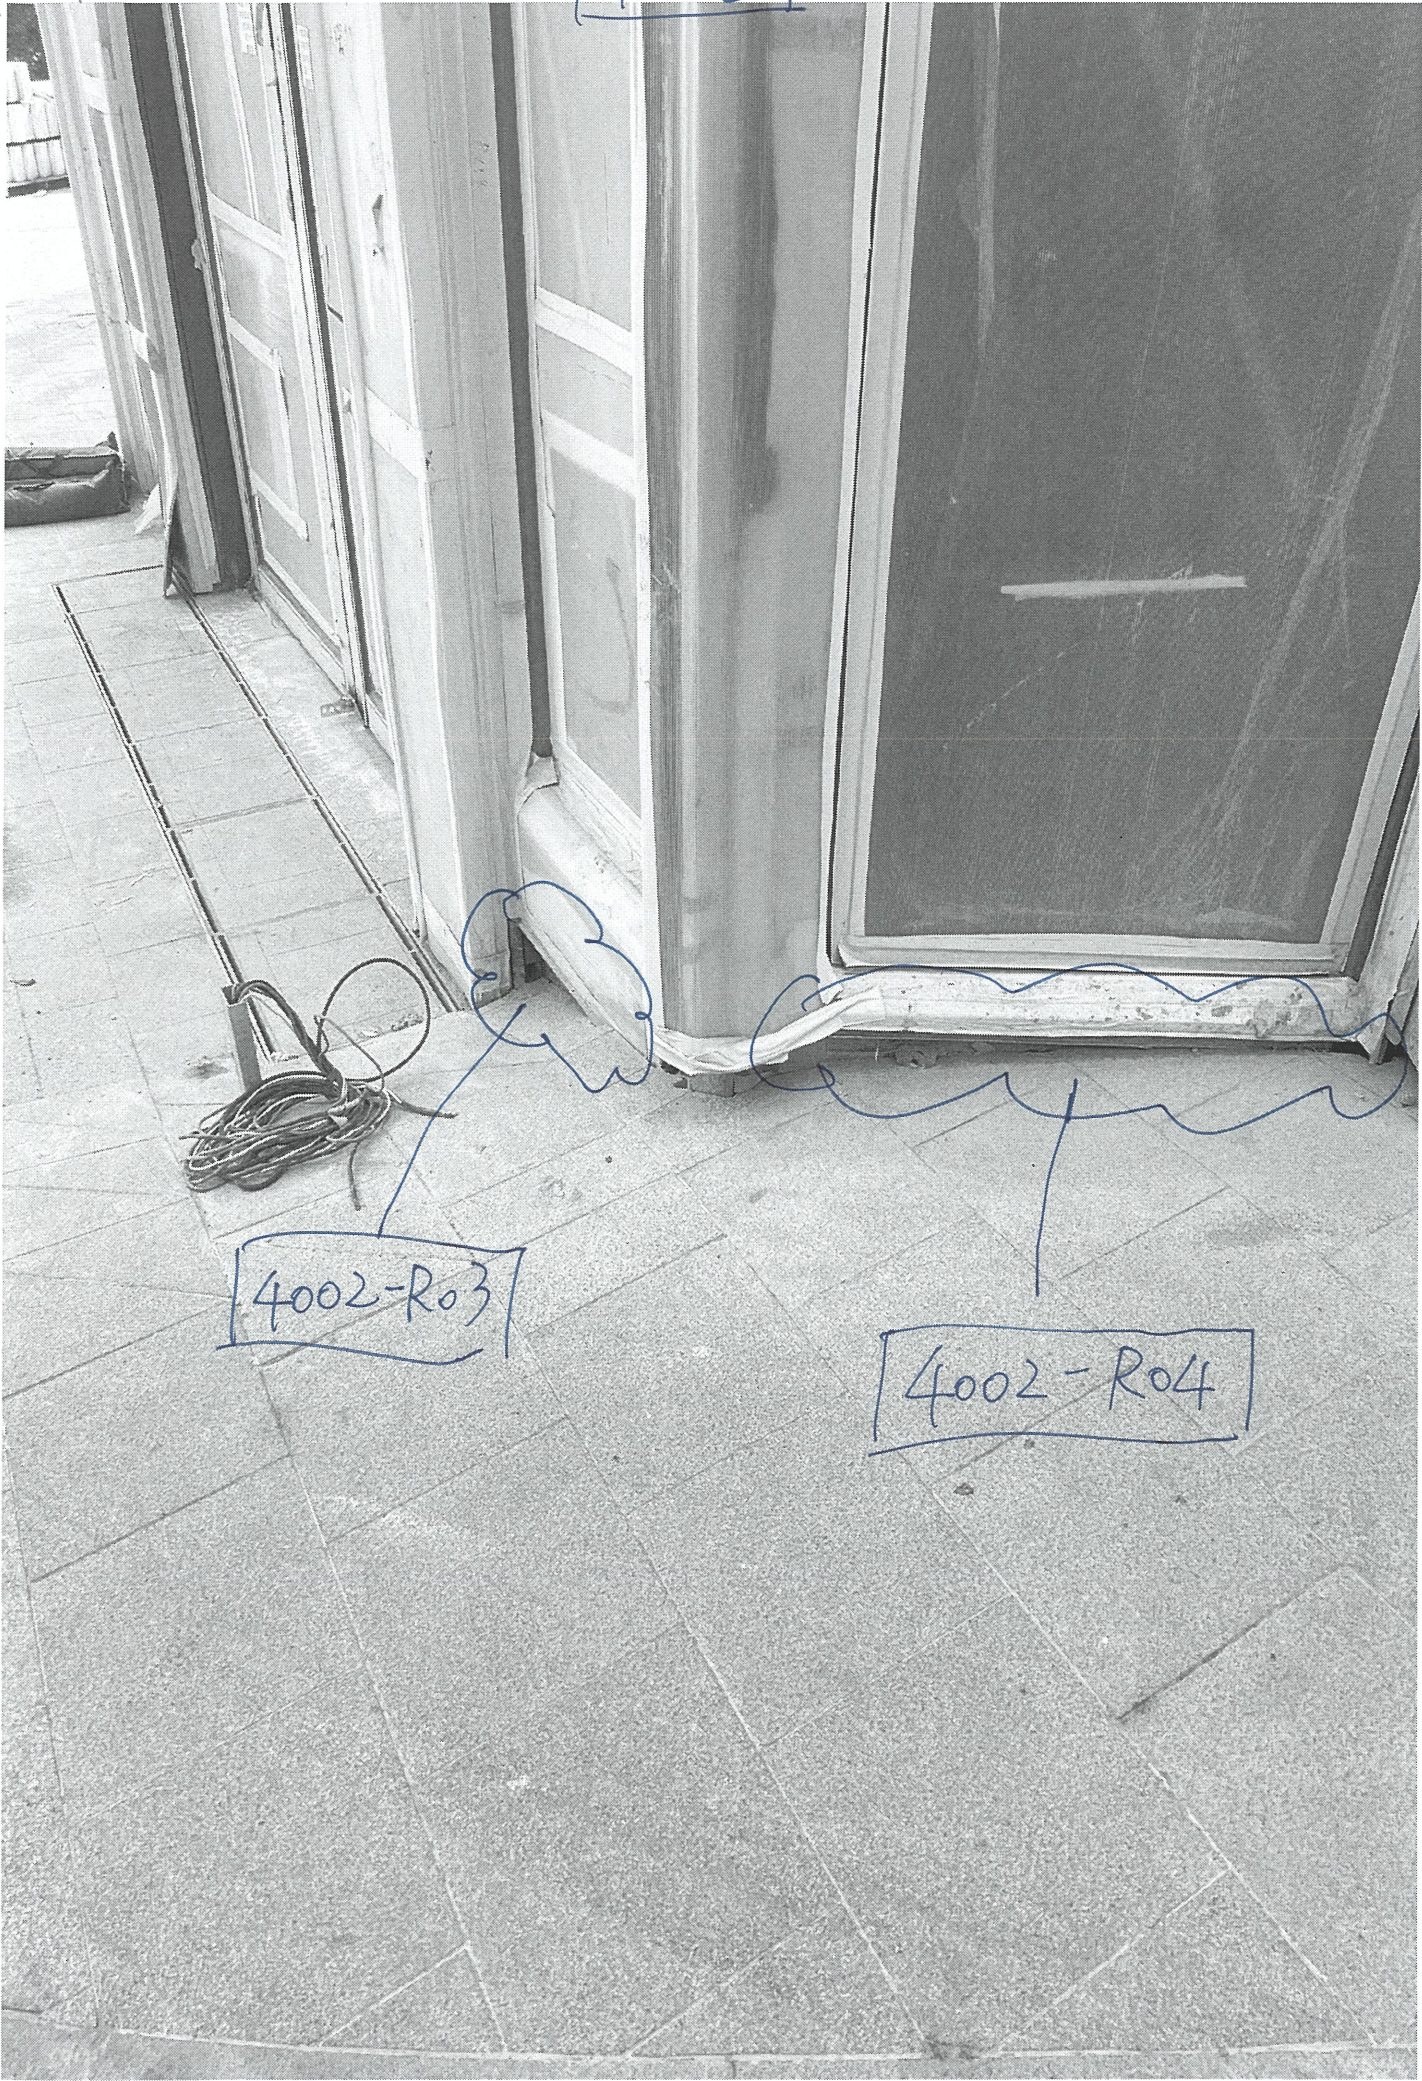

4002-R03

4002-R04

4003



4003-201

左右2件


4003-T06



4004 - Job

4004-Zof



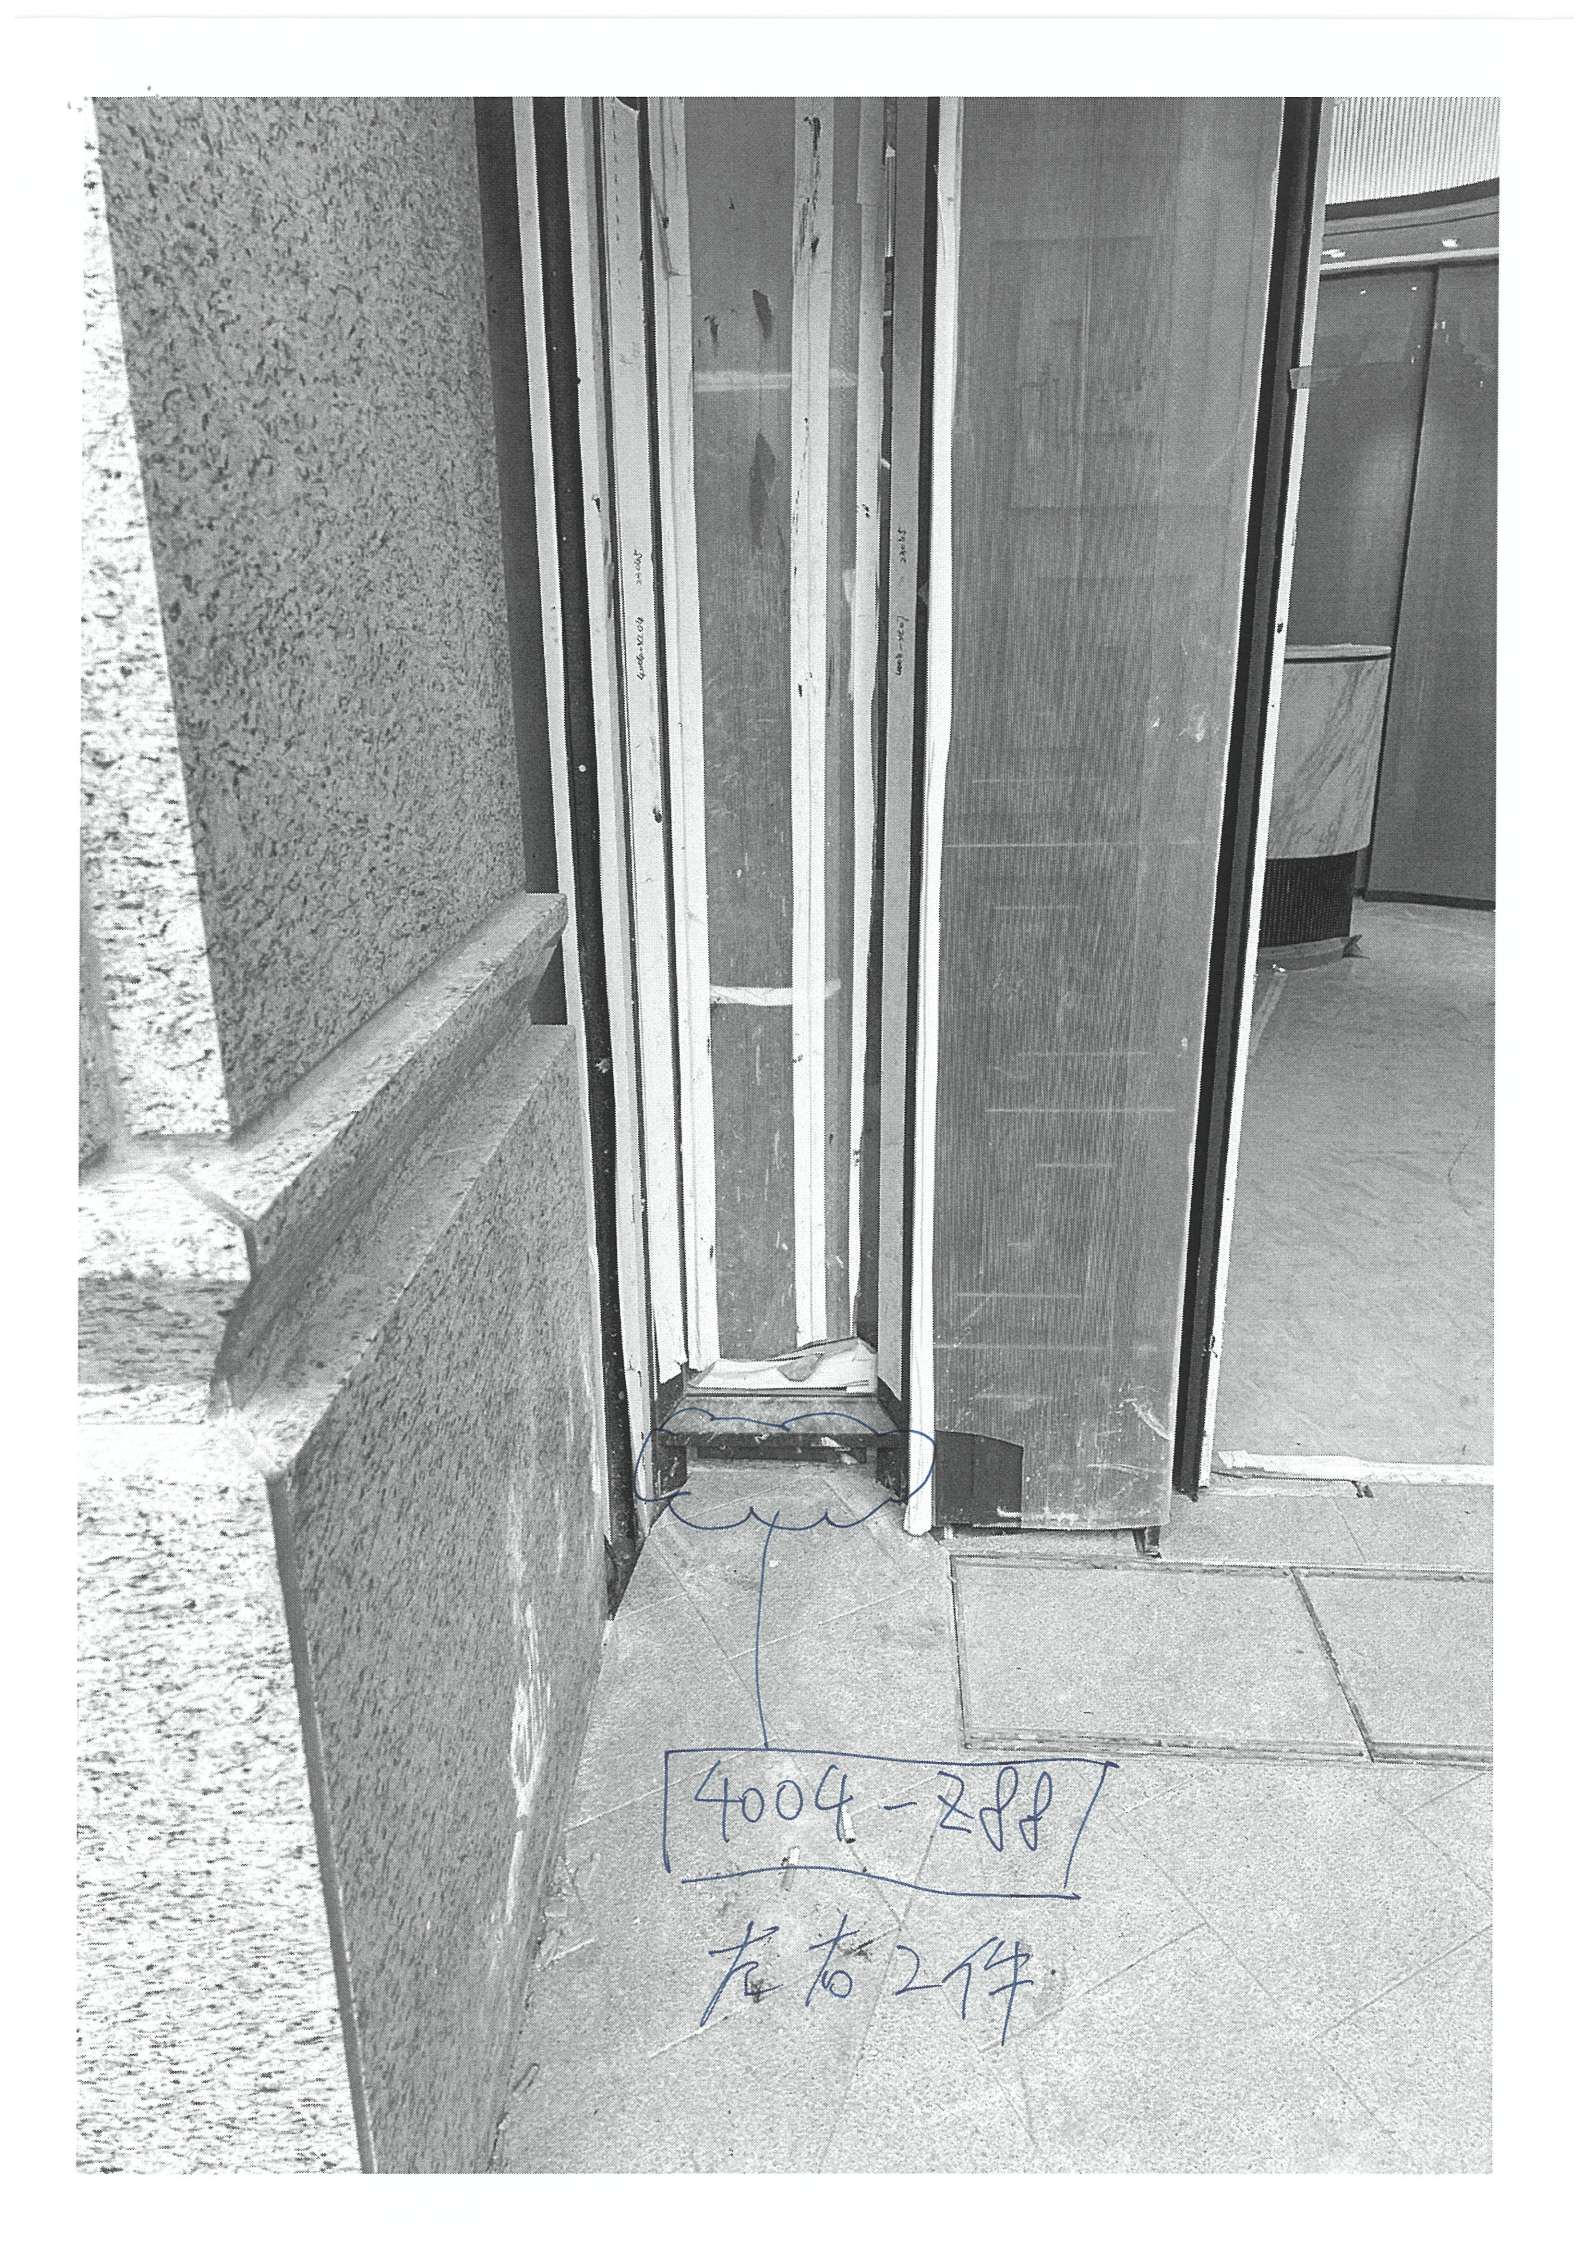

4004-2ff

左右2件