

工程指示 / 要求簡箋 ENGINEER INSTRUCTIONS(E.I.)

工程指示編號:	EI- 5449 B	修改版本:	B
	HK- 1130		
工程編號:	J 856	工程名稱:	天榮站
收件人:	生統/ 王良/ 林仁安	發件人:	Jingo
工程項目:	CW幕牆補充室外玻璃保護膜塗層方案	日期:	19/05/2023

<input checked="" type="checkbox"/> 原合約工程包	<input type="checkbox"/> 原合約工程加 / 減賬 QT-	<input type="checkbox"/> 新工程報價 QT-
--	--	------------------------------------

信件批核號碼/圖紙參考編號:	批核模具圖紙編號:
客戶指示附件:	管理內部批簽署:

<input type="checkbox"/> 初步鋁料 B.M.	<input type="checkbox"/> 加工拆圖, 然後生產	<input type="checkbox"/> 尺寸表
<input type="checkbox"/> 正式鋁料 B.M.	<input type="checkbox"/> 技術上資料/指示	<input type="checkbox"/> 報價
<input type="checkbox"/> 配件 B.M.	<input type="checkbox"/> 樣辦或貨品說明書	<input type="checkbox"/> 分判合約
<input type="checkbox"/> 其他:		

內容:
請按附件提供保護: CW幕牆補充室外玻璃保護膜塗層 - Omiguard 110NP

完成上列要求日期: 22/05/2023



國內

<input type="checkbox"/> 生產技術總監	<input type="checkbox"/> 連附件	<input checked="" type="checkbox"/> 技術部	<input checked="" type="checkbox"/> 連附件	<input type="checkbox"/> 生產部	<input type="checkbox"/> 連附件
<input type="checkbox"/> 採購部	<input type="checkbox"/> 連附件	<input checked="" type="checkbox"/> 生產統籌部	<input checked="" type="checkbox"/> 連附件	<input type="checkbox"/> 報關組	<input type="checkbox"/> 連附件
<input checked="" type="checkbox"/> 質檢部	<input checked="" type="checkbox"/> 連附件	<input type="checkbox"/> 會計部	<input type="checkbox"/> 連附件	<input type="checkbox"/> 機械設計部	<input type="checkbox"/> 連附件
<input type="checkbox"/> 香港辦	<input type="checkbox"/> 連附件	<input type="checkbox"/> 其他:			


香港

<input type="checkbox"/> 行政部	<input type="checkbox"/> 連附件	<input type="checkbox"/> 會計部	<input type="checkbox"/> 連附件	<input type="checkbox"/> 統籌部	<input type="checkbox"/> 連附件	<input type="checkbox"/> 工程部	<input type="checkbox"/> 連附件
<input type="checkbox"/> 採購部	<input type="checkbox"/> 連附件	<input type="checkbox"/> QS部	<input type="checkbox"/> 連附件	<input type="checkbox"/> 地盤管理	<input type="checkbox"/> 連附件	<input type="checkbox"/> 維修部	<input type="checkbox"/> 連附件

*發件人簽署: Jingo	*組別成員批核簽署:
傳遞編號:	項目經理簽署:

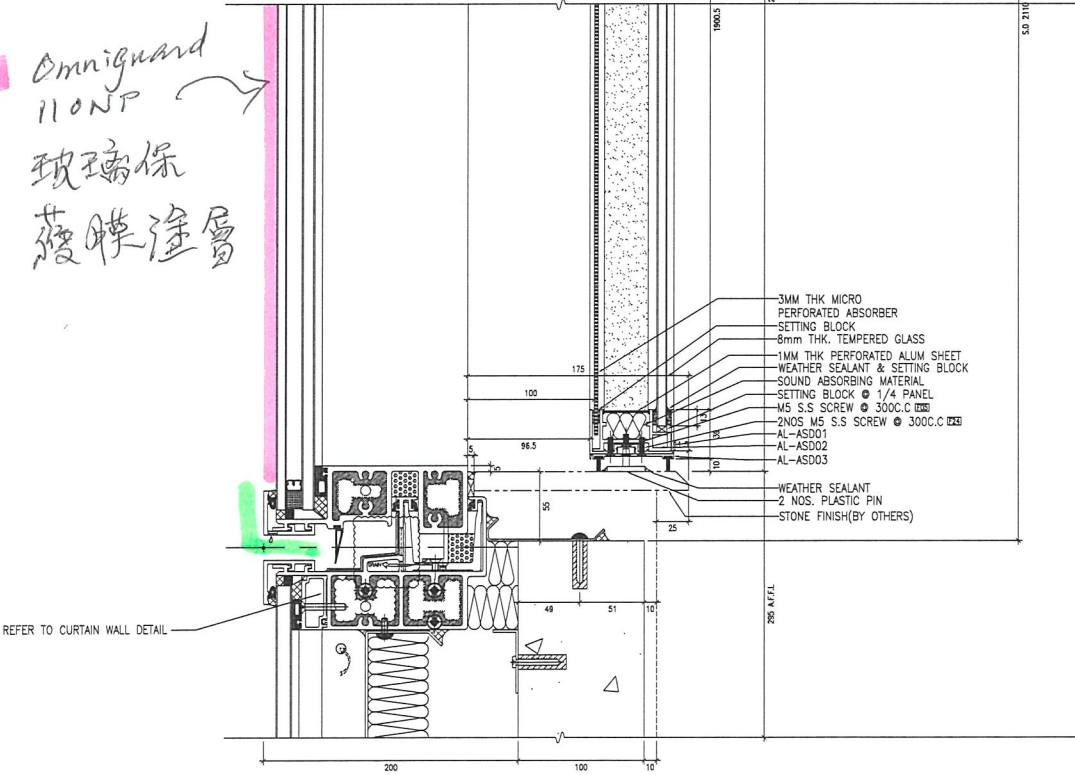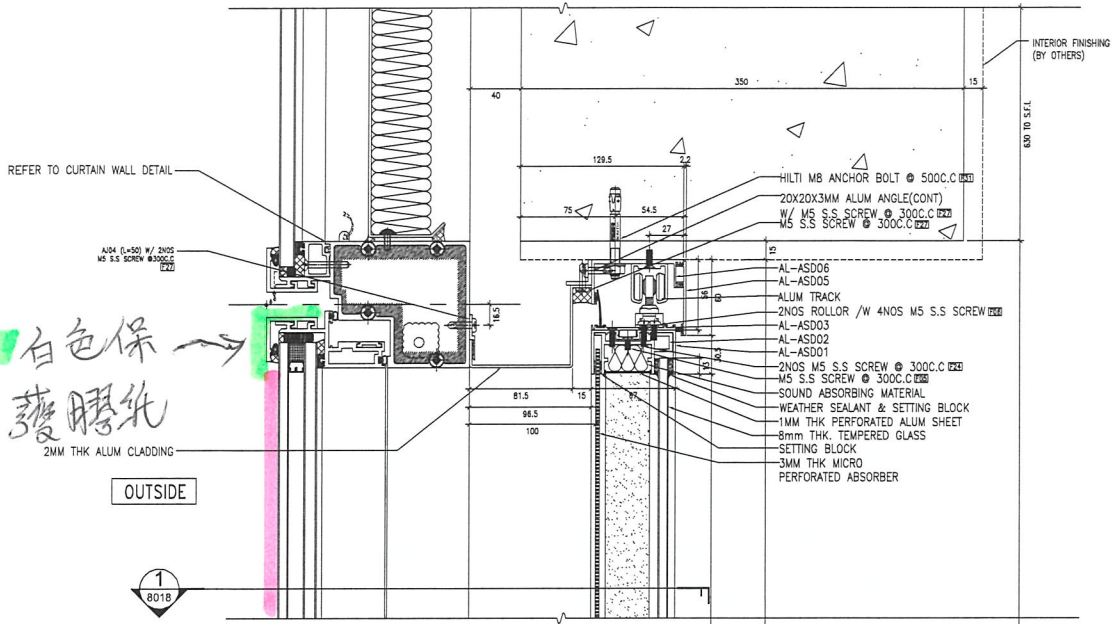

B.O. REF :																					
CLIENT : SUN HUNG KAI REAL ESTATE AGENCY LTD. <small>42/F, SUN HUNG KAI CENTRE, WANCHAI, HONGKONG</small>																					
ARCHITECT : hwk&partners ARCHITECTS																					
MAIN CONTRACTOR : 怡輝建築有限公司 Yee Fai Building Contractors Ltd.																					
STRUCTURAL ENGINEER : ARUP																					
FACADE CONSULTANT : ALPHA CONSULTING LIMITED <small>Steel Structure & Façade Specialist</small>																					
NOTE: 1. ALL DIMENSIONS ARE IN MM. 2. ALL ELEVATIONS ARE VIEWED FROM OUTSIDE. 3. ALL DIMENSIONS TO BE VERIFIED ON SITE BEFORE FABRICATION.																					
LEGEND: (A) DETAIL MARK NO. (X) REFER SHEET NO. (1) F.F.L. - FINISHED FLOOR LEVEL 2) R.F.L. - STRUCTURAL FLOOR LEVEL 3) (R) - REVERSED DETAIL																					
<table border="1"> <thead> <tr> <th>NO.</th> <th>DATE</th> <th>DESCRIPTION</th> <th>BY</th> <th>CHKD.</th> </tr> </thead> <tbody> <tr> <td>1</td> <td>21-09-2022</td> <td>REV. DIMENSION</td> <td>HW</td> <td>HW</td> </tr> <tr> <td>2</td> <td>24-09-2022</td> <td>2ND DIMENSION</td> <td>HW</td> <td>HW</td> </tr> <tr> <td>3</td> <td>21-09-2022</td> <td>REV. DIMENSION</td> <td>HW</td> <td>HW</td> </tr> </tbody> </table>	NO.	DATE	DESCRIPTION	BY	CHKD.	1	21-09-2022	REV. DIMENSION	HW	HW	2	24-09-2022	2ND DIMENSION	HW	HW	3	21-09-2022	REV. DIMENSION	HW	HW	JOB NO. : J-856 PROJECT : PROPOSED DEVELOPMENT ABOVE LIGHT RAIL TIN WING STOP 15W/L NO.23 AREA 331M SHUI WAH N.T.
NO.	DATE	DESCRIPTION	BY	CHKD.																	
1	21-09-2022	REV. DIMENSION	HW	HW																	
2	24-09-2022	2ND DIMENSION	HW	HW																	
3	21-09-2022	REV. DIMENSION	HW	HW																	
TITLE : TYPICAL DETAIL FOR CURTAIN WALL	DATE : 31-OCT-22 SCALE : 1:4 DRAWN BY : C.F. CHECKED BY :																				
DWG. NO. : J856-S0-CW-8019 REV. : B																					

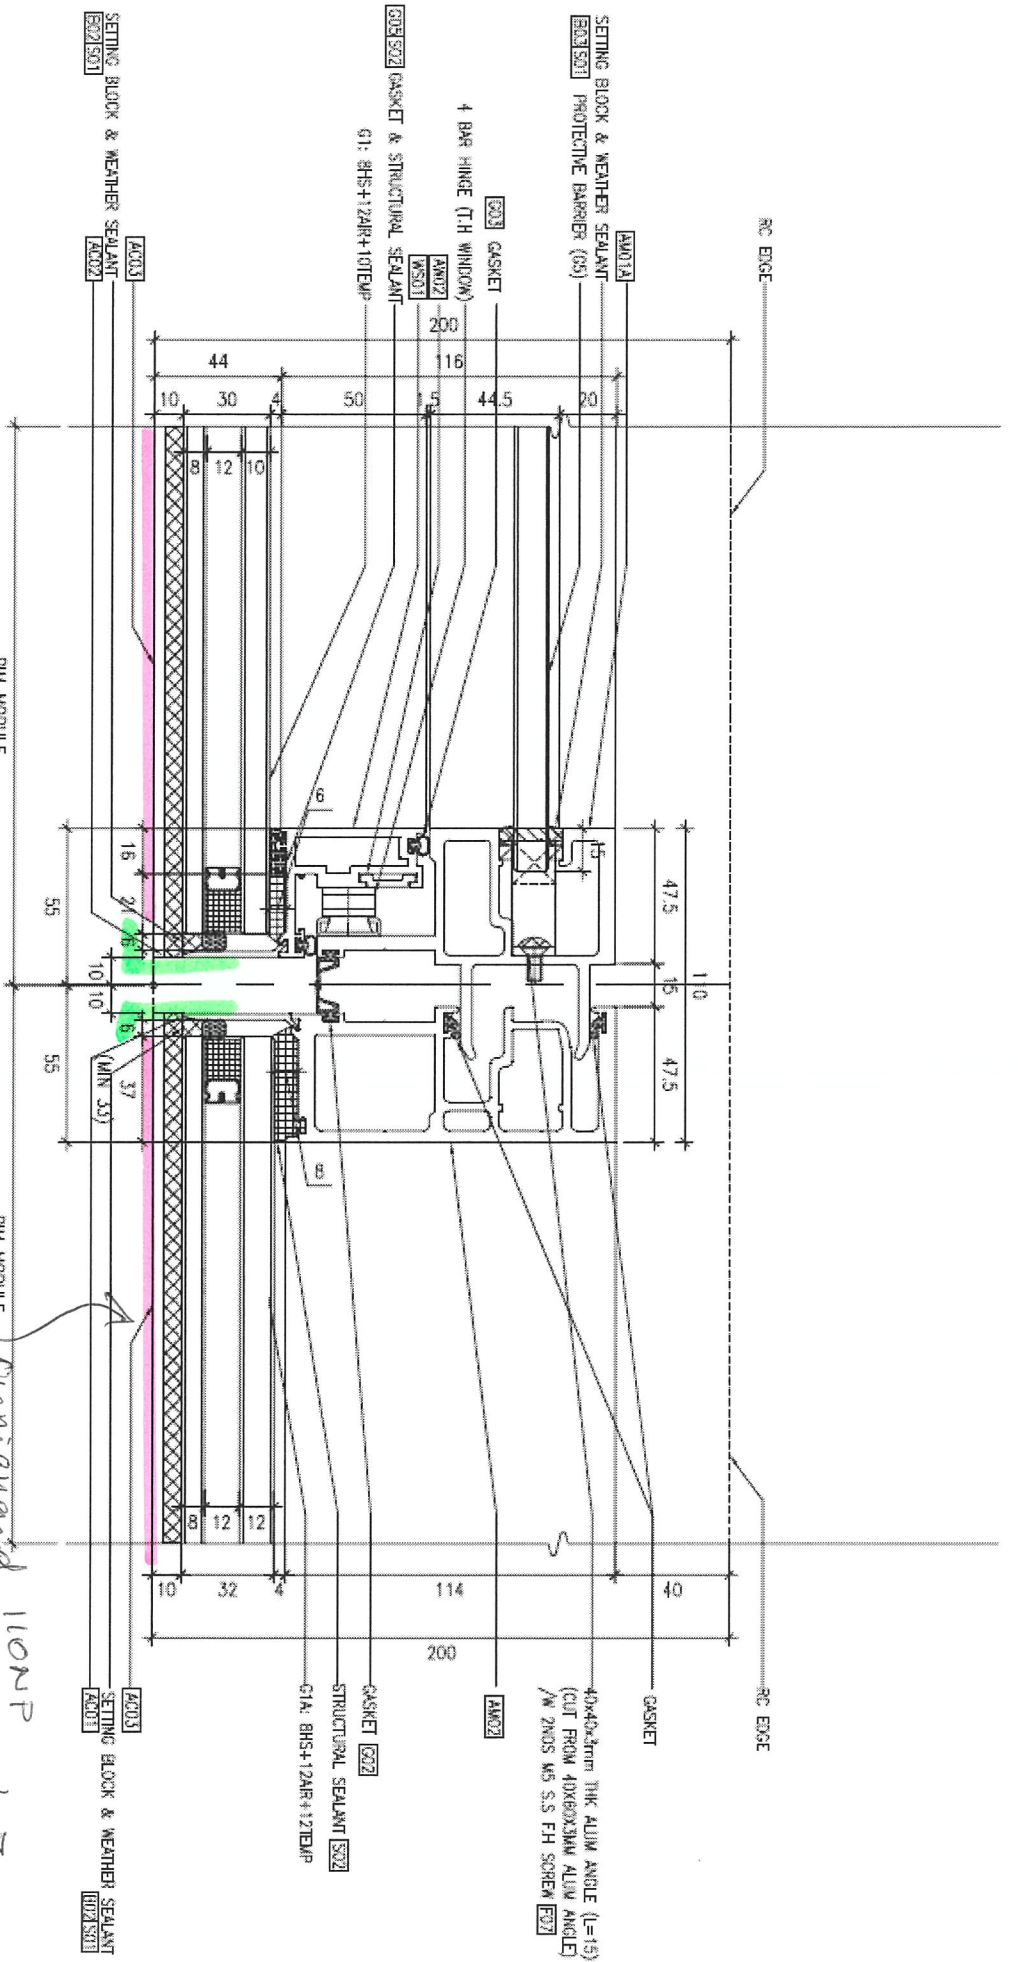

OUTSIDE

白色保護膠紙
 Diminished 110NP
 玻璃保護膠紙塗層

3 TYPICAL DETAIL OF CURTAIN WALL
 3005 FOR (G1A)