

工程指示 / 要求簡箋 ENGINEER INSTRUCTIONS(E.I.)

工程指示編號:	EI- 5449 B	修改版本:	B
	HK- 1130		
工程編號:	J 856	工程名稱:	天榮站
收件人:	生統/ 王良/ 林仁安	發件人:	Jingo
工程項目:	CW幕牆補充室外玻璃保護膜塗層方案	日期:	19/05/2023

<input checked="" type="checkbox"/> 原合約工程包	<input type="checkbox"/> 原合約工程加 / 減賬 QT-	<input type="checkbox"/> 新工程報價 QT-
--	--	------------------------------------

信件批核號碼/圖紙參考編號:	批核模具圖紙編號:
客戶指示附件:	管理內部批簽署:

<input type="checkbox"/> 初步鋁料 B.M.	<input type="checkbox"/> 加工拆圖, 然後生產	<input type="checkbox"/> 尺寸表
<input type="checkbox"/> 正式鋁料 B.M.	<input type="checkbox"/> 技術上資料/指示	<input type="checkbox"/> 報價
<input type="checkbox"/> 配件 B.M.	<input type="checkbox"/> 樣辦或貨品說明書	<input type="checkbox"/> 分判合約
<input type="checkbox"/> 其他:		

內容:
請按附件提供保護: CW幕牆補充室外玻璃保護膜塗層 - Omiguard 110NP

完成上列要求日期: 22/05/2023


國內

<input type="checkbox"/> 生產技術總監	<input type="checkbox"/> 連附件	<input checked="" type="checkbox"/> 技術部	<input checked="" type="checkbox"/> 連附件	<input type="checkbox"/> 生產部	<input type="checkbox"/> 連附件
<input type="checkbox"/> 採購部	<input type="checkbox"/> 連附件	<input checked="" type="checkbox"/> 生產統籌部	<input checked="" type="checkbox"/> 連附件	<input type="checkbox"/> 報關組	<input type="checkbox"/> 連附件
<input checked="" type="checkbox"/> 質檢部	<input checked="" type="checkbox"/> 連附件	<input type="checkbox"/> 會計部	<input type="checkbox"/> 連附件	<input type="checkbox"/> 機械設計部	<input type="checkbox"/> 連附件
<input type="checkbox"/> 香港辦	<input type="checkbox"/> 連附件	<input type="checkbox"/> 其他:			


香港

<input type="checkbox"/> 行政部	<input type="checkbox"/> 連附件	<input type="checkbox"/> 會計部	<input type="checkbox"/> 連附件	<input type="checkbox"/> 統籌部	<input type="checkbox"/> 連附件	<input type="checkbox"/> 工程部	<input type="checkbox"/> 連附件
<input type="checkbox"/> 採購部	<input type="checkbox"/> 連附件	<input type="checkbox"/> QS部	<input type="checkbox"/> 連附件	<input type="checkbox"/> 地盤管理	<input type="checkbox"/> 連附件	<input type="checkbox"/> 維修部	<input type="checkbox"/> 連附件

*發件人簽署: Jingo	*組別成員批核簽署:
傳遞編號:	項目經理簽署:

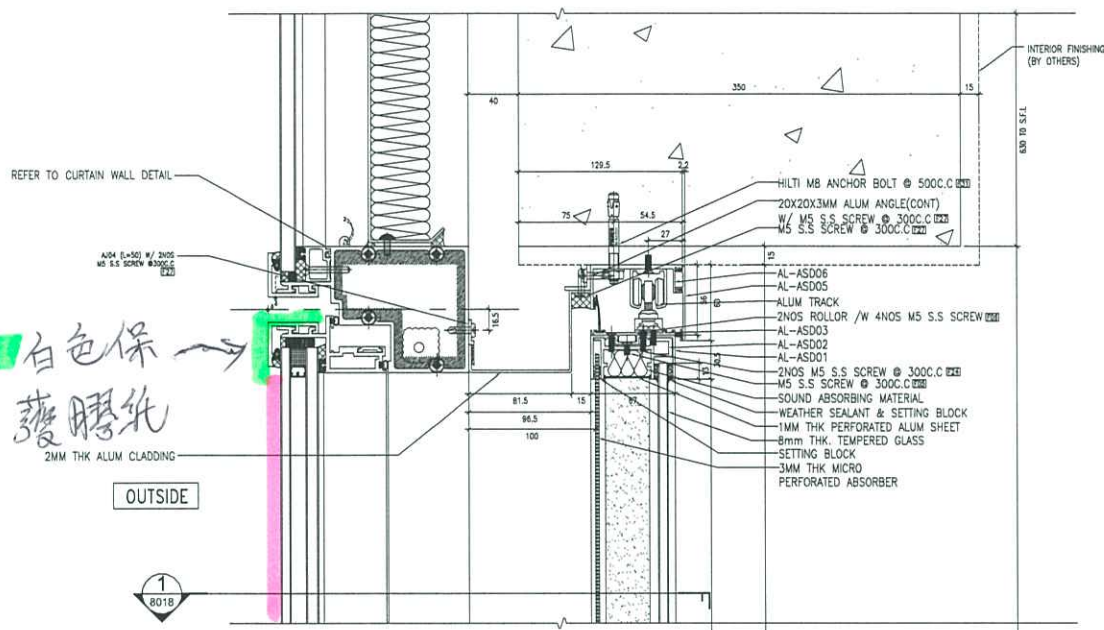

白色保
護膠紙
2MM THK ALUM CLADDING

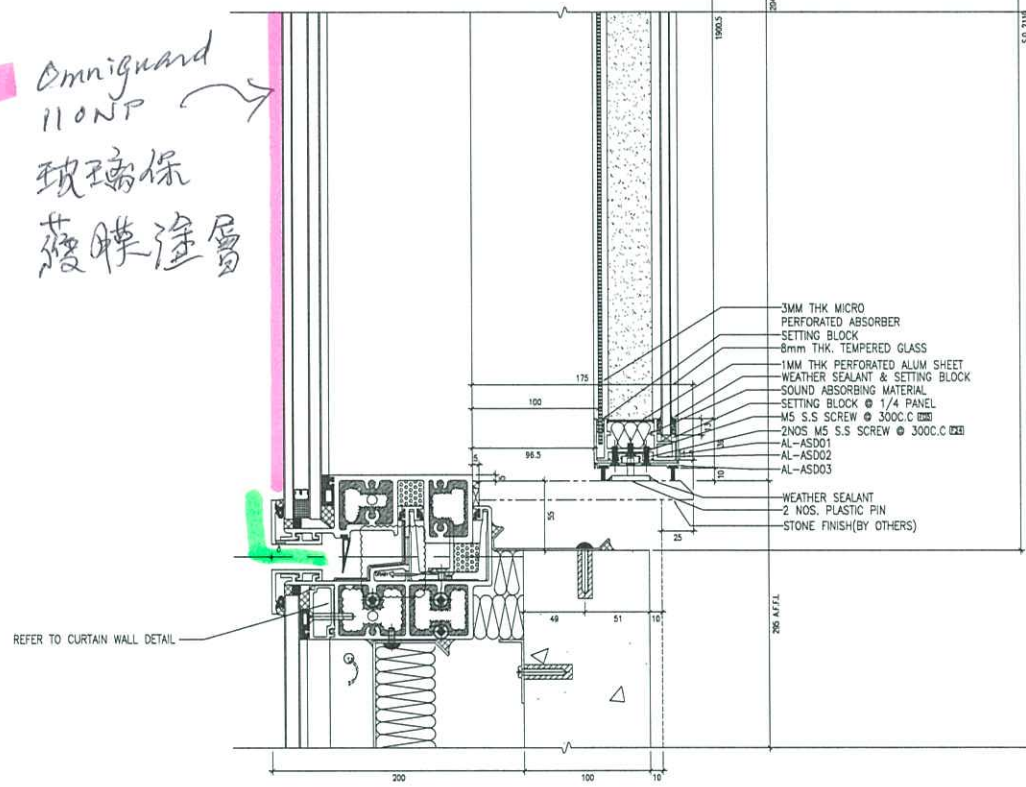

OmniGuard
110NP
玻璃保
護膜塗層

B.D. REF. :

CLIENT : SUN HUNG KAI REAL ESTATE AGENCY LTD. 42/F, SUN HUNG KAI CENTRAL, WINGLOK, HONGKONG

ARCHITECT : Iw&partners ARCHITECTS

MAIN CONTRACTOR : 恆達建築有限公司 Yee Fai Building Contractors Ltd.

STRUCTURAL ENGINEER :

FAHOD CONSULTANT: ARUP ALPHA CONSULTING LIMITED Steel Structures & Bridge Specialists

NOTE :
1. ALL DIMENSIONS ARE IN MM.
2. ALL ELEVATIONS ARE VIEWED FROM OUTSIDE.
3. ALL DIMENSIONS TO BE VERIFIED ON SITE BEFORE FABRICATION.

LEGEND :
A1 - DETAIL MARK NO.
A2 - CENTER SHEET NO.

1. F.F.L. - FINISHED FLOOR LEVEL
2. S.F.L. - STRUCTURAL FLOOR LEVEL
3. R.F.L. - REVERSED DETAIL

NO.	DATE	BY	CHKD	REVISION
1	27-10-2023	YHS	YHS	ISSUED FOR PERMIT
2	27-10-2023	YHS	YHS	REVISED

JOB NO. : J-956

PROJECT : PROPOSED DEVELOPMENT ABOVE LIGHT RAIL TIN WING STOP-15M/TL NO.23, AREA 3.31N SHUI WAH, N.T.

TITLE : TYPICAL DETAIL FOR CURTAIN WALL

DATE : 31-OCT-22 SCALE : 1:4

DRAWN BY : C.F. CHECKED BY :

UNIT: 8/F, SUNG HING INDUSTRIAL CENTRE, 1/F, 610 Chee Koo Ling Road, Kowloon, HONGKONG

REV. : B

