



工程指示 / 要求簡箋 ENGINEER INSTRUCTIONS(E.I.)

工程指示編號:	EI- 6149A	修改版本:	A
	HK- 1213		
工程編號:	J 856	工程名稱:	TSWTL23 天榮
收件人:	生統/林仁安	發件人:	Thomas Wong
工程項目:	CW地盤用鋁板生產單-MO1(修改A)	日期:	30/05/2023

<input checked="" type="checkbox"/> 原合約工程包	<input type="checkbox"/> 原合約工程加 / 減賬 QT-	<input type="checkbox"/> 新工程報價 QT-
--	--	------------------------------------

信件批核號碼/圖紙參考編號:	批核模具圖紙編號:
客戶指示附件:	管理內部批簽署:

<input type="checkbox"/> 初步鋁料 B.M.	<input type="checkbox"/> 加工拆圖, 然後生產	<input type="checkbox"/> 尺寸表
<input type="checkbox"/> 正式鋁料 B.M.	<input type="checkbox"/> 技術上資料/指示	<input type="checkbox"/> 報價
<input type="checkbox"/> 配件 B.M.	<input type="checkbox"/> 樣辦或貨品說明書	<input type="checkbox"/> 分判合約
<input type="checkbox"/> 其他:		

內容: CW地盤用鋁板生產單-MO1(修改A:EI6149因需要再修改 要等待確認才可出) 因顧問資料
完成上列要求日期: 1-6-2023

國內


<input type="checkbox"/> 生產技術總監	<input type="checkbox"/> 連附件	<input type="checkbox"/> 技術部	<input type="checkbox"/> 連附件	<input type="checkbox"/> 生產部	<input type="checkbox"/> 連附件
<input type="checkbox"/> 採購部	<input type="checkbox"/> 連附件	<input checked="" type="checkbox"/> 生產統籌部	<input checked="" type="checkbox"/> 連附件	<input type="checkbox"/> 報關組	<input type="checkbox"/> 連附件
<input type="checkbox"/> 質檢部	<input type="checkbox"/> 連附件	<input type="checkbox"/> 會計部	<input type="checkbox"/> 連附件	<input type="checkbox"/> 機械設計部	<input type="checkbox"/> 連附件
<input type="checkbox"/> 香港辦	<input type="checkbox"/> 連附件	<input type="checkbox"/> 其他:			

香港

<input type="checkbox"/> 行政部	<input type="checkbox"/> 連附件	<input type="checkbox"/> 會計部	<input type="checkbox"/> 連附件	<input type="checkbox"/> 統籌部	<input type="checkbox"/> 連附件	<input type="checkbox"/> 工程部	<input type="checkbox"/> 連附件
<input type="checkbox"/> 採購部	<input type="checkbox"/> 連附件	<input type="checkbox"/> QS部	<input type="checkbox"/> 連附件	<input type="checkbox"/> 地盤管理	<input type="checkbox"/> 連附件	<input type="checkbox"/> 維修部	<input type="checkbox"/> 連附件

*發件人簽署: 肆	*組別成員批核簽署:
傳遞編號:	項目經理簽署:

因應顧問意見，需修改鋁片尺寸，請待確認才加工鋁巴鑽孔

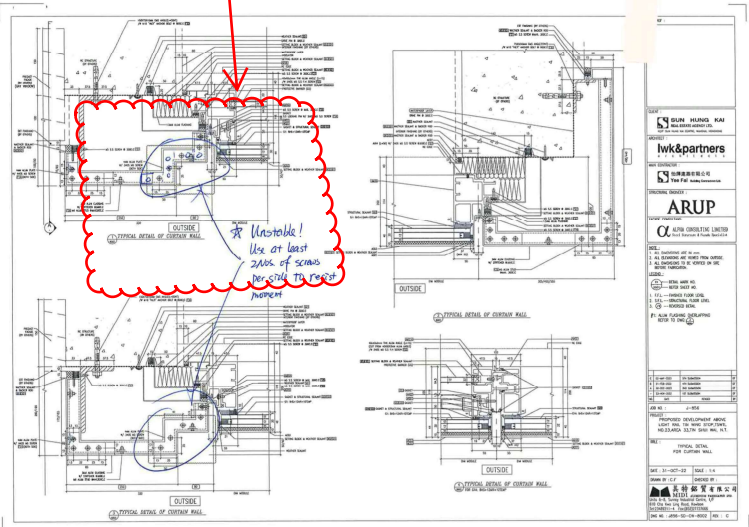

PROJECT : Property Development at LRT Tin Wing Stop at Tin Shui Wai on Lot No. TSWTL23  
 Document Ref.: TSWTL23/SDS-0388D RECEIVED

We submit herewith the following General Submission to **LWK & Partners (HK) Ltd.**  
 Attn: Ms. Carmen Wong / Mr. Ken Law / Mr. Jason Ho  
 Mr. Ryan Chan  
 for  approval /  information /  Others, please specify : \_\_\_\_\_

Sub-contractor: **Midi Aluminium Fabricator Ltd.**  
 Re-submission /  
 Supplementary

SUBJECT: 5<sup>th</sup> Shop Drawings Submission for Curtain Wall(Alum. Cladding) at Tower 1-3  
 Including :  Structural Calculation

We would like to submit herewith the following drawings for your comment and approval.

Drawing No.	Title	Revision
1. J856-SD-CW-1001	General note for curtain wall	Rev. C
2. J856-SD-CW-3001 to 3009	Layout plan of curtain wall at 3/F - 49/F for Tower 1 to Tower 3	Rev. B
3. J856-SD-CW-4001 to 4011	Part elevation, plan and section for curtain wall at Tower 1 to Tower 3	Rev. D
4. J856-SD-CW-8002, 802A, 8003, 8006, 8007, 8008, 8008A, 8010, 8011, 8020, 8020A, 8020B, 8023, 8024, 8025, 8027-8039	Typical detail for curtain wall at tower Tower 3 4001-4005, 8001, 8002, 8003, 8004, 8005, 8006, 8007, 8008, 8008A, 8010, 8011, 8020, 8020A, 8020B, 8023, 8024, 8025, 8027-8039	Rev. B

This submission is attached with the following:  
 Structural Calculation

Remarks:  
 Your prompt reply before 30 May 2023 would be much appreciated. Thank you for your attention.

c.c. (By Email)		via	via	Authorized Representative
Best Vision Development Ltd	Mr. Robert Seng / Mr. Jonathan Chan / Ms. Patricia Cheung	<input checked="" type="checkbox"/>	<input type="checkbox"/>	 <b>Ben Cheng (PM)</b> (Name in Block Letter) 17 MAY 2023 Submission Date
Sun Hung Kai Architects and Engineers (ST)	Mr. C. K. Lau / Mr. Kevin Lam	<input type="checkbox"/>	<input type="checkbox"/>	
Sun Hung Kai Architects and Engineers (ME)	Mr. K. L. Chan / Mr. Michael Chan	<input type="checkbox"/>	<input type="checkbox"/>	
Ove Arup & Partners Hong Kong Ltd	Mr. Michael Ku / Mr. James Wong	<input type="checkbox"/>	<input type="checkbox"/>	
Ove Arup & Partners Hong Kong Ltd (RP)	Mr. Kent Wong / Ms. Jenny Leung	<input type="checkbox"/>	<input type="checkbox"/>	
Ove Arup & Partners Hong Kong Ltd (RE)	Mr. Dixon Wong / Mr. Tommy Ng / Mr. Samson Ho / Mr. Tim Chau / Mr. Leo So	<input type="checkbox"/>	<input type="checkbox"/>	
Alpha Consulting Ltd	Mr. Dominic Yu / Mr. Z. H. Lau	<input type="checkbox"/>	<input type="checkbox"/>	
MTR Property	Mr. Dick Yang / Mr. Alvin Chan / Mr. Andrew Tai / Mr. Gary Chan / Mr. Sam Lee / Mr. Tony Chan / Mr. Tommy Chan	<input type="checkbox"/>	<input type="checkbox"/>	
Facade Manager (Sanfield)	Mr. Lai Yuen Wang	<input type="checkbox"/>	<input type="checkbox"/>	
Facade Manager (SHK Purchasing)	Mr. Teddy Chan	<input type="checkbox"/>	<input type="checkbox"/>	


REPLY BY  LWKP /  ARUP /  SHKAE /  ANONYMOUS /  ALPHA /   
 REPLY  Approved /  Approved with comments (A) /  Reviewed as Commented (Resubmission Required) (B)  
*General comments with star*

c.c.		via	via	Authorized Representative
Best Vision Development Ltd	Mr. Robert Seng / Mr. Jonathan Chan / Mr. Robert Lam / Mr. Nick Cheng / Ms. Patricia Cheung	<input checked="" type="checkbox"/>	<input type="checkbox"/>	 (Name in Block Letter) 29 MAY 2023 Reply Date
Sun Hung Kai Architects and Engineers (ST)	Mr. C. K. Lau / Mr. Kevin Lam	<input type="checkbox"/>	<input type="checkbox"/>	
Sun Hung Kai Architects and Engineers (ME)	Mr. K. L. Chan / Mr. Michael Chan	<input type="checkbox"/>	<input type="checkbox"/>	
Ove Arup & Partners Hong Kong Ltd	Mr. Michael Ku / Mr. James Wong	<input type="checkbox"/>	<input type="checkbox"/>	
Ove Arup & Partners Hong Kong Ltd (RP)	Mr. Kent Wong / Ms. Jenny Leung	<input type="checkbox"/>	<input type="checkbox"/>	
Ove Arup & Partners Hong Kong Ltd (RE)	Mr. Dixon Wong / Mr. Tommy Ng / Mr. Samson Ho / Mr. Tim Chau / Mr. Leo So	<input type="checkbox"/>	<input type="checkbox"/>	
Alpha Consulting Ltd	Mr. Dominic Yu / Mr. Z. H. Lau	<input type="checkbox"/>	<input type="checkbox"/>	
MTR Property	Mr. Dick Yang / Mr. Alvin Chan / Mr. Andrew Tai / Mr. Gary Chan / Mr. Sam Lee / Mr. Tony Chan / Mr. Tommy Chan	<input type="checkbox"/>	<input type="checkbox"/>	
Facade Manager (Sanfield)	Mr. Lai Yuen Wang	<input type="checkbox"/>	<input type="checkbox"/>	
Facade Manager (SHK Purchasing)	Mr. Teddy Chan	<input type="checkbox"/>	<input type="checkbox"/>	



Also make hard copy to the following for their retention and information.  
 1.  IPD  OPM  ASA  ASE  PC  DME  QS  Safety Officer  Site Admin  Others: \_\_\_\_\_  
 HCK:  (\* please cross the box and delete any as appropriate)

 <b>美特鋁質有限公司</b> MIDI Aluminium Fabricator Ltd.			工程號 J856 地盘 天榮站	類別 制圖 李傳鵬 復核 練松文 批准 林仁安	物料號 MP1 圖號 J856-H4 數量 - 單件重量 - (KG)
修改 - 日期 -	採用工廠 材料颜色 UCT309119XLB-3 銀色	图纸名称 收口铝板 材料 3mm 铝板			

PE201-2 左边

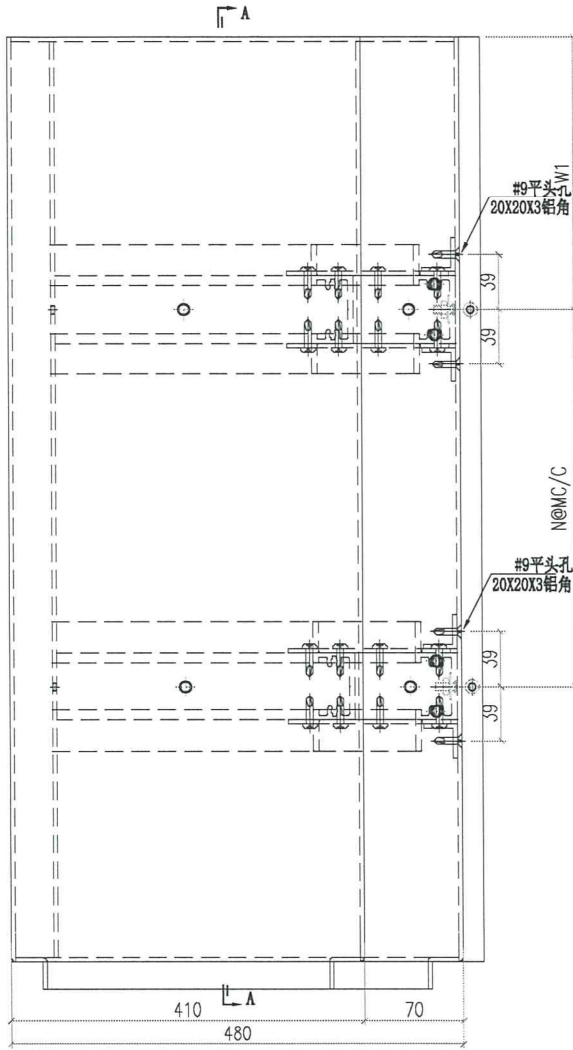

因應顧問意見, 需修改鋁片尺寸, 請待確認才加工鋁巴鑽孔

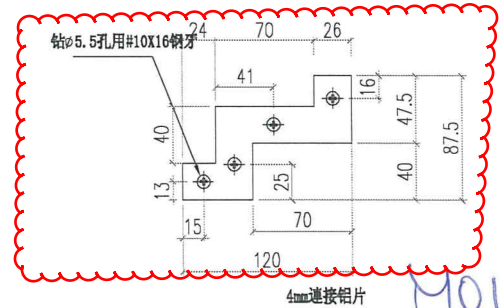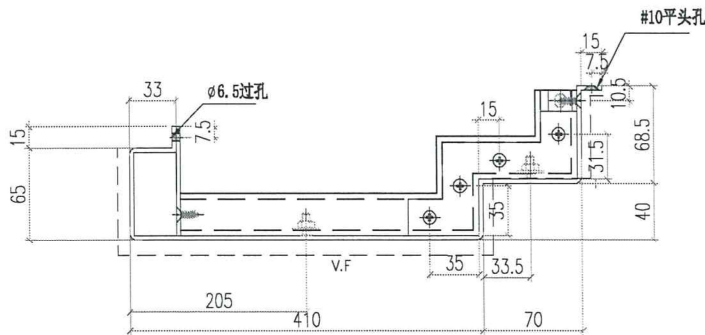

圖號	寬度 (W)	W1	N	M	數量	备注
856-H4-1	375	87.5	1	200	1	✓
856-H4-2	2045	122.5	6	300	37	14
856-H4-3	955	102.5	3	250	36	14
856-H4-4	2345	122.5	7	300	.1	✓
856-H4-5	985	117.5	3	250	1	✓
						38