

美特鋁質有限公司

MIDI ALUMINIUM FABRICATOR LTD.



工程指示 / 要求簡箋 ENGINEER INSTRUCTIONS(E.I.)

工程指示編號:	EI- 6153A	修改版本:	A
	HK- 1215.		
工程編號:	J 856	工程名稱:	TSWTL23 天榮
收件人:	生統/林仁安	發件人:	Thomas Wong
工程項目:	CW地盤用鋁板生產單-MO3 (T2-T3座) (修改A)	日期:	30/05/2023

<input checked="" type="checkbox"/> 原合約工程包	<input type="checkbox"/> 原合約工程加 / 減賬 QT-	<input type="checkbox"/> 新工程報價 QT-
--	--	------------------------------------

信件批核號碼/圖紙參考編號:	批核模具圖紙編號:
客戶指示附件:	管理內部批簽署:

<input type="checkbox"/> 初步鋁料 B.M.	<input type="checkbox"/> 加工拆圖, 然後生產	<input type="checkbox"/> 尺寸表
<input type="checkbox"/> 正式鋁料 B.M.	<input type="checkbox"/> 技術上資料/指示	<input type="checkbox"/> 報價
<input type="checkbox"/> 配件 B.M.	<input type="checkbox"/> 樣辦或貨品說明書	<input type="checkbox"/> 分判合約
<input type="checkbox"/> 其他:		

內容: CW地盤用鋁板生產單-MO3 (T2-T3座) (修改A:EI6153因需要再修改 要等待確認才可出)
 因顧問資料

完成上列要求日期: 01/06/2023

國內


<input type="checkbox"/> 生產技術總監	<input type="checkbox"/> 連附件	<input type="checkbox"/> 技術部	<input type="checkbox"/> 連附件	<input type="checkbox"/> 生產部	<input type="checkbox"/> 連附件
<input type="checkbox"/> 採購部	<input type="checkbox"/> 連附件	<input checked="" type="checkbox"/> 生產統籌部	<input checked="" type="checkbox"/> 連附件	<input type="checkbox"/> 報關組	<input type="checkbox"/> 連附件
<input type="checkbox"/> 質檢部	<input type="checkbox"/> 連附件	<input type="checkbox"/> 會計部	<input type="checkbox"/> 連附件	<input type="checkbox"/> 機械設計部	<input type="checkbox"/> 連附件
<input type="checkbox"/> 香港辦	<input type="checkbox"/> 連附件	<input type="checkbox"/> 其他:			

香港

<input type="checkbox"/> 行政部	<input type="checkbox"/> 連附件	<input type="checkbox"/> 會計部	<input type="checkbox"/> 連附件	<input type="checkbox"/> 統籌部	<input type="checkbox"/> 連附件	<input type="checkbox"/> 工程部	<input type="checkbox"/> 連附件
<input type="checkbox"/> 採購部	<input type="checkbox"/> 連附件	<input type="checkbox"/> QS部	<input type="checkbox"/> 連附件	<input type="checkbox"/> 地盤管理	<input type="checkbox"/> 連附件	<input type="checkbox"/> 維修部	<input type="checkbox"/> 連附件

*發件人簽署: 瑞	*組別成員批核簽署:
傳遞編號:	項目經理簽署: Joly

因應顧問意見，需修改鋁片尺寸，請待確認才加工鋁巴鑽孔

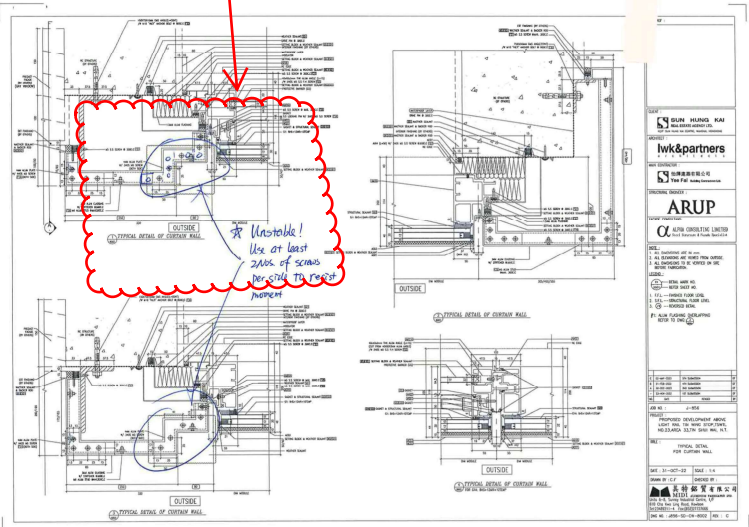

PROJECT : Property Development at LRT Tin Wing Stop at Tin Shui Wai on Lot No. TSWTL23
 Document Ref.: TSWTL23/SDS-0388D RECEIVED

We submit herewith the following General Submission to **LWK & Partners (HK) Ltd.**
 Attn: Ms. Carmen Wong / Mr. Ken Law / Mr. Jason Ho
 Mr. Ryan Chan
 for approval / information / Others, please specify : _____

Sub-contractor: **Midi Aluminium Fabricator Ltd.**
 Re-submission /
 Supplementary

SUBJECT: 5th Shop Drawings Submission for Curtain Wall(Alum. Cladding) at Tower 1-3
 Including : Structural Calculation

We would like to submit herewith the following drawings for your comment and approval.

Drawing No.	Title	Revision
1. J856-SD-CW-1001	General note for curtain wall	Rev. C
2. J856-SD-CW-3001 to 3009	General layout plan of curtain wall at 3/F - 49/F for Tower 1 to Tower 3	Rev. B
3. J856-SD-CW-4001 to 4011	Part elevation, plan and section for curtain wall at Tower 1 to Tower 3	Rev. D
4. J856-SD-CW-8002, 802A, 8003, 8006, 8007, 8008, 8008A, 8010, 8011, 8020, 8020A, 8020B, 8023, 8024, 8025, 8027-8039	Typical detail for curtain wall at tower	Rev. D

This submission is attached with the following:
 Structural Calculation

Remarks:
 Your prompt reply before 30 May 2023 would be much appreciated. Thank you for your attention.

c.c. (By Email)
 Best Vision Development Ltd
 Sun Hung Kai Architects and Engineers (ST)
 Sun Hung Kai Architects and Engineers (ME)
 Ove Arup & Partners Hong Kong Ltd
 Ove Arup & Partners Hong Kong Ltd (RP)
 Ove Arup & Partners Hong Kong Ltd (RE)
 Alpha Consulting Ltd
 MTR Property
 Façade Manager (Sanfield)
 Façade Manager (SHK Purchasing)
 Site Office
 Prepared by:

Mr. Robert Seng / Mr. Jonathan Chan / Mr. Robert Lam / Mr. Nick Cheng / Ms. Patricia Cheung
 Mr. C. K. Lau / Mr. Kevin Lam
 Mr. K. L. Chan / Mr. Michael Chan
 Mr. Michael Ku / Mr. James Wong
 Mr. Kent Wong / Ms. Jenny Leung
 Mr. Dixon Wong / Mr. Tommy Ng / Mr. Samson Ho / Mr. Tim Chau / Mr. Leo So
 Mr. Dominic Yu / Mr. Z. H. Lau
 Mr. Dick Yang / Mr. Alvin Chan / Mr. Andrew Tai / Mr. Gary Chan / Mr. Sam Lee / Mr. Tony Chan / Mr. Tommy Chan
 Mr. Lai Yuen Wang
 Mr. Teddy Chan

Authorized Representative
 Ben Cheng (PM)
 (Name in Block Letter)
 17 MAY 2023
 Submission Date

REPLY BY LWKP / ARUP / SHKAE / ANONYMOUS / ALPHA /
 REPLY Approved / Approved with comments (A) / Reviewed as Commented (Resubmission Required) (B)
 General Comments with Star


c.c. (By Email)
 Best Vision Development Ltd
 Sun Hung Kai Architects and Engineers (ST)
 Sun Hung Kai Architects and Engineers (ME)
 Ove Arup & Partners Hong Kong Ltd
 Ove Arup & Partners Hong Kong Ltd (RP)
 Ove Arup & Partners Hong Kong Ltd (RE)
 Alpha Consulting Ltd
 MTR Property
 Façade Manager (Sanfield)
 Façade Manager (SHK Purchasing)
 Site Office

Mr. Robert Seng / Mr. Jonathan Chan / Mr. Robert Lam / Mr. Nick Cheng / Ms. Patricia Cheung
 Mr. C. K. Lau / Mr. Kevin Lam
 Mr. K. L. Chan / Mr. Michael Chan
 Mr. Michael Ku / Mr. James Wong
 Mr. Kent Wong / Ms. Jenny Leung
 Mr. Dixon Wong / Mr. Tommy Ng / Mr. Samson Ho / Mr. Tim Chau / Mr. Leo So
 Mr. Dominic Yu / Mr. Z. H. Lau
 Mr. Dick Yang / Mr. Alvin Chan / Mr. Andrew Tai / Mr. Gary Chan / Mr. Sam Lee / Mr. Tony Chan / Mr. Tommy Chan
 Mr. Lai Yuen Wang
 Mr. Teddy Chan



Authorized Representative
 (Name in Block Letter)
 29 MAY 2023
 Reply Date

 美特鋁質有限公司 MIDI Aluminium Fabricator Ltd.			工程號 J856 地盘 天榮站	類別 制圖 李傳鵬 復核 練松文 批准 林仁安	物料號 MP1 圖號 J856-H4 數量 - 單件重量 - (KG)
修改 - 日期 -	採用工廠 材料颜色 UCT309119XLB-3 銀色	图纸名称 收口铝板 材料 3mm 铝板			

PE201-2 左边

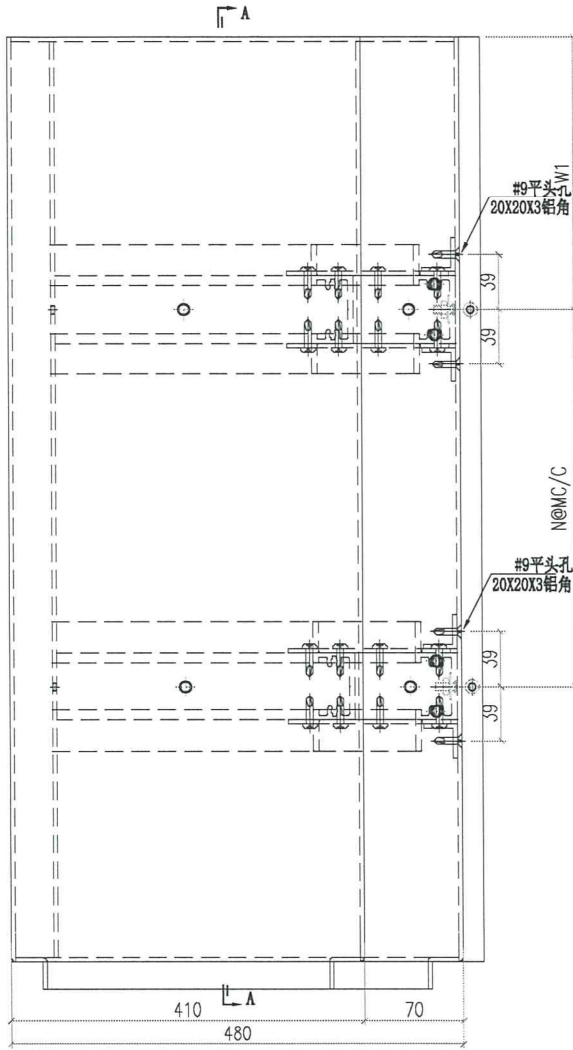

因應顧問意見, 需修改鋁片尺寸, 請待確認才加工鋁巴鑽孔

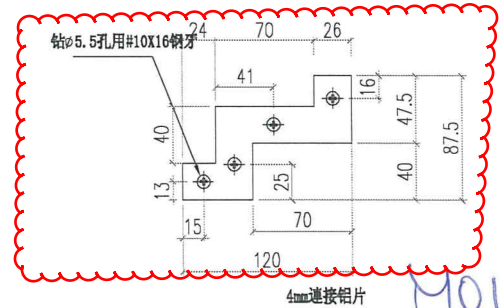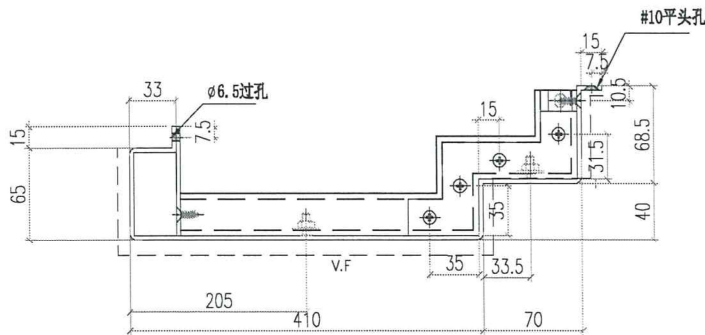

圖號	寬度 (W)	W1	N	M	數量	备注
856-H4-1	375	87.5	1	200	1	✓
856-H4-2	2045	122.5	6	300	37	14
856-H4-3	955	102.5	3	250	36	14
856-H4-4	2345	122.5	7	300	.1	✓
856-H4-5	985	117.5	3	250	1	✓