



工程指示 / 要求簡箋 ENGINEER INSTRUCTIONS(E.I.)

工程指示編號:	EI- 6449	修改版本:	A
	HK-1745		
工程編號:	J 856	工程名稱:	天榮站
收件人:	生統/ 王良 / 謝永林	發件人:	Jingo
工程項目:	46F 趟門AW302工廠展示樣板及試水測試用設計拆圖 (絲吉利亞)	日期:	08/08/2023

<input checked="" type="checkbox"/> 原合約工程包	<input type="checkbox"/> 原合約工程加 / 減賬 QT-	<input type="checkbox"/> 新工程報價 QT-
--	--	------------------------------------

信件批核號碼/圖紙參考編號:	批核模具圖紙編號:
客戶指示附件:	管理內部批簽署:

<input type="checkbox"/> 初步鋁料 B.M.	<input type="checkbox"/> 加工拆圖, 然後生產	<input type="checkbox"/> 尺寸表
<input type="checkbox"/> 正式鋁料 B.M.	<input type="checkbox"/> 技術上資料/指示	<input type="checkbox"/> 報價
<input type="checkbox"/> 配件 B.M.	<input type="checkbox"/> 樣辦或貨品說明書	<input type="checkbox"/> 分判合約
<input type="checkbox"/> 其他:		

內容:	應SHKP的要求, 趟門1幅於工廠展示樣板及作自行試水測試 註: 趟門完成展示及測試後需運往盤安裝大樓作貨用, 請提供加工圖
完成上列要求日期:	12/08/2023

國內

<input type="checkbox"/> 生產技術總監	<input type="checkbox"/> 連附件	<input checked="" type="checkbox"/> 技術部	<input checked="" type="checkbox"/> 連附件	<input type="checkbox"/> 生產部	<input type="checkbox"/> 連附件
<input type="checkbox"/> 採購部	<input type="checkbox"/> 連附件	<input checked="" type="checkbox"/> 生產統籌部	<input checked="" type="checkbox"/> 連附件	<input type="checkbox"/> 報關組	<input type="checkbox"/> 連附件
<input checked="" type="checkbox"/> 質檢部	<input checked="" type="checkbox"/> 連附件	<input type="checkbox"/> 會計部	<input type="checkbox"/> 連附件	<input type="checkbox"/> 機械設計部	<input type="checkbox"/> 連附件
<input type="checkbox"/> 香港辦	<input type="checkbox"/> 連附件	<input type="checkbox"/> 其他:			

香港

<input type="checkbox"/> 行政部	<input type="checkbox"/> 連附件	<input type="checkbox"/> 會計部	<input type="checkbox"/> 連附件	<input type="checkbox"/> 統籌部	<input type="checkbox"/> 連附件	<input type="checkbox"/> 工程部	<input type="checkbox"/> 連附件
<input type="checkbox"/> 採購部	<input type="checkbox"/> 連附件	<input type="checkbox"/> QS部	<input type="checkbox"/> 連附件	<input checked="" type="checkbox"/> 地盤管理	<input checked="" type="checkbox"/> 連附件	<input type="checkbox"/> 維修部	<input type="checkbox"/> 連附件

*發件人簽署: Jingo	*組別成員批核簽署:
傳遞編號:	項目經理簽署:

E.D. REF :

CLIENT :

SUN HUNG KAI  
REAL ESTATE AGENCY LTD.  
42/F SUN HUNG KAI CENTRE, MANDALAY, HONGKONG

ARCHITECT :

lwk&partners  
ARCHITECTS

MAIN CONTRACTOR :

怡輝建築有限公司  
Yee Fai Building Contractors Ltd.

STRUCTURAL ENGINEER :

ARUP

FACADE CONSULTANT:

ALPHA CONSULTING LIMITED  
Steel Structure & Façade Specialist

NOTE:  
1. ALL DIMENSIONS ARE IN mm.  
2. ALL ELEVATIONS ARE VIEWED FROM OUTSIDE.  
3. ALL DIMENSIONS TO BE VERIFIED ON SITE BEFORE FABRICATION.

LEGEND:

DETAIL MARK NO. REFER SHEET NO.

F.F.L. --- FINISHED FLOOR LEVEL

S.F.L. --- STRUCTURAL FLOOR LEVEL

--- REVERSED DETAIL

GLASS LEGEND

EQ-1 --- 8mmHS+12mm AIR GAP+10mmTP THK. I.G.U.

EQ-2 --- 10mm THK. CRYSTAL GRAY TEMPERED GLASS

EQ-4 --- 10mm THK. CRYSTAL TEMPERED AND ETCHED GLASS

EQ-1A --- 8mmHS+12mm AIR GAP+8mmTP THK. I.G.U.

B11/B81 --- FILING DETAIL (DWG. NO. F001)

B02-FRONT DETAIL (DWG. NO. F002)

GLAZING AREA

OPENABLE AREA

J-856

PROPOSED DEVELOPMENT ABOVE  
LIGHT RAIL TIN WING STOP-TS/WL  
NO.23,AREA 35,1IN SHUI WAI, N.T.

TITLE : WINDOW SCHEDULE FOR  
TOWER 3 IN-SITU WINDOW

DATE : 02-Aug-21

SCALE : 1:40

DRAWN BY : Ivan

CHECKED BY :

YIP TING YU

YIP TING YU


YIP TING YU

YIP TING YU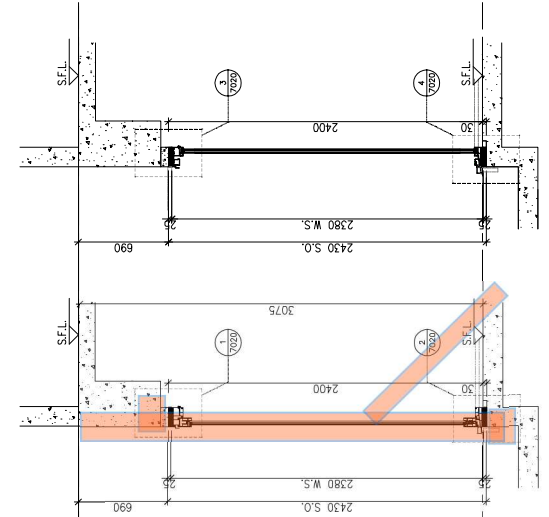

PART SECTION X


PART SECTION Y

樣板要求  
2 邊以鐵通作固定及  
配底掌

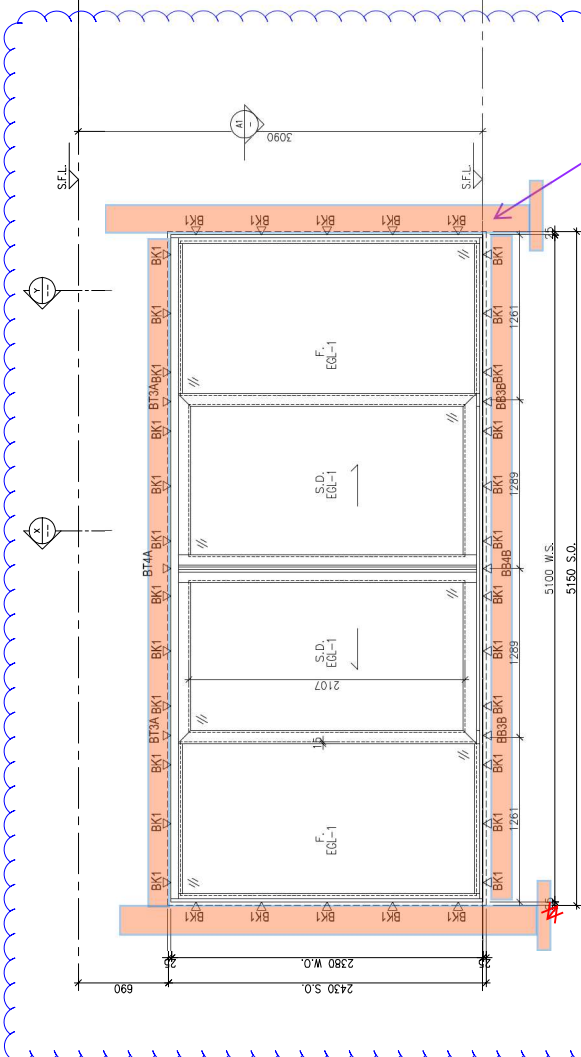


ELEVATION

ELEVATION

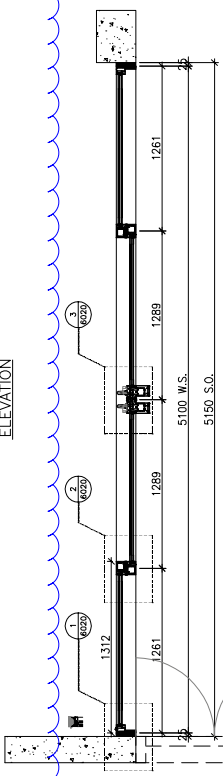

PART PLAN A1

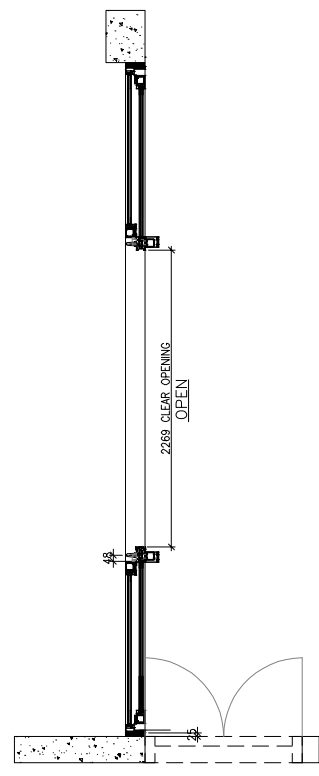

WINDOW MARK	AW 302
LOCATION	46/F UNIT SIMPLEX 1B LIV./DIN. AT TOWER 3
SECTION	70mm ALUM. SECTION
GLAZING	EGL-1A
QUANTITY	1 NO.
REMARKS	SIEMENIA SILDING DOOR SYSTEM

AW 302

46/F UNIT SIMPLEX 1B LIV./DIN. AT TOWER 3

70mm ALUM. SECTION

EGL-1A

1 NO.

SIEMENIA SILDING DOOR SYSTEM

AW 302

46/F UNIT SIMPLEX 1B LIV./DIN. AT TOWER 3

70mm ALUM. SECTION

EGL-1A

1 NO.

SIEMENIA SILDING DOOR SYSTEM

AW 302

46/F UNIT SIMPLEX 1B LIV./DIN. AT TOWER 3

70mm ALUM. SECTION

EGL-1A

1 NO.

SIEMENIA SILDING DO

E.D. REF :

CLIENT :

SUN HUNG KAI  
REAL ESTATE AGENCY LTD.  
42/F SUN HUNG KAI CENTRE, MANHANG, HONGKONG

ARCHITECT :

lwk&partners  
ARCHITECTS

MAIN CONTRACTOR :

怡輝建築有限公司  
Yee Fai Building Contractors Ltd.

STRUCTURAL ENGINEER :

ARUP

TRACER CONSULTANT:

ALPHA CONSULTING LIMITED  
Steel Structure & Façade Specialist

NOTE:  
1. ALL DIMENSIONS ARE IN mm.  
2. ALL ELEVATIONS ARE VIEWED FROM OUTSIDE.  
3. ALL DIMENSIONS TO BE VERIFIED ON SITE BEFORE FABRICATION.

LEGEND:

DETAIL MARK NO. REFER SHEET NO.  
1. F.F.L. --- FINISHED FLOOR LEVEL  
2. S.F.L. --- STRUCTURAL FLOOR LEVEL  
3. --- REVERSED DETAIL  
4. G.A.S. LEGEND

EQ-1---8mmx12mm AR GAP+10mmTP THK. I.G.U.  
EQ-1A---8mmx12mm AR GAP+8mmTP THK. I.G.U.  
EQ-2---10mm THK. CLEAR TEMPERED GLASS  
EQ-4---10mm THK. TEMPERED ACID ETCHED GLASS

NO. DATE DWE RESED BR

J-859

PROJECT : PROPOSED RESIDENTIAL / COMMERCIAL DEVELOPMENT AT NKIL NO.6951 KAI TAK AREA 4C, SITE 3 KAI TAK, KOWLOON






TITLE : TYPICAL DETAILS FOR IN-SITU WINDOW

DATE : 10-Nov-21 SCALE : 1:2

DRAWN BY : Ivan CHECKED BY :

YIP YIP YIP  
YIP YIP YIP  
Unit 6-8, Sunco Industrial Centre, 1/F  
610 Che Kwo Ling Road, Kowloon  
Tel:22489211-4 Fax:(852)2727666

ENG. NO. : JB56-SD-IW-6020 REV. : -

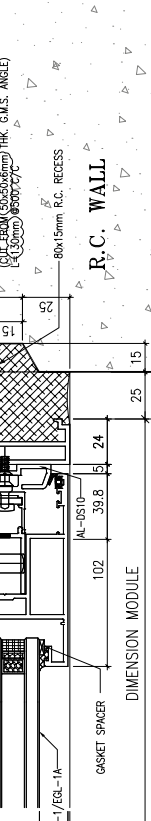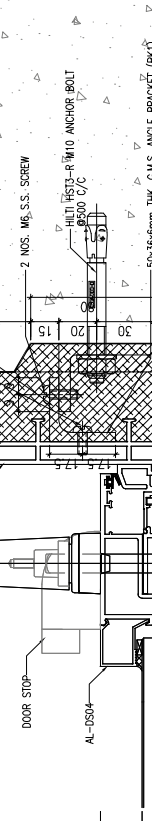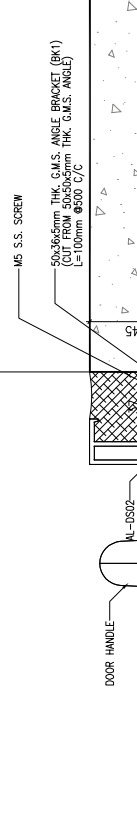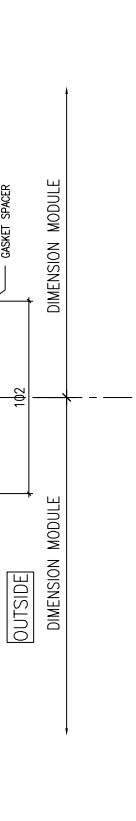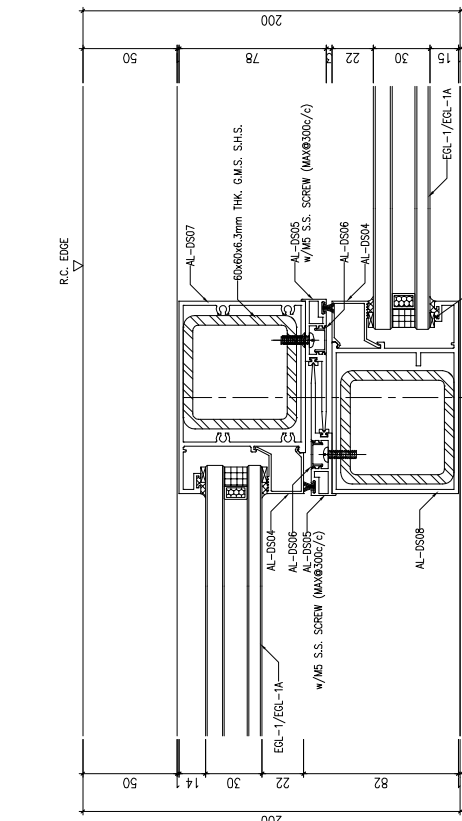

角碼焊接於通內

15mm (框邊至鐵通邊) 以膠收口

1 樣板-要求 4 邊以鐵通作固定及配底掌

3 HORIZONTAL DETAIL  
SCALE 1:2

E.D. REF :

CLIENT :

ARCHITECT :

MAIN CONTRACTOR :

STRUCTURAL ENGINEER :

FAÇADE CONSULTANT :

TRAFFIC CONSULTANT :

DATE :

DRAWN BY :

CHECKED BY :

TITLE :

SCALE :

PROJECT :

JOB NO. :

NO. :

DATE :

REVISION :

BY :

DATE :

REVISION :

BY :

DATE :

REVISION :

BY :

**SUN HUNG KAI**  
REAL ESTATE AGENCY LTD.  
42/F SUN HUNG KAI CENTRE, WING LOK, HONGKONG

**lwk&partners**  
ARCHITECTS

怡輝建築有限公司  
Yeep Fai Building Consultant Ltd.

**ARUP**  
STRUCTURAL ENGINEER

**ALPHA CONSULTING LIMITED**  
Steel Structure & Façade Specialist

NOTE :  
1. ALL DIMENSIONS ARE IN mm.  
2. ALL ELEVATIONS ARE VIEWED FROM OUTSIDE.  
3. ALL DIMENSIONS TO BE VERIFIED ON SITE BEFORE FABRICATION.

LEGEND :  
① DETAIL MARK NO.  
② REFER SHEET NO.

1. F.F.L. --- FINISHED FLOOR LEVEL  
2. S.F.L. --- STRUCTURAL FLOOR LEVEL  
3. --- RECESSED DETAIL  
4. GLASS LEGEND  
EGL-1 --- 6mmHS+12mm AIR GAP+10mmTP THK. I.G.U.  
EGL-1A --- 8mmHS+12mm AIR GAP+8mmTP THK. I.G.U.  
EGL-2 --- 10mm THK. CLEAR TEMPERED GLASS  
EGL-4 --- 10mm THK. TEMPERED ACID ETCHED GLASS

NO.	DATE	REVISION	BY
		J-859	





PROPOSED RESIDENTIAL / COMMERCIAL DEVELOPMENT AT NKIL NO.6551 KAI TAK AREA 4C, SITE 3 KAI TAK, KOWLOON

TYPICAL DETAILS FOR IN-SITU WINDOW



DATE : 10-Nov-21 SCALE : 1:2


DRAWN BY : Ivan  
CHECKED BY :  
M&T  
M&T  
M&T  
Units 6-8, Sunco Industrial Centre, 7/F, 610 Cha Kwo Ling Road, Kowloon  
Tel: 2489211-4 Fax: (852) 7727666

DWG NO. : JB56-SD-1W-7020 REV. : -

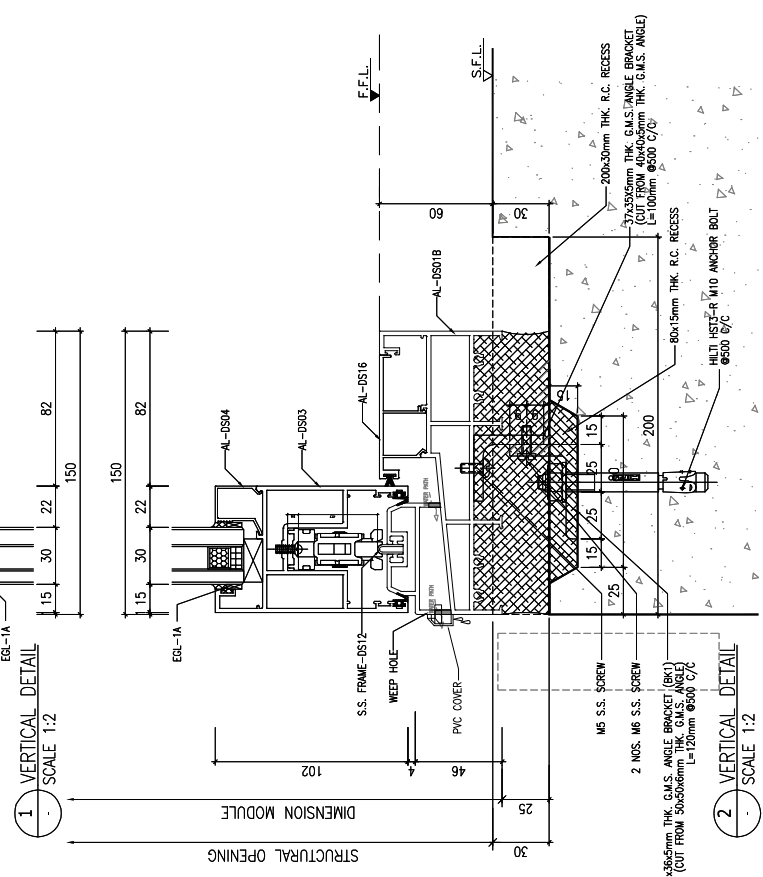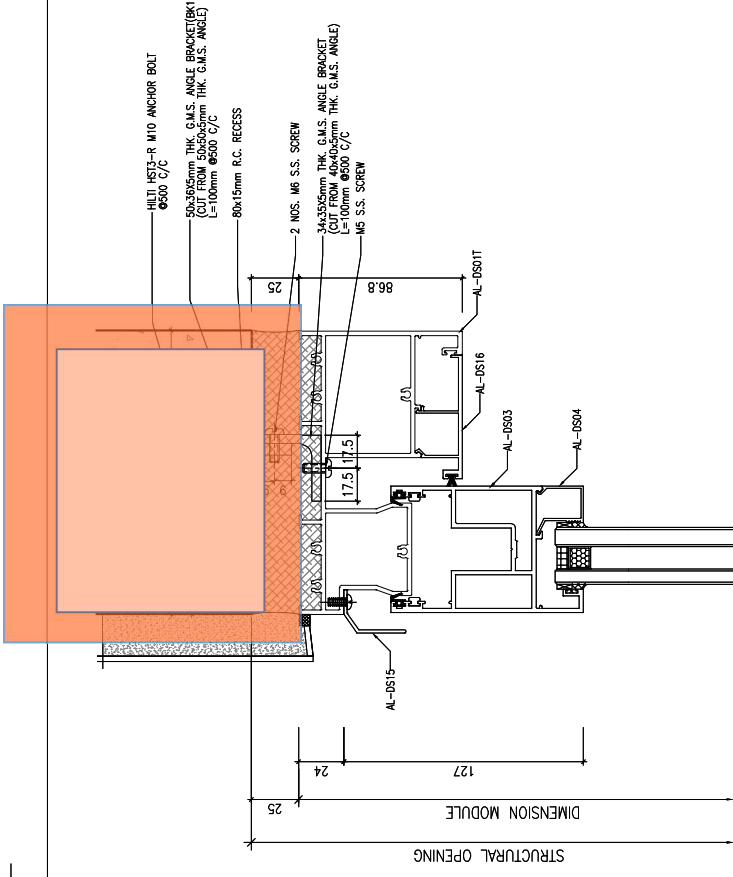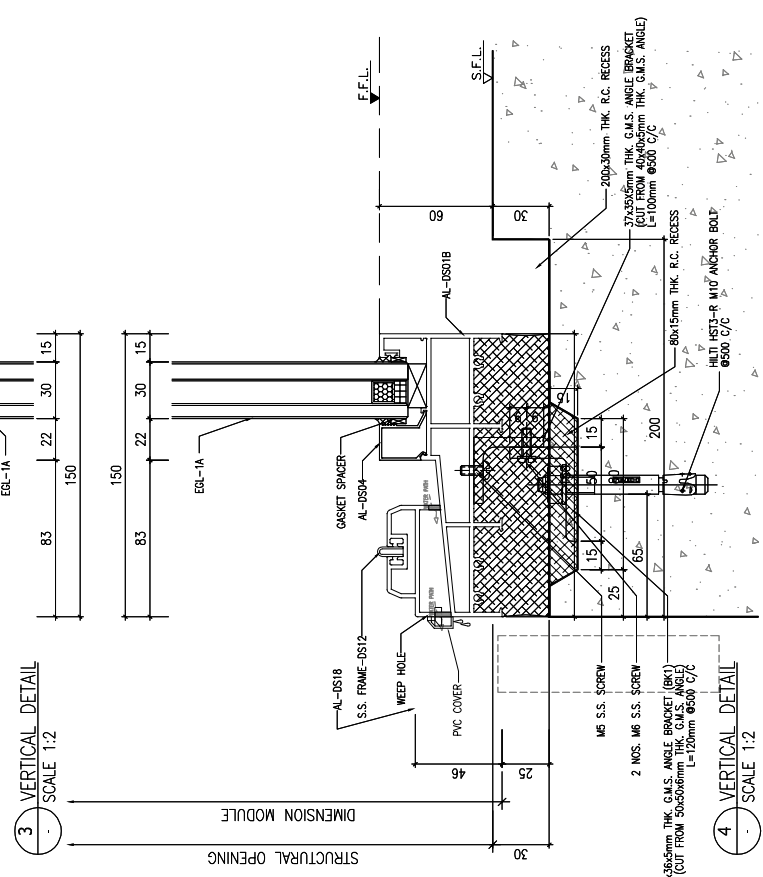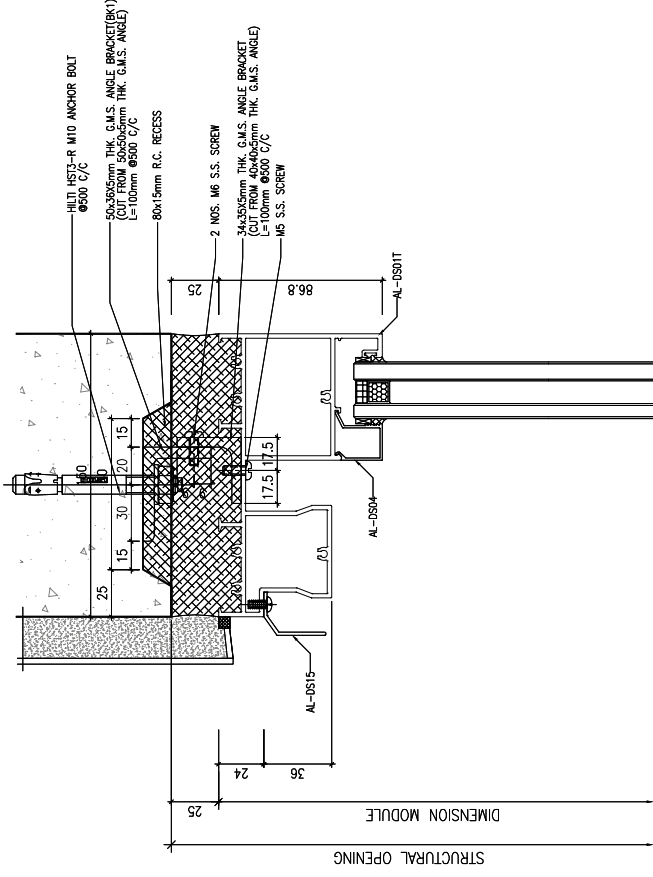


# 單趟 7020

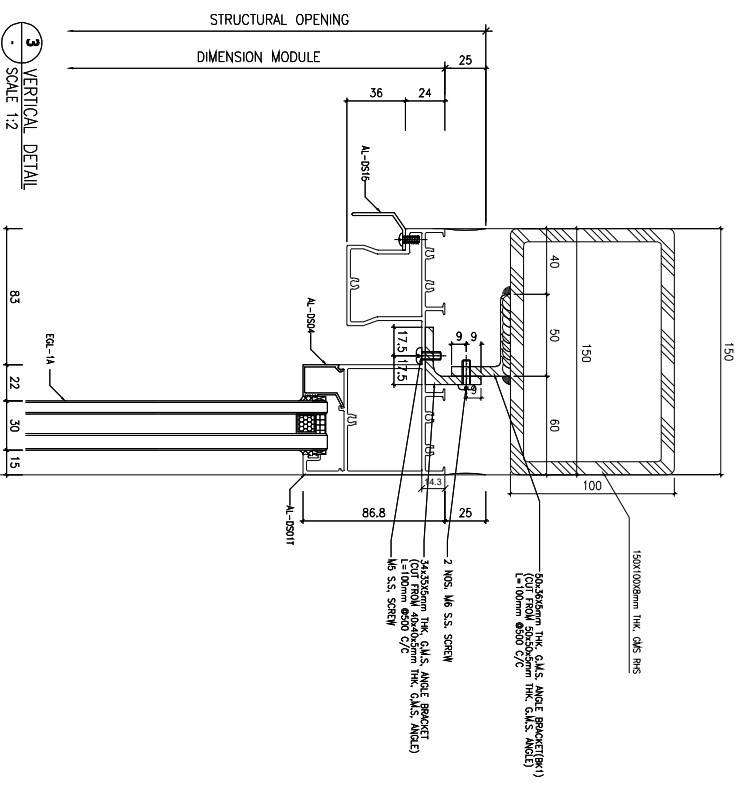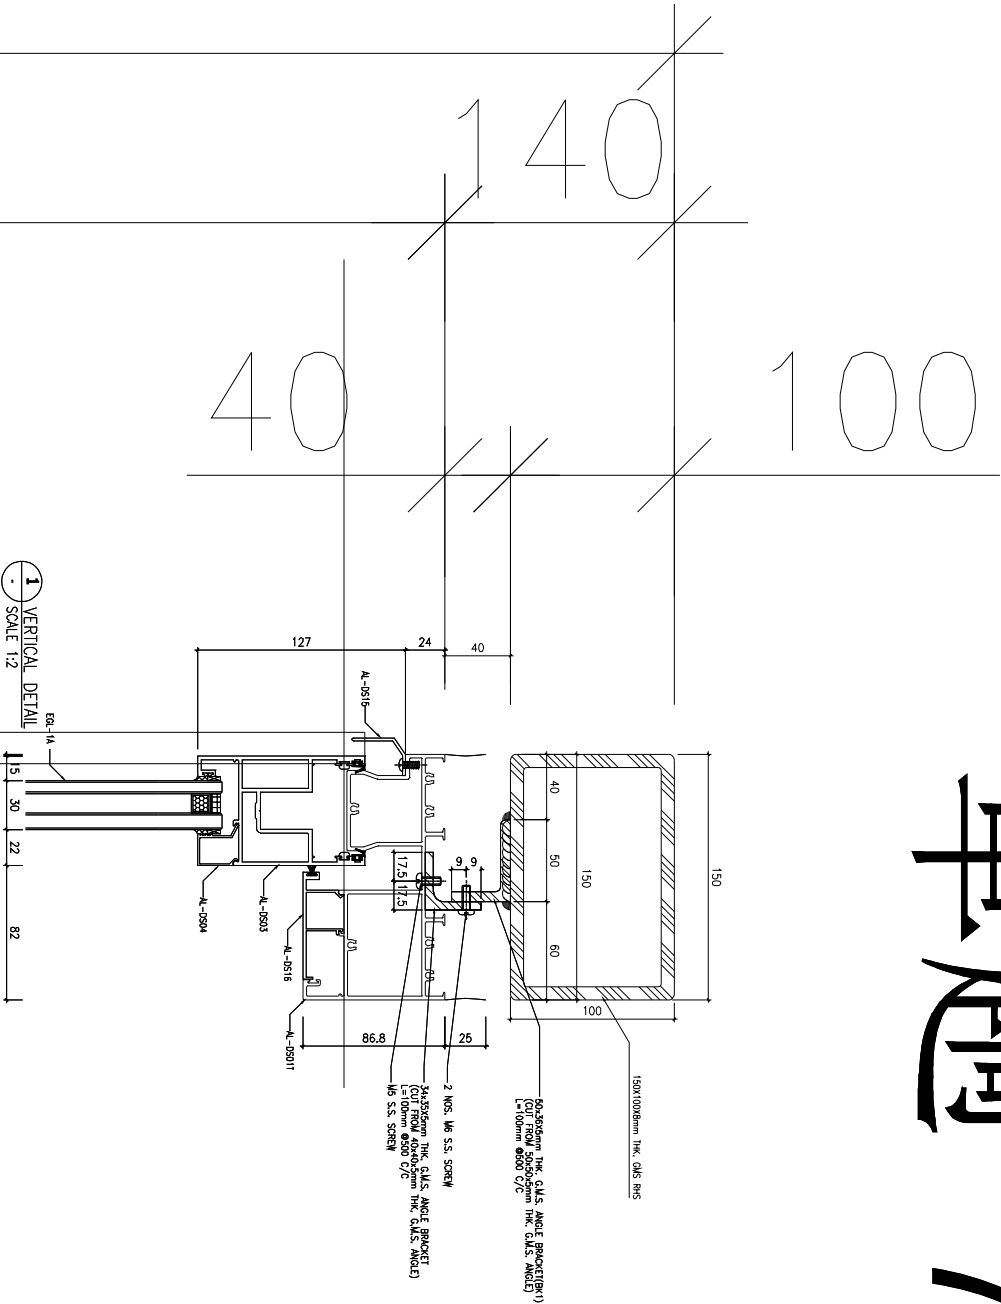

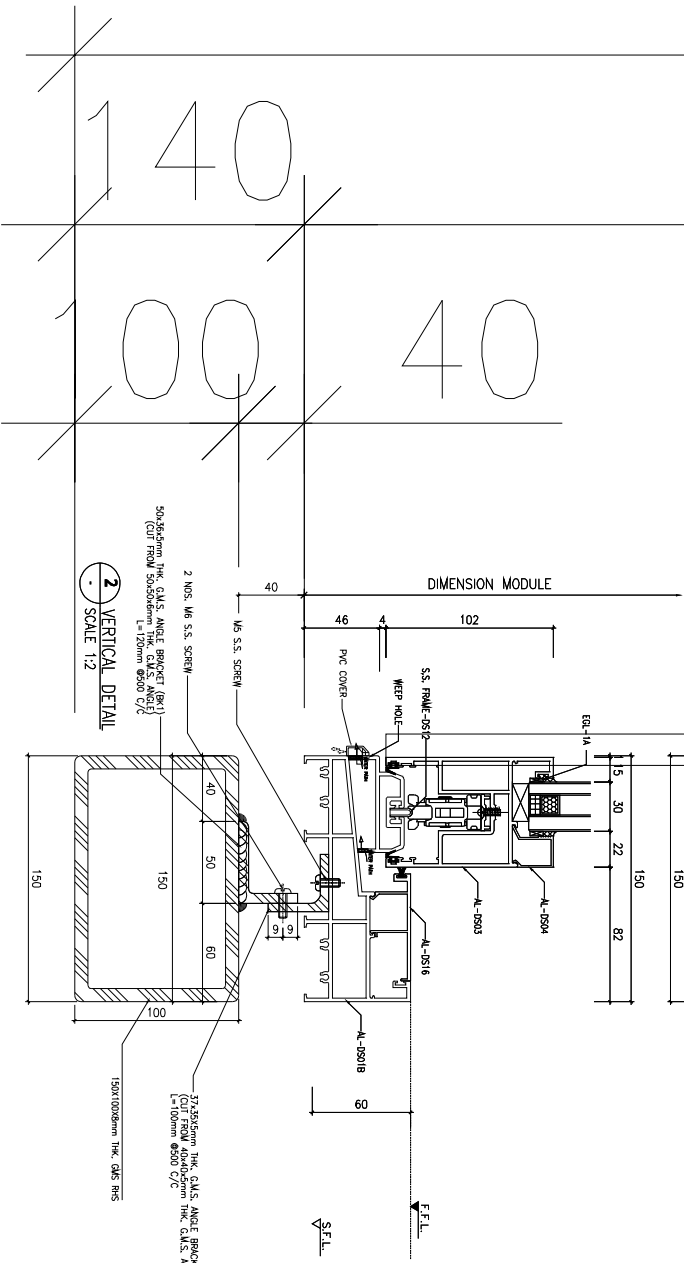

2 VERTICAL DETAIL  
SCALE 1:2

4 VERTICAL DETAIL  
SCALE 1:2

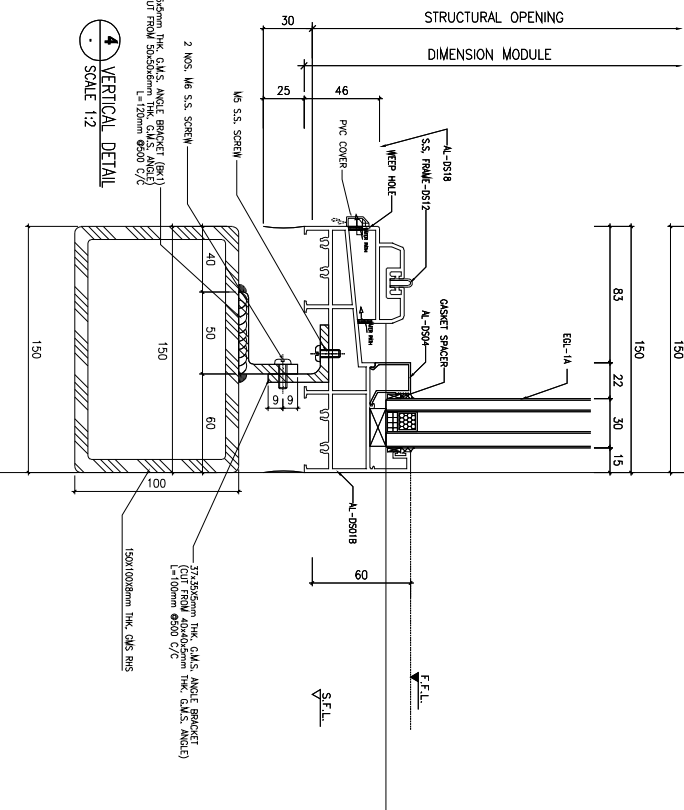

4 VERTICAL DETAIL  
SCALE 1:2

