



工程指示 / 要求簡箋 ENGINEER INSTRUCTIONS(E.I.)

|         |   |       |             |
|---------|---|-------|-------------|
| 工程指示編號: | EI- 6867A                               | 修改版本: | A           |
|         | HK-2400.                                |       |             |
| 工程編號:   | J 856                                   | 工程名稱: | TSWTL23 天榮  |
| 收件人:    | 生統/謝永林/Maggie姐                          | 發件人:  | Thomas Wong |
| 工程項目:   | 46F 廠用門窗 趙門大貨 鐵件(B.M表+圖則表+加工圖+位置圖)(修改A) | 日期:   | 25/10/2023  |

|  |  |                                    |
|--|--|------------------------------------|
| <input checked="" type="checkbox"/> 原合約工程包 | <input type="checkbox"/> 原合約工程加 / 減賬 QT- | <input type="checkbox"/> 新工程報價 QT- |
|--|--|------------------------------------|

|                |           |
|----------------|-----------|
| 信件批核號碼/圖紙參考編號: | 批核模具圖紙編號: |
| 客戶指示附件:        | 管理內部批簽署:  |

|                                    |                                     |                               |
|------------------------------------|-------------------------------------|-------------------------------|
| <input type="checkbox"/> 初步鋁料 B.M. | <input type="checkbox"/> 加工拆圖, 然後生產 | <input type="checkbox"/> 尺寸表  |
| <input type="checkbox"/> 正式鋁料 B.M. | <input type="checkbox"/> 技術上資料/指示   | <input type="checkbox"/> 報價   |
| <input type="checkbox"/> 配件 B.M.   | <input type="checkbox"/> 樣辦或貨品說明書   | <input type="checkbox"/> 分判合約 |
| <input type="checkbox"/> 其他:       |                                     |                               |

內容:  
熱浸鋅處理(需提供證書)  
而通知工程部驗焊日子,時間  
驗焊:Visual 100%, MPI 20%  
優先生產T3 ,T2-31/10 ,T1-2024年3月

完成上列要求日期: 31/10/2023

國內

|                                 |                              |   |   |                                |                              |
|---------------------------------|------------------------------|---|---|--------------------------------|------------------------------|
| <input type="checkbox"/> 生產技術總監 | <input type="checkbox"/> 連附件 | <input checked="" type="checkbox"/> 技術部     | <input checked="" type="checkbox"/> 連附件 | <input type="checkbox"/> 生產部   | <input type="checkbox"/> 連附件 |
| <input type="checkbox"/> 採購部    | <input type="checkbox"/> 連附件 | <input checked="" type="checkbox"/> 生產統籌部   | <input checked="" type="checkbox"/> 連附件 | <input type="checkbox"/> 報關組   | <input type="checkbox"/> 連附件 |
| <input type="checkbox"/> 質檢部    | <input type="checkbox"/> 連附件 | <input type="checkbox"/> 會計部                | <input type="checkbox"/> 連附件            | <input type="checkbox"/> 機械設計部 | <input type="checkbox"/> 連附件 |
| <input type="checkbox"/> 香港辦    | <input type="checkbox"/> 連附件 | <input checked="" type="checkbox"/> 其他: 謝永林 |   |                                |                              |

香港

|   |   |                              |                              |                               |                              |                              |                              |
|---|---|------------------------------|------------------------------|-------------------------------|------------------------------|------------------------------|------------------------------|
| <input type="checkbox"/> 行政部            | <input type="checkbox"/> 連附件            | <input type="checkbox"/> 會計部 | <input type="checkbox"/> 連附件 | <input type="checkbox"/> 統籌部  | <input type="checkbox"/> 連附件 | <input type="checkbox"/> 工程部 | <input type="checkbox"/> 連附件 |
| <input checked="" type="checkbox"/> 採購部 | <input checked="" type="checkbox"/> 連附件 | <input type="checkbox"/> QS部 | <input type="checkbox"/> 連附件 | <input type="checkbox"/> 地盤管理 | <input type="checkbox"/> 連附件 | <input type="checkbox"/> 維修部 | <input type="checkbox"/> 連附件 |

|         |  |            |  |
|---------|--|------------|--|
| *發件人簽署: |  | *組別成員批核簽署: |  |
| 傳遞編號:   |  | 項目經理簽署:    |  |

**圖則登記表**  
**DRAWING REGISTER**

| 圖則編號<br>Drg. No.           |         | 圖則名稱<br>Drawing Title |   | 年<br>月<br>日 | 接收日期 Receiving Date (適用於客戶圖則) |  |  |  |  |  |  |  |
|----------------------------|---------|-----------------------|---|-------------|-------------------------------|--|--|--|--|--|--|--|
| 工程名稱 Project Title: 天水圍天榮站 |         | 46F-后裝門窗鐵件拆圖 (廠用)     |   |             | 年                             |  |  |  |  |  |  |  |
| 工程編號 Project No: J-856     |         | 分發予 Distributed To    |   | 月           |                               |  |  |  |  |  |  |  |
|                            |         |                       |   | 日           |                               |  |  |  |  |  |  |  |
|                            |         |                       |   | 年           | 23                            |  |  |  |  |  |  |  |
|                            |         |                       |   | 月           | 10                            |  |  |  |  |  |  |  |
|                            |         |                       |   | 日           | 17                            |  |  |  |  |  |  |  |
|                            |         |                       |   | 1           | 修訂編號<br>Revision No.          |  |  |  |  |  |  |  |
|                            |         |                       |   |             | -                             |  |  |  |  |  |  |  |
| BK1-TT                     | 角鐵拆圖    | 2                     | - |             |                               |  |  |  |  |  |  |  |
| BK1-BB                     | 角鐵拆圖    | 3                     | - |             |                               |  |  |  |  |  |  |  |
| BK1-BB2                    | 角鐵拆圖    | 4                     | - |             |                               |  |  |  |  |  |  |  |
| BK1-QQ                     | 角鐵拆圖    | 5                     | - |             |                               |  |  |  |  |  |  |  |
| BK2-TT                     | 角鐵拆圖    | 6                     | - |             |                               |  |  |  |  |  |  |  |
| BK2-BB                     | 角鐵拆圖    | 7                     | - |             |                               |  |  |  |  |  |  |  |
| BK2-QQ                     | 角鐵拆圖    | 8                     | - |             |                               |  |  |  |  |  |  |  |
| BT3AA                      | 鐵件固定碼拆圖 | 9                     | - |             |                               |  |  |  |  |  |  |  |
| BB3BB                      | 鐵件固定碼拆圖 | 10                    | - |             |                               |  |  |  |  |  |  |  |
| BT4AA                      | 鐵件固定碼拆圖 | 11                    | - |             |                               |  |  |  |  |  |  |  |
| BB4BB                      | 鐵件固定碼拆圖 | 12                    | - |             |                               |  |  |  |  |  |  |  |
| BT5AA                      | 鐵件固定碼拆圖 | 13                    | - |             |                               |  |  |  |  |  |  |  |
| BB5BB                      | 鐵件固定碼拆圖 | 14                    | - |             |                               |  |  |  |  |  |  |  |
| BT3AA-L                    | 角鐵拆圖    | 15                    | - |             |                               |  |  |  |  |  |  |  |
| BT3AA-R                    | 角鐵拆圖    | 16                    | - |             |                               |  |  |  |  |  |  |  |
| SD-MG4-05                  | 鐵通加工圖   | 17                    | - |             |                               |  |  |  |  |  |  |  |
| SD-MG4-05R                 | 鐵通加工圖   | 18                    | - |             |                               |  |  |  |  |  |  |  |
| T3-MG4-S01                 | 鐵通加工圖   | 19                    | - |             |                               |  |  |  |  |  |  |  |
| T3-MG4-S04                 | 鐵通加工圖   | 20                    | - |             |                               |  |  |  |  |  |  |  |
| MG2-S01                    | 鐵通加工圖   | 21                    | - |             |                               |  |  |  |  |  |  |  |
| MG2-S04                    | 鐵通加工圖   | 22                    | - |             |                               |  |  |  |  |  |  |  |
| J856-SD-IW-5151            | 鐵件位置圖   | 23                    | - |             |                               |  |  |  |  |  |  |  |
| J856-SD-IW-5152            | 鐵件位置圖   | 23                    | - |             |                               |  |  |  |  |  |  |  |

**圖則登記表**  
**DRAWING REGISTER**

|   |                       |    |                      |  |  |  |  |  |  |
|---|-----------------------|----|----------------------|--|--|--|--|--|--|
| 接收日期 Receiving Date (適用於客戶圖則)                   |                       | 年  |                      |  |  |  |  |  |  |
| 工程名稱 Project Title: 天水圍天榮站<br>46F-后裝門窗鐵件拆圖 (廠用) |                       | 月  |                      |  |  |  |  |  |  |
| 工程編號 Project No: J-856                          |                       | 日  |                      |  |  |  |  |  |  |
| 分發予 Distributed To                              |                       |    |                      |  |  |  |  |  |  |
|   |                       | 年  | 23                   |  |  |  |  |  |  |
|   |                       | 月  | 10                   |  |  |  |  |  |  |
|   |                       | 日  | 17                   |  |  |  |  |  |  |
| 圖則編號<br>Drg. No.                                | 圖則名稱<br>Drawing Title |    | 修訂編號<br>Revision No. |  |  |  |  |  |  |
| J856-SD-IW-5153                                 | 鐵件位置圖                 | 24 | -                    |  |  |  |  |  |  |
| J856-SD-IW-5155                                 | 鐵件位置圖                 | 25 | -                    |  |  |  |  |  |  |
| J856-SD-IW-5156                                 | 鐵件位置圖                 | 26 | -                    |  |  |  |  |  |  |
| J856-SD-IW-5251                                 | 鐵件位置圖                 | 27 | -                    |  |  |  |  |  |  |
| J856-SD-IW-5253                                 | 鐵件位置圖                 | 28 | -                    |  |  |  |  |  |  |
| J856-SD-IW-5254                                 | 鐵件位置圖                 | 29 | -                    |  |  |  |  |  |  |
| J856-SD-IW-5351                                 | 鐵件位置圖                 | 30 | -                    |  |  |  |  |  |  |
| J856-SD-IW-5353                                 | 鐵件位置圖                 | 31 | -                    |  |  |  |  |  |  |
| J856-SD-IW-5354                                 | 鐵件位置圖                 | 32 | -                    |  |  |  |  |  |  |
| J856-SD-IW-5355                                 | 鐵件位置圖                 | 33 | -                    |  |  |  |  |  |  |
| J856-SD-IW-5356                                 | 鐵件位置圖                 | 34 | -                    |  |  |  |  |  |  |

|  |                |            |               |                 |
|--|----------------|------------|---------------|-----------------|
|  美特鋁質有限公司<br>MIDI Aluminium Fabricator Ltd | 工程號：J-856      | 計算：謝永林/劉龍浩 | 日期:2023.8.31  | 送呈: 胡哥          |
|  | 地盤名稱：天榮站       | 核對：謝永林     | 日期:2023.10.17 | 副本:             |
| 廠用鐵件B.M.表  | 項目類別：46F-門窗用鐵件 | 批准：        | 日期:           | 總重量： 786.446 KG |
|  | A/C Code:      |            |               | 此BM依據拆圖資料計算     |

| 序號 | 修改標示 | 物料編號       | 配件名稱    | 顏色       | 實用 | 後備  | 總數  | 單位 | 單件重量   | 總重量     | 備注 |
|----|------|------------|---------|----------|----|-----|-----|----|--------|---------|----|
|    |      |            |         |          |    |     |     | 件  | KG     |         |    |
| 1  |      | BK1-TT     | 角鐵拆圖    | 熱浸鋅/涂瀝青油 | 36 | 0   | 36  | 件  | 0.257  | 9.262   |    |
| 2  |      | BK1-BB     | 角鐵拆圖    | 熱浸鋅/涂瀝青油 | 16 | 0   | 16  | 件  | 0.269  | 4.305   |    |
| 3  |      | BK1-BB2    | 角鐵拆圖    | 熱浸鋅/涂瀝青油 | 20 | 0   | 20  | 件  | 0.273  | 5.459   |    |
| 4  |      | BK1-QQ     | 角鐵拆圖    | 熱浸鋅/涂瀝青油 | 50 | 0   | 50  | 件  | 0.257  | 12.863  |    |
| 5  |      | BK2-TT     | 角鐵拆圖    | 熱浸鋅/涂瀝青油 | 19 | 0   | 19  | 件  | 0.293  | 5.559   |    |
| 6  |      | BK2-BB     | 角鐵拆圖    | 熱浸鋅/涂瀝青油 | 19 | 0   | 19  | 件  | 0.380  | 7.227   |    |
| 7  |      | BK2-QQ     | 角鐵拆圖    | 熱浸鋅/涂瀝青油 | 20 | 0   | 20  | 件  | 0.293  | 5.852   |    |
| 8  |      | BT3AA      | 鐵件固定碼拆圖 | 熱浸鋅/涂瀝青油 | 6  | 0   | 6   | 件  | 1.078  | 6.469   |    |
| 9  |      | BT3AA-1    | 鐵巴拆圖    | 熱浸鋅/涂瀝青油 | 6  | 0   | 6   | 件  | 0.118  | 0.707   |    |
| 10 |      | BT3BB      | 鐵件固定碼拆圖 | 熱浸鋅/涂瀝青油 | 6  | 0   | 6   | 件  | 1.223  | 7.340   |    |
| 11 |      | BT4AA      | 鐵件固定碼拆圖 | 熱浸鋅/涂瀝青油 | 3  | 0   | 3   | 件  | 1.981  | 5.943   |    |
| 12 |      | BB4BB      | 鐵件固定碼拆圖 | 熱浸鋅/涂瀝青油 | 3  | 0   | 3   | 件  | 1.223  | 3.670   |    |
| 13 |      | BT5AA      | 鐵件固定碼拆圖 | 熱浸鋅/涂瀝青油 | 4  | 0   | 4   | 件  | 0.835  | 3.339   |    |
| 14 |      | BT5BB      | 鐵件固定碼拆圖 | 熱浸鋅/涂瀝青油 | 4  | 0   | 4   | 件  | 0.857  | 3.427   |    |
| 15 |      | BT3AA-L    | 角鐵拆圖    | 熱浸鋅/涂瀝青油 | 6  | 0   | 6   | 件  | 0.521  | 3.128   |    |
| 16 |      | BT3AA-R    | 角鐵拆圖    | 熱浸鋅/涂瀝青油 | 6  | 0   | 6   | 件  | 0.521  | 3.128   |    |
| 17 |      | SD-MG4-05  | 鐵通加工圖   | 熱浸鋅/涂瀝青油 | 3  | 0   | 3   | 件  | 19.936 | 59.809  |    |
| 18 |      | SD-MG4-05R | 鐵通加工圖   | 熱浸鋅/涂瀝青油 | 3  | 0   | 3   | 件  | 19.936 | 59.809  |    |
| 19 |      | T3-MG4-S01 | 鐵通加工圖   | 熱浸鋅/涂瀝青油 | 3  | 0   | 3   | 件  | 17.954 | 53.863  |    |
| 20 |      | T3-MG4-S04 | 鐵通加工圖   | 熱浸鋅/涂瀝青油 | 3  | 0   | 3   | 件  | 17.954 | 53.863  |    |
| 21 |      | MG2-S01    | 鐵通加工圖   | 熱浸鋅/涂瀝青油 | 13 | 0   | 13  | 件  | 18.132 | 235.713 |    |
| 22 |      | MG2-S04    | 鐵通加工圖   | 熱浸鋅/涂瀝青油 | 13 | 0   | 13  | 件  | 18.132 | 235.713 |    |
|    |      |            |         |          |    | 合計: | 262 | 件  | 合計:    | 786.446 |    |



美特鋁質 有限公司  
MIDI Aluminium Fabricator Ltd.

工程號







J-856

地盤

天榮站



| 物料編號   | 數量 | 樓層   | 使用窗號  | 座數 |
|--------|----|------|-------|----|
| BK1-TT | 4  | 46/F | AW103 | T1 |
| BK1-TT | 6  | 46/F | AW106 | T1 |
| BK1-TT | 6  | 46/F | AW204 | T2 |
| BK1-TT | 4  | 46/F | AW301 | T3 |
| BK1-TT | 4  | 46/F | AW303 | T3 |
| BK1-TT | 4  | 46/F | AW305 | T3 |
| BK1-TT | 8  | 46/F | AW306 | T3 |
| 合計     | 36 |      |       |    |

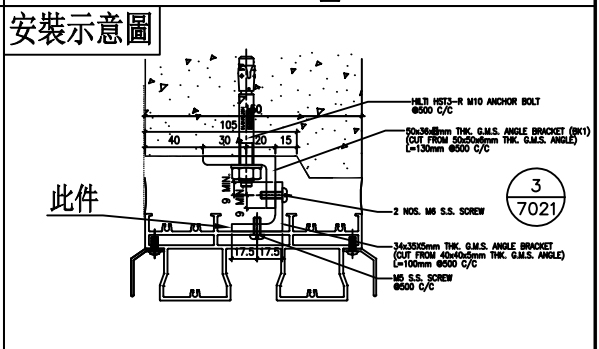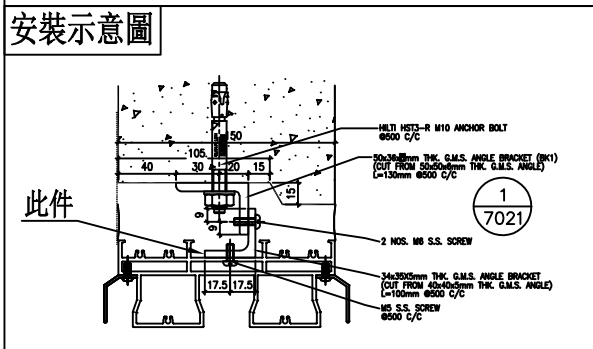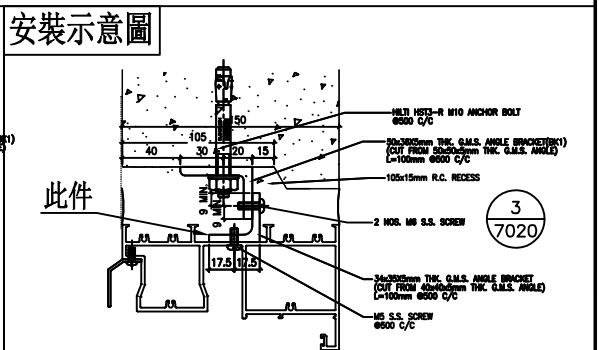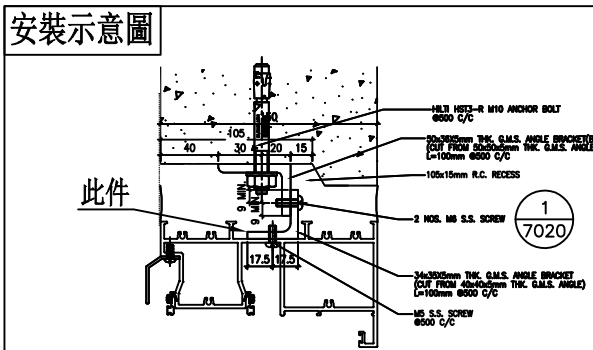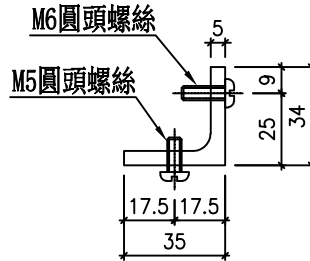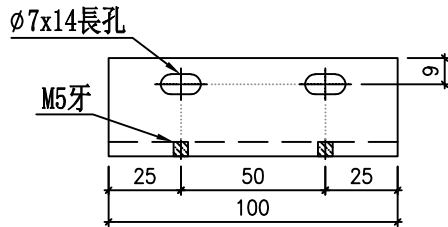

|    |             |    |     |            |    |        |  |
|----|-------------|----|-----|------------|----|--------|--|
| 名稱 | 角鐵拆圖        | 制圖 | 黃瓊玉 | 2023.08.28 | 修改 |        |  |
| 材料 | 35x34x5mm角鐵 | 復核 | 謝永林 | 2023.09.07 | 日期 |        |  |
| 顏色 | 熱浸鋅/塗瀝青油    | 批准 |     |            | 圖號 | BK1-TT |  |





美特鋁質 有限公司  
MIDI Aluminium Fabricator Ltd.


工程號 J-856 地盤 天榮站




| 物料編號   | 數量 | 樓層   | 使用窗號  | 座數 |
|--------|----|------|-------|----|
| BK1-BB | 4  | 46/F | AW301 | T3 |
| BK1-BB | 4  | 46/F | AW303 | T3 |
| BK1-BB | 8  | 46/F | AW306 | T3 |
| 合計     | 16 |      |       |    |

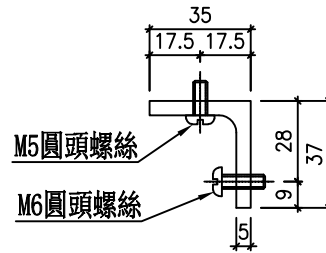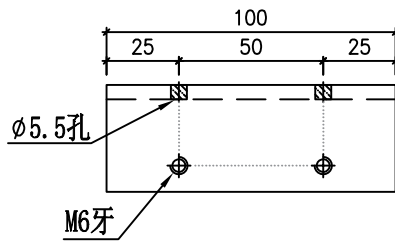

安裝示意圖

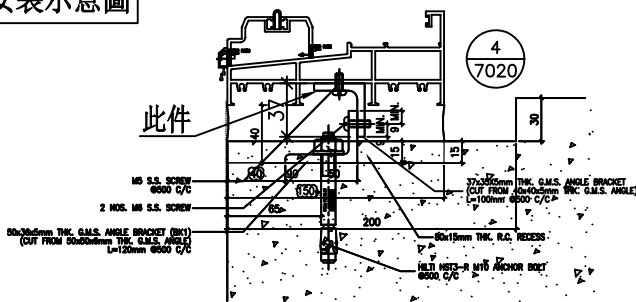

安裝示意圖

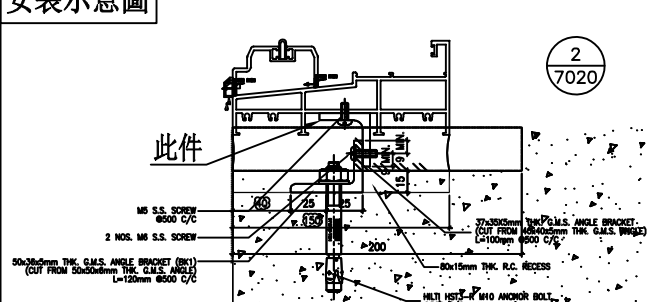

|    |             |    |     |            |    |        |  |  |
|----|-------------|----|-----|------------|----|--------|--|--|
| 名稱 | 角鐵拆圖        | 制圖 | 黃瓊玉 | 2023.08.28 | 修改 |        |  |  |
| 材料 | 37x35x5mm角鐵 | 復核 | 謝永林 | 2023.09.07 | 日期 |        |  |  |
| 顏色 | 熱浸鋅/塗瀝青油    | 批准 |     |            | 圖號 | BK1-BB |  |  |




美特鋁質 有限公司  
MIDI Aluminium Fabricator Ltd.


工程號 J-856 地盤 天榮站




| 物料編號    | 數量 | 樓層   | 使用窗號  | 座數 |
|---------|----|------|-------|----|
| BK1-BB2 | 4  | 46/F | AW103 | T1 |
| BK1-BB2 | 6  | 46/F | AW106 | T1 |
| BK1-BB2 | 6  | 46/F | AW204 | T2 |
| BK1-BB2 | 4  | 46/F | AW305 | T3 |
| 合計      | 20 |      |       |    |

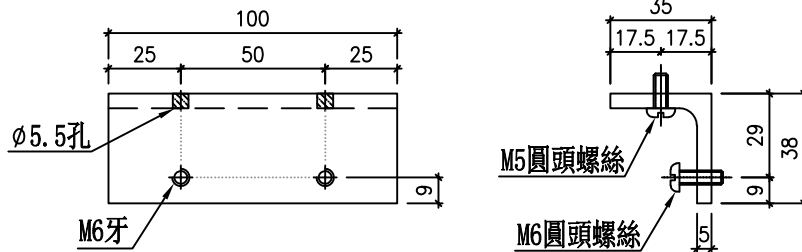


安裝示意圖

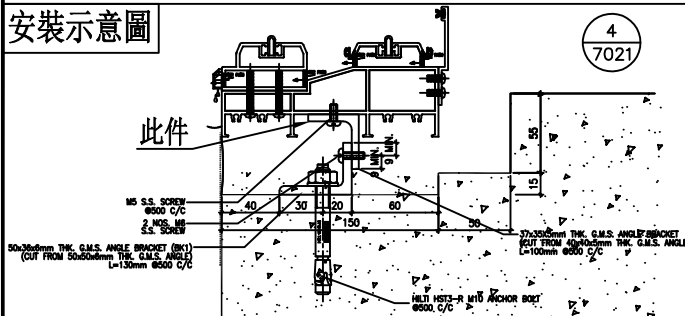

安裝示意圖

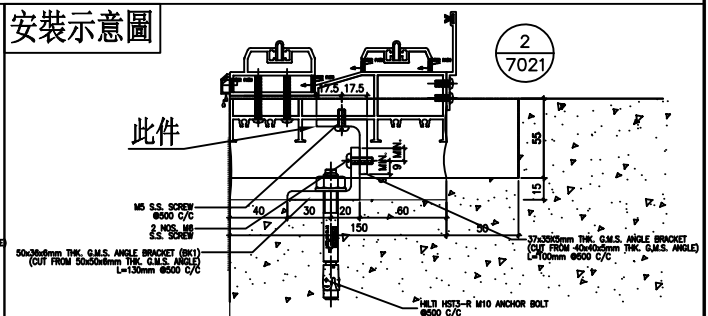

|    |             |    |     |            |    |         |  |
|----|-------------|----|-----|------------|----|---------|--|
| 名稱 | 角鐵拆圖        | 制圖 | 黃瓊玉 | 2023.08.28 | 修改 |         |  |
| 材料 | 38x35x5mm角鐵 | 復核 | 謝永林 | 2023.09.07 | 日期 |         |  |
| 顏色 | 熱浸鋅/塗瀝青油    | 批准 |     |            | 圖號 | BK1-BB2 |  |

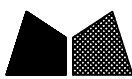



美特鋁質 有限公司  
MIDI Aluminium Fabricator Ltd.

工程號

J-856


地盤

天榮站

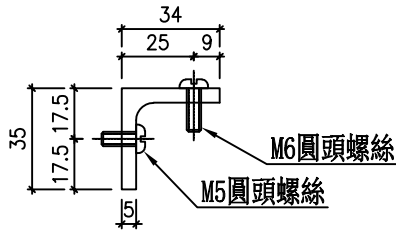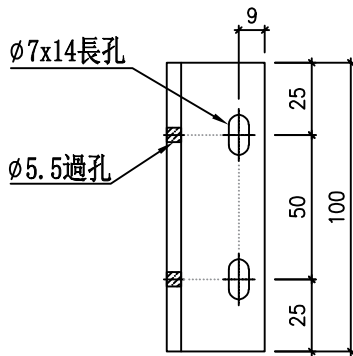


| 物料編號   | 數量 | 樓層   | 使用窗號  | 座數 |
|--------|----|------|-------|----|
| BK1-QQ | 5  | 46/F | AW103 | T1 |
| BK1-QQ | 10 | 46/F | AW106 | T1 |
| BK1-QQ | 10 | 46/F | AW204 | T2 |
| BK1-QQ | 5  | 46/F | AW301 | T3 |
| BK1-QQ | 5  | 46/F | AW303 | T3 |
| BK1-QQ | 5  | 46/F | AW305 | T3 |
| BK1-QQ | 10 | 46/F | AW306 | T3 |
| 合計     | 50 |      |       |    |


安裝示意圖

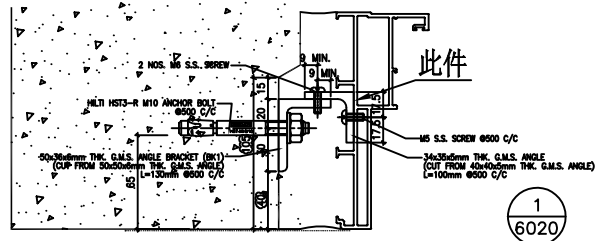

安裝示意圖

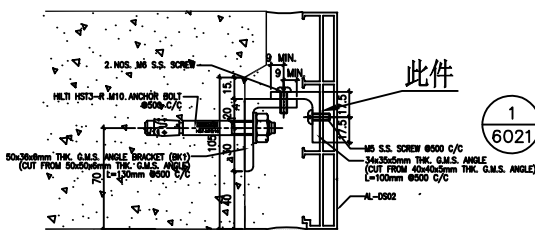

安裝示意圖

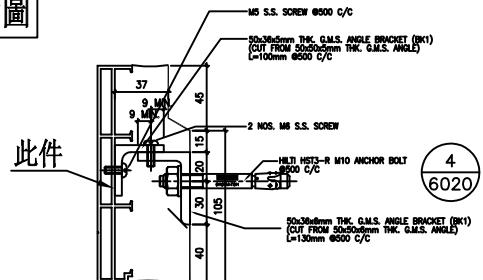

|    |             |    |     |            |    |        |  |
|----|-------------|----|-----|------------|----|--------|--|
| 名稱 | 角鐵拆圖        | 制圖 | 黃瓊玉 | 2023.08.28 | 修改 |        |  |
| 材料 | 35x34x5mm角鐵 | 復核 | 謝永林 | 2023.09.07 | 日期 |        |  |
| 顏色 | 熱浸鋅/塗滷青油    | 批准 |     |            | 圖號 | BK1-QQ |  |



美特鋁質 有限公司  
MIDI Aluminium Fabricator Ltd.

工程號



J-856

地盤


天榮站




| 物料編號   | 數量 | 樓層   | 使用窗號  | 座數 |
|--------|----|------|-------|----|
| BK2-TT | 5  | 46/F | AW103 | T1 |
| BK2-TT | 5  | 46/F | AW301 | T3 |
| BK2-TT | 5  | 46/F | AW303 | T3 |
| BK2-TT | 4  | 46/F | AW305 | T3 |
| 合計     | 19 |      |       |    |

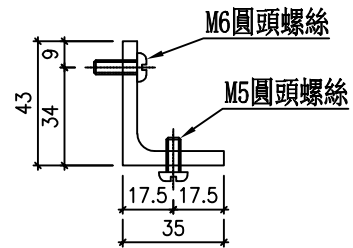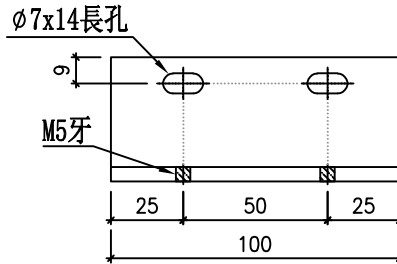


安裝示意圖

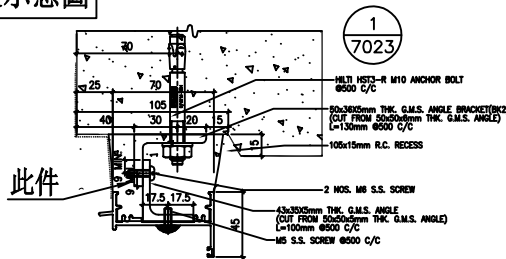

安裝示意圖

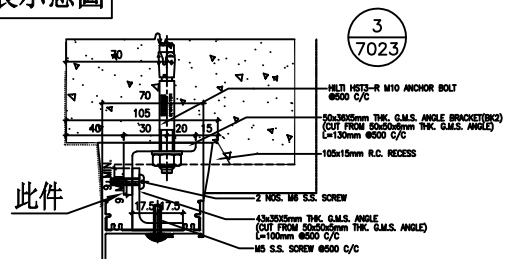

|    |             |    |     |            |    |        |  |
|----|-------------|----|-----|------------|----|--------|--|
| 名稱 | 角鐵拆圖        | 制圖 | 黃瓊玉 | 2023.08.28 | 修改 |        |  |
| 材料 | 43x35x5mm角鐵 | 復核 | 謝永林 | 2023.09.07 | 日期 |        |  |
| 顏色 | 熱浸鋅/塗瀝青油    | 批准 |     |            | 圖號 | BK2-TT |  |

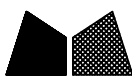

美特鋁質 有限公司  
MIDI Aluminium Fabricator Ltd.

工程號



J-856

地盤


天榮站



| 物料編號   | 數量 | 樓層   | 使用窗號  | 座數 |
|--------|----|------|-------|----|
| BK2-BB | 5  | 46/F | AW103 | T1 |
| BK2-BB | 5  | 46/F | AW301 | T3 |
| BK2-BB | 5  | 46/F | AW303 | T3 |
| BK2-BB | 4  | 46/F | AW305 | T3 |
| 合計     | 19 |      |       |    |

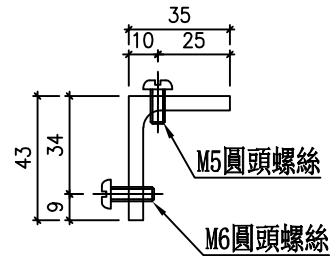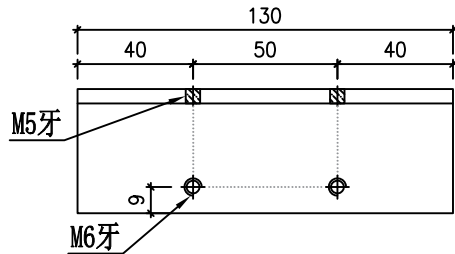

安裝示意圖

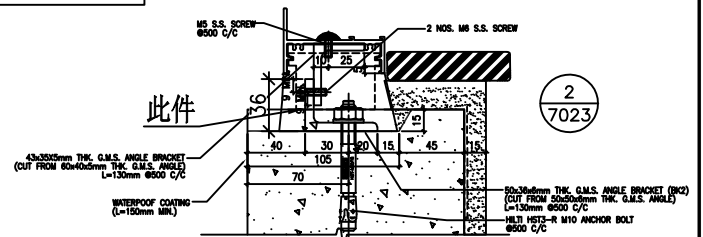

|    |             |    |     |            |    |        |  |
|----|-------------|----|-----|------------|----|--------|--|
| 名稱 | 角鐵拆圖        | 制圖 | 黃瓊玉 | 2023.08.28 | 修改 |        |  |
| 材料 | 43x35x5mm角鐵 | 復核 | 謝永林 | 2023.09.07 | 日期 |        |  |
| 顏色 | 熱浸鋅/塗瀝青油    | 批准 |     |            | 圖號 | BK2-BB |  |



美特鋁質 有限公司  
MIDI Aluminium Fabricator Ltd.

工程號



J-856

地盤


天榮站




| 物料編號   | 數量 | 樓層   | 使用窗號  | 座數 |
|--------|----|------|-------|----|
| BK2-QQ | 5  | 46/F | AW103 | T1 |
| BK2-QQ | 5  | 46/F | AW301 | T3 |
| BK2-QQ | 5  | 46/F | AW303 | T3 |
| BK2-QQ | 5  | 46/F | AW305 | T3 |
| 合計     | 20 |      |       |    |

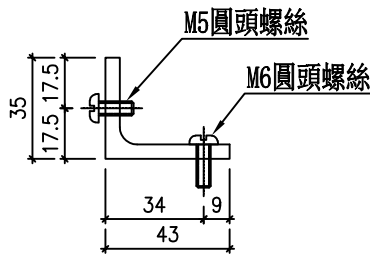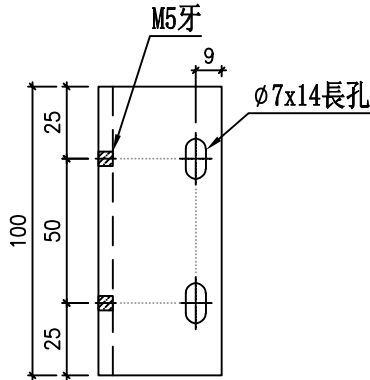

安裝示意圖

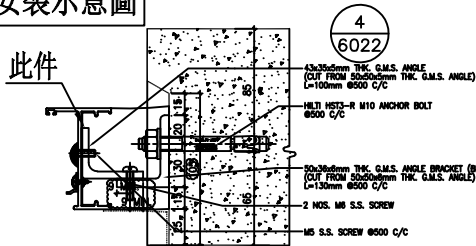

安裝示意圖

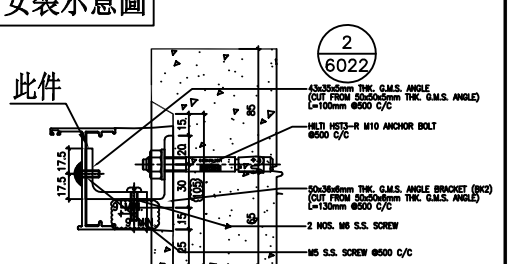

|    |             |    |     |            |    |        |  |  |
|----|-------------|----|-----|------------|----|--------|--|--|
| 名稱 | 角鐵拆圖        | 制圖 | 黃瓊玉 | 2023.08.28 | 修改 |        |  |  |
| 材料 | 43x35x5mm角鐵 | 復核 | 謝永林 | 2023.09.07 | 日期 |        |  |  |
| 顏色 | 熱浸鋅/塗瀝青油    | 批准 |     |            | 圖號 | BK2-QQ |  |  |





美特鋁質 有限公司  
MIDI Aluminium Fabricator Ltd.

工程號


J-856

地盤

天榮站




| 數量 | 樓層   | 使用窗號  | 座數 |
|----|------|-------|----|
| 2  | 46/F | AW301 | T3 |
| 2  | 46/F | AW303 | T3 |
| 2  | 46/F | AW306 | T3 |
| 6  | 合計   |       |    |

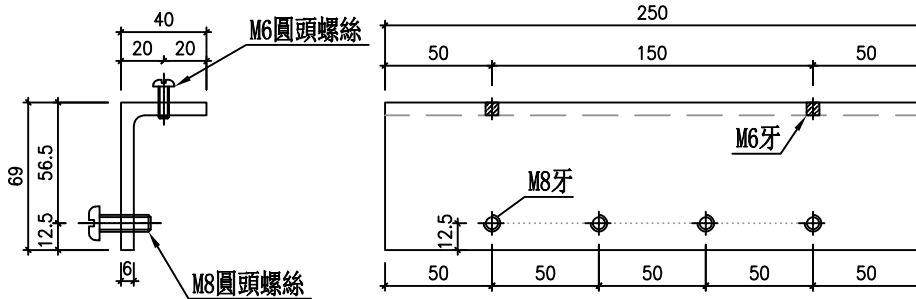

安裝示意圖

BB3B

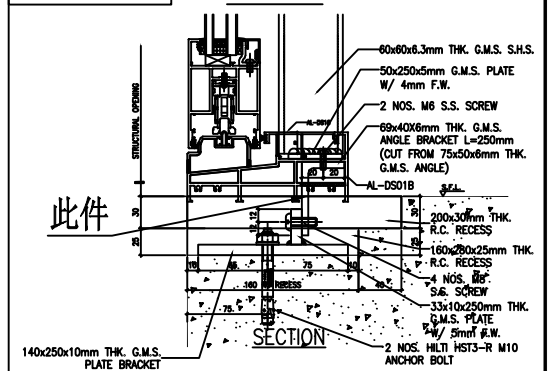

此件

|    |             |    |     |            |    |       |  |
|----|-------------|----|-----|------------|----|-------|--|
| 名稱 | 角鐵拆圖        | 制圖 | 黃瓊玉 | 2023.08.28 | 修改 |       |  |
| 材料 | 69x40x6mm鐵角 | 復核 | 謝永林 | 2023.09.07 | 日期 |       |  |
| 顏色 | 熱浸鋅/塗瀝青油    | 批准 |     |            | 圖號 | BB3BB |  |



美特鋁質 有限公司  
MIDI Aluminium Fabricator Ltd.

工程號



J-856

地盤


天榮站



| 數量 | 樓層   | 使用窗號  | 座數 |
|----|------|-------|----|
| 1  | 46/F | AW301 | T3 |
| 1  | 46/F | AW303 | T3 |
| 1  | 46/F | AW306 | T3 |
| 3  | 合計   |       |    |
|    |      |       |    |

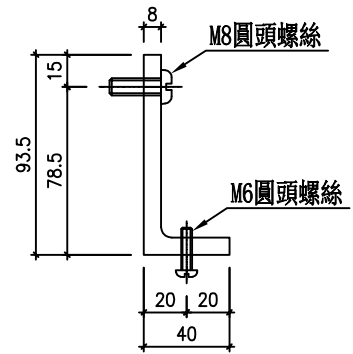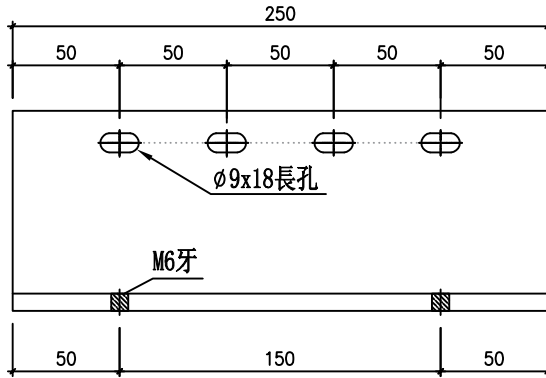

安裝示意圖

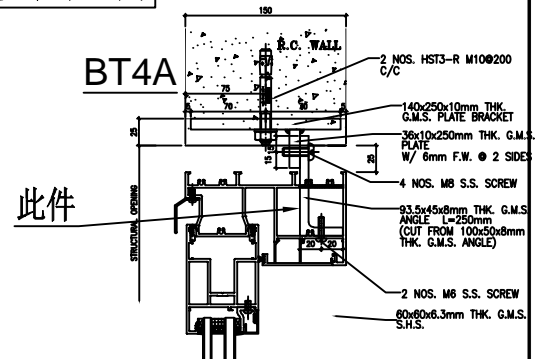

|    |               |    |     |            |    |       |  |  |
|----|---------------|----|-----|------------|----|-------|--|--|
| 名稱 | 角鐵拆圖          | 制圖 | 黃瓊玉 | 2023.08.28 | 修改 |       |  |  |
| 材料 | 93.5x40x8mm鐵角 | 復核 | 謝永林 | 2023.09.07 | 日期 |       |  |  |
| 顏色 | 熱浸鋅/塗瀝青油      | 批准 |     |            | 圖號 | BT4AA |  |  |



美特鋁質 有限公司  
MIDI Aluminium Fabricator Ltd.

工程號


J-856

地盤


天榮站

工廠用

| 數量 | 樓層   | 使用窗號  | 座數 |
|----|------|-------|----|
| 1  | 46/F | AW301 | T3 |
| 1  | 46/F | AW303 | T3 |
| 1  | 46/F | AW306 | T3 |
| 3  | 合計   |       |    |

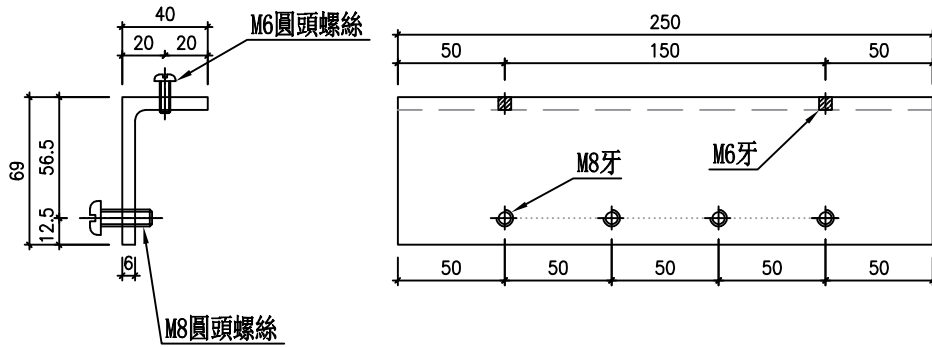

安裝示意圖 BB4B

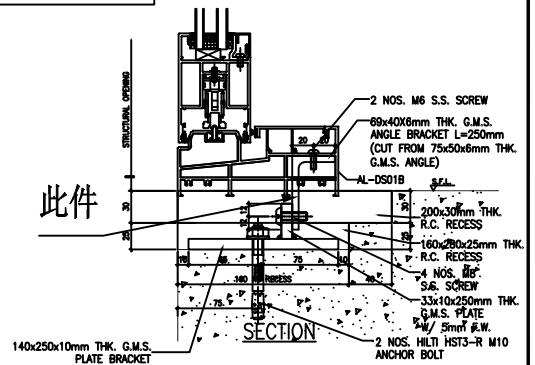

|    |             |    |     |            |    |       |  |  |
|----|-------------|----|-----|------------|----|-------|--|--|
| 名稱 | 角鐵拆圖        | 制圖 | 黃瓊玉 | 2023.08.28 | 修改 |       |  |  |
| 材料 | 69x40x6mm鐵角 | 復核 | 謝永林 | 2023.09.07 | 日期 |       |  |  |
| 顏色 | 熱浸鋅/塗瀝青油    | 批准 |     |            | 圖號 | BB4BB |  |  |



美特鋁質 有限公司  
MIDI Aluminium Fabricator Ltd.

工程號


J-856

地盤


天榮站

工廠用

| 數量 | 樓層   | 使用窗號  | 座數 |
|----|------|-------|----|
| 1  | 46/F | AW103 | T1 |
| 1  | 46/F | AW106 | T1 |
| 1  | 46/F | AW204 | T2 |
| 1  | 46/F | AW305 | T3 |
| 4  | 合計   |       |    |

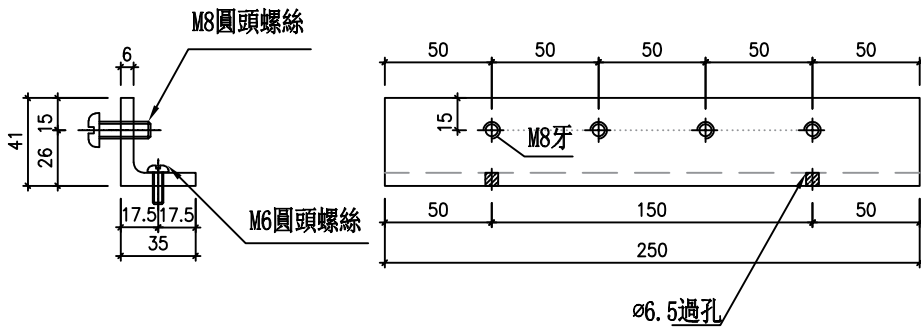

安裝示意圖

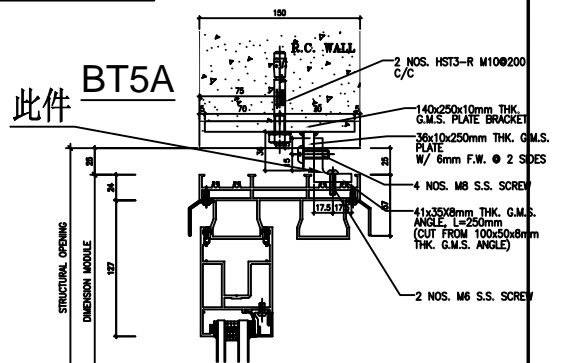

|    |             |    |     |            |    |       |  |
|----|-------------|----|-----|------------|----|-------|--|
| 名稱 | 鐵件固定碼拆圖     | 制圖 | 黃瓊玉 | 2023.08.28 | 修改 |       |  |
| 材料 | 41x35x8mm鐵角 | 復核 | 謝永林 | 2023.09.07 | 日期 |       |  |
| 顏色 | 熱浸鋅/塗瀝青油    | 批准 |     |            | 圖號 | BT5AA |  |









美特鋁質 有限公司  
MIDI Aluminium Fabricator Ltd.


工程號 J-856 地盤 天榮站



| 數量 | 樓層   | 使用窗號  | 座數 |
|----|------|-------|----|
| 2  | 46/F | AW301 | T3 |
| 2  | 46/F | AW303 | T3 |
| 2  | 46/F | AW306 | T3 |
| 6  | 合計   |       |    |

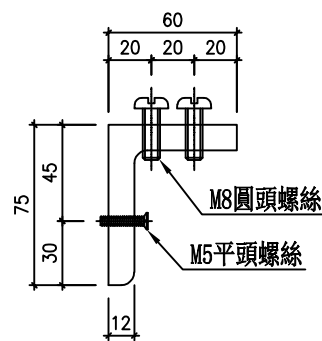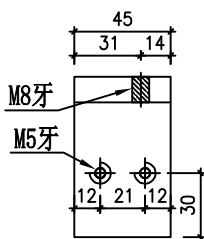

安裝示意圖

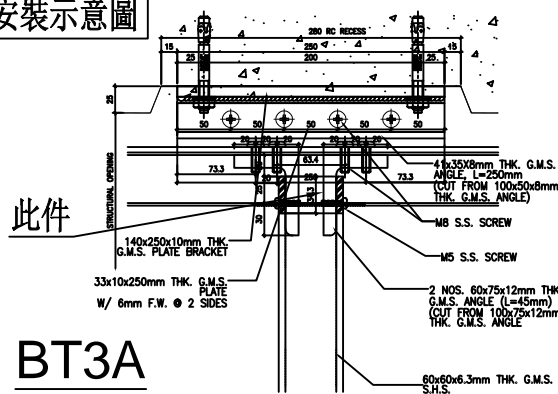

BT3A

|    |              |    |     |            |    |         |  |
|----|--------------|----|-----|------------|----|---------|--|
| 名稱 | 角鐵拆圖         | 制圖 | 黃瓊玉 | 2023.08.28 | 修改 |         |  |
| 材料 | 75x60x12mm角鐵 | 復核 | 謝永林 | 2023.09.07 | 日期 |         |  |
| 顏色 | 熱浸鋅/塗瀝青油     | 批准 |     |            | 圖號 | BT3AA-R |  |









美特鋁質 有限公司  
MIDI Aluminium Fabricator Ltd.

工程號 J856 地盤 天榮站

工廠用

| 數量 | 樓層   | 使用窗號  | 座數 |
|----|------|-------|----|
| 1  | 46/F | AW301 | T3 |
| 1  | 46/F | AW303 | T3 |
| 1  | 46/F | AW306 | T3 |
| 3  | 合計   |       |    |

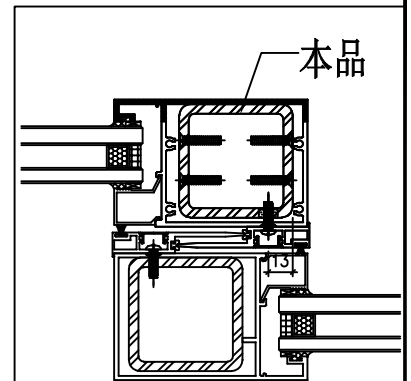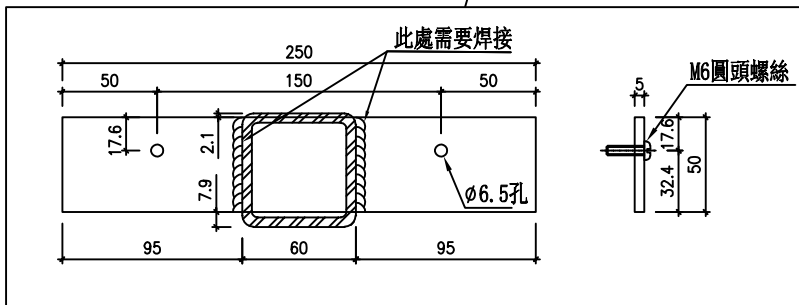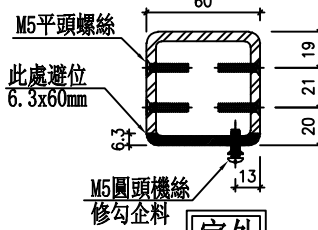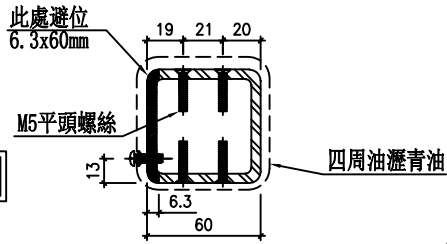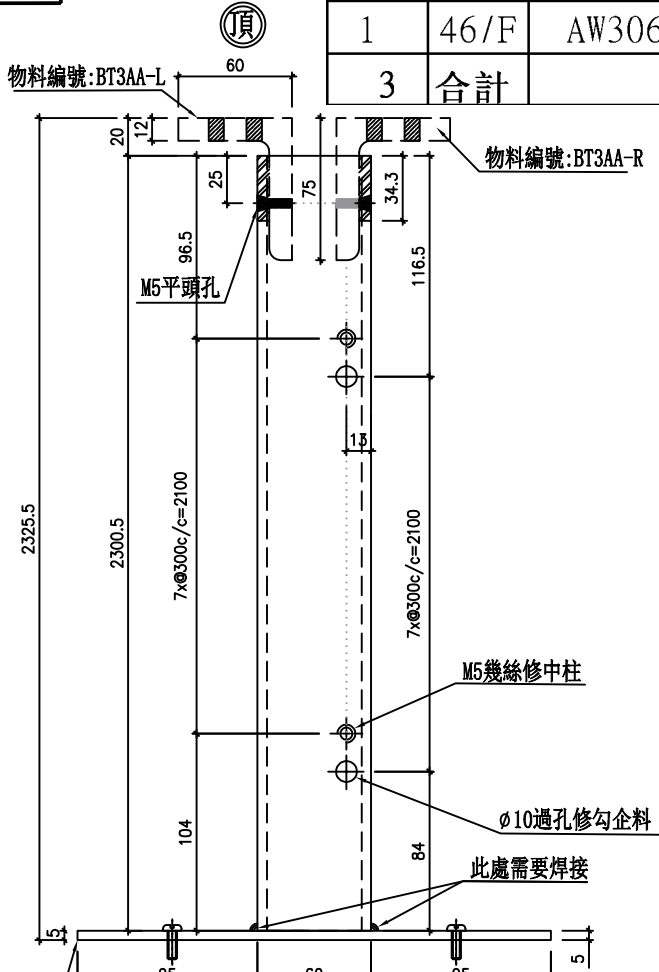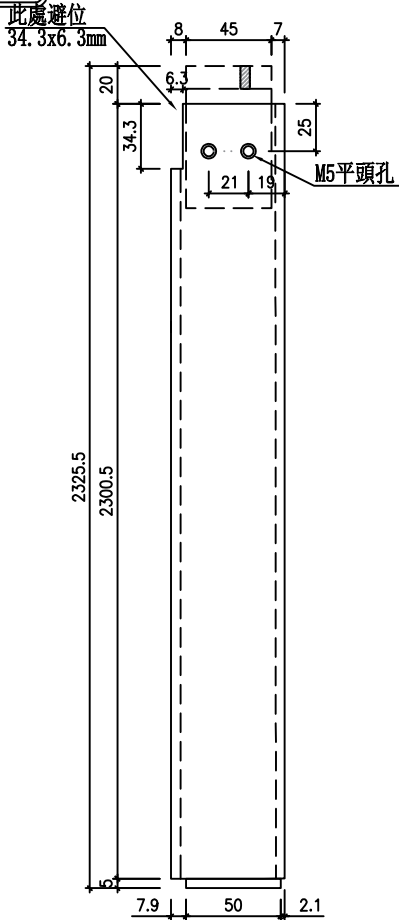

|    |                     |    |     |            |    |           |  |
|----|---------------------|----|-----|------------|----|-----------|--|
| 名稱 | 鐵通加工圖               | 制圖 | 謝永林 | 2023.08.28 | 修改 |           |  |
| 材料 | 60x60x5mm厚鋼通 /5mm鐵板 | 復核 | 謝永林 | 2023.09.07 | 日期 |           |  |
| 顏色 | 熱浸鋅/塗瀝青油            | 批准 |     |            | 圖號 | SD-MG4-05 |  |




美特鋁質 有限公司  
MIDI Aluminium Fabricator Ltd.

工程號 J856

地盤 天榮站

| 數量 | 樓層   | 使用窗號  | 座數 |
|----|------|-------|----|
| 1  | 46/F | AW301 | T3 |
| 1  | 46/F | AW303 | T3 |
| 1  | 46/F | AW306 | T3 |
| 3  | 合計   |       |    |

工廠用

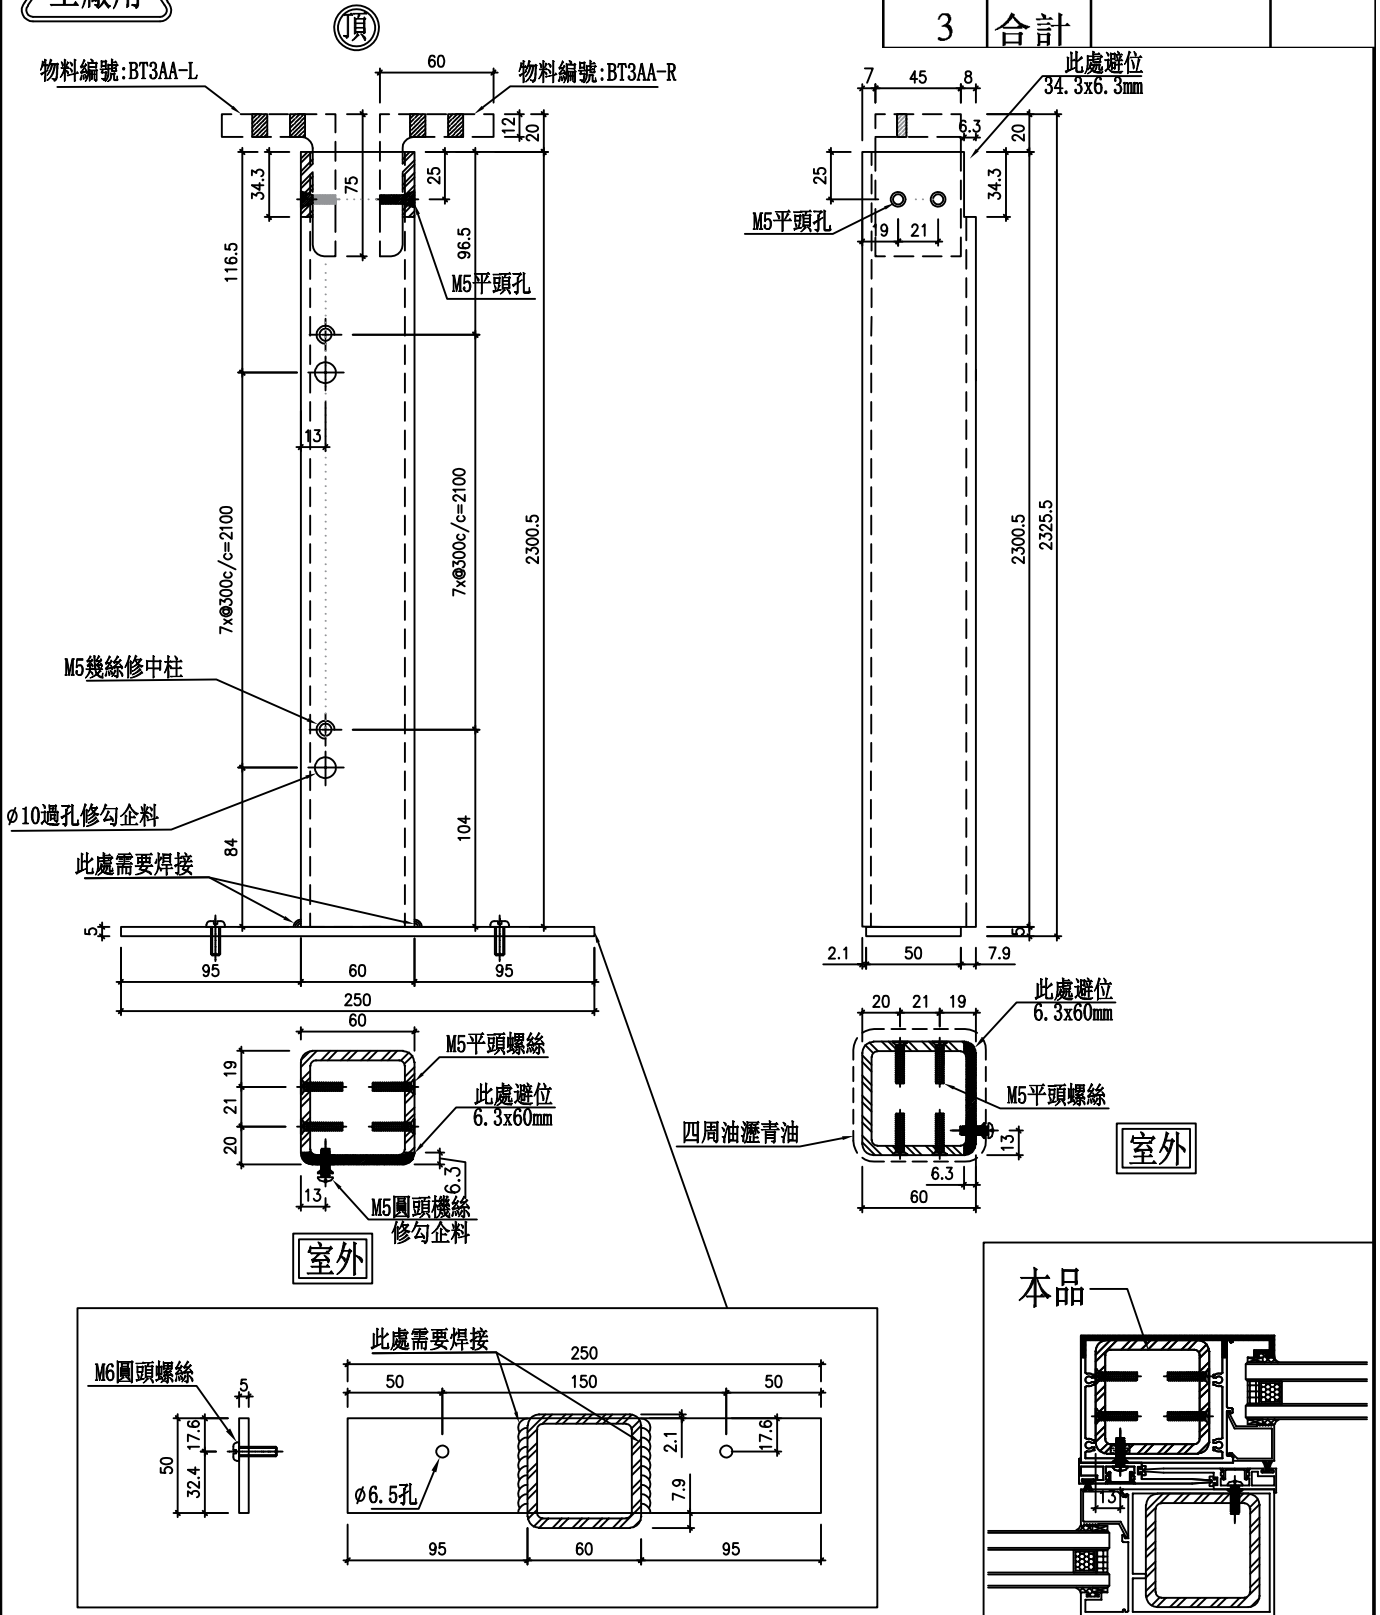

|    |                      |    |     |            |    |            |  |
|----|----------------------|----|-----|------------|----|------------|--|
| 名稱 | 鐵通加工圖                | 制圖 | 謝永林 | 2023.08.28 | 修改 |            |  |
| 材料 | 60x60x5mm厚鋼通 / 5mm鐵板 | 復核 | 謝永林 | 2023.09.07 | 日期 |            |  |
| 顏色 | 熱浸鋅/塗瀝青油             | 批准 |     |            | 圖號 | SD-MG4-05R |  |



美特鋁質 有限公司  
MIDI Aluminium Fabricator Ltd.

工程號



J856

地盤


天榮站




| 數量 | 樓層   | 使用窗號  | 座數 |
|----|------|-------|----|
| 1  | 46/F | AW301 | T3 |
| 1  | 46/F | AW303 | T3 |
| 1  | 46/F | AW306 | T3 |
| 3  | 合計   |       |    |

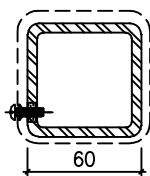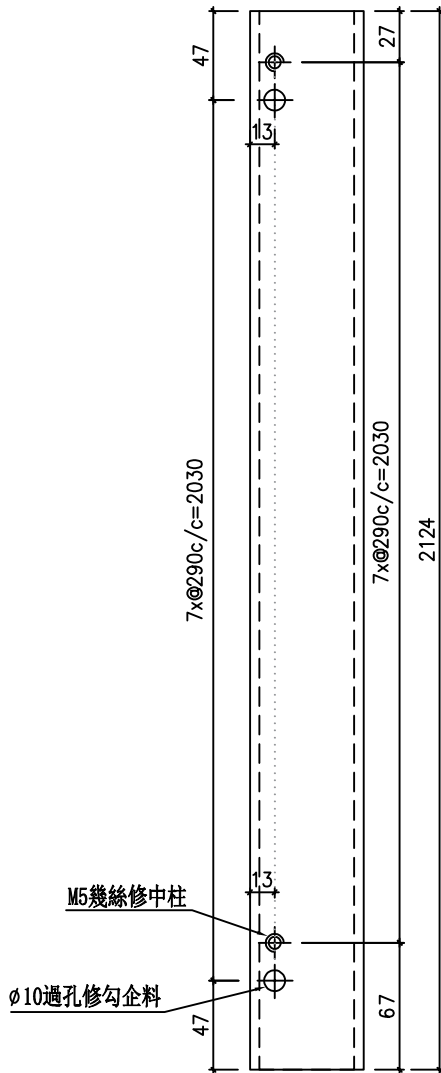

四周油瀝青油

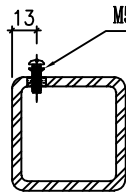

M5 圓頭機絲修勾企料

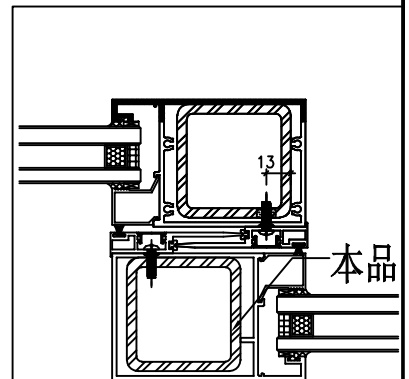

本品

|    |              |    |     |            |    |            |  |  |
|----|--------------|----|-----|------------|----|------------|--|--|
| 名稱 | 鐵通加工圖        | 制圖 | 謝永林 | 2023.08.28 | 修改 |            |  |  |
| 材料 | 60x60x5mm厚鋼通 | 復核 | 謝永林 | 2023.09.07 | 日期 |            |  |  |
| 顏色 | 熱浸鋅/塗瀝青油     | 批准 |     |            | 圖號 | T3-MG4-S01 |  |  |



美特鋁質 有限公司  
MIDI Aluminium Fabricator Ltd.

工程號

J856



地盤

天榮站

工廠用


| 數量 | 樓層   | 使用窗號  | 座數 |
|----|------|-------|----|
| 1  | 46/F | AW301 | T3 |
| 1  | 46/F | AW303 | T3 |
| 1  | 46/F | AW306 | T3 |
| 3  | 合計   |       |    |

(頂)

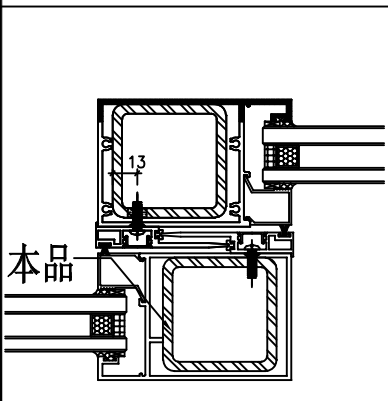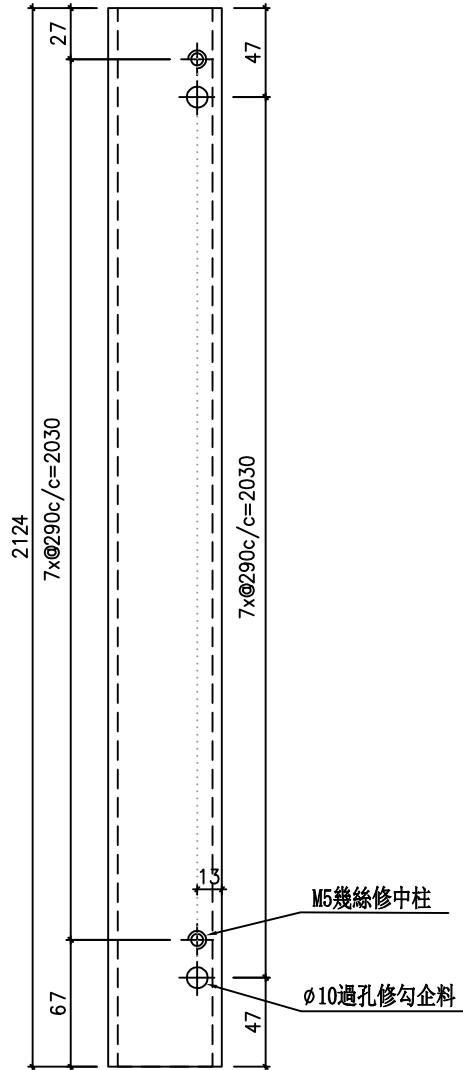


本品

M5圓頭機絲修勾企料

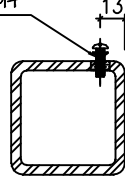

四周油瀝青油

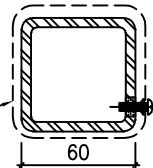

|    |              |    |     |            |    |            |  |  |
|----|--------------|----|-----|------------|----|------------|--|--|
| 名稱 | 鐵通加工圖        | 制圖 | 謝永林 | 2023.08.28 | 修改 |            |  |  |
| 材料 | 60x60x5mm厚鋼通 | 復核 | 謝永林 | 2023.09.07 | 日期 |            |  |  |
| 顏色 | 熱浸鋅/塗瀝青油     | 批准 |     |            | 圖號 | T3-MG4-S04 |  |  |



美特鋁質 有限公司  
MIDI Aluminium Fabricator Ltd.

工程號



J856

地盤


天榮站

工廠用


(頂)

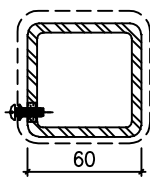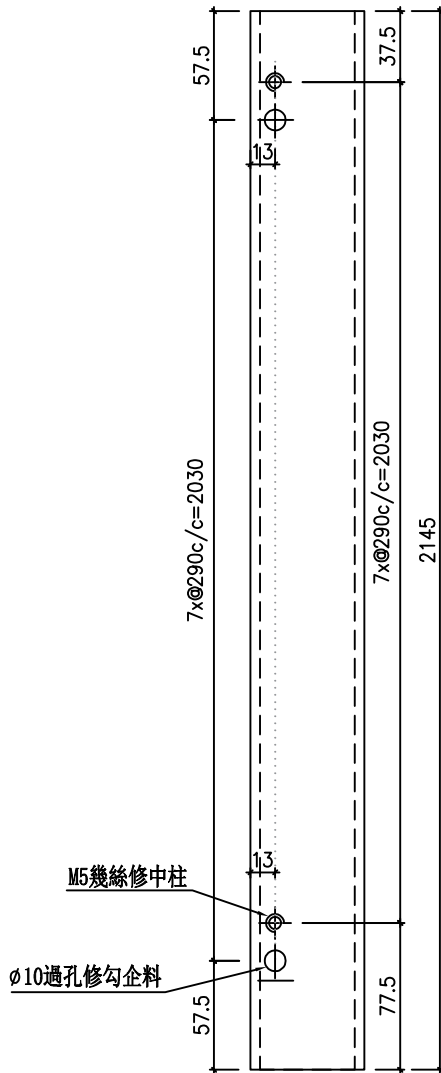

四周油瀝青油

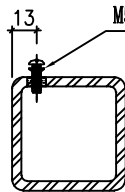

M5圓頭機絲修勾企料

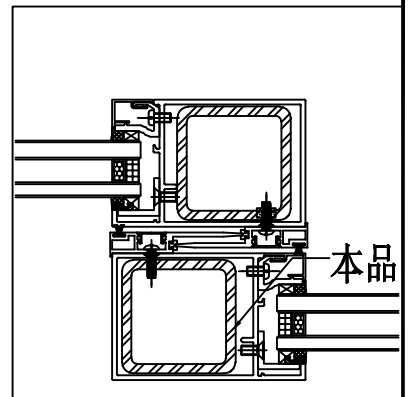

| 物料編號    | 數量 | 樓層   | 使用窗號  | 座數 |
|---------|----|------|-------|----|
| MG2-S01 | 4  | 46/F | AW18  | T1 |
| MG2-S01 | 1  | 46/F | AW103 | T1 |
| MG2-S01 | 1  | 46/F | AW106 | T1 |
| MG2-S01 | 4  | 46/F | AW18  | T2 |
| MG2-S01 | 1  | 46/F | AW204 | T2 |
| MG2-S01 | 1  | 46/F | AW18  | T3 |
| MG2-S01 | 1  | 46/F | AW305 | T3 |
| 合計      | 13 |      |       |    |

|    |              |    |     |              |    |         |  |
|----|--------------|----|-----|--------------|----|---------|--|
| 名稱 | 鐵通加工圖        | 制圖 | 劉龍浩 | 2023. 10. 14 | 修改 |         |  |
| 材料 | 60x60x5mm厚鋼通 | 復核 | 謝永林 | 2023. 10. 16 | 日期 |         |  |
| 顏色 | 熱浸鋅/塗瀝青油     | 批准 |     |              | 圖號 | MG2-S01 |  |



美特鋁質 有限公司  
MIDI Aluminium Fabricator Ltd.

工程號




J856

地盤

天榮站


工廠用

| 物料編號    | 數量 | 樓層   | 使用窗號  | 座數 |
|---------|----|------|-------|----|
| MG2-S04 | 4  | 46/F | AW18  | T1 |
| MG2-S04 | 1  | 46/F | AW103 | T1 |
| MG2-S04 | 1  | 46/F | AW106 | T1 |
| MG2-S04 | 4  | 46/F | AW18  | T2 |
| MG2-S04 | 1  | 46/F | AW204 | T2 |
| MG2-S04 | 1  | 46/F | AW18  | T3 |
| MG2-S04 | 1  | 46/F | AW305 | T3 |
| 合計      | 13 |      |       |    |

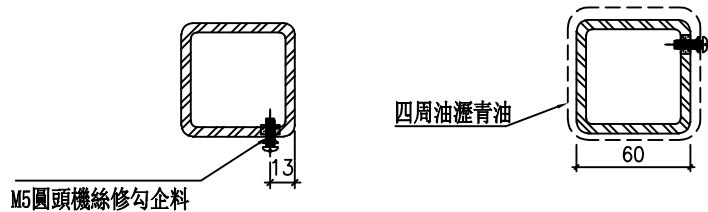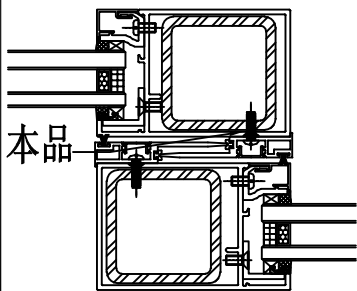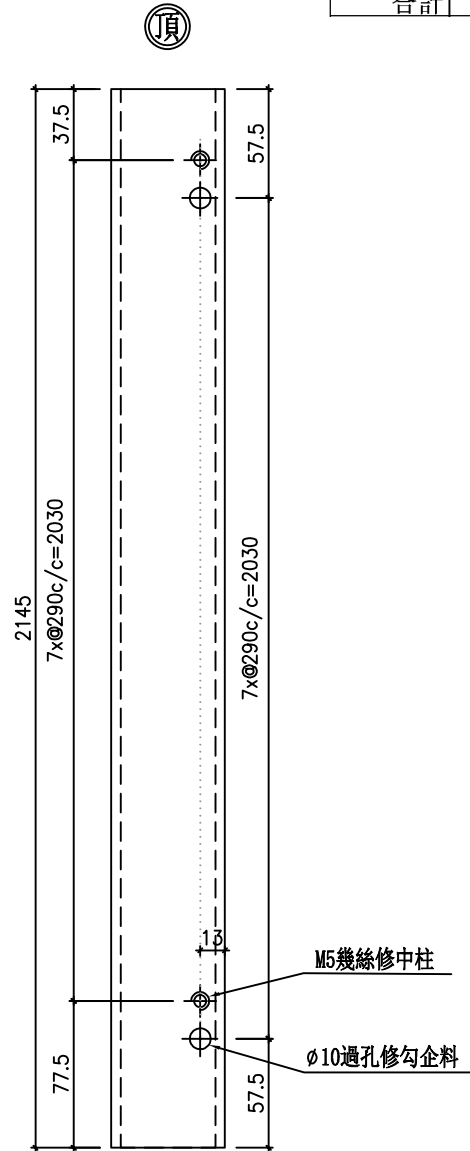


|    |              |    |     |              |    |         |  |  |
|----|--------------|----|-----|--------------|----|---------|--|--|
| 名稱 | 鐵通加工圖        | 制圖 | 劉龍浩 | 2023. 10. 14 | 修改 |         |  |  |
| 材料 | 60x60x5mm厚鋼通 | 復核 | 謝永林 | 2023. 10. 16 | 日期 |         |  |  |
| 顏色 | 熱浸鋅/塗瀝青油     | 批准 |     |              | 圖號 | MG2-S04 |  |  |


|                   |               |              |               |              |
|-------------------|---------------|--------------|---------------|--------------|
| PROVIDED          |               |              |               |              |
| LOCATION          | OPENABLE AREA | GLAZING AREA | OPENABLE AREA | GLAZING AREA |
| SIM. 1A LIV./DIN. | 1.924         | 3.079        | 1.559         | 2.908        |

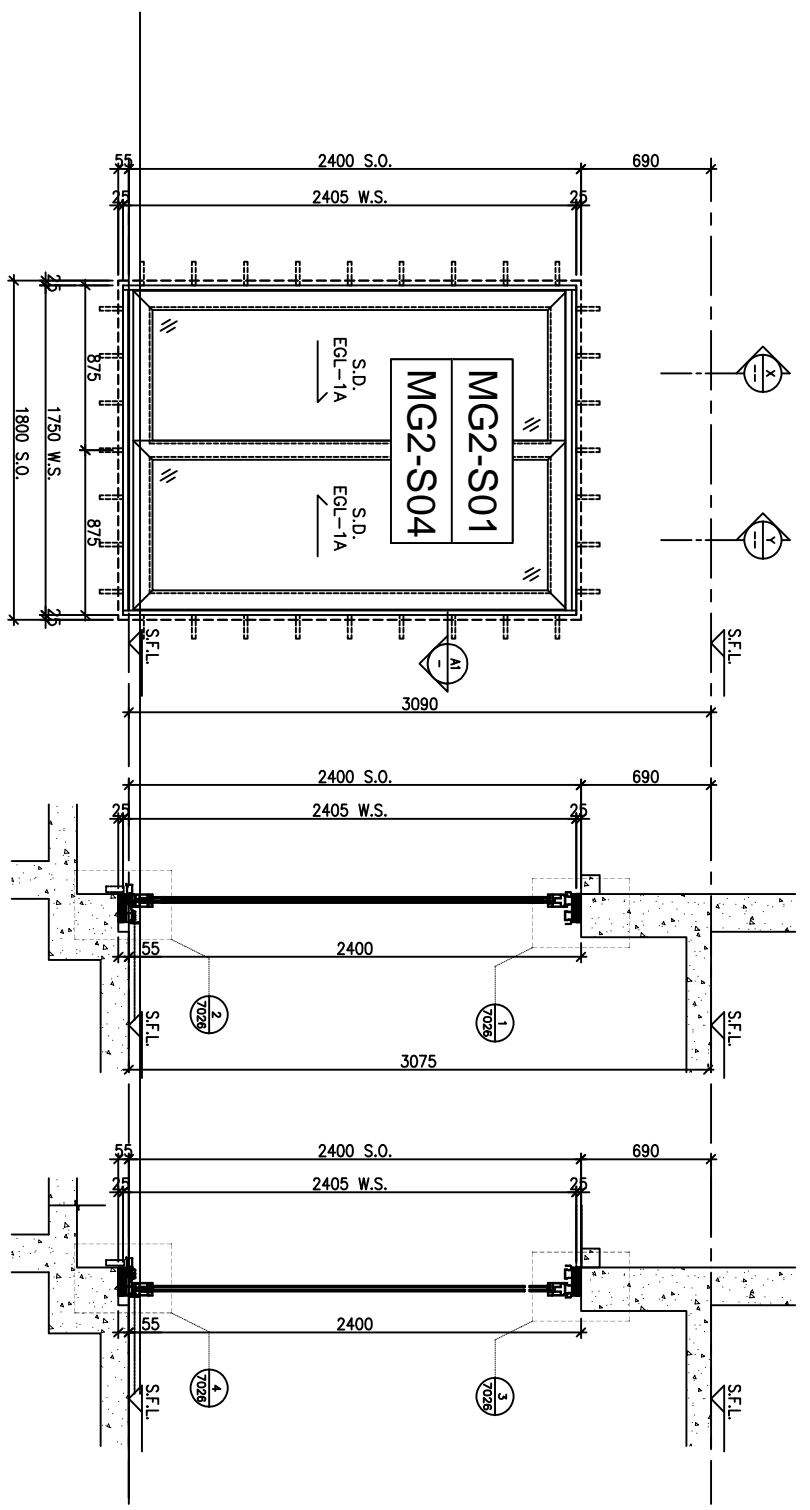


ELEVATION

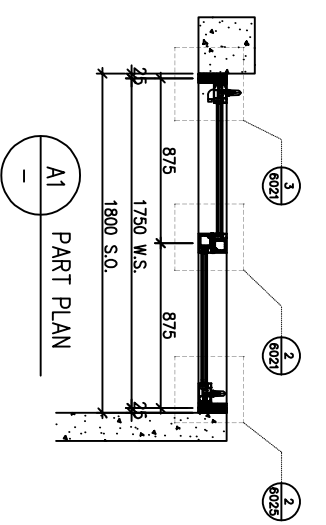


A1 PART PLAN

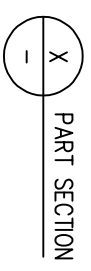

X PART SECTION

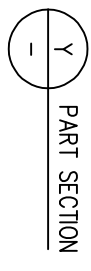

Y PART SECTION

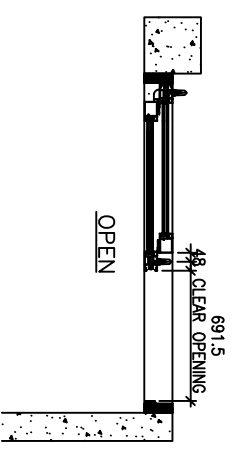

OPEN

|             |                                |
|-------------|--------------------------------|
| WINDOW MARK | AW 18                          |
| LOCATION    | 46/F UNIT SIMPLEX 1A LIV./DIN. |
| SECTION     | 70mm ALUM. SECTION             |
| GLAZING     | EGL-1A                         |
| QUANTITY    | 1 NO.                          |
| REMARKS     | SIEGENIA SLIDING DOOR SYSTEM   |

B.D. REF :

CLIENT :

SUN HUNG KAI  
REAL ESTATE AGENCY LTD.  
42/F SUN HUNG KAI CENTRE, MANUL, HONGKONG

ARCHITECT :

IWK&partners  
A F C H N I L O G I S

MAIN CONTRACTOR :

怡輝建築有限公司  
Yee Fai Building Contractors Ltd.

STRUCTURAL ENGINEER :

ARUP  
ALPHA CONSULTING LIMITED  
Steel Structure & Façade Specialist

NOTE :

1. ALL DIMENSIONS ARE IN mm.
2. ALL ELEVATIONS ARE VIEWED FROM OUTSIDE.
3. ALL DIMENSIONS TO BE VERIFIED ON SITE BEFORE FABRICATION.

LEGEND :

- (X1) DETAIL MARK NO.
- (X001) REFER SHEET NO.
- 1. F.F.L. --- FINISHED FLOOR LEVEL
- 2. S.F.L. --- STRUCTURAL FLOOR LEVEL
- 3. (R) --- REVERSED DETAIL
- 4. GLASS LEGEND

EQ1-1 --- 8mmHS+12mm AIR GAP+10mmTP THK. LGU.  
EQ1-2 --- 10mm THK. CRYSTAL GRAY TEMPERED GLASS  
EQ1-4 --- 10mm THK. CRYSTAL TEMPERED ADD ETCHED GLASS  
EQ1-1A --- 8mmHS+12mm AIR GAP+8mmTP THK. LGU.  
BT1/BB1 --- FIXING DETAIL (DWG. NO. FD01)  
BB2 --- FIXING DETAIL (DWG. NO. FD02)

GLAZING AREA

OPENABLE AREA


6001 TO 6011 & 7001 TO 7008A DETAILS REFER TO 3-45F IN-SITU WINDOW SCHEDULE

| NO. | DATE       | REVISION SUBJECT TO ARCH/COMMENT | BY   |
|-----|------------|----------------------------------|------|
| A   | 30/01/2023 | REVISION SUBJECT TO ARCH/COMMENT | IVON |


JOB NO. : J-856  
DRAWN BY : IVON  
CHECKED BY :  
DATE : 02-Aug-21  
SCALE : 1:40  
PROJECT : PROPOSED DEVELOPMENT ABOVE LIGHT RAIL TIN WING STOP, ISWTL NO.23, AREA 33, TIN SHUI WAI, N.T.  
TITLE : WINDOW SCHEDULE FOR TOWER 1 IN-SITU WINDOW  
Dwg No. : J856-SD-W-5151  
REV : B

美特鋁質有限公司  
MIDI ALUMINIUM FABRICATOR LTD.  
Units 6-8, Sunray Industrial Centre, 1/F  
610 Che Kwo Ling Road, Kowloon  
Tel: 23489211-4 Fax: (852) 2727666

|                  |               |              |               |              |
|------------------|---------------|--------------|---------------|--------------|
| LOCATION         | OPENABLE AREA | GLAZING AREA | OPENABLE AREA | GLAZING AREA |
| SIM. 2A LIV./DIN | 1,363         | 2,180        | 1,559         | 2,908        |
|                  |               |              | OPENABLE AREA | GLAZING AREA |
|                  |               |              | 0,507         | 2,737        |

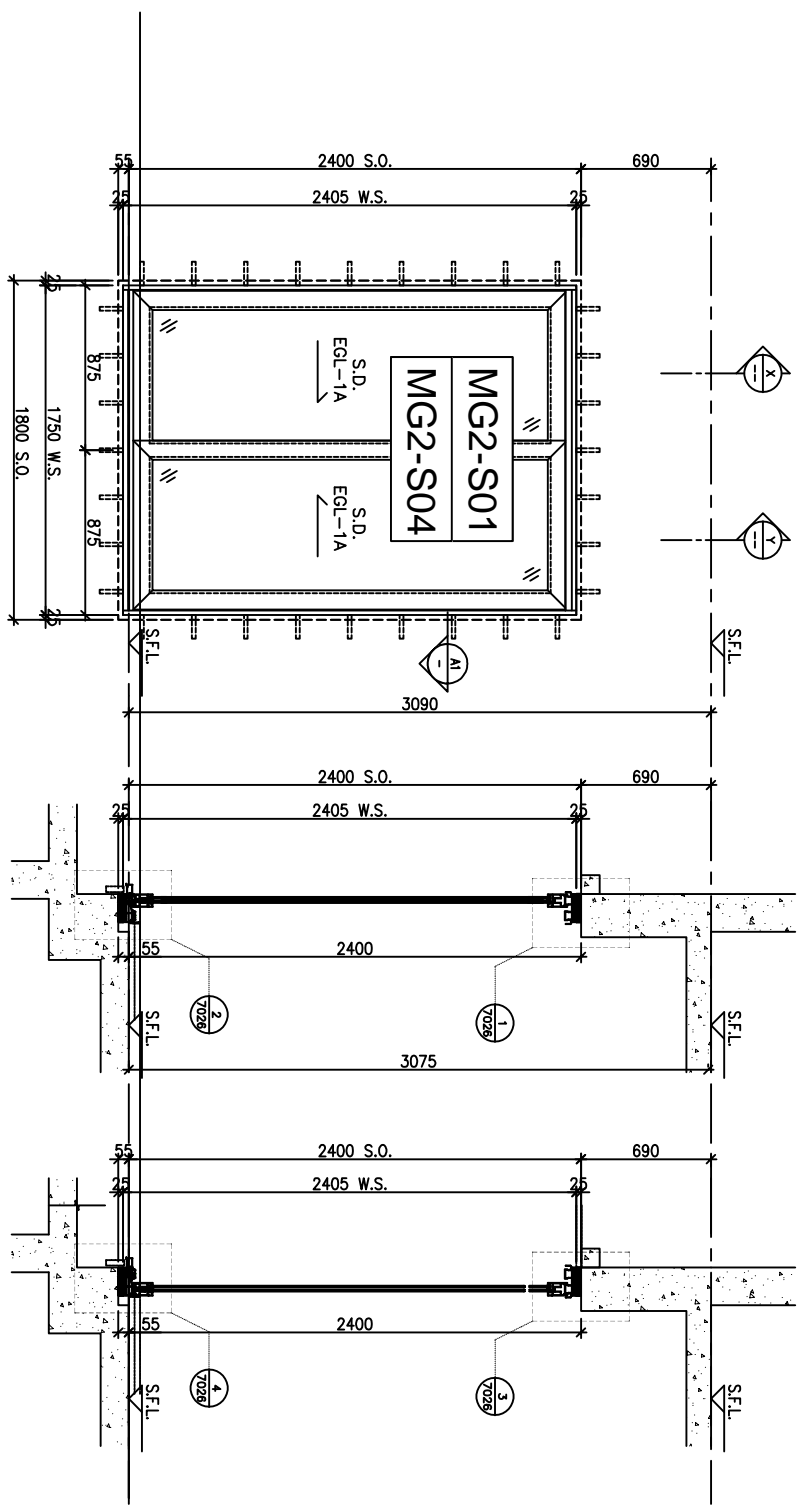


ELEVATION

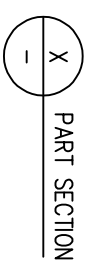


PART SECTION



PART SECTION

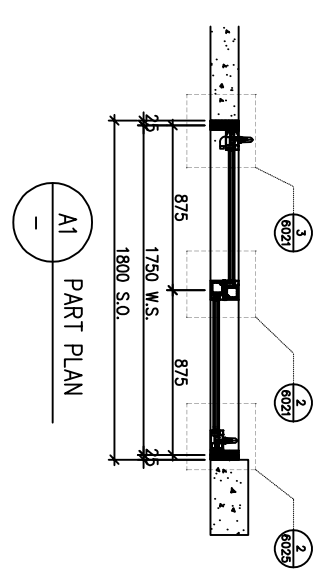

PART PLAN

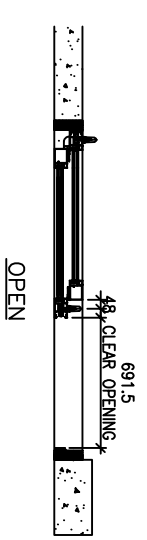

OPEN

|             |                                |
|-------------|--------------------------------|
| WINDOW MARK | AW-18                          |
| LOCATION    | 46/F UNIT SIMPLEX 2A LIV./DIN. |
| SECTION     | 70mm ALUM. SECTION             |
| GLAZING     | EGL-1A                         |
| QUANTITY    | 1 NO.                          |
| REMARKS     | SIEGENIA SLIDING DOOR SYSTEM   |

B.D. REF. :

CLIENT : SUN HUNG KAI REAL ESTATE AGENCY LTD.

ARCHITECT : Iwk&partners

MAIN CONTRACTOR : 怡輝建築有限公司 Yee Fai Building Contractors Ltd.

STRUCTURAL ENGINEER : ARUP ALPHA CONSULTING LIMITED Steel Structure & Façade Specialist

NOTE : 1. ALL DIMENSIONS ARE IN mm. 2. ALL ELEVATIONS ARE VIEWED FROM OUTSIDE. 3. ALL DIMENSIONS TO BE VERIFIED ON SITE BEFORE FABRICATION.

LEGEND : (X1) DETAIL MARK NO. (X001) REFER SHEET NO.

1. F.F.L. -- FINISHED FLOOR LEVEL  
2. S.F.L. -- STRUCTURAL FLOOR LEVEL  
3. (R) -- REVERSED DETAIL  
4. GLASS LEGEND  
EGL-1 -- 8mmHS+12mm AIR GAP+10mmTP THK. LGU.  
EGL-2 -- 10mm THK. CRYSTAL GRAY TEMPERED GLASS  
EGL-4 -- 10mm THK. CRYSTAL TEMPERED ADD ETCHED GLASS  
EGL-1A -- 8mmHS+12mm AIR GAP+8mmTP THK. LGU.  
BT1/BB1 -- FIXING DETAIL (DWG. NO. FD01)  
BB2 -- FIXING DETAIL (DWG. NO. FD02)

OPENABLE AREA  
GLAZING AREA

|     |            |                                  |      |
|-----|------------|----------------------------------|------|
| NO. | DATE       | REVISION SUBJECT TO ARCH/COMMENT | BY   |
| A   | 30/01/2023 | REVISION SUBJECT TO ARCH/COMMENT | IVON |


JOB NO. : J-856  
PROJECT : PROPOSED DEVELOPMENT ABOVE LIGHT RAIL TIN WING STOP, TSWL NO.23, AREA 33, TIN SHUI WAI, N.T.  
TITLE : WINDOW SCHEDULE FOR TOWER 1 IN-SITU WINDOW

DATE : 02-Aug-21 SCALE : 1:40  
DRAWN BY : IVON CHECKED BY :


美特鋁質有限公司 MIDALUMINIUM FABRICATOR LTD.  
Units 6-8, Sunray Industrial Centre, 1/F, 610 Che Kwo Ling Road, Kowloon  
Tel: 23489211-4 Fax: (852) 2727666  
DWG NO. : J856-SD-W-5152 REV. : B

|                  |               |              |               |              |
|------------------|---------------|--------------|---------------|--------------|
| LOCATION         | OPENABLE AREA | GLAZING AREA | OPENABLE AREA | GLAZING AREA |
| SIM. 2A LIV./DIN | 0.713         | 1.141        | 2.094         | 5.755        |

PROVIDED

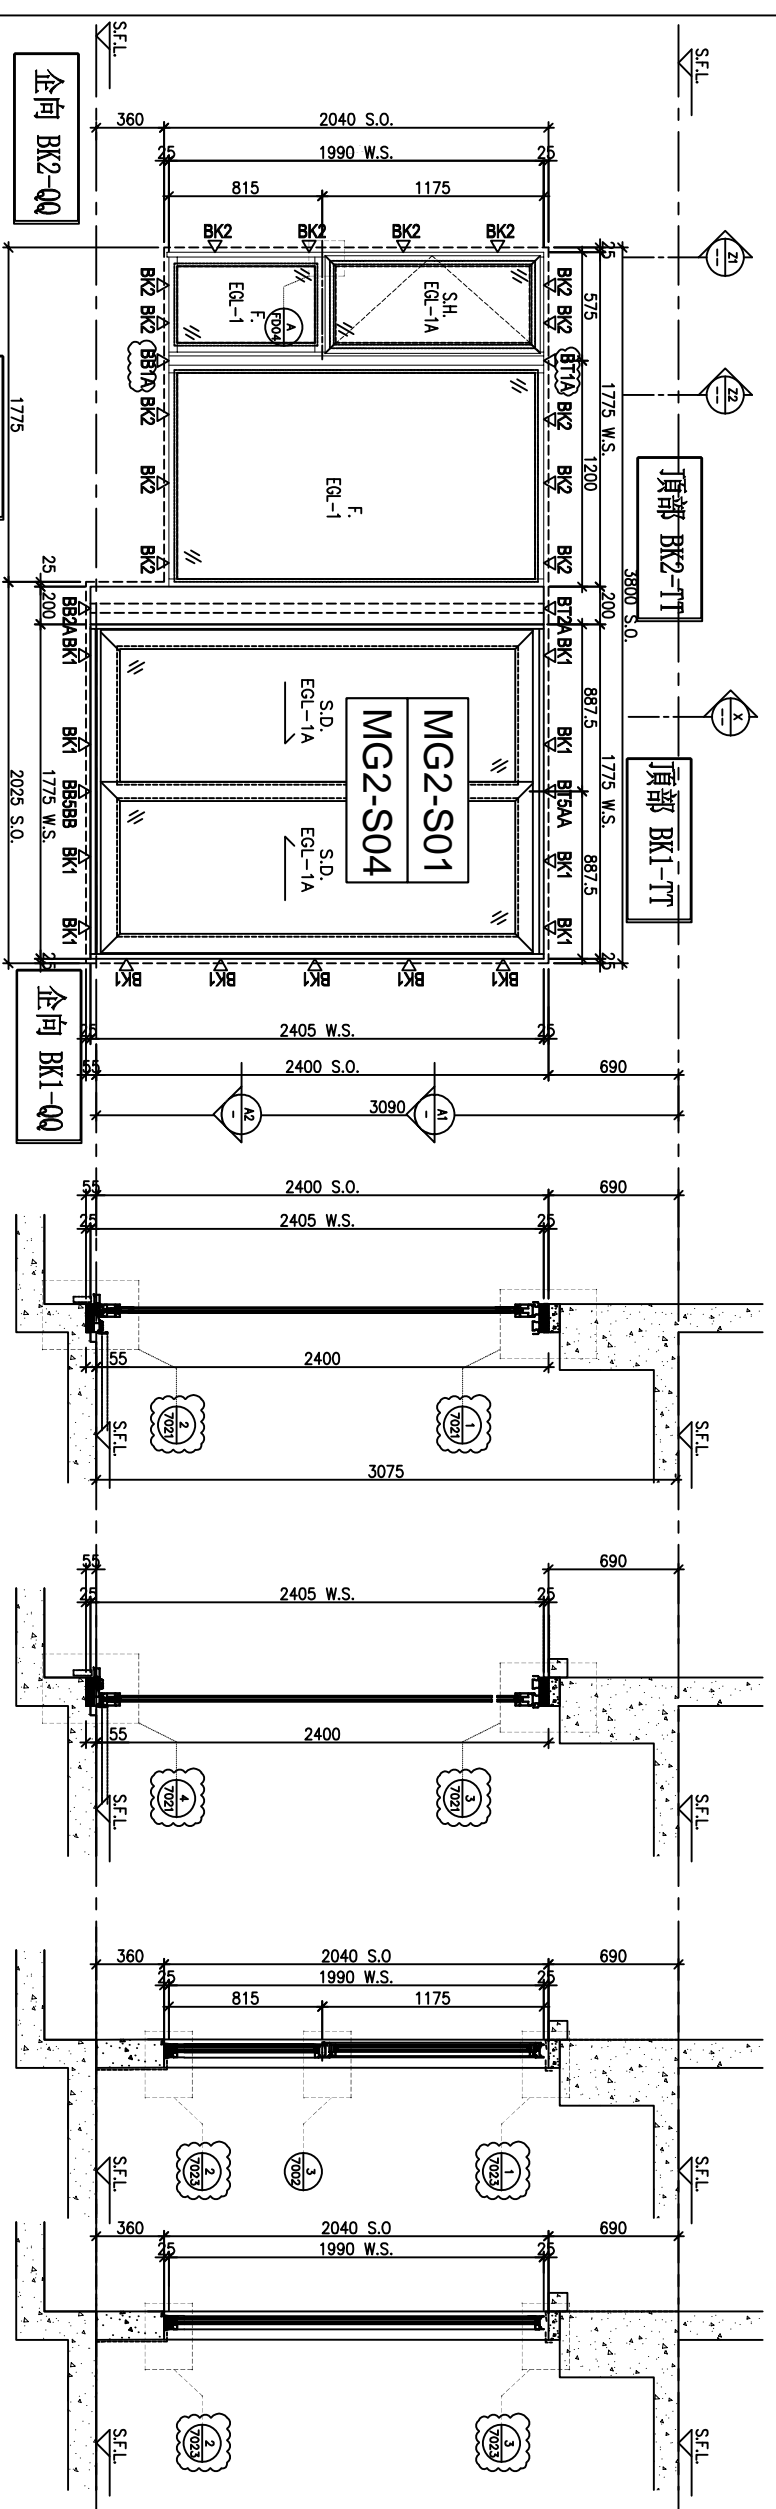

ELEVATION

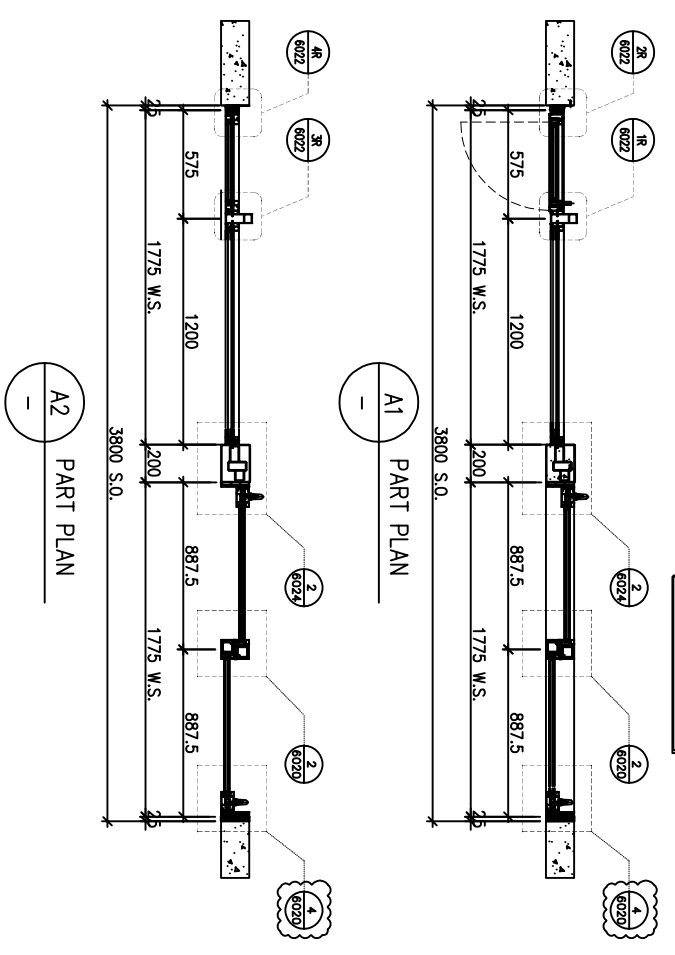

A2 PART PLAN

A1 PART PLAN

X PART SECTION

Y PART SECTION

Z1 PART SECTION

Z2 PART SECTION

|             |                          |
|-------------|--------------------------|
| WINDOW MARK | AW 103                   |
| LOCATION    | 46/F UNIT SIMPLEX 2A MBR |
| SECTION     | 70mm ALUM. SECTION       |
| GLAZING     | EGL-1 & EGL-1A           |
| QUANTITY    | 1 NO.                    |
| REMARKS     |                          |

B.D. REF :

CLIENT :  
**SUN HUNG KAI**  
 REAL ESTATE AGENCY LTD.  
 42/F SUN HUNG KAI CENTRE, WANCHAI, HONGKONG

ARCHITECT :  
**IWK&partners**  
 ARCHITECTS

MAIN CONTRACTOR :  
**怡輝建築有限公司**  
 Yee Fai Building Contractors Ltd.

STRUCTURAL ENGINEER :  
**ARUP**  
 ALPHA CONSULTING LIMITED  
 Steel Structure & Facade Specialist

NOTE :  
 1. ALL DIMENSIONS ARE IN mm.  
 2. ALL ELEVATIONS ARE VIEWED FROM OUTSIDE.  
 3. ALL DIMENSIONS TO BE VERIFIED ON SITE BEFORE FABRICATION.

- LEGEND :
- (X1) --- DETAIL MARK NO.
  - (X001) --- REFER SHEET NO.
  - 1. F.F.L. --- FINISHED FLOOR LEVEL
  - 2. S.F.L. --- STRUCTURAL FLOOR LEVEL
  - 3. (R) --- REVERSED DETAIL
  - 4. GLASS LEGEND

- EGL-1 --- 6mmHS+12mm AIR GAP+10mmTP THK. LGLU
  - EGL-2 --- 10mm THK. CRISTAL GRAY TEMPERED GLASS
  - EQ-4 --- 10mm THK. CRISTAL GRAY TEMPERED GLASS
  - EGL-1A --- 6mmHS+12mm AIR GAP+8mmTP THK. LGLU
  - BT1/BB1 --- FIXING DETAIL (DWG. NO. FD01)
  - BB2 --- FIXING DETAIL (DWG. NO. FD02)
- GLAZING AREA
- OPENABLE AREA
- 6001 TO 6011 & 7001 TO 7008A DETAILS REFER TO 3-45F IN-SITU WINDOW SCHEDULE

| NO. | DATE       | REVISION SUBJECT TO ARCH/COMMENT | BY |
|-----|------------|----------------------------------|----|
| A   | 30/01/2023 | REVISION SUBJECT TO ARCH/COMMENT | WY |

JOB NO. : J-856

PROJECT : PROPOSED DEVELOPMENT ABOVE LIGHT RAIL TIN WING STOP/ISWTL NO.23,AREA 33,TIN SHUI WAI, N.T.

TITLE : WINDOW SCHEDULE FOR TOWER 1 IN-SITU WINDOW

DATE : 02-Aug-21

SCALE : 1:40

DRAWN BY : IYVN


CHECKED BY :

美特鋁質有限公司  
 MIDY ALUMINIUM FABRICATOR LTD.  
 Units 6-8, Sunray Industrial Centre, 1/F  
 610 Che Kwo Ling Road, Kowloon  
 Tel:23489211-4 Fax:(852)2727666

DWG NO. : J856-SD-W-5153

REV : A


| PROVIDED     |               |              |              |
|--------------|---------------|--------------|--------------|
| LOCATION     | OPENABLE AREA | GLAZING AREA | GLAZING AREA |
| SIM. 1A MBR. | 0.874         | 1.398        | 1.559        |
| SIM. 1B MBR. | 0.784         | 1.254        | 2.908        |

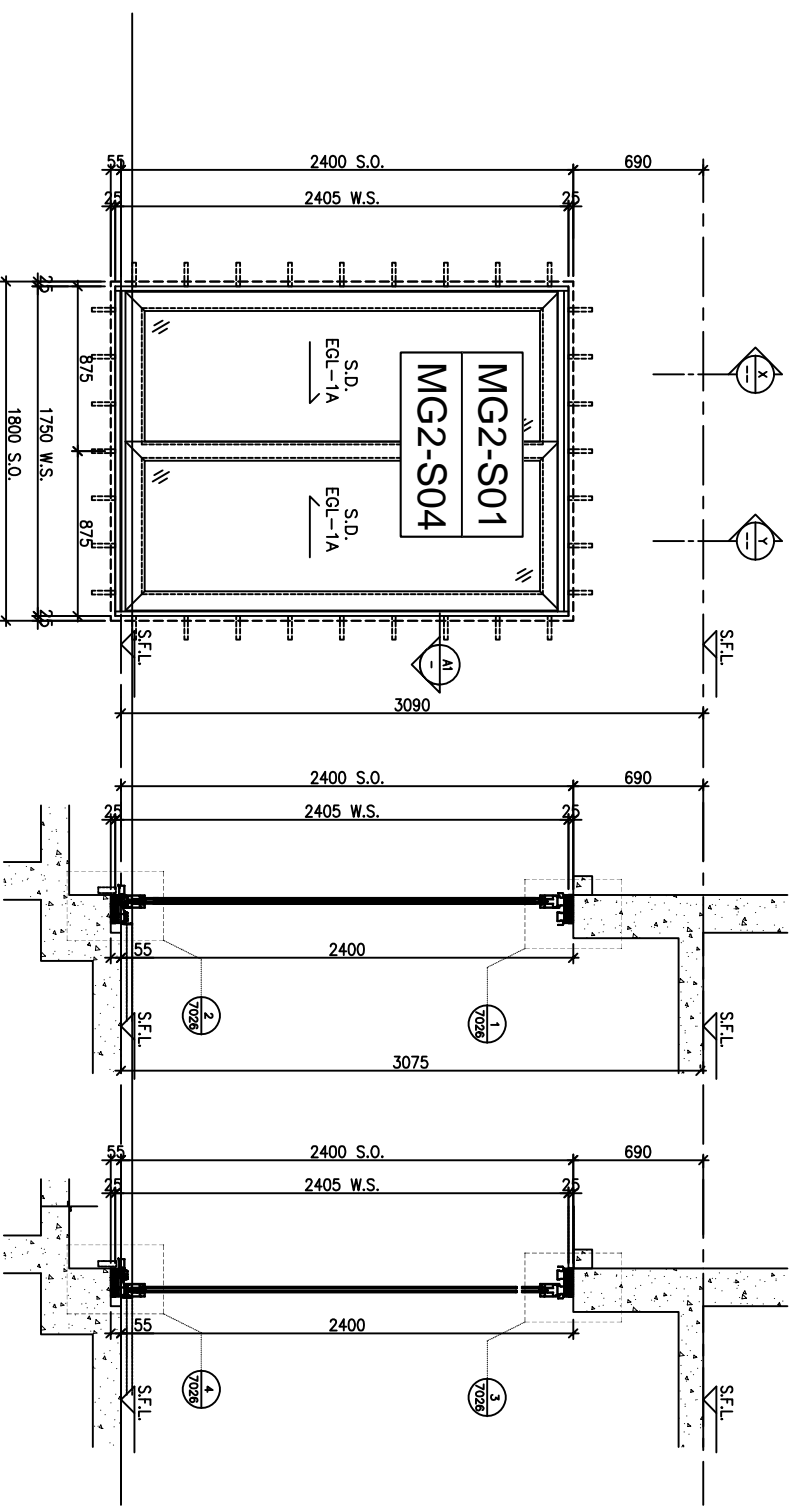


ELEVATION

PART SECTION X-X

PART SECTION Y-Y

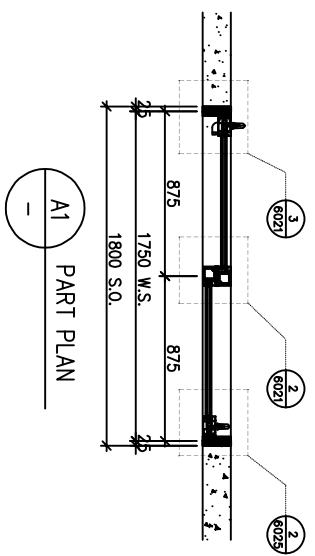

PART PLAN A1-A1

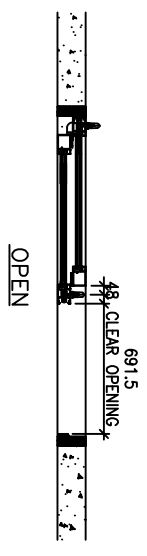

OPEN

|             |  |
|-------------|--|
| WINDOW MARK | AW 1B                                      |
| LOCATION    | 46/F UNIT SIMPLEX 1A MBR., SIMPLEX 1B MBR. |
| SECTION     | 70mm ALUM. SECTION                         |
| GLAZING     | EGL-1A                                     |
| QUANTITY    | 2 NOS.                                     |
| REMARKS     | SIEGENIA SLIDING DOOR SYSTEM               |

B.D. REF :

CLIENT :

SUN HUNG KAI REAL ESTATE AGENCY LTD.  
42/F SUN HUNG KAI CENTRE, WANCHAI, HONGKONG

ARCHITECT :

IWK&partners  
B F C H I L O G I S

MAIN CONTRACTOR :

怡輝建築有限公司  
Yee Fai Building Contractors Ltd.

STRUCTURAL ENGINEER :

ARUP  
ALPHA CONSULTING LIMITED  
Steel Structure & Façade Specialist

NOTE :

1. ALL DIMENSIONS ARE IN mm.
2. ALL ELEVATIONS ARE VIEWED FROM OUTSIDE.
3. ALL DIMENSIONS TO BE VERIFIED ON SITE BEFORE FABRICATION.

LEGEND :

- (X1) DETAIL MARK NO.
- (X001) REFER SHEET NO.
- 1. F.F.L. -- FINISHED FLOOR LEVEL
- 2. S.F.L. -- STRUCTURAL FLOOR LEVEL
- 3. (R) -- REVERSED DETAIL
- 4. GLASS LEGEND

EGL-1 -- 6mmHS+12mm AIR GAP+10mmTP THK. LGU.  
EGL-2 -- 10mm THK. CRYSTAL GRAY TEMPERED GLASS  
EGL-4 -- 10mm THK. CRYSTAL TEMPERED ADD ETCHED GLASS  
EGL-1A -- 6mmHS+12mm AIR GAP+8mmTP THK. LGU.  
BT1/BB1 -- FIXING DETAIL (DWG. NO. FD01)  
BB2 -- FIXING DETAIL (DWG. NO. FD02)

GLAZING AREA  
OPENABLE AREA

6001 TO 6011 & 7001 TO 7008A DETAILS REFER TO 3-45F IN-SITU WINDOW SCHEDULE

| NO. | DATE       | REVISION SUBJECT TO ARCH/COMMENT | BY  |
|-----|------------|----------------------------------|-----|
| A   | 30/01/2023 | REVISION SUBJECT TO ARCH/COMMENT | WYK |


JOB NO. : J-856  
PROJECT : PROPOSED DEVELOPMENT ABOVE LIGHT RAIL TIN WING STOP, ISWLL NO.23, AREA 33, TIN SHUI WAI, N.T.

TITLE : WINDOW SCHEDULE FOR TOWER 1 IN-SITU WINDOW

DATE : 02-Aug-21  
SCALE : 1:40  
DRAWN BY : IYVN  
CHECKED BY :

美特鋁質有限公司  
MIDI ALUMINIUM FABRICATOR LTD.  
Units 6-8, Sunray Industrial Centre, 1/F  
610 Che Kwo Ling Road, Kowloon  
Tel: 23489211-4 Fax: (852) 27276666  
DWG NO. : J856-SD-W-5155 REV : B

| REQUIRE           |               | PROVIDED     |               |              |
|-------------------|---------------|--------------|---------------|--------------|
| LOCATION          | OPENABLE AREA | GLAZING AREA | OPENABLE AREA | GLAZING AREA |
| SIM. 1B LIV./DIN. | 1.895         | 3.033        | 2.236         | 4.167        |

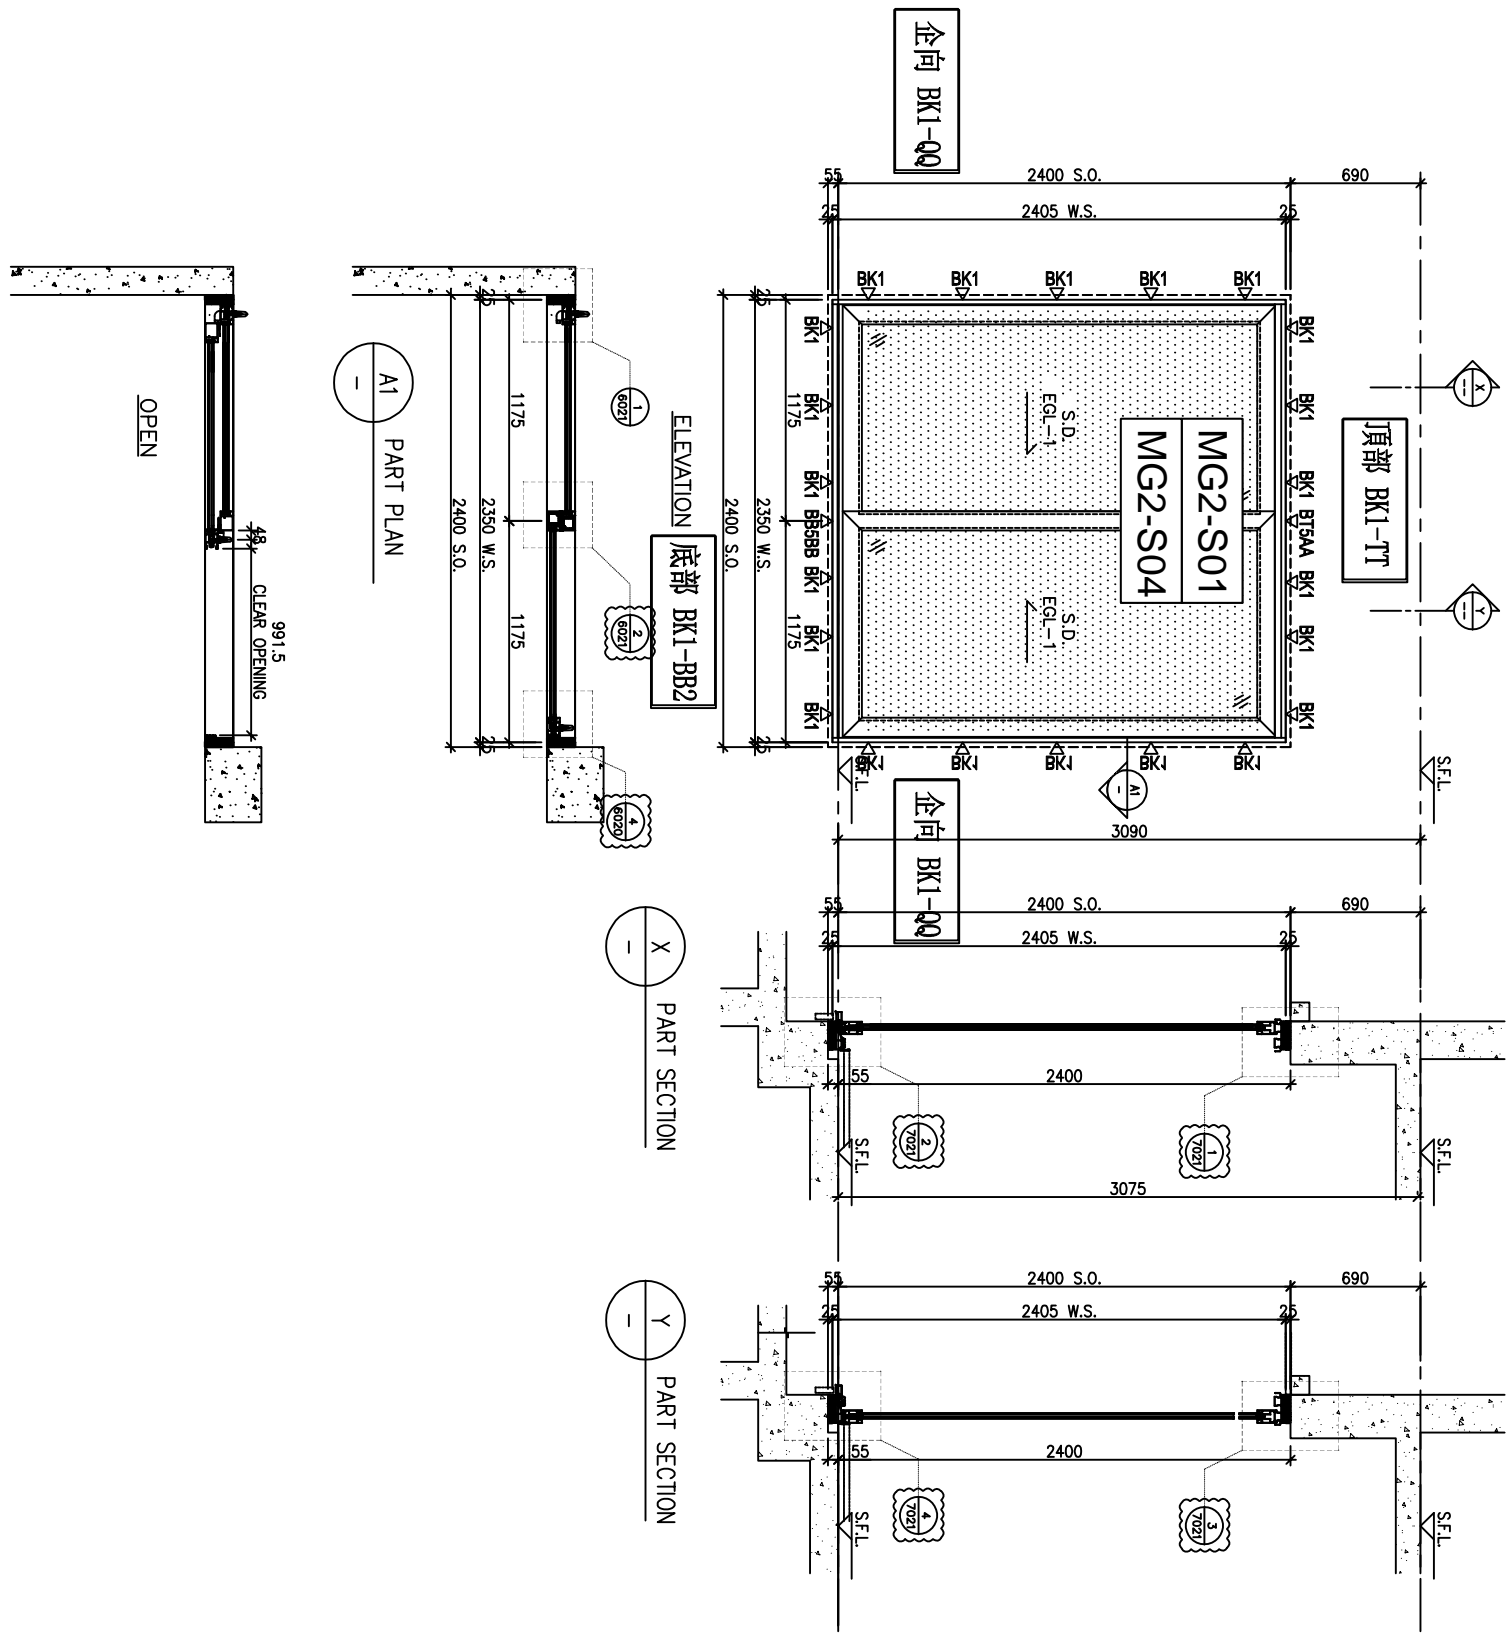

|             |                                |
|-------------|--------------------------------|
| WINDOW MARK | AM<br>105                      |
| LOCATION    | 46/F UNIT SIMPLEX 1B LIV./DIN. |
| SECTION     | 70mm ALUM. SECTION             |
| GLAZING     | EGL-1A                         |
| QUANTITY    | 1 NO.                          |
| REMARKS     | SIEGENIA SLIDING DOOR SYSTEM   |

B.D. REF :

CLIENT :

**SUN HUNG KAI**  
REAL ESTATE AGENCY LTD.  
42/F SUN HUNG KAI CENTRE, WANCHAU, HONGKONG

ARCHITECT :

**IWK&partners**  
ARCHITECTS

MAIN CONTRACTOR :

**怡輝建築有限公司**  
Yee Fai Building Contractors Ltd.

STRUCTURAL ENGINEER :

**ARUP**  
ALPHA CONSULTING LIMITED  
Steel Structure & Façade Specialist

FAÇADE CONSULTANT :

**a**  
ALPHA CONSULTING LIMITED  
Steel Structure & Façade Specialist

NOTE :

1. ALL DIMENSIONS ARE IN mm.
2. ALL ELEVATIONS ARE VIEWED FROM OUTSIDE.
3. ALL DIMENSIONS TO BE VERIFIED ON SITE BEFORE FABRICATION.

LEGEND :

- (X1) DETAIL MARK NO.
- (X001) REFER SHEET NO.

1. F.F.L. -- FINISHED FLOOR LEVEL
2. S.F.L. -- STRUCTURAL FLOOR LEVEL
3. (R) -- REVERSED DETAIL
4. GLASS LEGEND

EGL-1--8mmH5+12mm AIR GAP+10mmTP THK. LGU.  
EGL-2--10mm THK. CRYSTAL GRAY TEMPERED GLASS  
EGL-4--10mm THK. CRYSTAL TEMPERED ADD ETCHED GLASS  
EGL-1A--8mmH5+12mm AIR GAP+8mmTP THK. LGU.  
BT1/BB1--FIXING DETAIL (DWG. NO. FD01)  
BB2--FIXING DETAIL (DWG. NO. FD02)

OPENABLE AREA  
GLAZING AREA


6001 TO 6011 & 7001 TO 7008A DETAILS REFER TO 3-45F IN-SITU WINDOW SCHEDULE

| NO. | DATE       | REVISION SUBJECT TO ARCH/COMMENT REVISION | BY |
|-----|------------|---|----|
| A   | 30/01/2023 | REVISION SUBJECT TO ARCH/COMMENT          | WY |


JOB NO. : J-856  
DRAWN BY : IYVN  
CHECKED BY :  
DATE : 02-Aug-21  
SCALE : 1:40  
PROJECT : PROPOSED DEVELOPMENT ABOVE LIGHT RAIL TIN WING STOP, TSWLL NO.23, AREA 33, TIN SHUI WAI, N.T.  
TITLE : WINDOW SCHEDULE FOR TOWER 1 IN-SITU WINDOW  
Dwg No. : J856-SD-W-5156  
REV : A

**美特鋁質有限公司**  
MIDI ALUMINIUM FABRICATOR LTD.  
Units 6-8, Sunray Industrial Centre, 1/F  
610 Che Kwo Ling Road, Kowloon  
Tel: 23489211-4 Fax: (852) 2727666


| REQUIRE           |               | PROVIDED     |               |              |
|-------------------|---------------|--------------|---------------|--------------|
| LOCATION          | OPENABLE AREA | GLAZING AREA | OPENABLE AREA | GLAZING AREA |
| SIM. 1A LIV./DIN. | { 1.924 }     | { 3.079 }    | 1.559         | 2.908        |
| SIM. 1A MBR.      | { 0.874 }     | { 1.398 }    |               |              |
| SIM. 1B MBR.      | { 0.784 }     | { 1.254 }    |               |              |

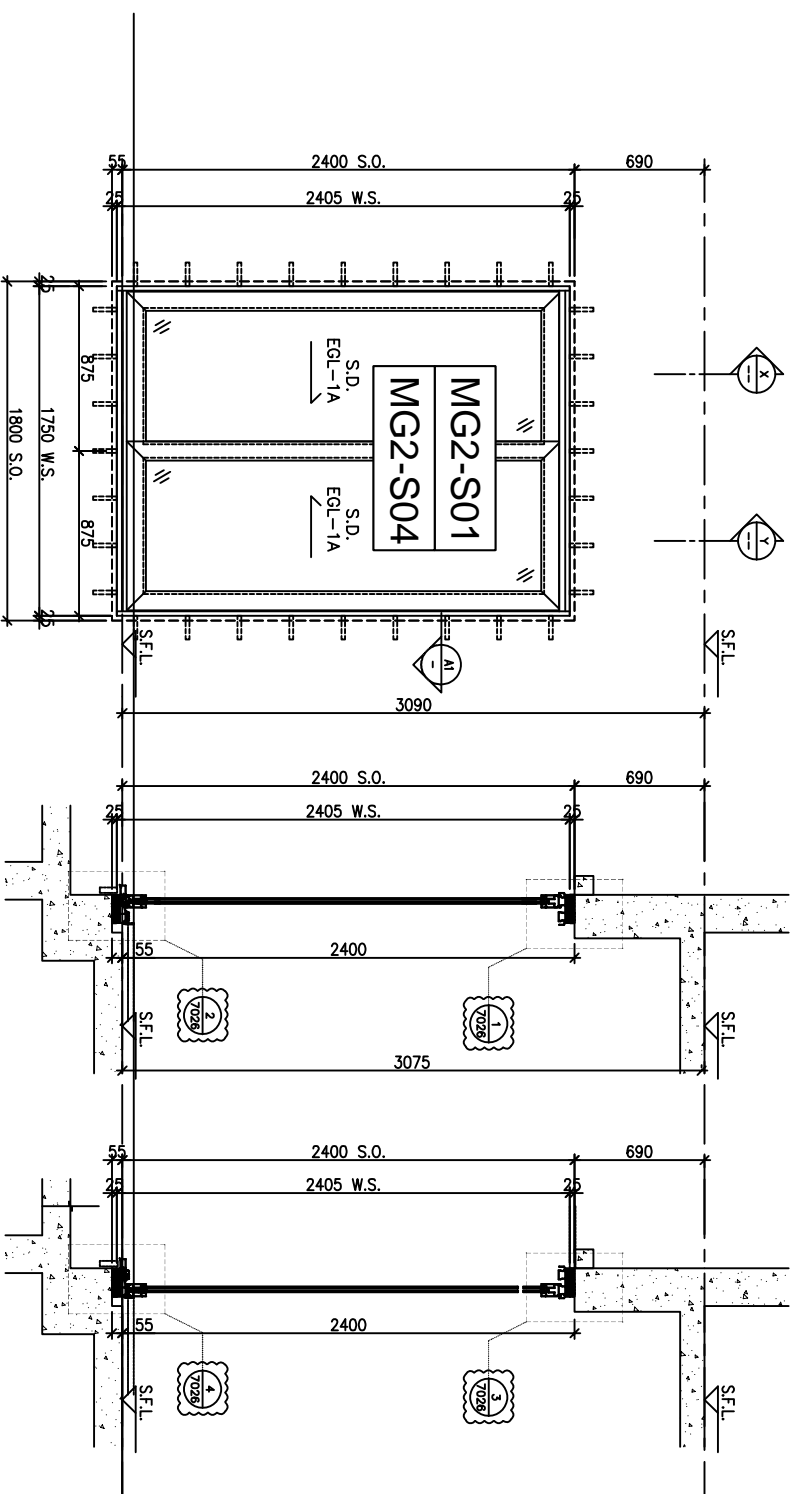


ELEVATION

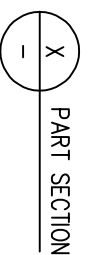


PART SECTION

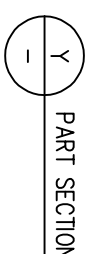

PART SECTION

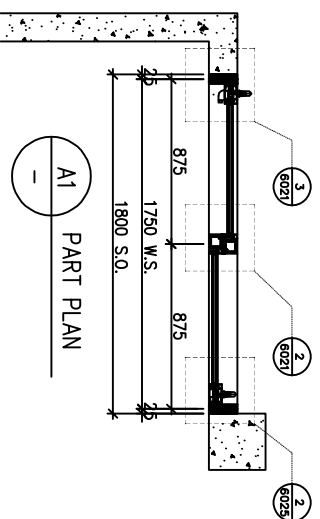

PART PLAN

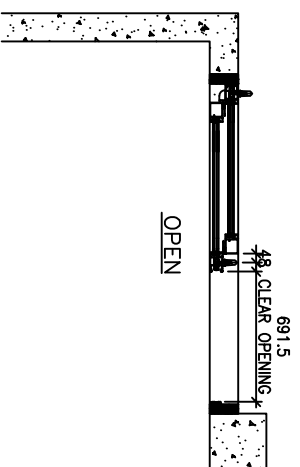

OPEN

|             |  |
|-------------|--|
| WINDOW MARK | AW 1B  |
| LOCATION    | 46/F UNIT SIMPLEX 1A LIV./DIN. & {MBR}, {SIMPLEX 1B MBR} |
| SECTION     | 70mm ALUM. SECTION                                       |
| GLAZING     | EGL-1A   |
| QUANTITY    | { 3 NOS. }   |
| REMARKS     | SIEGENIA SLIDING DOOR SYSTEM                             |

B.D. REF :

CLIENT :

SUN HUNG KAI  
REAL ESTATE AGENCY LTD.  
42/F SUN HUNG KAI CENTRE, MANOUL, HONGKONG

ARCHITECT :

IWK&partners  
ARCHITECTS

MAIN CONTRACTOR :

怡輝建築有限公司  
Yee Fai Building Contractors Ltd.

STRUCTURAL ENGINEER :

ARUP

FAÇADE CONSULTANT :

ALPHA CONSULTING LIMITED  
Steel Structure & Façade Specialist

NOTE :

1. ALL DIMENSIONS ARE IN MM.
2. ALL ELEVATIONS ARE VIEWED FROM OUTSIDE.
3. ALL DIMENSIONS TO BE VERIFIED ON SITE BEFORE FABRICATION.

LEGEND :

(X1) DETAIL MARK NO.  
(X001) REFER SHEET NO.

1. F.F.L. -- FINISHED FLOOR LEVEL
2. S.F.L. -- STRUCTURAL FLOOR LEVEL
3. (R) -- REVERSED DETAIL

4. GLASS LEGEND

EGL-1 -- 6mmH5+12mm AIR GAP+10mmTP THK. LGU.

EGL-2 -- 10mm THK. CRYSTAL GRAY TEMPERED GLASS

EQ-4 -- 10mm THK. CRYSTAL TEMPERED ADD ETCHED GLASS

EGL-1A -- 6mmH5+12mm AIR GAP+8mmTP THK. LGU.

BT1/BB1 -- FLYING DETAIL (DWG. NO. FD01)

BB2 -- FIXING DETAIL (DWG. NO. FD02)

GLAZING AREA

OPENABLE AREA

6001 TO 6011 & 7001 TO 7008A DETAILS REFER TO 3-45F IN-SITU WINDOW SCHEDULE

REVISION

DATE

BY

REVISION

DATE

BY

JOB NO. : J-856  
PROJECT : PROPOSED DEVELOPMENT ABOVE LIGHT RAIL TIN WING STOP, ISWTL NO.23, AREA 33, TIN SHUI WAI, N.T.  
TITLE : WINDOW SCHEDULE FOR TOWER 2 IN-SITU WINDOW  
DATE : 02-Aug-21 SCALE : 1:40  
DRAWN BY : IYVN CHECKED BY :  
MIDI ALUMINUM FABRICATOR LTD.  
Units 6-8, Sunray Industrial Centre, 1/F  
610 Che Kwo Ling Road, Kowloon  
Tel: 23489211-4 Fax: (852) 2727666  
DWG NO. : J856-SD-W-5251 REV : D

|                  |               |              |               |              |               |              |               |              |
|------------------|---------------|--------------|---------------|--------------|---------------|--------------|---------------|--------------|
| LOCATION         | OPENABLE AREA | GLAZING AREA | OPENABLE AREA | GLAZING AREA | OPENABLE AREA | GLAZING AREA | OPENABLE AREA | GLAZING AREA |
| SIM. 2B LIV./DIN | {1.463}       | {2.340}      | 1.559         | 2.908        | 1.587         | 1.123        | 0.507         | 2.405        |


|         |                  |                |                  |
|---------|------------------|----------------|------------------|
| REQUIRE | (AW-18) PROVIDED | AW-10 PROVIDED | AW-14&R PROVIDED |
|---------|------------------|----------------|------------------|

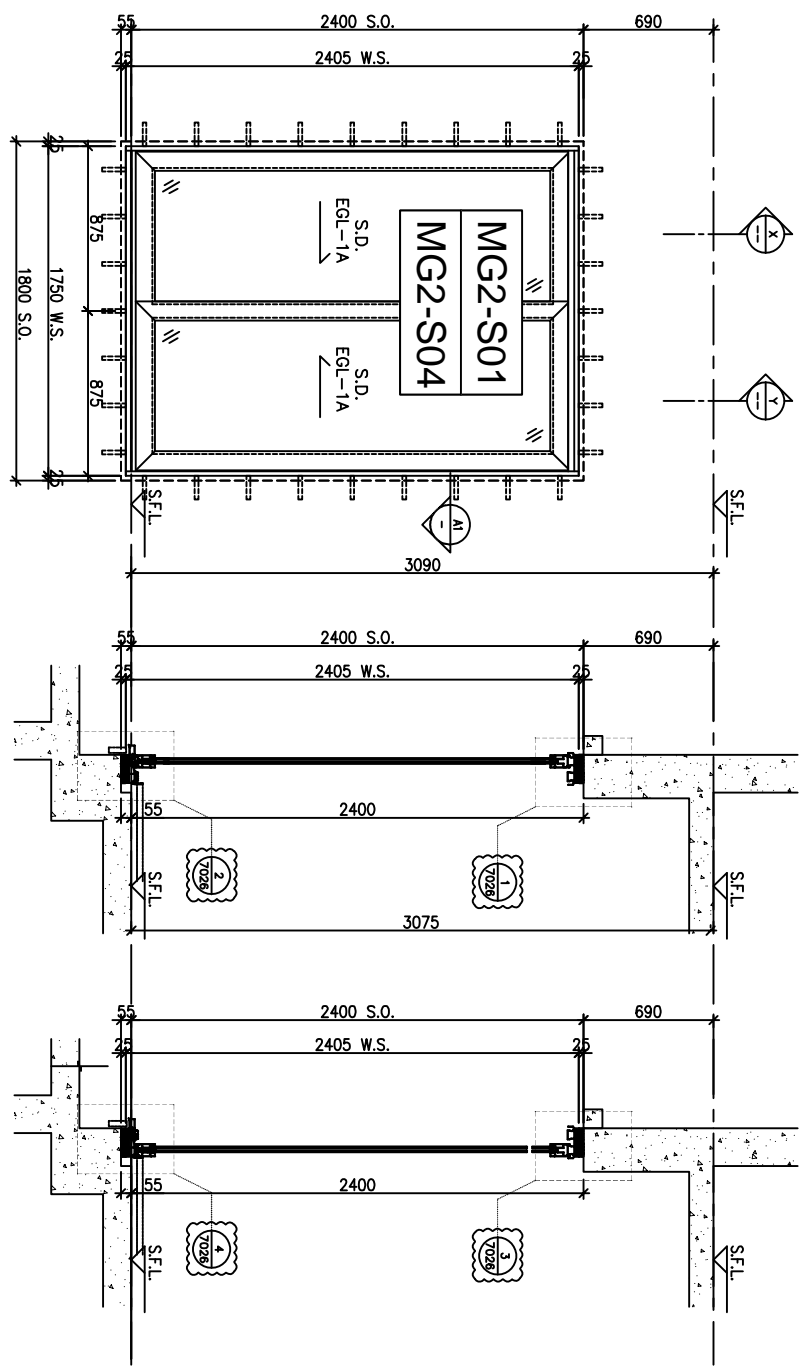


ELEVATION

X-X PART SECTION

Y-Y PART SECTION

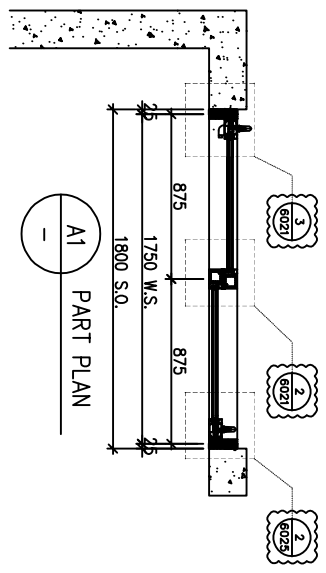

A1 PART PLAN

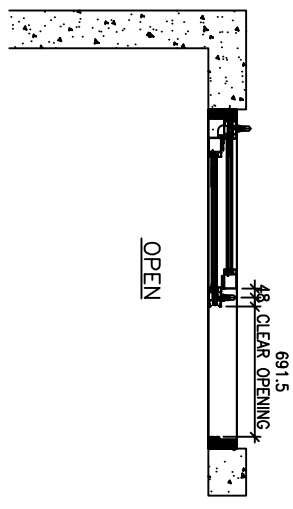

OPEN

|             |                                |
|-------------|--------------------------------|
| WINDOW MARK | AW-18                          |
| LOCATION    | 46/F UNIT SIMPLEX 2B LIV./DIN. |
| SECTION     | 70mm ALUM. SECTION             |
| GLAZING     | EGL-1A                         |
| QUANTITY    | 1 NO.                          |
| REMARKS     | SIEMENIA SLIDING DOOR SYSTEM   |

B.D. REF :

CLIENT :

SUN HUNG KAI  
REAL ESTATE AGENCY LTD.  
42/F SUN HUNG KAI CENTRE, WANCHAI, HONGKONG

ARCHITECT :

IWK&partners  
ARCHITECTS

MAIN CONTRACTOR :

怡輝建築有限公司  
Yee Fai Building Contractors Ltd.

STRUCTURAL ENGINEER :

ARUP  
ALPHA CONSULTING LIMITED  
Steel Structure & Facade Specialist

NOTE :

1. ALL DIMENSIONS ARE IN MM.
2. ALL ELEVATIONS ARE VIEWED FROM OUTSIDE.
3. ALL DIMENSIONS TO BE VERIFIED ON SITE BEFORE FABRICATION.

LEGEND :

- (X1) DETAIL MARK NO.
- (X001) REFER SHEET NO.
- 1. F.F.L. --- FINISHED FLOOR LEVEL
- 2. S.F.L. --- STRUCTURAL FLOOR LEVEL
- 3. (R) --- REVERSED DETAIL
- 4. GLASS LEGEND

EQ1-1 --- 8mmH5+12mm AIR GAP+10mmTP THK. LGU.  
EQ1-2 --- 10mm THK. CRYSTAL GRAY TEMPERED GLASS  
EQ1-4 --- 10mm THK. CRYSTAL GRAY TEMPERED GLASS  
EQ1-1A --- 8mmH5+12mm AIR GAP+8mmTP THK. LGU.  
BT1/BB1 --- FLYING DETAIL (DWG. NO. FD01)  
BB2 --- FIXING DETAIL (DWG. NO. FD02)

GLAZING AREA

OPENABLE AREA

6001 TO 6011 & 7001 TO 7008A DETAILS REFER TO 3-45F IN-SITU WINDOW SCHEDULE

| NO. | DATE       | REVISION                         | BY  |
|-----|------------|----------------------------------|-----|
| E   | 01/09/2023 | REVISION SUBJECT TO ARCH/COMMENT | hwk |
| D   | 29/07/2023 | REVISION SUBJECT TO ARCH/COMMENT | hwk |
| C   | 10/07/2023 | REVISION SUBJECT TO ARCH/COMMENT | hwk |

JOB NO. : J-856  
PROJECT : PROPOSED DEVELOPMENT ABOVE LIGHT RAIL TIN WING STOP, TSWL NO.23, AREA 33, TIN SHUI WAI, N.T.  
TITLE : WINDOW SCHEDULE FOR TOWER 2 IN-SITU WINDOW  
DATE : 02-Aug-21  
SCALE : 1:40  
DRAWN BY : IYVN  
CHECKED BY :  
UNIT 6-8, MIDT ALUMINIUM FABRICATOR LTD.  
610 Che Kwo Ling Road, Kowloon  
Tel: 23489211-4 Fax: (852) 2727666  
DWG NO. : J856-SD-W-5253 REV : E

| LOCATION         | OPENABLE AREA | GLAZING AREA | OPENABLE AREA | GLAZING AREA |
|------------------|---------------|--------------|---------------|--------------|
| SIM. 1B LIV./DIN | (1.895)       | (3.033)      | 2.405         | 4.481        |

B.D. REF :

CLIENT :

SUN HUNG KAI  
REAL ESTATE AGENCY LTD.  
42/F SUN HUNG KAI CENTRE, WANCHAI, HONGKONG

ARCHITECT :  
**IWK&partners**  
A R C H I T E C T S

MAIN CONTRACTOR :  
**怡輝建築有限公司**  
Yee Fai Building Contractors Ltd.

STRUCTURAL ENGINEER :  
**ARUP**

FAÇADE CONSULTANT :  
**a** ALPHA CONSULTING LIMITED  
Steel Structure & Façade Specialist

NOTE :  
1. ALL DIMENSIONS ARE IN MM.  
2. ALL ELEVATIONS ARE VIEWED FROM OUTSIDE.  
3. ALL DIMENSIONS TO BE VERIFIED ON SITE BEFORE FABRICATION.  
LEGEND :  
X1 - DETAIL MARK NO.  
X2001 - REFER SHEET NO.

1. F.F.L. -- FINISHED FLOOR LEVEL  
2. S.F.L. -- STRUCTURAL FLOOR LEVEL  
3. (R) -- REVERSED DETAIL  
4. GLASS LEGEND  
EQ1-1 -- 6mmH5+12mm AIR GAP+10mmTP THK. LGU.  
EQ1-2 -- 10mm THK. CRYSTAL GRAY TEMPERED GLASS  
EQ1-4 -- 10mm THK. CRYSTAL TEMPERED ADD ETCHED GLASS  
EQ1-1A -- 6mmH5+12mm AIR GAP+8mmTP THK. LGU.  
BT1/BB1 -- FIXING DETAIL (DWG. NO. FD01)  
BB2 -- FIXING DETAIL (DWG. NO. FD02)

OPENABLE AREA  
GLAZING AREA


6001 TO 6011 & 7001 TO 7008A DETAILS  
REFER TO 3-45F IN-SITU WINDOW SCHEDULE

JOB NO. : J-856  
PROJECT :  
PROPOSED DEVELOPMENT ABOVE  
LIGHT RAIL TIN WING STOP, ISWTL  
NO.23, AREA 33, TIN SHUI WAI, N.T.

TITLE :  
WINDOW SCHEDULE FOR  
TOWER 2 IN-SITU WINDOW

DATE : 02-Aug-21  
SCALE : 1:40  
DRAWN BY : IYVN  
CHECKED BY :

美特鋁質有限公司  
MIDI ALUMINIUM FABRICATOR LTD.  
Units 6-8, Sunray Industrial Centre, 1/F  
610 Che Kwo Ling Road, Kowloon  
Tel: 23489211-4 Fax: (852) 27276666  
DWG NO. : J856-SD-W-5254 REV : E

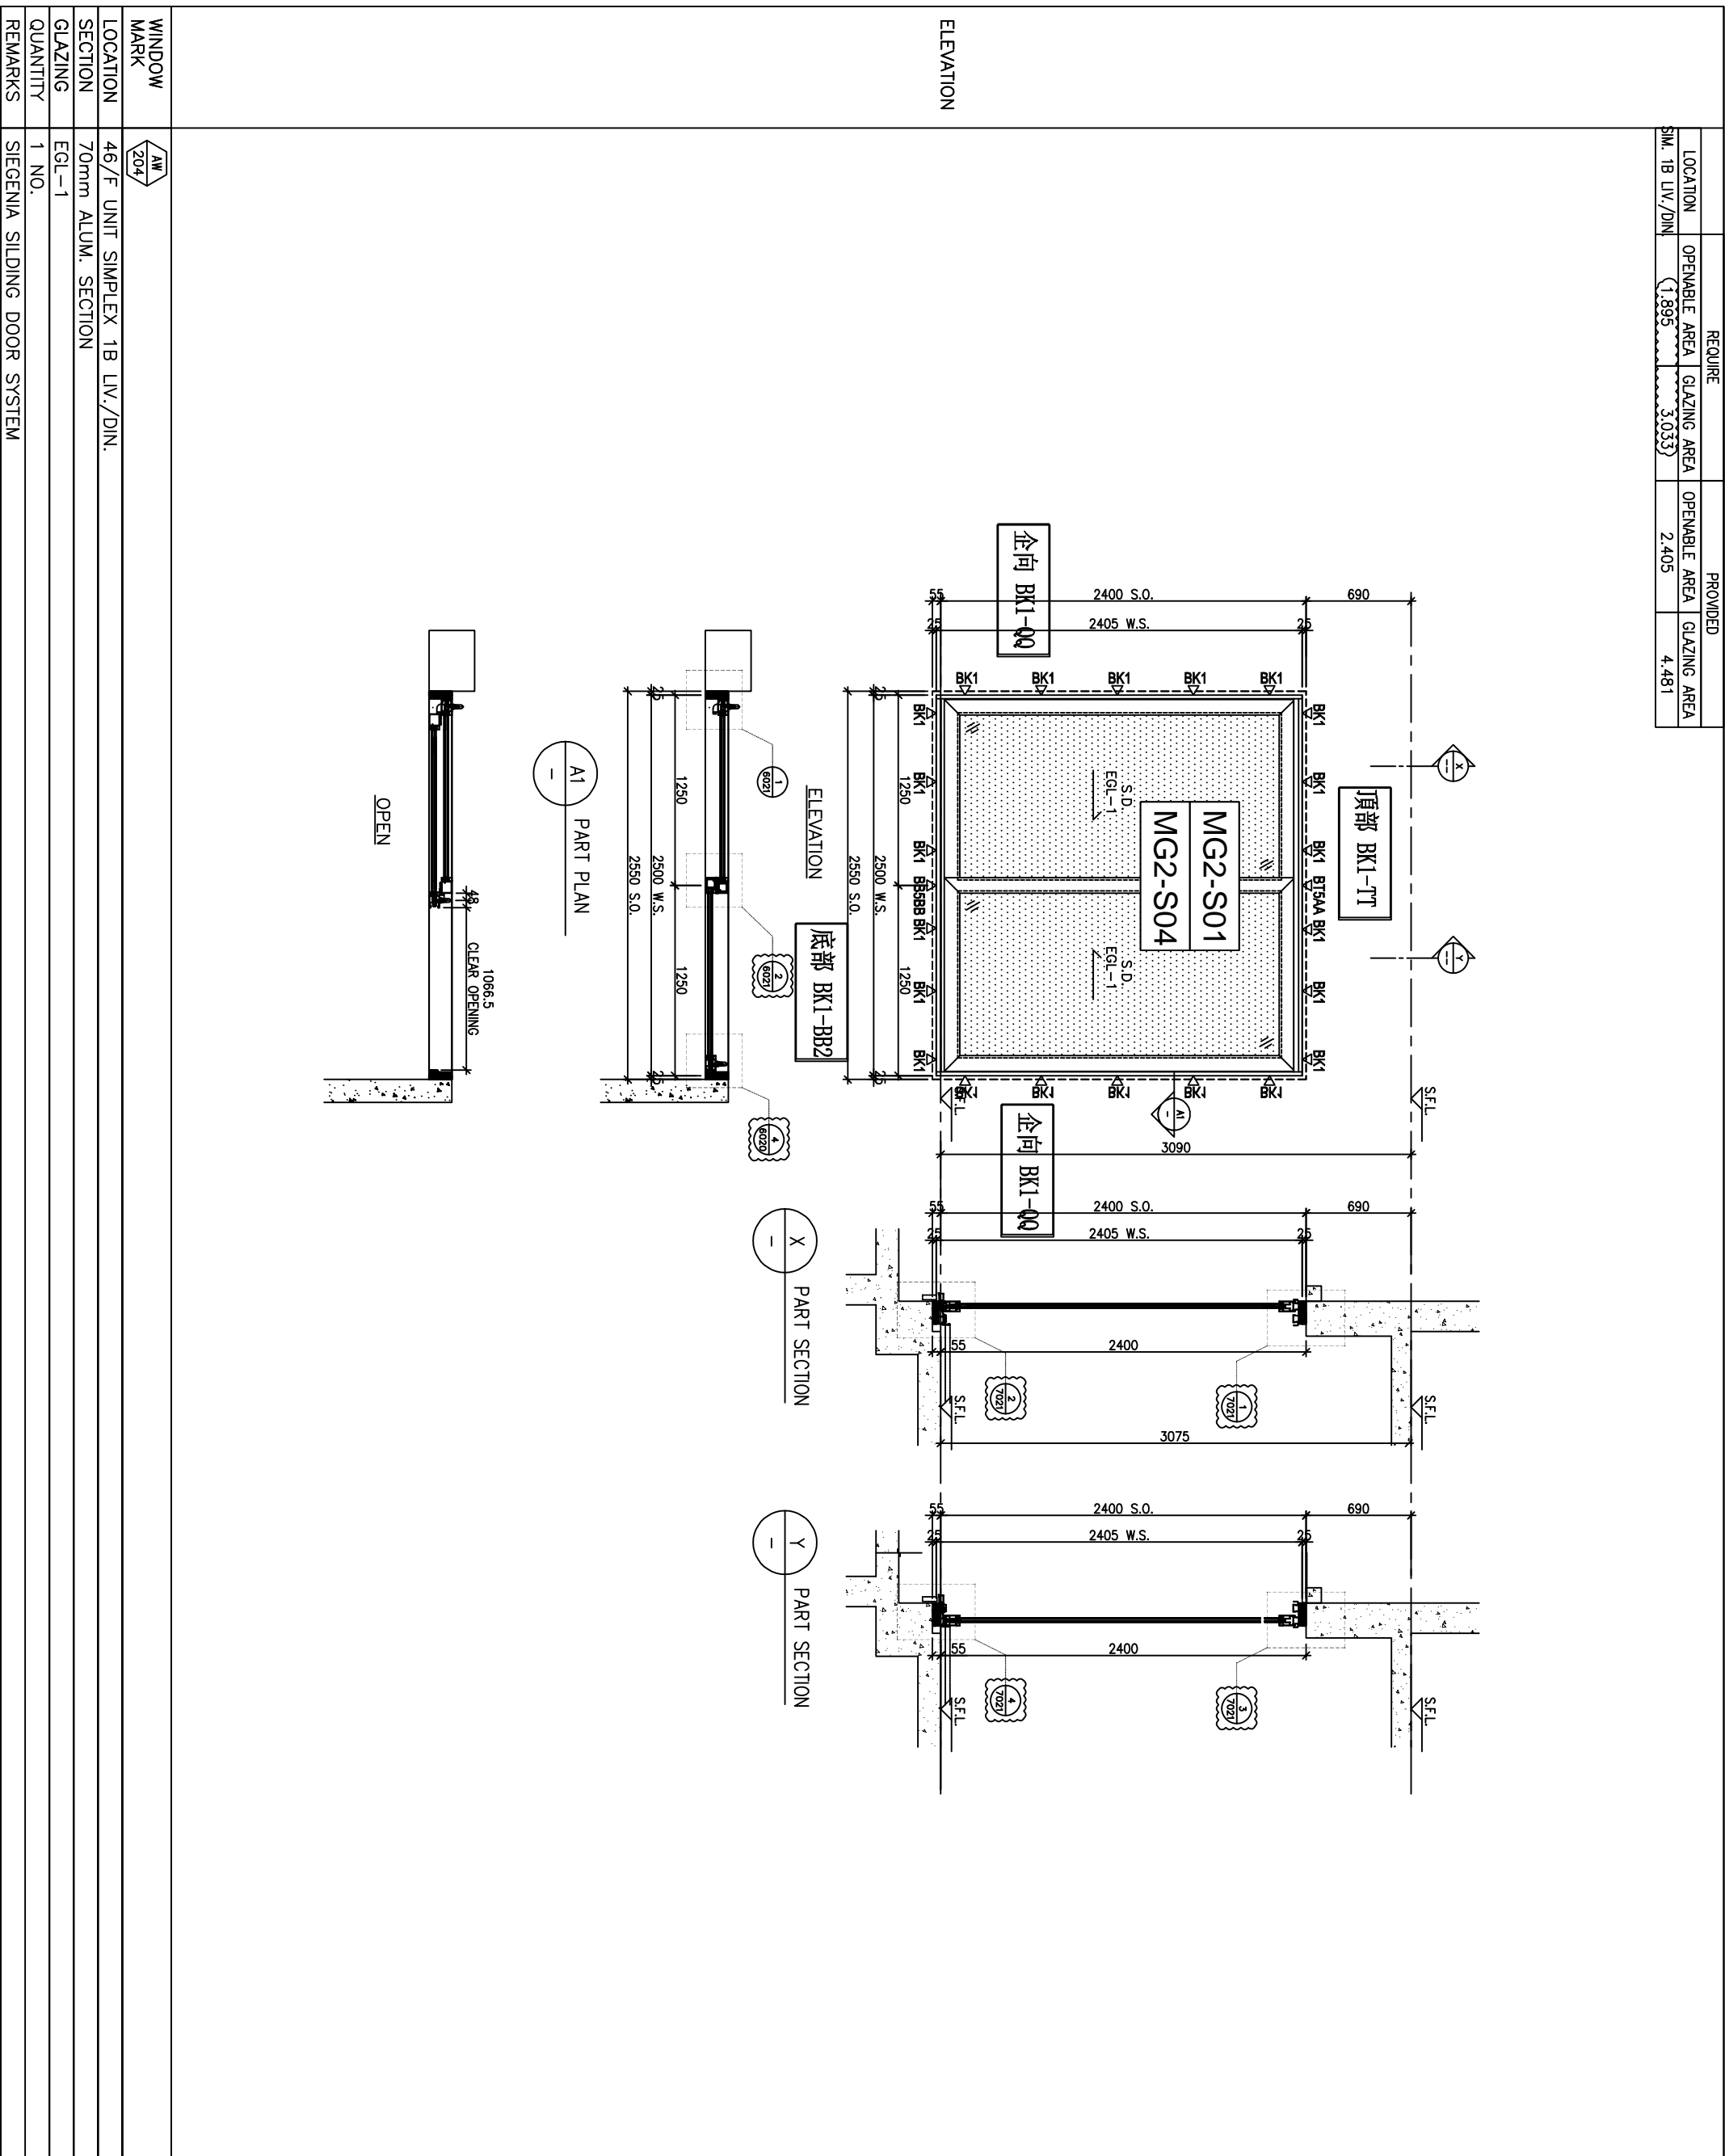

|             |                                |
|-------------|--------------------------------|
| WINDOW MARK | AW<br>204                      |
| LOCATION    | 46/F UNIT SIMPLEX 1B LIV./DIN. |
| SECTION     | 70mm ALUM. SECTION             |
| GLAZING     | EGL-1                          |
| QUANTITY    | 1 NO.                          |
| REMARKS     | SIEGENIA SLIDING DOOR SYSTEM   |





| LOCATION     | OPENABLE AREA | GLAZING AREA | OPENABLE AREA | GLAZING AREA |
|--------------|---------------|--------------|---------------|--------------|
| SIM. 2A MBR. | { 0.577 }     | { 0.923 }    | 1.559         | 2.908        |

B.D. REF :

CLIENT :

**SUN HUNG KAI**  
REAL ESTATE AGENCY LTD.  
42/F SUN HUNG KAI CENTRE, WANCHAI, HONGKONG

ARCHITECT :

**IWK&partners**  
A F C H I L O C I S

MAIN CONTRACTOR :

**怡輝建築有限公司**  
**Yee Fai Building Contractors Ltd.**

STRUCTURAL ENGINEER :

**ARUP**

FAÇADE CONSULTANT :

**a** ALPHA CONSULTING LIMITED  
Steel Structure & Façade Specialist

NOTE :

1. ALL DIMENSIONS ARE IN mm.
2. ALL ELEVATIONS ARE VIEWED FROM OUTSIDE.
3. ALL DIMENSIONS TO BE VERIFIED ON SITE BEFORE FABRICATION.

LEGEND :

(X1) DETAIL MARK NO.  
(X001) REFER SHEET NO.

1. F.F.L. -- FINISHED FLOOR LEVEL
2. S.F.L. -- STRUCTURAL FLOOR LEVEL
3. (R) -- REVERSED DETAIL
4. GLASS LEGEND

EQ1-1 -- 8mmHS+12mm AIR GAP+10mmTP THK. LGU.  
EQ1-2 -- 10mm THK. CRYSTAL GRAY TEMPERED GLASS  
EQ1-4 -- 10mm THK. CRYSTAL GRAY TEMPERED GLASS  
EQ1-1A -- 8mmHS+12mm AIR GAP+8mmTP THK. LGU.  
BT1/BB1 -- FIXING DETAIL (DWG. NO. FD01)  
BB2 -- FIXING DETAIL (DWG. NO. FD02)

GLAZING AREA

OPENABLE AREA

6001 TO 6011 & 7001 TO 7008A DETAILS  
REFER TO 3-45F IN-SITU WINDOW SCHEDULE

| NO. | DATE       | REVISION                         | BY  |
|-----|------------|----------------------------------|-----|
| E   | 01/08/2023 | REVISION SUBJECT TO ARCH COMMENT | hwk |
| D   | 29/07/2023 | REVISION SUBJECT TO ARCH COMMENT | hwk |
| C   | 10/07/2023 | REVISION SUBJECT TO ARCH COMMENT | hwk |

JOB NO. : J-856

PROJECT :

PROPOSED DEVELOPMENT ABOVE  
LIGHT RAIL TIN WING STOP, ISWTL  
NO.23, AREA 33, TIN SHUI WAI, N.T.

TITLE :

WINDOW SCHEDULE FOR  
TOWER 3 IN-SITU WINDOW

DATE : 02-Aug-21

SCALE : 1:40




DRAWN BY : IYVN

CHECKED BY :

**美特鋁質有限公司**  
MIDI ALUMINIUM FABRICATOR LTD.  
Units 6-8, Sunray Industrial Centre, 1/F  
610 Che Kwo Ling Road, Kowloon  
Tel: 23489211-4 Fax: (852) 27276666

DWG NO. : J856-SD-W-5354

REV. : E

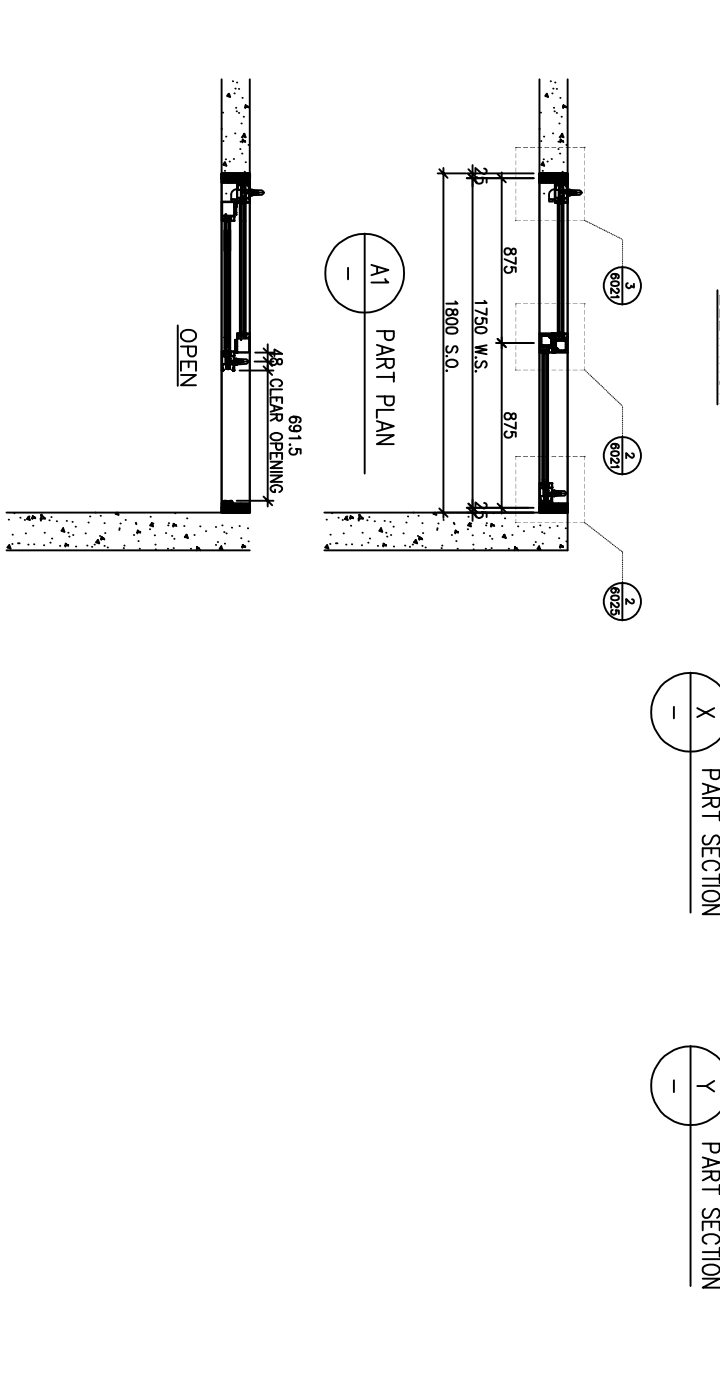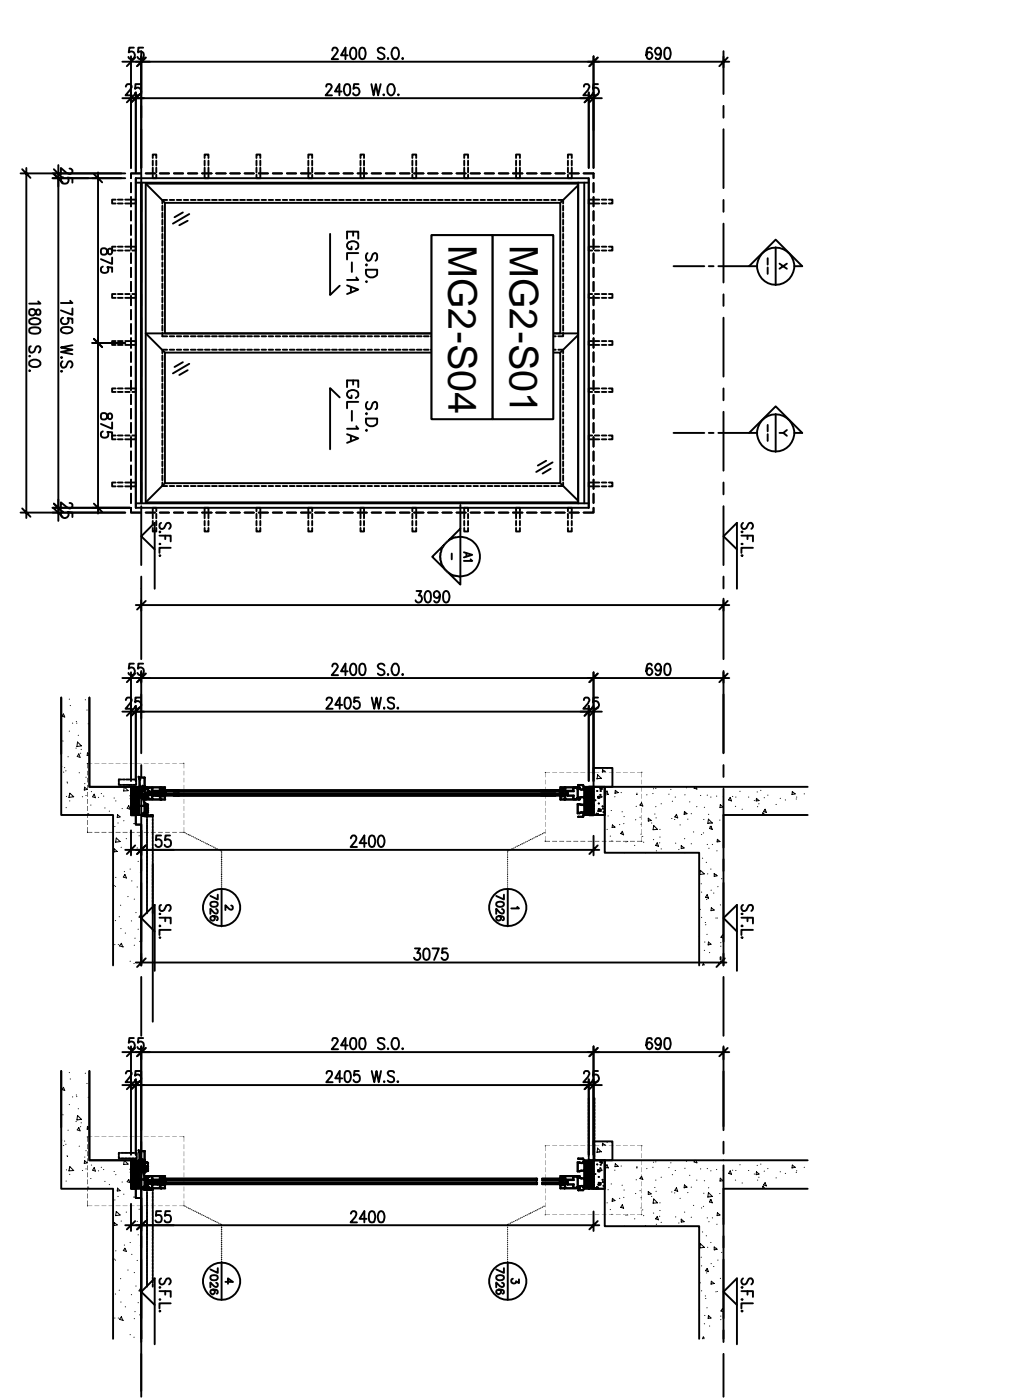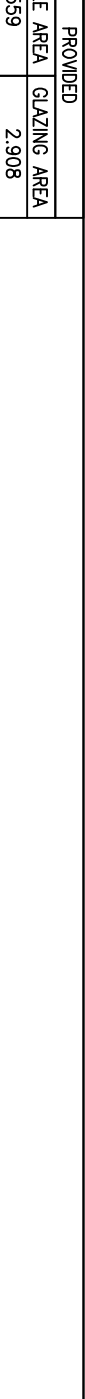

| WINDOW MARK | LOCATION                     | REQUIRE                       | PROVIDED                      |
|-------------|------------------------------|-------------------------------|-------------------------------|
| AW 18       | 46/F UNIT SIMPLEX 2A MBR     | OPENABLE AREA<br>GLAZING AREA | OPENABLE AREA<br>GLAZING AREA |
| SECTION     | 70mm ALUM. SECTION           |                               |                               |
| GLAZING     | EGL-1A                       |                               |                               |
| QUANTITY    | 1 NO.                        |                               |                               |
| REMARKS     | SIEGENIA SLIDING DOOR SYSTEM |                               |                               |



