



美特鋁質有限公司

MIDI ALUMINIUM FABRICATOR LTD.



工程指示 / 要求簡箋 ENGINEER INSTRUCTIONS(E.I.)

工程指示編號:	EI- 7002A	修改版本:	A
	HK- 0139		
工程編號:	J 856	工程名稱:	天榮站
收件人:	生統/謝永林	發件人:	Iris
工程項目:	T1 5F-10F臨時玻璃位置圖(B版本)	日期:	22/01/2024

<input checked="" type="checkbox"/> 原合約工程包	<input type="checkbox"/> 原合約工程加 / 減賬 QT-	<input type="checkbox"/> 新工程報價 QT-
--	--	------------------------------------

信件批核號碼/圖紙參考編號:	批核模具圖紙編號:
客戶指示附件:	管理內部批簽署:

<input type="checkbox"/> 初步鋁料 B.M.	<input type="checkbox"/> 加工拆圖, 然後生產	<input type="checkbox"/> 尺寸表
<input type="checkbox"/> 正式鋁料 B.M.	<input type="checkbox"/> 技術上資料/指示	<input type="checkbox"/> 報價
<input type="checkbox"/> 配件 B.M.	<input type="checkbox"/> 樣辦或貨品說明書	<input type="checkbox"/> 分判合約
<input type="checkbox"/> 其他:		

內容: T1 5F-10F臨時玻璃位置圖(B版本) 請按附件圖紙提供BM 如有問題請提出
完成上列要求日期: 24/01/2024

國內

<input type="checkbox"/> 生產技術總監	<input type="checkbox"/> 連附件	<input checked="" type="checkbox"/> 技術部	<input checked="" type="checkbox"/> 連附件	<input type="checkbox"/> 生產部	<input type="checkbox"/> 連附件
<input type="checkbox"/> 採購部	<input type="checkbox"/> 連附件	<input checked="" type="checkbox"/> 生產統籌部	<input checked="" type="checkbox"/> 連附件	<input type="checkbox"/> 報關組	<input type="checkbox"/> 連附件
<input type="checkbox"/> 質檢部	<input type="checkbox"/> 連附件	<input type="checkbox"/> 會計部	<input type="checkbox"/> 連附件	<input type="checkbox"/> 機械設計部	<input type="checkbox"/> 連附件
<input type="checkbox"/> 香港辦	<input type="checkbox"/> 連附件	<input type="checkbox"/> 其他:			

香港

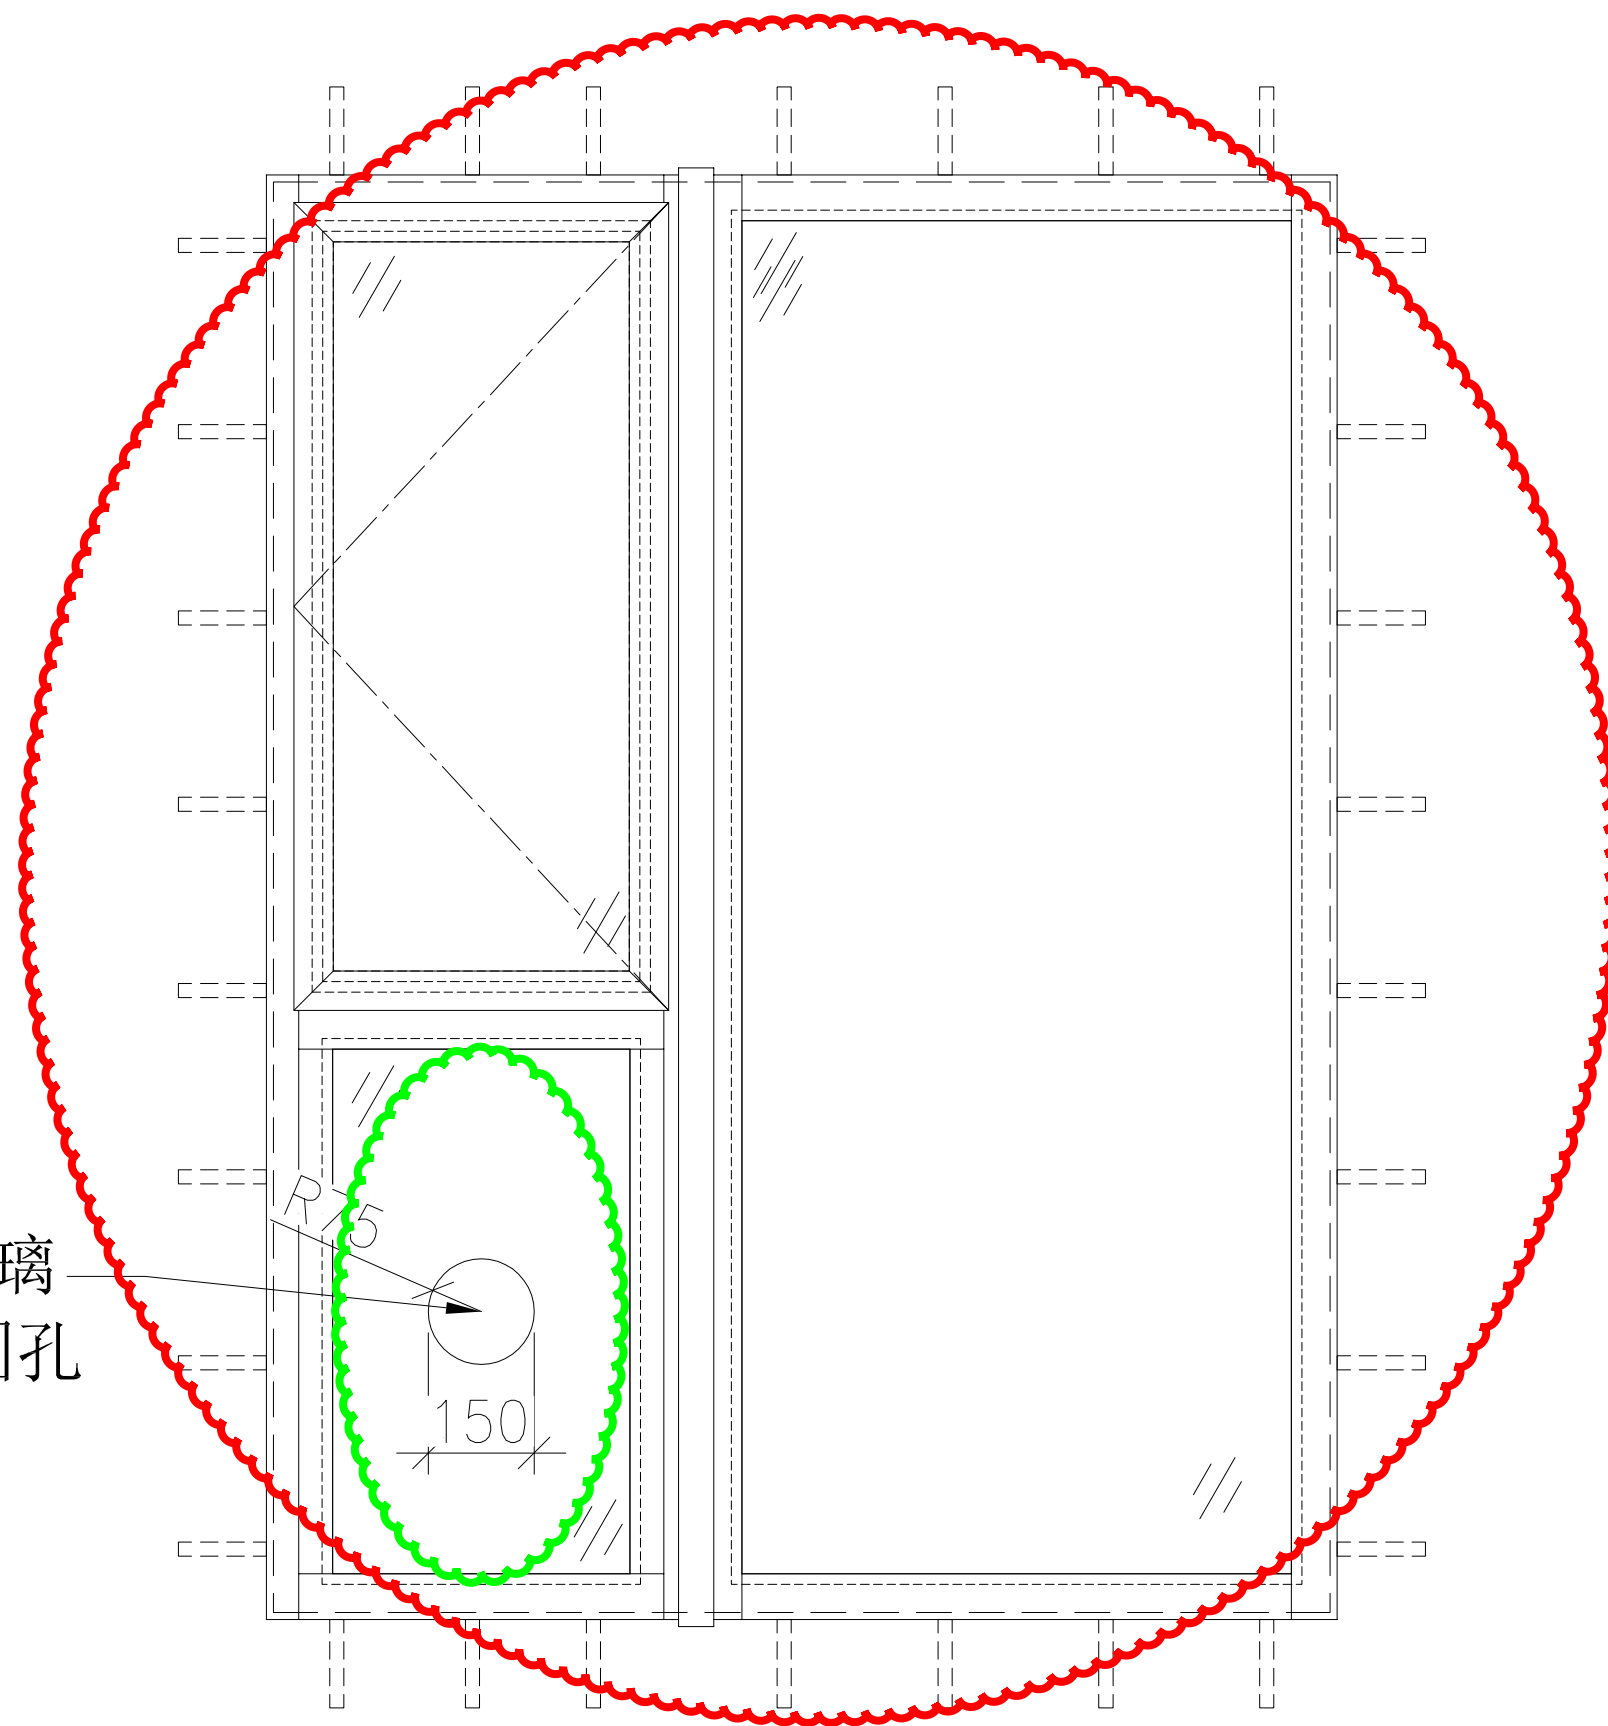
<input type="checkbox"/> 行政部	<input type="checkbox"/> 連附件	<input type="checkbox"/> 會計部	<input type="checkbox"/> 連附件	<input type="checkbox"/> 統籌部	<input type="checkbox"/> 連附件	<input type="checkbox"/> 工程部	<input type="checkbox"/> 連附件
<input type="checkbox"/> 採購部	<input type="checkbox"/> 連附件	<input type="checkbox"/> QS部	<input type="checkbox"/> 連附件	<input checked="" type="checkbox"/> 地盤管理	<input checked="" type="checkbox"/> 連附件	<input type="checkbox"/> 維修部	<input type="checkbox"/> 連附件


*發件人簽署: Iris	*組別成員批核簽署:
傳遞編號:	項目經理簽署:

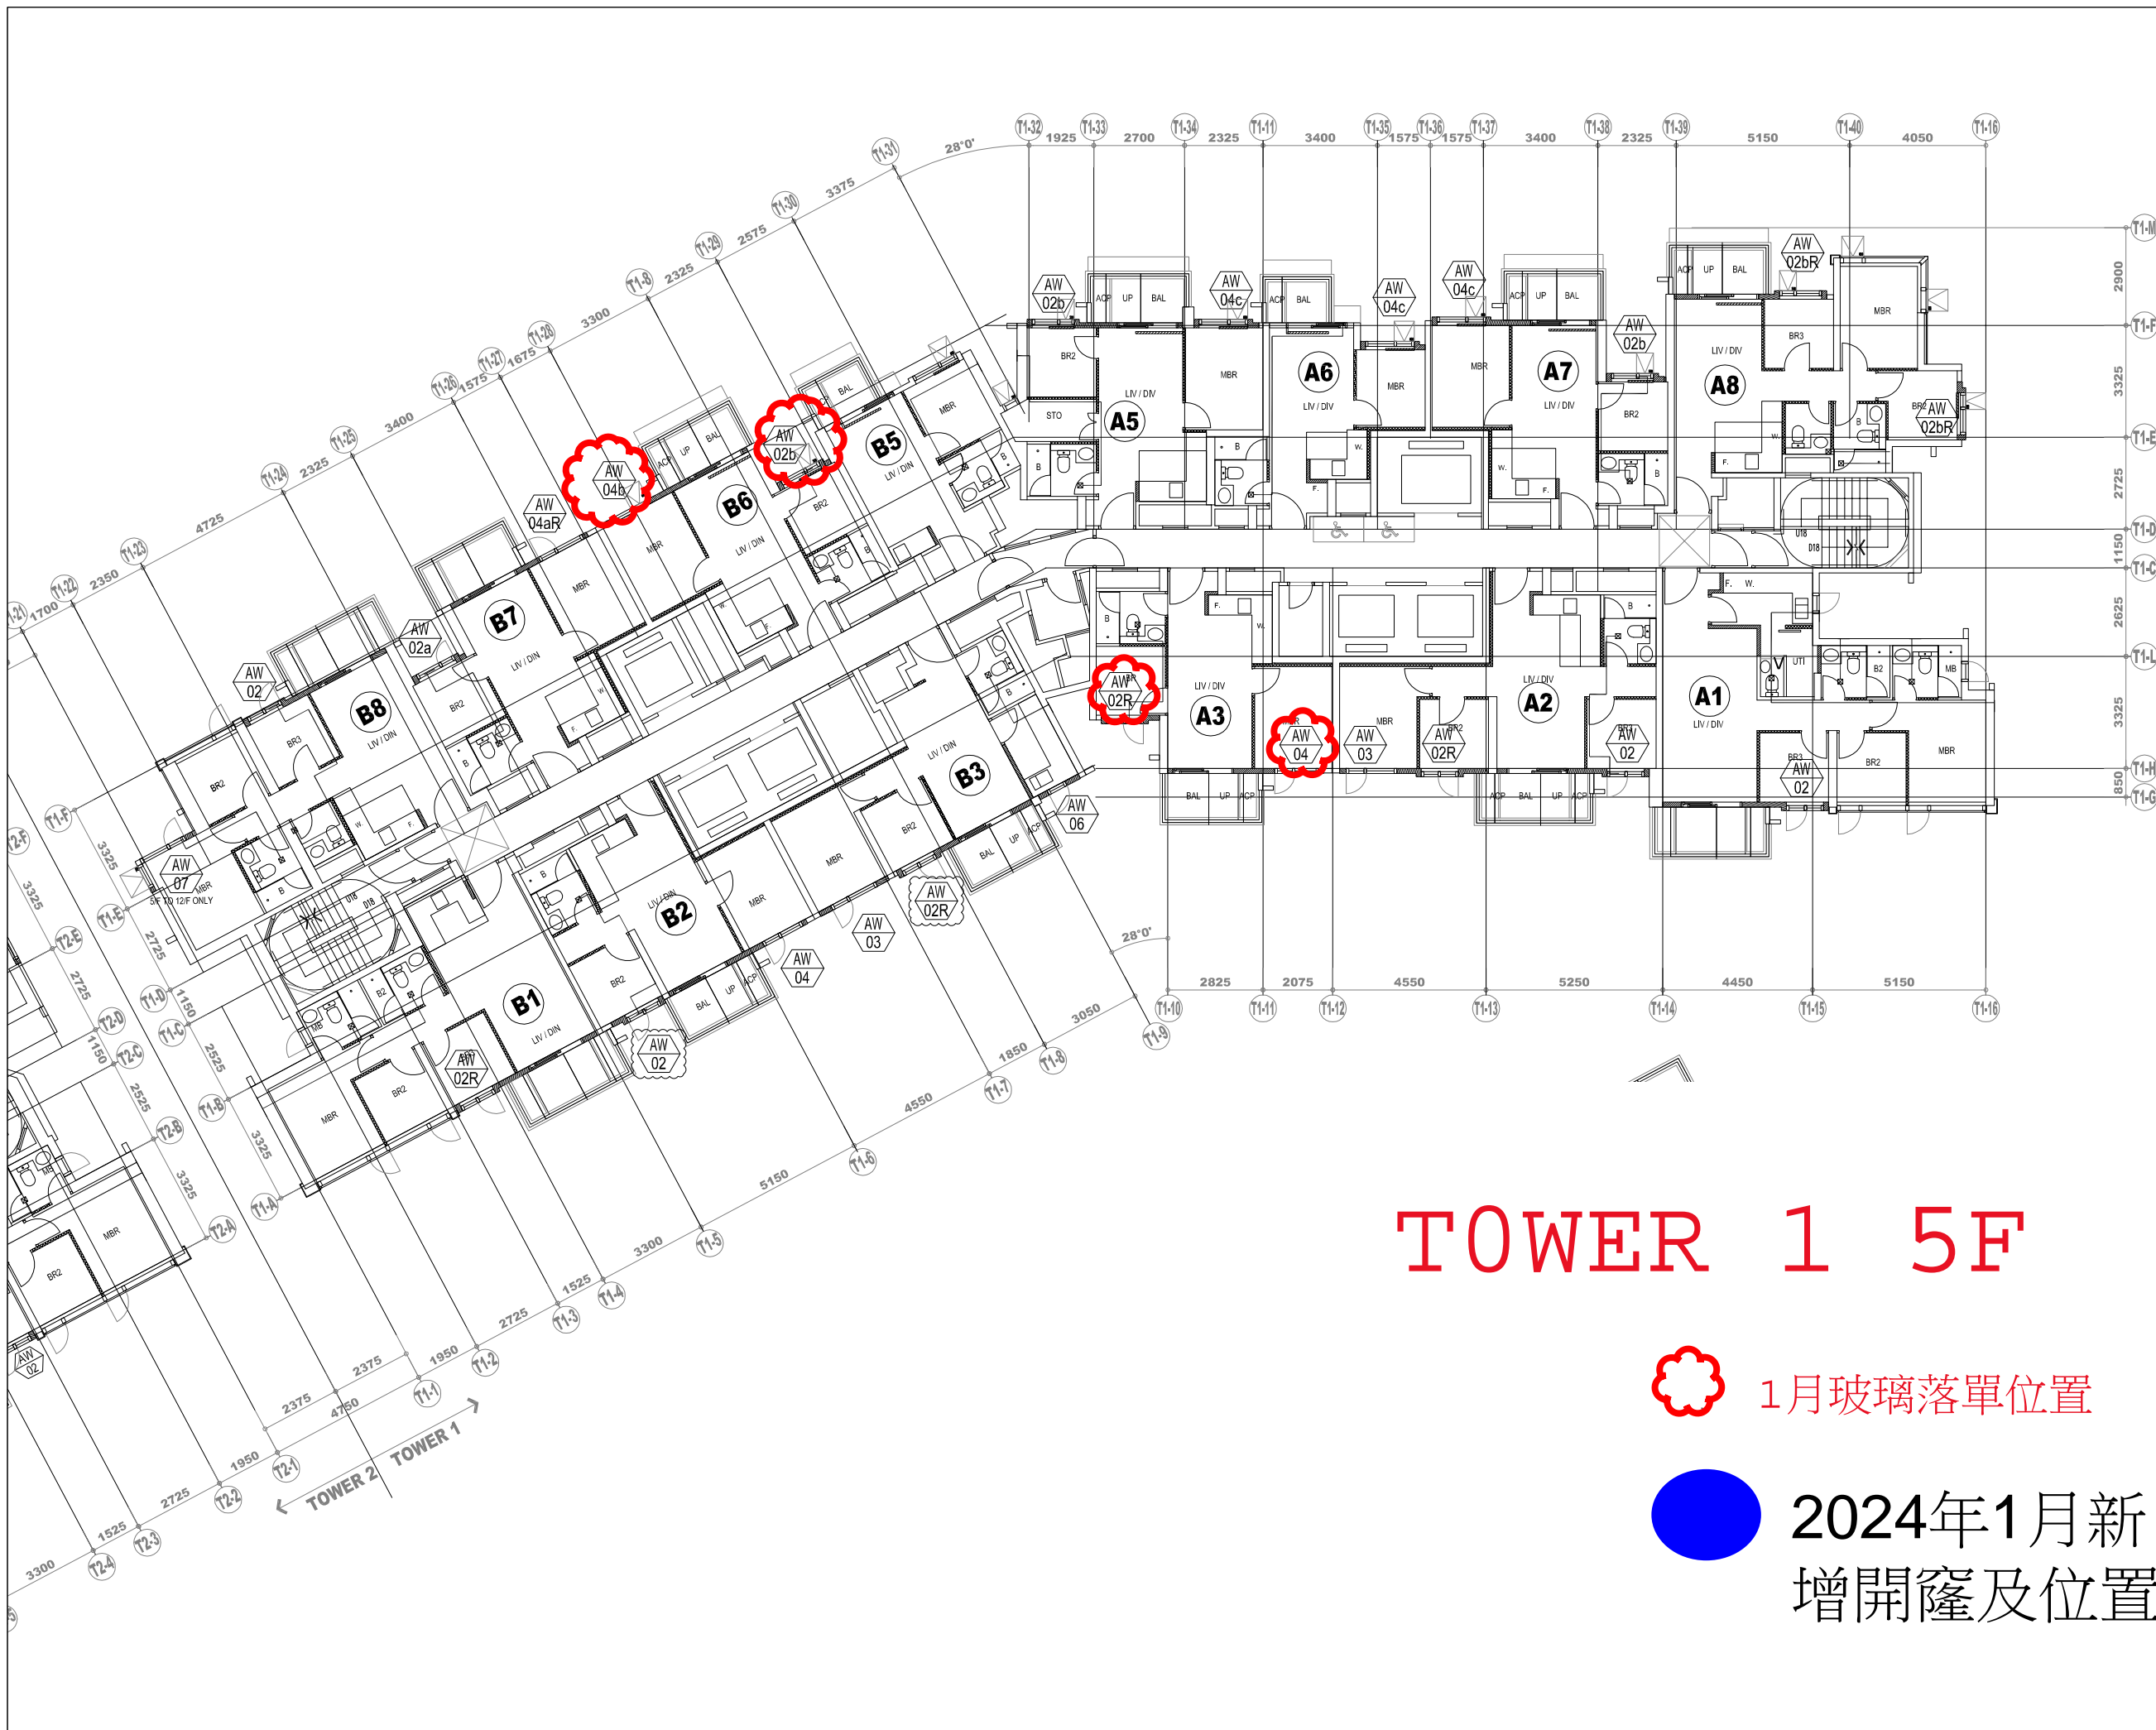
做法：1 

做法：2 

在生窗下的固定玻璃
中央開150mm下的圓孔

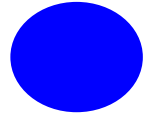


 藍點 AW02/02R/02a/03/04/04b開孔位置



TOWER 1 5F

 1月玻璃落單位置

 2024年1月新增開隆及位置

B.D. REF :

CLIENT :

 42/F SUN HUNG KAI CENTRE, WANCHAI, HONGKONG

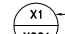
 
ARCHITECT :


MAIN CONTRACTOR :


STRUCTURAL ENGINEER :


FACADE CONSULTANT:


NOTE :
 1. ALL DIMENSIONS ARE IN mm.
 2. ALL ELEVATIONS ARE VIEWED FROM OUTSIDE.
 3. ALL DIMENSIONS TO BE VERIFIED ON SITE BEFORE FABRICATION.

LEGEND :
 — DETAIL MARK NO.
 — REFER SHEET NO.

NO.	DATE	REVISED	BY
I	24/04/2023	REVISION SUBJECT TO SITE MEMO-1324	lvn
H	21/02/2023	UPDATE 14TH 20230119 GBP	lvn
G	14/11/2022	UPDATE 14TH 20221109 GBP	lvn
F	26/10/2022	UPDATE GBP PLAN	YI
E	16/08/2022	REVISION SUBJECT TO ARCH.COMMENT	lvn
D	27/06/2022	REVISION SUBJECT TO ARCH.COMMENT	lvn
C	29/11/2021	REVISION SUBJECT TO ARCH.COMMENT	lvn
B	03/11/2021	REVISION SUBJECT TO ARCH.COMMENT	lvn
A	18/10/2021	REVISION SUBJECT TO ARCH.COMMENT	lvn

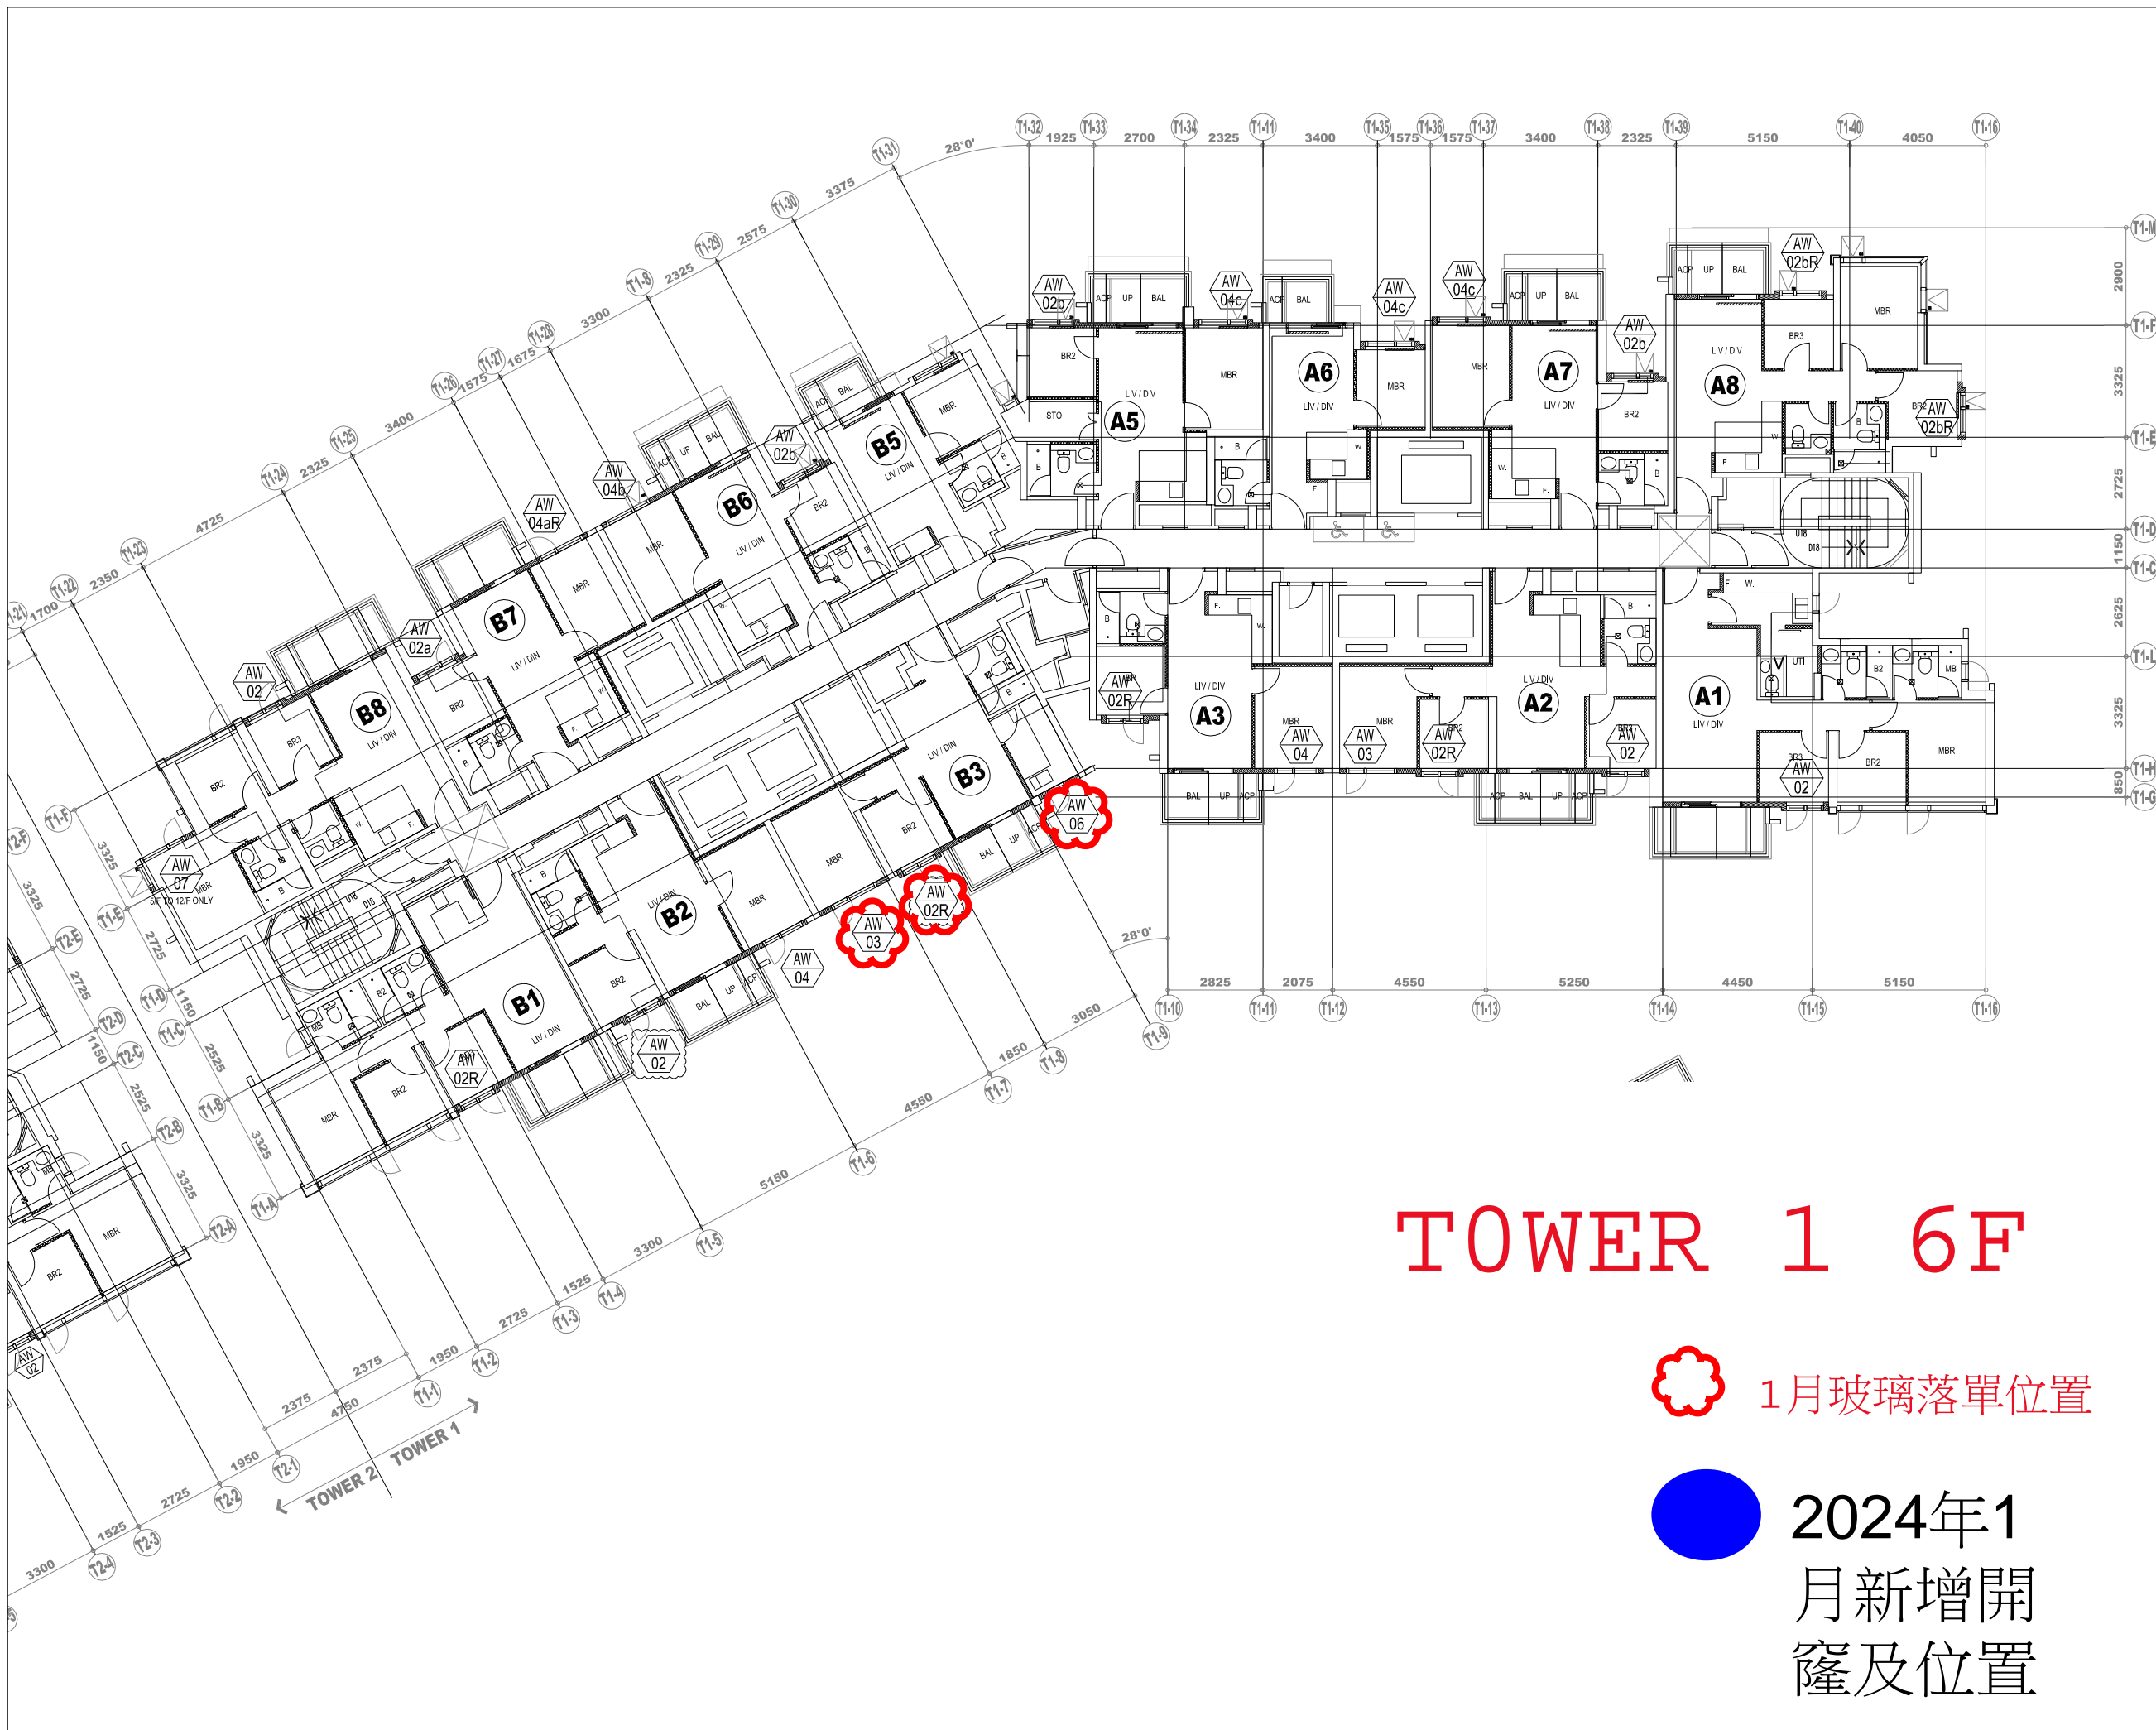
JOB NO. : J-856
 PROJECT : PROPOSED DEVELOPMENT ABOVE LIGHT RAIL TIN WING STOP, TSWTL NO.23, AREA 33, TIN SHUI WAI, N.T.

TITLE : PLAN FOR PRECAST WINDOW AT TOWER 1

DATE : 02-Aug-21 SCALE : 1:200
 DRAWN BY : lvn CHECKED BY :


 MIDI ALUMINIUM FABRICATOR LTD.
 Units 6-8, Sunray Industrial Centre, 1/F
 610 Cha Kwo Ling Road, Kowloon
 Tel:23489211-4 Fax:(852)2727666

DWG NO. : J856-SD-IW-3102 REV. : I



TOWER 1 6F

 1月玻璃落單位置

 2024年1月新增開窗及位置

B.D. REF :

CLIENT : **SUN HUNG KAI REAL ESTATE AGENCY LTD.**
42/F SUN HUNG KAI CENTRE, WANCHAI, HONGKONG

ARCHITECT : **lwk&partners architects**

MAIN CONTRACTOR : **怡輝建築有限公司 Yee Fai Building Contractors Ltd.**

STRUCTURAL ENGINEER : **ARUP**

FACADE CONSULTANT : **ALPHA CONSULTING LIMITED**
Steel Structure & Facade Specialist

NOTE :
1. ALL DIMENSIONS ARE IN mm.
2. ALL ELEVATIONS ARE VIEWED FROM OUTSIDE.
3. ALL DIMENSIONS TO BE VERIFIED ON SITE BEFORE FABRICATION.

LEGEND :
X1 — DETAIL MARK NO.
X001 — REFER SHEET NO.

I	24/04/2023	REVISION SUBJECT TO SITE MEMO-1324	lvn
H	21/02/2023	UPDATE 14TH 20230119 GBP	lvn
G	14/11/2022	UPDATE 14TH 20221109 GBP	lvn
F	26/10/2022	UPDATE GBP PLAN	yi
E	16/08/2022	REVISION SUBJECT TO ARCH.COMMENT	lvn
D	27/06/2022	REVISION SUBJECT TO ARCH.COMMENT	lvn
C	29/11/2021	REVISION SUBJECT TO ARCH.COMMENT	lvn
B	03/11/2021	REVISION SUBJECT TO ARCH.COMMENT	lvn
A	18/10/2021	REVISION SUBJECT TO ARCH.COMMENT	lvn
NO.	DATE	REVISED	BY

JOB NO. : J-856

PROJECT : PROPOSED DEVELOPMENT ABOVE LIGHT RAIL TIN WING STOP, TSWTL NO.23, AREA 33, TIN SHUI WAI, N.T.

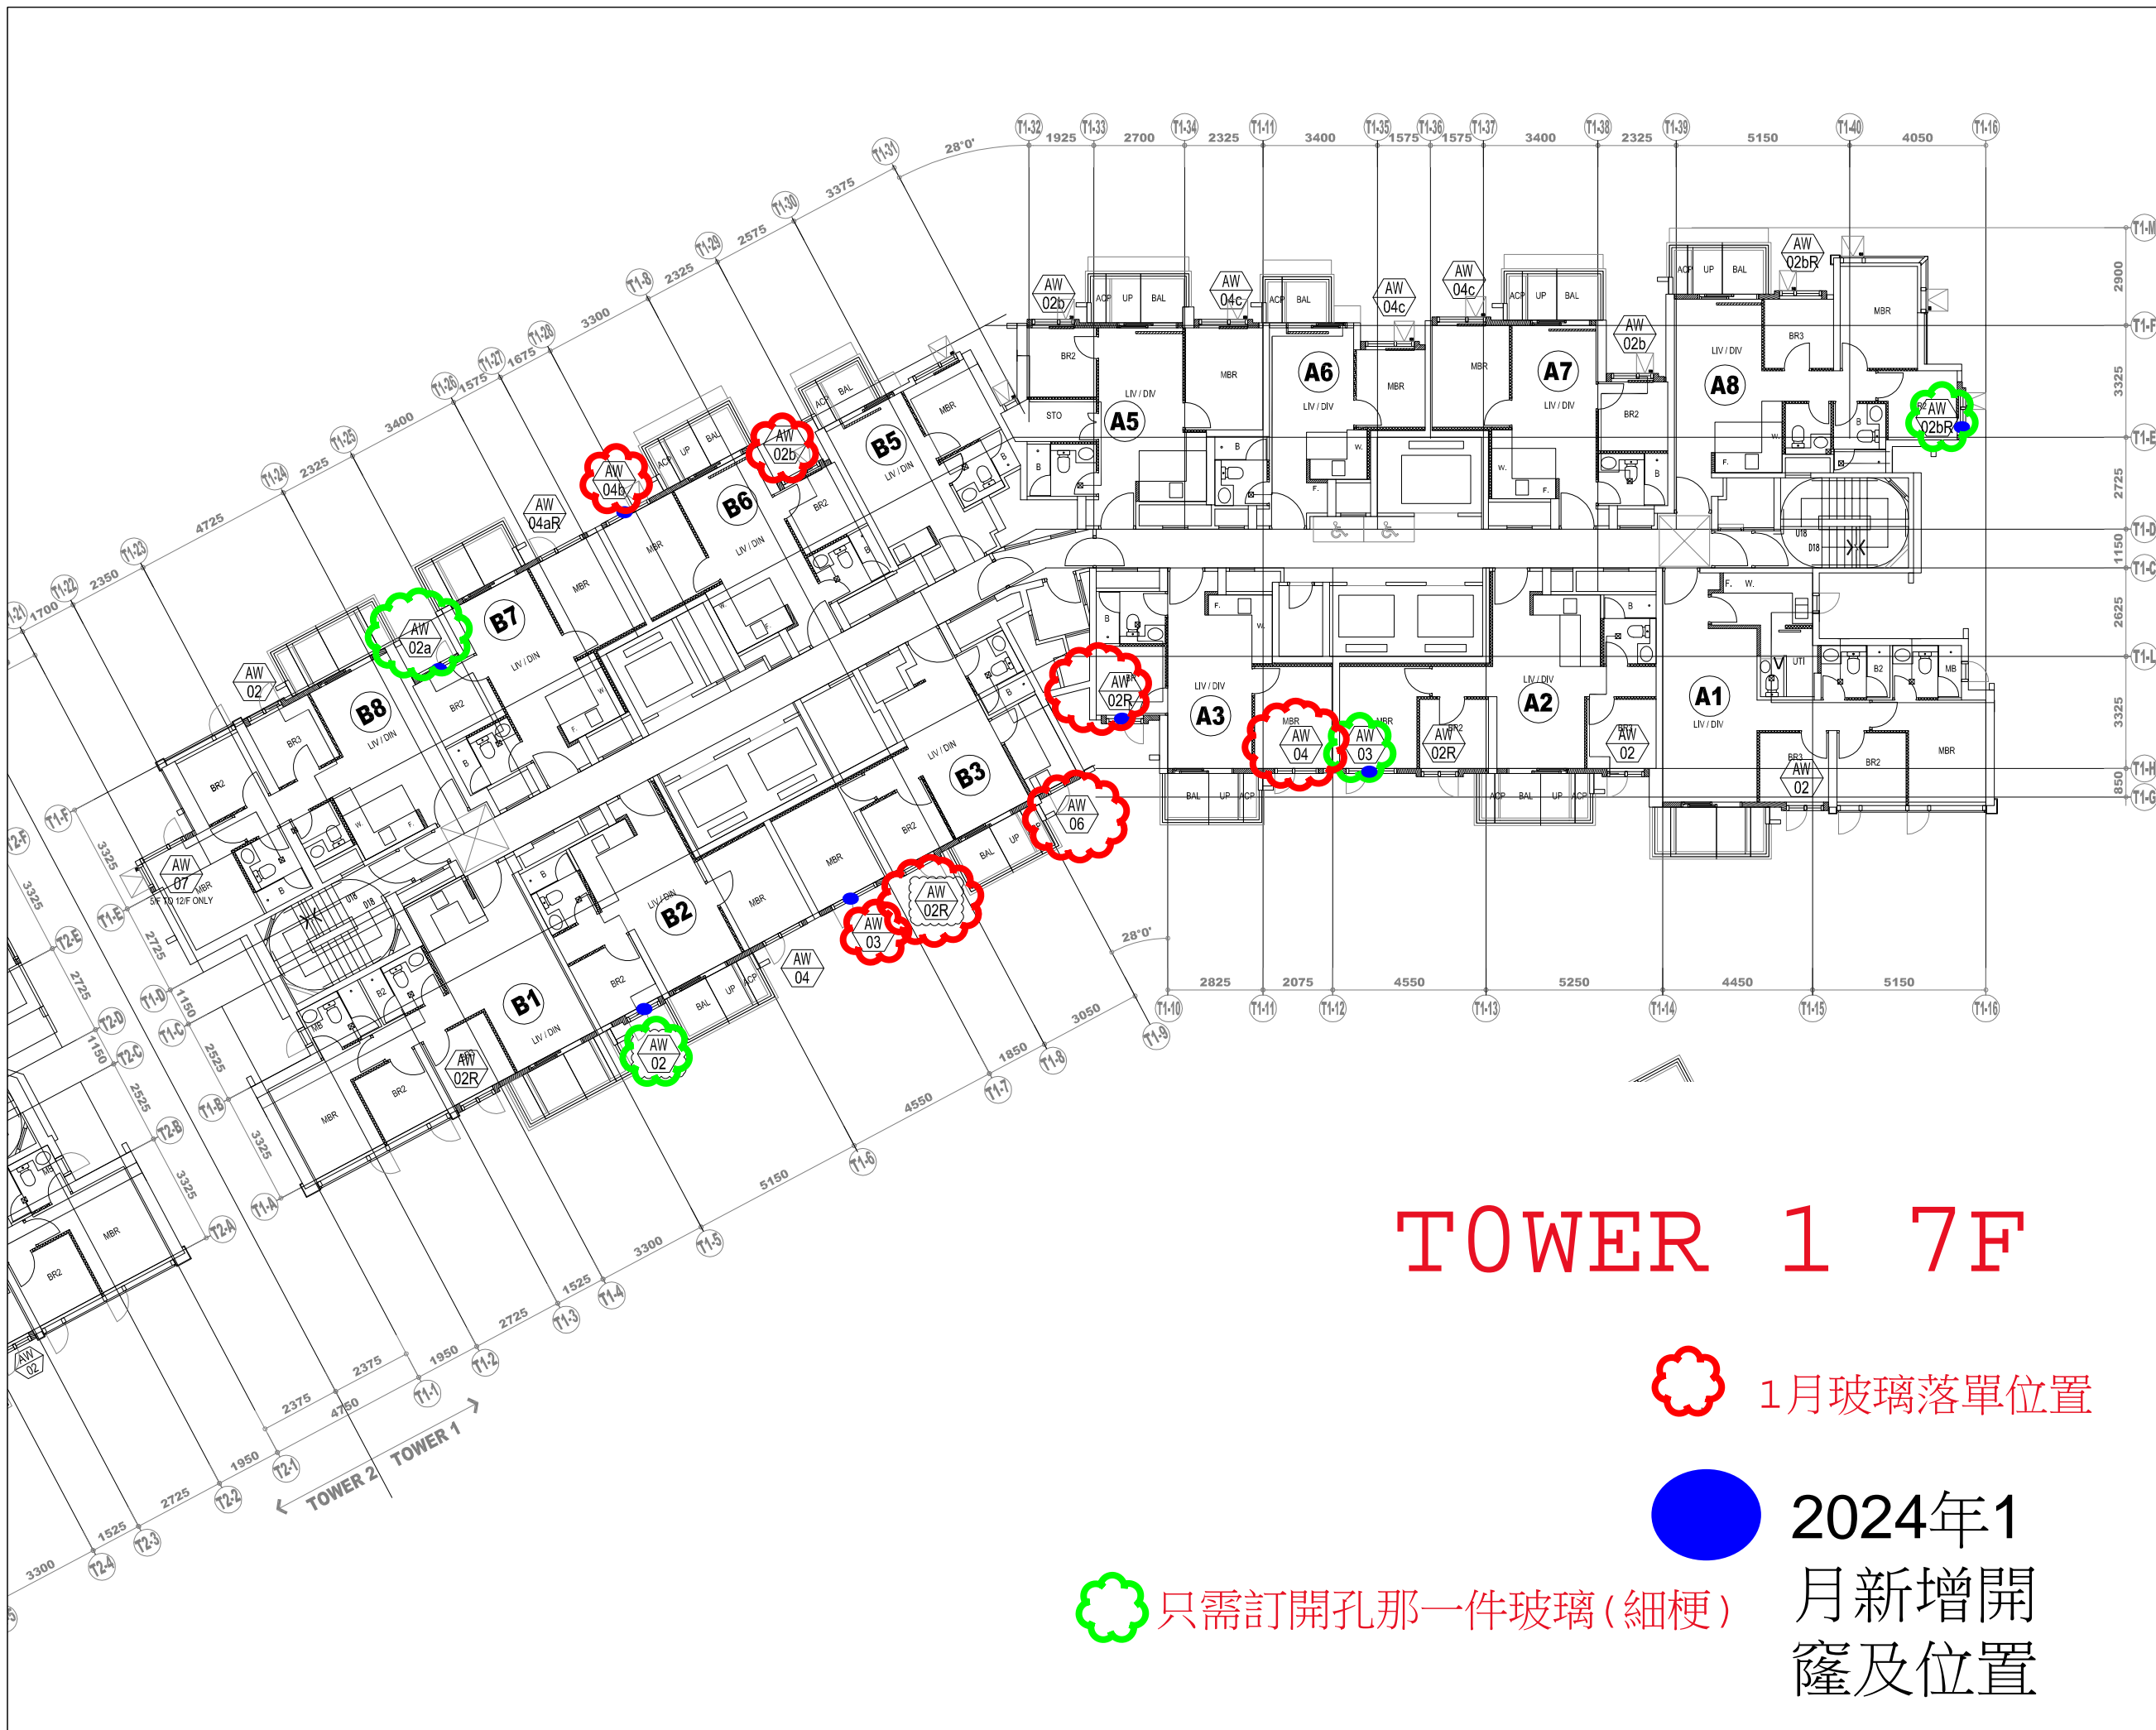
TITLE : PLAN FOR PRECAST WINDOW AT TOWER 1

DATE : 02-Aug-21 SCALE : 1:200

DRAWN BY : lvn CHECKED BY :

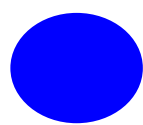
美特鋁質有限公司
MIDI ALUMINIUM FABRICATOR LTD.
Units 6-8, Sunray Industrial Centre, 1/F
610 Cha Kwo Ling Road, Kowloon
Tel:23489211-4 Fax:(852)27727666

DWG NO. : J856-SD-IW-3102 REV. : I




TOWER 1 7F


 1月玻璃落單位置


 2024年1月新增開
窿及位置


 只需訂開孔那一件玻璃(細梗)


B.D. REF :

CLIENT :

 42/F SUN HUNG KAI CENTRE, WANCHAI, HONGKONG

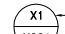
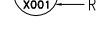
ARCHITECT :


MAIN CONTRACTOR :


STRUCTURAL ENGINEER :


FACADE CONSULTANT:


NOTE :
 1. ALL DIMENSIONS ARE IN mm.
 2. ALL ELEVATIONS ARE VIEWED FROM OUTSIDE.
 3. ALL DIMENSIONS TO BE VERIFIED ON SITE BEFORE FABRICATION.

LEGEND :
 — DETAIL MARK NO.
 — REFER SHEET NO.

NO.	DATE	REVISED	BY
I	24/04/2023	REVISION SUBJECT TO SITE MEMO-1324	ivan
H	21/02/2023	UPDATE 14TH 20230119 GBP	ivan
G	14/11/2022	UPDATE 14TH 20221109 GBP	ivan
F	26/10/2022	UPDATE GBP PLAN	yi
E	16/08/2022	REVISION SUBJECT TO ARCH.COMMENT	ivan
D	27/06/2022	REVISION SUBJECT TO ARCH.COMMENT	ivan
C	29/11/2021	REVISION SUBJECT TO ARCH.COMMENT	ivan
B	03/11/2021	REVISION SUBJECT TO ARCH.COMMENT	ivan
A	18/10/2021	REVISION SUBJECT TO ARCH.COMMENT	ivan


JOB NO. : J-856

PROJECT :
 PROPOSED DEVELOPMENT ABOVE LIGHT RAIL TIN WING STOP, TSWTL NO.23, AREA 33, TIN SHUI WAI, N.T.

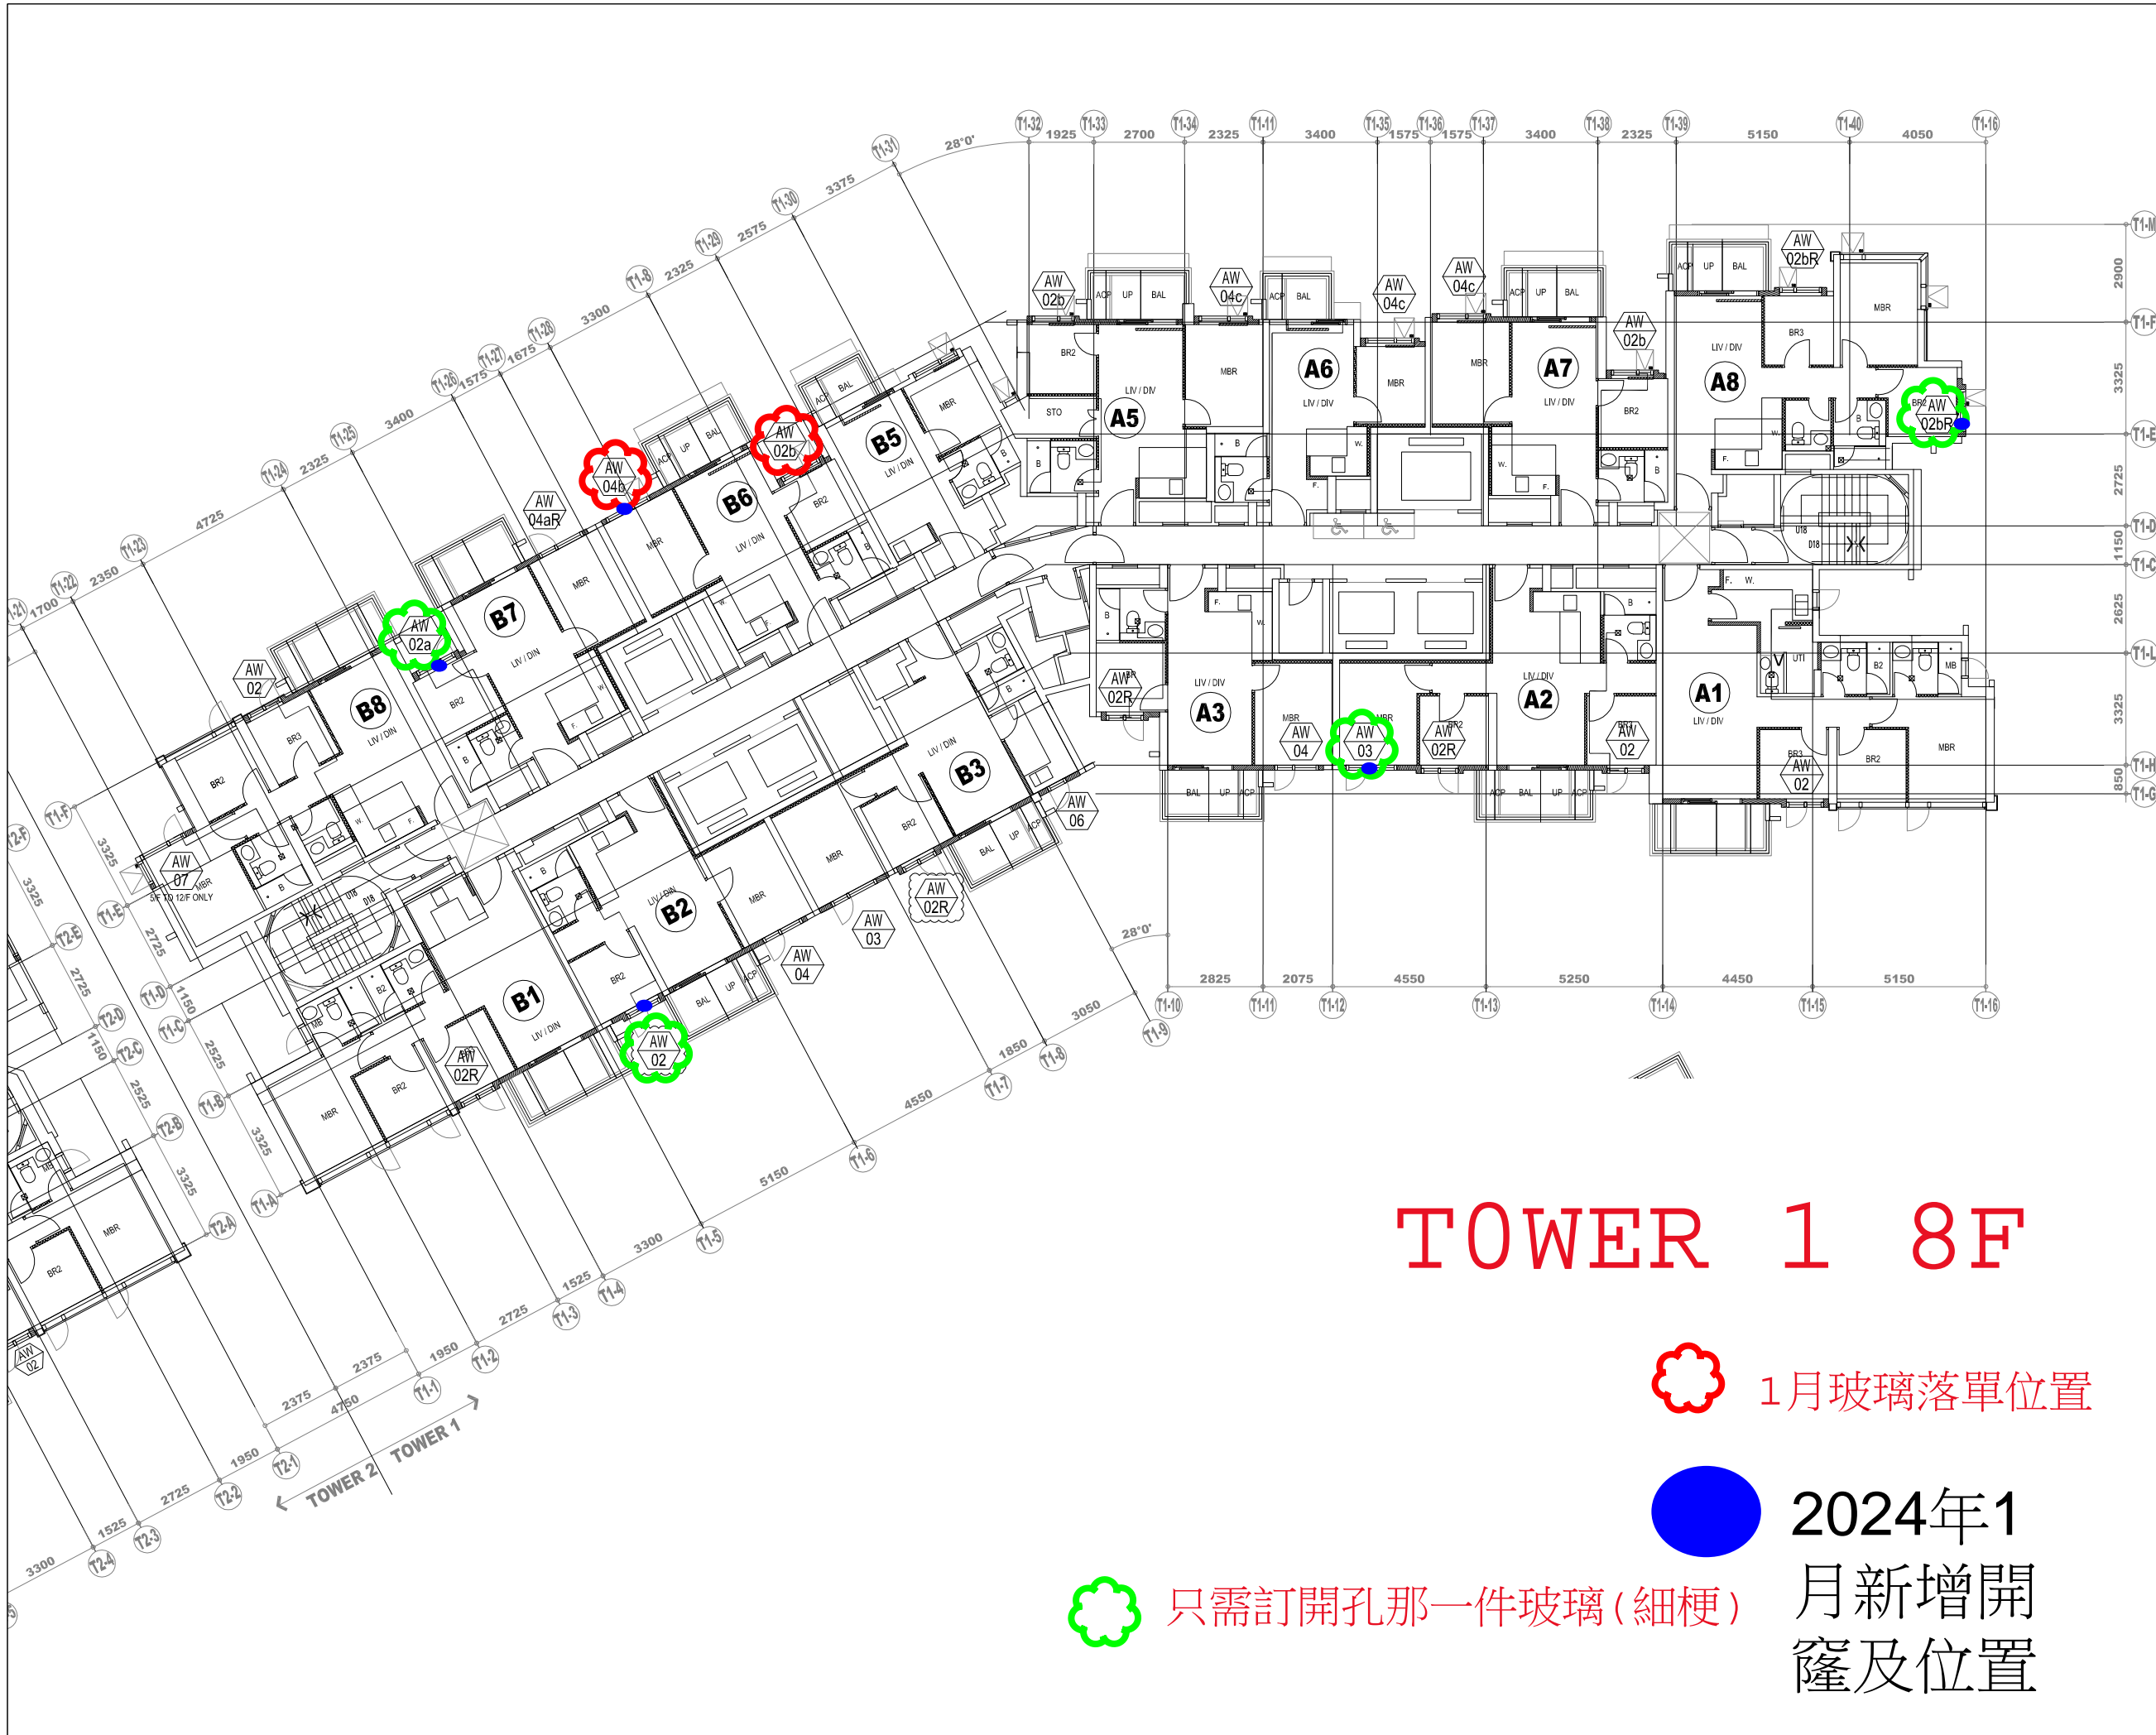
TITLE :
 PLAN FOR PRECAST WINDOW AT TOWER 1

DATE : 02-Aug-21 SCALE : 1:200

DRAWN BY : ivan CHECKED BY :

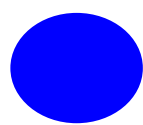

 MIDI ALUMINIUM FABRICATOR LTD.
 Units 6-8, Sunray Industrial Centre, 1/F
 610 Cha Kwo Ling Road, Kowloon
 Tel:23489211-4 Fax:(852)27727666

DWG NO. : J856-SD-IW-3102 REV. : I



TOWER 1 8F

 1月玻璃落單位置

 2024年1月新增開窗及位置

 只需訂開孔那一件玻璃(細梗)

B.D. REF :

CLIENT : **SUN HUNG KAI REAL ESTATE AGENCY LTD.**
42/F SUN HUNG KAI CENTRE, WANCHAI, HONGKONG

ARCHITECT : **lwk&partners architects**

MAIN CONTRACTOR : **怡輝建築有限公司 Yee Fai Building Contractors Ltd.**

STRUCTURAL ENGINEER : **ARUP**

FACADE CONSULTANT : **ALPHA CONSULTING LIMITED**
Steel Structure & Facade Specialist

NOTE :
1. ALL DIMENSIONS ARE IN mm.
2. ALL ELEVATIONS ARE VIEWED FROM OUTSIDE.
3. ALL DIMENSIONS TO BE VERIFIED ON SITE BEFORE FABRICATION.

LEGEND :
X1 ———— DETAIL MARK NO.
X001 ——— REFER SHEET NO.

I	24/04/2023	REVISION SUBJECT TO SITE MEMO-1324	lvn
H	21/02/2023	UPDATE 14TH 20230119 GBP	lvn
G	14/11/2022	UPDATE 14TH 20221109 GBP	lvn
F	26/10/2022	UPDATE GBP PLAN	yi
E	16/08/2022	REVISION SUBJECT TO ARCH.COMMENT	lvn
D	27/06/2022	REVISION SUBJECT TO ARCH.COMMENT	lvn
C	29/11/2021	REVISION SUBJECT TO ARCH.COMMENT	lvn
B	03/11/2021	REVISION SUBJECT TO ARCH.COMMENT	lvn
A	18/10/2021	REVISION SUBJECT TO ARCH.COMMENT	lvn
NO.	DATE	REVISED	BY

JOB NO. : J-856

PROJECT : PROPOSED DEVELOPMENT ABOVE LIGHT RAIL TIN WING STOP, TSWTL NO.23, AREA 33, TIN SHUI WAI, N.T.

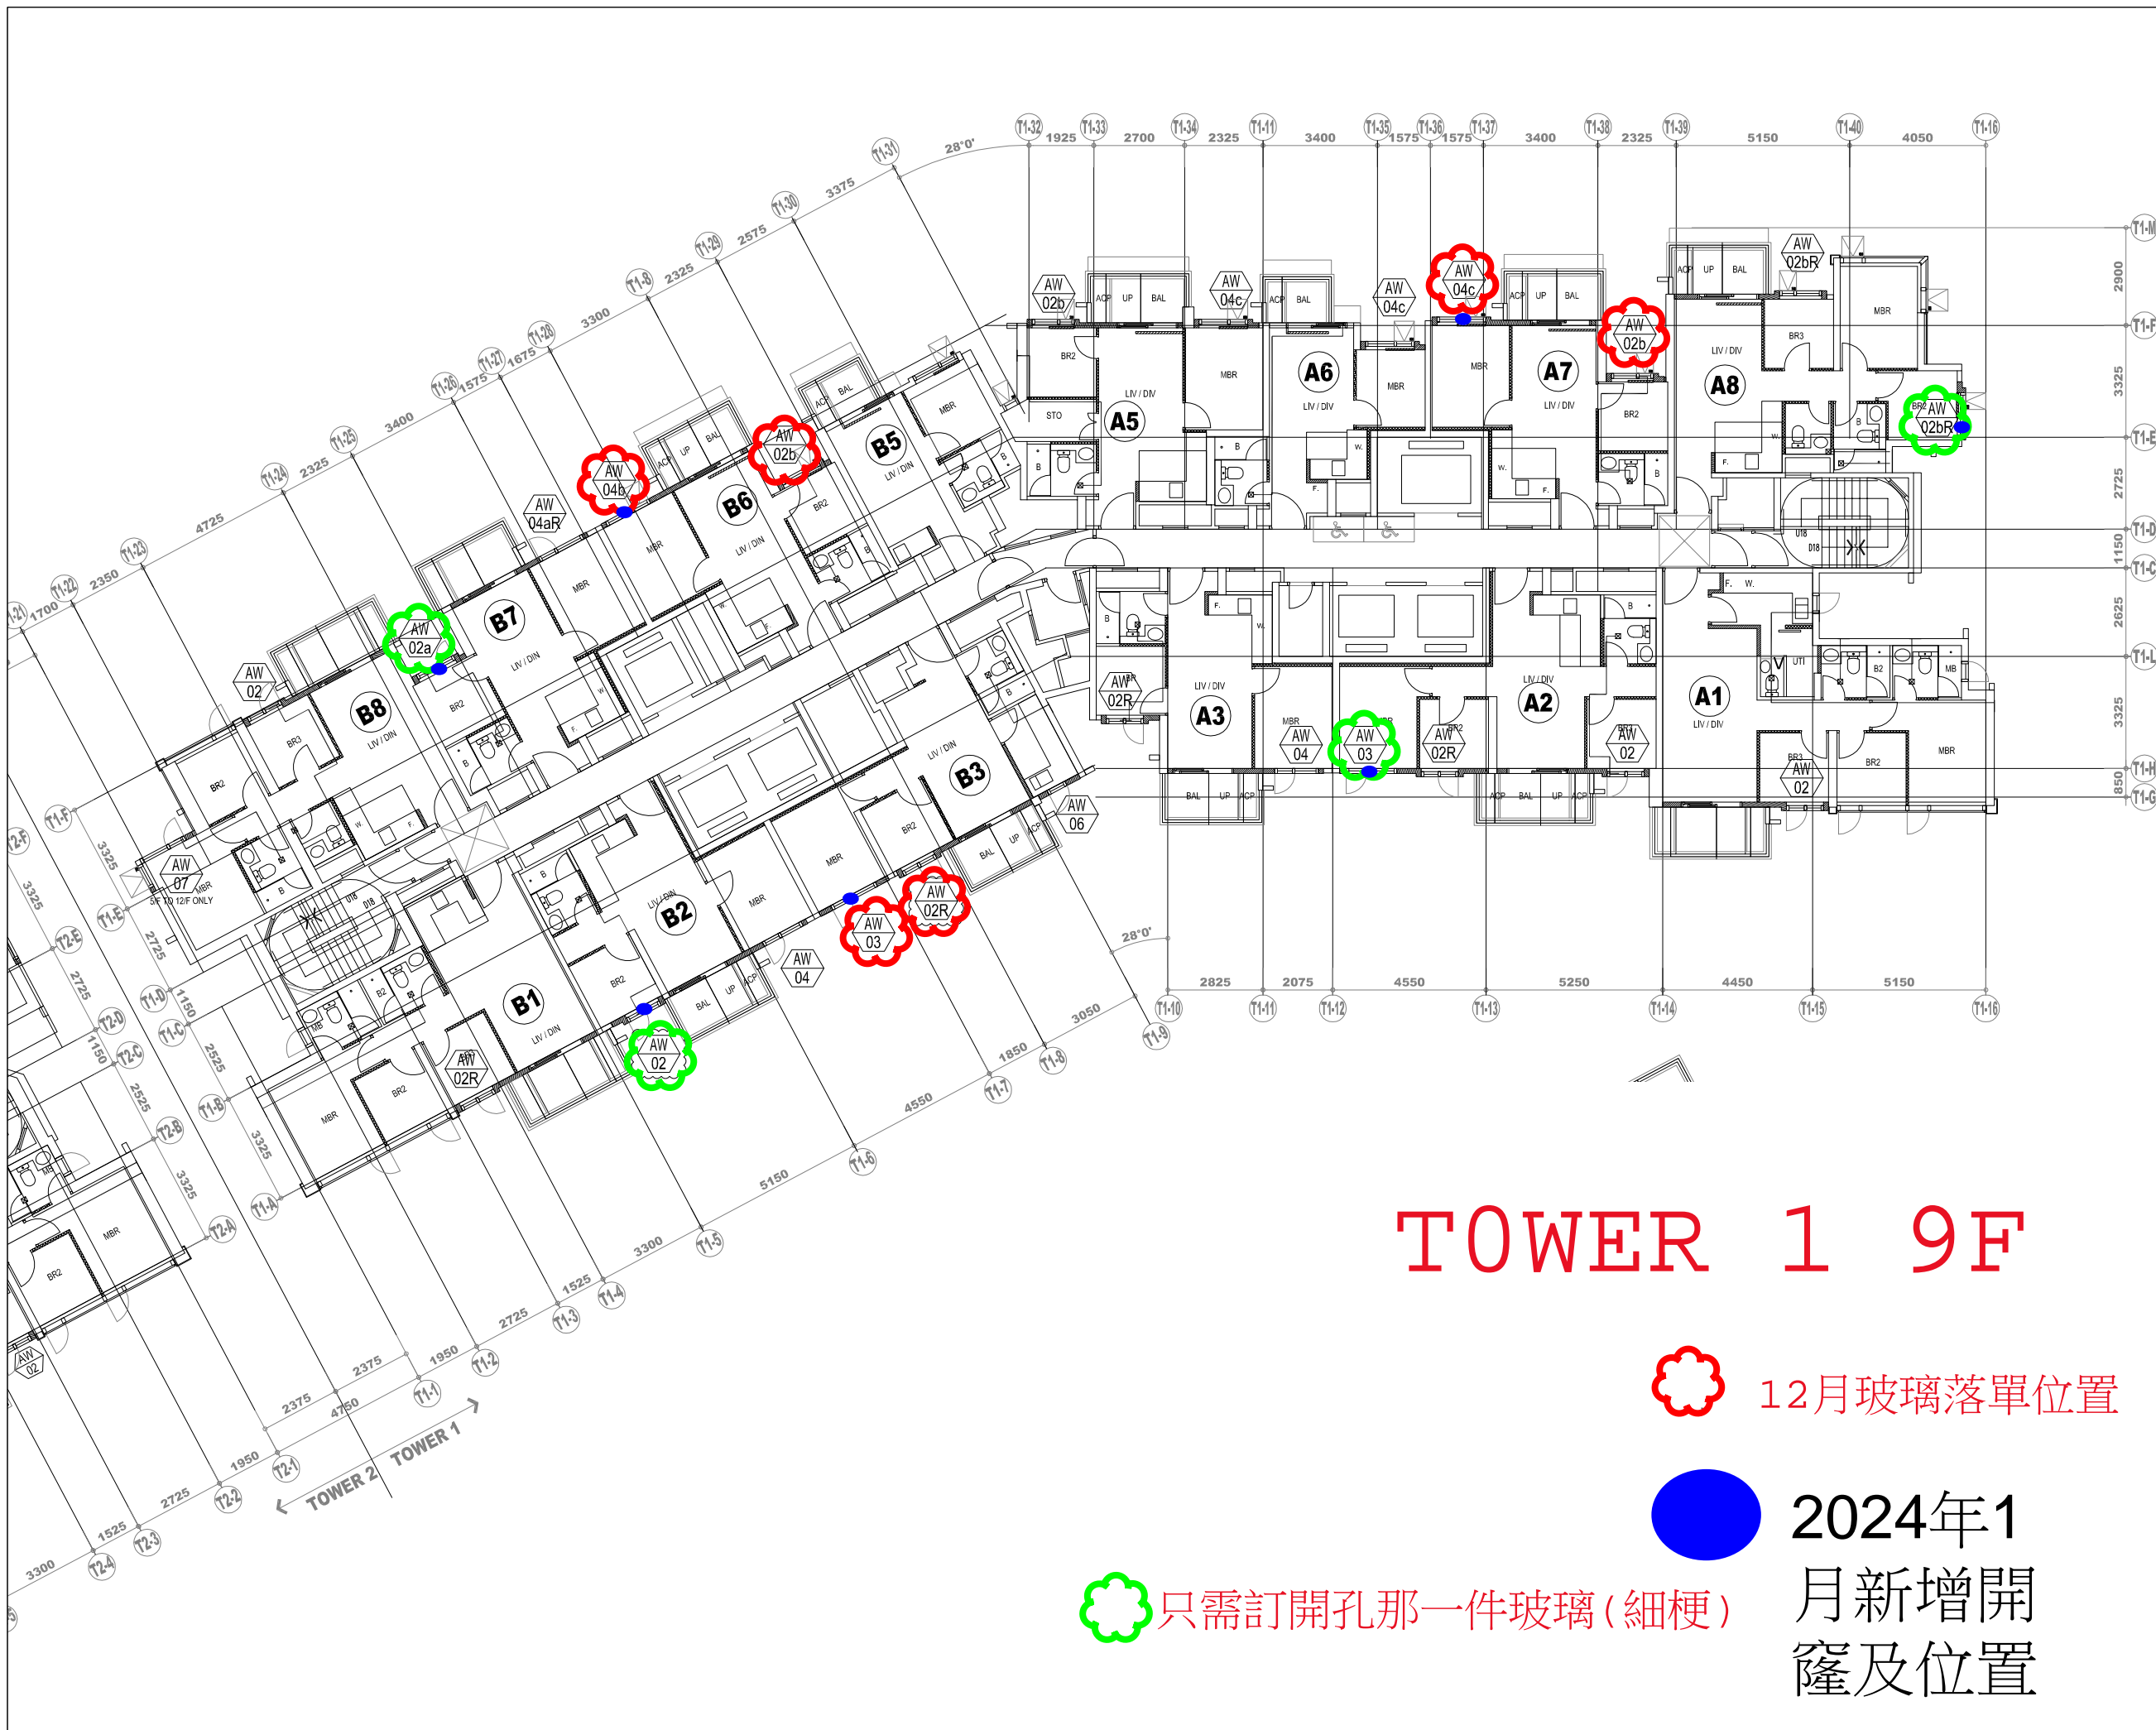
TITLE : PLAN FOR PRECAST WINDOW AT TOWER 1

DATE : 02-Aug-21 SCALE : 1:200

DRAWN BY : lvn CHECKED BY :

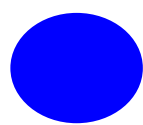
美特鋁質有限公司
MIDI ALUMINIUM FABRICATOR LTD.
Units 6-8, Sunray Industrial Centre, 1/F
610 Cha Kwo Ling Road, Kowloon
Tel:23489211-4 Fax:(852)27727666

DWG NO. : J856-SD-IW-3102 REV. : I




TOWER 1 9F


 12月玻璃落單位置


 2024年1月新增開
窿及位置


 只需訂開孔那一件玻璃(細梗)


B.D. REF :

CLIENT :

 42/F SUN HUNG KAI CENTRE, WANCHAI, HONGKONG

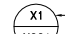
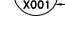
ARCHITECT :


MAIN CONTRACTOR :


STRUCTURAL ENGINEER :


FACADE CONSULTANT:


NOTE :
 1. ALL DIMENSIONS ARE IN mm.
 2. ALL ELEVATIONS ARE VIEWED FROM OUTSIDE.
 3. ALL DIMENSIONS TO BE VERIFIED ON SITE BEFORE FABRICATION.

LEGEND :
 — DETAIL MARK NO.
 — REFER SHEET NO.

NO.	DATE	REVISED	BY
I	24/04/2023	REVISION SUBJECT TO SITE MEMO-1324	ivan
H	21/02/2023	UPDATE 14TH 20230119 GBP	ivan
G	14/11/2022	UPDATE 14TH 20221109 GBP	ivan
F	26/10/2022	UPDATE GBP PLAN	yi
E	16/08/2022	REVISION SUBJECT TO ARCH.COMMENT	ivan
D	27/06/2022	REVISION SUBJECT TO ARCH.COMMENT	ivan
C	29/11/2021	REVISION SUBJECT TO ARCH.COMMENT	ivan
B	03/11/2021	REVISION SUBJECT TO ARCH.COMMENT	ivan
A	18/10/2021	REVISION SUBJECT TO ARCH.COMMENT	ivan


JOB NO. : J-856

PROJECT :
 PROPOSED DEVELOPMENT ABOVE LIGHT RAIL TIN WING STOP, TSWTL NO.23, AREA 33, TIN SHUI WAI, N.T.

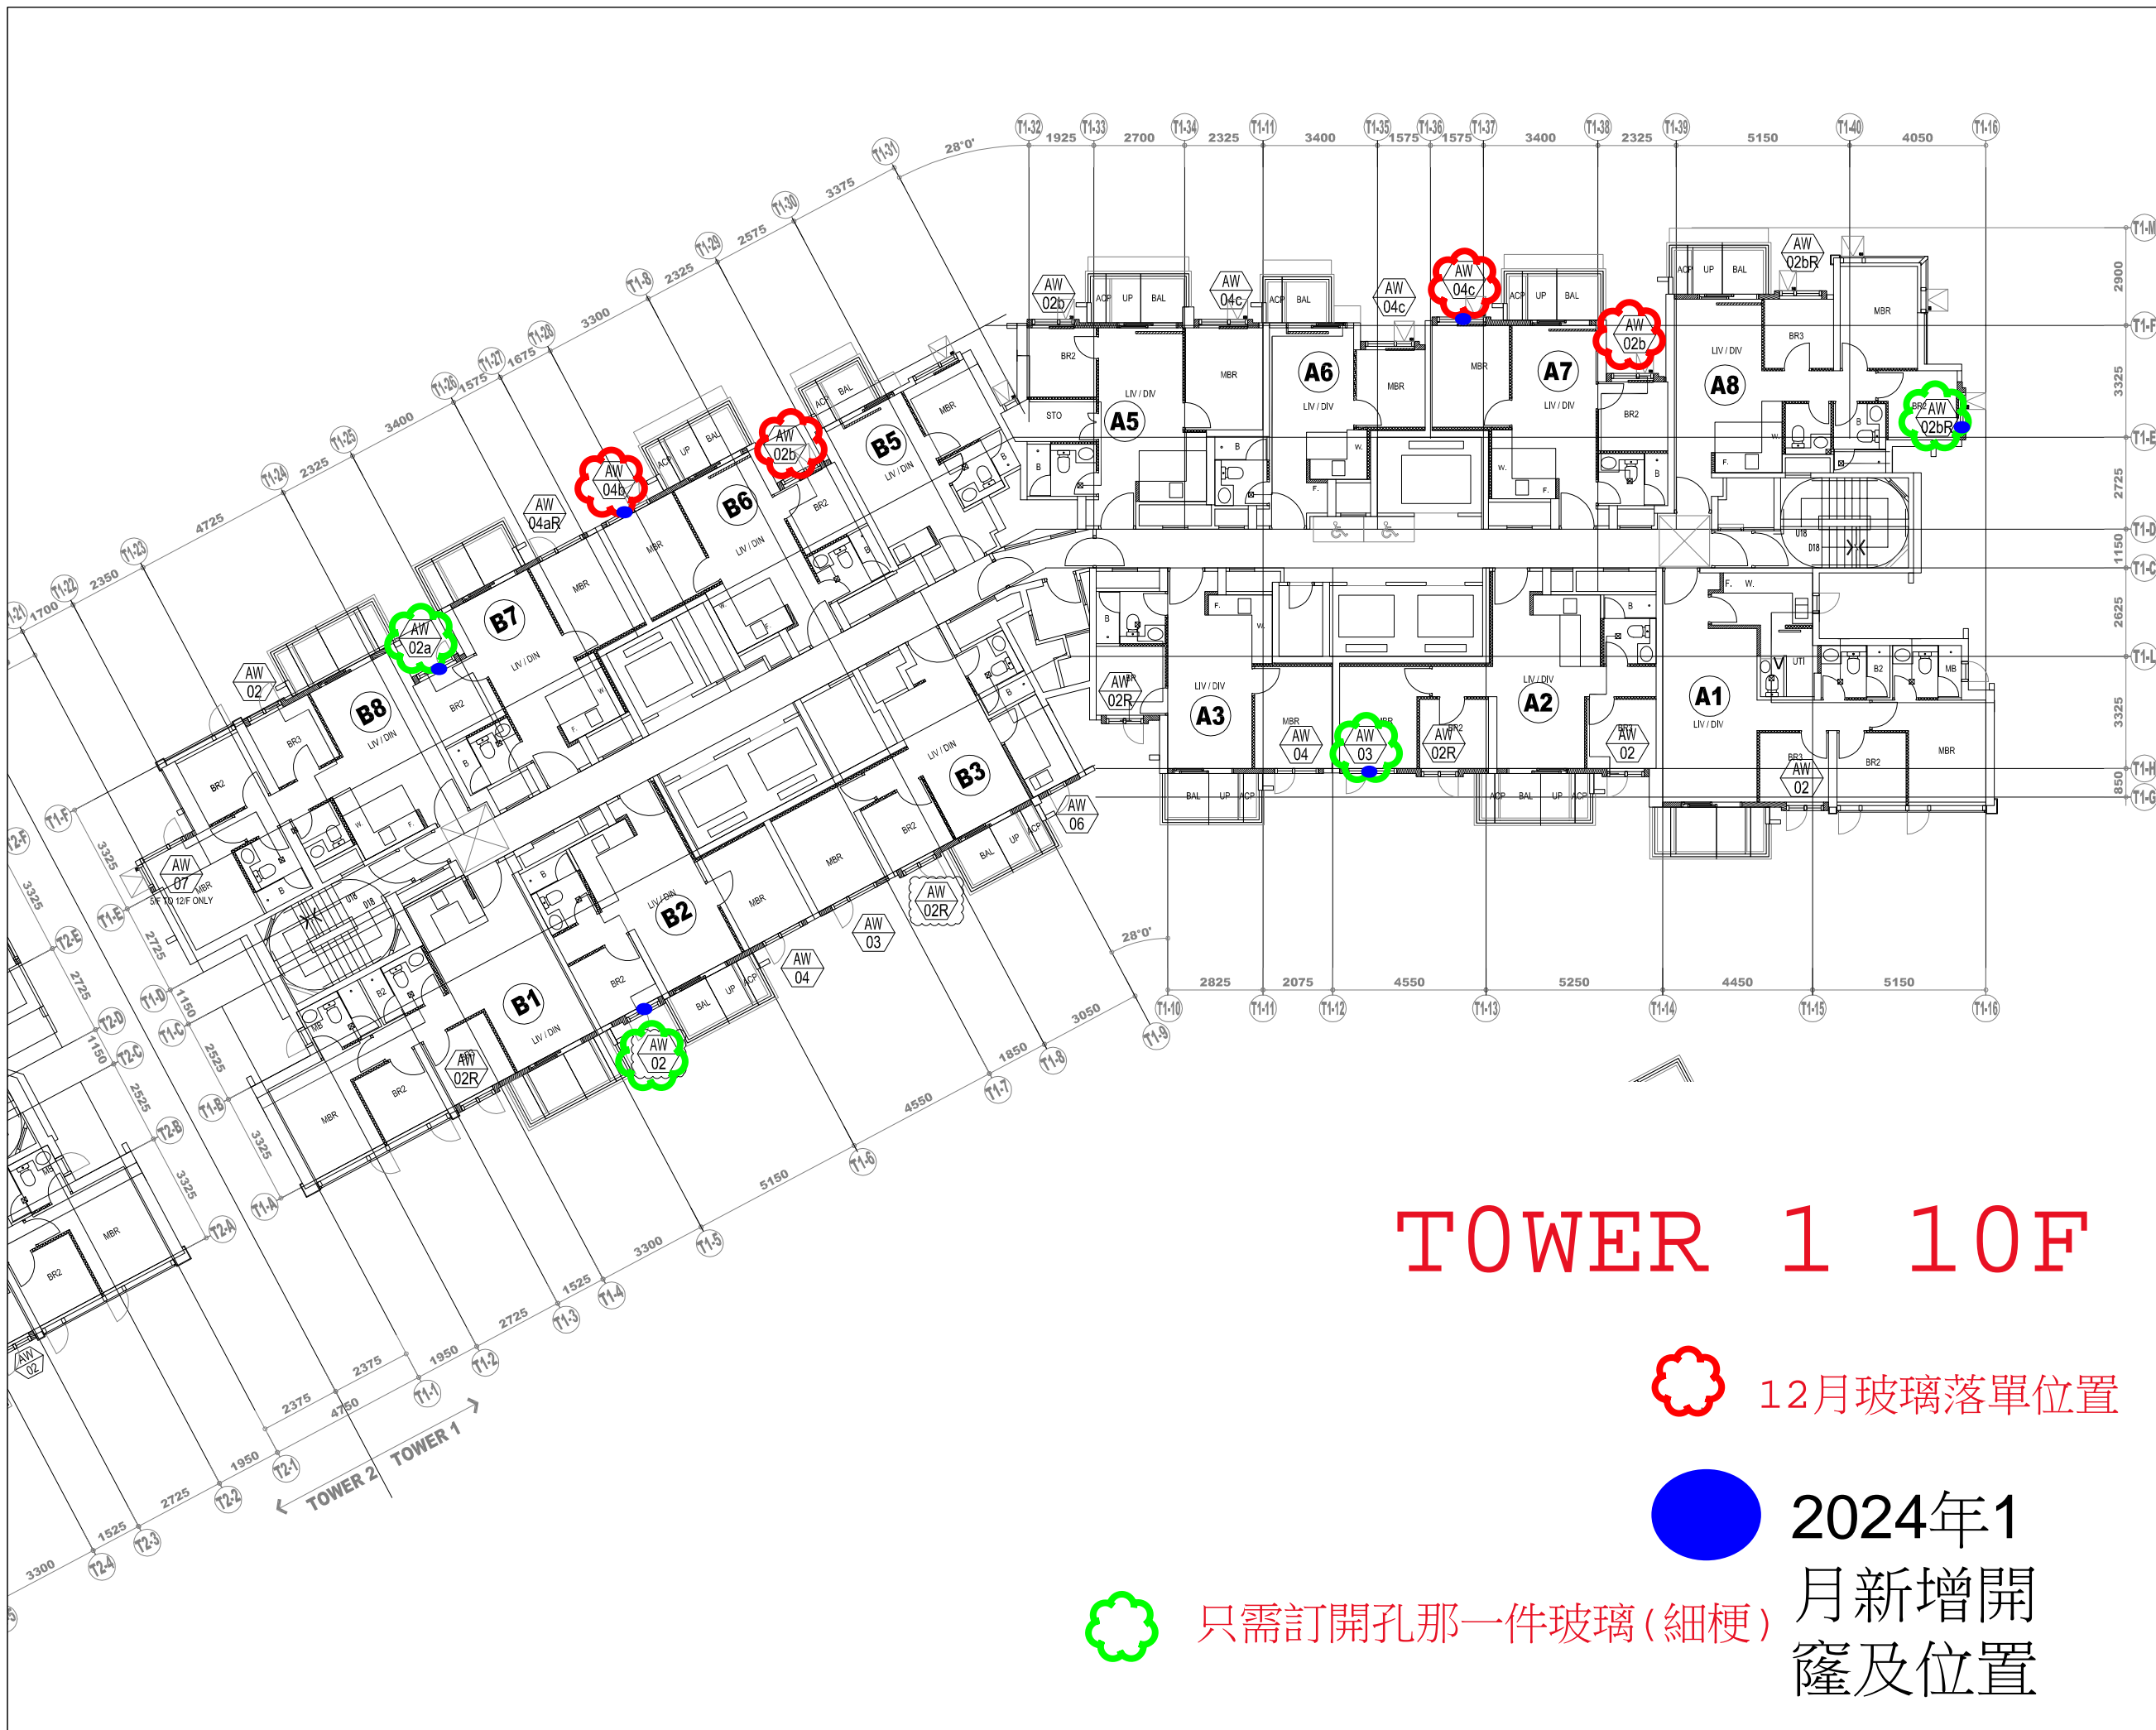
TITLE :
 PLAN FOR PRECAST WINDOW AT TOWER 1

DATE : 02-Aug-21 SCALE : 1:200

DRAWN BY : ivan CHECKED BY :

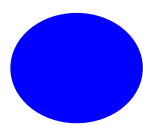

 MIDI ALUMINIUM FABRICATOR LTD.
 Units 6-8, Sunray Industrial Centre, 1/F
 610 Cha Kwo Ling Road, Kowloon
 Tel:23489211-4 Fax:(852)27727666

DWG NO. : J856-SD-IW-3102 REV. : I




TOWER 1 10F


 12月玻璃落單位置


 2024年1月新增開
窿及位置


 只需訂開孔那一件玻璃(細梗)


B.D. REF :

CLIENT :

 42/F SUN HUNG KAI CENTRE, WANCHAI, HONGKONG

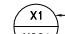
 
ARCHITECT :


MAIN CONTRACTOR :


STRUCTURAL ENGINEER :


FACADE CONSULTANT:


NOTE :
 1. ALL DIMENSIONS ARE IN mm.
 2. ALL ELEVATIONS ARE VIEWED FROM OUTSIDE.
 3. ALL DIMENSIONS TO BE VERIFIED ON SITE BEFORE FABRICATION.

LEGEND :
 — DETAIL MARK NO.
 — REFER SHEET NO.

I	24/04/2023	REVISION SUBJECT TO SITE MEMO-1324	lvn
H	21/02/2023	UPDATE 14TH 20230119 GBP	lvn
G	14/11/2022	UPDATE 14TH 20221109 GBP	lvn
F	26/10/2022	UPDATE GBP PLAN	yi
E	16/08/2022	REVISION SUBJECT TO ARCH.COMMENT	lvn
D	27/06/2022	REVISION SUBJECT TO ARCH.COMMENT	lvn
C	29/11/2021	REVISION SUBJECT TO ARCH.COMMENT	lvn
B	03/11/2021	REVISION SUBJECT TO ARCH.COMMENT	lvn
A	18/10/2021	REVISION SUBJECT TO ARCH.COMMENT	lvn
NO.	DATE	REVISED	BY


JOB NO. : J-856

PROJECT :
 PROPOSED DEVELOPMENT ABOVE LIGHT RAIL TIN WING STOP, TSWTL NO.23, AREA 33, TIN SHUI WAI, N.T.

TITLE :
 PLAN FOR PRECAST WINDOW AT TOWER 1

DATE : 02-Aug-21 SCALE : 1:200

DRAWN BY : lvn CHECKED BY :


 MIDI ALUMINIUM FABRICATOR LTD.
 Units 6-8, Sunray Industrial Centre, 1/F
 610 Cha Kwo Ling Road, Kowloon
 Tel:23489211-4 Fax:(852)27727666

DWG NO. : J856-SD-IW-3102 REV. : I