



工程指示 / 要求簡箋 ENGINEER INSTRUCTIONS(E.I.)

工程指示編號:	EI- 7732	修改版本:	-
	HK- 0818		
工程編號:	J 856	工程名稱:	天榮站
收件人:	生統/York	發件人:	Iris
工程項目:	T1售樓處隔音板(BM表+加工圖) (樣板)	日期:	09/05/2024

<input checked="" type="checkbox"/> 原合約工程包	<input type="checkbox"/> 原合約工程加 / 減賬 QT-	<input checked="" type="checkbox"/> 新工程報價 QT-
--	--	---

信件批核號碼/圖紙參考編號:	批核模具圖紙編號:
客戶指示附件:	管理內部批簽署:

<input type="checkbox"/> 初步鋁料 B.M.	<input type="checkbox"/> 加工拆圖, 然後生產	<input type="checkbox"/> 尺寸表
<input type="checkbox"/> 正式鋁料 B.M.	<input type="checkbox"/> 技術上資料/指示	<input type="checkbox"/> 報價
<input type="checkbox"/> 配件 B.M.	<input type="checkbox"/> 樣辦或貨品說明書	<input type="checkbox"/> 分判合約
<input type="checkbox"/> 其他:		

內容: T1售樓處隔音板(BM表+加工圖)(樣板)
完成上列要求日期: 23/05/2024


國內

<input type="checkbox"/> 生產技術總監	<input type="checkbox"/> 連附件	<input checked="" type="checkbox"/> 技術部	<input checked="" type="checkbox"/> 連附件	<input type="checkbox"/> 生產部	<input type="checkbox"/> 連附件
<input type="checkbox"/> 採購部	<input type="checkbox"/> 連附件	<input checked="" type="checkbox"/> 生產統籌部	<input checked="" type="checkbox"/> 連附件	<input type="checkbox"/> 報關組	<input type="checkbox"/> 連附件
<input type="checkbox"/> 質檢部	<input type="checkbox"/> 連附件	<input type="checkbox"/> 會計部	<input type="checkbox"/> 連附件	<input type="checkbox"/> 機械設計部	<input type="checkbox"/> 連附件
<input type="checkbox"/> 香港辦	<input type="checkbox"/> 連附件	<input type="checkbox"/> 其他:			

香港

<input type="checkbox"/> 行政部	<input type="checkbox"/> 連附件	<input type="checkbox"/> 會計部	<input type="checkbox"/> 連附件	<input type="checkbox"/> 統籌部	<input type="checkbox"/> 連附件	<input type="checkbox"/> 工程部	<input type="checkbox"/> 連附件
<input type="checkbox"/> 採購部	<input type="checkbox"/> 連附件	<input type="checkbox"/> QS部	<input type="checkbox"/> 連附件	<input checked="" type="checkbox"/> 地盤管理	<input checked="" type="checkbox"/> 連附件	<input type="checkbox"/> 維修部	<input type="checkbox"/> 連附件

*發件人簽署: Iris	*組別成員批核簽署:
傳遞編號:	項目經理簽署:


 美特鋁質 有限公司 MIDI Aluminium Fabricator Ltd.		工程號: I-856	計算: 劉龍浩	日期: 2024.5.6	送呈: 胡哥	註明: 計算參考數值/ 所屬位置分格							
廠用隔音板B.M.表		地盤名稱: 天水圍天榮站	核對: 謝永林	日期: 2024.5.8	副本:								
		項目類別: T1售樓處隔音板	批准:	A/C Code:									
		修改版次:			2.850								
序號	修改內容	隔音板編號	顏色與類型/加工圖參考	厚度 (mm)	隔音板尺寸		數量	總面積 (平方米)	使用位置	分座	分格寬度	分格高度	使用窗號
					寬度 (W mm)	高度 (H mm)							
1	寬度待定 2	L-BH05a	3mm THK. MIRCOPERFORATED ABSORBER	3	1278 1268	2230.5	1	2.850	A8	T1座	1298	2263.5	AW-A-05a
						合計:	1	2.850					

說明: 現寬度按客戶要求框料到邊-10, 未按設計圖框料到邊-15。



美特鋁質 有限公司
MIDI Aluminium Fabricator Ltd.

工程號 J856 | 地盤 天榮站

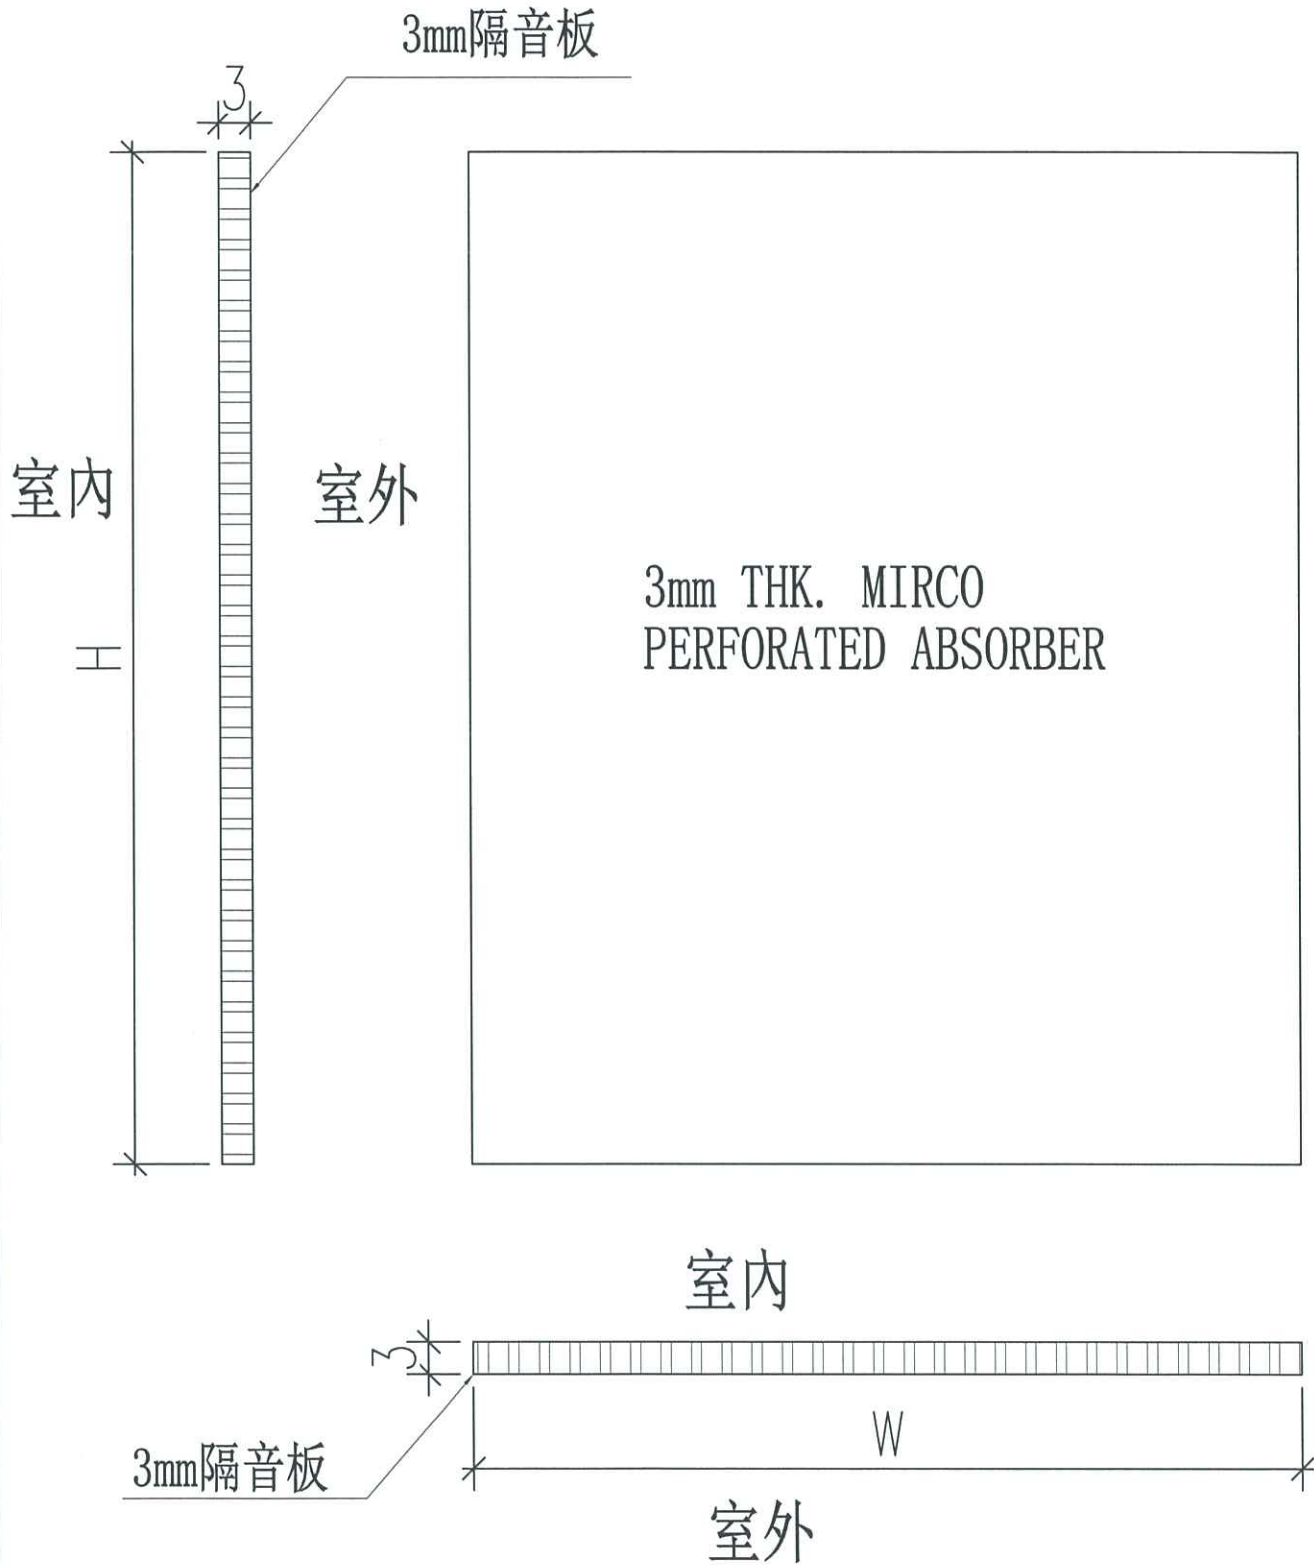

名稱	3mm 隔音板	制圖	劉龍浩	2024. 5. 6	修改			
材料	/	復核	謝永林	2024. 5. 8	日期			
顏色	見圖	批准			圖號	L-BH		

B.D. REF :

CLIENT : **SUN HUNG KAI REAL ESTATE GROUP LTD.**
42/F SUN HUNG KAI CENTRE, WANCHAI, HONGKONG

ARCHITECT : **lwk&partners**
Architects & Engineers

MAIN CONTRACTOR : **怡和建築有限公司**
Yee Ho Fall Building Contractors Ltd.

STRUCTURAL ENGINEER : **ARUP**

FAÇADE CONSULTANT : **ALPHA CONSULTING LIMITED**
Steel Structure & Façade Specialist

NOTE:

1. ALL DIMENSIONS ARE IN MM.
2. ALL ELEVATIONS ARE VIEWED FROM OUTSIDE.
3. ALL DIMENSIONS TO BE VERIFIED ON SITE BEFORE FABRICATION.

LEGEND:

① DETAIL MARK NO.
② REFER SHEET NO.

1. F.F.L. --- FINISHED FLOOR LEVEL
2. S.F.L. --- STRUCTURAL FLOOR LEVEL
3. R.F.L. --- REVERSED DETAIL
4. GLASS LEGEND

EQ-1 --- 6mmES+12mm AIR GAP+10mmIP THK. LGLU
EQ-2 --- 10mm THK. CRYSAL GRAY TEMPERED GLASS
EQ-4 --- 10mm THK. CRYSAL TINTED AND ETCHED GLASS
EQ-1A --- 6mmES+12mm AIR GAP+6mmIP THK. LGLU
BT/BBT --- TUNG DETAIL (DWC. NO. F101)
BB2-FINING DETAIL (DWC. NO. F102)

CLAZING AREA
OPENABLE AREA

JOB NO. : J-856

DATE :
REVISED :
BY :


PROJECT : PROPOSED DEVELOPMENT ABOVE LIGHT RAIL TRAM STOP, ISWTL NO.23, AREA 35.31N SHUI WAH, N.T.

TITLE : WINDOW SCHEDULE FOR FOR SALES MOCK-UP AT TOWER 1 IN-SITU WINDOW

DATE : 02-Aug-21 SCALE : 1:40
DRAWN BY : Ivan CHECKED BY :

MIDI ARCHITECTURAL PRACTICE LTD.
Units 6-8, Sunny Industrial Centre, 1/F
180-182, Sunny Industrial Centre, 1/F
182-188, Sunny Industrial Centre, 1/F
Tel: (852) 27272668 Fax: (852) 27272668

DWG NO. : JS56-SD-MU-5101 REV. : F

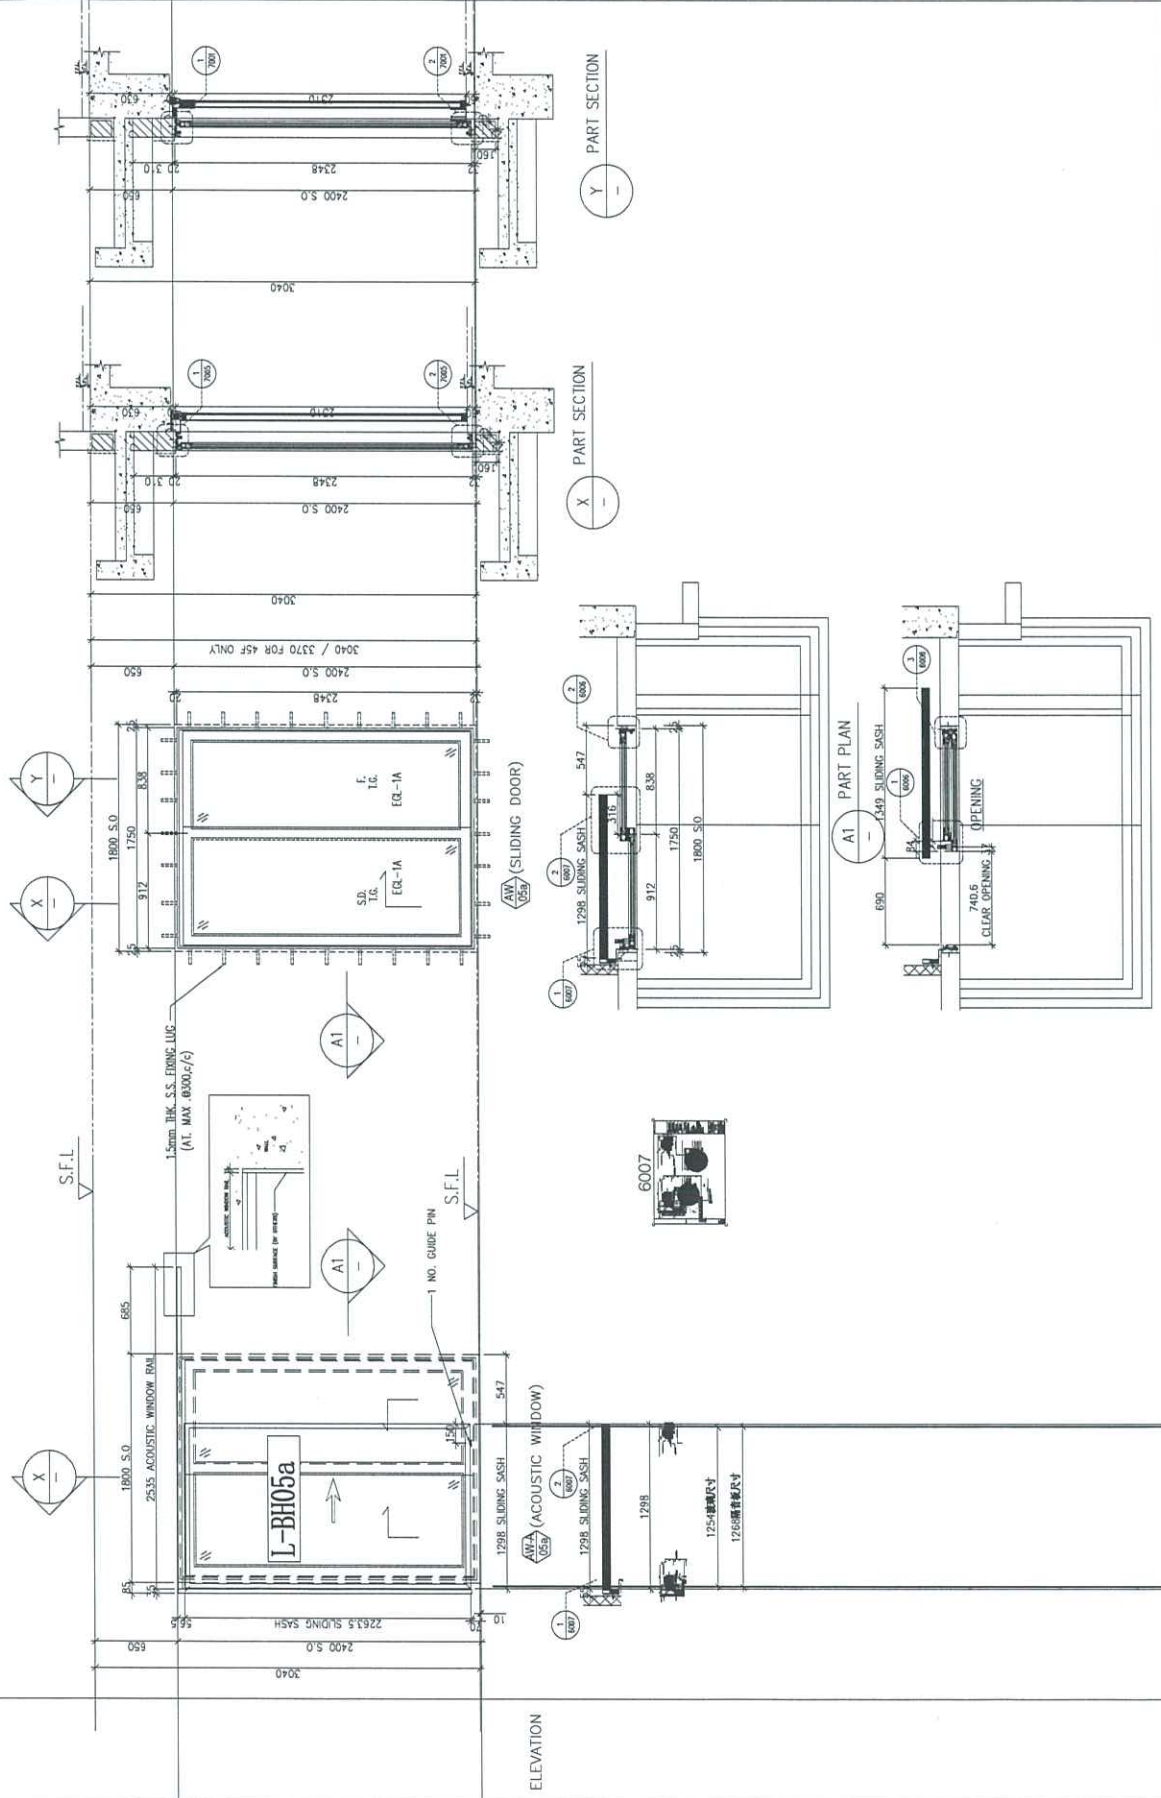

WINDOW MARK	AW (55W) & AW (55W) (ACOUSTIC WINDOW)
LOCATION	36/F UNIT A8
SECTION	70mm ALUM. SECTION
GLAZING	EQ-1A
QUANTITY	1 No.
REMARKS	FAÇADE (TYPE T1PF07 FOR 5/F~42/F)