



工程指示 / 要求簡箋 ENGINEER INSTRUCTIONS(E.I.)

工程指示編號:	EI- 8333	修改版本:	-
	HK- 1701		
工程編號:	J 856	工程名稱:	天榮站
收件人:	生統/Maggie/謝永林	發件人:	Iris
工程項目:	T1隔音門窗鐵件加工圖(廠用)✓	日期:	14/09/2024

<input checked="" type="checkbox"/> 原合約工程包	<input type="checkbox"/> 原合約工程加 / 減賬 QT-	<input type="checkbox"/> 新工程報價 QT-
--	--	------------------------------------

信件批核號碼/圖紙參考編號:	批核模具圖紙編號:
客戶指示附件:	管理內部批簽署:

<input type="checkbox"/> 初步鋁料 B.M.	<input type="checkbox"/> 加工拆圖, 然後生產	<input type="checkbox"/> 尺寸表
<input type="checkbox"/> 正式鋁料 B.M.	<input type="checkbox"/> 技術上資料/指示	<input type="checkbox"/> 報價
<input type="checkbox"/> 配件 B.M.	<input type="checkbox"/> 樣辦或貨品說明書	<input type="checkbox"/> 分判合約
<input type="checkbox"/> 其他:		

內容:
T1隔音門窗鐵件加工圖

需熱浸鋅處理及提供證書


完成上列要求日期: 01/10/2024

國內

<input type="checkbox"/> 生產技術總監	<input type="checkbox"/> 連附件	<input checked="" type="checkbox"/> 技術部	<input checked="" type="checkbox"/> 連附件	<input type="checkbox"/> 生產部	<input type="checkbox"/> 連附件
<input type="checkbox"/> 採購部	<input type="checkbox"/> 連附件	<input checked="" type="checkbox"/> 生產統籌部	<input checked="" type="checkbox"/> 連附件	<input type="checkbox"/> 報關組	<input type="checkbox"/> 連附件
<input type="checkbox"/> 質檢部	<input type="checkbox"/> 連附件	<input type="checkbox"/> 會計部	<input type="checkbox"/> 連附件	<input type="checkbox"/> 機械設計部	<input type="checkbox"/> 連附件
<input type="checkbox"/> 香港辦	<input type="checkbox"/> 連附件	<input type="checkbox"/> 其他:			


香港

<input type="checkbox"/> 行政部	<input type="checkbox"/> 連附件	<input type="checkbox"/> 會計部	<input type="checkbox"/> 連附件	<input type="checkbox"/> 統籌部	<input type="checkbox"/> 連附件	<input type="checkbox"/> 工程部	<input type="checkbox"/> 連附件
<input checked="" type="checkbox"/> 採購部	<input checked="" type="checkbox"/> 連附件	<input type="checkbox"/> QS部	<input type="checkbox"/> 連附件	<input checked="" type="checkbox"/> 地盤管理	<input checked="" type="checkbox"/> 連附件	<input type="checkbox"/> 維修部	<input type="checkbox"/> 連附件

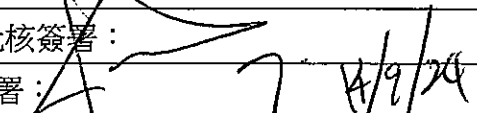*發件人簽署: Iris	*組別成員批核簽署:
傳遞編號:	項目經理簽署: 

圖則登記表
DRAWING REGISTER

接收日期 Receiving Date (適用於客戶圖則)									
工程名稱 Project Title:	天水圍天榮站	年							
	隔音門窗T1座鐵件拆圖 (廠用)	月							
工程編號 Project No:	J-856	日							
分發予 Distributed To									
		年	24						
		月	09						
		日	13						
圖則編號 Drg. No.	圖則名稱 Drawing Title		修訂編號 Revision No.						
TB-H01	鐵板加工圖	1	-						
TB-H02	鐵板加工圖	2	-						
TB-H03	鐵板加工圖	3	-						
J856-SD-AS-5103	鐵件位置圖	4	-						
J856-SD-AS-5104	鐵件位置圖	5	-						
J856-SD-AS-5106	鐵件位置圖	6	-						

 美特鋁質有限公司 MIDI Aluminium Fabricator Ltd.	工程號: J-856	計算:	周廣志	日期:	2024.09.12	送呈: 胡哥
	地盤名稱: 天榮站	核對:	謝永林	日期:	2024.09.13	副本:
廠用鐵件B.M.表	項目類別: 隔音門窗T1座鐵件	批准:		日期:		總重量: 1553.55 KG
A/C Code:						
此BM依據拆圖資料計算						

序號	修改內容	物料編號	配件名稱	顏色	實用	後備	總數	單件重量		備注	
								單位	總重量		
								KG			
1		TB-H01	鐵板加工圖	熱浸鋅/涂滌青油	27	0	27	件	5.746	155.147	
2		TB-H02	鐵板加工圖	熱浸鋅/涂滌青油	113	0	113	件	5.746	649.321	
3		TB-H03	鐵板加工圖	熱浸鋅/涂滌青油	112	0	112	件	6.688	749.078	
								合計:	252	合計:	1553.546



美特鋁質有限公司
MIDI Aluminium Fabricator Ltd.




廠用

工程號 J856 地盤 天榮站

序號	物料編號	分座	使用位置	使用樓層	窗號	樓層	每層數	數量	長度L
1	TB-H01	T1座	A8-BR3	6/F-12/F	AW-A-02bR	7	1	7	1220
2	TB-H01	T1座	A8-BR2	3/F-26F		20	1	20	
								合計：	27

(外)

左

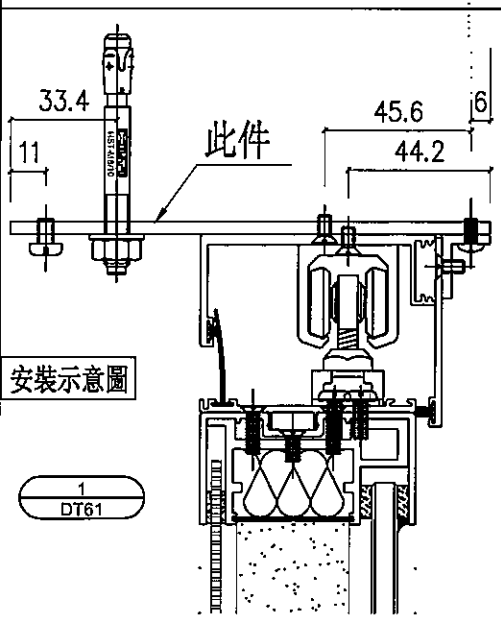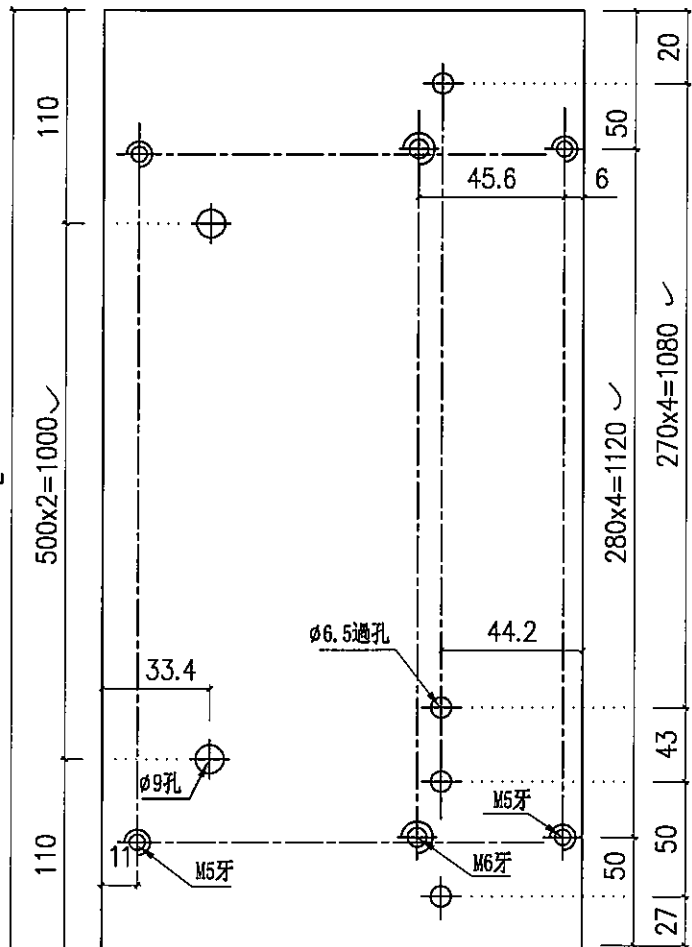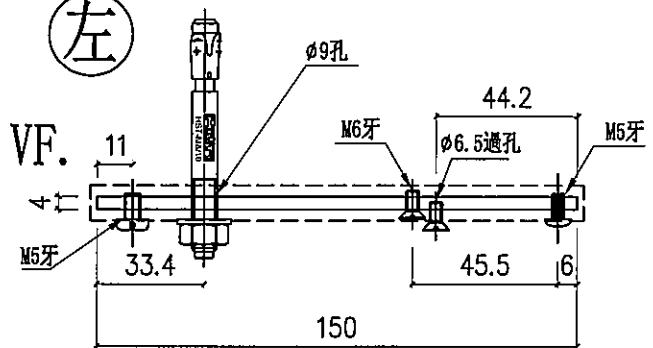

名稱	鐵板加工圖	制圖	周廣志	2024.09.05	修改		
材料	150x4mm鐵板	復核	謝永林	2024.09.12	日期		
顏色	熱浸鋅/塗瀝青油	批准			圖號	TB-H01	






美特鋁質有限公司
MIDI Aluminium Fabricator Ltd.

廠用

工程號 J856 地盤 天榮站

序號	物料編號	分座	使用位置	使用樓層	窗號	樓層	每層數	數量	長度L
1	TB-H02	T1座	A5-BR2	3/F-46/F	AW-A-02b	38	1	38	1220
2	TB-H02	T1座	A7-BR2	3/F-45/F		37	1	37	
3	TB-H02	T1座	B6-BR2	3/F-46/F		38	1	38	
合計：								113	

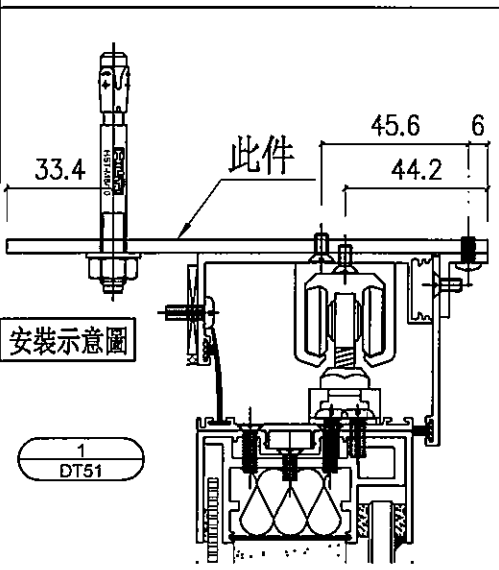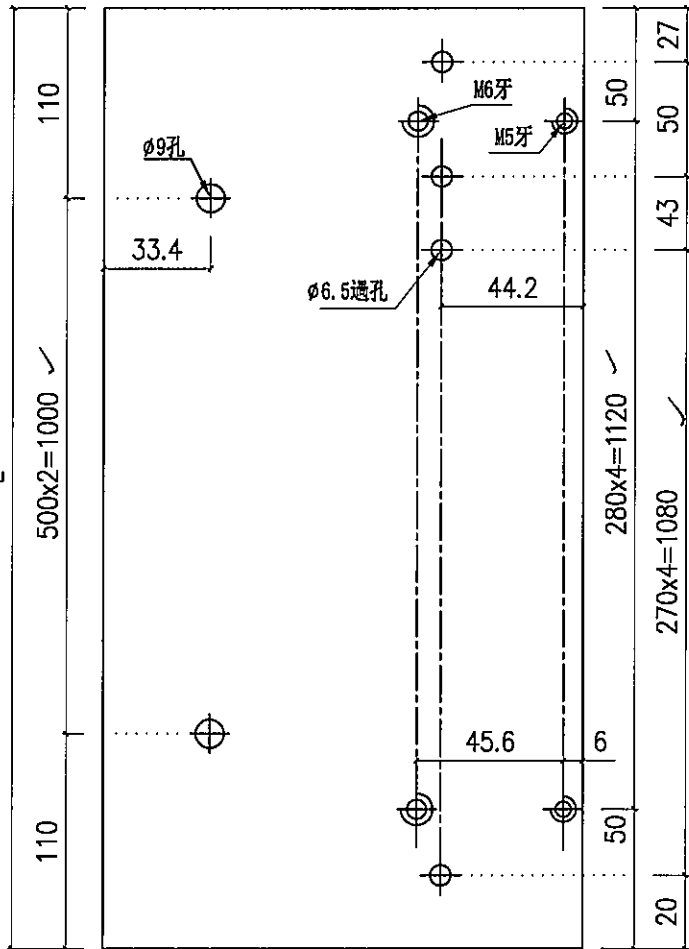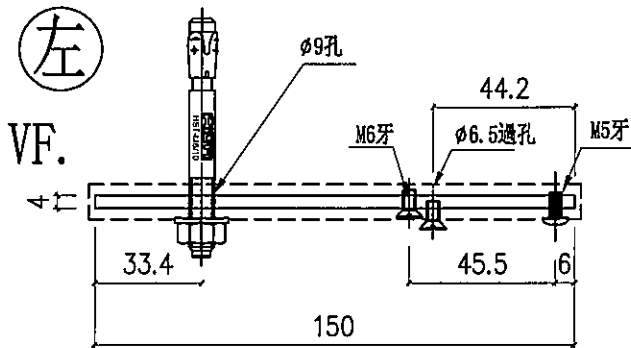

名稱	鐵板加工圖	制圖	周廣志	2024.09.05	修改		
材料	150x4mm鐵板	復核	謝永林	2024.09.12	日期		
顏色	熱浸鋅/塗瀝青油	批准			圖號	TB-H02	






美特鋁質有限公司
MIDI Aluminium Fabricator Ltd.

廠用

工程號 J856 地盤 天榮站

序號	物料編號	分座	使用位置	使用樓層	窗號	樓層	每層數	數量	長度L
1	TB-H03	T1座	A5-MBR	3/F-46/F	AW-A-04c	38	1	38	1420
2	TB-H03	T1座	A6-MBR	3/F-45/F		37	1	37	
3	TB-H03	T1座	A7-MBR	3/F-45/F		37	1	37	
合計：								112	

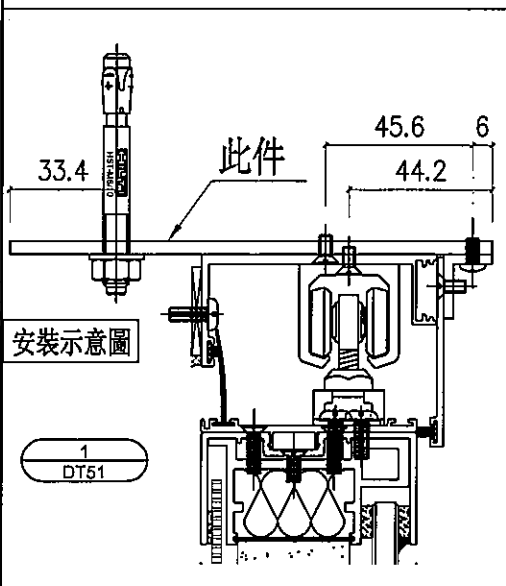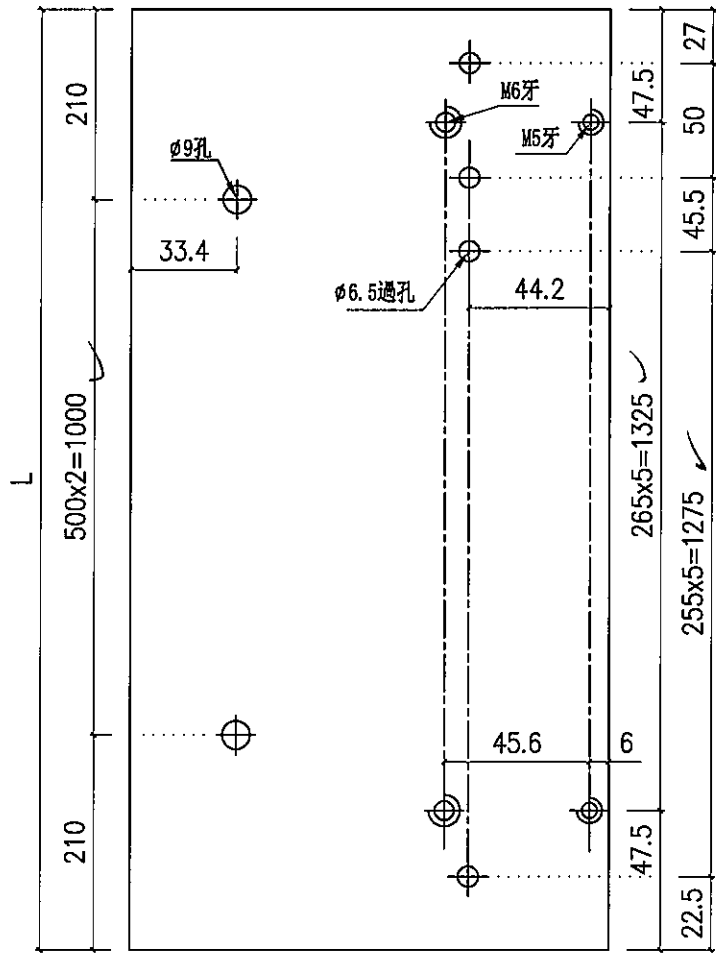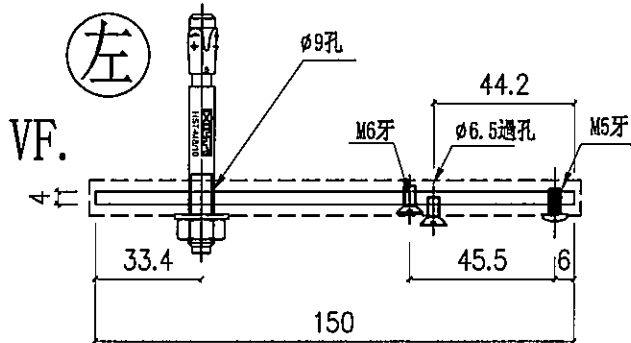

名稱	鐵板加工圖	制圖	周廣志	2024.09.05	修改		
材料	150x4mm鐵板	復核	謝永林	2024.09.12	日期		
顏色	熱浸鋅/塗瀝青油	批准			圖號	TB-H03	

REV. NO. :

CLIENT : SHIMAO GROUP HOLDINGS LIMITED

ARCHITECT : YONG TAI & PARTNERS LIMITED



MAIN CONTRACTOR : 協興建築有限公司 HOP HING CONSTRUCTION CO. LTD



STRUCTURAL ENGINEER : CHAI WONG & ASSOCIATES LTD 兆基建築工程師有限公司



FRAME CONSULTANT: MENHARDT

NOTE:

1. ALL DIMENSIONS ARE IN MM.
2. ALL DIMENSIONS ARE NOTED FROM OUTSIDE.
3. ALL DIMENSIONS TO BE WORKED ON SITE BEFORE FABRICATION.

LEGEND:

- ① — DETAIL MARK NO.
- ② — REFER SHEET NO.
- 1. FFL — FINISHED FLOOR LEVEL.
- 2. SFL — STRUCTURAL FLOOR LEVEL.
- 3. @ — REVERSED DETAIL.
- 4. CLASS LEGEND.

- ES-1 — 10mm THK CLEAR GLASS W/ 100mm THK UGLL
- ES-2 — 10mm THK CLEAR TINTED GLASS
- ES-3 — 10mm THK TINTED AND LEADED GLASS
- ES-4 — 10mm THK TINTED AND LEADED GLASS W/ 100mm THK UGLL AND 100mm THK UGLL
- ES-5 — 10mm THK UGLL

B. 1. 1/2" ALUMINUM	REFERENCE SUBJECT TO ANNOTATION
C. 1. 1/2" ALUMINUM	REFERENCE SUBJECT TO ANNOTATION
D. 1. 1/2" ALUMINUM	REFERENCE SUBJECT TO ANNOTATION
E. 1. 1/2" ALUMINUM	REFERENCE SUBJECT TO ANNOTATION

JOB NO. : J-858

PROJECT : PROPOSED DEVELOPMENT ABOVE LIGHT RAIL TRAIN STATION AT NO.23 AREA 33, 37th ST/1st WA, H.K.

TITLE : WINDOW SCHEDULE FOR TOWER 1 ACOUSTIC WINDOW


DATE : 06-Jun-23

SCALE : 1:40


DRAWN BY : Iven

CHECKED BY :


REV. : D

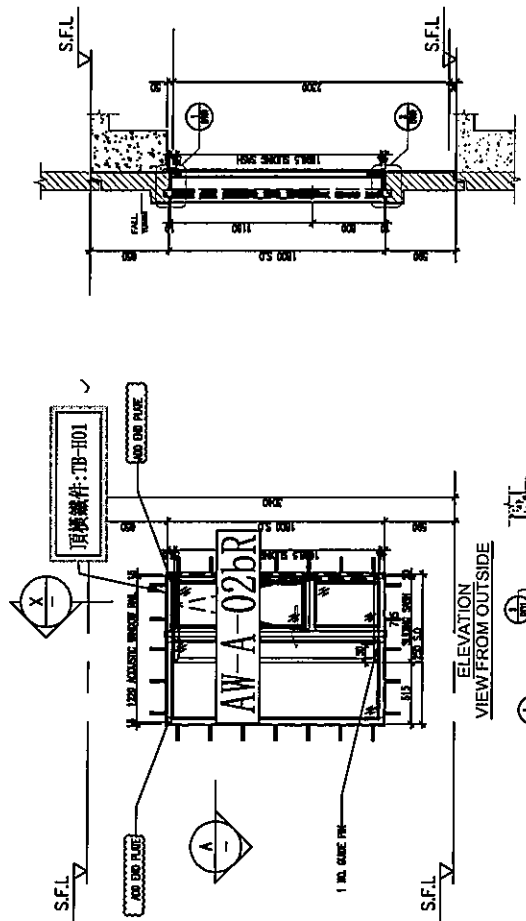

ELEVATION VIEW FROM OUTSIDE

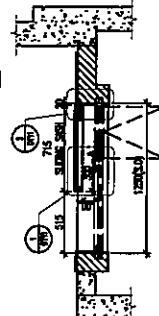

PART SECTION A-A

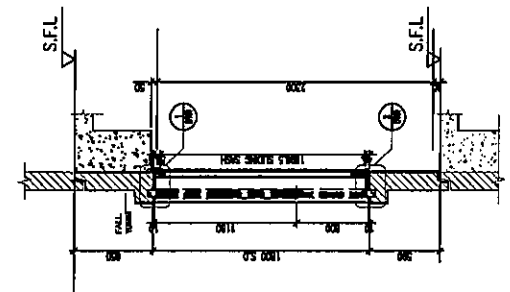

PART SECTION X-X

AW-A-02bR	
LOCATION	A8-BR3 A8-BR2
FLOOR	6/F-12/F 3/F-26/F
MPA	YES YES
TOP & SIDE SAM	NO NO
QUANTITY	7 20
OVERLAPPING(REQUIRE)	253 253
OVERLAPPING(PROVIDED)	300 300

R.A. REF :

CLIENT :
SHIMAO GROUP HOLDINGS LIMITED

ARCHITECT :
YIP YUNG & ASSOCIATES LIMITED



M&E CONTRACTOR :
**協興建築有限公司
HOP HING CONSTRUCTION CO LTD**

STRUCTURAL ENGINEER :

CMA
CHAI WONG & ASSOCIATES LTD
香港中環皇后大道中

PROJECT CONSULTANT:



NOTE :
1. ALL DIMENSIONS ARE IN MM.
2. ALL ELEVATIONS ARE VIEWED FROM OUTSIDE.
3. ALL DIMENSIONS TO BE WORKED ON SITE BEFORE FABRICATION.

LEGEND :

- ① — DETAIL WORK NO.
- ② — REFER SHEET NO.
- 1. EFF — FINISHED FLOOR LEVEL
- 2. S.F.L — STRUCTURAL FLOOR LEVEL
- 3. ② — RECESSED SECTION
- 4. CLASS LEGEND

CLASS-1 — HANDMADE/FORM AS PER DRAWING THE LOCAL
CLASS-2 — FORM THE CLEAR TYPED/FORM CLASS
CLASS-3 — FORM THE TYPED/FORM CLASS COATED GLASS
CLASS-4 — HANDMADE/FORM AS PER DRAWING THE LOCAL
CLASS-5 — FORM THE LOCAL (CLASS NO. 1/2/3/4)
CLASS-6 — FORM THE LOCAL (CLASS NO. 7/8/9)

1	MPA/MPA	RENDER SUBJECT TO APPROVAL
2	MPA/MPA	RENDER SUBJECT TO APPROVAL
3	MPA/MPA	RENDER SUBJECT TO APPROVAL
4	MPA/MPA	RENDER SUBJECT TO APPROVAL
5	MPA/MPA	RENDER SUBJECT TO APPROVAL
6	MPA/MPA	RENDER SUBJECT TO APPROVAL

JOB NO. : J-558

PROJECT :
PROPOSED DEVELOPMENT ABOVE
EXISTING BUILDING AT THE
NO. 33, 35, 37, 3929, 3931

DATE: 08-Jun-23

CLIENT: SHIMAO GROUP HOLDINGS LIMITED

ARCHITECT: SHIMAO GROUP HOLDINGS LIMITED

MAIN CONTRACTOR: 協同建築有限公司 HIP HING CONSTRUCTION CO LTD

STRUCTURAL ENGINEER: CHA CHONG & ASSOCIATES LTD 齊志軒建築工程師有限公司

FAÇADE CONSULTANT: AENHARD

NOTE: 1. ALL DIMENSIONS ARE IN MM. 2. ALL ELEVATIONS ARE VIEWED FROM OUTSIDE. 3. ALL DIMENSIONS TO BE WORKED ON SITE BEFORE FABRICATION.

LEGEND: (X) - DETAIL MARK NO. (Y) - REFER SHEET NO. 1. FFL - FINISHED FLOOR LEVEL 2. SFL - STRUCTURAL FLOOR LEVEL 3. (A) - REVERSED DETAIL 4. CLASS LEGEND

REV: 1 - Issued 12mm AIR GAP-10mmTP THE CALL OUT 2 - From THE CLEAR TEMPERED GLASS 3 - From THE TEMPERED AND ECHED GLASS 4 - From THE TEMPERED AND ECHED GLASS 5 - From THE TEMPERED AND ECHED GLASS 6 - From THE TEMPERED AND ECHED GLASS 7 - From THE TEMPERED AND ECHED GLASS 8 - From THE TEMPERED AND ECHED GLASS 9 - From THE TEMPERED AND ECHED GLASS 10 - From THE TEMPERED AND ECHED GLASS

JOB NO.: J-006

PROJECT: PROPOSED DEVELOPMENT ABOVE UNIT AND TEN WINGS STRIPS WITH HOLDING AREA, 35/FIN 36/FIN W/L, H.L.


TITLE: WINDOW SCHEDULE FOR TOWER 1 ACOUSTIC WINDOW

DATE: 08-Jun-23 SCALE: 1:40

DRAWN BY: Yuen CHECKED BY:

SHIMAO GROUP HOLDINGS LIMITED
 310 Cheong Chee Nam Street, Kowloon
 HONG KONG
 TEL: (852) 2422 1111 FAX: (852) 2422 7288

REV: E

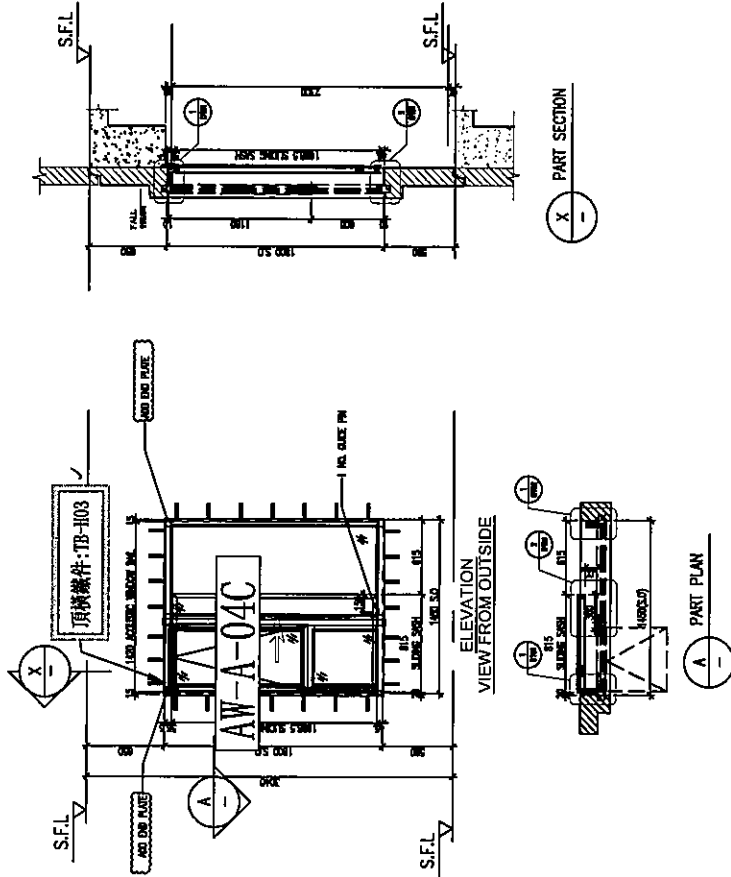

AW-A-04C						
LOCATION	A5-MBR	A6-MBR	A7-MBR			
FLOOR	3/F-46/F	3/F-45/F	3/F-45/F	3/F-45/F		
MPA	YES	YES	YES	YES		
TOP & SIDE SAM	YES	YES	YES	YES		
QUANTITY	38	37	37	37		
OVERLAPPING(REQUIRE)	300	300	300	300		
OVERLAPPING(PROVIDED)	300	300	300	300		