

工程指示 / 要求簡箋 ENGINEER INSTRUCTIONS (E.I.)

工程指示編號:	EI- 8441	修改版本:	-
	HK- 1867		
工程編號:	J 856	工程名稱:	天榮站
收件人:	生統/Maggie	發件人:	Charmant
工程項目:	T1座 46F SIMPLEX 2B MB 增加後裝窗 AW06bR 玻璃BM	日期:	14/10/2024

<input checked="" type="checkbox"/> 原合約工程包	<input type="checkbox"/> 原合約工程加 / 減賬 QT-	<input type="checkbox"/> 新工程報價 QT-
--	--	------------------------------------

信件批核號碼/圖紙參考編號:	批核模具圖紙編號:
客戶指示附件:	管理內部批簽署:

<input type="checkbox"/> 初步鋁料 B.M.	<input type="checkbox"/> 加工拆圖, 然後生產	<input type="checkbox"/> 尺寸表
<input type="checkbox"/> 正式鋁料 B.M.	<input type="checkbox"/> 技術上資料/指示	<input type="checkbox"/> 報價
<input type="checkbox"/> 配件 B.M.	<input type="checkbox"/> 樣辦或貨品說明書	<input type="checkbox"/> 分判合約
<input type="checkbox"/> 其他:		

內容: T1座 46F SIMPLEX 2B MB 按客人要求, 需增加一件後裝窗 AW06bR 附此窗玻璃BM
完成上列要求日期: 18/11/2024

國內

<input type="checkbox"/> 生產技術總監	<input type="checkbox"/> 連附件	<input checked="" type="checkbox"/> 技術部	<input checked="" type="checkbox"/> 連附件	<input type="checkbox"/> 生產部	<input type="checkbox"/> 連附件
<input type="checkbox"/> 採購部	<input type="checkbox"/> 連附件	<input checked="" type="checkbox"/> 生產統籌部	<input checked="" type="checkbox"/> 連附件	<input type="checkbox"/> 報關組	<input type="checkbox"/> 連附件
<input type="checkbox"/> 質檢部	<input type="checkbox"/> 連附件	<input type="checkbox"/> 會計部	<input type="checkbox"/> 連附件	<input type="checkbox"/> 機械設計部	<input type="checkbox"/> 連附件
<input type="checkbox"/> 香港辦	<input type="checkbox"/> 連附件	<input type="checkbox"/> 其他:			


香港

<input type="checkbox"/> 行政部	<input type="checkbox"/> 連附件	<input type="checkbox"/> 會計部	<input type="checkbox"/> 連附件	<input type="checkbox"/> 統籌部	<input type="checkbox"/> 連附件	<input type="checkbox"/> 工程部	<input type="checkbox"/> 連附件
<input checked="" type="checkbox"/> 採購部	<input checked="" type="checkbox"/> 連附件	<input type="checkbox"/> QS部	<input type="checkbox"/> 連附件	<input checked="" type="checkbox"/> 地盤管理	<input checked="" type="checkbox"/> 連附件	<input type="checkbox"/> 維修部	<input type="checkbox"/> 連附件

*發件人簽署: Charmant Fok	*組別成員批核簽署:
傳遞編號:	項目經理簽署:




	工程號:	J-856	計算:	周廣志	日期:	2024.10.14	送呈:		註明: 計算參考數值/ 所屬位置分格								
	地盤名稱:	天水圍天榮站	核對:	謝永林	日期:	2024.10.14	副本:										
	地盤用玻璃B.M.表	項目類別:	T1座-50後裝窗	批准:			A/C Code:	正式數									
		修改版次:		總計玻璃面積(平方米):	0.468	依據E18405計算											
序號	修改內容	玻璃編號	顏色與類型/加工圖參考	厚度 (mm)	玻璃尺寸		數量 (塊)	總面積 (平方米)	使用樓層	使用位置	分屬類型	分格1	分格高度	座數	使用窗號	樓層	每層 用量
					寬度 (W mm)	高度 (H mm)											
1		AW-06bR-1	EGL-2	10	450	1040	1	0.468	46/F	T1-SIM. 2B MB	50生窗	580	1190	T1	AW-06bR	1	1
2						合計:	1	0.468									
加工注意事項/玻璃類型描述:		1). 本表中玻璃採用三鑫公司產玻璃,															
		2). 本表中所有玻璃對角線尺寸偏差要求不超過負2mm。															
		3). 本表中玻璃要求粗磨邊處理並倒棱角, 攔河玻璃頂底要精磨邊, 而所有玻璃之入爐方向需保持一致。															
		4). 本表中所有玻璃成品均需做雙面保護, 用透明靜電膠紙加四周一寸FK白膠紙做雙面加固保護處理。															
		5). 本表中所有玻璃成品均需注明室內外及其玻璃編號/使用位置/樓層, 以便識別。															
		EGL-1--8mmHS+12mm AIR GAP+10mmTP THK. I.G.U.															
EGL-1A-8mmHS+12mm AIR GAP+8mmTP THK. I.G.U.																	
EGL-2--10mm THK. CRYSTAL GRAY TEMPERED GLASS(FOR KIT & ST)																	
EGL-4--10mm THK. CRYSTAL TEMPERED ACID ETCHED GLASS(FOR BATH)																	

 美特鋁質有限公司 MIDI Aluminium Fabricator Ltd.				類別		物料號	
修改				制圖	周廣志	2024.10.07	圖號 EGL-2
日期				復核	謝永林	2024.10.11	數量 見BOM表
				批准			位置 見BOM表

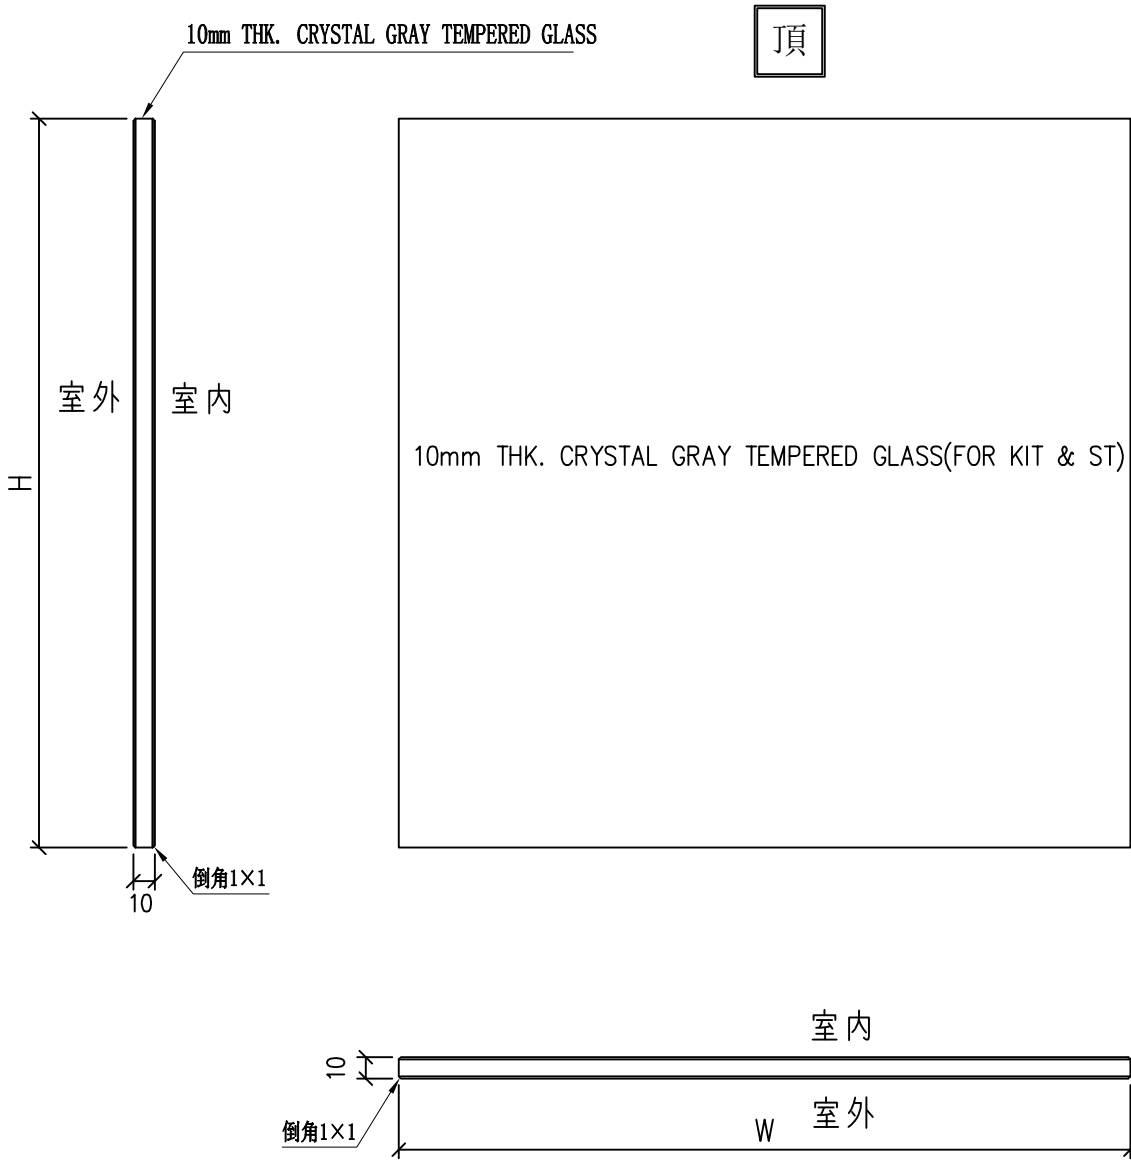

工程號	J-856	地盤	天水圍天榮站	附件
名稱	玻璃加工圖 (50窗玻璃)		採用	
材料		地盤	√	
顏色	10mm THK. CRYSTAL GRAY TEMPERED GLASS		工廠	

LOCATION	REQUIRE		PROVIDED	
	OPENABLE AREA	GLAZING AREA	OPENABLE AREA	GLAZING AREA
A1-M.BATH	0.318	0.318	0.329	0.439
B1-M.BATH	0.318	0.318		

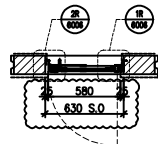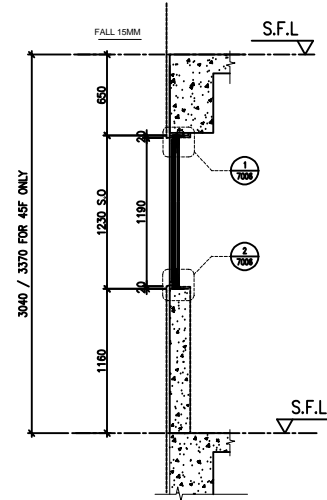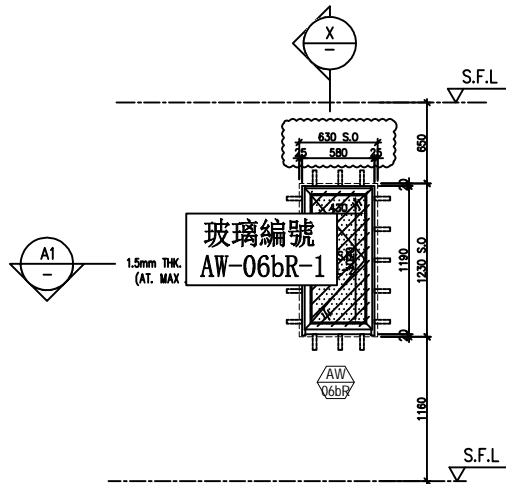

B.D. REF :

CLIENT :
 SUN HUNG KAI
 REAL ESTATE AGENCY LTD.
 45/F SUN HUNG KAI CENTRE, SHIPING, HONGKONG

ARCHITECT :
 IWK&partners
 architects

MAIN CONTRACTOR :
 怡輝建築有限公司
 Yee Fai Building Contractors Ltd.

STRUCTURAL ENGINEER :
 ARUP

FACADE CONSULTANT:
 ALPHA CONSULTING LIMITED
 Steel Structure & Facade Specialist

- NOTE :
- ALL DIMENSIONS ARE IN mm.
 - ALL ELEVATIONS ARE VIEWED FROM OUTSIDE.
 - ALL DIMENSIONS TO BE VERIFIED ON SITE BEFORE FABRICATION.

- LEGEND :
- DETAIL MARK NO.
 REFER SHEET NO.
- F.F.L. --- FINISHED FLOOR LEVEL
 - S.F.L. --- STRUCTURAL FLOOR LEVEL
 - ⊕ --- REVERSED DETAIL
4. GLASS LEGEND
- EGL-1 --- 8mmHS+12mm AIR GAP+10mmTP THK. I.G.U.
- EGL-2 --- 10mm THK. CRYSTAL GRAY TEMPERED GLASS
- EGL-4 --- 10mm THK. CRYSTAL TEMPERED ACID ETCHED GLASS
- EGL-1A --- 8mmHS+12mm AIR GAP+8mmTP THK. I.G.U.
- BT1/BT1 --- FIXING DETAIL (DWG. NO. FD01)
- BB2 --- FIXING DETAIL (DWG. NO. FD02)
- GLAZING AREA
- OPENABLE AREA

6001 TO 6011 & 7001 TO 7008A DETAILS
 REFER TO 3-45F IN-SITU WINDOW SCHEDULE

REV.	DATE	REVISION SUBJECT TO APPROVAL
C	12/03/2023	REVISION SUBJECT TO APPROVAL
B	23/02/2023	REVISION SUBJECT TO APPROVAL
A	08/01/2023	REVISION SUBJECT TO APPROVAL
REV.	DATE	REVISION SUBJECT TO APPROVAL

JOB NO. : J-856

PROJECT :
 PROPOSED DEVELOPMENT ABOVE
 LIGHT RAIL TIN WING STOP, TSWTL
 NO.23, AREA 33, TIN SHUI WAI, N.T.

TITLE :
 WINDOW SCHEDULE FOR
 TOWER 1 IN-SITU WINDOW

DATE : 22-Jun-22 SCALE : 1:40

DRAWN BY : Ivan CHECKED BY :

英特銘有限公司
 MTR 英特銘有限公司
 Units 6-8, Sunny Industrial Centre, 1/F
 810 Cho Kwong Road, Kowloon
 Tel: 23488211-4 Fax: (852) 2727666

DWG NO. : J856-SD-W-5168A REV. : -

ELEVATION

WINDOW MARK	
LOCATION	46/F UNIT SIMPLEX 2B MB
SECTION	50mm ALUM. SECTION
GLAZING	EGL-4
QUANTITY	1 Nos.
REMARKS	50mm ALUM. WINDOW SECTION , 4 BAR HINGE-LIP HING (HHMS-N16)



mandy chow 周珮汶

26/9/2024

➔ 轉寄訊息

RECORD PLAN (46/F)



46樓呢個廁所都要加返隻窗，size同45/F一樣，
46樓窗圖畫埋呢個俾我啊，下星期一有冇？

14:24