

工程指示 / 要求簡箋 ENGINEER INSTRUCTIONS(E.I.)

工程指示編號:	EI- 4040	修改版本:	D
工程編號:	HK- 0622 / 22 J 857	工程名稱:	NKIL6552
收件人:	生統	發件人:	Nero HO
工程項目:	後裝窗, FD門及趟門 - 廠用配件BM	日期:	13/04/2022

<input type="checkbox"/> 原合約工程包	<input type="checkbox"/> 原合約工程加 / 減賬 QT-	<input type="checkbox"/> 新工程報價 QT-
---------------------------------	--	------------------------------------

信件批核號碼/圖紙參考編號:	批核模具圖紙編號:
MS-AR-046	
客戶指示附件:	管理內部批簽署:

<input type="checkbox"/> 初步鋁料 B.M.	<input type="checkbox"/> 加工拆圖, 然後生產	<input type="checkbox"/> 尺寸表
<input type="checkbox"/> 正式鋁料 B.M.	<input type="checkbox"/> 技術上資料 / 指示	<input type="checkbox"/> 報價
<input type="checkbox"/> 配件 B.M.	<input type="checkbox"/> 樣辦或貨品說明書	<input type="checkbox"/> 分判合約
<input type="checkbox"/> 其他:		

內容:

放行: 序號85, 87, 88, 89, 90
取消: 序號86

已通過則師批核 可以訂購配件 送廠加工

***序號90 滑輪需要由膠輪改用銅輪

完成上列要求日期:


國內

<input type="checkbox"/> 生產技術總監	<input type="checkbox"/> 連附件	<input type="checkbox"/> 技術部	<input type="checkbox"/> 連附件	<input type="checkbox"/> 生產部	<input type="checkbox"/> 連附件
<input type="checkbox"/> 採購部	<input type="checkbox"/> 連附件	<input checked="" type="checkbox"/> 生產統籌部	<input checked="" type="checkbox"/> 連附件	<input type="checkbox"/> 報關組	<input type="checkbox"/> 連附件
<input type="checkbox"/> 質檢部	<input type="checkbox"/> 連附件	<input type="checkbox"/> 會計部	<input type="checkbox"/> 連附件	<input type="checkbox"/> 機械設計部	<input type="checkbox"/> 連附件
<input type="checkbox"/> 其他:					

香港

<input type="checkbox"/> 行政部	<input type="checkbox"/> 連附件	<input type="checkbox"/> 會計部	<input type="checkbox"/> 連附件	<input type="checkbox"/> 統籌部	<input type="checkbox"/> 連附件	<input checked="" type="checkbox"/> 工程部	<input checked="" type="checkbox"/> 連附件
<input checked="" type="checkbox"/> 採購部	<input checked="" type="checkbox"/> 連附件	<input type="checkbox"/> QS部	<input type="checkbox"/> 連附件	<input type="checkbox"/> 地盤管理	<input type="checkbox"/> 連附件	<input type="checkbox"/> 維修部	<input type="checkbox"/> 連附件

*發件人簽署:	<i>Mr</i>	*組別成員批核簽署:	<i>Mr</i>
傳遞編號:	HK 0622 / 22	項目經理簽署:	


 美特鋁質有限公司 MIDI Aluminium Fabricator Ltd.	工程號:	J-857	計算:	吳祚瑜	日期:	4/11/2021	送呈:	細佬
	地盤名稱:	啓德6552	核對:	王禮秋	日期:	4/11/2021	副本:	
廠用配件B.M.表	項目類別:	後裝窗, FD門及趟門	批准:		日期:			
BM編號: EI4040D(2022.4.13) A/C Code: 此BM依據20210914收施工圖大樣計算								

序號	修改標示	配件圖號	物料編號	配件名稱	顏色	實用	後備	總數	單位	備注
85	D版放行	駿華	YM5	推拉門双面条锁	ECK3X10063S-XFI	242	8	250	套	長合金叉
86	取消	駿華	YM	推拉锁拉手	深灰色	242	8	250	件	
87	D版放行	駿華	J179	不銹鋼T型连接件	S.S-316	242	8	250	個	不含底片30mm
88	D版放行	駿華	G15-1000	传动杆	ECK3X10063S-XFI	242	8	250	支	蘑菇头锁点3+5.5+12.2 (見加工圖)
89	D版放行	駿華	J022A	推拉锁座	S.S-316	484	16	500	個	高度7.1mm (2個/幅)
90	D版放行	駿華	TSM21	推拉手滑轮		484	16	500	套	(2套/幅) (銅輪)
91	C(新增)			3/16x5/16"平頭機絲	A4-70	300	20	320	粒	修防护玻璃底托角
92	C(新增)			3/16x5/16"圓頭機絲	A4-70	250	20	270	粒	修防护玻璃铝槽
93	C(新增)			#8x50平頭鋼牙	S.S-316	150	20	170	粒	收生反拍线
94	C(新增)			M5x20平頭自攻自鑽螺絲	A4-70	668	62	730	粒	收百葉框在鋁通上










世運牌推拉門(窗)鈎鎖系列
SLIDING DOOR AND WINDOW LOCK SERIES


專注品質 · 不斷創新
Focus on quality · continuous innovation

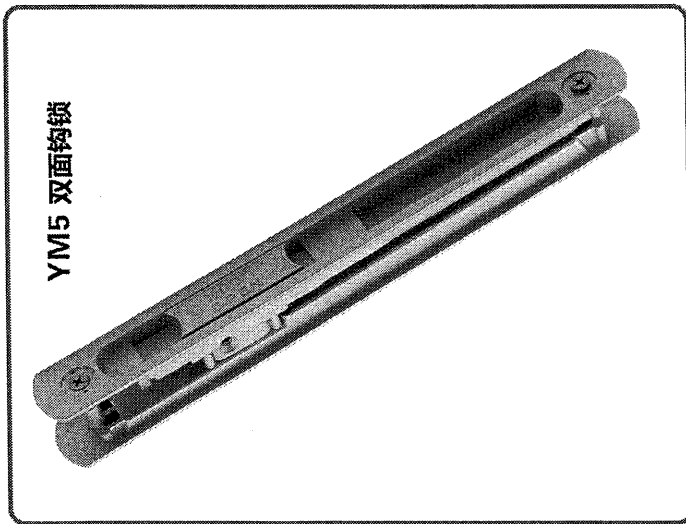

G15铝传动杆

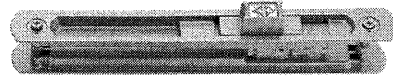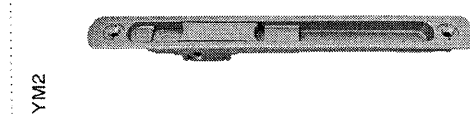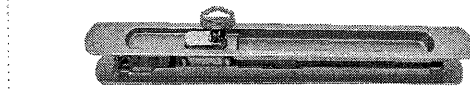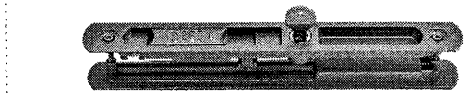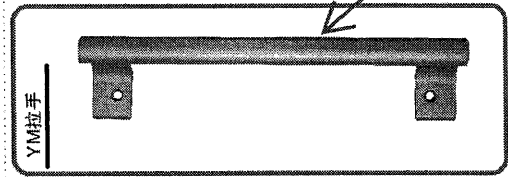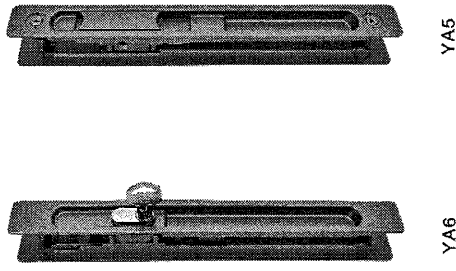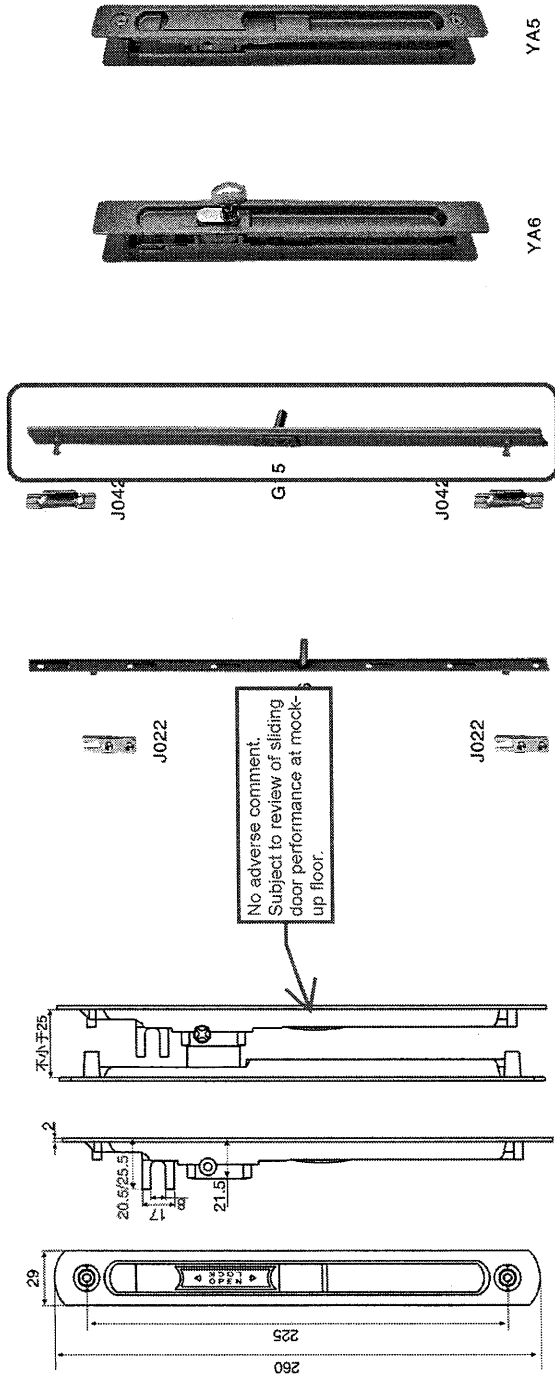


Y鎖系列安裝節點圖

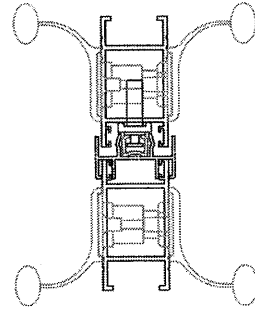


ALUMINUM FABRICATOR, INC.
1000 S. ...


Model: ...
Part No. ...
Date: ...

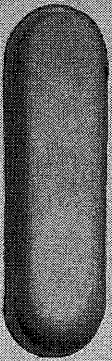

2. 罗德手柄
(Model: CR10)

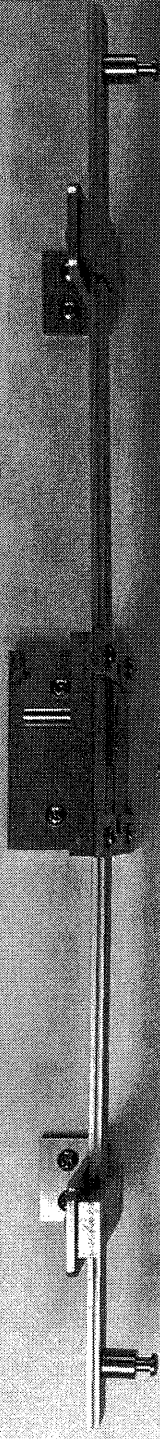


3. 罗德手柄
(Model: CR10)

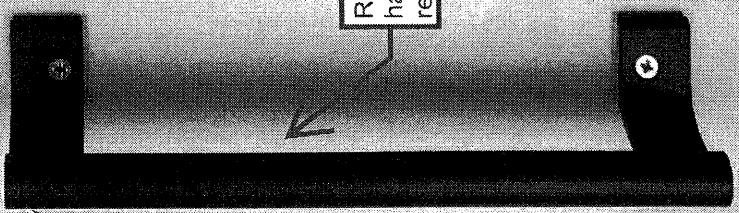


4. 罗德手柄
(Model: Y85)

1. 罗德手柄
(Model: Y85)

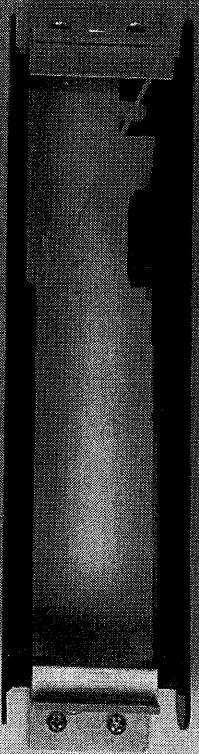

5. 罗德手柄
(Model: TR825)

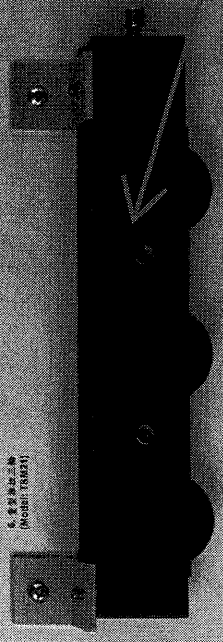

No adverse comment.
Subject to review of sliding
door performance at mock-
up floor.

Rod-type
handle is not
required.

Superseded by
MS-AR-046
(Rev.1)

