

工程指示 / 要求簡箋(E.I.)

工程指示編號：EI / 4367 / 22

修改版次：-

工程編號：J857

工程名稱：啟德 6552

工程項目：預製窗 - 雀仔网樣板

收件人：生統

發件人：Yancy Chen

日期：10/02/2022

要求提供 / 確認 事項：

- () 初步鋁料 B.M. () 加工拆圖，然後生產 () 尺寸表
- () 正式鋁料 B.M. () 技術上資料 / 指示 () 報價
- () 配件 B.M. () 樣辦或貨品說明書 () 分判合約
- () 其他：_____

內容：

請提供雀仔网樣板二件，送香港寫字樓。

雀仔网樣板要求: 300X300, 3mm 厚 316 不銹鋼網，油黑色。

請在 15/2/2022 前完成上列要求。

附：

1+ 1 頁

以上項目為：

- 原合約工程包 原合約工程加 / 減賬 新工程報價

原因：-

分發東莞各部門：

- () 生產技術總監 連附件 () 技術部 連附件 () 生產部 連附件 () 機械設計部 連附件
- () 採購部 連附件 (✓) 生產統籌部 連附件
- (✓) 質檢部 連附件 () 會計部 連附件 () 報關組 連附件 () 其他 _____ 連附件

分發香港各部門：

- () 行政部 連附件 () 會計部 連附件 () 統籌部 連附件 () 工程部地盤科文 連附件
- () 採購部 連附件 () QS 部 連附件 () 維修部 連附件 () 其他 _____ 連附件

傳遞編號：

HK0226 / 22

發件人簽署：

項目經理簽署：

B.D. REF :
 F.S.D. REF :
 Note :
 1. All dimensions are in mm.
 2. All elevations are viewed from outside.
 3. All dimensions to be verified on site before fabrication.

GENERAL NOTES
 Legend :
 1. F.F.L. — Finished Floor Level
 2. S.F.L. — Structural Floor Level
 3. (A) — Referred Detail
 4. (X1) — DETAIL MARK NO.
 (X001) — REFER SHEET NO.

NO.	DATE	BY	REVISION

CLIENT :
MARBLE EDGE INVESTMENT LTD.

ARCHITECT :
RONALD LU & PARTNERS
 ARCHITECTS PARTNERS INTERIOR SYSTEMS

STRUCTURAL ENGINEER :
OMA
 10/F, 100 HONG KONG STREET, HONG KONG

FAÇADE CONSULTANT :
Inhabit
 Inhabit Group
 Hong Kong
 www.inhabitgroup.com


MAIN CONTRACTOR :
裕民建築有限公司

PROJECT :
美特鋁質有限公司
 MIDTI ALUMINIUM MANUFACTURER LTD.
 Units 6-8, Sunny Industrial Centre, 1/F
 610 Chee Koo Ling Road, Kowloon
 HK22408211-4 Fax: (852) 7777866

PROJECT :
PROPOSED RESIDENTIAL DEVELOPMENT AT NEW KOWLOON INLAND LOT, NO.6552

TITLE :
 TYPICAL DETAIL FOR
 PRECAST ALUM. WINDOW

JOB NO. : J-857
 DRAWN BY : Aijing
 DATE : 2021-08-30
 CHECK BY :
 SCALE : A1: A3: B3
 DWG. NO. : J657-PW-6004
 REV. : -

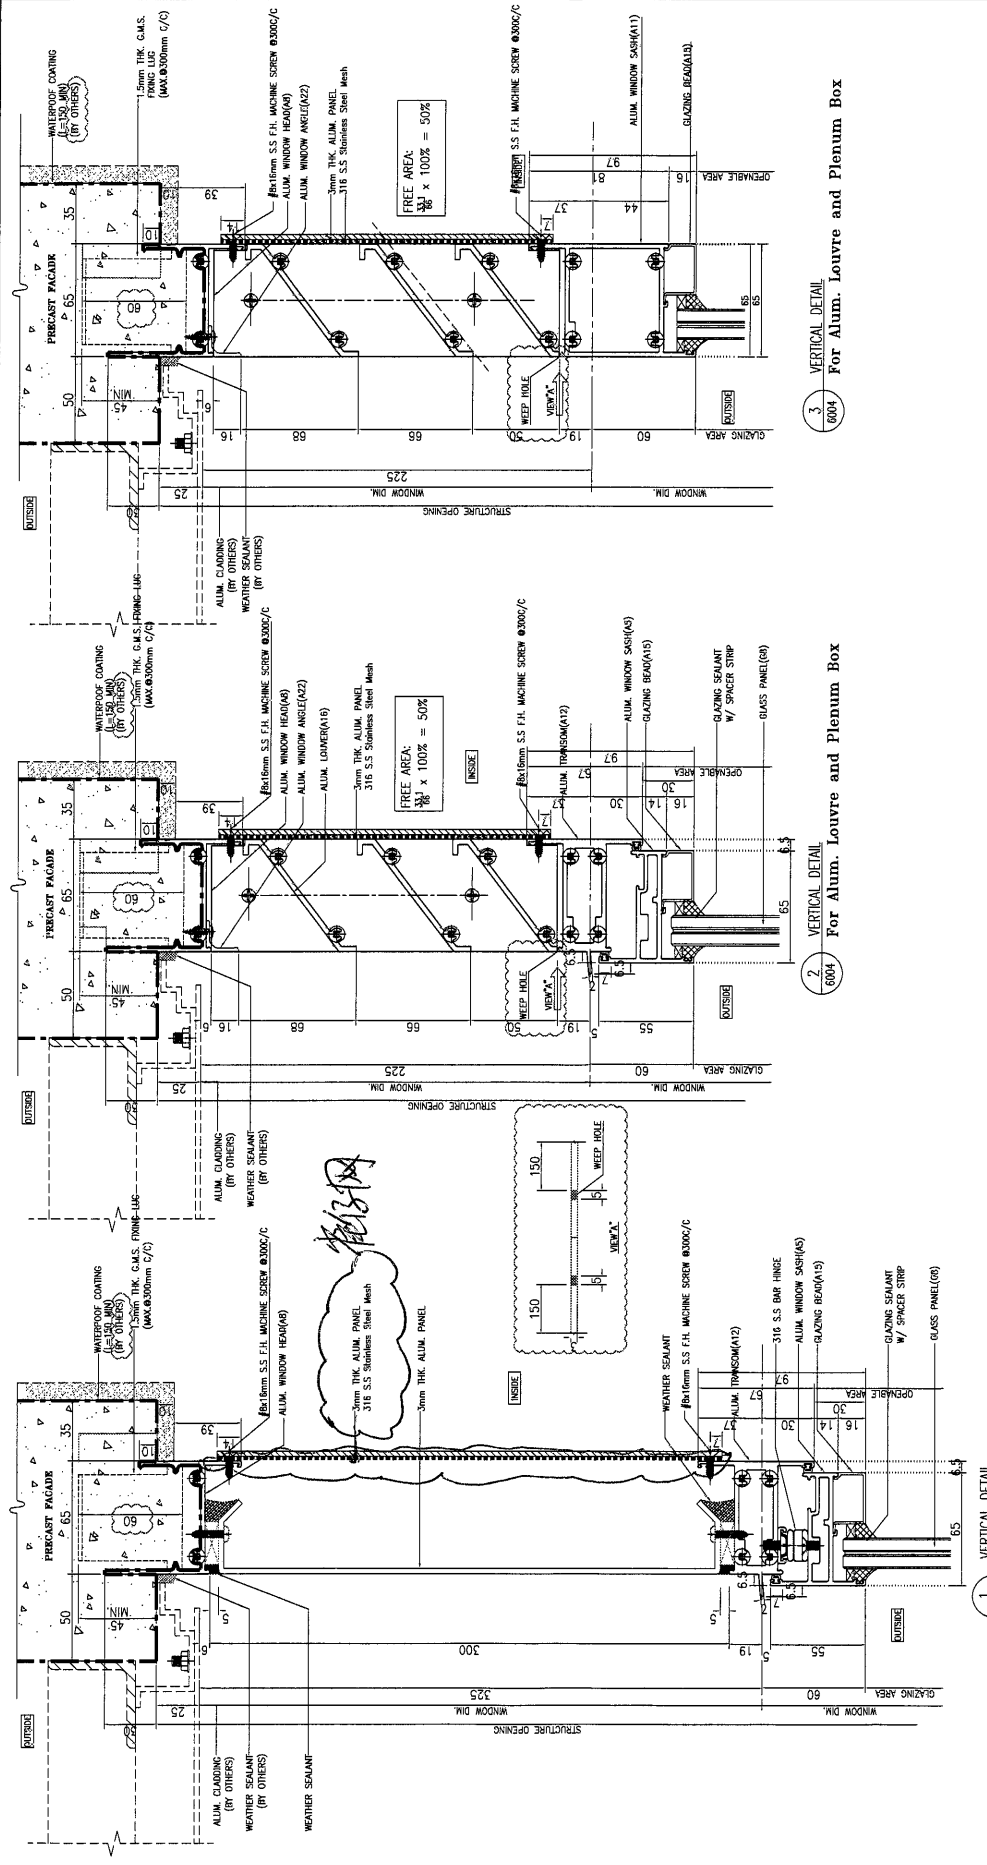

1 VERTICAL DETAIL
 6004 For Alum. Louvre and Plenum Box

2 VERTICAL DETAIL
 6004 For Alum. Louvre and Plenum Box

3 VERTICAL DETAIL
 6004 For Alum. Louvre and Plenum Box