

工程指示 / 要求簡箋(E.I.)

工程指示編號：EI / 4369 / 22 修改版次：-  
 工程編號：J857 工程名稱：啟德 6552  
 工程項目：駿華配件 - 趟門用月牙鎖  
 收件人：Maggie Lor (羅小姐) 發件人：Leung Hin Wai 日期：11/02/2022

要求提供 /  確認 事項：

- |                                    |                                     |                               |
|------------------------------------|-------------------------------------|-------------------------------|
| <input type="checkbox"/> 初步鋁料 B.M. | <input type="checkbox"/> 加工拆圖，然後生產  | <input type="checkbox"/> 尺寸表  |
| <input type="checkbox"/> 正式鋁料 B.M. | <input type="checkbox"/> 技術上資料 / 指示 | <input type="checkbox"/> 報價   |
| <input type="checkbox"/> 配件 B.M.   | <input type="checkbox"/> 樣辦或貨品說明書   | <input type="checkbox"/> 分判合約 |
| <input type="checkbox"/> 其他：_____  |                                     |                               |

內容：根據合約要求

請按附件資料，安排駿華提供以下型號配件樣板各二件，送香港寫字樓。

1)ALP62

2)DK840

3)GC086

顏色：深灰色

請在 30/2/2022 前完成上列要求。

附：1+ 7 頁

以上項目為：

- 原合約工程包                       原合約工程加 / 減賬                       新工程報價

原因：-

分發東莞各部門：

- ( ) 生產技術總監  連附件    ( ) 技術部     連附件    ( ) 生產部     連附件    ( ) 機械設計部  連附件  
 ( ) 採購部     連附件    ( ) 生產統籌部  連附件  
 ( ) 質檢部     連附件    ( ) 會計部     連附件    ( ) 報關組     連附件    ( ) 其他 \_\_\_\_\_  連附件

分發香港各部門：

- ( ) 行政部  連附件    ( ) 會計部  連附件    ( ) 統籌部  連附件    ( ) 工程部地盤科文     連附件  
 ( ) 採購部  連附件    ( ) QS 部     連附件    ( ) 維修部  連附件    ( ) 其他 \_\_\_\_\_  連附件

傳遞編號：

發件人簽署：

項目經理簽署：








**世運牌月牙鎖鈎系列**  
CRESCENT LOCK SERIES





GC 086

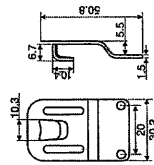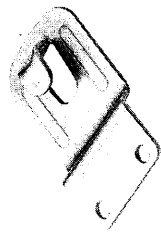


GC 082

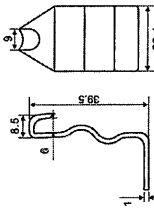



GC 085A

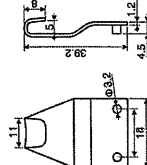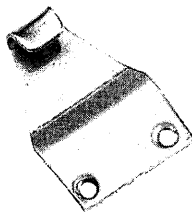



GC 085

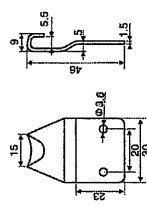



GC 040A

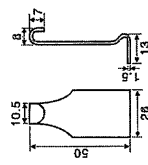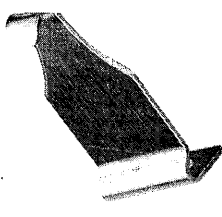



GC 040

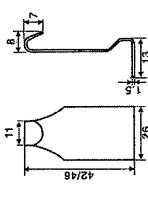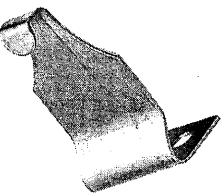

GC 087

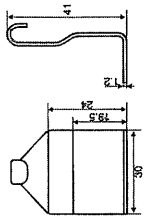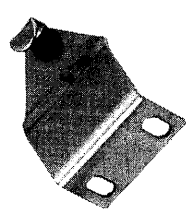

GC 088

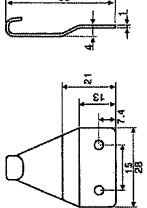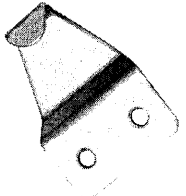

**世運牌推拉門(窗)滑輪系列**  
SLIDING DOOR AND WINDOW ROLLER SERIES

專注品質 · 不斷創新  
Focus on quality · continuous innovation

A-型材的下方腔體寬度尺寸


B-型材下方與滑軌配合後高度尺寸(可調的中門尺寸), B=G

C-型材的下方腔體高度尺寸 (H<C)

D-框扇型材的搭接量 (通常為6-10mm)

E-型材滑軌形狀 (R/J/JP)

F-型材的滑軌寬度 (W<F)

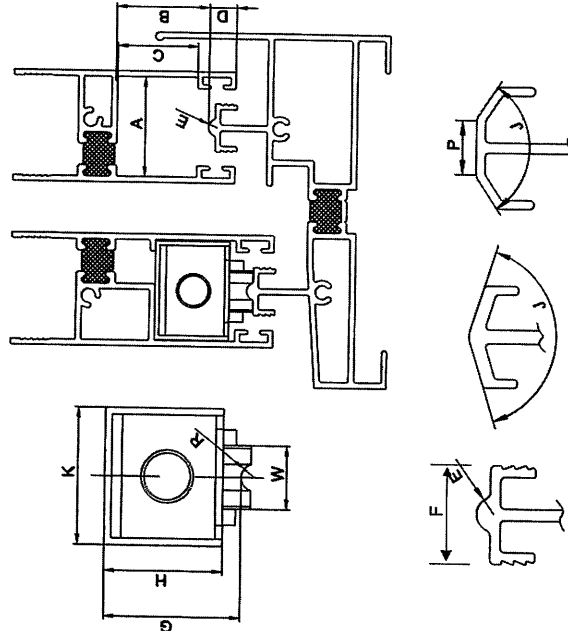

說明

K-滑輪外殼寬

G-滑輪高度 (此高度為中間尺寸, 上下可調)

W-輪寬

H-外殼高

R-滑軌圓弧形

J-滑輪角度形

JP-滑軌特殊形




B.D. REF :  
 F.S.A. REF :  
 N.B.:  
 1.M. dimensions are in mm.  
 2.M. dimensions are viewed from outside.  
 3.M. dimensions to be verified on site before fabrication.


**GENERAL NOTES**  
 Legend :  
 1. FEI --- Filled Area  
 2. SEI --- Stippled Area  
 3. --- Hatched Area  
 ① --- DETAIL MARK NO.  
 ② --- REFER SHEET NO.

NO.	DATE	DESCRIPTION	BY
1	04/10/2024	ISSUED FOR PERMIT	BY
2	04/10/2024	ISSUED FOR PERMIT	BY
3	04/10/2024	ISSUED FOR PERMIT	BY
4	04/10/2024	ISSUED FOR PERMIT	BY
5	04/10/2024	ISSUED FOR PERMIT	BY


CLIENT : MARBLE EDGE INVESTMENT LTD.  
 ARCHITECT : RONALD LU & PARTNERS  
 ADVISERS (PARTNER) INTERIOR DESIGN  
 STRUCTURAL ENGINEER : C.M. WONG & ASSOCIATES LTD.  
 MAIN CONTRACTOR : 裕民建築有限公司  
 美特鋁業有限公司  
 MTDI 美特鋁業有限公司  
 110, C/O Sun Lee Road, Kowloon  
 Tel: 22288211-4 Fax: 22272766  
 PROJECT : PROPOSED RESIDENTIAL DEVELOPMENT AT NEW KOWLOON INLAND LOT, NO.652  
 TITLE : TYPICAL DETAIL FOR IN-SITU WINDOW  
 JOB NO. : J-657  
 DRAWN BY :  
 DATE :  
 CHECK BY :  
 SCALE : A1  
 DATE : AS 13  
 DWG. NO. : J657-W-5005  
 REV. : C

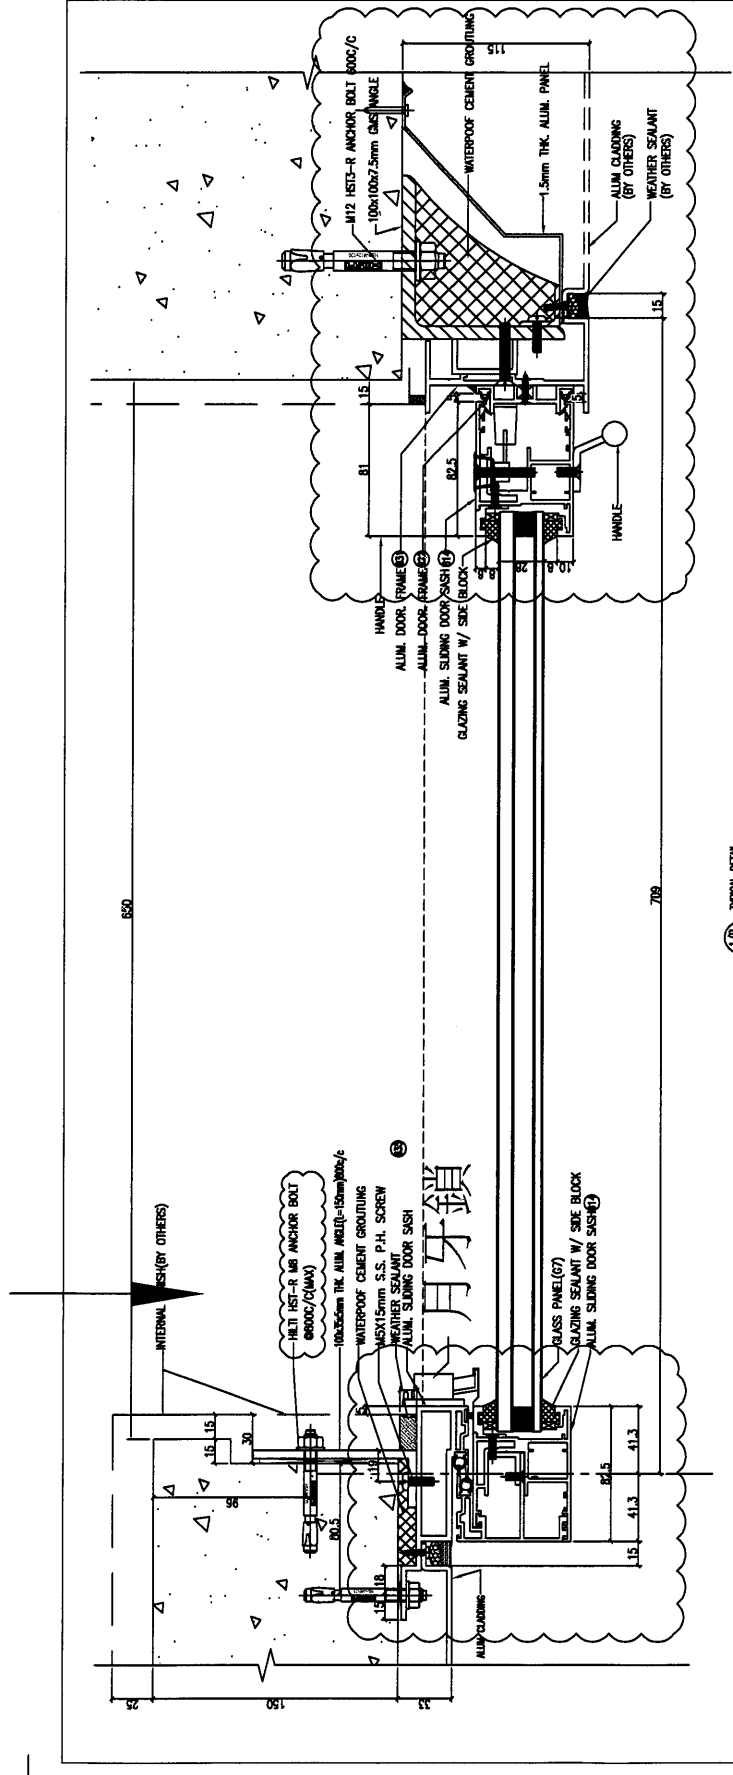

TYPICAL DETAIL  
 SLIDING DOOR

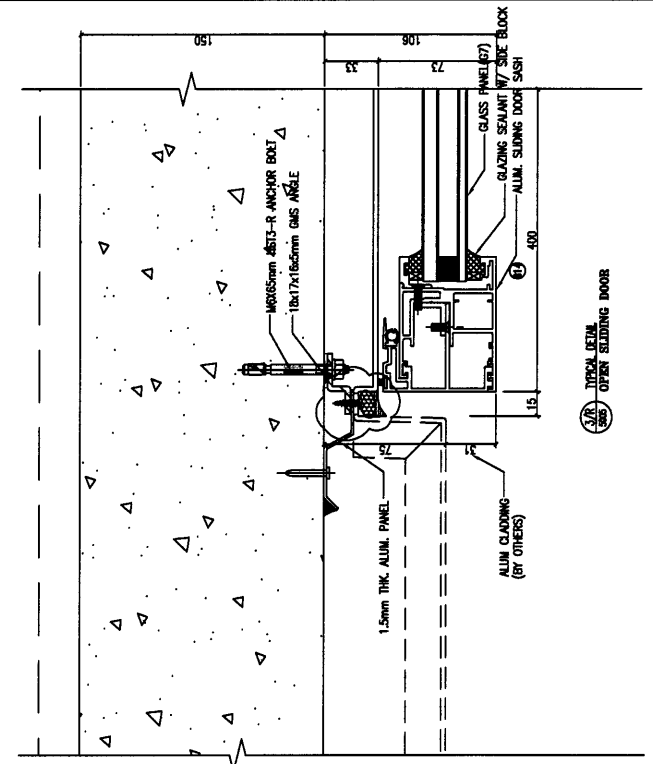

TYPICAL DETAIL  
 OPEN SLIDING DOOR

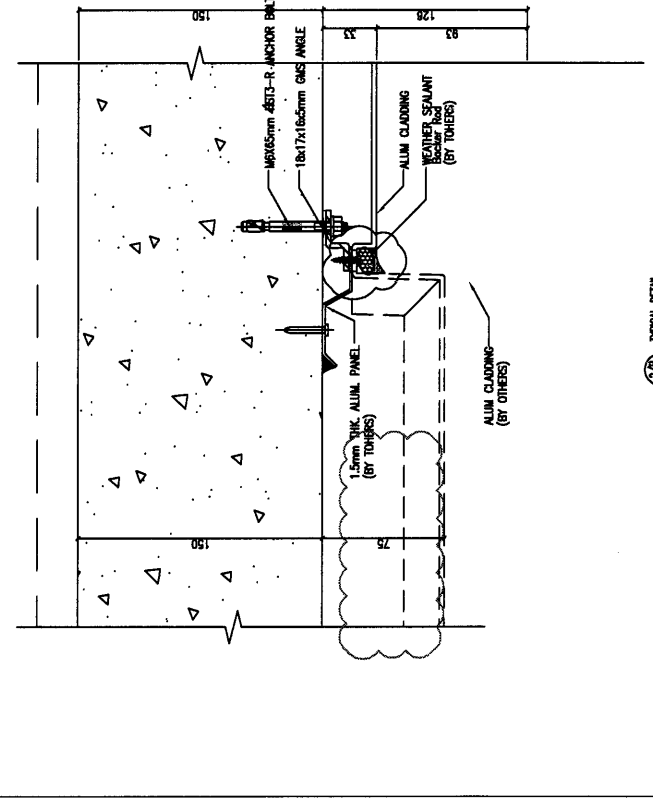

TYPICAL DETAIL  
 SLIDING DOOR



**ALUMINIUM WINDOWS AND ALUMINIUM GRILLES**

**PSB14.00**

**Appendix A**

**Child-Proof Lock**

