



美特鋁質有限公司

MIDI ALUMINIUM FABRICATOR LTD.



工程指示 / 要求簡箋 ENGINEER INSTRUCTIONS (E.I.)

工程指示編號:	EI- 4467	修改版本:	C
	HK- 0539/22		
工程編號:	J 857	工程名稱:	啟德6552
收件人:	Maggie Lor (羅小姐)	發件人:	Yancy Chen
工程項目:	UP趟門 - 確認模圖(興發鋁材)	日期:	31/03/2022

<input checked="" type="checkbox"/> 原合約工程包	<input type="checkbox"/> 原合約工程加 / 減賬 QT-	<input type="checkbox"/> 新工程報價 QT-
--------------------------------------------	------------------------------------------	------------------------------------

信件批核號碼/圖紙參考編號: Xingfa email	批核模具圖紙編號: X86270
客戶指示附件:	管理內部批簽署:

<input type="checkbox"/> 初步鋁料 B.M.	<input type="checkbox"/> 加工拆圖, 然後生產	<input type="checkbox"/> 尺寸表
<input type="checkbox"/> 正式鋁料 B.M.	<input type="checkbox"/> 技術上資料/指示	<input type="checkbox"/> 報價
<input type="checkbox"/> 配件 B.M.	<input type="checkbox"/> 樣辦或貨品說明書	<input type="checkbox"/> 分判合約
<input checked="" type="checkbox"/> 其他: 確認模圖		

內容: 現確認1款模圖, 封面1頁, 附件2頁, 共3頁.

完成上列要求日期: 04/04/2022

國內

<input type="checkbox"/> 生產技術總監	<input type="checkbox"/> 連附件	<input type="checkbox"/> 技術部	<input type="checkbox"/> 連附件	<input checked="" type="checkbox"/> 生產部	<input checked="" type="checkbox"/> 連附件
<input type="checkbox"/> 採購部	<input type="checkbox"/> 連附件	<input type="checkbox"/> 生產統籌部	<input type="checkbox"/> 連附件	<input type="checkbox"/> 報關組	<input type="checkbox"/> 連附件
<input checked="" type="checkbox"/> 質檢部	<input checked="" type="checkbox"/> 連附件	<input type="checkbox"/> 會計部	<input type="checkbox"/> 連附件	<input type="checkbox"/> 機械設計部	<input type="checkbox"/> 連附件
<input type="checkbox"/> 其他:					


香港

<input type="checkbox"/> 行政部	<input type="checkbox"/> 連附件	<input type="checkbox"/> 會計部	<input type="checkbox"/> 連附件	<input type="checkbox"/> 統籌部	<input type="checkbox"/> 連附件	<input type="checkbox"/> 工程部	<input type="checkbox"/> 連附件
<input type="checkbox"/> 採購部	<input type="checkbox"/> 連附件	<input type="checkbox"/> QS部	<input type="checkbox"/> 連附件	<input type="checkbox"/> 地盤管理	<input type="checkbox"/> 連附件	<input type="checkbox"/> 維修部	<input type="checkbox"/> 連附件



*發件人簽署: <i>YK</i>	*組別成員批核簽署:
傳遞編號: HK 0539/22	項目經理簽署:

此型材如停止订货两年以上，我司有权对模具进行报废或销毁
如私自改动而确认，导致生产出来有异议，我司一律不承担责任！

A	版次	1	型号	D64506
---	----	---	----	--------

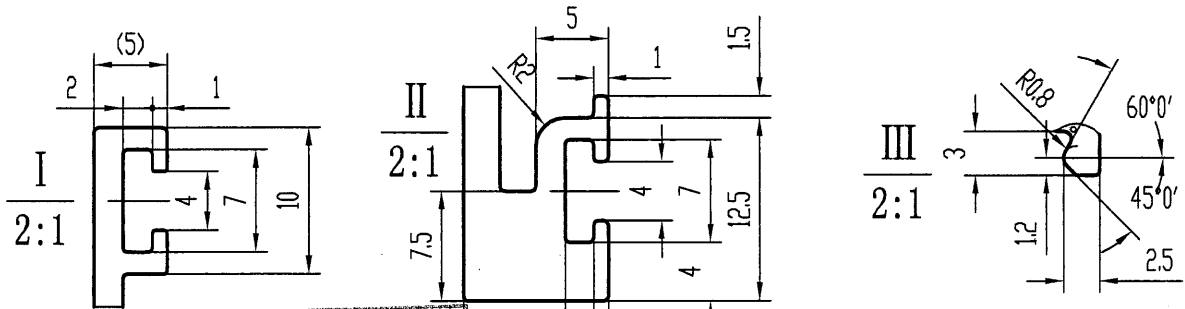

美特铝业有限公司
承认图面
日期 3/3-2022

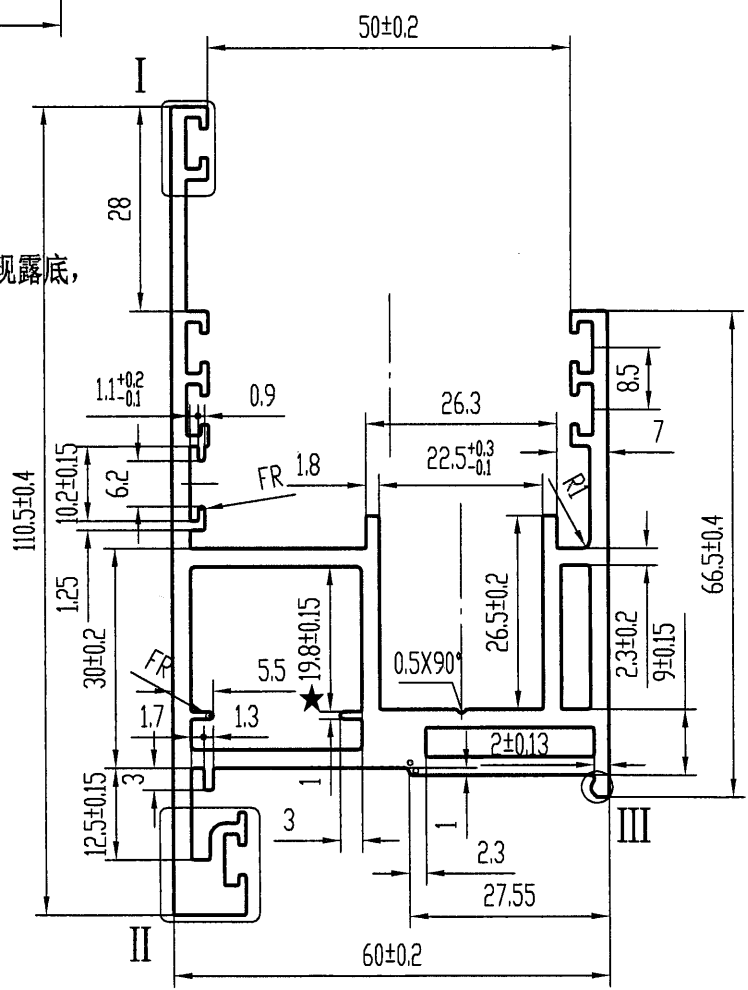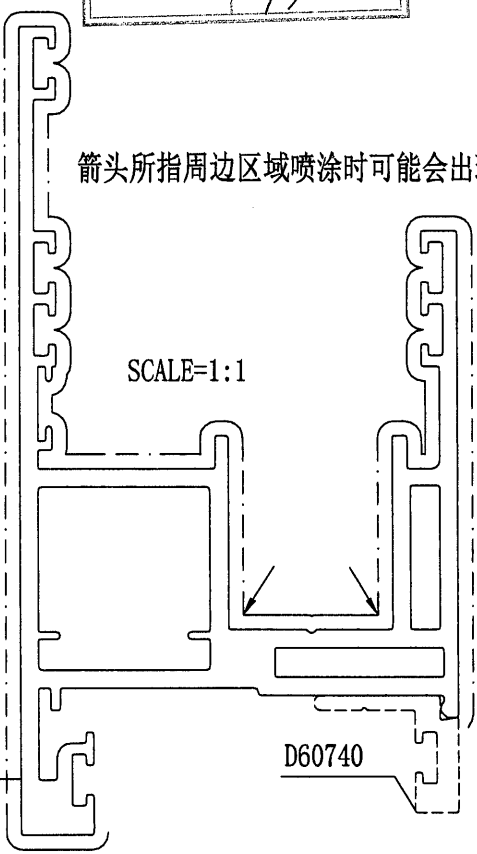



技术要求

1. 装饰面为: _____
2. 基材验收标准按EN755-9执行
3. 表面处理是: 氟碳喷涂 ✓
4. 带“★”尺寸以实配为准
5. ◯=R0.5
6. 配角码: C04797

特此声明

1. 此图与客户“来样/来图”相符，若涉及专利或商标事宜，概由需方负责。
2. 如与其它型材或配件配合，需注明或提供配套件，否则产生的装配问题，由客户自行承担。
3. 客户确认图纸，包括确认并认可图纸上所示的图形、公差、验收标准，模具费，单重和装饰面面积等图面上的信息。

未注实心部位壁厚	2.5 ± 0.13	机型	1800	未注圆角	R0.3	外 D	115.66 mm	材料	
未注空心部位壁厚	2.5 ± 0.2	备注		周长	597.4 mm	比例	1:1	6063-T6	✓
装饰面面积	0.4386 m ² /m	 <p>广东兴发铝业有限公司 兴发铝业(成都)有限公司 广东兴发铝业(江西)有限公司 广东兴发铝业(河南)有限公司 总部技术部E-mail: tech@xingfa.com 联系电话: 0757-66695205</p>		型材重量	2.650 Kg/m	客户编号	X86270	✓	
设计	梁鹏飞			2022.03.25	型号	D64506	名称	扇料	
校核	刘秀欢			2022.03.25					
批准	陆承强			2022.03.25					

From: "midipur@midiltd.com.hk" <midipur@midiltd.com.hk>
To: j857@midiltd.com.hk
Date sent: Thu, 31 Mar 2022 10:39:48 +0800
Subject: (Fwd) RE: EI4467B J857 啟德站確認模圖 1 個
Priority: normal

----- Forwarded message follows -----

From: "Frankie Leung" <xingfa38@biznetvigator.com>
To: <midipur@midiltd.com.hk>
Subject: RE: EI4467B J857 啟德站確認模圖 1 個
Date sent: Thu, 31 Mar 2022 10:28:14 +0800

Dear Maggie,

貴司 EI4467B 之批圖 X86270，我們發現標示之標準錯誤，正確應為 EN755-9，另外貴司未有簽署起影之提示，為免將來引起爭拗，我司圖紙已將提示標註在圖紙上，而不用貴司單獨簽名確認，如貴司簽圖則表示同意圖紙上之提示。請查收附件更新圖紙，及重新簽回確認，謝謝。

Best Regards,
Frankie Leung

Xingfa Aluminium (Hong Kong) Ltd.
For and On behalf of Guangdong Xingfa Aluminium Co. Ltd.
Unit 5, 6/F, Wing On Plaza,
62 Mody Road, Kowloon, Hong Kong
Tel: 852- 2780 3680 Fax: 852- 2175 5383

From: midipur@midiltd.com.hk <midipur@midiltd.com.hk>
Sent: Tuesday, March 29, 2022 10:13 AM
To: xingfa38@biznetvigator.com
Subject: EI4467B J857 啟德站確認模圖 1 個

Dear Frankie,
請查收附件批核模圖並安排開模，謝謝！

Maggie

MIDI Aluminium Fabricator Ltd., Tel:(852) 2348 9211, Fax:(852) 2772 7666

The information contained in this e-mail is confidential and is intended solely for the addressee. If you are not the intended recipient, please notify the sender immediately and delete this e-mail from your system. Any unauthorised use, disclosure, copying, printing, forwarding or dissemination of any part of this information is prohibited. MIDI does not accept responsibility for the content of any e-mail transmitted by its staff for any reason other than bona fide business purposes. Any information that is not transmitted via secure tamper-proof technology should not be relied upon, unless advised or agreed otherwise in writing by an authorised representative of MIDI

----- End of forwarded message -----

MIDI Aluminium Fabricator Ltd., Tel:(852) 2348 9211, Fax:(852) 2772 7666

The information contained in this e-mail is confidential and is intended solely for the addressee. If you are not the intended recipient, please notify the sender immediately and delete this e-mail from your system. Any unauthorised use, disclosure, copying, printing, forwarding or dissemination of any part of this information is prohibited. MIDI does not accept responsibility for the content of any e-mail transmitted by its staff for any reason other than bona fide business purposes. Any information that is not transmitted via secure tamper-proof technology should not be relied upon, unless advised or agreed otherwise in writing by an authorised representative of MIDI
