

工程指示 / 要求簡箋 ENGINEER INSTRUCTIONS(E.I.)

工程指示編號:	EI- 4728/22	修改版本:	-
	HK- 0875/22		
工程編號:	J 857	工程名稱:	啟德6552
收件人:	生統	發件人:	Nero HO
工程項目:	幕牆單元件 - 廠用鋁背板(L座補料)	日期:	30/05/2022

<input type="checkbox"/> 原合約工程包	<input type="checkbox"/> 原合約工程加 / 減脹 QT-	<input type="checkbox"/> 新工程報價 QT-
---------------------------------	--	------------------------------------

信件批核號碼/圖紙參考編號:	批核模具圖紙編號:
客戶指示附件:	管理內部批簽署:

<input type="checkbox"/> 初步鋁料 B.M.	<input type="checkbox"/> 加工拆圖, 然後生產	<input type="checkbox"/> 尺寸表
<input type="checkbox"/> 正式鋁料 B.M.	<input type="checkbox"/> 技術上資料/指示	<input type="checkbox"/> 報價
<input type="checkbox"/> 配件 B.M.	<input type="checkbox"/> 樣辦或貨品說明書	<input type="checkbox"/> 分判合約
<input type="checkbox"/> 其他:		

內容: 按附件BM&加工圖, 訂購和生產加工L座鋁背板。
完成上列要求日期: 14.6.2022

國內


<input type="checkbox"/> 生產技術總監	<input type="checkbox"/> 連附件	<input type="checkbox"/> 技術部	<input type="checkbox"/> 連附件	<input type="checkbox"/> 生產部	<input type="checkbox"/> 連附件
<input type="checkbox"/> 採購部	<input type="checkbox"/> 連附件	<input checked="" type="checkbox"/> 生產統籌部	<input checked="" type="checkbox"/> 連附件	<input type="checkbox"/> 報關組	<input type="checkbox"/> 連附件
<input type="checkbox"/> 質檢部	<input type="checkbox"/> 連附件	<input type="checkbox"/> 會計部	<input type="checkbox"/> 連附件	<input type="checkbox"/> 機械設計部	<input type="checkbox"/> 連附件
<input checked="" type="checkbox"/> 香港辦	<input checked="" type="checkbox"/> 連附件	<input type="checkbox"/> 其他:			

<input type="checkbox"/> 行政部	<input type="checkbox"/> 連附件	<input type="checkbox"/> 會計部	<input type="checkbox"/> 連附件	<input type="checkbox"/> 統籌部	<input type="checkbox"/> 連附件	<input type="checkbox"/> 工程部	<input type="checkbox"/> 連附件
<input type="checkbox"/> 採購部	<input type="checkbox"/> 連附件	<input type="checkbox"/> QS部	<input type="checkbox"/> 連附件	<input type="checkbox"/> 地盤管理	<input type="checkbox"/> 連附件	<input type="checkbox"/> 維修部	<input type="checkbox"/> 連附件


*發件人簽署:	<i>HL</i>	*組別成員批核簽署:	<i>[Signature]</i>
傳遞編號:	HK 0875/22	項目經理簽署:	

 美特鋁質 有限公司 MIDI Aluminium Fabricator Ltd.		工程號:	J-857	計算:	刘灿		日期:	2022.5.24		送呈:	施哥		
		地盤名稱:	啟德6552	核對:	徐祥坤		日期:	2022.5.25		副本:	细栳		
廠用鋁板B.M.表		項目類別:	L座变更补料	批准:	林仁安		日期:	2022.5.26					
BM編號:		修改版次:		A/C Code:			總V.F.:	4.531		總重量:	34.71		
序號	修改內容	鋁板編號	鋁板名稱	顏色	實用	後備	總數	總重量	單件展開面積	總展開面積	單件V.F.	總V.F.	圖紙編號
									平方米		平方米		
1		LZ-BST-J01-01	3mm厚鋁板	ECK3M96295S-ZD1	1	0	1	2.228	0.411	0.411	0.297	0.297	LZ-BST-J01
2		LZ-BST-J01-02	3mm厚鋁板	ECK3M96295S-ZD1	6	0	6	8.343	0.257	1.539	0.176	1.058	LZ-BST-J01
3		LZ-BST-J01-03	3mm厚鋁板	ECK3M96295S-ZD1	1	0	1	2.759	0.509	0.509	0.373	0.373	LZ-BST-J01
4		LZ-BST-J01-04	3mm厚鋁板	ECK3M96295S-ZD1	1	0	1	1.518	0.280	0.280	0.195	0.195	LZ-BST-J01
5		LZ-BST-J01-05	3mm厚鋁板	ECK3M96295S-ZD1	1	0	1	1.241	0.229	0.229	0.155	0.155	LZ-BST-J01
6		LZ-BST-J01-06	3mm厚鋁板	ECK3M96295S-ZD1	1	0	1	1.265	0.233	0.233	0.158	0.158	LZ-BST-J01
7		LZ-BST-J01-07	3mm厚鋁板	ECK3M96295S-ZD1	1	0	1	2.380	0.439	0.439	0.319	0.319	LZ-BST-J01
8		LZ-BST-J01-08	3mm厚鋁板	ECK3M96295S-ZD1	1	0	1	0.975	0.180	0.180	0.117	0.117	LZ-BST-J01
9		LZ-BST-J01-09	3mm厚鋁板	ECK3M96295S-ZD1	1	0	1	2.860	0.528	0.528	0.388	0.388	LZ-BST-J01
10		LZ-BST-J01-10	3mm厚鋁板	ECK3M96295S-ZD1	1	0	1	1.127	0.208	0.208	0.138	0.138	LZ-BST-J01
11		LZ-BST-J01-11	3mm厚鋁板	ECK3M96295S-ZD1	1	0	1	0.774	0.143	0.143	0.088	0.088	LZ-BST-J01
12		LZ-BST-J01-12	3mm厚鋁板	ECK3M96295S-ZD1	1	0	1	1.910	0.352	0.352	0.251	0.251	LZ-BST-J01
13		LZ-BST-M01-01	3mm厚鋁板	ECK3M96295S-ZD1	1	0	1	1.338	0.247	0.247	0.169	0.169	LZ-BST-M01
14		LZ-BST-M01-02	3mm厚鋁板	ECK3M96295S-ZD1	1	0	1	3.298	0.609	0.609	0.485	0.485	LZ-BST-M01
15		LZ-BST-N01-01	3mm厚鋁板	ECK3M96295S-ZD1	1	0	1	1.184	0.218	0.218	0.147	0.147	LZ-BST-N01
16		LZ-BST-N02-01	3mm厚鋁板	ECK3M96295S-ZD1	1	0	1	1.508	0.278	0.278	0.193	0.193	LZ-BST-N02
17													
總計:					21		21	34.71	5.121	6.40	3.65	4.531	

 美特鋁質有限公司 MIDI Aluminium Fabricator Ltd.				工程號	J857	類別		物料號	-			
				地盘	啟德6552	制圖	刘灿	2022.5.24	圖號	LZ-BST-M01		
修改	-	-	-	採用工廠	✓ 地盘	图纸名称	铝板加工图	復核	徐詳坤	2022.5.25	數量	-
日期	-	-	-	材料颜色	ECK3M96295S-ZD1	材料	3mm THK. 铝板	批准	林仁安	2022.5.26	單件重量	- (KG)

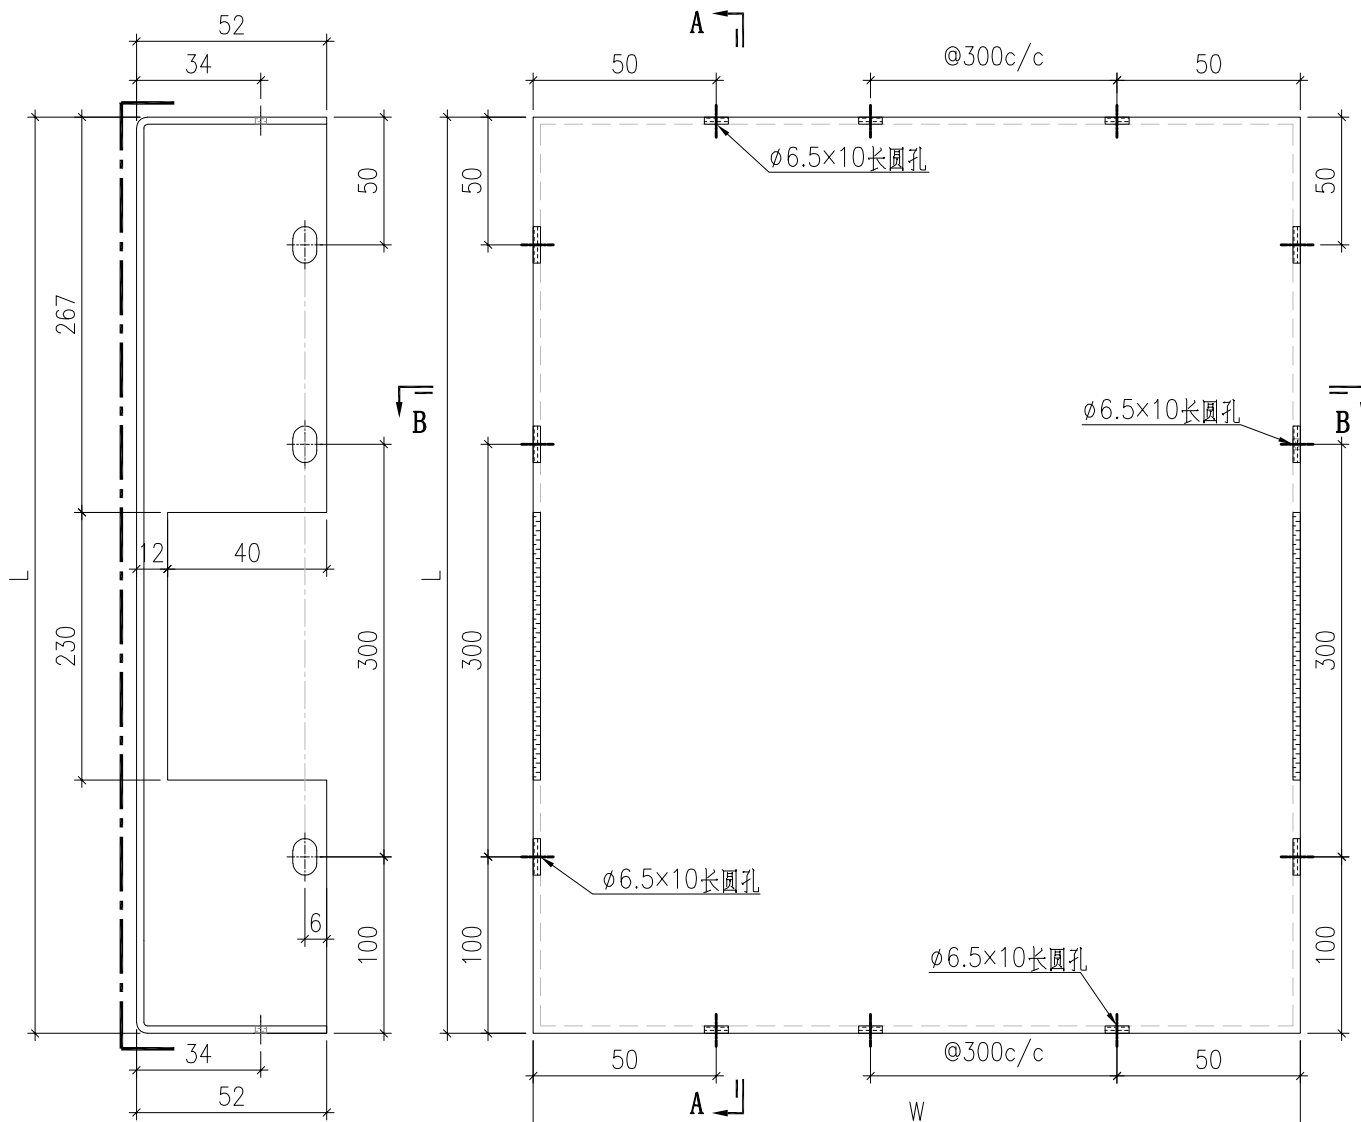


SECTION A-A

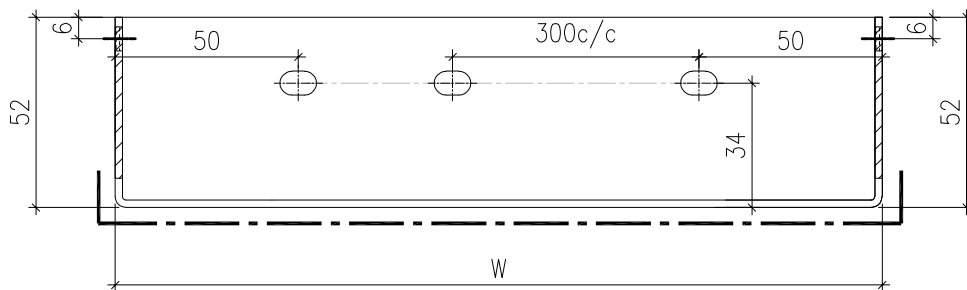



SECTION B-B

序号	背板编号	宽度W	高度L	数量
1	LZ-BST-M01-01	382	646	1
2	LZ-BST-M01-02	942	646	1

 美特铝质有限公司 MIDI Aluminium Fabricator Ltd.				工程號	J857	類別		物料號	-			
				地盘	啟德6552	制圖	刘灿	2022.5.24	圖號	LZ-BST-J01		
修改	-	-	採用工廠	✓	地盘	图纸名称	铝板加工图	復核	徐詳坤	2022.5.25	數量	-
日期	-	-	材料颜色	ECK3M96295S-ZD1		材料	3mm THK. 铝板	批准	林仁安	2022.5.26	單件重量	- (KG)

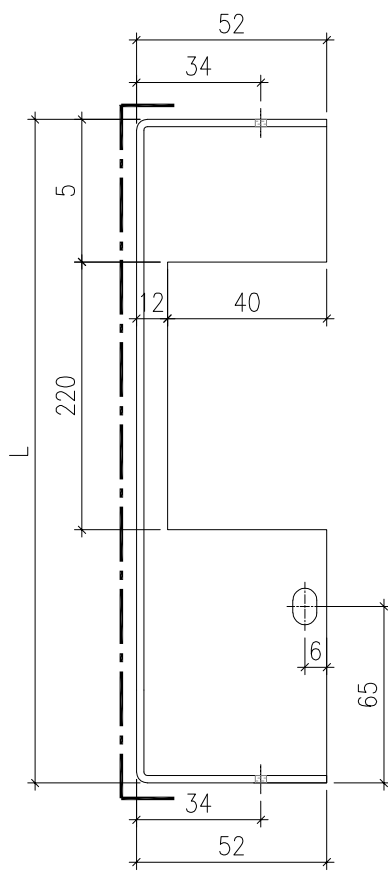



SECTION A-A

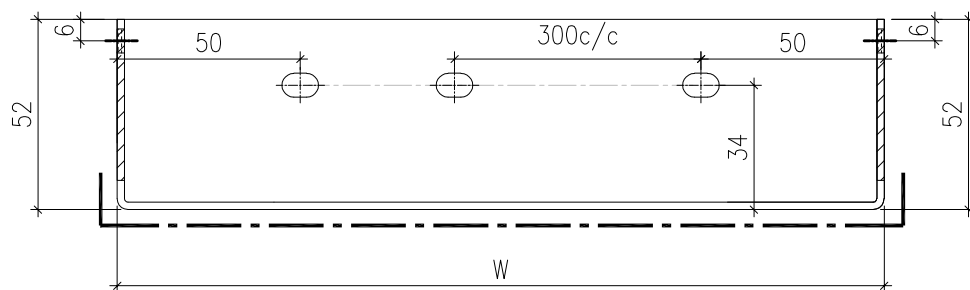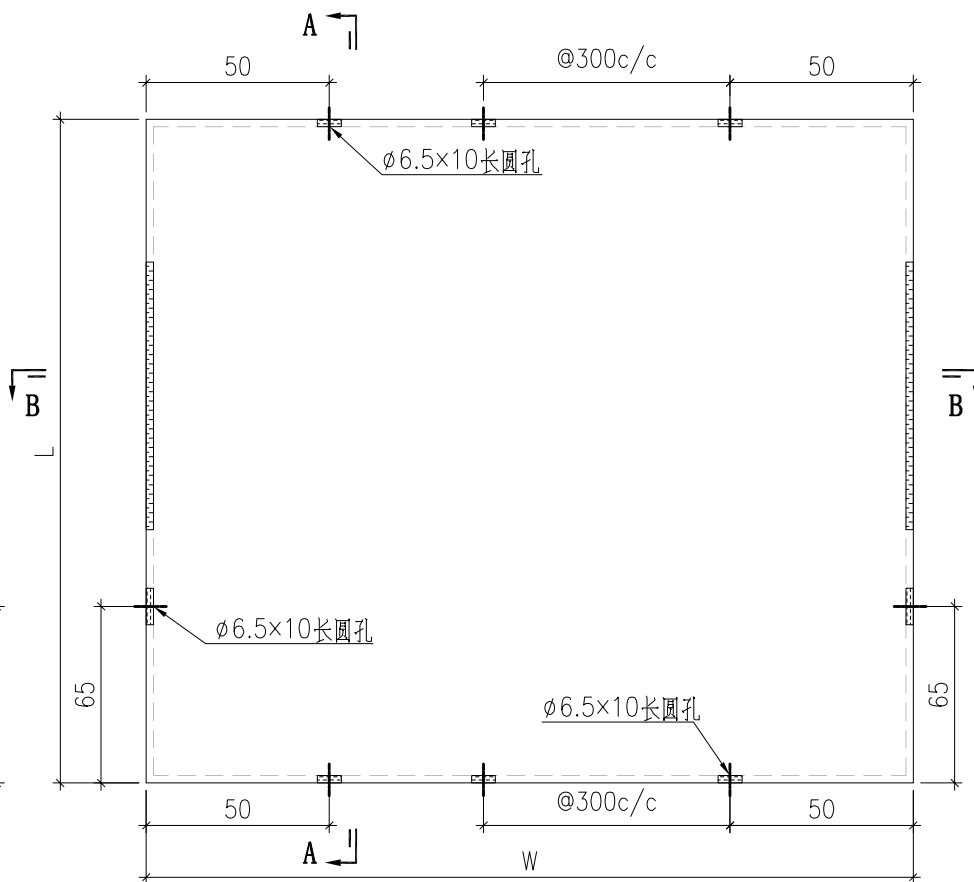

SECTION B-B



序号	背板编号	宽度W	高度L	数量
1	LZ-BST-J01-01	1099	374	1
2	LZ-BST-J01-02	686	374	6
3	LZ-BST-J01-03	1361	374	1
4	LZ-BST-J01-04	749	374	1
5	LZ-BST-J01-05	612	374	1
6	LZ-BST-J01-06	624	374	1
7	LZ-BST-J01-07	1174	374	1
8	LZ-BST-J01-08	481	374	1
9	LZ-BST-J01-09	1411	374	1
10	LZ-BST-J01-10	556	374	1
11	LZ-BST-J01-11	382	374	1
12	LZ-BST-J01-12	942	374	1

 美特鋁質有限公司 MIDI Aluminium Fabricator Ltd.				工程號	J857	類別		物料號	-			
				地盤	啟德6552	制圖	刘灿	2022.5.24	圖號	LZ-BST-N01		
修改	-	-	採用工廠	✓	地盤	图纸名称	铝板加工图	復核	徐詳坤	2022.5.25	數量	-
日期	-	-	材料颜色	ECK3M96295S-ZD1		材料	3mm THK. 铝板	批准	林仁安	2022.5.26	單件重量	- (KG)







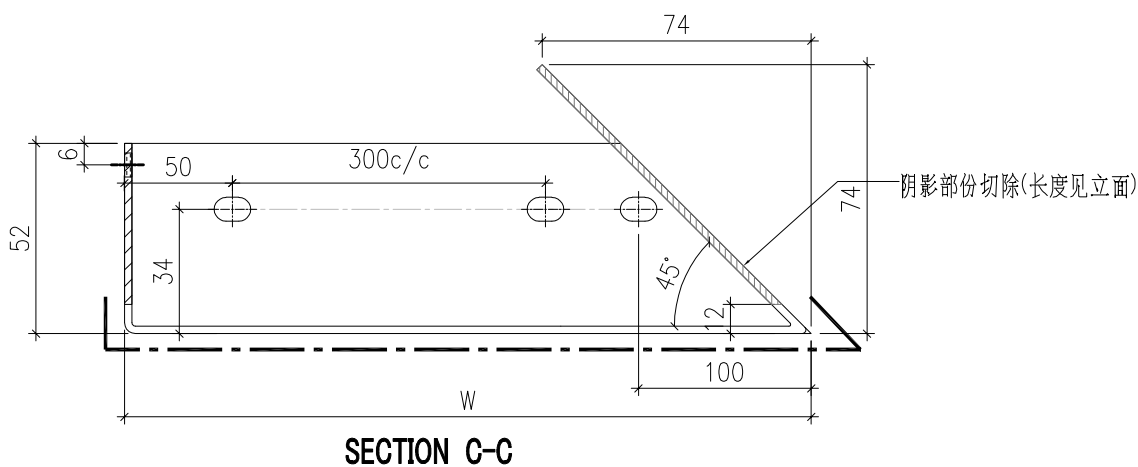
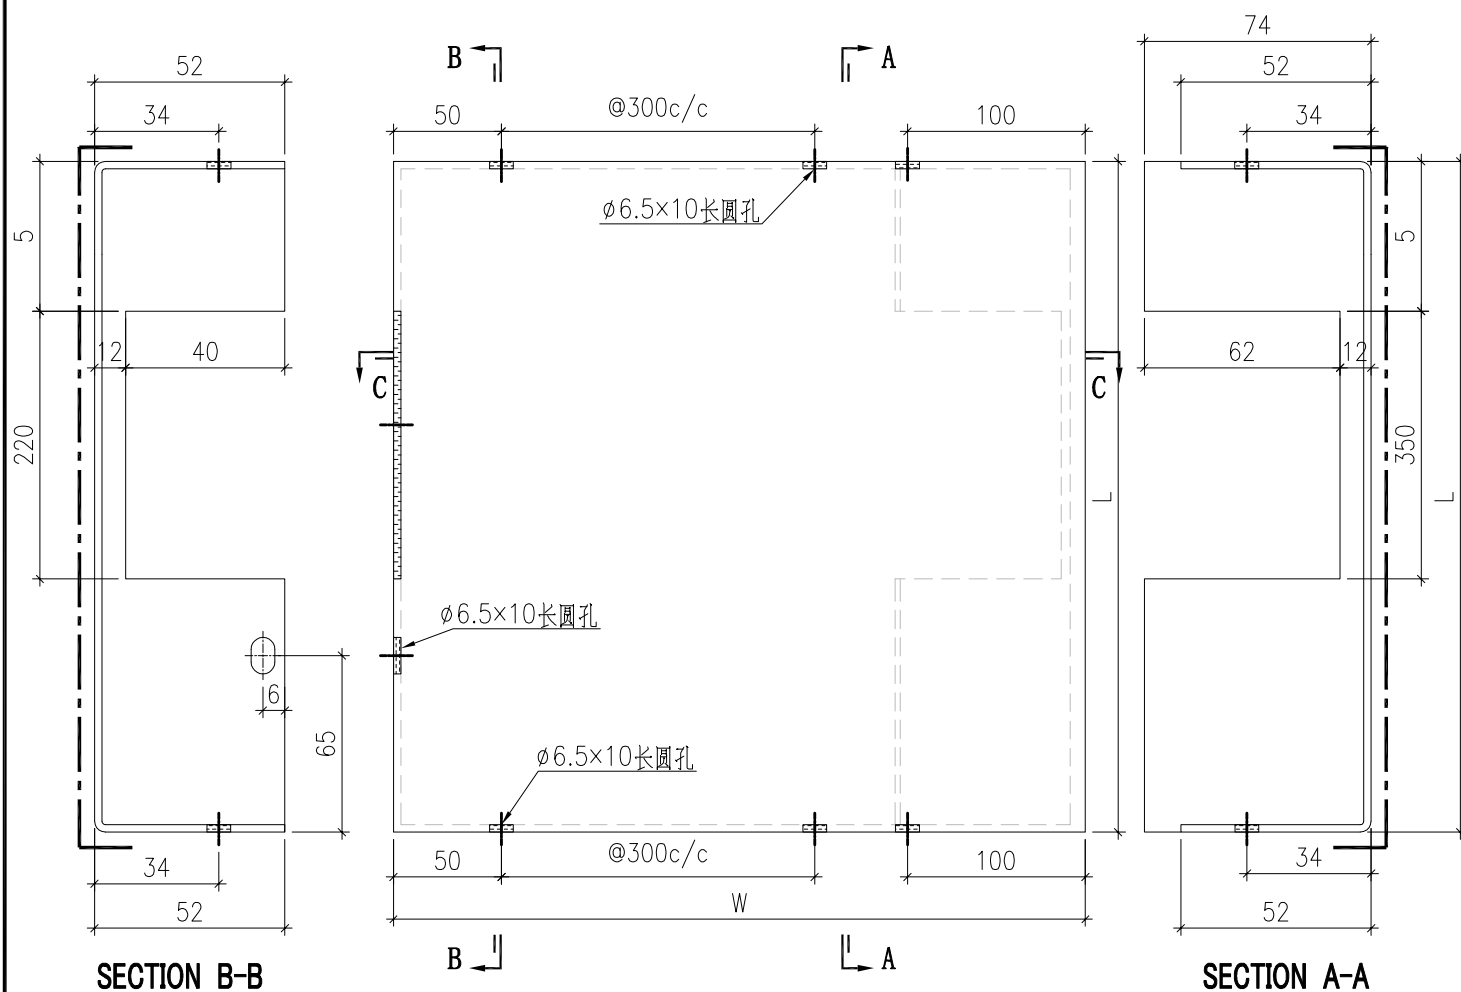


序号	背板编号	宽度W	高度L	数量
1	LZ-BST-N01-01	584	374	1

 美特铝质有限公司 MIDI Aluminium Fabricator Ltd.				工程號	J857	類別		物料號	-			
				地盘	啟德6552	制圖	刘灿	2022.5.24	圖號	LZ-BST-N02		
修改	-	-	採用工廠	✓	地盘	图纸名称	铝板加工图	復核	徐詳坤	2022.5.25	數量	-
日期	-	-	材料颜色	ECK3M96295S-ZD1		材料	3mm THK. 铝板	批准	林仁安	2022.5.26	單件重量	- (KG)

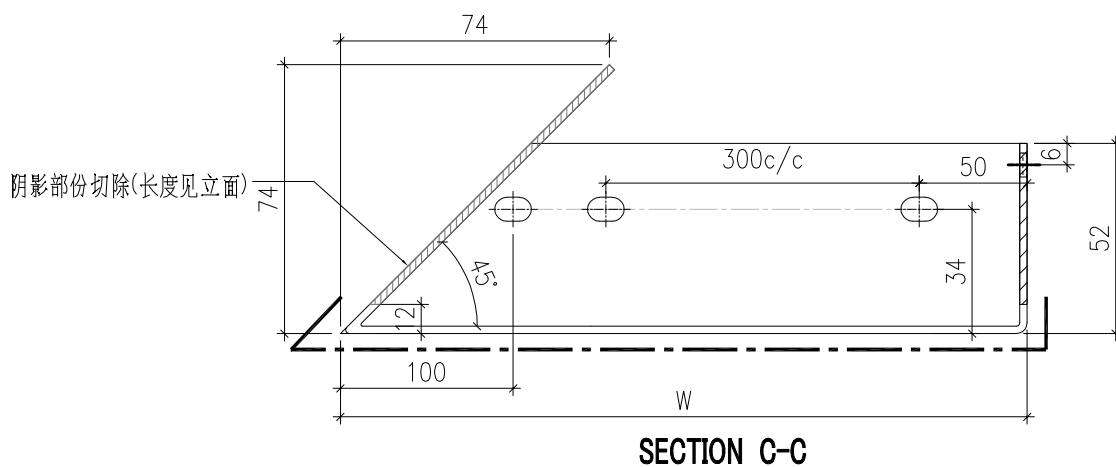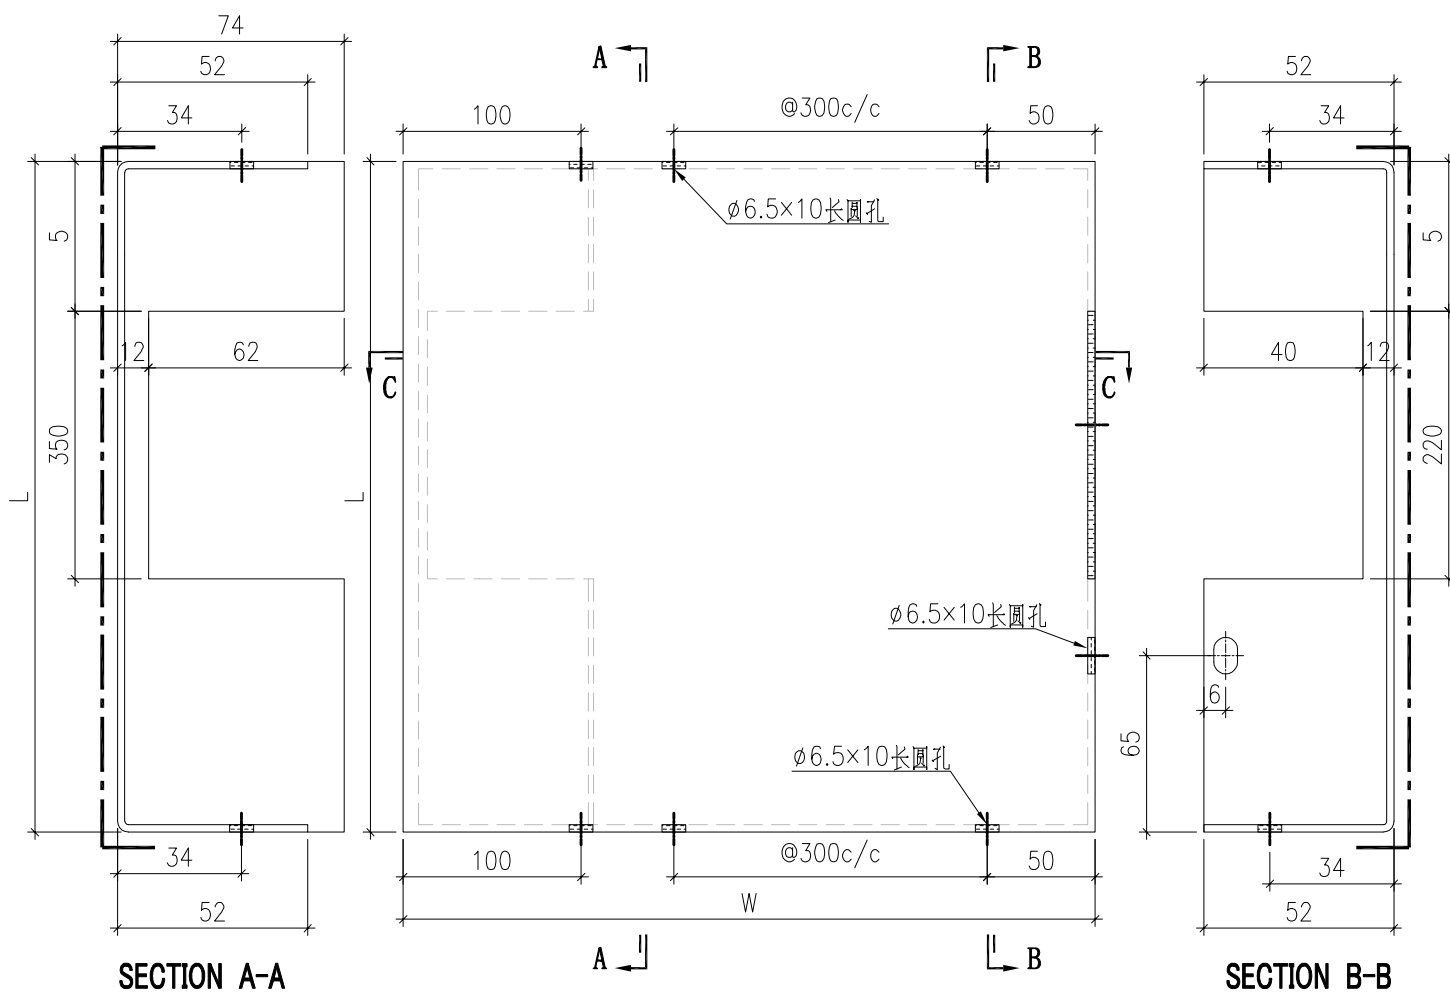

序号	背板编号	宽度W	高度L	数量
1	LZ-BST-N02-01	744	374	1

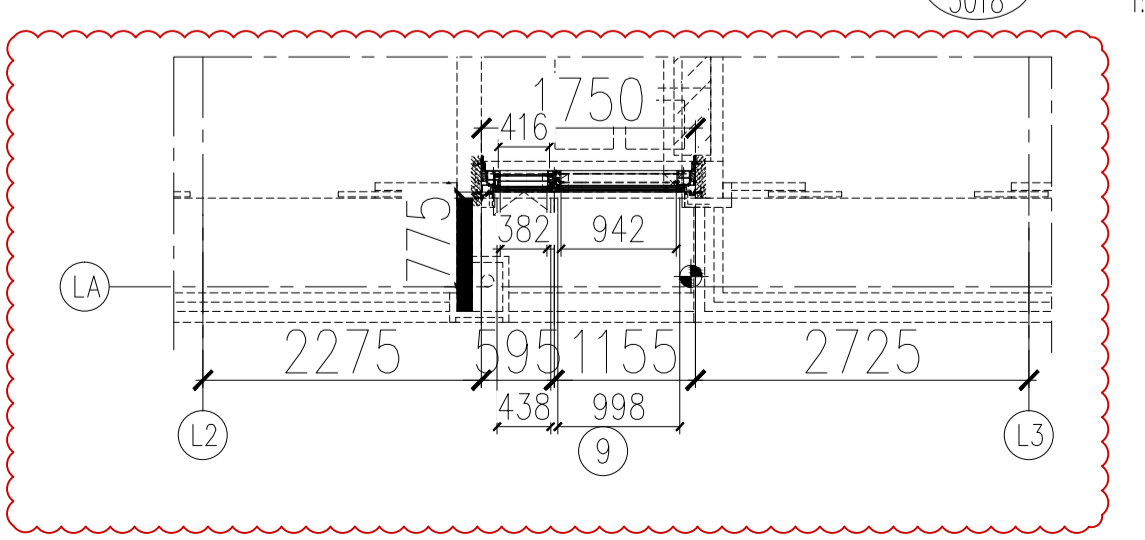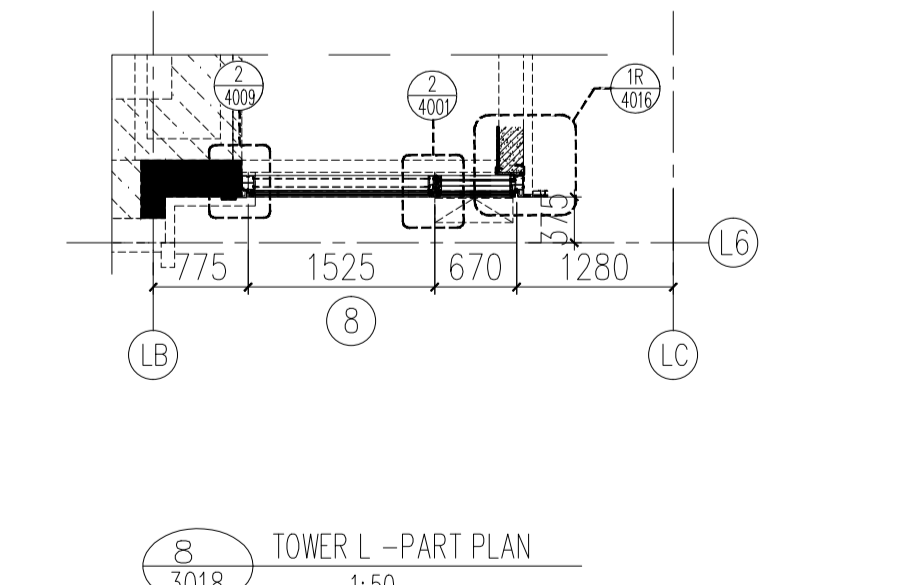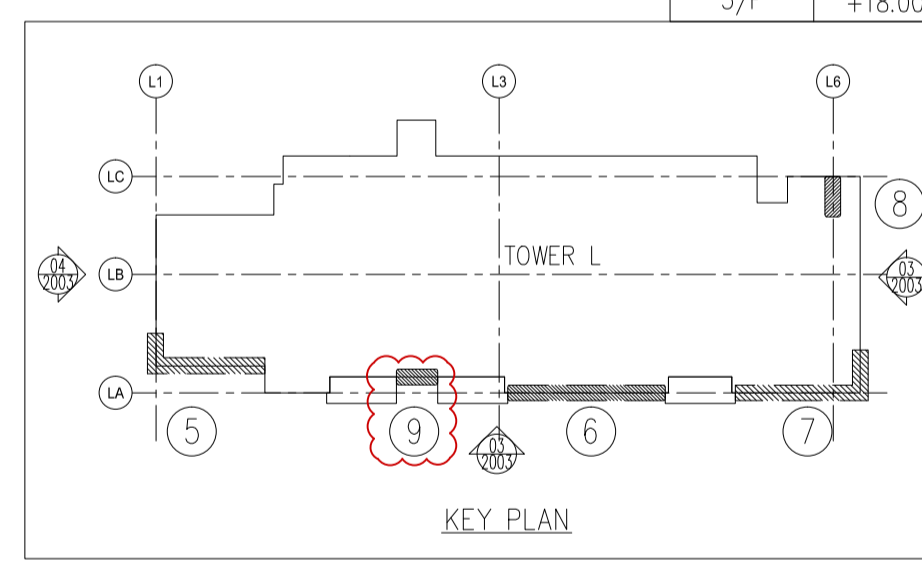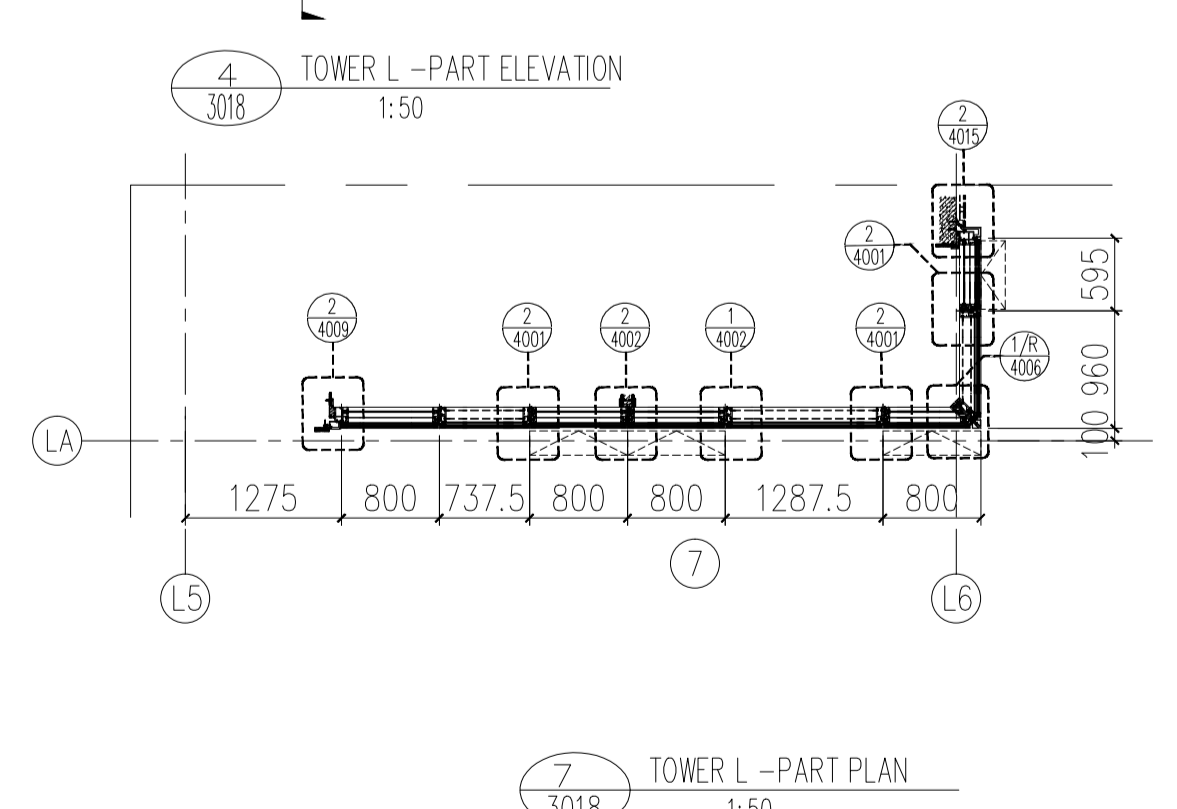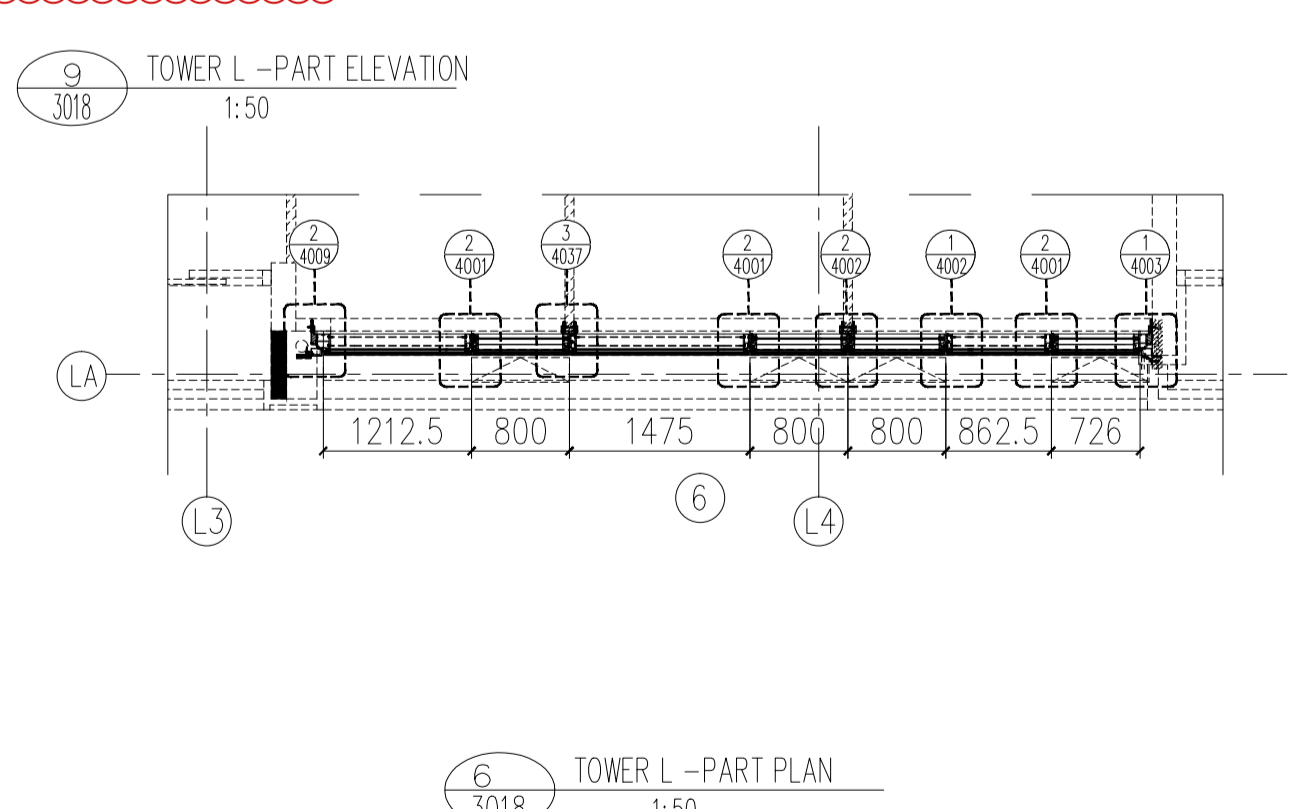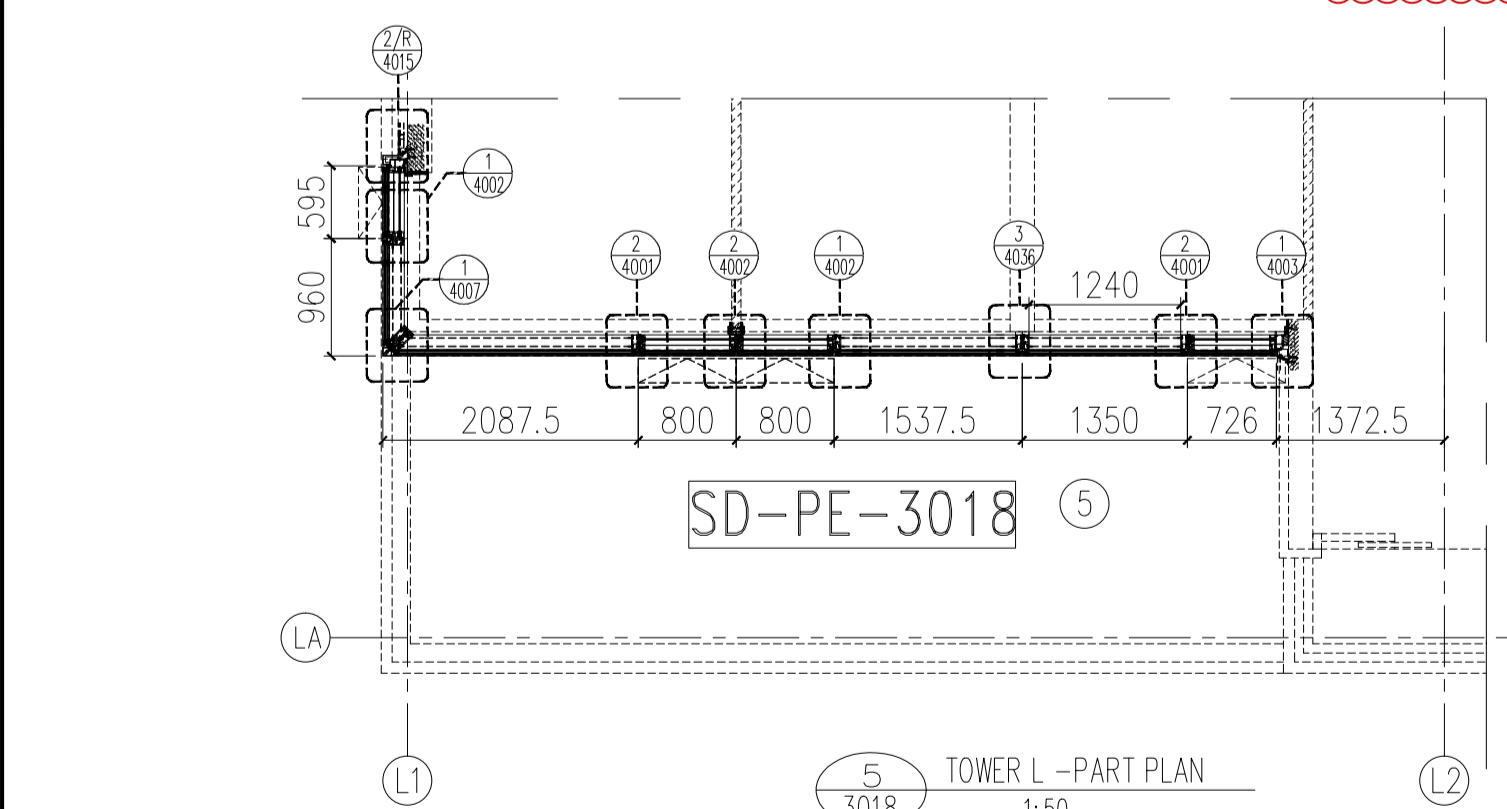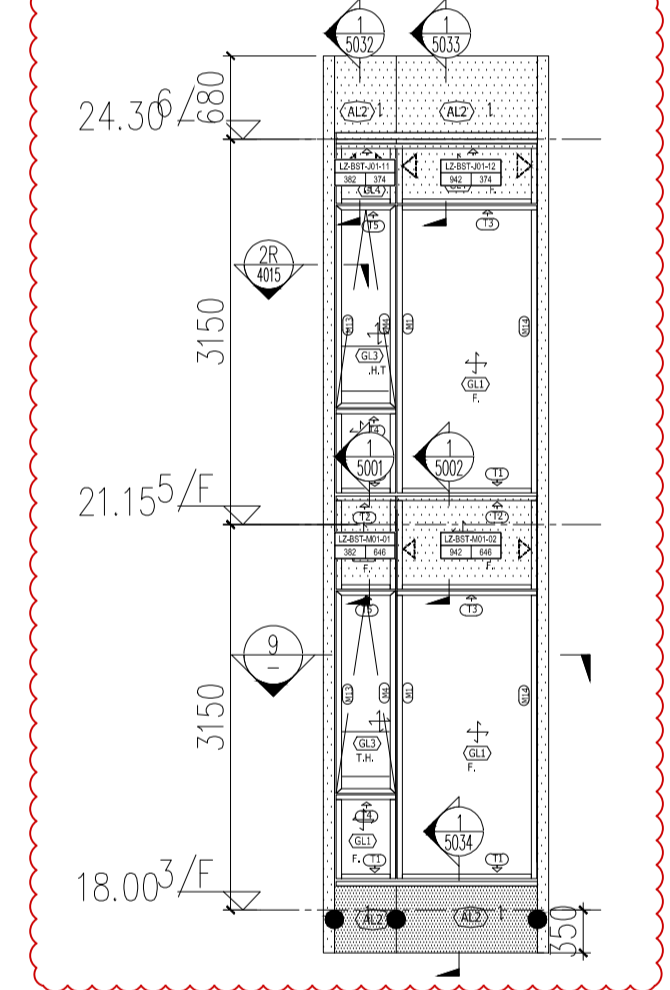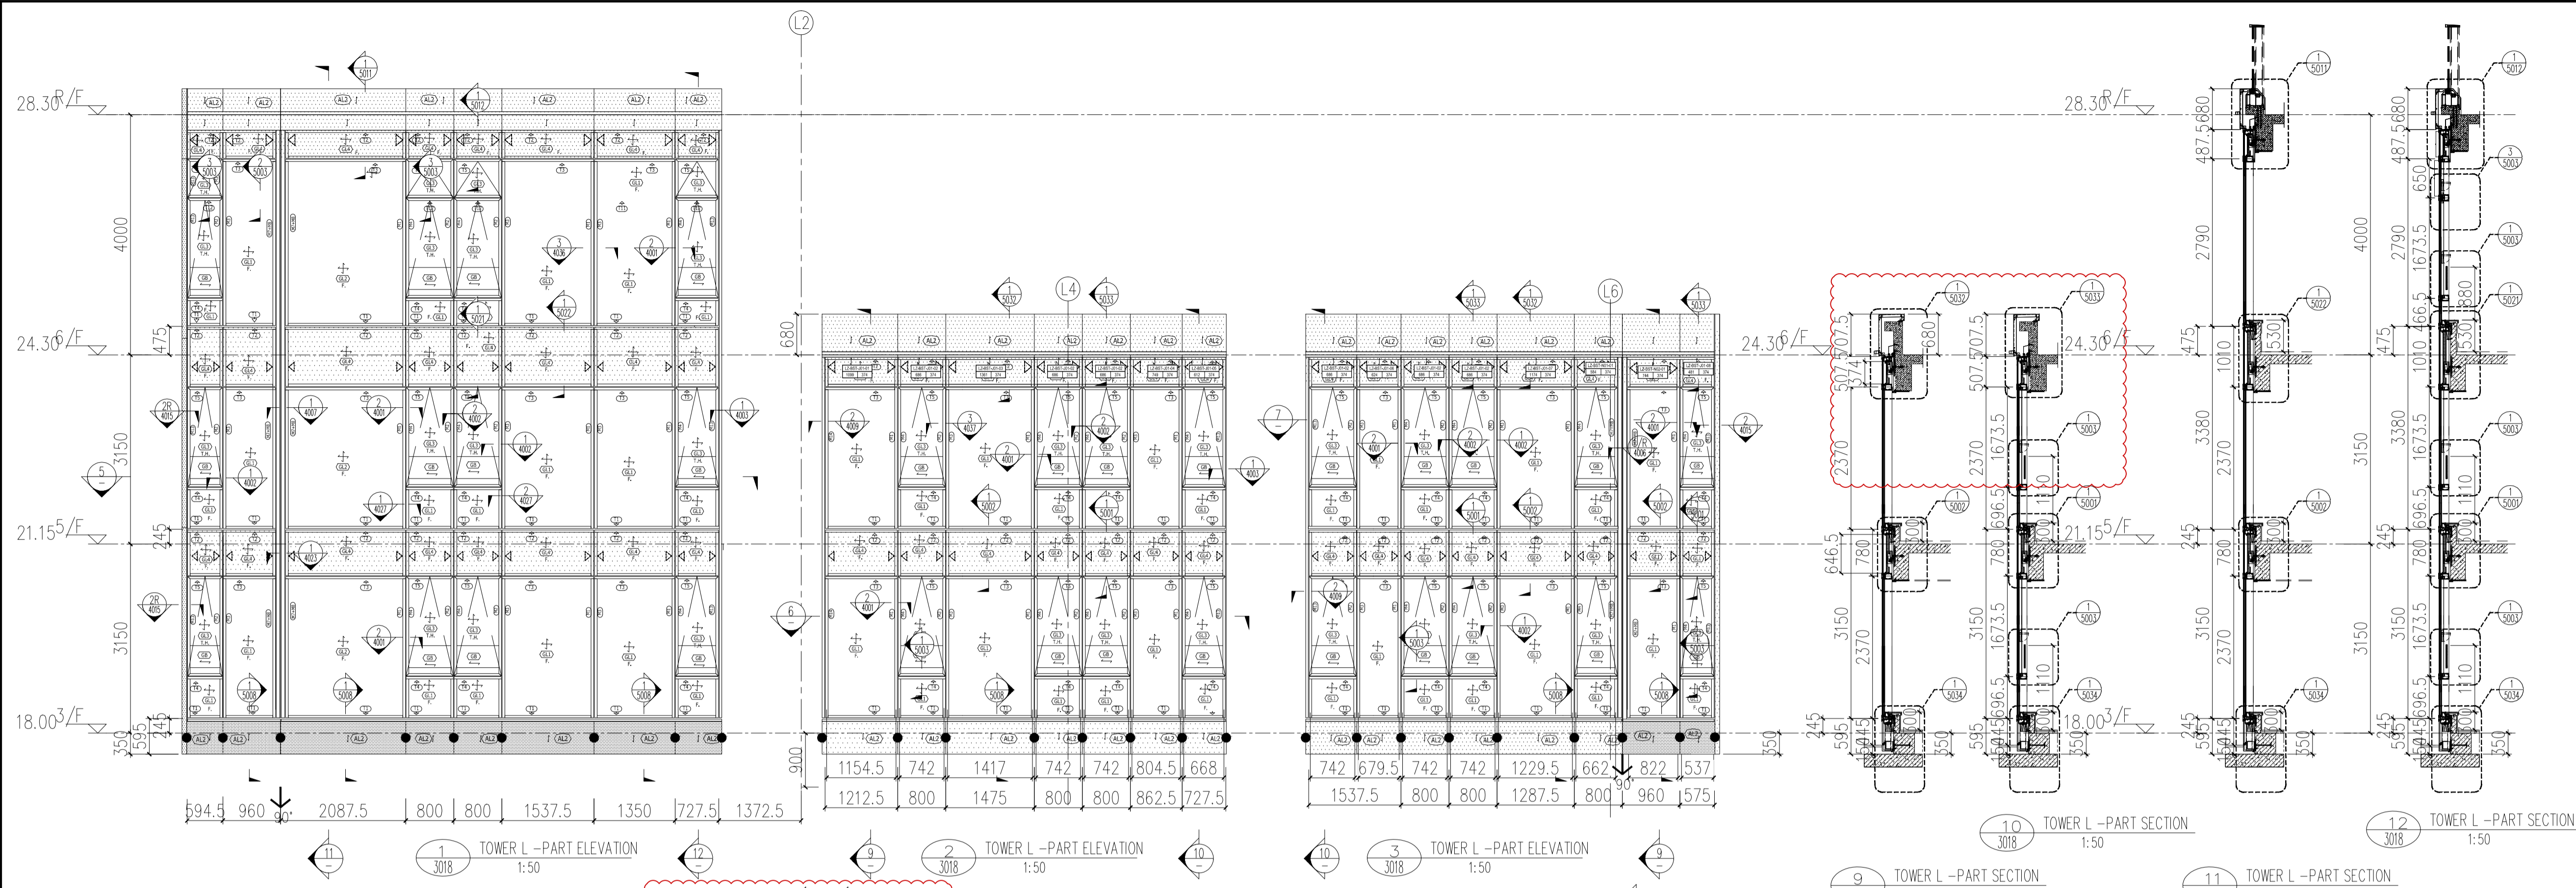

- LEGEND :**
- S.F.L. = STRUCTURAL FLOOR LEVEL
 - C.W. = UNITIZED CURTAIN WALL (FOR BD APPROVAL)
 - ◀EM1= WIND LOAD +DEAD LOAD FIXING LOCATION
 - ◀EM2= WIND LOAD +DEAD LOAD FIXING LOCATION
 - ◀EM3= WIND LOAD FIXING LOCATION
 - GL1 = 8mm HEAT STRENGTHEN LOW IRON GLASS + 1.52 PVB INTERLAYER
 - GL2 = 8mm HEAT STRENGTHEN LOW IRON GLASS + 12mm AIR SPACE +12mm LOW IRON FULLY TEMPERED IGU LAMINATED CLEAR GLASS
 - GL3 = 8mm HEAT STRENGTHEN LOW IRON GLASS + 1.52 PVB INTERLAYER+ 8mm HEAT STRENGTHEN LOW IRON GLASS + 9mm AIR SPACE +8mm LOW IRON FULLY TEMPERED IGU LAMINATED CLEAR GLASS
 - GL4 = 8mm FULLY TEMPERED GLASS + 1.52 PVB INTERLAYER+ 8mm FULLY TEMPERED LAMINATED GLASS
 - GB = 10mm FULLY TEMPERED MONOLITHIC CLEAR GLASS (BARRIER)
 - S.J. = STACK JOINT
 - M1 = EXTRUDED ALUM. MALE MULLION (AL03)
 - M2 = EXTRUDED ALUM. MALE MULLION (AL03A)
 - M3 = EXTRUDED ALUM. FEMALE MULLION (AL04)
 - M4 = EXTRUDED ALUM. FEMALE MULLION (AL04A)
 - M7 = EXTRUDED ALUM. OUTER CORNER MALE MULLION (AL07)
 - M8 = EXTRUDED ALUM. OUTER CORNER FEMALE MULLION (AL08)
 - M9 = EXTRUDED ALUM. OUTER CORNER MALE MULLION (AL86)
 - M10 = EXTRUDED ALUM. OUTER CORNER FEMALE MULLION (AL85)
 - M13 = EXTRUDED ALUM. INTERMEDIATE MULLION (AL65)
 - M14 = EXTRUDED ALUM. INTERMEDIATE MULLION (AL66)
 - M15 = EXTRUDED ALUM. MALE MULLION (AL67)
 - M16 = EXTRUDED ALUM. FEMALE MULLION (AL68)
 - T1 = EXTRUDED ALUM. SILL STACK JOINT (AL11)
 - T2 = EXTRUDED ALUM. GUTTER STACK JOINT (AL12)
 - T3 = EXTRUDED ALUM. INTERMEDIATE TRANSOM (AL13)
 - T4 = EXTRUDED ALUM. INTERMEDIATE TRANSOM (AL15)
 - T5 = EXTRUDED ALUM. INTERMEDIATE TRANSOM (AL14)
 - T7 = EXTRUDED ALUM. TRANSOM (AL71)
 - T8 = EXTRUDED ALUM. TRANSOM (AL72)
 - T9 = EXTRUDED ALUM. TRANSOM (AL69)
 - T10 = EXTRUDED ALUM. TRANSOM (AL70)
 - T11 = EXTRUDED ALUM. INTERMEDIATE TRANSOM(AL106)
 - T12 = EXTRUDED ALUM. INTERMEDIATE TRANSOM(AL107)
 - T13 = EXTRUDED ALUM. GUTTER STACK JOINT (AL105)
 - ⊙ = BMU SOCKET(GLASS UNIT)

B.D. REF :
 F.S.D. REF :
 Note :
 1.All dimensions are in mm.
 2.All elevations are viewed from outside.
 3.All dimensions to be verified on site before fabrication.

GENERAL NOTES

Legend :

1. F.F.L.-- Finished Floor Level
2. S.F.L.-- Structural Floor Level
3. (R) -- Reversed Detail

X1 -- DETAIL MARK NO.
 X001 -- REFER SHEET NO.

REV.	DATE	DESCRIPTION	BY

CLIENT :
MARBLE EDGE INVESTMENT LTD.

ARCHITECT :
RONALD LU & PARTNERS
 ARCHITECTS | PLANNERS | INTERIOR DESIGNERS

STRUCTURAL ENGINEER :
CMA C M WONG & ASSOCIATES LTD
 110-112, 114, 116, 118, 998, 1000

MAIN CONTRACTOR :
裕民建築有限公司

美特鋁質有限公司
 MIDI ALUMINIUM FABRICATOR LTD.
 Units 6-8, Sunray Industrial Centre, 1/F
 610 Cha Kwo Ling Road, Kowloon
 Tel:23489211-4 Fax:(852)27727666

PROJECT :
PROPOSED RESIDENTIAL DEVELOPMENT AT NEW KOWLOON INLAND LOT. NO.6552

TITLE :
PARTIAL ELEVATION, PLAN, SECTION FOR TOWER L

JOB NO. : J-857

DRAWN BY : AN DATE : 18.Oct.2021

CHKD BY : SCALE A1:60.000000 A3:


DWG. NO. : SD-PE-3018 REV. : B

28.30^R/F

24.30⁶/F

21.15⁵/F

18.00³/F

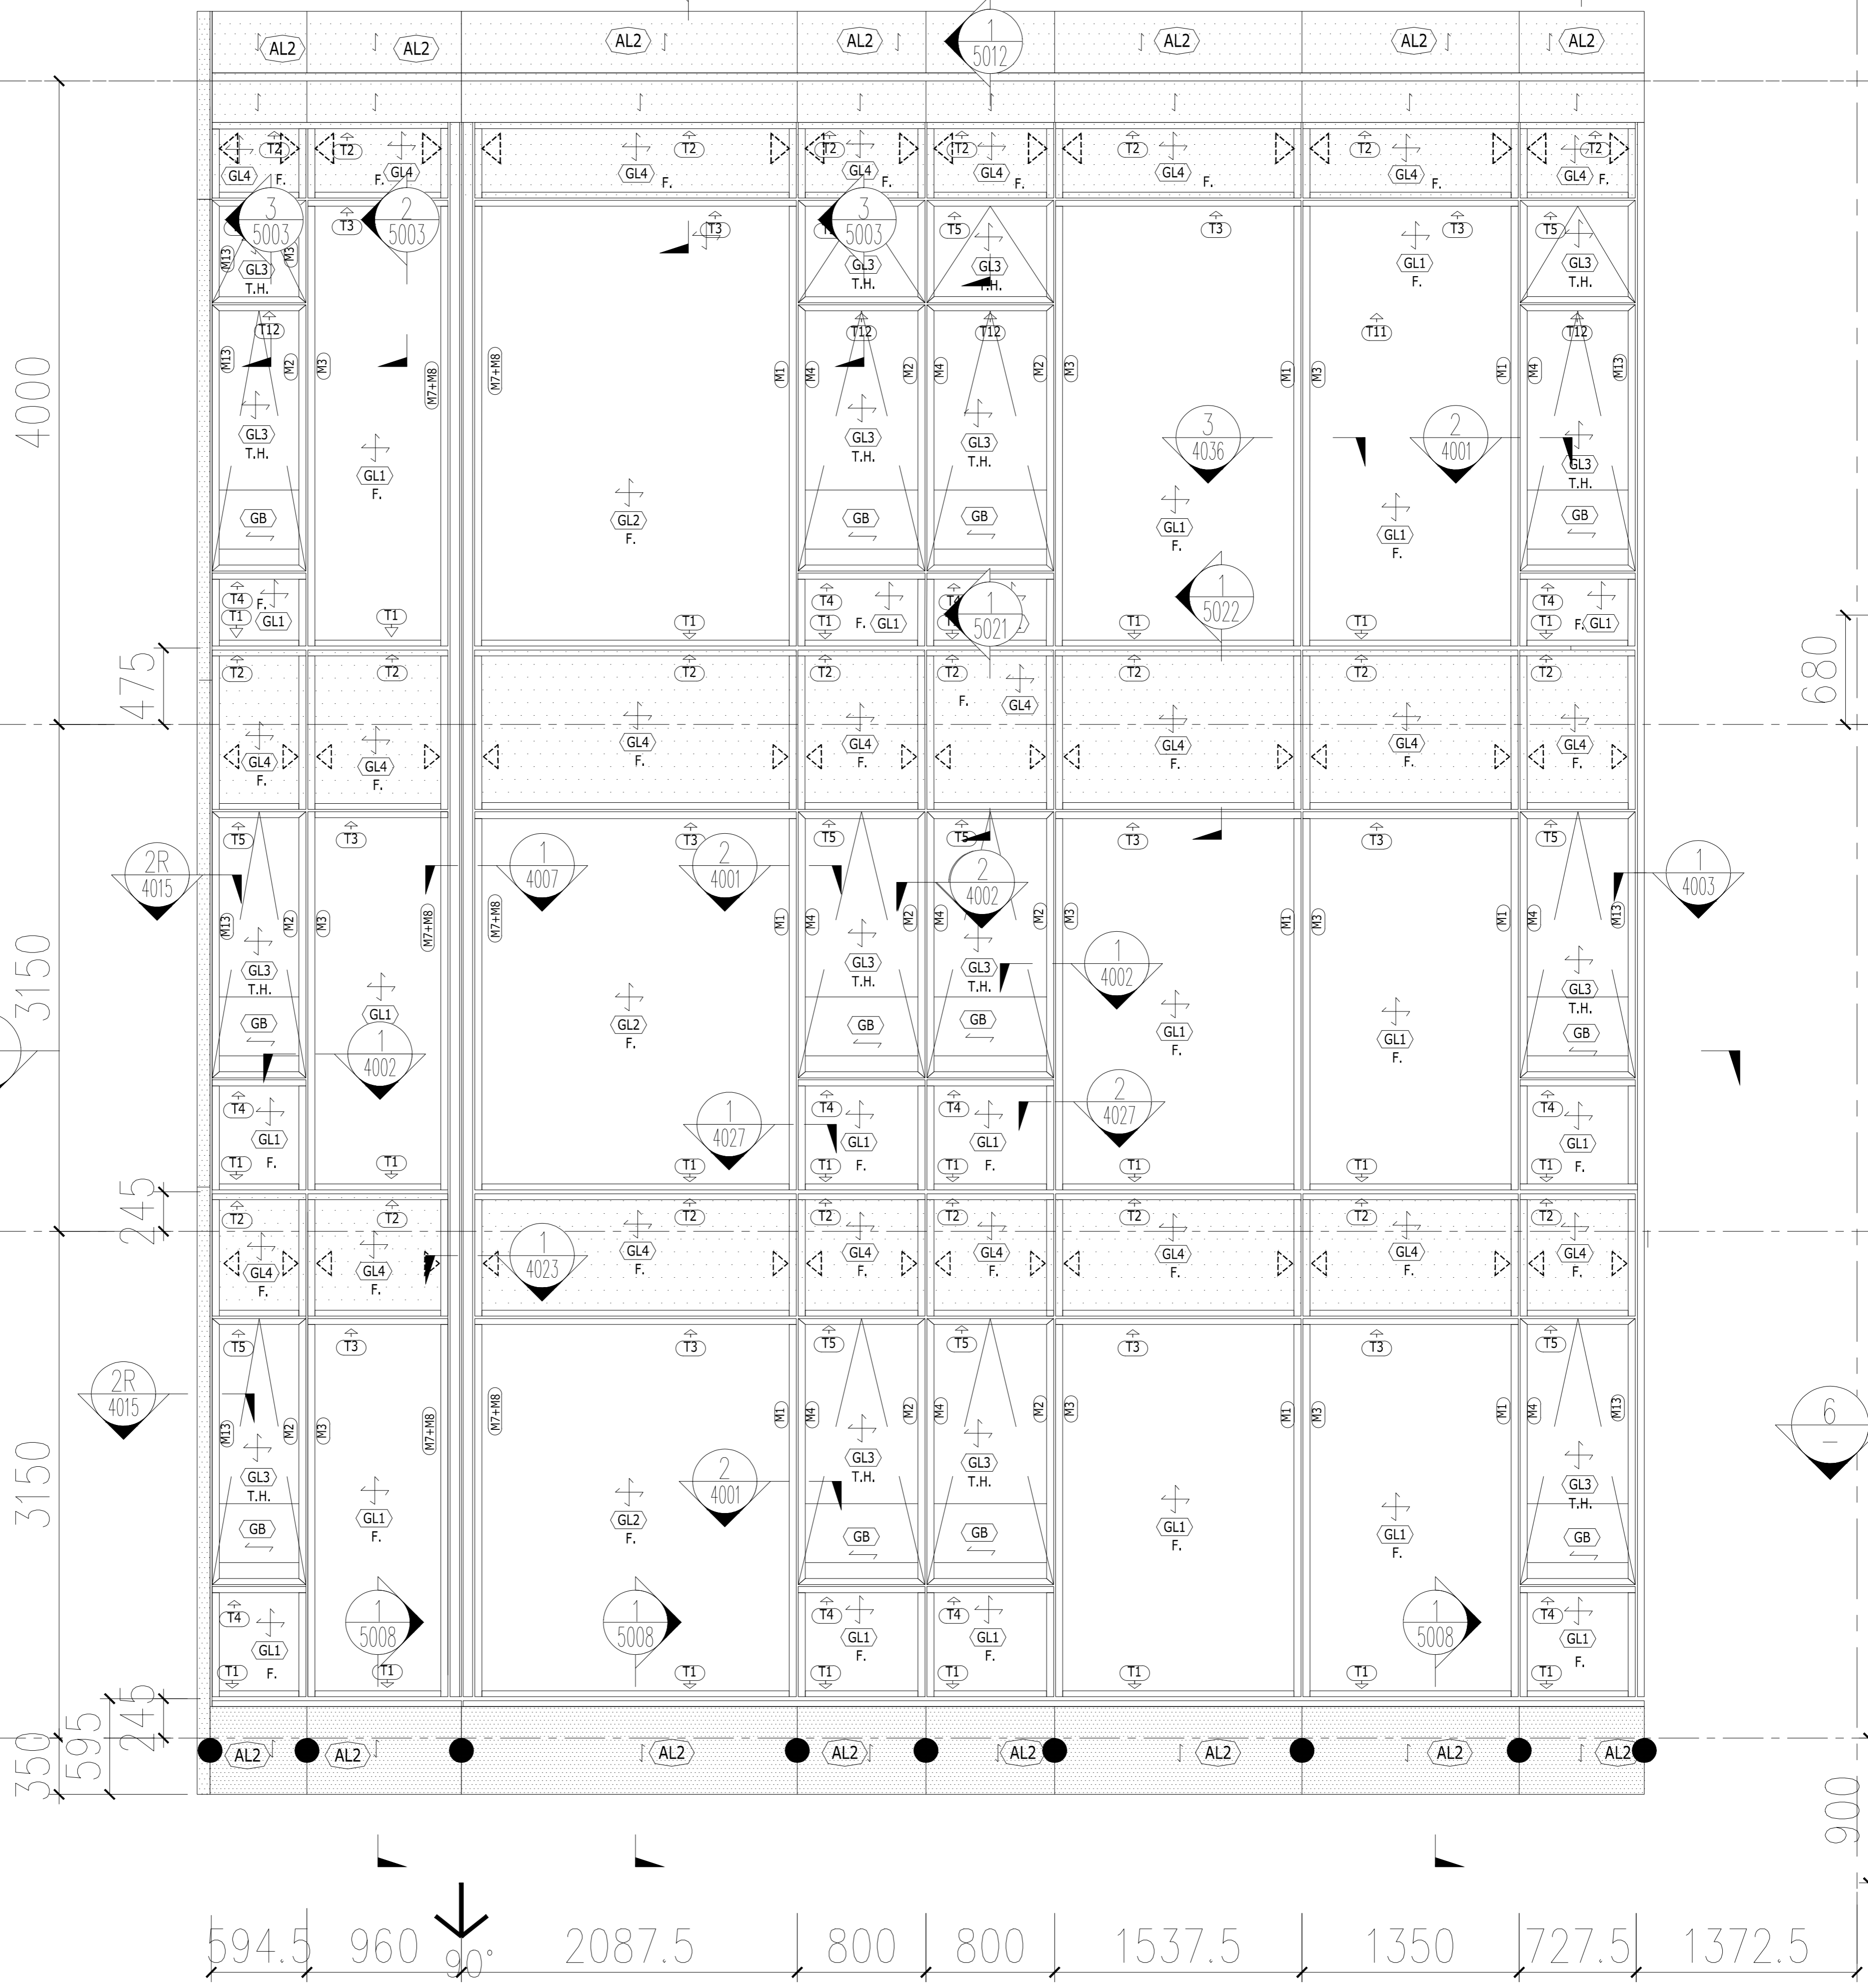


11

1
3018

TOWER L - PART ELEVATION
1:50

12

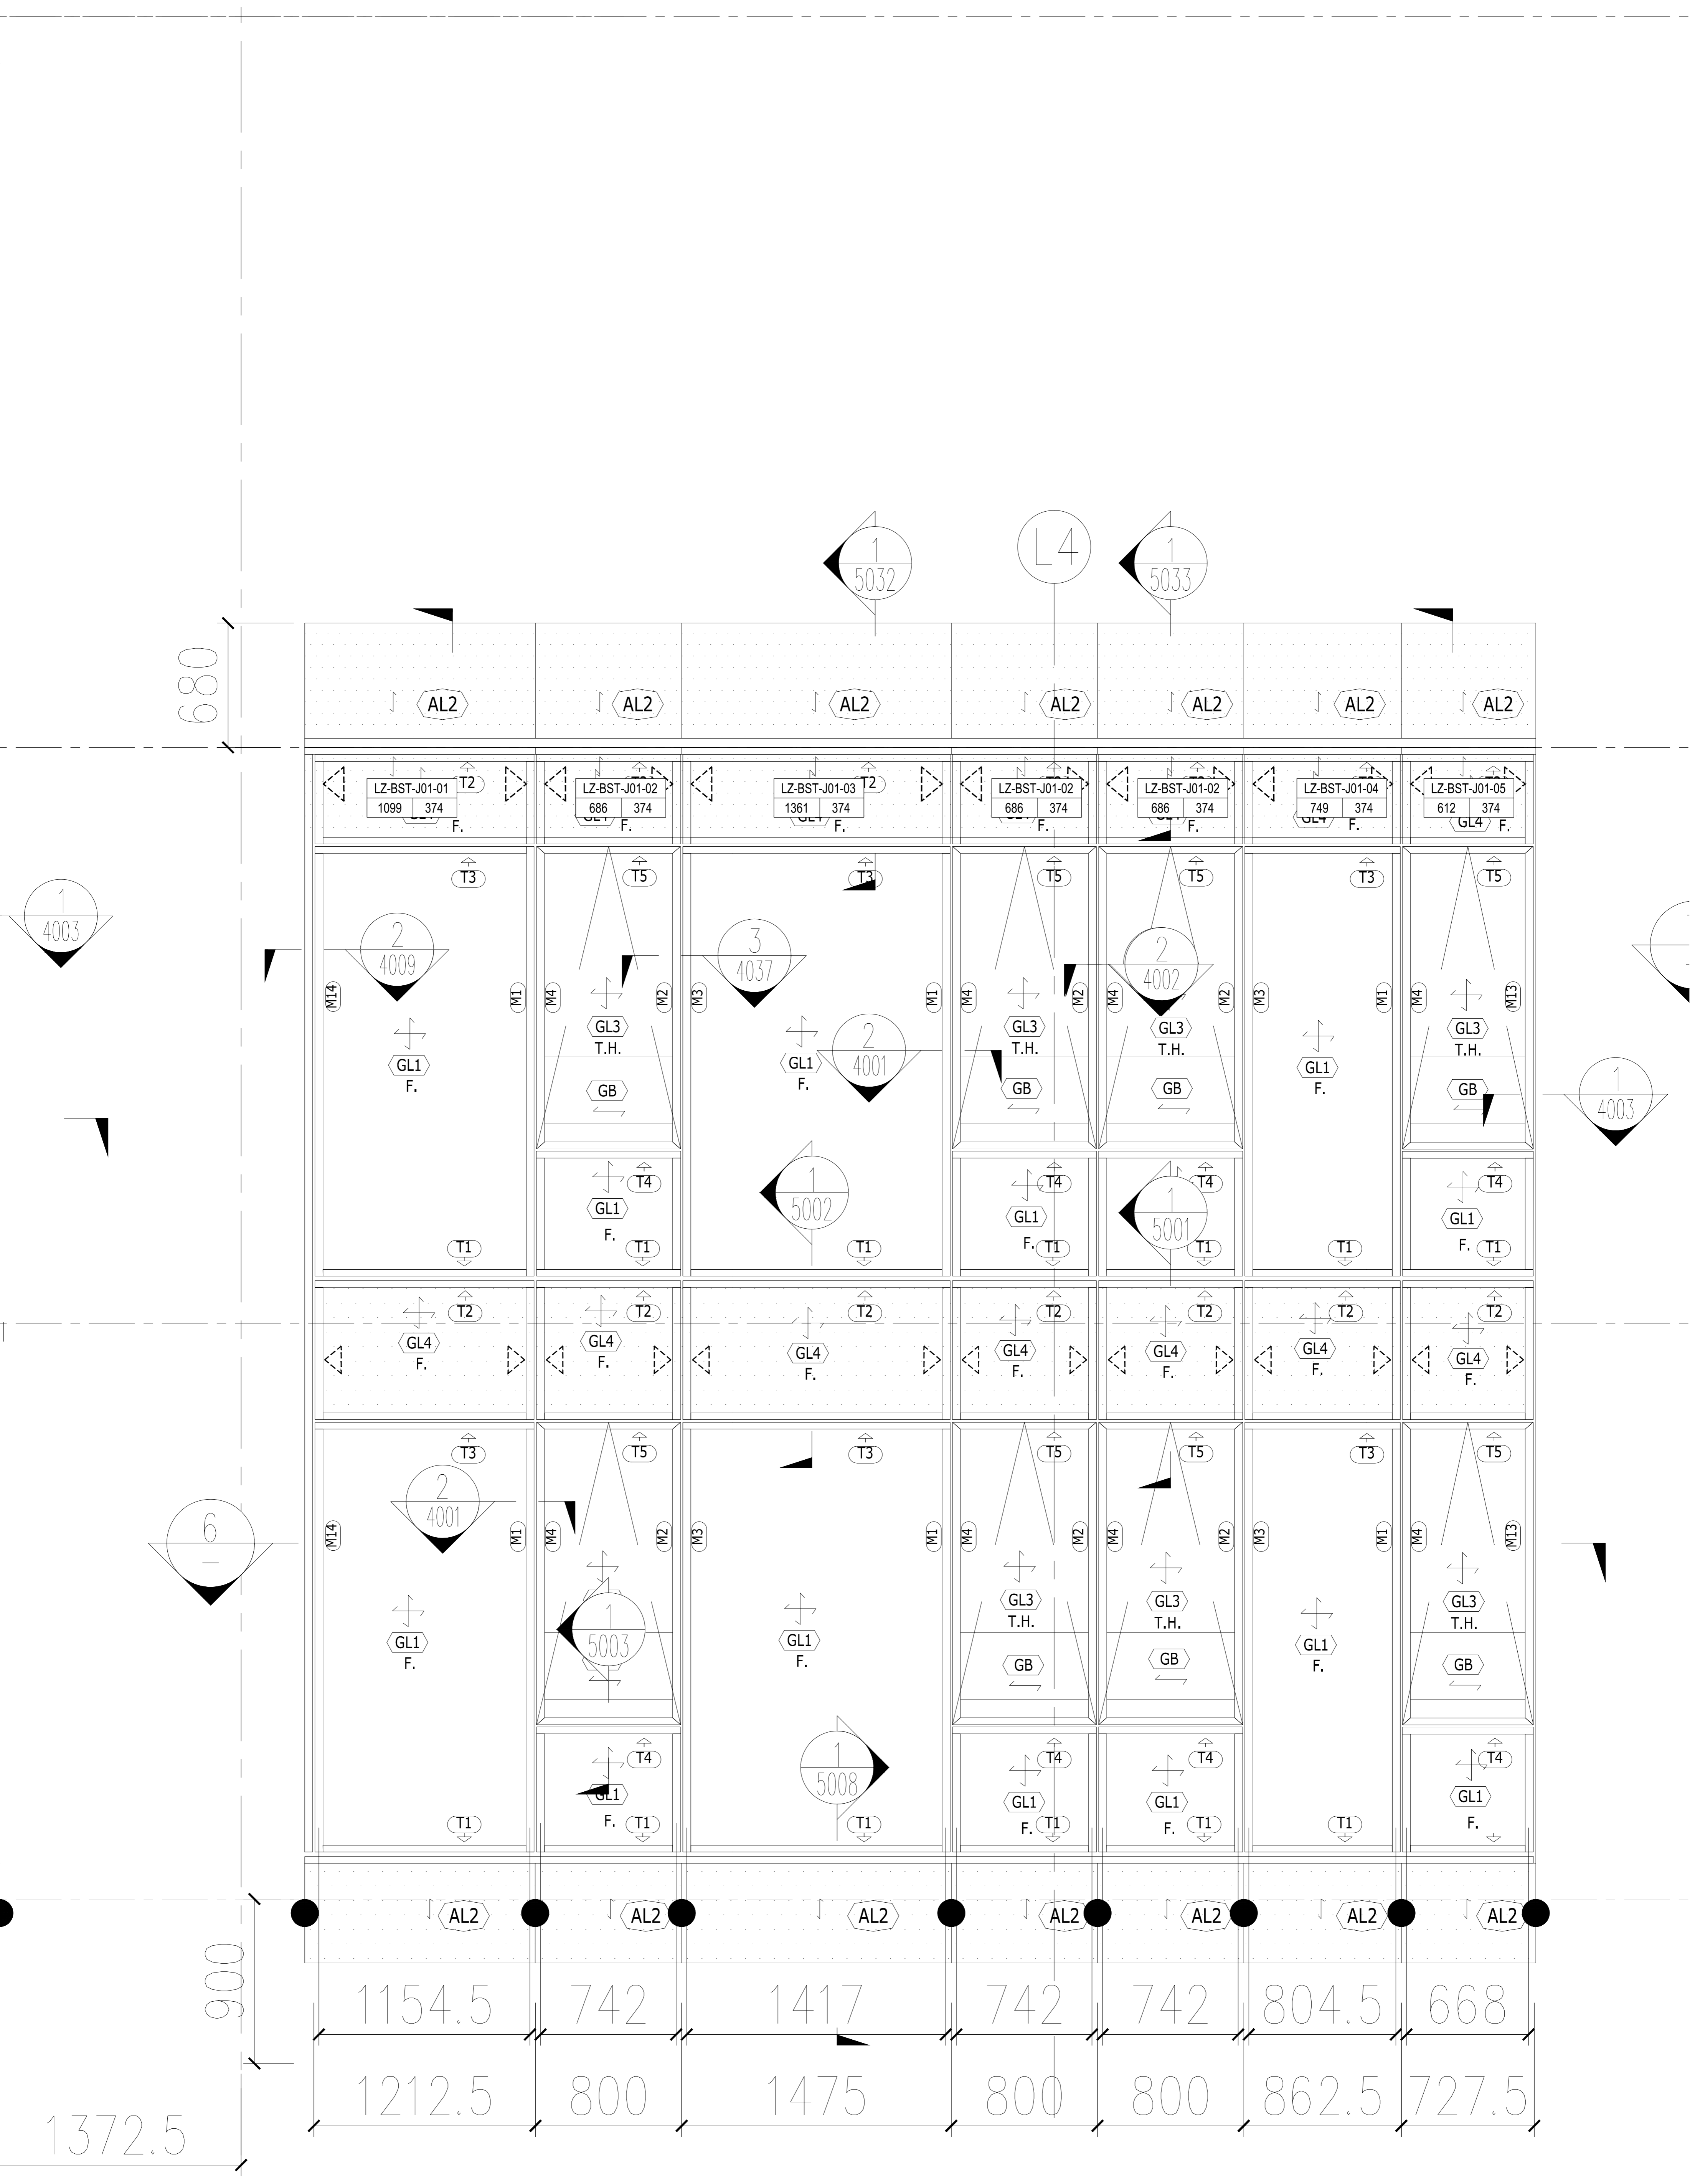

1372.5

900

680

1154.5 742 1417 742 742 804.5 668
 1212.5 800 1475 800 800 862.5 727.5


9
-

2
3018

TOWER L - PART ELEVATION


1:50

10
-

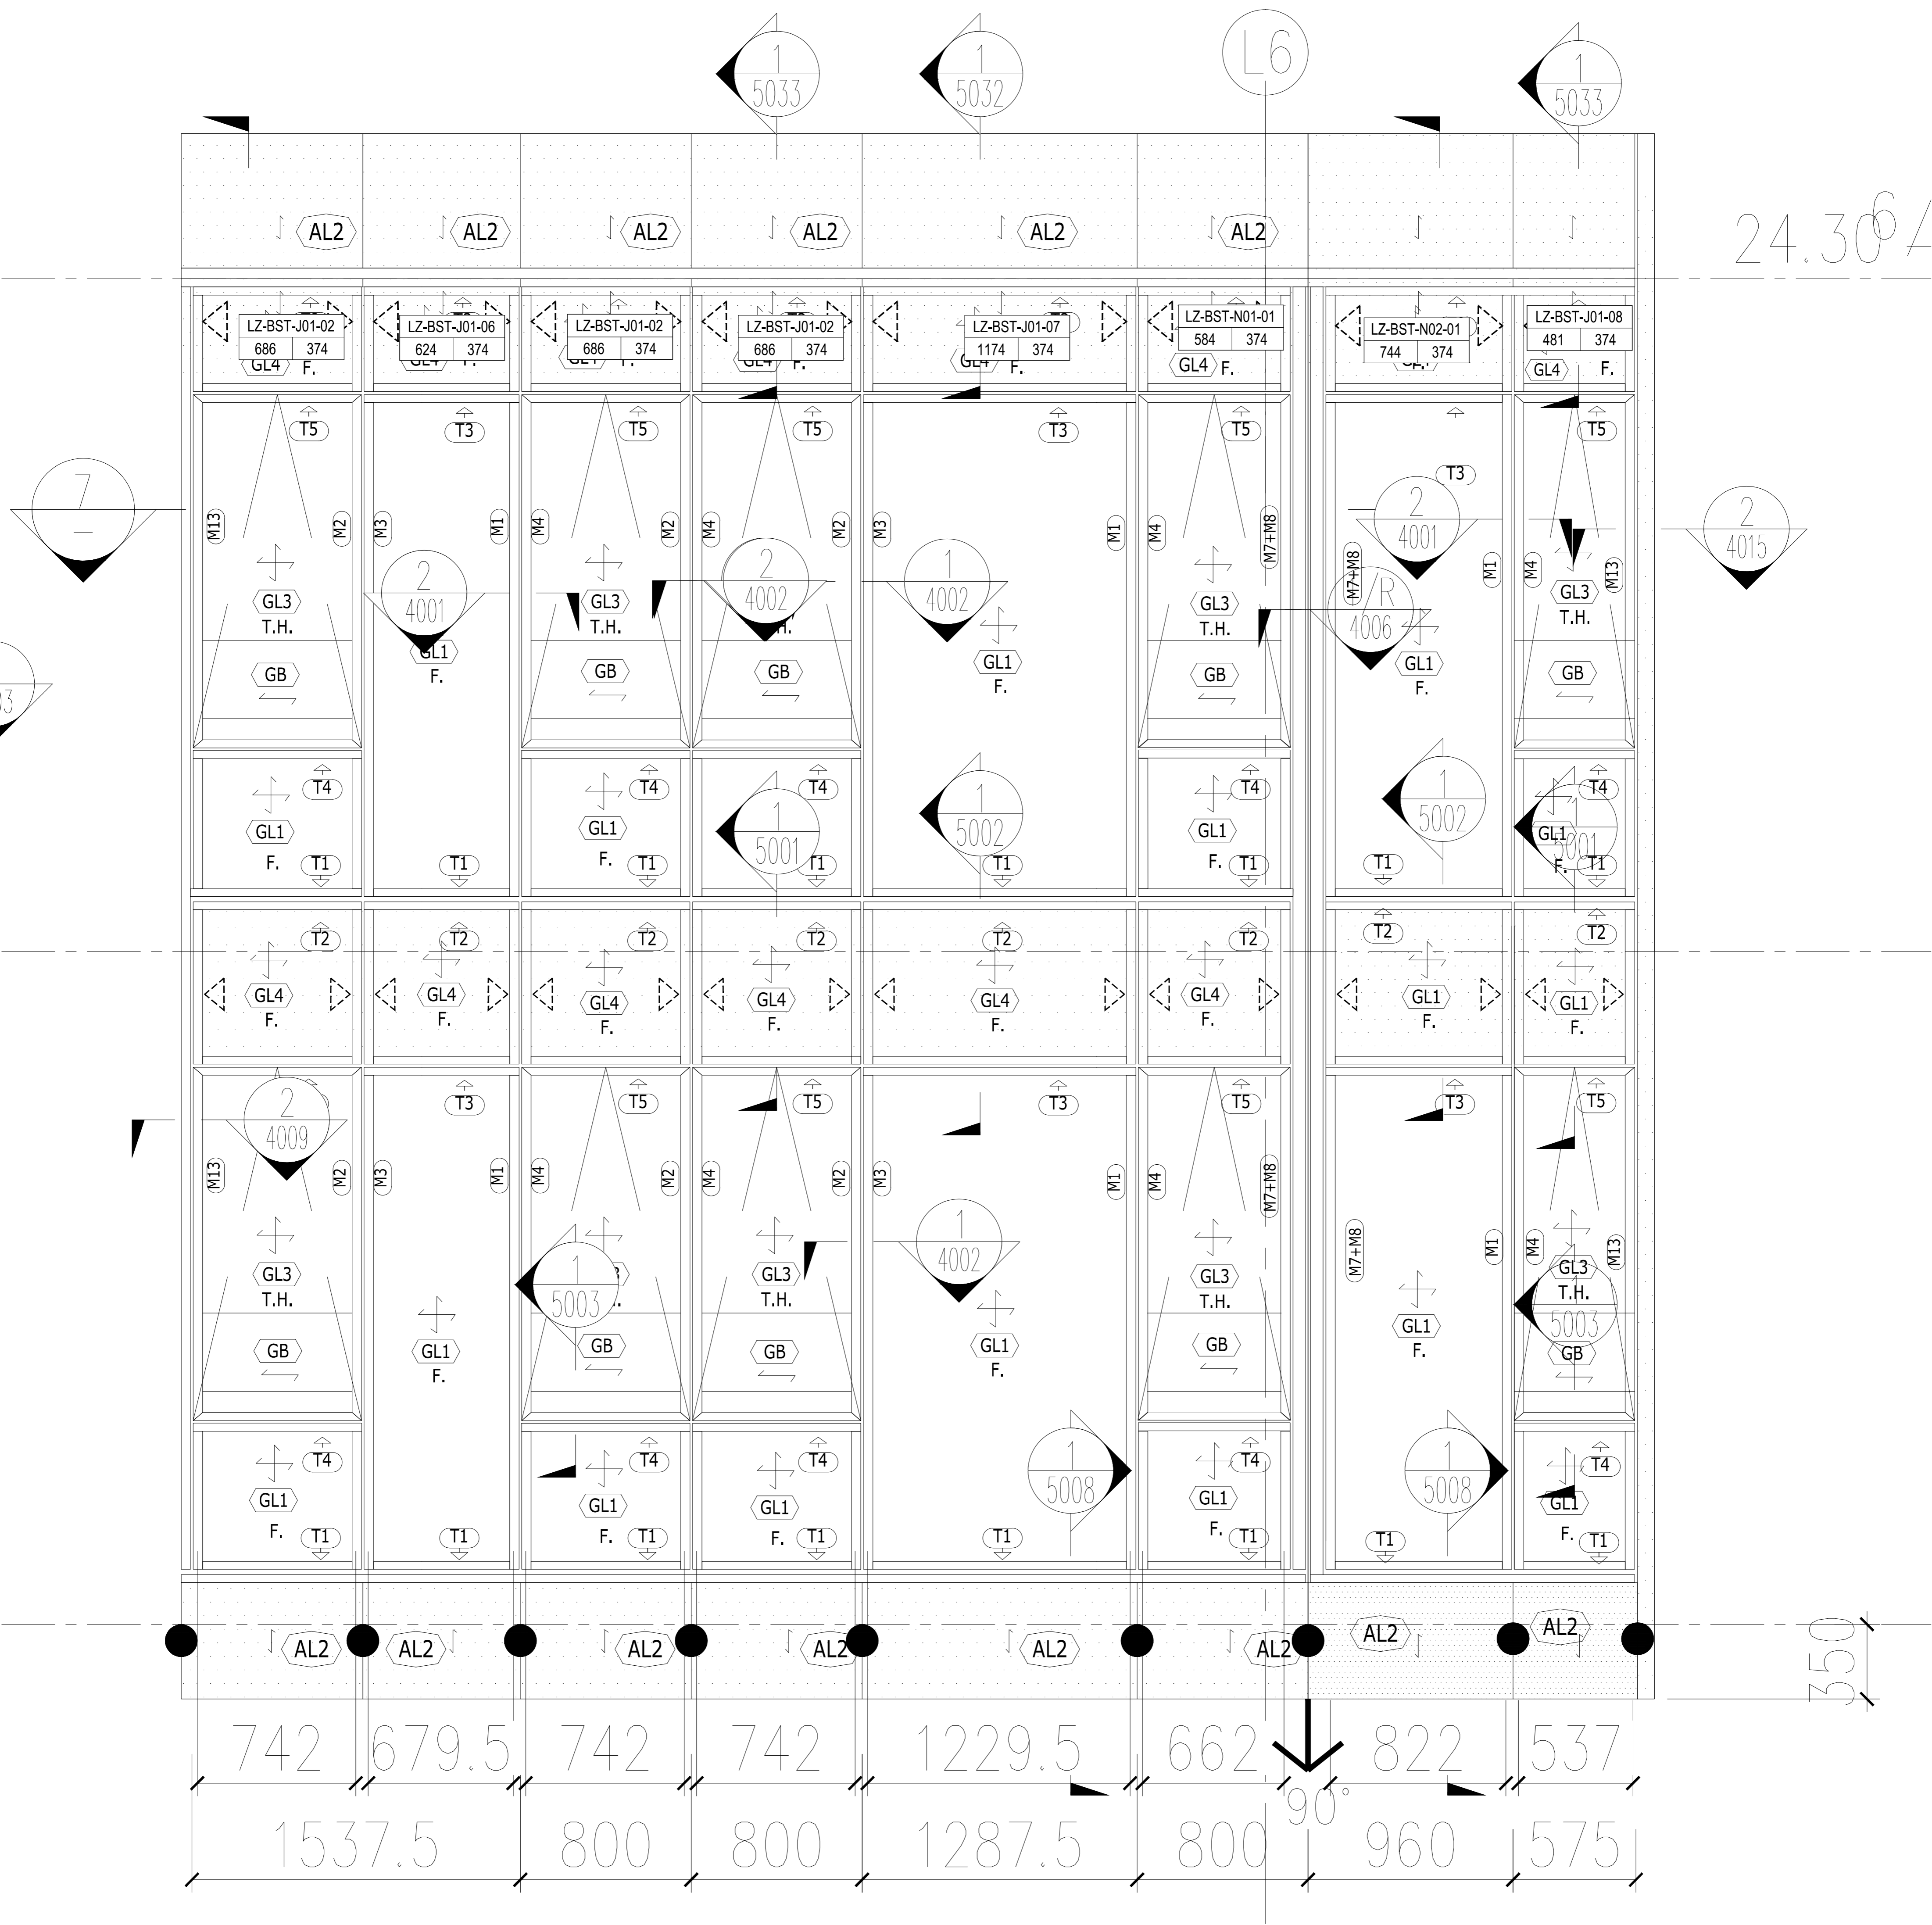

10
3
9

TOWER L - PART ELEVATION
 1:50

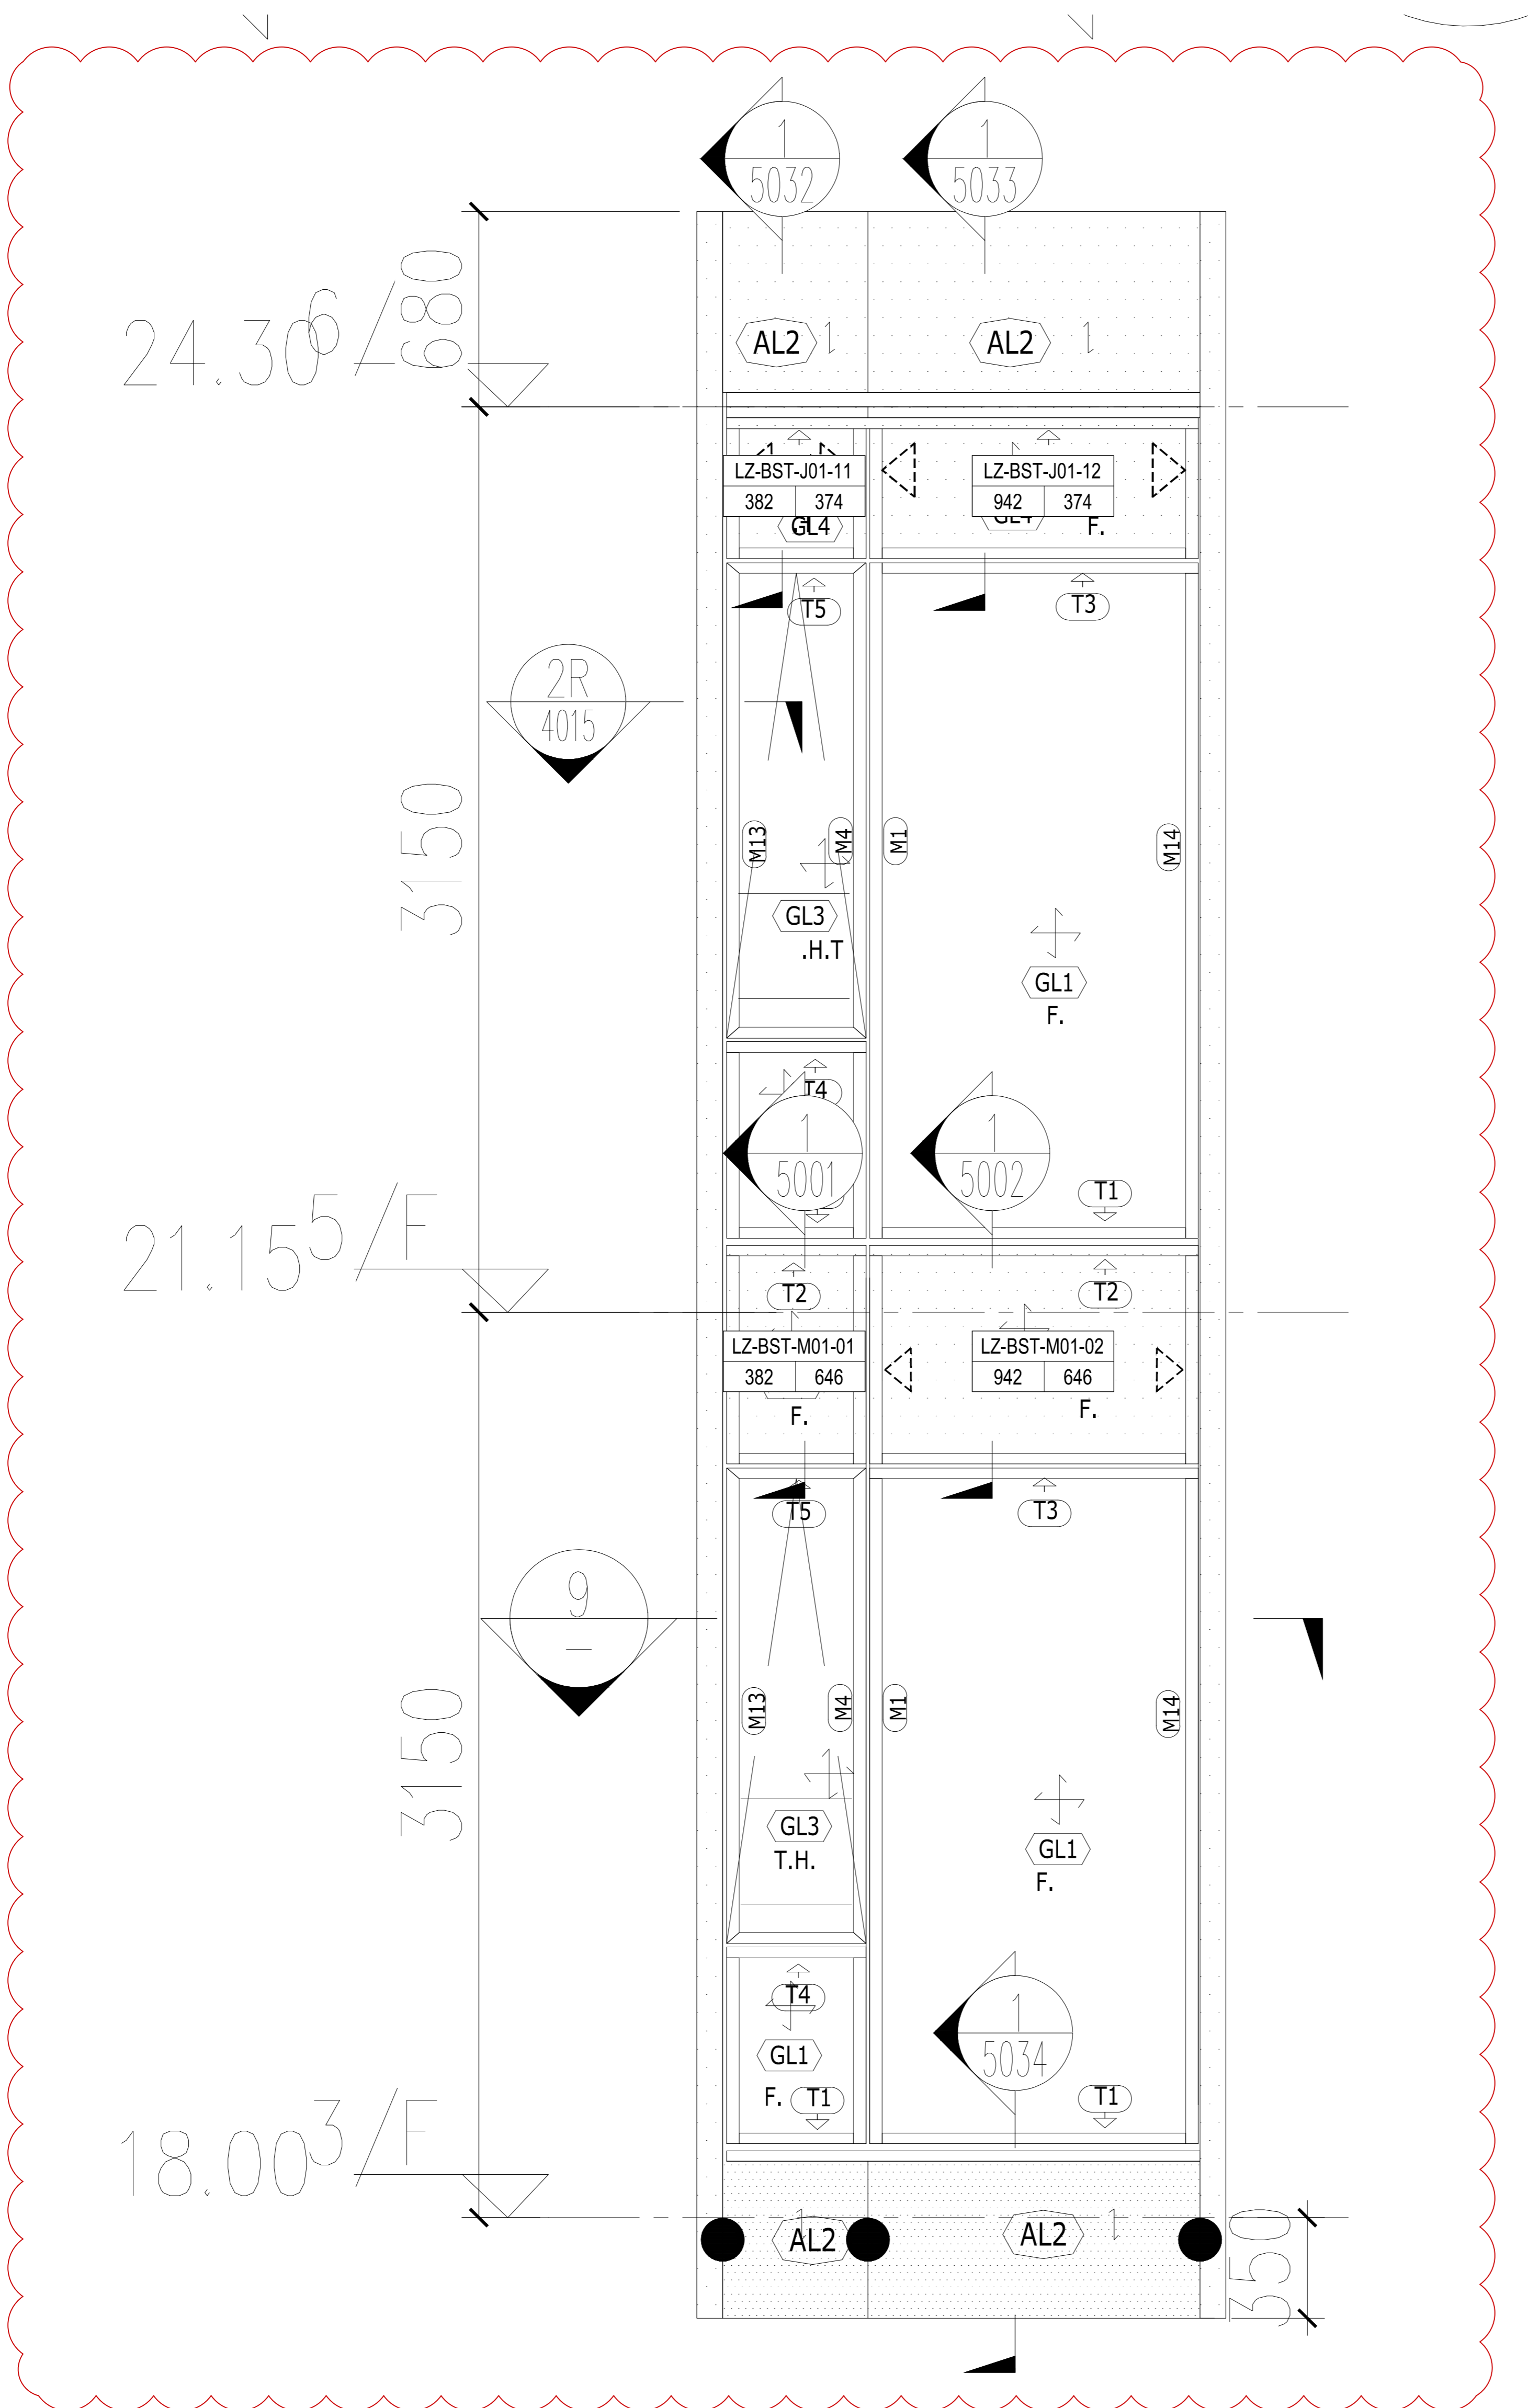

9
3018

TOWER L - PART ELEVATION

1:50

