



工程指示 / 要求簡箋 ENGINEER INSTRUCTIONS(E.I.)

工程指示編號:	EI- 4733	修改版本:	C
	HK- /		
工程編號:	J 857	工程名稱:	啟德6552
收件人:	Maggie Lor	發件人:	Nero HO
工程項目:	屋頂欄河 - 地盤用玻璃BM	日期:	22/11/2022

<input type="checkbox"/> 原合約工程包	<input type="checkbox"/> 原合約工程加 / 減賬 QT-	<input type="checkbox"/> 新工程報價 QT-
---------------------------------	--	------------------------------------

信件批核號碼/圖紙參考編號:	批核模具圖紙編號:
客戶指示附件:	管理內部批簽署:

<input type="checkbox"/> 初步鋁料 B.M.	<input type="checkbox"/> 加工拆圖, 然後生產	<input type="checkbox"/> 尺寸表
<input type="checkbox"/> 正式鋁料 B.M.	<input type="checkbox"/> 技術上資料/指示	<input type="checkbox"/> 報價
<input type="checkbox"/> 配件 B.M.	<input type="checkbox"/> 樣辦或貨品說明書	<input type="checkbox"/> 分判合約
<input type="checkbox"/> 其他:		

內容: 增加可放行生產的玻璃, 請按附件資料生產加工, 並按附件資料保護方法包裝送地盤。  *依玻璃廠建議只標註放行的部份, 暫停的部份不要標註, 以避免混亂以致漏單。
完成上列要求日期: 17/02/2023


國內


<input type="checkbox"/> 生產技術總監	<input type="checkbox"/> 連附件	<input type="checkbox"/> 技術部	<input type="checkbox"/> 連附件	<input type="checkbox"/> 生產部	<input type="checkbox"/> 連附件
<input type="checkbox"/> 採購部	<input type="checkbox"/> 連附件	<input type="checkbox"/> 生產統籌部	<input type="checkbox"/> 連附件	<input type="checkbox"/> 報關組	<input type="checkbox"/> 連附件
<input type="checkbox"/> 質檢部	<input type="checkbox"/> 連附件	<input type="checkbox"/> 會計部	<input type="checkbox"/> 連附件	<input type="checkbox"/> 機械設計部	<input type="checkbox"/> 連附件
<input type="checkbox"/> 香港辦	<input type="checkbox"/> 連附件	<input type="checkbox"/> 其他:			

<input type="checkbox"/> 行政部	<input type="checkbox"/> 連附件	<input type="checkbox"/> 會計部	<input type="checkbox"/> 連附件	<input type="checkbox"/> 統籌部	<input type="checkbox"/> 連附件	<input type="checkbox"/> 工程部	<input type="checkbox"/> 連附件
<input checked="" type="checkbox"/> 採購部	<input checked="" type="checkbox"/> 連附件	<input type="checkbox"/> QS部	<input type="checkbox"/> 連附件	<input checked="" type="checkbox"/> 地盤管理	<input checked="" type="checkbox"/> 連附件	<input type="checkbox"/> 維修部	<input type="checkbox"/> 連附件


*發件人簽署:	<i>M L</i>	*組別成員批核簽署:	
傳遞編號:	/	項目經理簽署:	<i>HO</i>

# 欄河玻璃保護方案

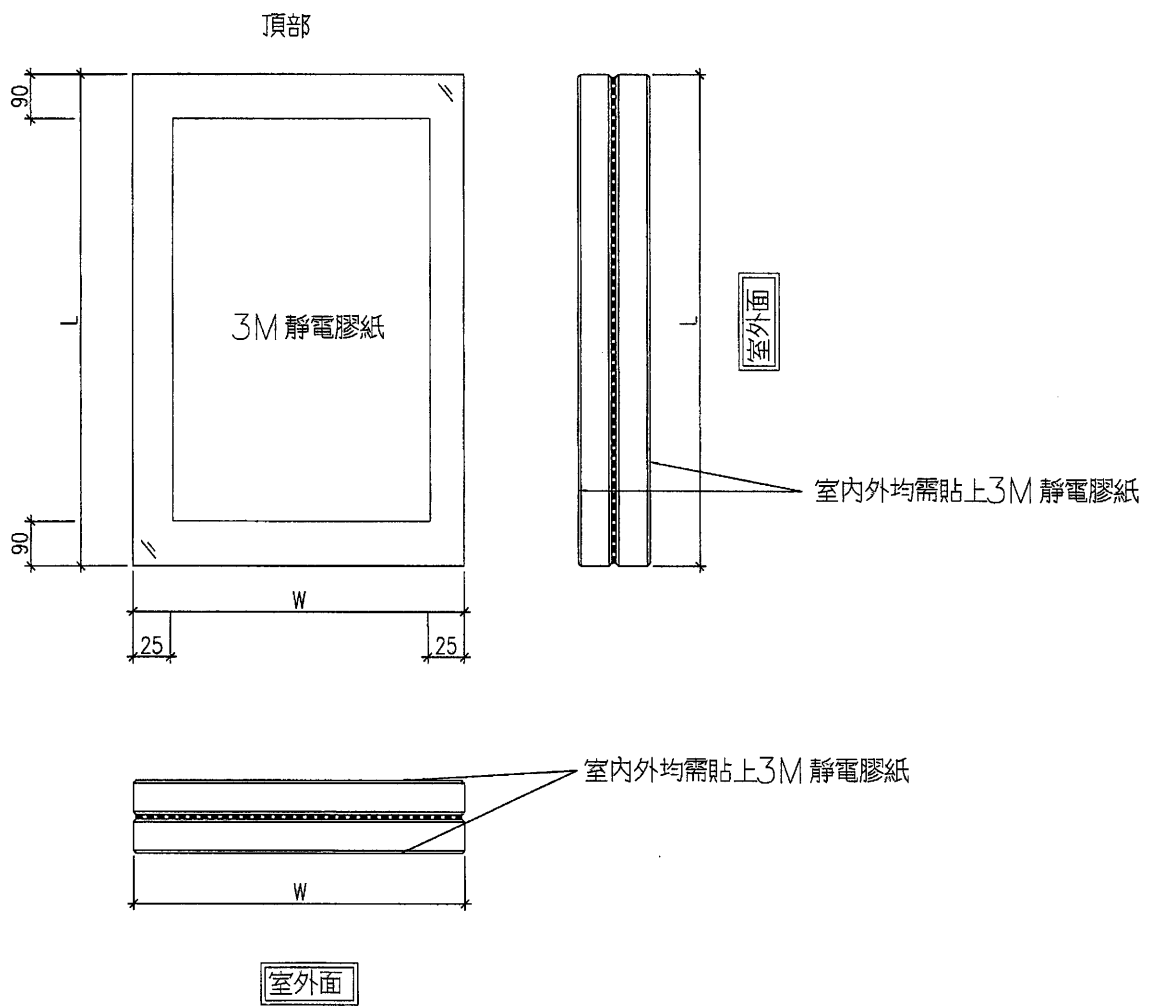


 <b>美特鋁質</b> 有限公司 MIDI Aluminium Fabricator Ltd.		<b>工程號:</b> J-857 <b>地盤名稱:</b> 啟德6552 <b>項目類別:</b> 屋頂玻璃攔河	<b>計算:</b> <b>核對:</b> <b>批准:</b>	<b>HHQ</b>   	<b>日期:</b> <b>日期:</b> <b>日期:</b>	19/10/2022   	<b>送呈:</b> <b>副本:</b>  A/C Code:	<b>施哥</b>
<b>BM編號:</b>		<b>修改版次:</b> C 21/11/2022	<b>總計玻璃面積 (平方米): 507.731</b> <b>此BM依據</b>					
<b>序號</b>	<b>修改內容</b>	<b>玻璃圖號</b>	<b>厚度 (mm)</b>	<b>玻璃尺寸</b> <b>寬度 (mm)</b> <b>高度 (mm)</b>	<b>數量 (塊)</b>	<b>總面積 (平方米)</b>	<b>備注</b>	
1	B放行	GB-1-G10	25.52	1625    1088.0	1	1.768	見加工圖J857-GB-G1 Tower 8	
2	B放行	GB-1-G16	25.52	1490    1088.0	2	3.242	見加工圖J857-GB-G1 Tower 8	
3	B放行	GB-1-G22	25.52	1625    1088.0	1	1.768	見加工圖J857-GB-G1 Tower 8	
4	C放行	GB-1-G23	25.52	1623    1088.0	1	1.766	見加工圖J857-GB-G1 Tower 8	
5	C放行	GB-1-G24	25.52	1333    1088.0	1	1.450	見加工圖J857-GB-G1 Tower 8	
6	B放行	GB-1-G34	25.52	1292    1088.0	1	1.406	見加工圖J857-GB-G1 Tower 8	
7	C放行	GB-1-G35	25.52	1290    1088.0	1	1.404	見加工圖J857-GB-G1 Tower 8	
8	B放行	GB-1-G7	25.52	1370    1088.0	1	1.491	見加工圖J857-GB-G1 Tower 8	
9	C放行	GB-1-G8	25.52	1368    1088.0	1	1.488	見加工圖J857-GB-G1 Tower 8	
10	C放行	GB-1-G9	25.52	1623    1088.0	1	1.766	見加工圖J857-GB-G1 Tower 8	
11	B放行	GB-2-G12	25.52	1490    1088.0	2	3.242	見加工圖J857-GB-G1 Tower 6	
12	B放行	GB-2-G18	25.52	1625    1088.0	1	1.768	見加工圖J857-GB-G1 Tower 6	
13	C放行	GB-2-G19	25.52	1623    1088.0	1	1.766	見加工圖J857-GB-G1 Tower 6	
14	B放行	GB-2-G2	25.52	1419    1088.0	1	1.544	見加工圖J857-GB-G1 Tower 6	
15	B放行	GB-2-G34	25.52	1582    1088.0	1	1.721	見加工圖J857-GB-G1 Tower 6	
16	C放行	GB-2-G5	25.52	958    1088.0	1	1.042	見加工圖J857-GB-G1 Tower 6	
17	C放行	GB-2-G6	25.52	1623    1088.0	1	1.766	見加工圖J857-GB-G1 Tower 6	
18	B放行	GB-2-G7	25.52	1625    1088.0	1	1.768	見加工圖J857-GB-G1 Tower 6	
19	C放行	GB-3-G19	25.52	1623    1088.0	1	1.766	見加工圖J857-GB-G1 Tower 3	
20	B放行	GB-3-G20	25.52	1625    1088.0	1	1.768	見加工圖J857-GB-G1 Tower 3	
21	B放行	GB-3-G26	25.52	1490    1088.0	2	3.242	見加工圖J857-GB-G1 Tower 3	

**G5a - 12mm FT Clear + 1.52**  
**PVB + 12mm FT Clear**  
**Laminated Sample code:**  
**R20210902040**

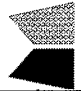
 <b>美特鋁質</b> 有限公司 MIDI Aluminium Fabricator Ltd.		<b>工程號:</b> J-857 <b>地盤名稱:</b> 啟德6552 <b>項目類別:</b> 屋頂玻璃欄河 <b>修改版次:</b> C 21/11/2022	<b>計算:</b> <b>核對:</b> <b>批准:</b>	<b>HHQ</b> <b>日期:</b> <b>日期:</b> <b>日期:</b>	<b>送呈:</b> <b>副本:</b> <b>A/C Code:</b>	<b>19/10/2022</b> <b>施哥</b>			
<b>地盤用玻璃B.M.表</b> <b>BM編號:</b>		<b>總計玻璃面積 (平方米): 507.731</b> <b>此BM依據</b>							
序號	修改內容	玻璃圖號	顏色與類型		玻璃尺寸		數量 (塊)	總面積 (平方米)	備注
			厚度 (mm)	寬度 (mm)	高度 (mm)	面積			
22	B放行	GB-3-G32	25.52	1625	1088.0	1	1.768	見加工圖J857-GB-G1	Tower 3
23	C放行	GB-3-G33	25.52	1623	1088.0	1	1.766	見加工圖J857-GB-G1	Tower 3
24	C放行	GB-3-G34	25.52	958	1088.0	1	1.042	見加工圖J857-GB-G1	Tower 3
25	B放行	GB-3-G37	25.52	1419	1088.0	1	1.544	見加工圖J857-GB-G1	Tower 3
26	B放行	GB-3-G8	25.52	1582	1088.0	1	1.721	見加工圖J857-GB-G1	Tower 3
27	C放行	GB-4-G16	25.52	1321	1088.0	1	1.437	見加工圖J857-GB-G1	Tower 1
28	C放行	GB-4-G17	25.52	1632	1088.0	1	1.776	見加工圖J857-GB-G1	Tower 1
29	B放行	GB-4-G18	25.52	1634	1088.0	1	1.778	見加工圖J857-GB-G1	Tower 1
30	B放行	GB-4-G24	25.52	1090	1088.0	1	1.186	見加工圖J857-GB-G1	Tower 1
31	B放行	GB-4-G38	25.52	1490	1088.0	2	3.242	見加工圖J857-GB-G1	Tower 1
32	C放行	GB-4-G4	25.52	1290	1088.0	1	1.404	見加工圖J857-GB-G1	Tower 1
33	B放行	GB-4-G41	25.52	1392	1088.0	1	1.514	見加工圖J857-GB-G1	Tower 1
34	B放行	GB-4-G5	25.52	1292	1088.0	1	1.406	見加工圖J857-GB-G1	Tower 1
35	B放行	GB-5-G1	25.52	1529	1088.0	1	1.664	見加工圖J857-GB-G1	Tower 1
36	B放行	GB-5-G13	25.52	1615	1088.0	1	1.757	見加工圖J857-GB-G1	Tower 1
37	B放行	GB-5-G4	25.52	1490	1088.0	6	9.727	見加工圖J857-GB-G1	Tower 1
38	B放行	GB-5-G8	25.52	1490	1088.0	4	6.484	見加工圖J857-GB-G1	Tower 1
39	B放行	GB-6-G17	25.52	1490	1088.0	5	8.106	見加工圖J857-GB-G1	Tower 3
40	B放行	GB-6-G4	25.52	1354	1088.0	1	1.473	見加工圖J857-GB-G1	Tower 3
41	B放行	GB-6-G7a	25.52	1073	1088.0	1	1.167	見加工圖J857-GB-G1	Tower 3
42	B放行	GB-7-G11	25.52	1490	1088.0	4	6.484	見加工圖J857-GB-G1	Tower 5

**G5a - 12mm FT Clear + 1.52 PVB + 12mm FT Clear Laminated Sample code: R20210902040**


訂貨單

 <b>美特鋁質</b> 有限公司 MIDI Aluminium Fabricator Ltd.		<b>工程號:</b> J-857 <b>地盤名稱:</b> 啟德6552 <b>項目類別:</b> 屋頂玻璃欄河	<b>計算:</b> <b>核對:</b> <b>批准:</b>	<b>HHQ</b> <b>日期:</b> 19/10/2022 <b>日期:</b> <b>日期:</b>	<b>送呈:</b> <b>副本:</b> <b>A/C Code:</b>	<b>施哥</b>		
<b>BM編號:</b>		<b>修改版次:</b> C 21/11/2022	<b>總計玻璃面積 (平方米): 507.731</b> <b>此BM依據</b>					
序號	修改內容	玻璃圖號	厚度 (mm)	玻璃尺寸		數量 (塊)	總面積 (平方米)	備注
				寬度 (mm)	高度 (mm)			
43	B放行	GB-7-G2	25.52	1490	1088.0	5	8.106	見加工圖J857-GB-G1 Tower 5
44	B放行	GB-7-G7	25.52	1490	1088.0	2	3.242	見加工圖J857-GB-G1 Tower 5
45	B放行	GB-8-G5	25.52	1490	1088.0	10	16.211	見加工圖J857-GB-G1 Tower 6
46	B放行	GB-9-G13	25.52	1490	1088.0	4	6.484	見加工圖J857-GB-G1 Tower 8
47	B放行	GB-9-G17	25.52	1490	1088.0	5	8.106	見加工圖J857-GB-G1 Tower 8
48	B放行	GB-9-G20	25.52	1490	1088.0	2	3.242	見加工圖J857-GB-G1 Tower 8
49	B放行	GB-9-G4	25.52	1354	1088.0	1	1.473	見加工圖J857-GB-G1 Tower 8
50	B放行	GB-9-G8	25.52	1615	1088.0	1	1.757	見加工圖J857-GB-G1 Tower 8
51	C放行	GB-12-G21	25.52	1521	1088.0	1	1.655	見加工圖J857-GB-G1 Tower 8
52	C放行	GB-12-G3	25.52	1088	1088.0	1	1.184	見加工圖J857-GB-G1 Tower 1
53	C放行	GB-12-G8	25.52	1403	1088.0	1	1.526	見加工圖J857-GB-G1 Tower 1
54	C放行	GB-5-G14	25.52	1121	1088.0	1	1.220	見加工圖J857-GB-G1 Tower 1
55	B放行	GB-5-G20	25.52	1595	1088.0	1	1.735	見加工圖J857-GB-G1 Tower 1
56	B放行	GB-5-G24	25.52	1340	1088.0	1	1.458	見加工圖J857-GB-G1 Tower 1
57	B放行	GB-5-G28	25.52	1507	1088.0	1	1.640	見加工圖J857-GB-G1 Tower 1
58	C放行	GB-5-G29	25.52	1505	1088.0	1	1.637	見加工圖J857-GB-G1 Tower 1
59	C放行	GB-6-G18	25.52	1321	1088.0	1	1.437	見加工圖J857-GB-G1 Tower 3
60	B放行	GB-6-G24	25.52	1490	1088.0	2	3.242	見加工圖J857-GB-G1 Tower 3
61	B放行	GB-7-G15	25.52	1490	1088.0	6	9.727	見加工圖J857-GB-G1 Tower 5
62	C放行	GB-7-G16	25.52	1396	1088.0	1	1.519	見加工圖J857-GB-G1 Tower 5
63	C放行	GB-8-G15	25.52	1396	1088.0	1	1.519	見加工圖J857-GB-G1 Tower 6


訂貨單


 <b>美特鋁質</b> 有限公司 MIDI Aluminium Fabricator Ltd.		工程號: J-857 地盤名稱: 啟德6552 項目類別: 屋頂玻璃欄河 修改版次: C 21/11/2022	計算: HHQ 核對: 批准:	日期: 19/10/2022 日期: 日期:	送呈: 副本: A/C Code:	施哥	
<b>地盤用玻璃B.M.表</b>		總計玻璃面積 (平方米): 507.731 此BM依據					
序號	修改內容	玻璃圖號	玻璃尺寸		數量 (塊)	總面積 (平方米)	備注
			厚度 (mm)	高度 (mm)			
64	B放行	GB-8-G16	25.52	1088.0	6	9.727	見加工圖J857-GB-G1 Tower 6
65	C放行	GB-8-G22	25.52	1088.0	1	1.437	見加工圖J857-GB-G1 Tower 6
66	C放行	GB-9-G21	25.52	1497	1	1.629	見加工圖J857-GB-G1 Tower 8
67	B放行	GB-9-G22	25.52	1499	1	1.631	見加工圖J857-GB-G1 Tower 8
68	B放行	GB-9-G26	25.52	1490	4	6.484	見加工圖J857-GB-G1 Tower 8
69	C放行	GB-9-G34	25.52	936	1	1.018	見加工圖J857-GB-G1 Tower 8
70		GB-1-G12	25.52	1200	1	1.306	見加工圖J857-GB-G2 Tower 8
71		GB-1-G15	25.52	1432	1	1.558	見加工圖J857-GB-G2 Tower 8
72		GB-1-G21	25.52	1622	1	1.765	見加工圖J857-GB-G2 Tower 8
73		GB-1-G28	25.52	1275	1	1.387	見加工圖J857-GB-G2 Tower 8
74		GB-1-G33	25.52	1289	1	1.402	見加工圖J857-GB-G2 Tower 8
75		GB-1-G4	25.52	1530	1	1.665	見加工圖J857-GB-G2 Tower 8
76		GB-2-G11a	25.52	1432	1	1.558	見加工圖J857-GB-G2 Tower 6
77		GB-2-G17	25.52	1622	1	1.765	見加工圖J857-GB-G2 Tower 6
78		GB-2-G21	25.52	1175	1	1.278	見加工圖J857-GB-G2 Tower 6
79		GB-2-G30	25.52	1395	1	1.518	見加工圖J857-GB-G2 Tower 6
80		GB-2-G33	25.52	1579	1	1.718	見加工圖J857-GB-G2 Tower 6
81		GB-2-G41	25.52	865	1	0.941	見加工圖J857-GB-G2 Tower 6
82		GB-2-G9	25.52	1200	1	1.306	見加工圖J857-GB-G2 Tower 6
83		GB-3-G18	25.52	1315	1	1.431	見加工圖J857-GB-G2 Tower 3
84		GB-3-G2	25.52	1587	1	1.727	見加工圖J857-GB-G2 Tower 3

訂貨單

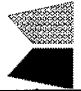
 <b>美特鋁質</b> 有限公司 MIDI Aluminium Fabricator Ltd.		工程號: J-857 地盤名稱: 啟德6552 項目類別: 屋頂玻璃攔河 修改版次: C 21/11/2022	計算: 核對: 批准:	HHQ 日期: 日期:	日期: 19/10/2022 送呈: 副本:	施哥
<b>地盤用玻璃B.M.表</b>		總計玻璃面積 (平方米): 507.731 此BM依據		A/C Code:		
BM編號:	顏色與類型					
序號	修改內容	玻璃圖號	厚度 (mm)	玻璃尺寸 寬度 (mm)    高度 (mm)	數量 (塊)	總面積 (平方米)
85		GB-3-G22	25.52	1200    1088.0	1	1.306
86		GB-3-G25	25.52	1432    1088.0	1	1.558
87		GB-3-G31	25.52	1622    1088.0	1	1.765
88		GB-3-G5	25.52	975    1088.0	1	1.061
89		GB-4-G20	25.52	1070    1088.0	1	1.164
90		GB-4-G23	25.52	1087    1088.0	1	1.183
91		GB-4-G37	25.52	1307    1088.0	1	1.422
92		GB-4-G43	25.52	1205    1088.0	1	1.311
93		GB-4-G47	25.52	1525    1088.0	1	1.659
94		GB-4-G7	25.52	925    1088.0	1	1.006
95		GB-5-G12	25.52	1612    1088.0	1	1.754
96		GB-5-G3	25.52	1475    1088.0	1	1.605
97		GB-5-G7	25.52	1550    1088.0	1	1.686
98		GB-6-G12	25.52	1495    1088.0	1	1.627
99		GB-6-G14	25.52	1437    1088.0	1	1.563
100		GB-6-G3	25.52	1351    1088.0	1	1.470
101		GB-7-G10	25.52	1482    1088.0	1	1.612
102		GB-7-G6	25.52	1150    1088.0	1	1.251
103		GB-8-G2	25.52	1112    1088.0	1	1.210
104		GB-8-G14	25.52	1612    1088.0	1	1.754
105		GB-8-G9	25.52	1495    1088.0	1	1.627

**G5a - 12mm FT Clear + 1.52 PVB + 12mm FT Clear Laminated Sample code: R20210902040**


 <b>美特鋁質</b> 有限公司 MIDI Aluminium Fabricator Ltd.		工程號:	J-857	計算:	HHQ	日期:	19/10/2022	送呈:	施哥	
<b>地盘名稱:</b> 啟德6552		地盤名稱:		核對:		日期:		副本:		
<b>項目類別:</b> 屋頂玻璃栏河		項目類別:		批准:		日期:		A/C Code:		
<b>修改版次:</b> C 21/11/2022		修改版次:		總計玻璃面積 (平方米): 507.731		此BM依據				
序號	修改內容	玻璃圖號	顏色與類型	厚度 (mm)	玻璃尺寸		數量 (塊)	總面積 (平方米)	備注	
					寬度 (mm)	高度 (mm)				
106		GB-9-G10	<b>G5a - 12mm FT Clear + 1.52 PVB + 12mm FT Clear Laminated Sample code: R20210902040</b>	25.52	1095	1088.0	1	1.191	見加工圖J857-GB-G2 Tower 8	
107		GB-9-G16		25.52	1107	1088.0	1	1.204	見加工圖J857-GB-G2 Tower 8	
108		GB-9-G19		25.52	1612	1088.0	1	1.754	見加工圖J857-GB-G2 Tower 8	
109		GB-9-G3		25.52	1351	1088.0	1	1.470	見加工圖J857-GB-G2 Tower 8	
110		GB-12-G14	<b>G5a - 12mm FT Low Iron + 1.52PVB+12mm FT Low Iron Laminated (超白) - Sample code: R20220927005</b>	25.52	1665	1088.0	1	1.812	見加工圖J857-GB-G2 Tower 1	
111		GB-12-G18		25.52	341	1088.0	1	0.371	見加工圖J857-GB-G2 Tower 3	
112		GB-12-G2		25.52	1087	1088.0	1	1.183	見加工圖J857-GB-G2 Tower 1	
113		GB-12-G20		25.52	1520	1088.0	1	1.654	見加工圖J857-GB-G2 Tower 8	
114		GB-12-G25		25.52	715	1088.0	1	0.778	見加工圖J857-GB-G2 Tower 6	
115		GB-12-G27		25.52	565	1088.0	1	0.615	見加工圖J857-GB-G2 Tower 8	
116		GB-5-G16	<b>G5a - 12mm FT Clear + 1.52 PVB + 12mm FT Clear Laminated Sample code: R20210902040</b>	25.52	1250	1088.0	1	1.360	見加工圖J857-GB-G2 Tower 1	
117		GB-5-G19		25.52	1592	1088.0	1	1.732	見加工圖J857-GB-G2 Tower 1	
118		GB-6-G23		25.52	1395	1088.0	1	1.518	見加工圖J857-GB-G2 Tower 3	
119		GB-8-G21		25.52	1320	1088.0	1	1.436	見加工圖J857-GB-G2 Tower 6	
120		GB-9-G25		25.52	1357	1088.0	1	1.476	見加工圖J857-GB-G2 Tower 8	
121		GB-9-G31		25.52	1445	1088.0	1	1.572	見加工圖J857-GB-G2 Tower 8	
122		GB-9-G33		25.52	935	1088.0	1	1.017	見加工圖J857-GB-G2 Tower 8	
123		GB-1-G1		<b>G5a - 12mm FT Clear + 1.52 PVB + 12mm FT Clear Laminated Sample code: R20210902040</b>	25.52	1632	1088.0	1	1.776	見加工圖J857-GB-G3 Tower 8
124		GB-1-G11			25.52	1622	1088.0	1	1.765	見加工圖J857-GB-G3 Tower 8
125		GB-1-G17			25.52	1432	1088.0	1	1.558	見加工圖J857-GB-G3 Tower 8
126		GB-1-G20	25.52		1200	1088.0	1	1.306	見加工圖J857-GB-G3 Tower 8	

 <b>美特鋁質</b> 有限公司 MIDI Aluminium Fabricator Ltd.		工程號:	J-857	計算:	HHQ	日期:	19/10/2022	送呈:	施哥		
<b>地盘用玻璃B.M.表</b>		地盘名稱:	啟德6552	核對:		日期:		副本:			
		項目類別:	屋頂玻璃栏河	批准:		日期:		A/C Code:			
BM編號:		修改版次:	C 21/11/2022	總計玻璃面積 (平方米): 507.731						此BM依據	
序號	修改內容	玻璃圖號	顏色與類型	厚度 (mm)	玻璃尺寸		數量 (塊)	總面積 (平方米)	備注		
					寬度 (mm)	高度 (mm)					
127		GB-1-G27	<b>G5a - 12mm FT Clear + 1.52 PVB + 12mm FT Clear Laminated Sample code: R20210902040</b>	25.52	1225	1088.0	1	1.333	見加工圖J857-GB-G3	Tower 8	
128		GB-1-G32		25.52	925	1088.0	1	1.006	見加工圖J857-GB-G3	Tower 8	
129		GB-2-G13		25.52	1432	1088.0	1	1.558	見加工圖J857-GB-G3	Tower 6	
130		GB-2-G16		25.52	1200	1088.0	1	1.306	見加工圖J857-GB-G3	Tower 6	
131		GB-2-G20		25.52	1315	1088.0	1	1.431	見加工圖J857-GB-G3	Tower 6	
132		GB-2-G37		25.52	975	1088.0	1	1.061	見加工圖J857-GB-G3	Tower 6	
133		GB-2-G40		25.52	1587	1088.0	1	1.727	見加工圖J857-GB-G3	Tower 6	
134		GB-2-G8		25.52	1622	1088.0	1	1.765	見加工圖J857-GB-G3	Tower 6	
135		GB-3-G1		25.52	1290	1088.0	1	1.404	見加工圖J857-GB-G3	Tower 3	
136		GB-3-G12		25.52	1395	1088.0	1	1.518	見加工圖J857-GB-G3	Tower 3	
137		GB-3-G17		25.52	1175	1088.0	1	1.278	見加工圖J857-GB-G3	Tower 3	
138		GB-3-G21		25.52	1622	1088.0	1	1.765	見加工圖J857-GB-G3	Tower 3	
139		GB-3-G27		25.52	1432	1088.0	1	1.558	見加工圖J857-GB-G3	Tower 3	
140		GB-3-G30		25.52	1200	1088.0	1	1.306	見加工圖J857-GB-G3	Tower 3	
141		GB-3-G9		25.52	1579	1088.0	1	1.718	見加工圖J857-GB-G3	Tower 3	
142		GB-4-G11		25.52	1312	1088.0	1	1.427	見加工圖J857-GB-G3	Tower 1	
143		GB-4-G19		25.52	1631	1088.0	1	1.775	見加工圖J857-GB-G3	Tower 1	
144		GB-4-G25	25.52	1087	1088.0	1	1.183	見加工圖J857-GB-G3	Tower 1		
145		GB-4-G28	25.52	950	1088.0	1	1.034	見加工圖J857-GB-G3	Tower 1		
146		GB-4-G36	25.52	1340	1088.0	1	1.458	見加工圖J857-GB-G3	Tower 1		
147		GB-4-G38a	25.52	1307	1088.0	1	1.422	見加工圖J857-GB-G3	Tower 1		


訂貨 Bm

 <b>美特鋁質</b> 有限公司 MIDI Aluminium Fabricator Ltd.		工程號:	J-857	計算:	HHQ	日期:	19/10/2022	送呈:	施哥		
<b>地盘用玻璃B.M.表</b>		地盘名稱:	啟德6552 <th>核對:</th> <td></td> <th>日期:</th> <td></td> <th>副本:</th> <td></td>	核對:		日期:		副本:			
		項目類別:	屋頂玻璃栏河 <th>批准:</th> <td></td> <th>日期:</th> <td></td> <th>A/C Code:</th> <td></td>	批准:		日期:		A/C Code:			
BM編號:		修改版次:	C 21/11/2022 <th colspan="6">總計玻璃面積 (平方米): 507.731</th> <th colspan="2">此BM依據</th>	總計玻璃面積 (平方米): 507.731						此BM依據	
序號	修改內容	玻璃圖號	顏色與類型	厚度 (mm)	玻璃尺寸 寬度 (mm) 高度 (mm)	數量 (塊)	總面積 (平方米)	備注			
148		GB-4-G42	<b>G5a - 12mm FT Clear + 1.52 PVB +12mm FT Clear Laminated Sample code: R20210902040</b>	25.52	1389 1088.0	1	1.511	見加工圖J857-GB-G3	Tower 1		
149		GB-4-G46		25.52	987 1088.0	1	1.074	見加工圖J857-GB-G3	Tower 1		
150		GB-4-G6		25.52	1289 1088.0	1	1.402	見加工圖J857-GB-G3	Tower 1		
151		GB-5-G2		25.52	1526 1088.0	1	1.660	見加工圖J857-GB-G3	Tower 1		
152		GB-5-G11		25.52	922 1088.0	1	1.003	見加工圖J857-GB-G3	Tower 1		
153		GB-6-G13		25.52	1494 1088.0	1	1.625	見加工圖J857-GB-G3	Tower 3		
154		GB-6-G5		25.52	1351 1088.0	1	1.470	見加工圖J857-GB-G3	Tower 3		
155		GB-6-G8		25.52	1070 1088.0	1	1.164	見加工圖J857-GB-G3	Tower 3		
156		GB-7-G12		25.52	1482 1088.0	1	1.612	見加工圖J857-GB-G3	Tower 5		
157		GB-7-G5		25.52	1112 1088.0	1	1.210	見加工圖J857-GB-G3	Tower 5		
158		GB-8-G1		25.52	1150 1088.0	1	1.251	見加工圖J857-GB-G3	Tower 6		
159		GB-8-G10		25.52	1495 1088.0	1	1.627	見加工圖J857-GB-G3	Tower 6		
160		GB-8-G8		25.52	1437 1088.0	1	1.563	見加工圖J857-GB-G3	Tower 6		
161		GB-9-G18		25.52	1107 1088.0	1	1.204	見加工圖J857-GB-G3	Tower 8		
162		GB-9-G5		25.52	1351 1088.0	1	1.470	見加工圖J857-GB-G3	Tower 8		
163		GB-9-G9		25.52	1612 1088.0	1	1.754	見加工圖J857-GB-G3	Tower 8		
164		GB-12-G1		25.52	890 1088.0	1	0.968	見加工圖J857-GB-G3	Tower 1		
165		GB-12-G13	25.52	465 1088.0	1	0.506	見加工圖J857-GB-G3	Tower 1			
166		GB-12-G15	<b>G5a -12mm FT Low Iron +1.52PVB+12mm FT Low Iron Laminated (超白) - Sample code: R20220927005</b>	25.52	715 1088.0	1	0.778	見加工圖J857-GB-G3	Tower 3		
167		GB-12-G19		25.52	1565 1088.0	1	1.703	見加工圖J857-GB-G3	Tower 8		
168		GB-12-G22		25.52	341 1088.0	1	0.371	見加工圖J857-GB-G3	Tower 6		
169		GB-12-G26		25.52	1690 1088.0	1	1.839	見加工圖J857-GB-G3	Tower 8		
170		GB-12-G9		25.52	1402 1088.0	1	1.525	見加工圖J857-GB-G3	Tower 1		


訂貨單

 <b>美特鋁質</b> 有限公司 MIDI Aluminium Fabricator Ltd.		工程號:	J-857	計算:	HHQ	日期:	19/10/2022	送呈:	施哥		
<b>地盤名稱:</b> 啟德6552		地盤名稱:	啟德6552	核對:		日期:		副本:			
<b>項目類別:</b> 屋頂玻璃攔河		項目類別:	屋頂玻璃攔河	批准:		日期:		A/C Code:			
<b>修改版次:</b> C 21/11/2022		修改版次:	C 21/11/2022	總計玻璃面積 (平方米): 507.731						此BM依據	
序號	修改內容	玻璃圖號	顏色與類型	厚度 (mm)	玻璃尺寸		數量 (塊)	總面積 (平方米)	備注		
					寬度 (mm)	高度 (mm)					
171		GB-5-G15	<b>G5a - 12mm FT Low Iron +1.52PVB+12mm FT Low Iron Laminated (超白) - Sample code: R20220927005</b>	25.52	1120	1088.0	1	1.219	見加工圖J857-GB-G3	Tower 1	
172		GB-5-G21		25.52	1592	1088.0	1	1.732	見加工圖J857-GB-G3	Tower 1	
173		GB-5-G25		25.52	1337	1088.0	1	1.455	見加工圖J857-GB-G3	Tower 1	
174		GB-6-G19		25.52	1320	1088.0	1	1.436	見加工圖J857-GB-G3	Tower 3	
175		GB-8-G17		25.52	1395	1088.0	1	1.518	見加工圖J857-GB-G3	Tower 6	
176		GB-9-G27		25.52	1357	1088.0	1	1.476	見加工圖J857-GB-G3	Tower 8	
177		GB-9-G32		25.52	1445	1088.0	1	1.572	見加工圖J857-GB-G3	Tower 8	
178		GB-1-G14		25.52	185	1088.0	1	0.201	見加工圖J857-GB-G4	Tower 8	
179		GB-1-G3		25.52	385	1088.0	1	0.419	見加工圖J857-GB-G4	Tower 8	
180		GB-2-G11		25.52	185	1088.0	1	0.201	見加工圖J857-GB-G4	Tower 6	
181		GB-2-G23		25.52	785	1088.0	1	0.854	見加工圖J857-GB-G4	Tower 6	
182		GB-2-G29		25.52	960	1088.0	1	1.044	見加工圖J857-GB-G4	Tower 6	
183		GB-2-G32		25.52	485	1088.0	1	0.528	見加工圖J857-GB-G4	Tower 6	
184		GB-3-G24		<b>G5a - 12mm FT Clear + 1.52 PVB + 12mm FT Clear Laminated Sample code: R20210902040</b>	25.52	185	1088.0	1	0.201	見加工圖J857-GB-G4	Tower 3
185		GB-3-G4			25.52	535	1088.0	1	0.582	見加工圖J857-GB-G4	Tower 3
186		GB-3-G40			25.52	135	1088.0	1	0.147	見加工圖J857-GB-G4	Tower 3
187		GB-4-G13			25.52	135	1088.0	1	0.147	見加工圖J857-GB-G4	Tower 1
188		GB-4-G22	25.52		185	1088.0	1	0.201	見加工圖J857-GB-G4	Tower 1	
189		GB-4-G30	25.52		185	1088.0	1	0.201	見加工圖J857-GB-G4	Tower 1	
190		GB-5-G6	25.52		340	1088.0	1	0.370	見加工圖J857-GB-G4	Tower 1	
191		GB-6-G2	25.52		185	1088.0	1	0.201	見加工圖J857-GB-G4	Tower 3	
192		GB-6-G11	25.52		1485	1088.0	1	1.616	見加工圖J857-GB-G4	Tower 3	

1/16/2022

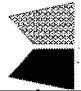 <b>美特鋁質</b> 有限公司 MIDI Aluminium Fabricator Ltd.		工程號:	J-857	計算:	HHQ	日期:	19/10/2022	送呈:	施哥
<b>地盘用玻璃B.M.表</b>		地盘名稱:	啟德6552	核對:		日期:		副本:	
		項目類別:	屋頂玻璃栏河	批准:		日期:		A/C Code:	
BM編號:		修改版次:	C 21/11/2022	總計玻璃面積 (平方米):		507.731	此BM依據		
序號	修改內容	玻璃圖號	顏色與類型	厚度 (mm)	玻璃尺寸 寬度 (mm) 高度 (mm)	數量 (塊)	總面積 (平方米)	備注	
193		GB-7-G9	<b>G5a - 12mm FT Clear + 1.52 PVB + 12mm FT Clear Laminated Sample code: R20210902040</b>	25.52	185 1088.0	1	0.201	見加工圖J857-GB-G4	Tower 5
194		GB-8-G13		25.52	185 1088.0	1	0.201	見加工圖J857-GB-G4	Tower 6
195		GB-9-G15		25.52	710 1088.0	1	0.772	見加工圖J857-GB-G4	Tower 8
196		GB-9-G2		25.52	485 1088.0	1	0.528	見加工圖J857-GB-G4	Tower 8
197		GB-12-G17	<b>G5a - 12mm FT Low Iron + 1.52PVB+12mm FT Low Iron Laminated (超白) - Sample code: R20220927005</b>	25.52	1160 1088.0	1	1.262	見加工圖J857-GB-G4	Tower 3
198		GB-12-G24		25.52	960 1088.0	1	1.044	見加工圖J857-GB-G4	Tower 6
199		GB-5-G18		25.52	185 1088.0	1	0.201	見加工圖J857-GB-G4	Tower 1
200		GB-6-G22		25.52	185 1088.0	1	0.201	見加工圖J857-GB-G4	Tower 3
201		GB-8-G20		25.52	1235 1088.0	1	1.344	見加工圖J857-GB-G4	Tower 6
202		GB-9-G24		25.52	185 1088.0	1	0.201	見加工圖J857-GB-G4	Tower 8
203		GB-9-G30	<b>G5a - 12mm FT Clear + 1.52 PVB + 12mm FT Clear Laminated Sample code: R20210902040</b>	25.52	610 1088.0	1	0.664	見加工圖J857-GB-G4	Tower 8
204		GB-1-G18		25.52	185 1088.0	1	0.201	見加工圖J857-GB-G5	Tower 8
205		GB-1-G2		25.52	775 1088.0	1	0.843	見加工圖J857-GB-G5	Tower 8
206		GB-2-G14		25.52	185 1088.0	1	0.201	見加工圖J857-GB-G5	Tower 6
207		GB-2-G25		25.52	135 1088.0	1	0.147	見加工圖J857-GB-G5	Tower 6
208		GB-2-G38		25.52	535 1088.0	1	0.582	見加工圖J857-GB-G5	Tower 6
209		GB-3-G10		25.52	485 1088.0	1	0.528	見加工圖J857-GB-G5	Tower 3


訂貨單

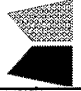
 <b>美特鋁質</b> 有限公司 MIDI Aluminium Fabricator Ltd.		工程號: J-857	計算:	HHQ	日期:	19/10/2022	送呈:	施哥	
		地盤名稱: 啟德6552	核對:		日期:		副本:		
<b>地盤用玻璃B.M.表</b>		項目類別: 屋頂玻璃攔河	批准:		日期:		A/C Code:		
		修改版次: C 21/11/2022	總計玻璃面積 (平方米): 507.731	此BM依據					
序號	修改內容	玻璃圖號	顏色與類型	厚度 (mm)	玻璃尺寸		數量 (塊)	總面積 (平方米)	備注
210		GB-3-G13	<b>G5a - 12mm FT Clear + 1.52 PVB + 12mm FT Clear Laminated Sample code: R20210902040</b>	25.52	寬度 (mm)	高度 (mm)	1	1.044	見加工圖J857-GB-G5
211		GB-3-G28		25.52	960	1088.0	1	0.201	見加工圖J857-GB-G5
212		GB-3-G42		25.52	185	1088.0	1	0.854	見加工圖J857-GB-G5
213		GB-4-G12		25.52	785	1088.0	1	1.881	見加工圖J857-GB-G5
214		GB-4-G14		25.52	1729	1088.0	1	1.051	見加工圖J857-GB-G5
215		GB-4-G26		25.52	966	1088.0	1	0.201	見加工圖J857-GB-G5
216		GB-4-G29		25.52	185	1088.0	1	1.289	見加工圖J857-GB-G5
217		GB-4-G31		25.52	1185	1088.0	1	0.500	見加工圖J857-GB-G5
218		GB-4-G38b		25.52	460	1088.0	1	0.234	見加工圖J857-GB-G5
219		GB-6-G6		25.52	215	1088.0	1	0.528	見加工圖J857-GB-G5
220		GB-6-G9		25.52	485	1088.0	1	0.201	見加工圖J857-GB-G5
221		GB-7-G13		25.52	185	1088.0	1	0.201	見加工圖J857-GB-G5
222		GB-8-G11		25.52	185	1088.0	1	1.616	見加工圖J857-GB-G5
223		GB-9-G6		25.52	1485	1088.0	1	0.201	見加工圖J857-GB-G5
224		GB-12-G11		25.52	185	1088.0	1	0.990	見加工圖J857-GB-G5
225		GB-12-G16		25.52	910	1088.0	1	1.044	見加工圖J857-GB-G5
226		GB-12-G23		25.52	960	1088.0	1	1.262	見加工圖J857-GB-G5
227		GB-5-G22		25.52	1160	1088.0	1	0.364	見加工圖J857-GB-G5
228		GB-5-G26		25.52	335	1088.0	1	0.201	見加工圖J857-GB-G5
229		GB-6-G20		25.52	185	1088.0	1	1.344	見加工圖J857-GB-G5
230		GB-8-G18		25.52	1235	1088.0	1	0.201	見加工圖J857-GB-G5
231		GB-9-G28		25.52	185	1088.0	1	0.201	見加工圖J857-GB-G5
232		GB-12-G10		25.52	185	1088.0	1	1.016	見加工圖J857-GB-G6

訂覽 Bc

美特鋁質有限公司 MIDI Aluminium Fabricator Ltd.		工程號: 地盤名稱:	J-857 啟德6552	計算: 核對:	HHQ	日期:	19/10/2022	送呈: 副本:	施哥
地盤用玻璃B.M.表		項目類別:	屋頂玻璃拦河	批准:		日期:		A/C Code:	
BM編號:	修改版次:		C 21/11/2022	總計玻璃面積 (平方米):		507.731	此BM依據		
序號	修改內容	玻璃圖號	顏色與類型	厚度 (mm)	玻璃尺寸 寬度 (mm) 高度 (mm)	數量 (塊)	總面積 (平方米)	備注	
233		GB-2-G24	G5a - 12mm FT Clear + 1.52 PVB + 12mm FT Clear Laminated Sample code: R20210902040	25.52	934 1088.0	1	1.016	見加工圖J857-GB-G6	Tower 6
234		GB-3-G41		25.52	1334 1088.0	1	1.451	見加工圖J857-GB-G6	Tower 3
235		GB-1-G30		25.52	1545 1088.0	1	1.681	見加工圖J857-GB-G7	Tower 8
236		GB-2-G26		25.52	1310 1088.0	1	1.425	見加工圖J857-GB-G7	Tower 6
237		GB-2-G28		25.52	1330 1088.0	1	1.447	見加工圖J857-GB-G7	Tower 6
238		GB-3-G14		25.52	1330 1088.0	1	1.447	見加工圖J857-GB-G7	Tower 3
239		GB-3-G39		25.52	1310 1088.0	1	1.425	見加工圖J857-GB-G7	Tower 3
240		GB-4-G9		25.52	1570 1088.0	1	1.708	見加工圖J857-GB-G7	Tower 1
241		GB-1-G19		25.52	1225 1088.0	1	1.333	見加工圖J857-GB-G8	Tower 8
242		GB-1-G26		25.52	1249 1088.0	1	1.359	見加工圖J857-GB-G8	Tower 8
243		GB-1-G31		25.52	950 1088.0	1	1.034	見加工圖J857-GB-G8	Tower 8
244		GB-1-G6		25.52	1392 1088.0	1	1.514	見加工圖J857-GB-G8	Tower 8
245		GB-2-G1		25.52	1441 1088.0	1	1.568	見加工圖J857-GB-G8	Tower 6
246		GB-2-G15		25.52	1225 1088.0	1	1.333	見加工圖J857-GB-G8	Tower 6
247		GB-2-G36		25.52	1000 1088.0	1	1.088	見加工圖J857-GB-G8	Tower 6
248		GB-2-G39	25.52	1612 1088.0	1	1.754	見加工圖J857-GB-G8	Tower 6	
249		GB-2-G4	25.52	982 1088.0	1	1.068	見加工圖J857-GB-G8	Tower 6	
250		GB-3-G11	25.52	1420 1088.0	1	1.545	見加工圖J857-GB-G8	Tower 3	
251		GB-3-G15	25.52	1750 1088.0	1	1.904	見加工圖J857-GB-G8	Tower 3	
252		GB-3-G16	25.52	1200 1088.0	1	1.306	見加工圖J857-GB-G8	Tower 3	
253		GB-3-G29	25.52	1225 1088.0	1	1.333	見加工圖J857-GB-G8	Tower 3	
254		GB-3-G36	25.52	1441 1088.0	1	1.568	見加工圖J857-GB-G8	Tower 3	
255		GB-3-G7	25.52	1604 1088.0	1	1.745	見加工圖J857-GB-G8	Tower 3	


新貨

 <b>美特鋁質</b> 有限公司 MIDI Aluminium Fabricator Ltd.		工程號:	J-857	計算:	HHQ	日期:	19/10/2022	送呈:	施哥	
<b>地盘用玻璃B.M.表</b>		地盘名稱:	啟德6552	核對:		日期:		副本:		
		項目類別:	屋頂玻璃栏河	批准:		日期:		A/C Code:		
BM編號:		修改版次:	C 21/11/2022	總計玻璃面積 (平方米):		507.731	此BM依據			
序號	修改內容	玻璃圖號	顏色與類型	厚度 (mm)	玻璃尺寸		數量 (塊)	總面積 (平方米)	備注	
					寬度 (mm)	高度 (mm)				
256		GB-4-G10	<b>G5a - 12mm FT Clear + 1.52 PVB +12mm FT Clear Laminated Sample code: R20210902040</b>	25.52	1337	1088.0	1	1.455	見加工圖J857-GB-G8 Tower 1	
257		GB-4-G15		25.52	1345	1088.0	1	1.463	見加工圖J857-GB-G8 Tower 1	
258		GB-4-G27		25.52	975	1088.0	1	1.061	見加工圖J857-GB-G8 Tower 1	
259		GB-4-G38c		25.52	975	1088.0	1	1.061	見加工圖J857-GB-G8 Tower 1	
260		GB-4-G40		25.52	1414	1088.0	1	1.538	見加工圖J857-GB-G8 Tower 1	
261		GB-4-G45		25.52	1012	1088.0	1	1.101	見加工圖J857-GB-G8 Tower 1	
262		GB-5-G10		25.52	947	1088.0	1	1.030	見加工圖J857-GB-G8 Tower 1	
263		GB-6-G10		25.52	942	1088.0	1	1.025	見加工圖J857-GB-G8 Tower 3	
264		GB-6-G16		25.52	1517	1088.0	1	1.650	見加工圖J857-GB-G8 Tower 3	
265		GB-6-G7		25.52	1096	1088.0	1	1.192	見加工圖J857-GB-G8 Tower 3	
266		GB-7-G14		25.52	1175	1088.0	1	1.278	見加工圖J857-GB-G8 Tower 5	
267		GB-7-G4		25.52	1137	1088.0	1	1.237	見加工圖J857-GB-G8 Tower 5	
268		GB-8-G4		25.52	1542	1088.0	1	1.678	見加工圖J857-GB-G8 Tower 6	
269		GB-8-G7		25.52	1462	1088.0	1	1.591	見加工圖J857-GB-G8 Tower 6	
270		GB-9-G12		25.52	1267	1088.0	1	1.378	見加工圖J857-GB-G8 Tower 8	
271		GB-9-G7		25.52	1637	1088.0	1	1.781	見加工圖J857-GB-G8 Tower 8	
272		GB-12-G12		25.52	1000	1088.0	1	1.088	見加工圖J857-GB-G8 Tower 1	
273		GB-5-G23		<b>G5a -12mm FT Low Iron +1.52PVB+12mm FT Low Iron Laminated (超白) - Sample code: R20220927005</b>	25.52	1362	1088.0	1	1.482	見加工圖J857-GB-G8 Tower 1
274		GB-5-G27			25.52	1529	1088.0	1	1.664	見加工圖J857-GB-G8 Tower 1
275		GB-6-G21			25.52	942	1088.0	1	1.025	見加工圖J857-GB-G8 Tower 3
276		GB-8-G19			25.52	942	1088.0	1	1.025	見加工圖J857-GB-G8 Tower 6
277		GB-9-G29			25.52	942	1088.0	1	1.025	見加工圖J857-GB-G8 Tower 8


 <b>美特鋁質</b> 有限公司 MIDI Aluminium Fabricator Ltd.		工程號:	J-857	計算:	HHQ	日期:	19/10/2022	送呈:	施哥		
		地盤名稱:	啟德6552	核對:		日期:		副本:			
		項目類別:	屋頂玻璃栏河	批准:		日期:		A/C Code:			
		修改版次:	C 21/11/2022	總計玻璃面積 (平方米): 507.731						此BM依據	
序號	修改內容	玻璃圖號	顏色與類型	厚度 (mm)	玻璃尺寸		數量 (塊)	總面積 (平方米)	備注		
					寬度 (mm)	高度 (mm)					
278		GB-1-G13		25.52	1225	1088.0	1	1.333	見加工圖J857-GB-G9	Tower 8	
279		GB-1-G25		25.52	1357	1088.0	1	1.476	見加工圖J857-GB-G9	Tower 8	
280		GB-1-G29		25.52	1300	1088.0	1	1.414	見加工圖J857-GB-G9	Tower 8	
281		GB-1-G5		25.52	1555	1088.0	1	1.692	見加工圖J857-GB-G9	Tower 8	
282		GB-2-G10		25.52	1225	1088.0	1	1.333	見加工圖J857-GB-G9	Tower 6	
283		GB-2-G22		25.52	1200	1088.0	1	1.306	見加工圖J857-GB-G9	Tower 6	
284		GB-2-G27		25.52	1750	1088.0	1	1.904	見加工圖J857-GB-G9	Tower 6	
285		GB-2-G3		25.52	1441	1088.0	1	1.568	見加工圖J857-GB-G9	Tower 6	
286		GB-2-G31		25.52	1420	1088.0	1	1.545	見加工圖J857-GB-G9	Tower 6	
287		GB-2-G35		25.52	1604	1088.0	1	1.745	見加工圖J857-GB-G9	Tower 6	
288		GB-3-G23		25.52	1225	1088.0	1	1.333	見加工圖J857-GB-G9	Tower 3	
289		GB-3-G3		25.52	1612	1088.0	1	1.754	見加工圖J857-GB-G9	Tower 3	
290		GB-3-G35		25.52	982	1088.0	1	1.068	見加工圖J857-GB-G9	Tower 3	
291		GB-3-G38		25.52	1441	1088.0	1	1.568	見加工圖J857-GB-G9	Tower 3	
292		GB-3-G6		25.52	1000	1088.0	1	1.088	見加工圖J857-GB-G9	Tower 3	
293		GB-4-G21		25.52	1095	1088.0	1	1.191	見加工圖J857-GB-G9	Tower 1	
294		GB-4-G39		25.52	975	1088.0	1	1.061	見加工圖J857-GB-G9	Tower 1	
295		GB-4-G44		25.52	1230	1088.0	1	1.338	見加工圖J857-GB-G9	Tower 1	
296		GB-4-G8		25.52	950	1088.0	1	1.034	見加工圖J857-GB-G9	Tower 1	
297		GB-5-G5		25.52	1500	1088.0	1	1.632	見加工圖J857-GB-G9	Tower 1	
298		GB-5-G9		25.52	1575	1088.0	1	1.714	見加工圖J857-GB-G9	Tower 1	
299		GB-6-G1		25.52	1637	1088.0	1	1.781	見加工圖J857-GB-G9	Tower 3	
300		GB-6-G10a		25.52	942	1088.0	1	1.025	見加工圖J857-GB-G9	Tower 3	

**G5a - 12mm FT Clear + 1.52  
PVB + 12mm FT Clear  
Laminated Sample code:  
R20210902040**

美特鋁質有限公司 MIDI Aluminium Fabricator Ltd.		工程號: 地盤名稱:	J-857 啟德6552	計算:	HHQ	日期:	19/10/2022	送呈:	施哥
地盤用玻璃B.M.表		項目類別:	屋頂玻璃拦河	核對:		日期:		副本:	
BM編號:		修改版次:	C 21/11/2022	批准:		日期:		A/C Code:	
序號	修改內容	玻璃圖號	顏色與類型	厚度 (mm)	玻璃尺寸 寬度 (mm) 高度 (mm)	數量 (塊)	總面積 (平方米)	備注	
				總計玻璃面積 (平方米): 507.731					
301		GB-6-G15	G5a - 12mm FT Clear + 1.52 PVB +12mm FT Clear Laminated Sample code: R20210902040	25.52	1462 1088.0	1	1.591	見加工圖J857-GB-G9	Tower 3
302		GB-7-G3		25.52	1517 1088.0	1	1.650	見加工圖J857-GB-G9	Tower 5
303		GB-7-G8		25.52	1175 1088.0	1	1.278	見加工圖J857-GB-G9	Tower 5
304		GB-8-G12a		25.52	942 1088.0	1	1.025	見加工圖J857-GB-G9	Tower 6
305		GB-8-G3		25.52	1137 1088.0	1	1.237	見加工圖J857-GB-G9	Tower 6
306		GB-8-G6		25.52	1542 1088.0	1	1.678	見加工圖J857-GB-G9	Tower 6
307		GB-9-G1		25.52	1637 1088.0	1	1.781	見加工圖J857-GB-G9	Tower 8
308		GB-9-G11		25.52	1120 1088.0	1	1.219	見加工圖J857-GB-G9	Tower 8
309		GB-9-G14		25.52	1267 1088.0	1	1.378	見加工圖J857-GB-G9	Tower 8
310		GB-5-G17		25.52	1275 1088.0	1	1.387	見加工圖J857-GB-G9	Tower 1
311		GB-6-G21a	G5a - 12mm FT Low Iron +1.52PVB+12mm FT Low Iron Laminated (超白) - Sample code: R20220927005	25.52	942 1088.0	1	1.025	見加工圖J857-GB-G9	Tower 3
312		GB-8-G19a		25.52	942 1088.0	1	1.025	見加工圖J857-GB-G9	Tower 6
313		GB-9-G23		25.52	1521 1088.0	1	1.655	見加工圖J857-GB-G9	Tower 8
314		GB-9-G29a		25.52	942 1088.0	1	1.025	見加工圖J857-GB-G9	Tower 8
315		GB-4-G32	G5a - 12mm FT Clear + 1.52 PVB +12mm FT Clear Laminated Sample code: R20210902040	25.52	823 1088.0	1	0.895	見加工圖GB-4-G32	Tower 1
316		GB-4-G33		25.52	1062 1088.0	1	1.155	見加工圖GB-4-G33	Tower 1
317		GB-4-G34		25.52	1062 1088.0	1	1.155	見加工圖GB-4-G34	Tower 1
318		GB-4-G35		25.52	319 1088.0	1	0.347	見加工圖GB-4-G35	Tower 1
319					小計	373	499.586		
320		GB-10-G1	G11-2 - 10mm FT Clear + 1.52 PVB + 10mm FT Clear Laminated Glass Sample code: R20220602027	21.52	80 1039.0	98	8.146	見加工圖GB-10-G1	Tower L

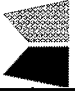 <b>美特鋁質</b> 有限公司 MIDI Aluminium Fabricator Ltd.		工程號: J-857 地盤名稱: 啟德6552 項目類別: 屋頂玻璃欄河	計算: HHQ 核對: 批准:	日期: 19/10/2022 日期: 日期:	送呈: 副本: A/C Code:	施哥
BM編號:	修改版次: C 21/11/2022	總計玻璃面積 (平方米): 507.731		此BM依據		
序號	修改內容	玻璃圖號	顏色與類型	厚度 (mm) 玻璃尺寸 寬度 (mm) 高度 (mm)	數量 (塊) 總面積 (平方米)	備注
				小計	98	8.146
1). 本表中所有玻璃對角線尺寸偏差要求不超過正負2mm。						
2). 本表中所有玻璃要求倒棱角。						
3). 本表中所有種類玻璃參照玻璃加工圖加工。						
4). 本表中所有強化玻璃均需HEAT SOAK TEST。						
5). 本表中所有強化玻璃之入爐方向均以寬度方向進入。						
6). 本表中所有玻璃成品送交地盤，每次交貨時須齊座、齊款、齊數量，每次來貨之具體數量由地盤管理提供。						
7). 本表中所有玻璃成品均需注明室內外面及其玻璃編號，以便識別。						


10/15/2022

 <b>美特鋁質</b> 有限公司 MIDI Aluminium Fabricator Ltd.		工程號:	J-857	計算:	WYY	日期:	19/10/2022	送呈:	施哥	
<b>地盘用玻璃B.M.表</b>		地盘名稱:	啟德6552	核對:		日期:		副本:		
		項目類別:	屋頂玻璃拦河	批准:		日期:		A/C Code:		
BM編號:		修改版次:	C 21/11/2022	總計玻璃面積 (平方米):		507.731	此BM依據			
序號	修改內容	玻璃圖號	顏色與類型	厚度 (mm)	玻璃尺寸		數量 (塊)	總面積 (平方米)	備注	
					寬度 (mm)	高度 (mm)				
1	B放行	GB-1-G10	<b>G5a - 12mm FT Clear + 1.52 PVB + 12mm FT Clear Laminated Sample code: R20210902040</b>	25.52	1625	1088.0	1	1.768	見加工圖J857-GB-G1	Tower 8
2	B放行	GB-1-G16		25.52	1490	1088.0	2	3.242	見加工圖J857-GB-G1	Tower 8
3	B放行	GB-1-G22		25.52	1625	1088.0	1	1.768	見加工圖J857-GB-G1	Tower 8
4	C放行	GB-1-G23		25.52	1623	1088.0	1	1.766	見加工圖J857-GB-G1	Tower 8
5	C放行	GB-1-G24		25.52	1333	1088.0	1	1.450	見加工圖J857-GB-G1	Tower 8
6	B放行	GB-1-G34		25.52	1292	1088.0	1	1.406	見加工圖J857-GB-G1	Tower 8
7	C放行	GB-1-G35		25.52	1290	1088.0	1	1.404	見加工圖J857-GB-G1	Tower 8
8	B放行	GB-1-G7		25.52	1370	1088.0	1	1.491	見加工圖J857-GB-G1	Tower 8
9	C放行	GB-1-G8		25.52	1368	1088.0	1	1.488	見加工圖J857-GB-G1	Tower 8
10	C放行	GB-1-G9		25.52	1623	1088.0	1	1.766	見加工圖J857-GB-G1	Tower 8
11	B放行	GB-2-G12		25.52	1490	1088.0	2	3.242	見加工圖J857-GB-G1	Tower 6
12	B放行	GB-2-G18		25.52	1625	1088.0	1	1.768	見加工圖J857-GB-G1	Tower 6
13	C放行	GB-2-G19		25.52	1623	1088.0	1	1.766	見加工圖J857-GB-G1	Tower 6
14	B放行	GB-2-G2		25.52	1419	1088.0	1	1.544	見加工圖J857-GB-G1	Tower 6
15	B放行	GB-2-G34		25.52	1582	1088.0	1	1.721	見加工圖J857-GB-G1	Tower 6
16	C放行	GB-2-G5		25.52	958	1088.0	1	1.042	見加工圖J857-GB-G1	Tower 6
17	C放行	GB-2-G6		25.52	1623	1088.0	1	1.766	見加工圖J857-GB-G1	Tower 6
18	B放行	GB-2-G7		25.52	1625	1088.0	1	1.768	見加工圖J857-GB-G1	Tower 6
19	C放行	GB-3-G19		25.52	1623	1088.0	1	1.766	見加工圖J857-GB-G1	Tower 3
20	B放行	GB-3-G20		25.52	1625	1088.0	1	1.768	見加工圖J857-GB-G1	Tower 3
21	B放行	GB-3-G26		25.52	1490	1088.0	2	3.242	見加工圖J857-GB-G1	Tower 3


Handwritten signature/initials in the top left corner.

美特鋁質有限公司 MIDI Aluminium Fabricator Ltd.		工程號:	J-857	計算:	WYY	日期:	19/10/2022	送呈:	施哥		
地盤名稱:		啟德6552		核對:		日期:		副本:			
項目類別:		屋頂玻璃欄河		批准:		日期:		A/C Code:			
修改版次:		C 21/11/2022		總計玻璃面積 (平方米): 507.731						此BM依據	
序號	修改內容	玻璃圖號	顏色與類型	厚度 (mm)	玻璃尺寸		數量 (塊)	總面積 (平方米)	備注		
					寬度 (mm)	高度 (mm)					
22	B放行	GB-3-G32	G5a - 12mm FT Clear + 1.52 PVB + 12mm FT Clear Laminated Sample code: R20210902040	25.52	1625	1088.0	1	1.768	見加工圖J857-GB-G1	Tower 3	
23	C放行	GB-3-G33		25.52	1623	1088.0	1	1.766	見加工圖J857-GB-G1	Tower 3	
24	C放行	GB-3-G34		25.52	958	1088.0	1	1.042	見加工圖J857-GB-G1	Tower 3	
25	B放行	GB-3-G37		25.52	1419	1088.0	1	1.544	見加工圖J857-GB-G1	Tower 3	
26	B放行	GB-3-G8		25.52	1582	1088.0	1	1.721	見加工圖J857-GB-G1	Tower 3	
27	C放行	GB-4-G16		25.52	1321	1088.0	1	1.437	見加工圖J857-GB-G1	Tower 1	
28	C放行	GB-4-G17		25.52	1632	1088.0	1	1.776	見加工圖J857-GB-G1	Tower 1	
29	B放行	GB-4-G18		25.52	1634	1088.0	1	1.778	見加工圖J857-GB-G1	Tower 1	
30	B放行	GB-4-G24		25.52	1090	1088.0	1	1.186	見加工圖J857-GB-G1	Tower 1	
31	B放行	GB-4-G38		25.52	1490	1088.0	2	3.242	見加工圖J857-GB-G1	Tower 1	
32	C放行	GB-4-G4		25.52	1290	1088.0	1	1.404	見加工圖J857-GB-G1	Tower 1	
33	B放行	GB-4-G41		25.52	1392	1088.0	1	1.514	見加工圖J857-GB-G1	Tower 1	
34	B放行	GB-4-G5		25.52	1292	1088.0	1	1.406	見加工圖J857-GB-G1	Tower 1	
35	B放行	GB-5-G1		25.52	1529	1088.0	1	1.664	見加工圖J857-GB-G1	Tower 1	
36	B放行	GB-5-G13		25.52	1615	1088.0	1	1.757	見加工圖J857-GB-G1	Tower 1	
37	B放行	GB-5-G4		25.52	1490	1088.0	6	9.727	見加工圖J857-GB-G1	Tower 1	
38	B放行	GB-5-G8		25.52	1490	1088.0	4	6.484	見加工圖J857-GB-G1	Tower 1	
39	B放行	GB-6-G17		25.52	1490	1088.0	5	8.106	見加工圖J857-GB-G1	Tower 3	
40	B放行	GB-6-G4		25.52	1354	1088.0	1	1.473	見加工圖J857-GB-G1	Tower 3	
41	B放行	GB-6-G7a		25.52	1073	1088.0	1	1.167	見加工圖J857-GB-G1	Tower 3	
42	B放行	GB-7-G11		25.52	1490	1088.0	4	6.484	見加工圖J857-GB-G1	Tower 5	


參考

 <b>美特鋁質</b> 有限公司 MIDI Aluminium Fabricator Ltd.		工程號:	J-857	計算:	WYY	日期:	19/10/2022	送呈:	施哥		
地盤名稱:		放德6552		核對:		日期:		副本:			
項目類別:		屋頂玻璃拦河		批准:		日期:		A/C Code:			
修改版次:		C 21/11/2022		總計玻璃面積 (平方米): 507.731						此BM依據	
序號	修改內容	玻璃圖號	顏色與類型	厚度 (mm)	玻璃尺寸		數量 (塊)	總面積 (平方米)	備注		
					寬度 (mm)	高度 (mm)					
43	B放行	GB-7-G2	<b>G5a - 12mm FT Clear + 1.52 PVB + 12mm FT Clear Laminated Sample code: R20210902040</b>	25.52	1490	1088.0	5	8.106	見加工圖J857-GB-G1	Tower 5	
44	B放行	GB-7-G7		25.52	1490	1088.0	2	3.242	見加工圖J857-GB-G1	Tower 5	
45	B放行	GB-8-G5		25.52	1490	1088.0	10	16.211	見加工圖J857-GB-G1	Tower 6	
46	B放行	GB-9-G13		25.52	1490	1088.0	4	6.484	見加工圖J857-GB-G1	Tower 8	
47	B放行	GB-9-G17		25.52	1490	1088.0	5	8.106	見加工圖J857-GB-G1	Tower 8	
48	B放行	GB-9-G20		25.52	1490	1088.0	2	3.242	見加工圖J857-GB-G1	Tower 8	
49	B放行	GB-9-G4		25.52	1354	1088.0	1	1.473	見加工圖J857-GB-G1	Tower 8	
50	B放行	GB-9-G8		25.52	1615	1088.0	1	1.757	見加工圖J857-GB-G1	Tower 8	
51	C放行	GB-12-G21	<b>G5a - 12mm FT Low Iron +1.52PVB+12mm FT Low Iron Laminated (超白) - Sample code: R20220927005</b>	25.52	1521	1088.0	1	1.655	見加工圖J857-GB-G1	Tower 8	
52	C放行	GB-12-G3		25.52	1088	1088.0	1	1.184	見加工圖J857-GB-G1	Tower 1	
53	C放行	GB-12-G8		25.52	1403	1088.0	1	1.526	見加工圖J857-GB-G1	Tower 1	
54	C放行	GB-5-G14		25.52	1121	1088.0	1	1.220	見加工圖J857-GB-G1	Tower 1	
55	B放行	GB-5-G20		25.52	1595	1088.0	1	1.735	見加工圖J857-GB-G1	Tower 1	
56	B放行	GB-5-G24		25.52	1340	1088.0	1	1.458	見加工圖J857-GB-G1	Tower 1	
57	B放行	GB-5-G28		25.52	1507	1088.0	1	1.640	見加工圖J857-GB-G1	Tower 1	
58	C放行	GB-5-G29		25.52	1505	1088.0	1	1.637	見加工圖J857-GB-G1	Tower 1	
59	C放行	GB-6-G18	25.52	1321	1088.0	1	1.437	見加工圖J857-GB-G1	Tower 3		
60	B放行	GB-6-G24	25.52	1490	1088.0	2	3.242	見加工圖J857-GB-G1	Tower 3		
61	B放行	GB-7-G15	25.52	1490	1088.0	6	9.727	見加工圖J857-GB-G1	Tower 5		
62	C放行	GB-7-G16	25.52	1396	1088.0	1	1.519	見加工圖J857-GB-G1	Tower 5		
63	C放行	GB-8-G15	25.52	1396	1088.0	1	1.519	見加工圖J857-GB-G1	Tower 6		

Handwritten signature/initials in the top right corner.

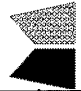
 <b>美特鋁質</b> 有限公司 MIDI Aluminium Fabricator Ltd.		工程號:	J-857	計算:	WYY	日期:	19/10/2022	送呈:	施哥		
<b>地盘用玻璃B.M.表</b>		地盘名稱:	啟德6552 <th>核對:</th> <td></td> <th>日期:</th> <td></td> <th>副本:</th> <td></td>	核對:		日期:		副本:			
		項目類別:	屋頂玻璃拦河 <th>批准:</th> <td></td> <th>日期:</th> <td></td> <th>A/C Code:</th> <td></td>	批准:		日期:		A/C Code:			
BM編號:		修改版次:	C 21/11/2022 <th colspan="6">總計玻璃面積 (平方米): 507.731</th> <th colspan="2">此BM依據</th>	總計玻璃面積 (平方米): 507.731						此BM依據	
序號	修改內容	玻璃圖號	顏色與類型	厚度 (mm)	玻璃尺寸 寬度 (mm) 高度 (mm)	數量 (塊)	總面積 (平方米)	備注			
64	B放行	GB-8-G16	<b>G5a - 12mm FT Low Iron +1.52PVB+12mm FT Low Iron Laminated (超白) - Sample code: R20220927005</b>	25.52	1490 1088.0	6	9.727	見加工圖J857-GB-G1 Tower 6			
65	C放行	GB-8-G22		25.52	1321 1088.0	1	1.437	見加工圖J857-GB-G1 Tower 6			
66	C放行	GB-9-G21		25.52	1497 1088.0	1	1.629	見加工圖J857-GB-G1 Tower 8			
67	B放行	GB-9-G22		25.52	1499 1088.0	1	1.631	見加工圖J857-GB-G1 Tower 8			
68	B放行	GB-9-G26		25.52	1490 1088.0	4	6.484	見加工圖J857-GB-G1 Tower 8			
69	C放行	GB-9-G34		25.52	936 1088.0	1	1.018	見加工圖J857-GB-G1 Tower 8			
70		GB-1-G12		<b>G5a - 12mm FT Clear + 1.52 PVB + 12mm FT Clear Laminated Sample code: R20210902040</b>	25.52	1200 1088.0	1	1.306	見加工圖J857-GB-G2 Tower 8		
71		GB-1-G15			25.52	1432 1088.0	1	1.558	見加工圖J857-GB-G2 Tower 8		
72		GB-1-G21			25.52	1622 1088.0	1	1.765	見加工圖J857-GB-G2 Tower 8		
73		GB-1-G28	25.52		1275 1088.0	1	1.387	見加工圖J857-GB-G2 Tower 8			
74		GB-1-G33	25.52		1289 1088.0	1	1.402	見加工圖J857-GB-G2 Tower 8			
75		GB-1-G4	25.52		1530 1088.0	1	1.665	見加工圖J857-GB-G2 Tower 8			
76		GB-2-G11a	25.52		1432 1088.0	1	1.558	見加工圖J857-GB-G2 Tower 6			
77		GB-2-G17	25.52		1622 1088.0	1	1.765	見加工圖J857-GB-G2 Tower 6			
78		GB-2-G21	25.52	1175 1088.0	1	1.278	見加工圖J857-GB-G2 Tower 6				
79		GB-2-G30	25.52	1395 1088.0	1	1.518	見加工圖J857-GB-G2 Tower 6				
80		GB-2-G33	25.52	1579 1088.0	1	1.718	見加工圖J857-GB-G2 Tower 6				
81		GB-2-G41	25.52	865 1088.0	1	0.941	見加工圖J857-GB-G2 Tower 6				
82		GB-2-G9	25.52	1200 1088.0	1	1.306	見加工圖J857-GB-G2 Tower 6				
83		GB-3-G18	25.52	1315 1088.0	1	1.431	見加工圖J857-GB-G2 Tower 3				
84		GB-3-G2	25.52	1587 1088.0	1	1.727	見加工圖J857-GB-G2 Tower 3				

第 5 頁


 <b>美特鋁質</b> 有限公司 MIDI Aluminium Fabricator Ltd.		工程號:	J-857	計算:	WYY	日期:	19/10/2022	送呈:	施哥		
<b>地盘用玻璃B.M.表</b>		地盘名稱:	啟德6552	核對:		日期:		副本:			
		項目類別:	屋頂玻璃栏河	批准:		日期:		A/C Code:			
BM編號:		修改版次:	C 21/11/2022	總計玻璃面積 (平方米): 507.731						此BM依據	
序號	修改內容	玻璃圖號	顏色與類型			玻璃尺寸		數量 (塊)	總面積 (平方米)	備注	
			厚度 (mm)	寬度 (mm)	高度 (mm)	寬度 (mm)	高度 (mm)				
85		GB-3-G22	25.52	1200	1088.0	1088.0	1	1.306	見加工圖J857-GB-G2	Tower 3	
86		GB-3-G25	25.52	1432	1088.0	1088.0	1	1.558	見加工圖J857-GB-G2	Tower 3	
87		GB-3-G31	25.52	1622	1088.0	1088.0	1	1.765	見加工圖J857-GB-G2	Tower 3	
88		GB-3-G5	25.52	975	1088.0	1088.0	1	1.061	見加工圖J857-GB-G2	Tower 3	
89		GB-4-G20	25.52	1070	1088.0	1088.0	1	1.164	見加工圖J857-GB-G2	Tower 1	
90		GB-4-G23	25.52	1087	1088.0	1088.0	1	1.183	見加工圖J857-GB-G2	Tower 1	
91		GB-4-G37	25.52	1307	1088.0	1088.0	1	1.422	見加工圖J857-GB-G2	Tower 1	
92		GB-4-G43	25.52	1205	1088.0	1088.0	1	1.311	見加工圖J857-GB-G2	Tower 1	
93		GB-4-G47	25.52	1525	1088.0	1088.0	1	1.659	見加工圖J857-GB-G2	Tower 1	
94		GB-4-G7	25.52	925	1088.0	1088.0	1	1.006	見加工圖J857-GB-G2	Tower 1	
95		GB-5-G12	25.52	1612	1088.0	1088.0	1	1.754	見加工圖J857-GB-G2	Tower 1	
96		GB-5-G3	25.52	1475	1088.0	1088.0	1	1.605	見加工圖J857-GB-G2	Tower 1	
97		GB-5-G7	25.52	1550	1088.0	1088.0	1	1.686	見加工圖J857-GB-G2	Tower 1	
98		GB-6-G12	25.52	1495	1088.0	1088.0	1	1.627	見加工圖J857-GB-G2	Tower 3	
99		GB-6-G14	25.52	1437	1088.0	1088.0	1	1.563	見加工圖J857-GB-G2	Tower 3	
100		GB-6-G3	25.52	1351	1088.0	1088.0	1	1.470	見加工圖J857-GB-G2	Tower 3	
101		GB-7-G10	25.52	1482	1088.0	1088.0	1	1.612	見加工圖J857-GB-G2	Tower 5	
102		GB-7-G6	25.52	1150	1088.0	1088.0	1	1.251	見加工圖J857-GB-G2	Tower 5	
103		GB-8-G2	25.52	1112	1088.0	1088.0	1	1.210	見加工圖J857-GB-G2	Tower 6	
104		GB-8-G14	25.52	1612	1088.0	1088.0	1	1.754	見加工圖J857-GB-G2	Tower 6	
105		GB-8-G9	25.52	1495	1088.0	1088.0	1	1.627	見加工圖J857-GB-G2	Tower 6	

**G5a - 12mm FT Clear + 1.52 PVB + 12mm FT Clear Laminated Sample code: R20210902040**

第 6 頁


 <b>美特鋁質</b> 有限公司 MIDI Aluminium Fabricator Ltd.		工程號:	J-857	計算:	WYY	日期:	19/10/2022	送呈:	施哥
<b>地盘用玻璃B.M.表</b>		地盘名稱:	啟德6552	核對:		日期:		副本:	
		項目類別:	屋頂玻璃拦河	批准:		日期:		A/C Code:	
BM編號:	修改版次:		C 21/11/2022	總計玻璃面積 (平方米):		507.731	此BM依據		
序號	修改內容	玻璃圖號	顏色與類型	厚度 (mm)	寬度 (mm)	高度 (mm)	數量 (塊)	總面積 (平方米)	備注
106		GB-9-G10	<b>G5a - 12mm FT Clear + 1.52 PVB + 12mm FT Clear Laminated Sample code: R20210902040</b>	25.52	1095	1088.0	1	1.191	見加工圖J857-GB-G2 Tower 8
107		GB-9-G16		25.52	1107	1088.0	1	1.204	見加工圖J857-GB-G2 Tower 8
108		GB-9-G19		25.52	1612	1088.0	1	1.754	見加工圖J857-GB-G2 Tower 8
109		GB-9-G3		25.52	1351	1088.0	1	1.470	見加工圖J857-GB-G2 Tower 8
110		GB-12-G14	<b>G5a - 12mm FT Low Iron + 1.52PVB+12mm FT Low Iron Laminated (超白) - Sample code: R20220927005</b>	25.52	1665	1088.0	1	1.812	見加工圖J857-GB-G2 Tower 1
111		GB-12-G18		25.52	341	1088.0	1	0.371	見加工圖J857-GB-G2 Tower 3
112		GB-12-G2		25.52	1087	1088.0	1	1.183	見加工圖J857-GB-G2 Tower 1
113		GB-12-G20		25.52	1520	1088.0	1	1.654	見加工圖J857-GB-G2 Tower 8
114		GB-12-G25		25.52	715	1088.0	1	0.778	見加工圖J857-GB-G2 Tower 6
115		GB-12-G27		25.52	565	1088.0	1	0.615	見加工圖J857-GB-G2 Tower 8
116		GB-5-G16		25.52	1250	1088.0	1	1.360	見加工圖J857-GB-G2 Tower 1
117		GB-5-G19		25.52	1592	1088.0	1	1.732	見加工圖J857-GB-G2 Tower 1
118		GB-6-G23		25.52	1395	1088.0	1	1.518	見加工圖J857-GB-G2 Tower 3
119		GB-8-G21		25.52	1320	1088.0	1	1.436	見加工圖J857-GB-G2 Tower 6
120		GB-9-G25	25.52	1357	1088.0	1	1.476	見加工圖J857-GB-G2 Tower 8	
121		GB-9-G31	25.52	1445	1088.0	1	1.572	見加工圖J857-GB-G2 Tower 8	
122		GB-9-G33	25.52	935	1088.0	1	1.017	見加工圖J857-GB-G2 Tower 8	
123		GB-1-G1	<b>G5a - 12mm FT Clear + 1.52 PVB + 12mm FT Clear Laminated Sample code: R20210902040</b>	25.52	1632	1088.0	1	1.776	見加工圖J857-GB-G3 Tower 8
124		GB-1-G11		25.52	1622	1088.0	1	1.765	見加工圖J857-GB-G3 Tower 8
125		GB-1-G17		25.52	1432	1088.0	1	1.558	見加工圖J857-GB-G3 Tower 8
126		GB-1-G20		25.52	1200	1088.0	1	1.306	見加工圖J857-GB-G3 Tower 8

陸嘉琪


 <b>美特鋁質</b> 有限公司 MIDI Aluminium Fabricator Ltd.		<b>工程號:</b> J-857 <b>地盤名稱:</b> 啟德6552 <b>項目類別:</b> 屋頂玻璃欄河 <b>修改版次:</b> C 21/11/2022	<b>計算:</b> <b>核對:</b> <b>批准:</b>	<b>WYY</b>   	<b>日期:</b> <b>日期:</b> <b>日期:</b>	<b>19/10/2022</b>   	<b>送呈:</b> <b>副本:</b> <b>A/C Code:</b>	<b>施哥</b>
<b>地盤用玻璃B.M.表</b>		<b>總計玻璃面積 (平方米):</b> 507.731 <b>此BM依據</b>						
<b>BM編號:</b>	<b>顏色與類型</b>		<b>玻璃尺寸</b>		<b>數量</b> (塊)	<b>總面積</b> (平方米)	<b>備注</b>	
<b>序號</b>	<b>修改內容</b>	<b>玻璃圖號</b>	<b>厚度 (mm)</b>	<b>寬度 (mm)</b>	<b>高度 (mm)</b>			
127		GB-1-G27	25.52	1225	1088.0	1	1.333	見加工圖J857-GB-G3 Tower 8
128		GB-1-G32	25.52	925	1088.0	1	1.006	見加工圖J857-GB-G3 Tower 8
129		GB-2-G13	25.52	1432	1088.0	1	1.558	見加工圖J857-GB-G3 Tower 6
130		GB-2-G16	25.52	1200	1088.0	1	1.306	見加工圖J857-GB-G3 Tower 6
131		GB-2-G20	25.52	1315	1088.0	1	1.431	見加工圖J857-GB-G3 Tower 6
132		GB-2-G37	25.52	975	1088.0	1	1.061	見加工圖J857-GB-G3 Tower 6
133		GB-2-G40	25.52	1587	1088.0	1	1.727	見加工圖J857-GB-G3 Tower 6
134		GB-2-G8	25.52	1622	1088.0	1	1.765	見加工圖J857-GB-G3 Tower 6
135		GB-3-G1	25.52	1290	1088.0	1	1.404	見加工圖J857-GB-G3 Tower 3
136		GB-3-G12	25.52	1395	1088.0	1	1.518	見加工圖J857-GB-G3 Tower 3
137		GB-3-G17	25.52	1175	1088.0	1	1.278	見加工圖J857-GB-G3 Tower 3
138		GB-3-G21	25.52	1622	1088.0	1	1.765	見加工圖J857-GB-G3 Tower 3
139		GB-3-G27	25.52	1432	1088.0	1	1.558	見加工圖J857-GB-G3 Tower 3
140		GB-3-G30	25.52	1200	1088.0	1	1.306	見加工圖J857-GB-G3 Tower 3
141		GB-3-G9	25.52	1579	1088.0	1	1.718	見加工圖J857-GB-G3 Tower 3
142		GB-4-G11	25.52	1312	1088.0	1	1.427	見加工圖J857-GB-G3 Tower 1
143		GB-4-G19	25.52	1631	1088.0	1	1.775	見加工圖J857-GB-G3 Tower 1
144		GB-4-G25	25.52	1087	1088.0	1	1.183	見加工圖J857-GB-G3 Tower 1
145		GB-4-G28	25.52	950	1088.0	1	1.034	見加工圖J857-GB-G3 Tower 1
146		GB-4-G36	25.52	1340	1088.0	1	1.458	見加工圖J857-GB-G3 Tower 1
147		GB-4-G38a	25.52	1307	1088.0	1	1.422	見加工圖J857-GB-G3 Tower 1

**G5a - 12mm FT Clear + 1.52  
 PVB + 12mm FT Clear  
 Laminated Sample code:  
 R20210902040**


第8頁

 <b>美特鋁質</b> 有限公司 MIDI Aluminium Fabricator Ltd.		工程號:	J-857	計算:	WYY	日期:	19/10/2022	送呈:	施哥
地盤名稱:		啟德6552		核對:		日期:		副本:	
項目類別:		屋頂玻璃欄河		批准:		日期:		A/C Code:	
修改版次:		C 21/11/2022		總計玻璃面積 (平方米):		507.731		此BM依據	
序號	修改內容	玻璃圖號	顏色與類型	厚度 (mm)	玻璃尺寸		數量 (塊)	總面積 (平方米)	備注
					寬度 (mm)	高度 (mm)			
148		GB-4-G42	<b>G5a - 12mm FT Clear + 1.52 PVB + 12mm FT Clear Laminated Sample code: R20210902040</b>	25.52	1389	1088.0	1	1.511	見加工圖J857-GB-G3 Tower 1
149		GB-4-G46		25.52	987	1088.0	1	1.074	見加工圖J857-GB-G3 Tower 1
150		GB-4-G6		25.52	1289	1088.0	1	1.402	見加工圖J857-GB-G3 Tower 1
151		GB-5-G2		25.52	1526	1088.0	1	1.660	見加工圖J857-GB-G3 Tower 1
152		GB-5-G11		25.52	922	1088.0	1	1.003	見加工圖J857-GB-G3 Tower 1
153		GB-6-G13		25.52	1494	1088.0	1	1.625	見加工圖J857-GB-G3 Tower 3
154		GB-6-G5		25.52	1351	1088.0	1	1.470	見加工圖J857-GB-G3 Tower 3
155		GB-6-G8		25.52	1070	1088.0	1	1.164	見加工圖J857-GB-G3 Tower 3
156		GB-7-G12		25.52	1482	1088.0	1	1.612	見加工圖J857-GB-G3 Tower 5
157		GB-7-G5		25.52	1112	1088.0	1	1.210	見加工圖J857-GB-G3 Tower 5
158		GB-8-G1		25.52	1150	1088.0	1	1.251	見加工圖J857-GB-G3 Tower 6
159		GB-8-G10		25.52	1495	1088.0	1	1.627	見加工圖J857-GB-G3 Tower 6
160		GB-8-G8		25.52	1437	1088.0	1	1.563	見加工圖J857-GB-G3 Tower 6
161		GB-9-G18		25.52	1107	1088.0	1	1.204	見加工圖J857-GB-G3 Tower 8
162		GB-9-G5		25.52	1351	1088.0	1	1.470	見加工圖J857-GB-G3 Tower 8
163		GB-9-G9		25.52	1612	1088.0	1	1.754	見加工圖J857-GB-G3 Tower 8
164		GB-12-G1		25.52	890	1088.0	1	0.968	見加工圖J857-GB-G3 Tower 1
165		GB-12-G13	25.52	465	1088.0	1	0.506	見加工圖J857-GB-G3 Tower 1	
166		GB-12-G15	<b>G5a - 12mm FT Low Iron + 1.52PVB+12mm FT Low Iron Laminated (超白) - Sample code: R20220927005</b>	25.52	715	1088.0	1	0.778	見加工圖J857-GB-G3 Tower 3
167		GB-12-G19		25.52	1565	1088.0	1	1.703	見加工圖J857-GB-G3 Tower 8
168		GB-12-G22		25.52	341	1088.0	1	0.371	見加工圖J857-GB-G3 Tower 6
169		GB-12-G26		25.52	1690	1088.0	1	1.839	見加工圖J857-GB-G3 Tower 8
170		GB-12-G9		25.52	1402	1088.0	1	1.525	見加工圖J857-GB-G3 Tower 1


2/11/22

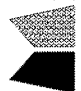 <b>美特鋁質</b> 有限公司 MIDI Aluminium Fabricator Ltd.		工程號:	J-857	計算:	WYY	日期:	19/10/2022	送呈:	施哥
<b>地盤名稱:</b> 地盤名稱:		<b>項目類別:</b> 屋頂玻璃欄河		核對:		日期:		副本:	
<b>BM編號:</b>		<b>修改版次:</b> C 21/11/2022		批准:		日期:		A/C Code:	
<b>修改內容</b>		<b>顏色與類型</b>		厚度 (mm)	玻璃尺寸	數量	總面積	此BM依據	
序號	玻璃圖號			寬度 (mm)	高度 (mm)	(塊)	(平方米)	備注	
171	GB-5-G15	<b>G5a - 12mm FT Low Iron +1.52PVB+12mm FT Low Iron Laminated (超白) - Sample code: R20220927005</b>		25.52	1088.0	1	1.219	見加工圖J857-GB-G3	Tower 1
172	GB-5-G21			25.52	1088.0	1	1.732	見加工圖J857-GB-G3	Tower 1
173	GB-5-G25			25.52	1088.0	1	1.455	見加工圖J857-GB-G3	Tower 1
174	GB-6-G19			25.52	1088.0	1	1.436	見加工圖J857-GB-G3	Tower 3
175	GB-8-G17			25.52	1088.0	1	1.518	見加工圖J857-GB-G3	Tower 6
176	GB-9-G27			25.52	1088.0	1	1.476	見加工圖J857-GB-G3	Tower 8
177	GB-9-G32			25.52	1088.0	1	1.572	見加工圖J857-GB-G3	Tower 8
178	GB-1-G14			25.52	1088.0	1	0.201	見加工圖J857-GB-G4	Tower 8
179	GB-1-G3			25.52	1088.0	1	0.419	見加工圖J857-GB-G4	Tower 8
180	GB-2-G11			25.52	1088.0	1	0.201	見加工圖J857-GB-G4	Tower 6
181	GB-2-G23			25.52	1088.0	1	0.854	見加工圖J857-GB-G4	Tower 6
182	GB-2-G29			25.52	1088.0	1	1.044	見加工圖J857-GB-G4	Tower 6
183	GB-2-G32			25.52	1088.0	1	0.528	見加工圖J857-GB-G4	Tower 6
184	GB-3-G24			25.52	1088.0	1	0.201	見加工圖J857-GB-G4	Tower 3
185	GB-3-G4			25.52	1088.0	1	0.582	見加工圖J857-GB-G4	Tower 3
186	GB-3-G40			25.52	1088.0	1	0.147	見加工圖J857-GB-G4	Tower 3
187	GB-4-G13			25.52	1088.0	1	0.147	見加工圖J857-GB-G4	Tower 1
188	GB-4-G22	25.52	1088.0	1	0.201	見加工圖J857-GB-G4	Tower 1		
189	GB-4-G30	25.52	1088.0	1	0.201	見加工圖J857-GB-G4	Tower 1		
190	GB-5-G6	25.52	1088.0	1	0.370	見加工圖J857-GB-G4	Tower 1		
191	GB-6-G2	25.52	1088.0	1	0.201	見加工圖J857-GB-G4	Tower 3		
192	GB-6-G11	25.52	1088.0	1	1.616	見加工圖J857-GB-G4	Tower 3		


BM

 <b>美特鋁質</b> 有限公司 MIDI Aluminium Fabricator Ltd.		工程號:	J-857	計算:	WYY	日期:	19/10/2022	送呈:	施哥		
地盤名稱:		啟德6552		核對:		日期:		副本:			
項目類別:		屋頂玻璃欄河		批准:		日期:		A/C Code:			
修改版次:		C. 21/11/2022		總計玻璃面積 (平方米): 507.731						此BM依據	
序號	修改內容	玻璃圖號	顏色與類型	厚度 (mm)	玻璃尺寸		數量 (塊)	總面積 (平方米)	備注		
					寬度 (mm)	高度 (mm)					
193		GB-7-G9	<b>G5a - 12mm FT Clear + 1.52 PVB + 12mm FT Clear Laminated Sample code: R20210902040</b>	25.52	185	1088.0	1	0.201	見加工圖J857-GB-G4	Tower 5	
194		GB-8-G13		25.52	185	1088.0	1	0.201	見加工圖J857-GB-G4	Tower 6	
195		GB-9-G15		25.52	710	1088.0	1	0.772	見加工圖J857-GB-G4	Tower 8	
196		GB-9-G2		25.52	485	1088.0	1	0.528	見加工圖J857-GB-G4	Tower 8	
197		GB-12-G17	<b>G5a - 12mm FT Low Iron + 1.52PVB+12mm FT Low Iron Laminated (超白) - Sample code: R20220927005</b>	25.52	1160	1088.0	1	1.262	見加工圖J857-GB-G4	Tower 3	
198		GB-12-G24		25.52	960	1088.0	1	1.044	見加工圖J857-GB-G4	Tower 6	
199		GB-5-G18		25.52	185	1088.0	1	0.201	見加工圖J857-GB-G4	Tower 1	
200		GB-6-G22		25.52	185	1088.0	1	0.201	見加工圖J857-GB-G4	Tower 3	
201		GB-8-G20		25.52	1235	1088.0	1	1.344	見加工圖J857-GB-G4	Tower 6	
202		GB-9-G24		25.52	185	1088.0	1	0.201	見加工圖J857-GB-G4	Tower 8	
203		GB-9-G30	<b>G5a - 12mm FT Clear + 1.52 PVB + 12mm FT Clear Laminated Sample code: R20210902040</b>	25.52	610	1088.0	1	0.664	見加工圖J857-GB-G4	Tower 8	
204		GB-1-G18		25.52	185	1088.0	1	0.201	見加工圖J857-GB-G5	Tower 8	
205		GB-1-G2		25.52	775	1088.0	1	0.843	見加工圖J857-GB-G5	Tower 8	
206		GB-2-G14		25.52	185	1088.0	1	0.201	見加工圖J857-GB-G5	Tower 6	
207		GB-2-G25		25.52	135	1088.0	1	0.147	見加工圖J857-GB-G5	Tower 6	
208		GB-2-G38		25.52	535	1088.0	1	0.582	見加工圖J857-GB-G5	Tower 6	
209		GB-3-G10		25.52	485	1088.0	1	0.528	見加工圖J857-GB-G5	Tower 3	

參考


 <b>美特鋁質</b> 有限公司 MIDI Aluminium Fabricator Ltd.		工程號:	J-857	計算:	WYY	日期:	19/10/2022	送呈:	施哥	
<b>地盘用玻璃B.M.表</b>		地盘名稱:	啟德6552 <th>核對:</th> <td></td> <th>日期:</th> <td></td> <th>副本:</th> <td></td>	核對:		日期:		副本:		
		項目類別:	屋頂玻璃栏河 <th>批准:</th> <td></td> <th>日期:</th> <td></td> <th>A/C Code:</th> <td></td>	批准:		日期:		A/C Code:		
BM編號:	修改版次:		C 21/11/2022	總計玻璃面積 (平方米):		507.731		此BM依據		
序號	修改內容	玻璃圖號	顏色與類型	厚度 (mm)	寬度 (mm)	玻璃尺寸 高度 (mm)	數量 (塊)	總面積 (平方米)	備注	
210		GB-3-G13	<b>G5a - 12mm FT Clear + 1.52 PVB + 12mm FT Clear Laminated Sample code: R20210902040</b>	25.52	960	1088.0	1	1.044	見加工圖J857-GB-G5 Tower 3	
211		GB-3-G28		25.52	185	1088.0	1	0.201	見加工圖J857-GB-G5 Tower 3	
212		GB-3-G42		25.52	785	1088.0	1	0.854	見加工圖J857-GB-G5 Tower 3	
213		GB-4-G12		25.52	1729	1088.0	1	1.881	見加工圖J857-GB-G5 Tower 1	
214		GB-4-G14		25.52	966	1088.0	1	1.051	見加工圖J857-GB-G5 Tower 1	
215		GB-4-G26		25.52	185	1088.0	1	0.201	見加工圖J857-GB-G5 Tower 1	
216		GB-4-G29		25.52	1185	1088.0	1	1.289	見加工圖J857-GB-G5 Tower 1	
217		GB-4-G31		25.52	460	1088.0	1	0.500	見加工圖J857-GB-G5 Tower 1	
218		GB-4-G38b		25.52	215	1088.0	1	0.234	見加工圖J857-GB-G5 Tower 1	
219		GB-6-G6		25.52	485	1088.0	1	0.528	見加工圖J857-GB-G5 Tower 3	
220		GB-6-G9		25.52	185	1088.0	1	0.201	見加工圖J857-GB-G5 Tower 3	
221		GB-7-G13		25.52	185	1088.0	1	0.201	見加工圖J857-GB-G5 Tower 5	
222		GB-8-G11		25.52	1485	1088.0	1	1.616	見加工圖J857-GB-G5 Tower 6	
223		GB-9-G6		25.52	185	1088.0	1	0.201	見加工圖J857-GB-G5 Tower 1	
224		GB-12-G11		25.52	910	1088.0	1	0.990	見加工圖J857-GB-G5 Tower 1	
225		GB-12-G16		25.52	960	1088.0	1	1.044	見加工圖J857-GB-G5 Tower 3	
226		GB-12-G23		25.52	1160	1088.0	1	1.262	見加工圖J857-GB-G5 Tower 6	
227		GB-5-G22		<b>G5a - 12mm FT Low Iron + 1.52PVB+12mm FT Low Iron Laminated (超白) - Sample code: R20220927005</b>	25.52	335	1088.0	1	0.364	見加工圖J857-GB-G5 Tower 1
228		GB-5-G26			25.52	185	1088.0	1	0.201	見加工圖J857-GB-G5 Tower 1
229		GB-6-G20			25.52	1235	1088.0	1	1.344	見加工圖J857-GB-G5 Tower 3
230		GB-8-G18			25.52	185	1088.0	1	0.201	見加工圖J857-GB-G5 Tower 8
231		GB-9-G28			25.52	185	1088.0	1	0.201	見加工圖J857-GB-G5 Tower 1
232		GB-12-G10			25.52	934	1088.0	1	1.016	見加工圖J857-GB-G6 Tower 1

15/8


 <b>美特鋁質</b> 有限公司 MIDI Aluminium Fabricator Ltd.		工程號:	J-857	計算:	WYY	日期:	19/10/2022	送呈:	施哥		
<b>地盘用玻璃B.M.表</b>		地盘名稱:	啟德6552 <th>核對:</th> <td></td> <th>日期:</th> <td></td> <th>副本:</th> <td></td>	核對:		日期:		副本:			
		項目類別:	屋頂玻璃栏河 <th>批准:</th> <td></td> <th>日期:</th> <td></td> <th>A/C Code:</th> <td></td>	批准:		日期:		A/C Code:			
BM編號:		修改版次:	C 21/11/2022 <th colspan="6">總計玻璃面積 (平方米): 507.731</th> <th colspan="2">此BM依據</th>	總計玻璃面積 (平方米): 507.731						此BM依據	
序號	修改內容	玻璃圖號	顏色與類型		厚度 (mm)	玻璃尺寸		數量 (塊)	總面積 (平方米)	備注	
			寬度 (mm)	高度 (mm)		寬度 (mm)	高度 (mm)				
233		GB-2-G24			25.52	934	1088.0	1	1.016	見加工圖J857-GB-G6	Tower 6
234		GB-3-G41			25.52	1334	1088.0	1	1.451	見加工圖J857-GB-G6	Tower 3
235		GB-1-G30			25.52	1545	1088.0	1	1.681	見加工圖J857-GB-G7	Tower 8
236		GB-2-G26			25.52	1310	1088.0	1	1.425	見加工圖J857-GB-G7	Tower 6
237		GB-2-G28			25.52	1330	1088.0	1	1.447	見加工圖J857-GB-G7	Tower 6
238		GB-3-G14			25.52	1330	1088.0	1	1.447	見加工圖J857-GB-G7	Tower 3
239		GB-3-G39			25.52	1310	1088.0	1	1.425	見加工圖J857-GB-G7	Tower 3
240		GB-4-G9			25.52	1570	1088.0	1	1.708	見加工圖J857-GB-G7	Tower 1
241		GB-1-G19			25.52	1225	1088.0	1	1.333	見加工圖J857-GB-G8	Tower 8
242		GB-1-G26			25.52	1249	1088.0	1	1.359	見加工圖J857-GB-G8	Tower 8
243		GB-1-G31			25.52	950	1088.0	1	1.034	見加工圖J857-GB-G8	Tower 8
244		GB-1-G6			25.52	1392	1088.0	1	1.514	見加工圖J857-GB-G8	Tower 8
245		GB-2-G1			25.52	1441	1088.0	1	1.568	見加工圖J857-GB-G8	Tower 6
246		GB-2-G15			25.52	1225	1088.0	1	1.333	見加工圖J857-GB-G8	Tower 6
247		GB-2-G36			25.52	1000	1088.0	1	1.088	見加工圖J857-GB-G8	Tower 6
248		GB-2-G39			25.52	1612	1088.0	1	1.754	見加工圖J857-GB-G8	Tower 6
249		GB-2-G4			25.52	982	1088.0	1	1.068	見加工圖J857-GB-G8	Tower 6
250		GB-3-G11			25.52	1420	1088.0	1	1.545	見加工圖J857-GB-G8	Tower 3
251		GB-3-G15			25.52	1750	1088.0	1	1.904	見加工圖J857-GB-G8	Tower 3
252		GB-3-G16			25.52	1200	1088.0	1	1.306	見加工圖J857-GB-G8	Tower 3
253		GB-3-G29			25.52	1225	1088.0	1	1.333	見加工圖J857-GB-G8	Tower 3
254		GB-3-G36			25.52	1441	1088.0	1	1.568	見加工圖J857-GB-G8	Tower 3
255		GB-3-G7			25.52	1604	1088.0	1	1.745	見加工圖J857-GB-G8	Tower 3

**G5a - 12mm FT Clear + 1.52  
PVB + 12mm FT Clear  
Laminated Sample code:  
R20210902040**

4/15 Bw

 <b>美特鋁質</b> 有限公司 MIDI Aluminium Fabricator Ltd.		工程號:	J-857	計算:	WYY	日期:	19/10/2022	送呈:	施哥		
<b>地盘用玻璃B.M.表</b>		地盘名稱:	啟德6552	核對:		日期:		副本:			
		項目類別:	屋頂玻璃栏河	批准:		日期:		A/C Code:			
BM編號:		修改版次:	C 21/11/2022	總計玻璃面積 (平方米): 507.731						此BM依據	
序號	修改內容	玻璃圖號	顏色與類型	厚度 (mm)	玻璃尺寸		數量 (塊)	總面積 (平方米)	備注		
					寬度 (mm)	高度 (mm)					
256		GB-4-G10	<b>G5a - 12mm FT Clear + 1.52 PVB + 12mm FT Clear Laminated Sample code: R20210902040</b>	25.52	1337	1088.0	1	1.455	見加工圖J857-GB-G8	Tower 1	
257		GB-4-G15		25.52	1345	1088.0	1	1.463	見加工圖J857-GB-G8	Tower 1	
258		GB-4-G27		25.52	975	1088.0	1	1.061	見加工圖J857-GB-G8	Tower 1	
259		GB-4-G38c		25.52	975	1088.0	1	1.061	見加工圖J857-GB-G8	Tower 1	
260		GB-4-G40		25.52	1414	1088.0	1	1.538	見加工圖J857-GB-G8	Tower 1	
261		GB-4-G45		25.52	1012	1088.0	1	1.101	見加工圖J857-GB-G8	Tower 1	
262		GB-5-G10		25.52	947	1088.0	1	1.030	見加工圖J857-GB-G8	Tower 1	
263		GB-6-G10		25.52	942	1088.0	1	1.025	見加工圖J857-GB-G8	Tower 3	
264		GB-6-G16		25.52	1517	1088.0	1	1.650	見加工圖J857-GB-G8	Tower 3	
265		GB-6-G7		25.52	1096	1088.0	1	1.192	見加工圖J857-GB-G8	Tower 3	
266		GB-7-G14		25.52	1175	1088.0	1	1.278	見加工圖J857-GB-G8	Tower 5	
267		GB-7-G4		25.52	1137	1088.0	1	1.237	見加工圖J857-GB-G8	Tower 5	
268		GB-8-G4		25.52	1542	1088.0	1	1.678	見加工圖J857-GB-G8	Tower 6	
269		GB-8-G7		25.52	1462	1088.0	1	1.591	見加工圖J857-GB-G8	Tower 6	
270		GB-9-G12		25.52	1267	1088.0	1	1.378	見加工圖J857-GB-G8	Tower 8	
271		GB-9-G7		25.52	1637	1088.0	1	1.781	見加工圖J857-GB-G8	Tower 8	
272		GB-12-G12		25.52	1000	1088.0	1	1.088	見加工圖J857-GB-G8	Tower 1	
273		GB-5-G23		<b>G5a - 12mm FT Low Iron + 1.52PVB+12mm FT Low Iron Laminated (超白) - Sample code: R20220927005</b>	25.52	1362	1088.0	1	1.482	見加工圖J857-GB-G8	Tower 1
274		GB-5-G27			25.52	1529	1088.0	1	1.664	見加工圖J857-GB-G8	Tower 1
275		GB-6-G21			25.52	942	1088.0	1	1.025	見加工圖J857-GB-G8	Tower 3
276		GB-8-G19			25.52	942	1088.0	1	1.025	見加工圖J857-GB-G8	Tower 6
277		GB-9-G29			25.52	942	1088.0	1	1.025	見加工圖J857-GB-G8	Tower 8

W. S. Bu

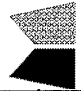
 <b>美特鋁質</b> 有限公司 MIDI Aluminium Fabricator Ltd.		工程號:	J-857	計算:	WYY	日期:	19/10/2022	送呈:	施哥		
<b>地盘用玻璃B.M.表</b>		地盤名稱:	啟德6552	核對:		日期:		副本:			
		項目類別:	屋頂玻璃栏河	批准:		日期:		A/C Code:			
BM編號:		修改版次:	C 21/11/2022	總計玻璃面積 (平方米): 507.731						此BM依據	
序號	修改內容	玻璃圖號	顏色與類型		玻璃尺寸		數量 (塊)	總面積 (平方米)	備注		
			厚度 (mm)	面度	寬度 (mm)	高度 (mm)					
278		GB-1-G13	25.52		1225	1088.0	1	1.333	見加工圖J857-GB-G9	Tower 8	
279		GB-1-G25	25.52		1357	1088.0	1	1.476	見加工圖J857-GB-G9	Tower 8	
280		GB-1-G29	25.52		1300	1088.0	1	1.414	見加工圖J857-GB-G9	Tower 8	
281		GB-1-G5	25.52		1555	1088.0	1	1.692	見加工圖J857-GB-G9	Tower 8	
282		GB-2-G10	25.52		1225	1088.0	1	1.333	見加工圖J857-GB-G9	Tower 6	
283		GB-2-G22	25.52		1200	1088.0	1	1.306	見加工圖J857-GB-G9	Tower 6	
284		GB-2-G27	25.52		1750	1088.0	1	1.904	見加工圖J857-GB-G9	Tower 6	
285		GB-2-G3	25.52		1441	1088.0	1	1.568	見加工圖J857-GB-G9	Tower 6	
286		GB-2-G31	25.52		1420	1088.0	1	1.545	見加工圖J857-GB-G9	Tower 6	
287		GB-2-G35	25.52		1604	1088.0	1	1.745	見加工圖J857-GB-G9	Tower 6	
288		GB-3-G23	25.52		1225	1088.0	1	1.333	見加工圖J857-GB-G9	Tower 3	
289		GB-3-G3	25.52		1612	1088.0	1	1.754	見加工圖J857-GB-G9	Tower 3	
290		GB-3-G35	25.52		982	1088.0	1	1.068	見加工圖J857-GB-G9	Tower 3	
291		GB-3-G38	25.52		1441	1088.0	1	1.568	見加工圖J857-GB-G9	Tower 3	
292		GB-3-G6	25.52		1000	1088.0	1	1.088	見加工圖J857-GB-G9	Tower 3	
293		GB-4-G21	25.52		1095	1088.0	1	1.191	見加工圖J857-GB-G9	Tower 1	
294		GB-4-G39	25.52		975	1088.0	1	1.061	見加工圖J857-GB-G9	Tower 1	
295		GB-4-G44	25.52		1230	1088.0	1	1.338	見加工圖J857-GB-G9	Tower 1	
296		GB-4-G8	25.52		950	1088.0	1	1.034	見加工圖J857-GB-G9	Tower 1	
297		GB-5-G5	25.52		1500	1088.0	1	1.632	見加工圖J857-GB-G9	Tower 1	
298		GB-5-G9	25.52		1575	1088.0	1	1.714	見加工圖J857-GB-G9	Tower 1	
299		GB-6-G1	25.52		1637	1088.0	1	1.781	見加工圖J857-GB-G9	Tower 3	
300		GB-6-G10a	25.52		942	1088.0	1	1.025	見加工圖J857-GB-G9	Tower 3	


**G5a - 12mm FT Clear + 1.52  
 PVB + 12mm FT Clear  
 Laminated Sample code:  
 R20210902040**

20/10/2022

美特鋁質有限公司 MIDI Aluminium Fabricator Ltd.		工程號:	J-857	計算:	WYY	日期:	19/10/2022	送呈:	施哥	
地盤名稱:		啟德6552		核對:		日期:		副本:		
項目類別:		屋頂玻璃欄河		批准:		日期:		A/C Code:		
修改版次:		C 21/11/2022		總計玻璃面積 (平方米):		507.731		此BM依據		
序號	修改內容	玻璃圖號	顏色與類型	厚度 (mm)	玻璃尺寸		數量 (塊)	總面積 (平方米)	備注	
					寬度 (mm)	高度 (mm)				
301		GB-6-G15	G5a - 12mm FT Clear + 1.52 PVB + 12mm FT Clear Laminated Sample code: R20210902040	25.52	1462	1088.0	1	1.591	見加工圖J857-GB-G9 Tower 3	
302		GB-7-G3		25.52	1517	1088.0	1	1.650	見加工圖J857-GB-G9 Tower 5	
303		GB-7-G8		25.52	1175	1088.0	1	1.278	見加工圖J857-GB-G9 Tower 5	
304		GB-8-G12a		25.52	942	1088.0	1	1.025	見加工圖J857-GB-G9 Tower 6	
305		GB-8-G3		25.52	1137	1088.0	1	1.237	見加工圖J857-GB-G9 Tower 6	
306		GB-8-G6		25.52	1542	1088.0	1	1.678	見加工圖J857-GB-G9 Tower 6	
307		GB-9-G1		25.52	1637	1088.0	1	1.781	見加工圖J857-GB-G9 Tower 8	
308		GB-9-G11		25.52	1120	1088.0	1	1.219	見加工圖J857-GB-G9 Tower 8	
309		GB-9-G14		25.52	1267	1088.0	1	1.378	見加工圖J857-GB-G9 Tower 8	
310		GB-5-G17		G5a - 12mm FT Low Iron + 1.52PVB+12mm FT Low Iron Laminated (超白) - Sample code: R20220927005	25.52	1275	1088.0	1	1.387	見加工圖J857-GB-G9 Tower 1
311		GB-6-G21a			25.52	942	1088.0	1	1.025	見加工圖J857-GB-G9 Tower 3
312		GB-8-G19a			25.52	942	1088.0	1	1.025	見加工圖J857-GB-G9 Tower 6
313		GB-9-G23			25.52	1521	1088.0	1	1.655	見加工圖J857-GB-G9 Tower 8
314		GB-9-G29a		G5a - 12mm FT Clear + 1.52 PVB + 12mm FT Clear Laminated Sample code: R20210902040	25.52	942	1088.0	1	1.025	見加工圖J857-GB-G9 Tower 8
315		GB-4-G32	25.52		823	1088.0	1	0.895	見加工圖GB-4-G32 Tower 1	
316		GB-4-G33	25.52		1062	1088.0	1	1.155	見加工圖GB-4-G33 Tower 1	
317		GB-4-G34	25.52		1062	1088.0	1	1.155	見加工圖GB-4-G34 Tower 1	
318		GB-4-G35	G11-2 - 10mm FT Clear + 1.52 PVB + 10mm FT Clear Laminated Glass Sample code: R20220602027	25.52	319	1088.0	1	0.347	見加工圖GB-4-G35 Tower 1	
319						小計	373	499.586		
320		GB-10-G1		21.52	80	1039.0	98	8.146	見加工圖GB-10-G1 Tower L	




施哥

 <b>美特鋁質</b> 有限公司 MIDI Aluminum Fabricator Ltd.		<b>工程號:</b> J-857 <b>地盤名稱:</b> 啟德6552 <b>項目類別:</b> 屋頂玻璃欄河	<b>計算:</b> <b>核對:</b> <b>批准:</b>	<b>WYY</b>   	<b>日期:</b> 19/10/2022 <b>日期:</b> <b>日期:</b>	<b>送呈:</b> <b>副本:</b> <b>A/C Code:</b>	<b>施哥</b>	
<b>BM編號:</b>	<b>修改版次:</b> C 21/11/2022	<b>總計玻璃面積 (平方米):</b> 507.731	<b>此BM依據</b>					
<b>序號</b>	<b>修改內容</b>	<b>玻璃圖號</b>	<b>厚度 (mm)</b>	<b>玻璃尺寸</b> <b>寬度 (mm)</b>	<b>高度 (mm)</b>	<b>數量 (塊)</b>	<b>總面積 (平方米)</b>	<b>備注</b>
				<b>小計</b>		<b>98</b>	<b>8.146</b>	
1).本表中所有玻璃對角線尺寸偏差要求不超過正負2mm。 2).本表中所有玻璃要求倒稜角。 3).本表中不同種類玻璃參照玻璃加工圖加工。 4).本表中所有強化玻璃均需HEAT SOAK TEST。 5).本表中所有強化玻璃之入爐方向均以寬度方向進入。 6).本表中所有玻璃成品送交地盤，每次交貨時須齊座、齊款、齊數量，每次來貨之具體數量由地盤管理提供。 7).本表中所有玻璃成品均需注明室內外面及其玻璃編號，以便識別。								

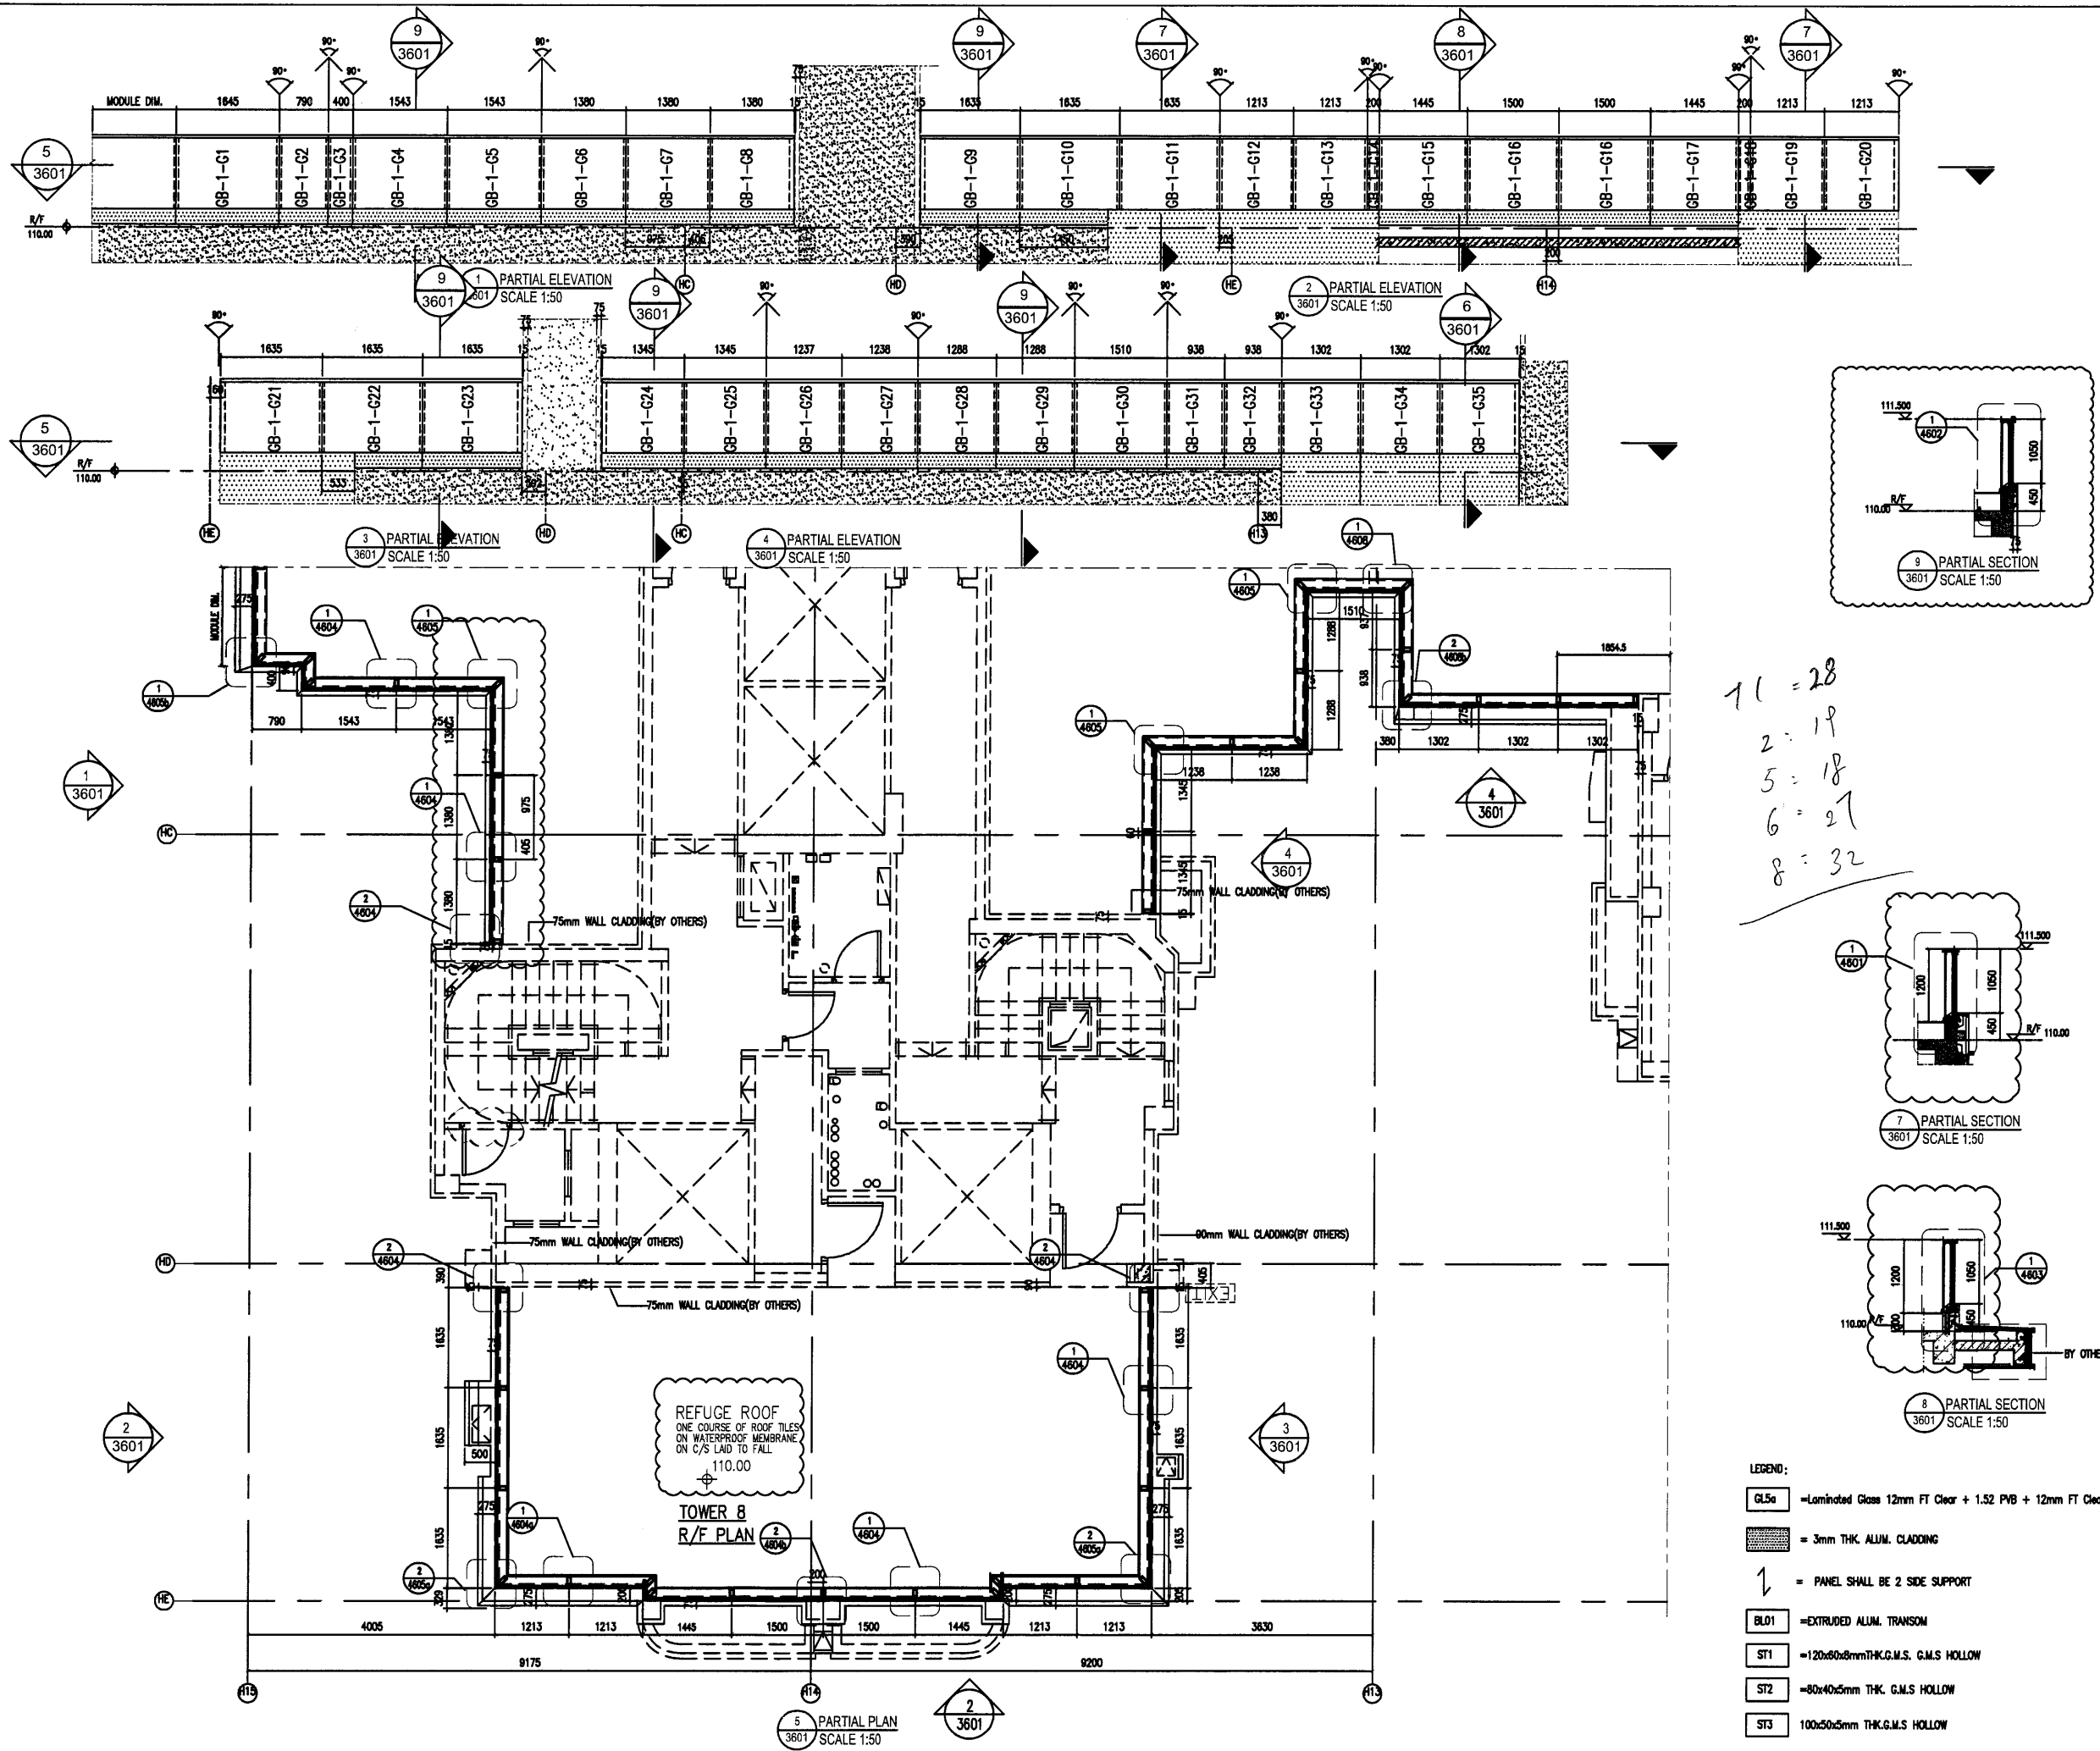


B.D. REF :																															
F.S.D. REF :																															
<b>Note :</b> 1. All dimensions are in mm. 2. All elevations are viewed from outside. 3. All dimensions to be verified on site before fabrication.																															
GENERAL NOTES																															
<b>Legend :</b> 1. F.F.L. --- Finished Floor Level 2. S.F.L. --- Structural Floor Level 3. (Symbol) --- Reversed Detail																															
(X1)	DETAIL MARK NO.																														
(X001)	REFER SHEET NO.																														
<table border="1"> <tr> <td>E 22 Aug 2022</td> <td>6TH SUBMISSION</td> <td></td> <td></td> </tr> <tr> <td>D 01 Aug 2022</td> <td>5TH SUBMISSION</td> <td></td> <td></td> </tr> <tr> <td>C 14 Jul 2022</td> <td>4TH SUBMISSION</td> <td></td> <td></td> </tr> <tr> <td>B 10 May 2022</td> <td>3rd SUBMISSION</td> <td></td> <td></td> </tr> <tr> <td>A 13 Dec 2021</td> <td>2nd SUBMISSION</td> <td></td> <td></td> </tr> <tr> <td>00 18 Oct 2021</td> <td>1ST SUBMISSION</td> <td></td> <td></td> </tr> <tr> <td>REV.</td> <td>DATE</td> <td>DESCRIPTION</td> <td>BY</td> </tr> </table>				E 22 Aug 2022	6TH SUBMISSION			D 01 Aug 2022	5TH SUBMISSION			C 14 Jul 2022	4TH SUBMISSION			B 10 May 2022	3rd SUBMISSION			A 13 Dec 2021	2nd SUBMISSION			00 18 Oct 2021	1ST SUBMISSION			REV.	DATE	DESCRIPTION	BY
E 22 Aug 2022	6TH SUBMISSION																														
D 01 Aug 2022	5TH SUBMISSION																														
C 14 Jul 2022	4TH SUBMISSION																														
B 10 May 2022	3rd SUBMISSION																														
A 13 Dec 2021	2nd SUBMISSION																														
00 18 Oct 2021	1ST SUBMISSION																														
REV.	DATE	DESCRIPTION	BY																												
CLIENT :																															
MARBLE EDGE INVESTMENT LTD.																															
ARCHITECT :																															
 <b>RONALD LU &amp; PARTNERS</b> <small>ARCHITECTS   PLANNERS   INTERIOR DESIGNERS</small>																															
STRUCTURAL ENGINEER :																															
 <b>CMA C M WONG &amp; ASSOCIATES LTD</b> <small>STRUCTURAL ENGINEERS</small>																															
MAIN CONTRACTOR :																															
裕民建築有限公司																															
 <b>MIDI ALUMINIUM FABRICATOR LTD.</b> <small>Units 6-8, Sunray Industrial Centre, 1/F          810 Cha Kwo Ling Road, Kowloon          Tel: 23489211-4 Fax: (852) 27727866</small>																															
PROJECT :																															
PROPOSED RESIDENTIAL DEVELOPMENT AT NEW KOWLOON INLAND LOT. NO. 6552																															
TITLE :																															
PART ELEVATION FOR GLASS BALUSTRADE																															
JOB NO. : J-857																															
DRAWN BY : AN		DATE : 29 AUG 2022																													
CHKD BY :		SCALE A1: 1/50 A3:																													
DWG. NO. : CW-PE-3601		REV. : E																													

11 = 28  
 2 = 19  
 5 = 18  
 6 = 27  
 8 = 32

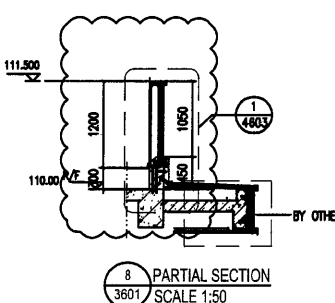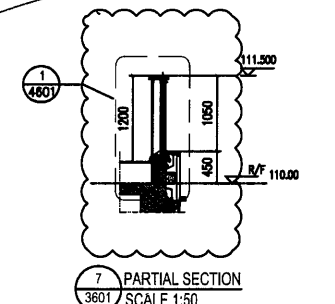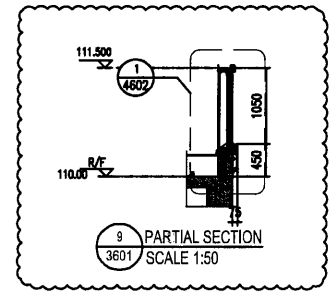


- LEGEND:
- GL5a = Laminated Glass 12mm FT Clear + 1.52 PVB + 12mm FT Clear
  - (Symbol) = 3mm THK. ALUM. CLADDING
  - (Symbol) = PANEL SHALL BE 2 SIDE SUPPORT
  - BLD1 = EXTRUDED ALUM. TRANSOM
  - ST1 = 120x60x8mm THK. G.M.S. G.M.S. HOLLOW
  - ST2 = 80x40x5mm THK. G.M.S. HOLLOW
  - ST3 = 100x50x5mm THK. G.M.S. HOLLOW

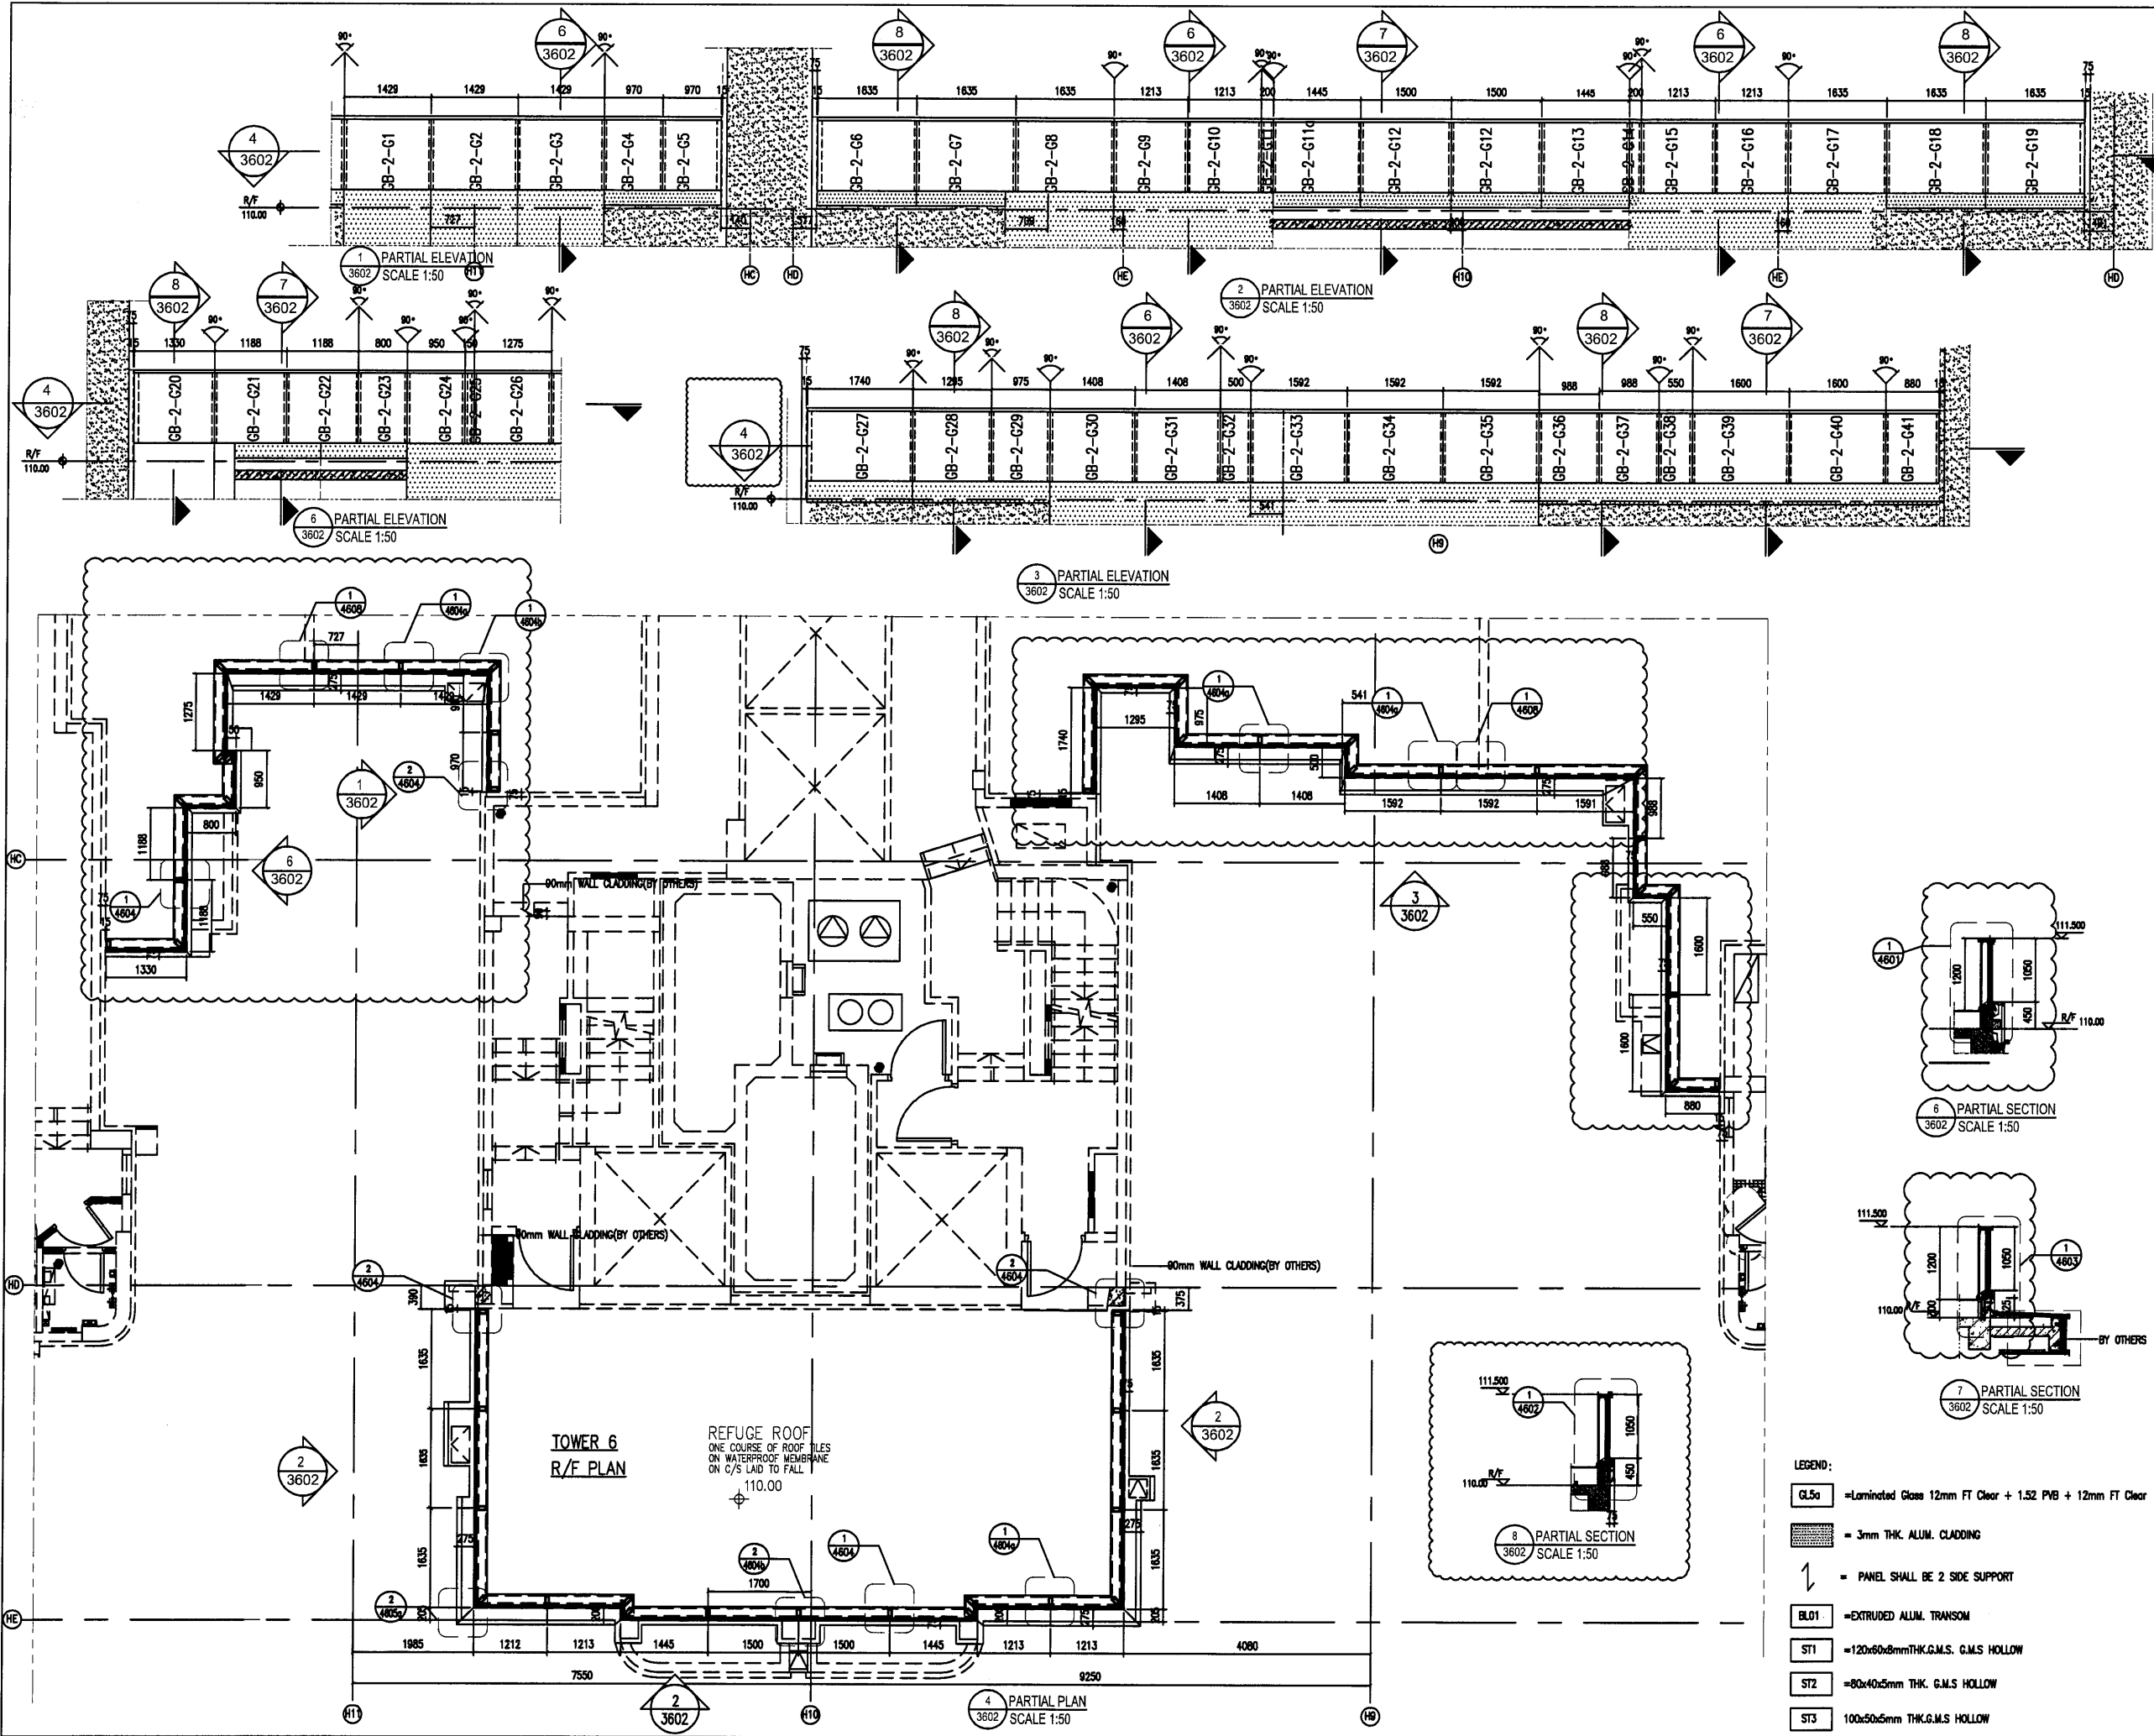


B.D. REF :																															
F.S.D. REF :																															
Note :																															
1. All dimensions are in mm.																															
2. All elevations are viewed from outside.																															
3. All dimensions to be verified on site before fabrication.																															
GENERAL NOTES																															
Legend :																															
1. F.F.L. --- Finished Floor Level																															
2. S.F.L. --- Structural Floor Level																															
3. (R) --- Reversed Detail																															
(X1)		DETAIL MARK NO.																													
(X001)		REFER SHEET NO.																													
<table border="1"> <tr> <td>REV.</td> <td>DATE</td> <td>DESCRIPTION</td> <td>BY</td> </tr> <tr> <td>E</td> <td>22 Aug. 2022</td> <td>6TH SUBMISSION</td> <td></td> </tr> <tr> <td>D</td> <td>01 Aug. 2022</td> <td>5TH SUBMISSION</td> <td></td> </tr> <tr> <td>C</td> <td>14 Jul. 2022</td> <td>4TH SUBMISSION</td> <td></td> </tr> <tr> <td>B</td> <td>10 May. 2022</td> <td>3rd SUBMISSION</td> <td></td> </tr> <tr> <td>A</td> <td>13 Dec. 2021</td> <td>2nd SUBMISSION</td> <td></td> </tr> <tr> <td>00</td> <td>18 Oct. 2021</td> <td>1ST SUBMISSION</td> <td></td> </tr> </table>				REV.	DATE	DESCRIPTION	BY	E	22 Aug. 2022	6TH SUBMISSION		D	01 Aug. 2022	5TH SUBMISSION		C	14 Jul. 2022	4TH SUBMISSION		B	10 May. 2022	3rd SUBMISSION		A	13 Dec. 2021	2nd SUBMISSION		00	18 Oct. 2021	1ST SUBMISSION	
REV.	DATE	DESCRIPTION	BY																												
E	22 Aug. 2022	6TH SUBMISSION																													
D	01 Aug. 2022	5TH SUBMISSION																													
C	14 Jul. 2022	4TH SUBMISSION																													
B	10 May. 2022	3rd SUBMISSION																													
A	13 Dec. 2021	2nd SUBMISSION																													
00	18 Oct. 2021	1ST SUBMISSION																													
CLIENT :																															
MARBLE EDGE INVESTMENT LTD.																															
ARCHITECT :																															
 RONALD LU & PARTNERS ARCHITECTS   PLANNERS   INTERIOR DESIGNERS																															
STRUCTURAL ENGINEER :																															
 C M WONG & ASSOCIATES LTD <small>THE HONG KONG INSTITUTE OF PROFESSIONAL ENGINEERS</small>																															
MAIN CONTRACTOR :																															
裕民建築有限公司																															
 美特鋁質有限公司 MIDI ALUMINIUM FABRICATOR LTD. Units 6-8, Sunray Industrial Centre, 1/F 810 Cha Kwo Ling Road, Kowloon Tel: 23489211-4 Fax: (852) 27727666																															
PROJECT :																															
PROPOSED RESIDENTIAL DEVELOPMENT AT NEW KOWLOON INLAND LOT. NO. 6552																															
TITLE :																															
PART ELEVATION FOR GLASS BALUSTRADE																															
JOB NO. : J-857																															
DRAWN BY : AN		DATE : 29 AUG. 2022																													
CHKD BY :		SCALE A1: 1/50 A3:																													
DWG. NO. : CW-PE-3602		REV. : E																													

- LEGEND:
- = Laminated Glass 12mm FT Clear + 1.52 PVB + 12mm FT Clear
  - = 3mm THK. ALUM. CLADDING
  - = PANEL SHALL BE 2 SIDE SUPPORT
  - = BLD1 = EXTRUDED ALUM. TRANSOM
  - = ST1 = 120x60x8mm THK. G.M.S. HOLLOW
  - = ST2 = 80x40x5mm THK. G.M.S. HOLLOW
  - = ST3 = 100x50x5mm THK. G.M.S. HOLLOW

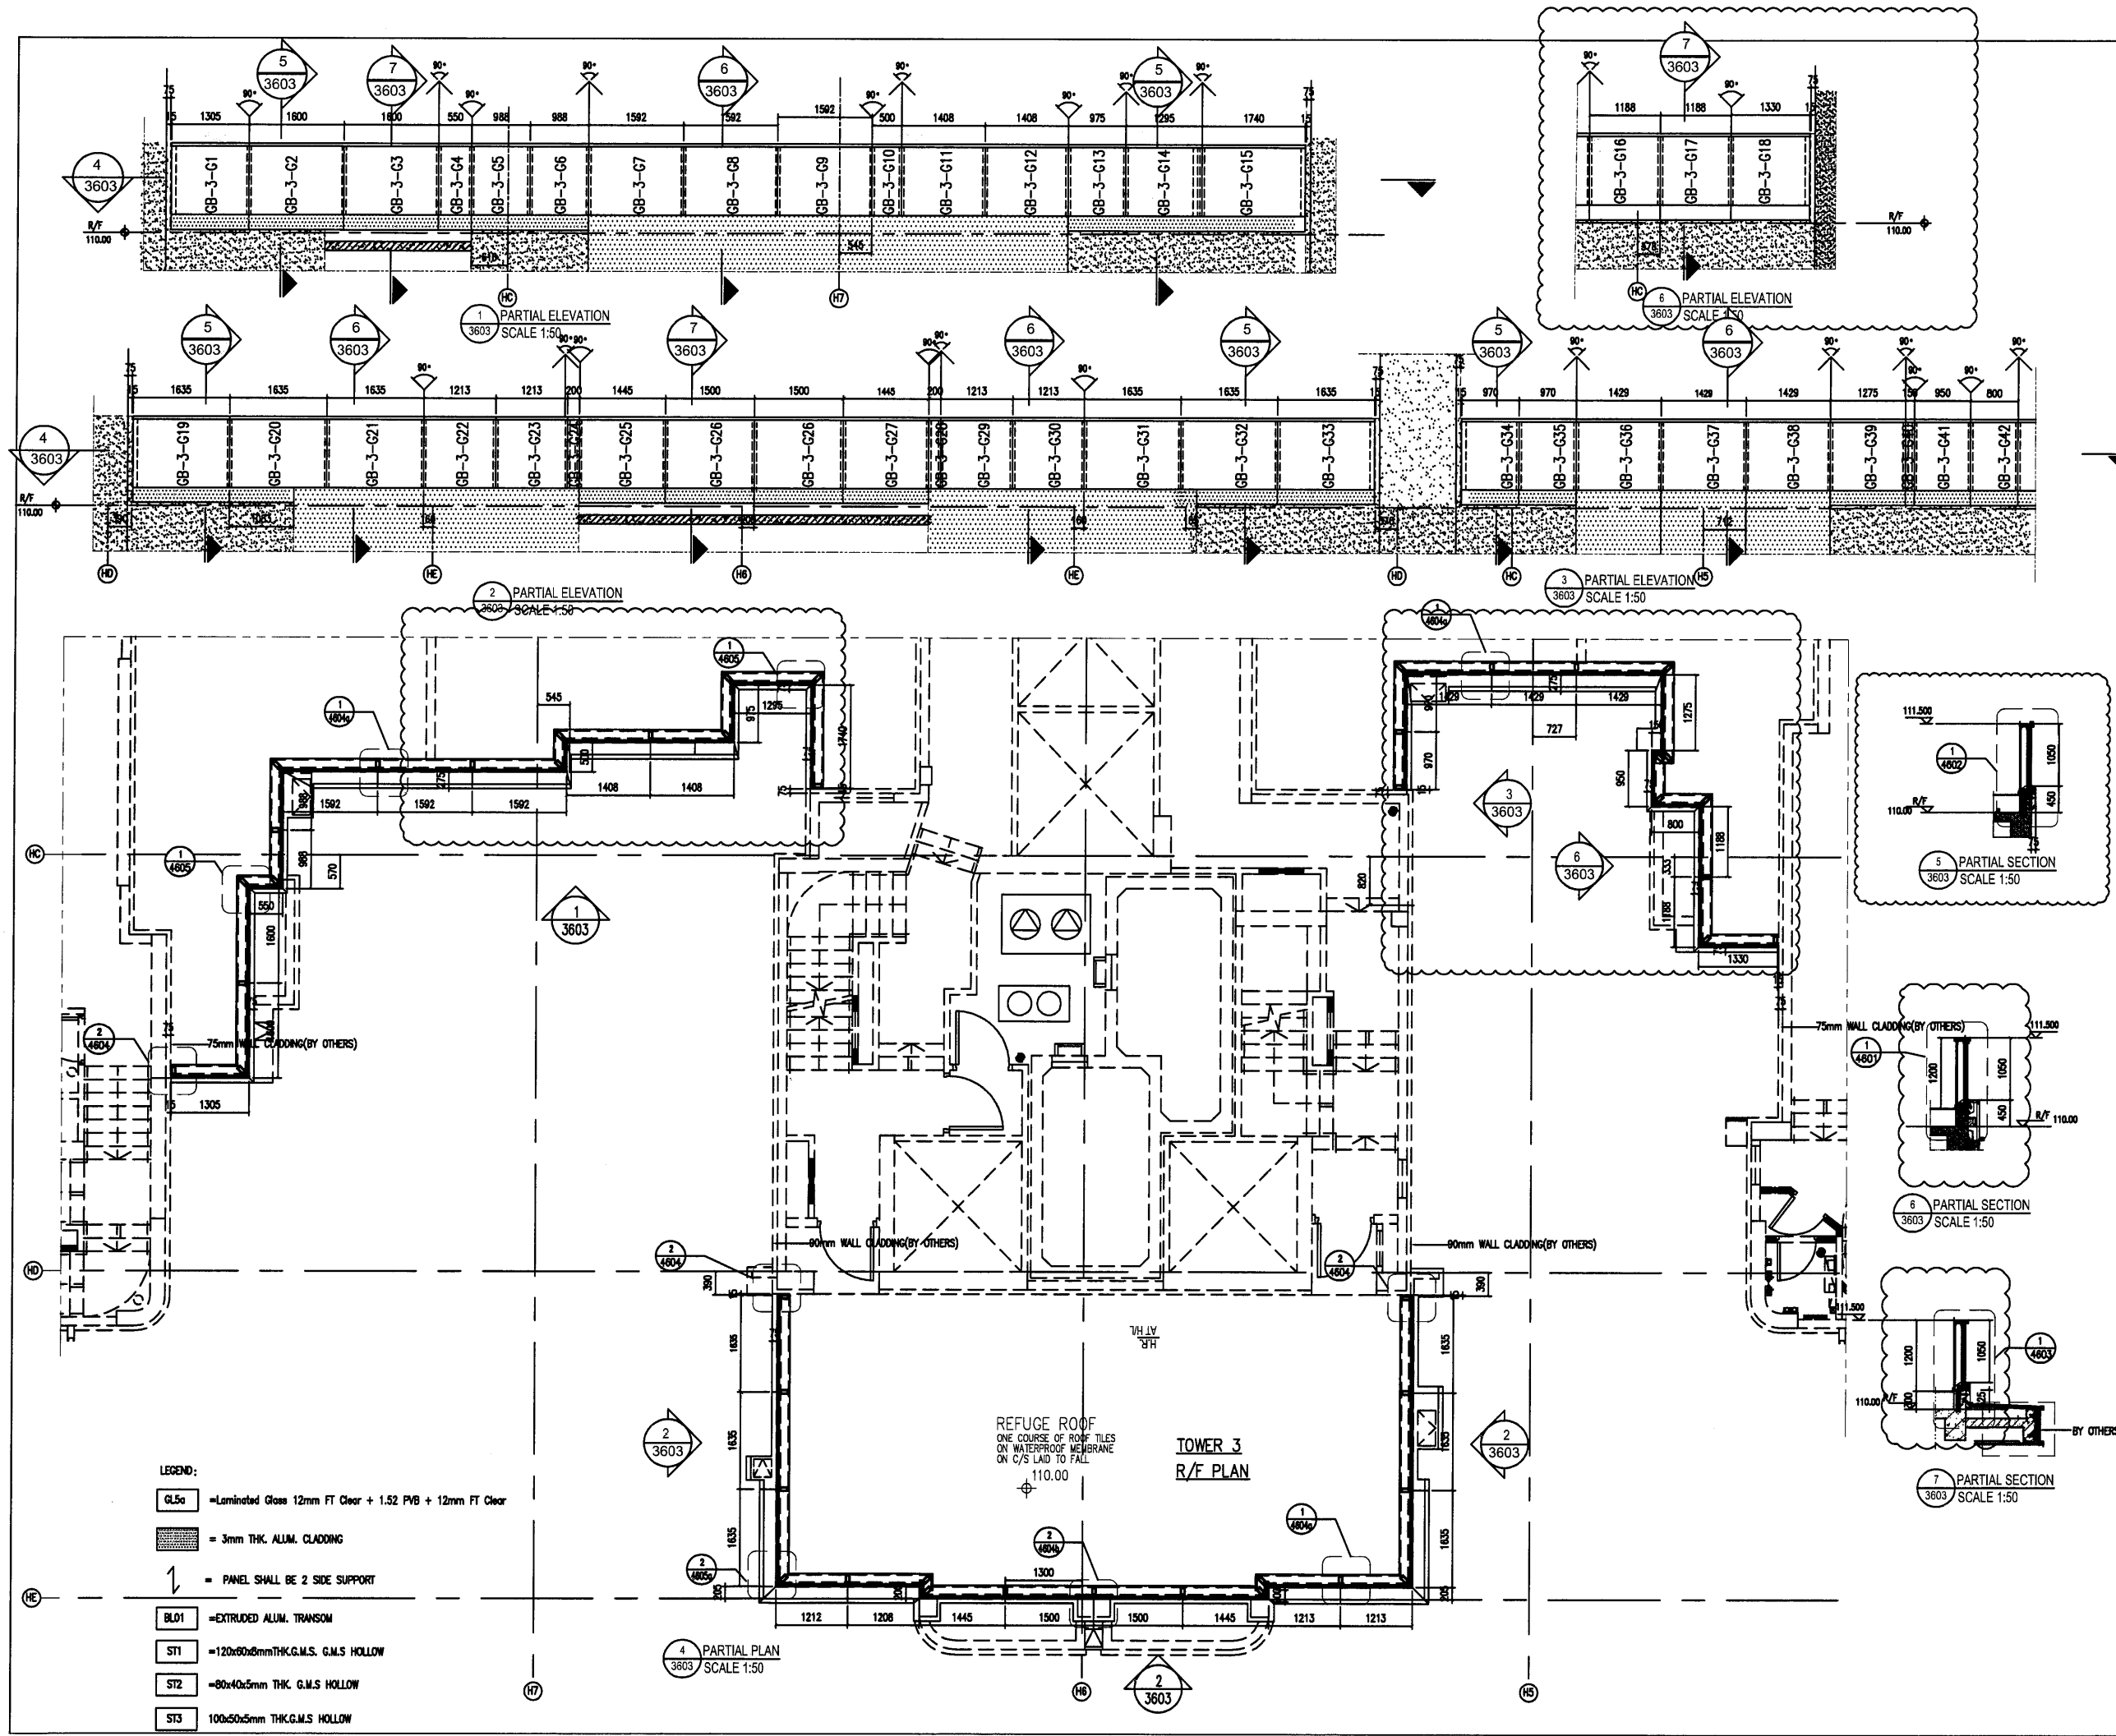

B.D. REF :		
F.S.D. REF :		
<b>Note :</b> 1.All dimensions are in mm. 2.All elevations are viewed from outside. 3.All dimensions to be verified on site before fabrication.		
GENERAL NOTES		
<b>Legend :</b> 1. F.F.L.— Finished Floor Level 2. S.F.L.— Structural Floor Level 3. (R) — Reversed Detail		
(X1)	DETAIL MARK NO.	
(X001)	REFER SHEET NO.	
CLIENT : <b>MARBLE EDGE INVESTMENT LTD.</b>		
ARCHITECT : <b>RONALD LU &amp; PARTNERS</b> ARCHITECTS   PLANNERS   INTERIOR DESIGNERS		
STRUCTURAL ENGINEER : <b>CMA C M WONG &amp; ASSOCIATES LTD</b> TEL: (852) 2922 1998 Email: cma@cmawong.com		
MAIN CONTRACTOR : <b>裕民建築有限公司</b>		
<b>美特鋁質有限公司</b> <b>MIDI ALUMINIUM FABRICATOR LTD.</b> Units 6-8, Sunray Industrial Centre, 1/F 610 Cha Kwo Ling Road, Kowloon Tel: 23489211-4 Fax: (852) 27727666		
PROJECT : PROPOSED RESIDENTIAL DEVELOPMENT AT NEW KOWLOON INLAND LOT. NO.6552		
TITLE : PART ELEVATION FOR GLASS BALUSTRADE		
JOB NO. : J-857		
DRAWN BY : AN	DATE : 29.AUG.2022	
CHKD BY :	SCALE A1: 1/50 A3:	
DWG. NO. : CW-PE-3603	REV. : E	

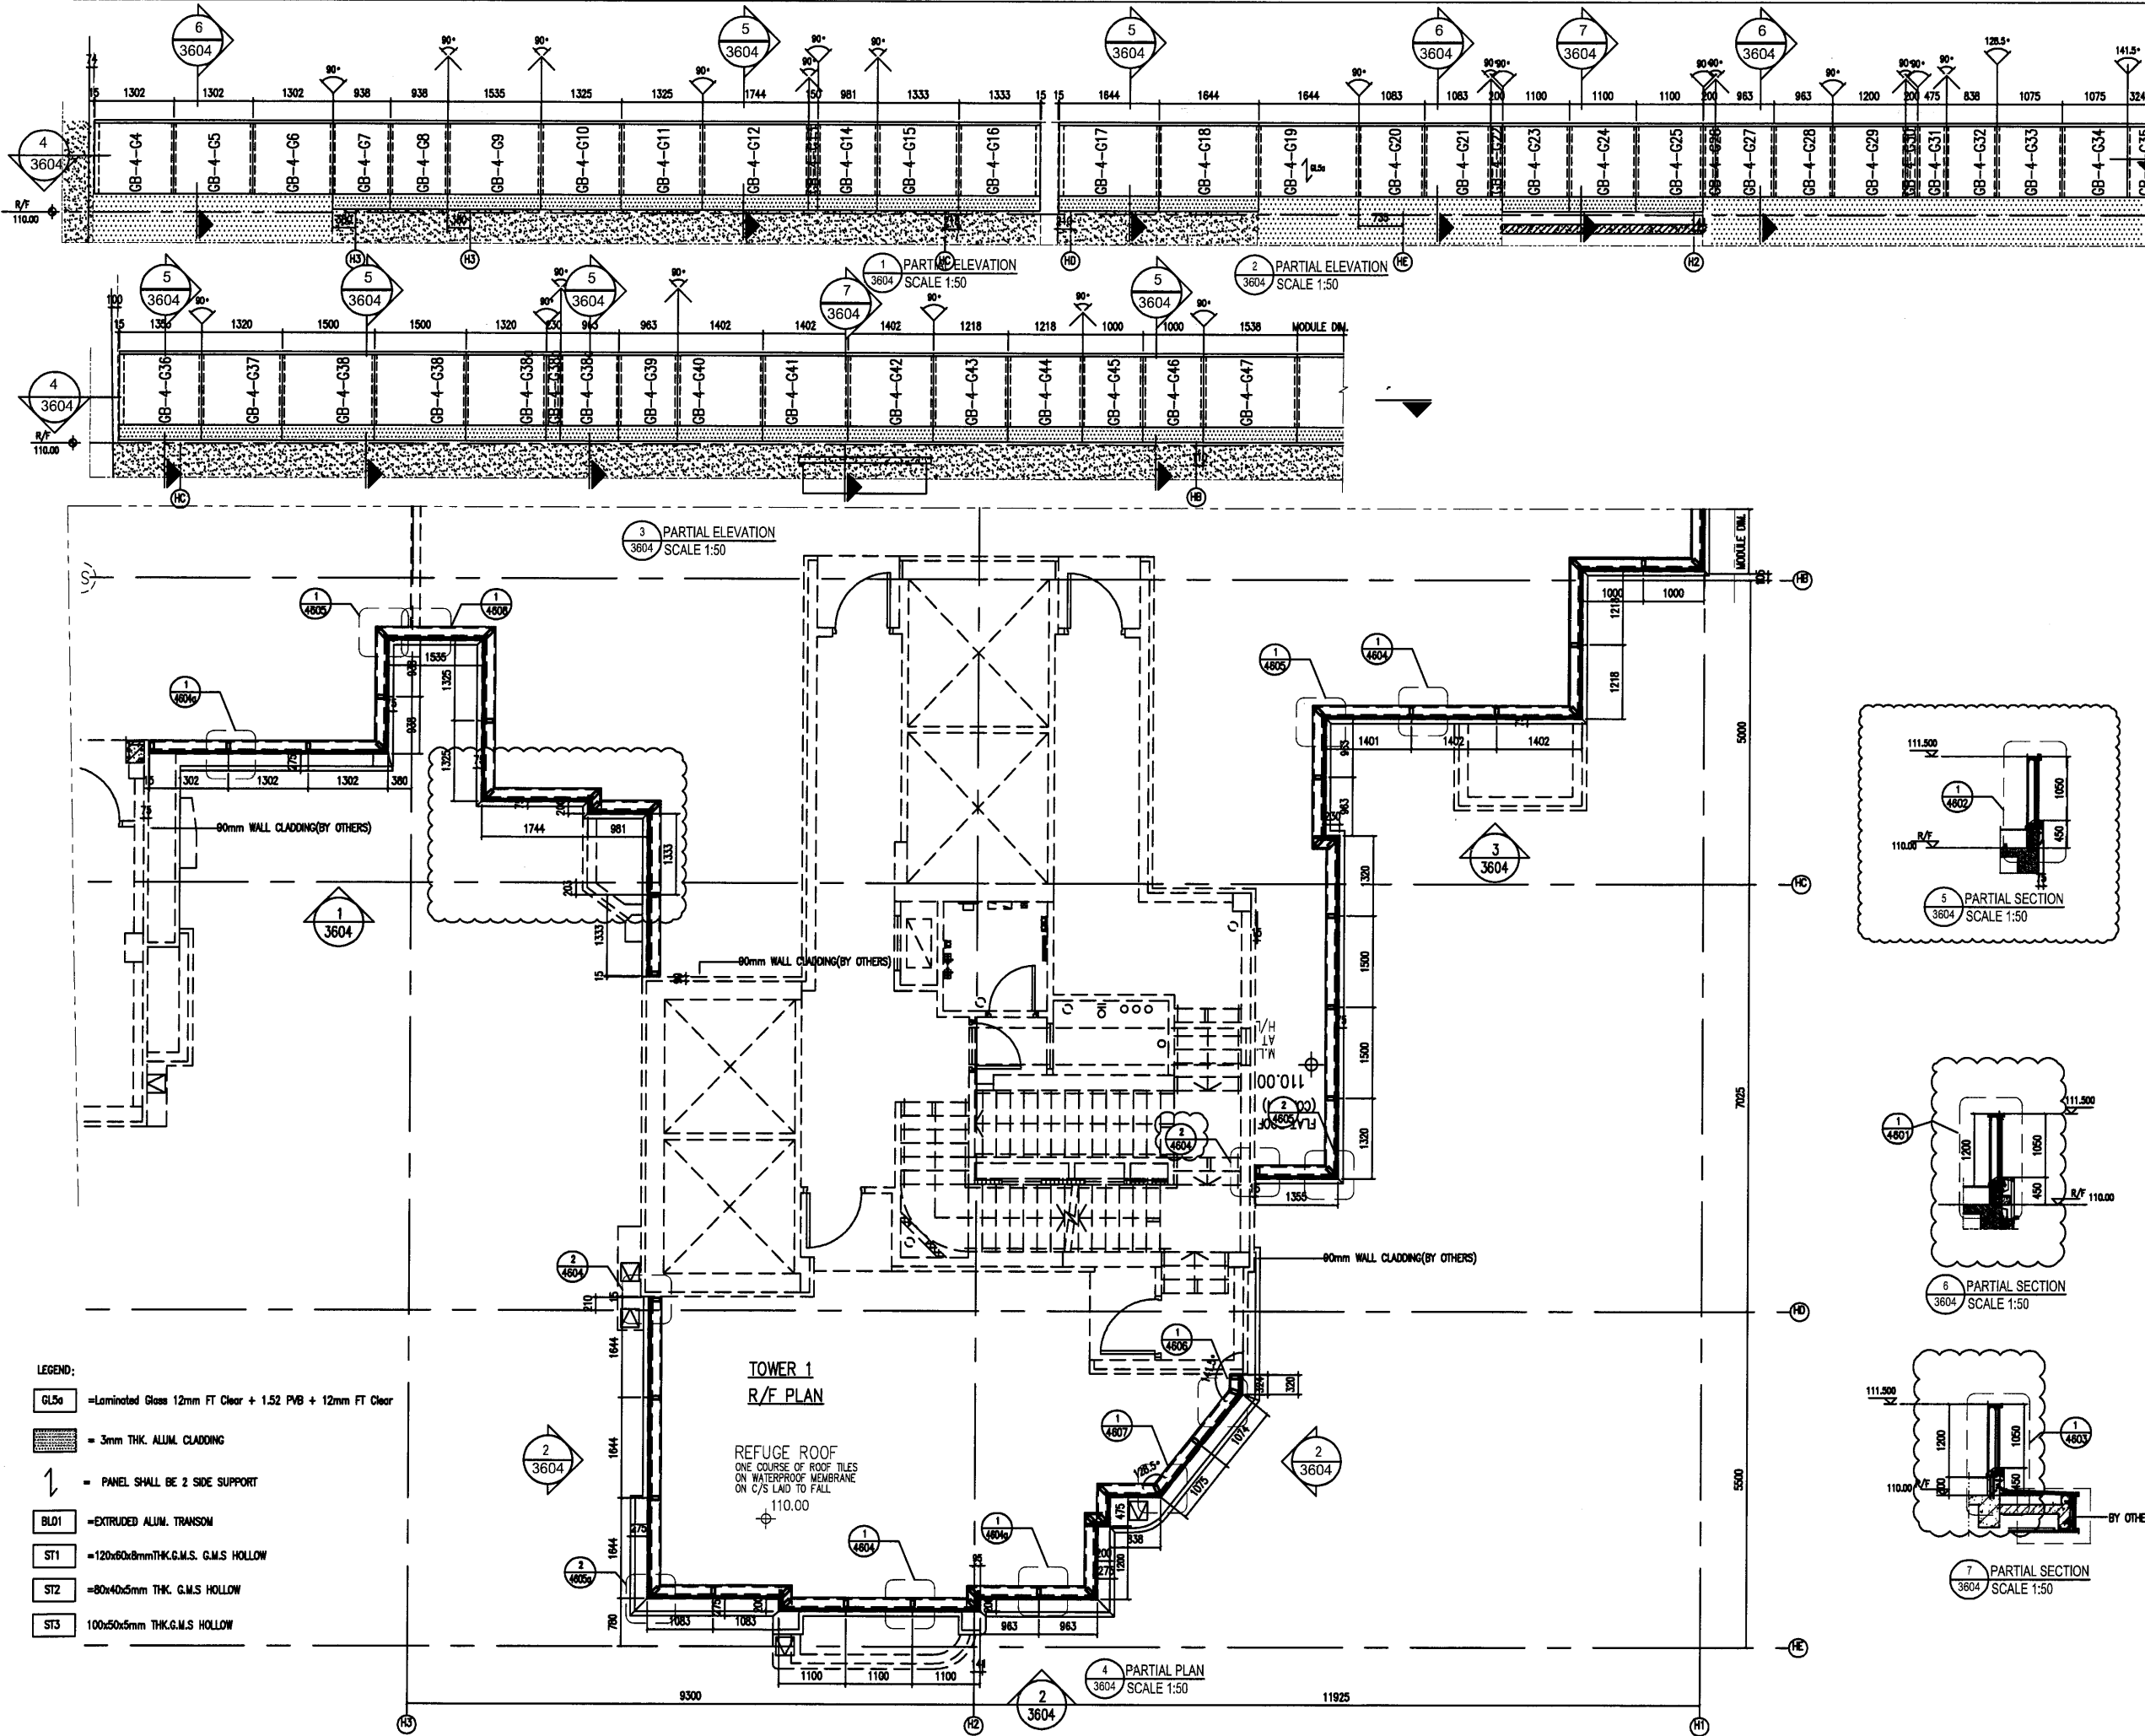

B.D. REF :  
 F.S.D. REF :  
 Note:  
 1. All dimensions are in mm.  
 2. All elevations are viewed from outside.  
 3. All dimensions to be verified on site before fabrication.

GENERAL NOTES

- Legend:  
 1. F.F.L. --- Finished Floor Level  
 2. S.F.L. --- Structural Floor Level  
 3. (R) --- Reversed Detail

(X1) --- DETAIL MARK NO.  
 (X001) --- REFER SHEET NO.

REV.	DATE	DESCRIPTION	BY
E	22 Aug. 2022	6TH SUBMISSION	
D	01 Aug. 2022	5TH SUBMISSION	
C	14 Jul. 2022	4TH SUBMISSION	
B	10 May. 2022	3rd SUBMISSION	
A	13 Dec. 2021	2nd SUBMISSION	
00	18 Oct. 2021	1ST SUBMISSION	

CLIENT :  
 MARBLE EDGE INVESTMENT LTD.

ARCHITECT :  

 RONALD LU & PARTNERS  
 ARCHITECTS | PLANNERS | INTERIOR DESIGNERS

STRUCTURAL ENGINEER :  

 C M WONG & ASSOCIATES LTD  
 TEL: (852) 3022 1888  
 Email: cmwong@cma.com.hk

MAIN CONTRACTOR :  
 裕民建築有限公司


美特鋁質有限公司  
 MIDI ALUMINIUM FABRICATOR LTD.  
 Units 6-8, Sunray Industrial Centre, 1/F  
 610 Cha Kwo Ling Road, Kowloon  
 Tel: 23489211-4 Fax: (852) 27727666

PROJECT :  
 PROPOSED RESIDENTIAL DEVELOPMENT AT NEW KOWLOON INLAND LOT. NO.6552

TITLE :  
 PART ELEVATION FOR GLASS BALUSTRADE

JOB NO. : J-857  
 DRAWN BY : AN DATE : 29 AUG. 2022  
 CHKD BY : SCALE A1: 1/50 A3:  
 DWG. NO. : CW-PE-3604 REV. : E

# CW-PE-3605

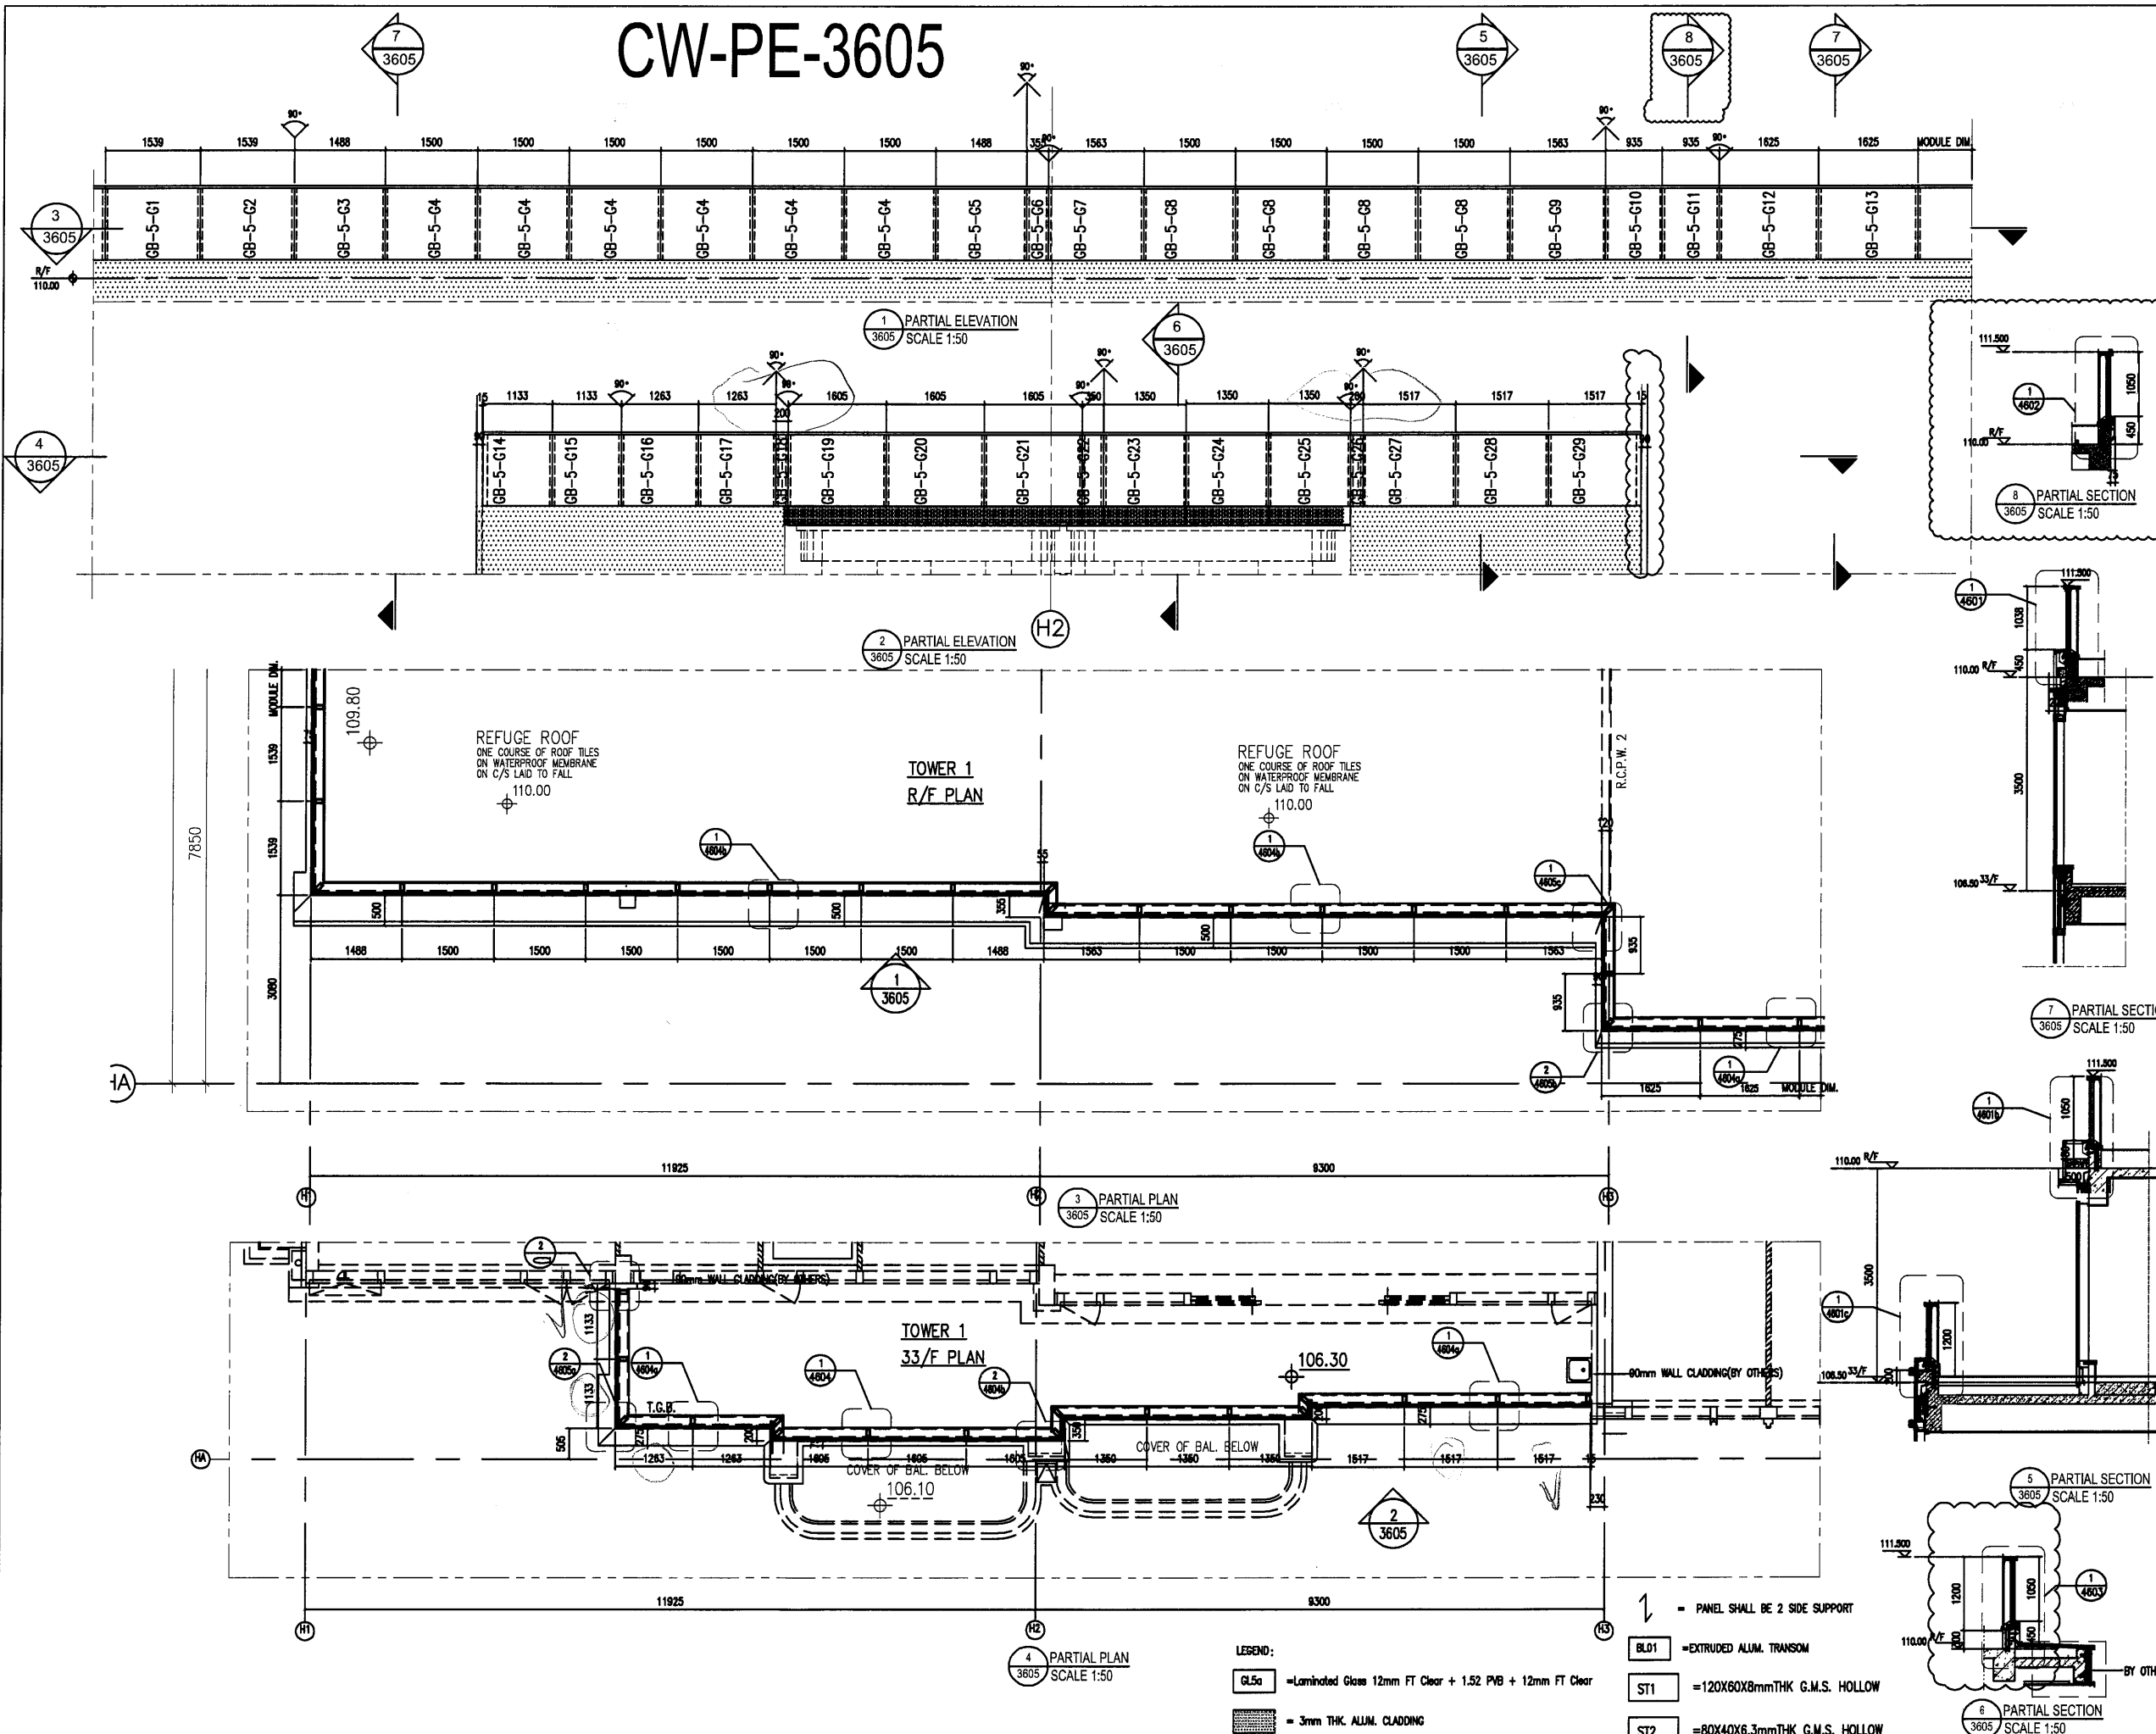

**B.D. REF :**  
**F.S.D. REF :**  
**Note :**  
 1. All dimensions are in mm.  
 2. All elevations are viewed from outside.  
 3. All dimensions to be verified on site before fabrication.

**GENERAL NOTES**

**Legend :**  
 1. F.F.L. --- Finished Floor Level  
 2. S.F.L. --- Structural Floor Level  
 3. (Symbol) --- Reversed Detail

**X1** --- DETAIL MARK NO.  
**X001** --- REFER SHEET NO.

REV.	DATE	DESCRIPTION	BY
E	22 Aug. 2022	6TH SUBMISSION	
D	01 Aug. 2022	5TH SUBMISSION	
C	14 Jul. 2022	4TH SUBMISSION	
B	10 May. 2022	3rd SUBMISSION	
A	13 Dec. 2021	2nd SUBMISSION	
00	18 Oct. 2021	1ST SUBMISSION	

**CLIENT :**  
 MARBLE EDGE INVESTMENT LTD.

**ARCHITECT :**  
**RONALD LU & PARTNERS**  
 ARCHITECTS | PLANNERS | INTERIOR DESIGNERS

**STRUCTURAL ENGINEER :**  
**CMA C M WONG & ASSOCIATES LTD**  
 TEL: (852) 2422 3868  
 Email: cma@cma.com.hk

**MAIN CONTRACTOR :**  
 裕民建築有限公司





**美特鋁質有限公司**  
**MIDI ALUMINIUM FABRICATOR LTD.**  
 Units 6-8, Sunray Industrial Centre, 1/F  
 610 Cha Kwo Ling Road, Kowloon  
 Tel: 23489211-4 Fax: (852) 27727666

**PROJECT :**  
 PROPOSED RESIDENTIAL DEVELOPMENT AT NEW KOWLOON INLAND LOT. NO. 6552

**TITLE :**  
 PART ELEVATION FOR GLASS BALUSTRADE

**JOB NO. :** J-857  
**DATE :** 28.AUG.2022  
**DRAWN BY :** AN  
**DATE :** 28.AUG.2022  
**CHKD BY :**  
**SCALE :** A1: 1/50  
 A3:  
**DWG. NO. :** CW-PE-3605  
**REV. :** E

- LEGEND:**
- GL5a = Laminated Glass 12mm FT Clear + 1.52 PVB + 12mm FT Clear
  - BLD1 = EXTRUDED ALUM. TRANSOM
  - ST1 = 120X60X8mmTHK G.M.S. HOLLOW
  - ST2 = 80X40X6.3mmTHK G.M.S. HOLLOW
  - 1 = PANEL SHALL BE 2 SIDE SUPPORT
  - 3mm THK. ALUM. CLADDING

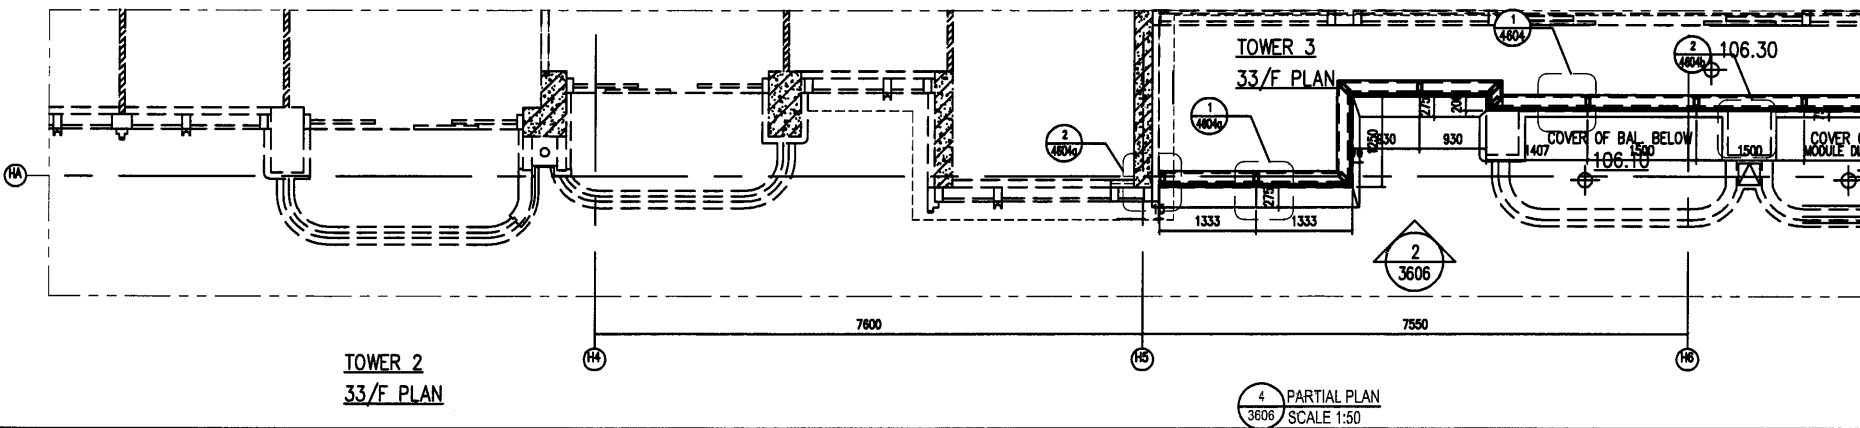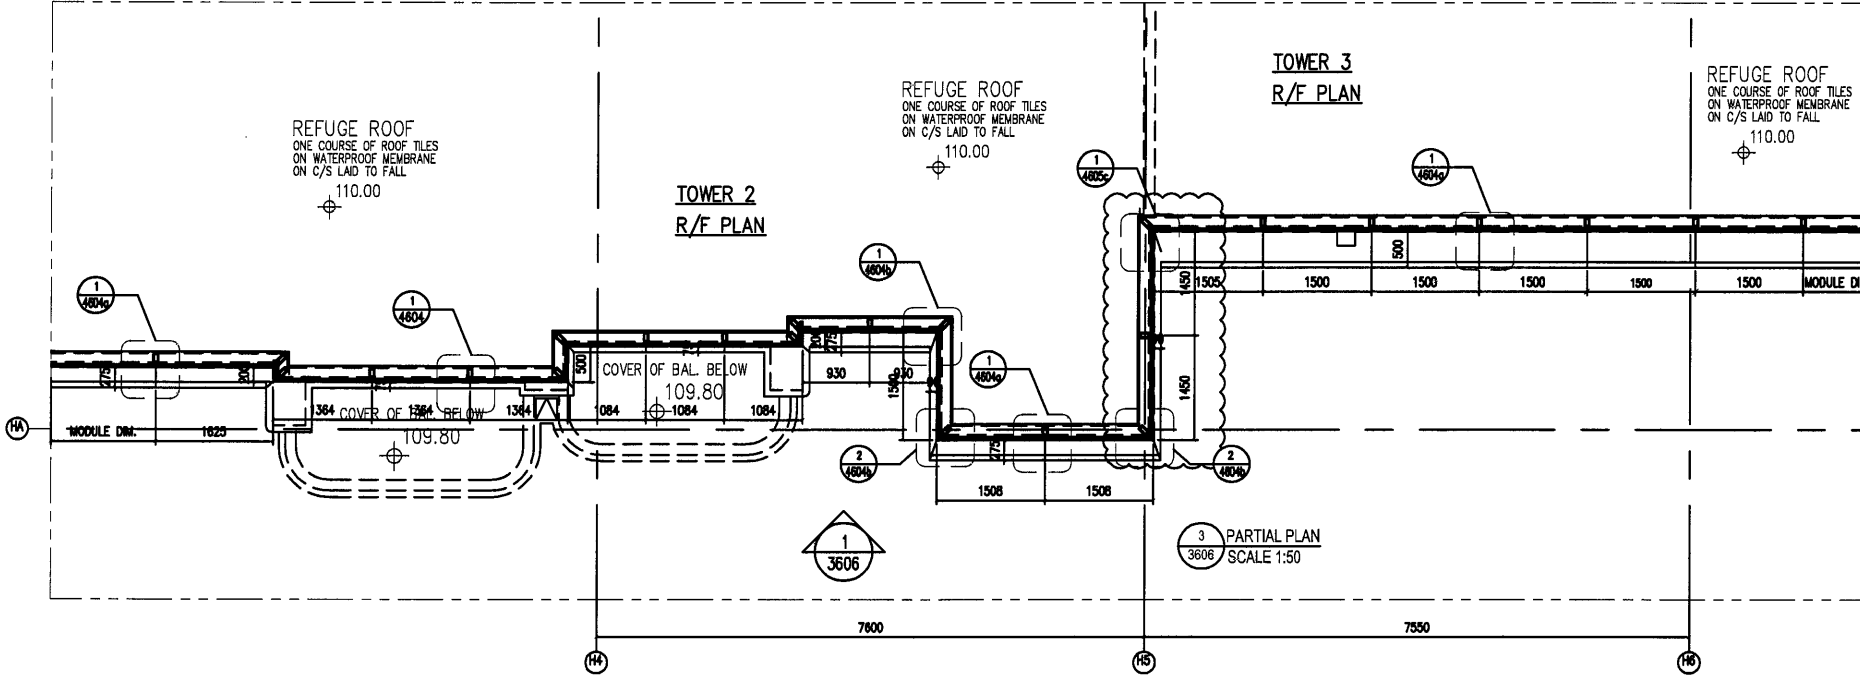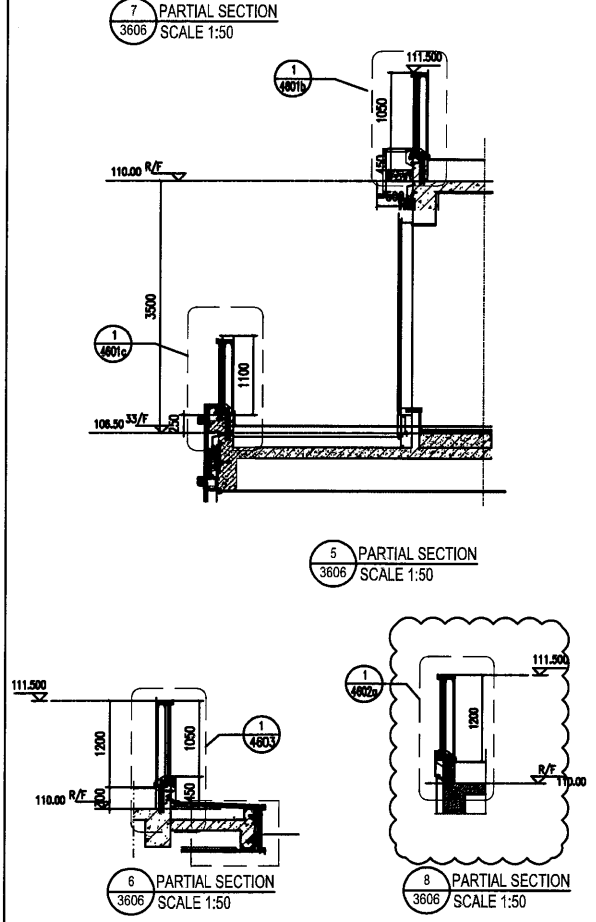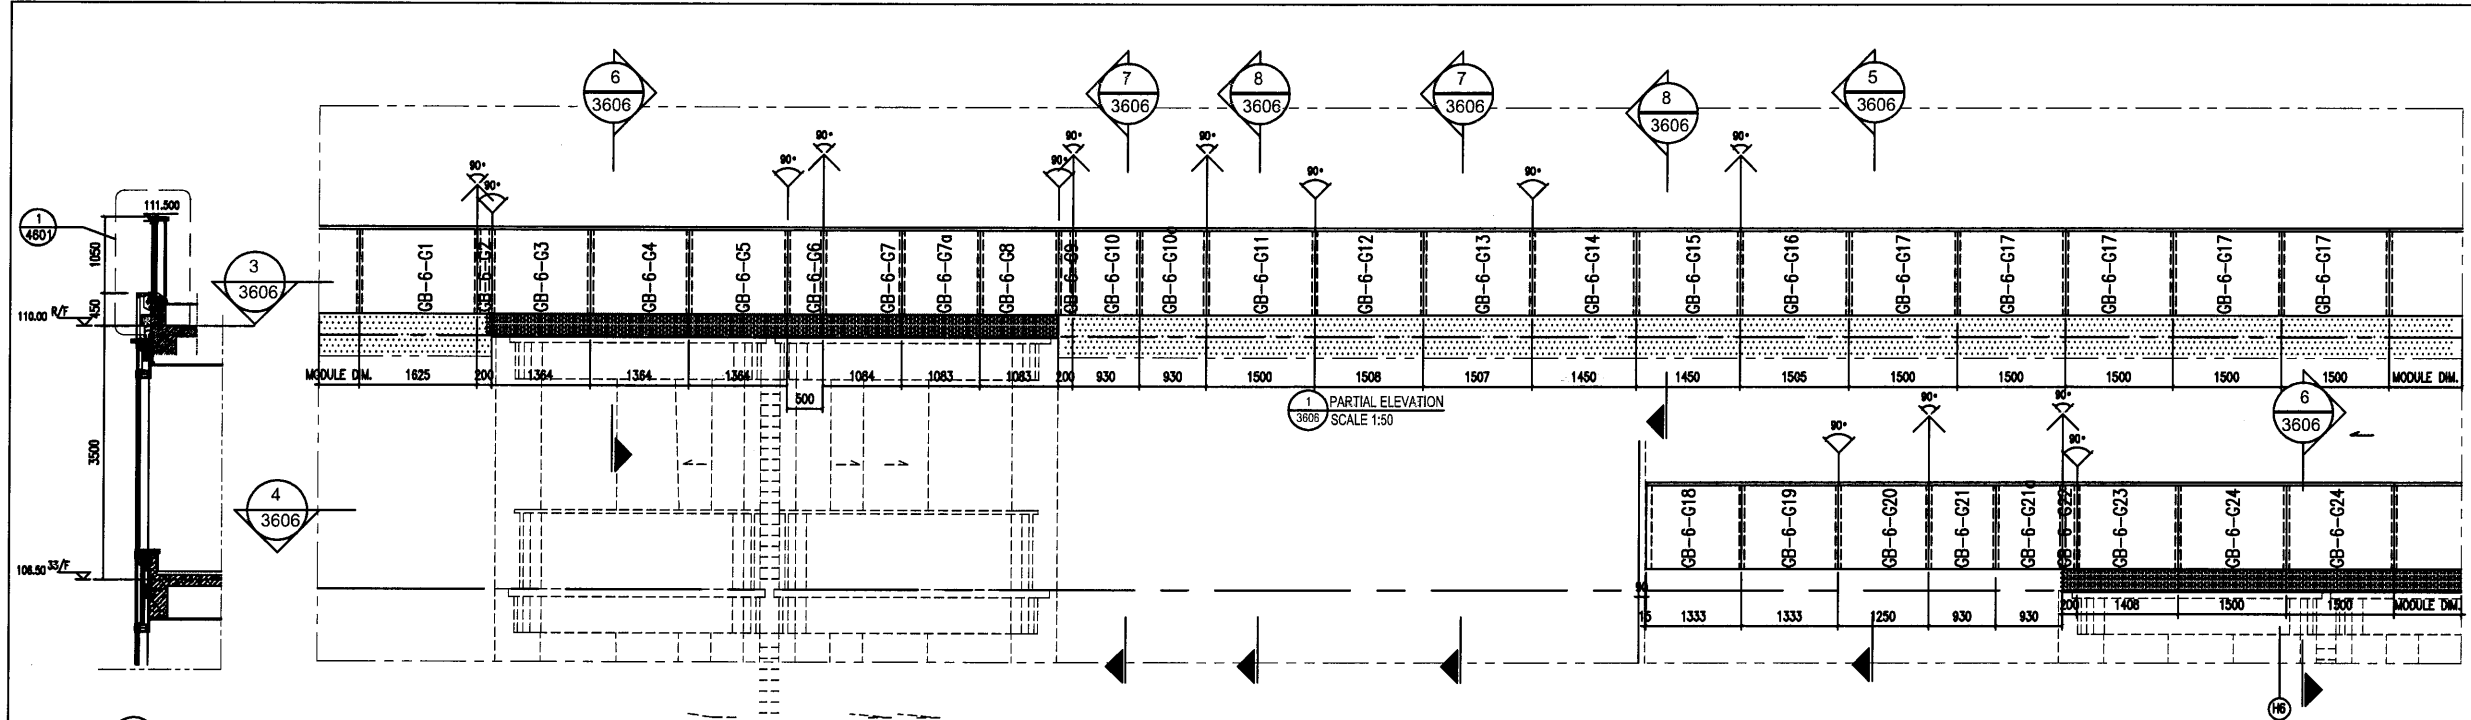

- LEGEND:**
- GL5a = Laminated Glass 12mm FT Clear + 1.52 PVB + 12mm FT Clear
  - 3mm THK ALUM. CLADDING
  - PANEL SHALL BE 2 SIDE SUPPORT
  - BL01 = EXTRUDED ALUM. TRANSOM
  - ST1 = 120x60x8mm THK G.M.S. G.M.S. HOLLOW
  - ST2 = 80x40x5mm THK G.M.S. HOLLOW
  - ST3 = 100x50x5mm THK G.M.S. HOLLOW

B.D. REF :  
 F.S.D. REF :  
**Note :**  
 1. All dimensions are in mm.  
 2. All elevations are viewed from outside.  
 3. All dimensions to be verified on site before fabrication.

**GENERAL NOTES**

**Legend :**

1. F.F.L. --- Finished Floor Level
2. S.F.L. --- Structural Floor Level
3. (Symbol) --- Reversed Detail

X1 --- DETAIL MARK NO.  
 X001 --- REFER SHEET NO.

E 22 Aug.2022	6TH SUBMISSION		
D 01 Aug.2022	5TH SUBMISSION		
C 14 Jul.2022	4TH SUBMISSION		
B 10 May.2022	3rd SUBMISSION		
A 13 Dec.2021	2nd SUBMISSION		
00 18 Oct.2021	1ST SUBMISSION		
REV.	DATE	DESCRIPTION	BY

**CLIENT :**  
 MARBLE EDGE INVESTMENT LTD.

**ARCHITECT :**  
 RONALD LU & PARTNERS  
 ARCHITECTS | PLANNERS | INTERIOR DESIGNERS

**STRUCTURAL ENGINEER :**  
 CMA C M WONG & ASSOCIATES LTD  
 110-1002-1001-1006  
 110-1002-1001-1006


**MAIN CONTRACTOR :**  
 裕民建築有限公司

**美特鋁質有限公司**  
 MIDI ALUMINIUM FABRICATOR LTD.  
 Units 6-8, Sunray Industrial Centre, 1/F  
 810 Cha Kwo Ling Road, Kowloon  
 Tel:23489211-4 Fax:(852)27727666

**PROJECT :**  
 PROPOSED RESIDENTIAL DEVELOPMENT AT NEW KOWLOON INLAND LOT. NO.6552

**TITLE :**  
 PART ELEVATION FOR GLASS BALUSTRADE

**JOB NO. :** J-857  
**DRAWN BY :** AN **DATE :** 29.AUG.2022  
**CHKD BY :** **SCALE :** A1: 1/50 A3:  
**DWG. NO. :** CW-PE-3606 **REV. :** E

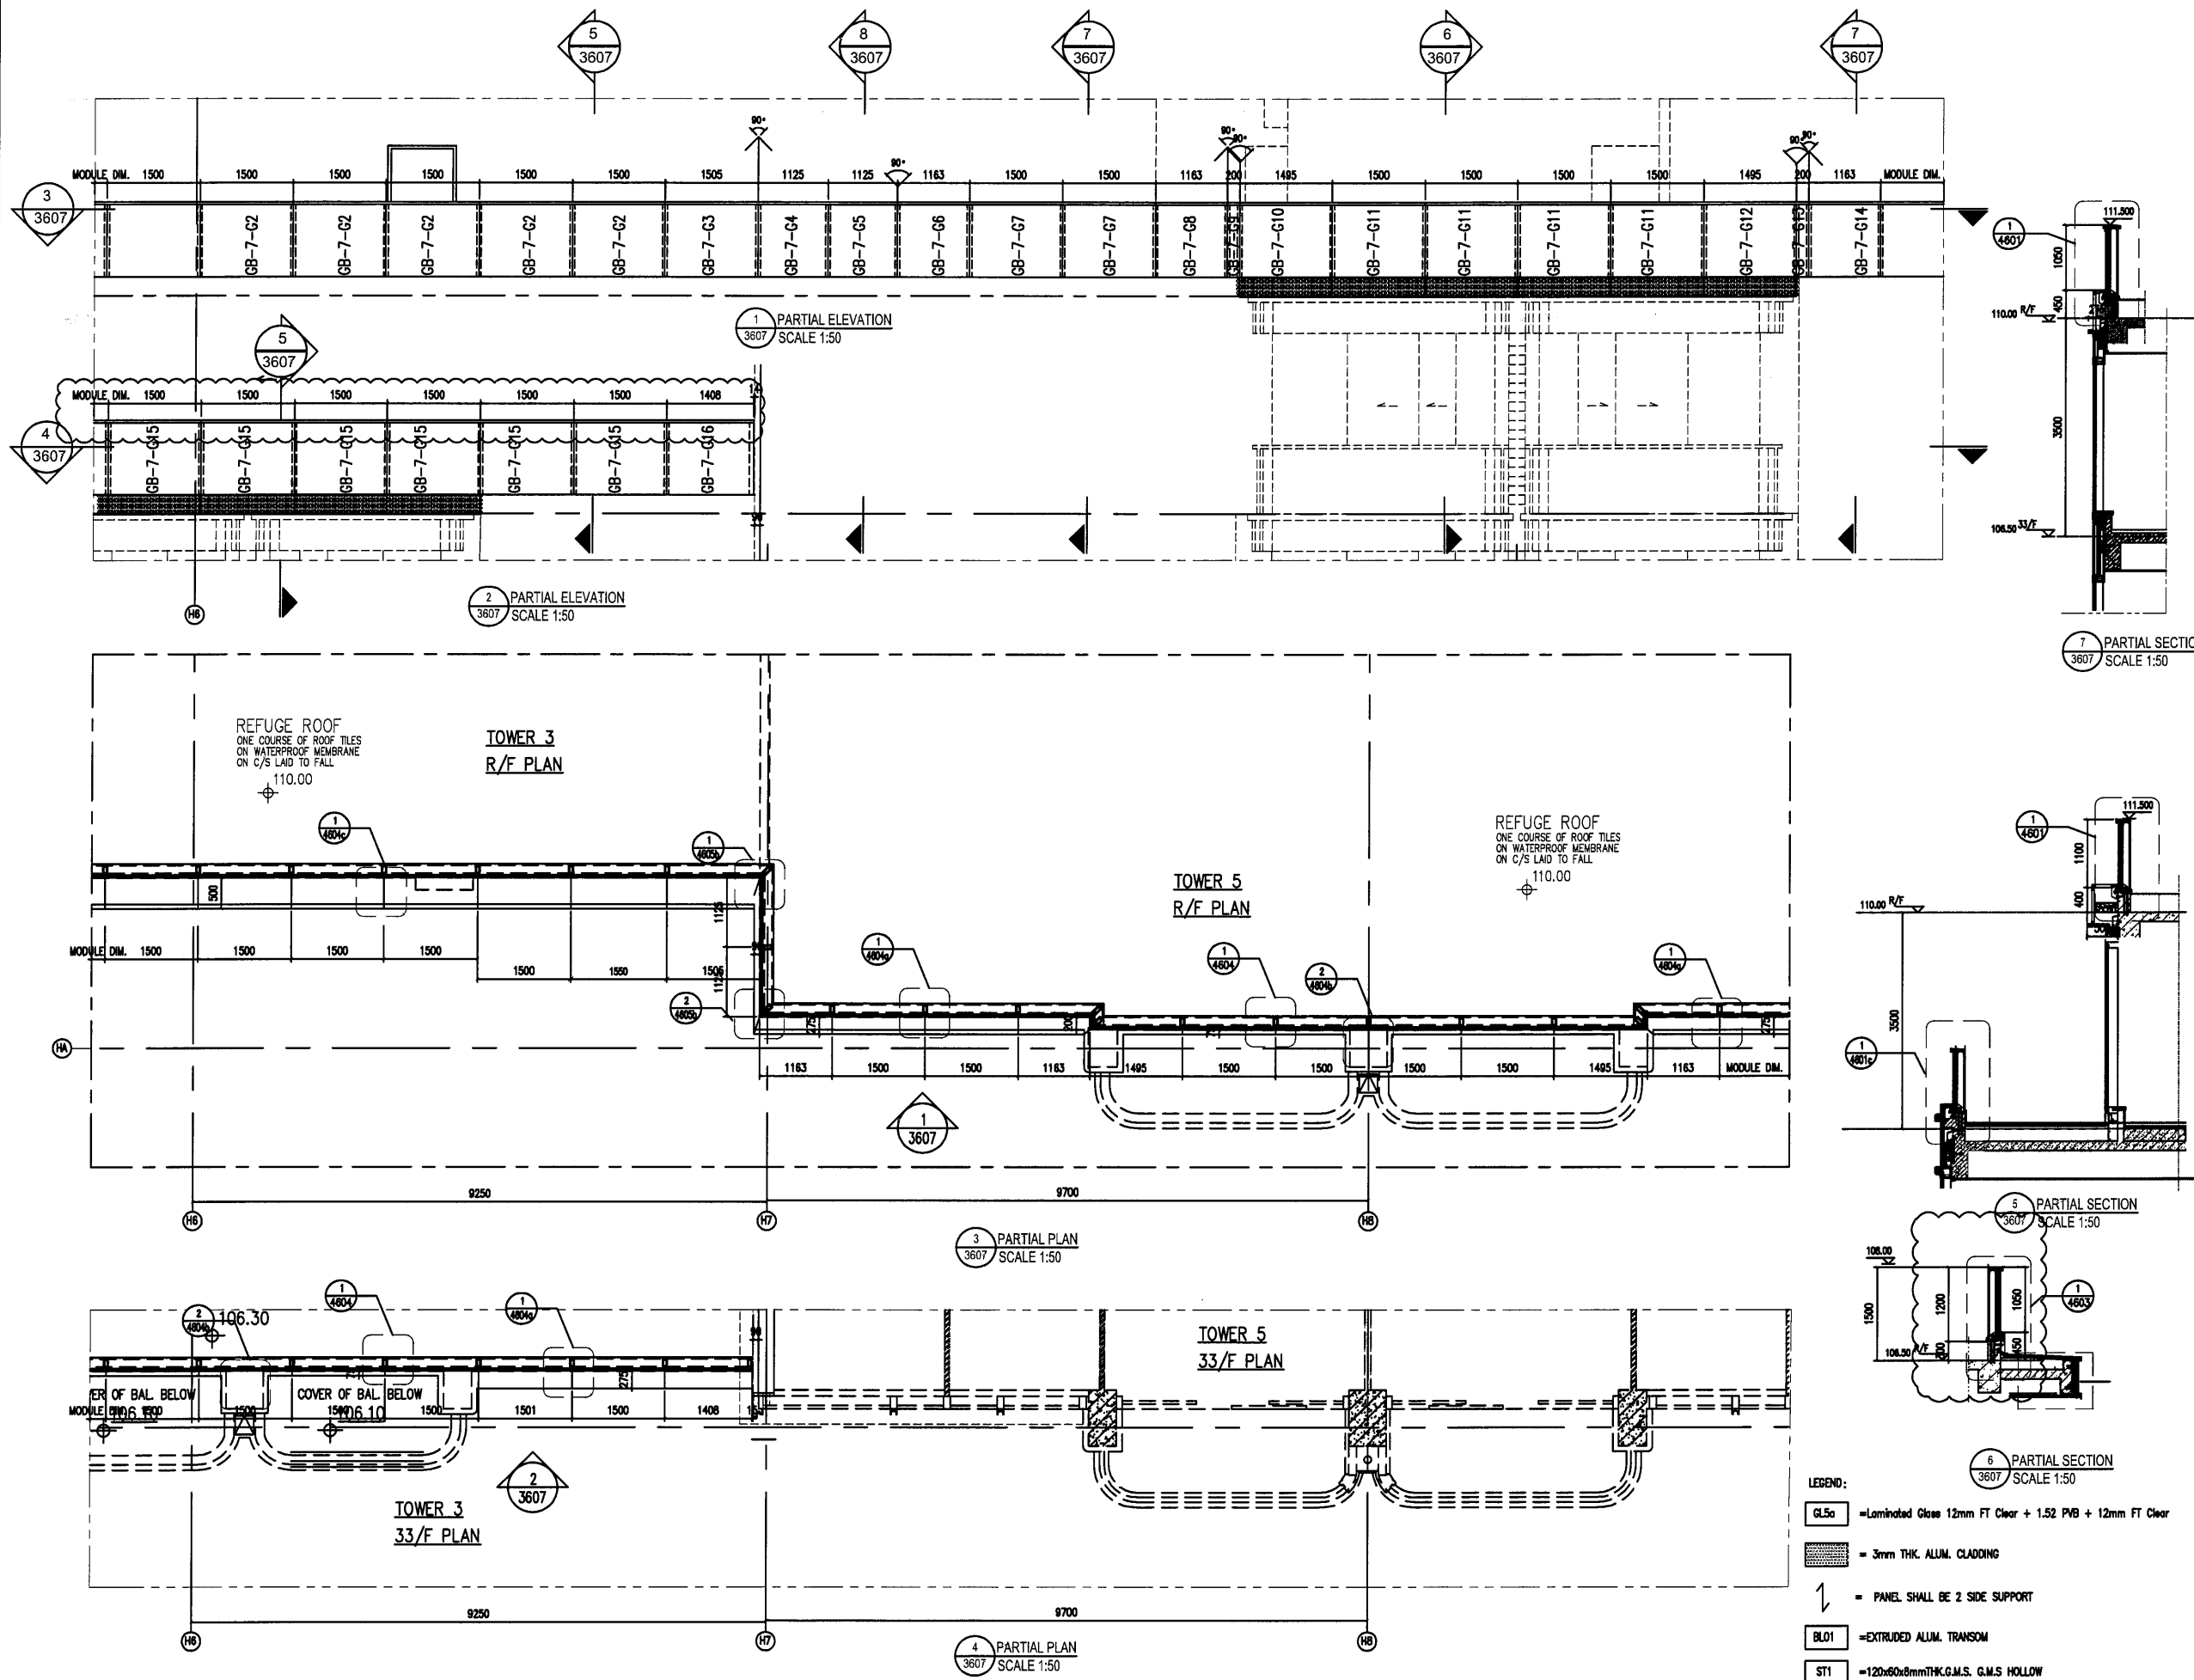

B.D. REF :  
 F.S.D. REF :

Note:  
 1. All dimensions are in mm.  
 2. All elevations are viewed from outside.  
 3. All dimensions to be verified on site before fabrication.

GENERAL NOTES

Legend:  
 1. F.F.L. --- Finished Floor Level  
 2. S.F.L. --- Structural Floor Level  
 3. (Symbol) --- Reversed Detail

X1 --- DETAIL MARK NO.  
 X001 --- REFER SHEET NO.

REV.	DATE	DESCRIPTION	BY
E	22 Aug. 2022	6TH SUBMISSION	
D	01 Aug. 2022	5TH SUBMISSION	
C	14 Jul. 2022	4TH SUBMISSION	
B	10 May. 2022	3rd SUBMISSION	
A	13 Dec. 2021	2nd SUBMISSION	
00	18 Oct. 2021	1ST SUBMISSION	

CLIENT :  
 MARBLE EDGE INVESTMENT LTD.

ARCHITECT :  
 RONALD LU & PARTNERS  
 ARCHITECTS | PLANNERS | INTERIOR DESIGNERS

STRUCTURAL ENGINEER :  
 CMA C M WONG & ASSOCIATES LTD  
 TEL: (852) 3022 1886  
 Email: cmawong@cma.com.hk

MAIN CONTRACTOR :  
 裕民建築有限公司

美特鋁質有限公司  
 MIDI ALUMINIUM FABRICATOR LTD.  
 Units 6-8, Sunray Industrial Centre, 1/F  
 610 Cha Kwo Ling Road, Kowloon  
 Tel: 23489211-4 Fax: (852) 27727666

PROJECT :  
 PROPOSED RESIDENTIAL DEVELOPMENT AT NEW KOWLOON INLAND LOT. NO. 6552

TITLE :  
 PART ELEVATION FOR GLASS BALUSTRADE

JOB NO. : J-857






DRAWN BY : AN DATE : 29.AUG.2022

CHKD BY : SCALE A1: 1/50 A3:

DWG. NO. : CW-PE-3607 REV. : E

- LEGEND:
- GL5a = Laminated Glass 12mm FT Clear + 1.52 PVB + 12mm FT Clear
  - (Symbol) = 3mm THK. ALUM. CLADDING
  - (Symbol) = PANEL SHALL BE 2 SIDE SUPPORT
  - BL01 = EXTRUDED ALUM. TRANSOM
  - ST1 = 120x60x8mm THK. G.M.S. HOLLOW
  - ST2 = 80x40x5mm THK. G.M.S. HOLLOW
  - ST3 = 100x50x5mm THK. G.M.S. HOLLOW



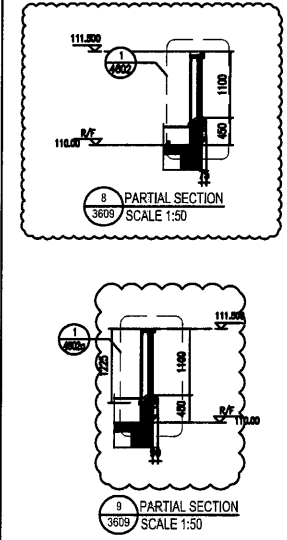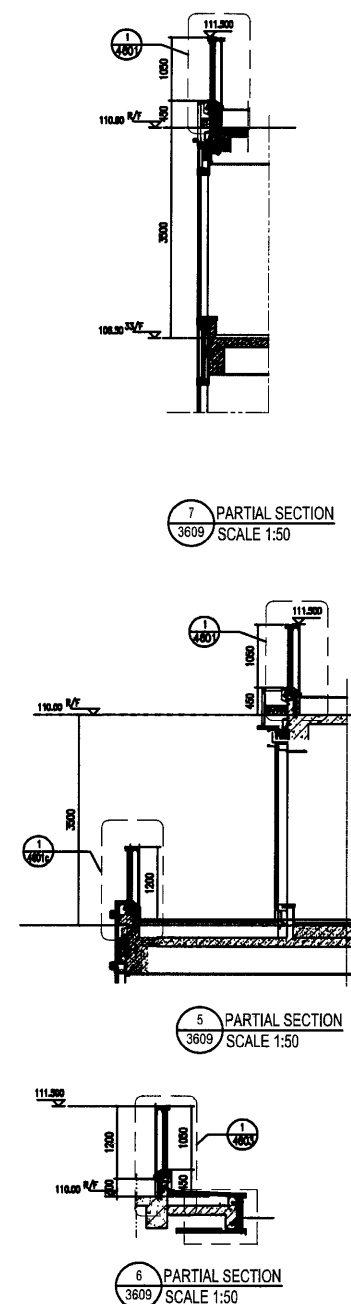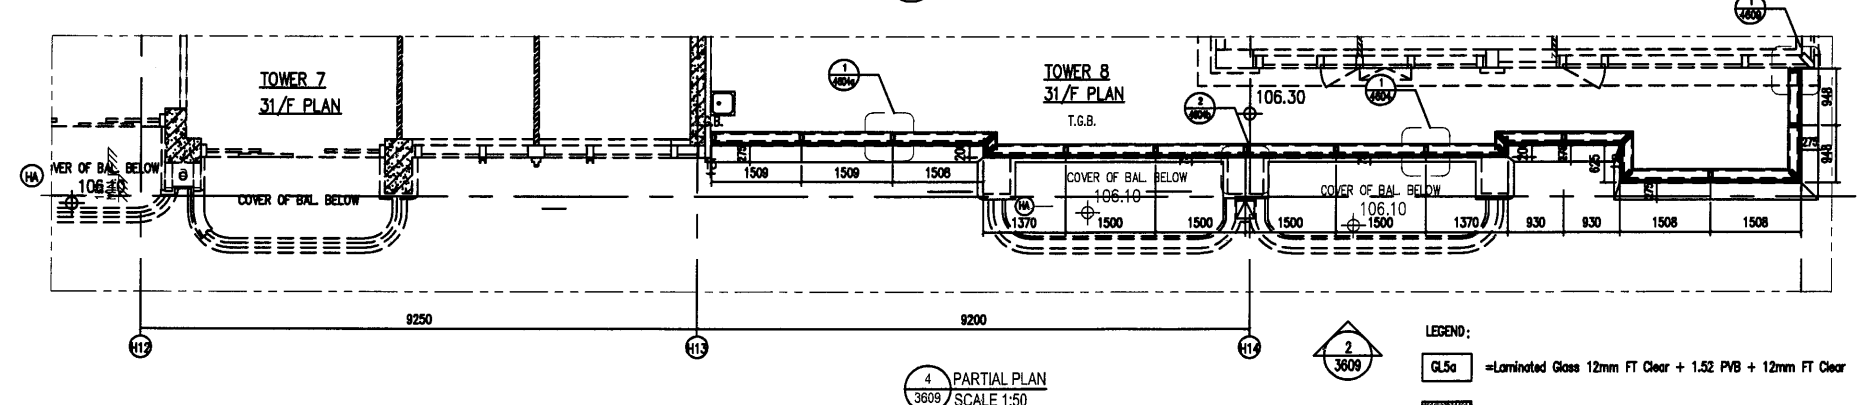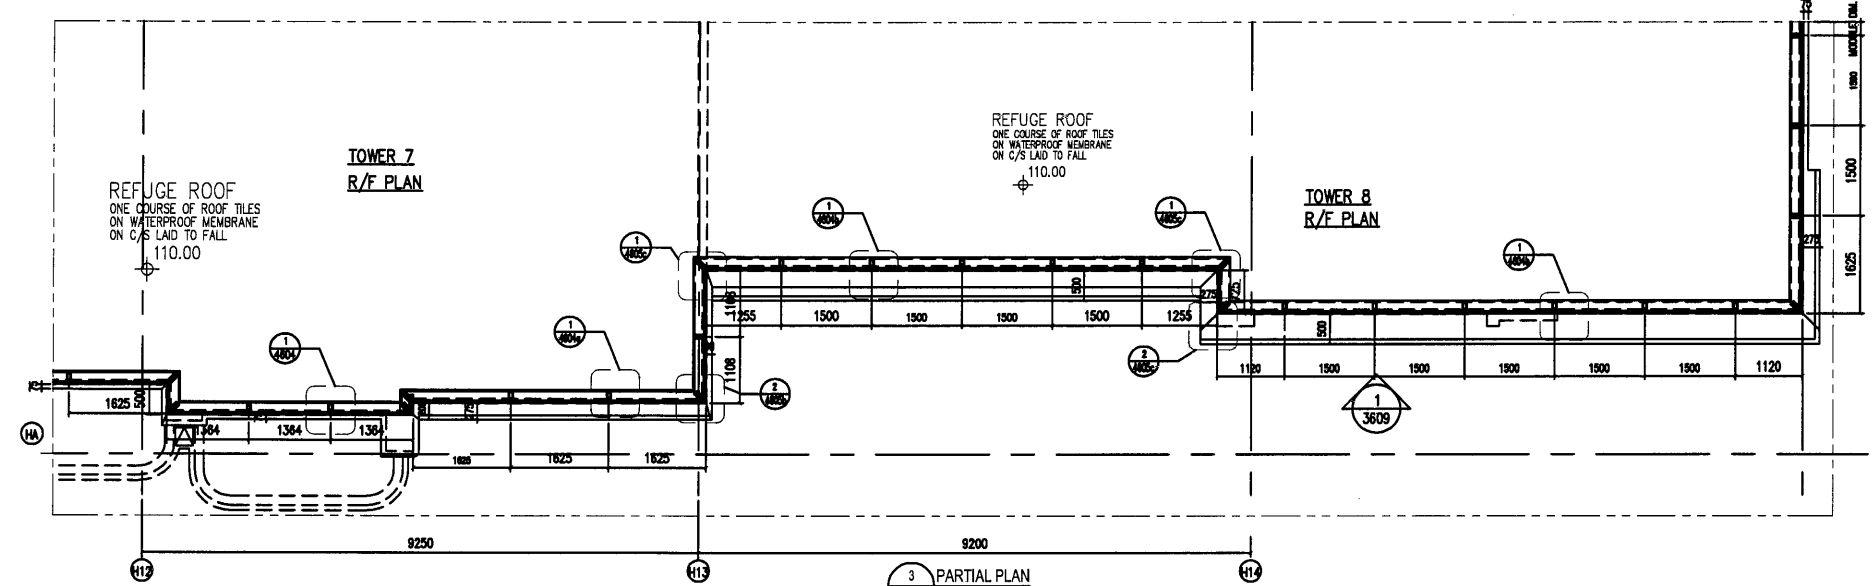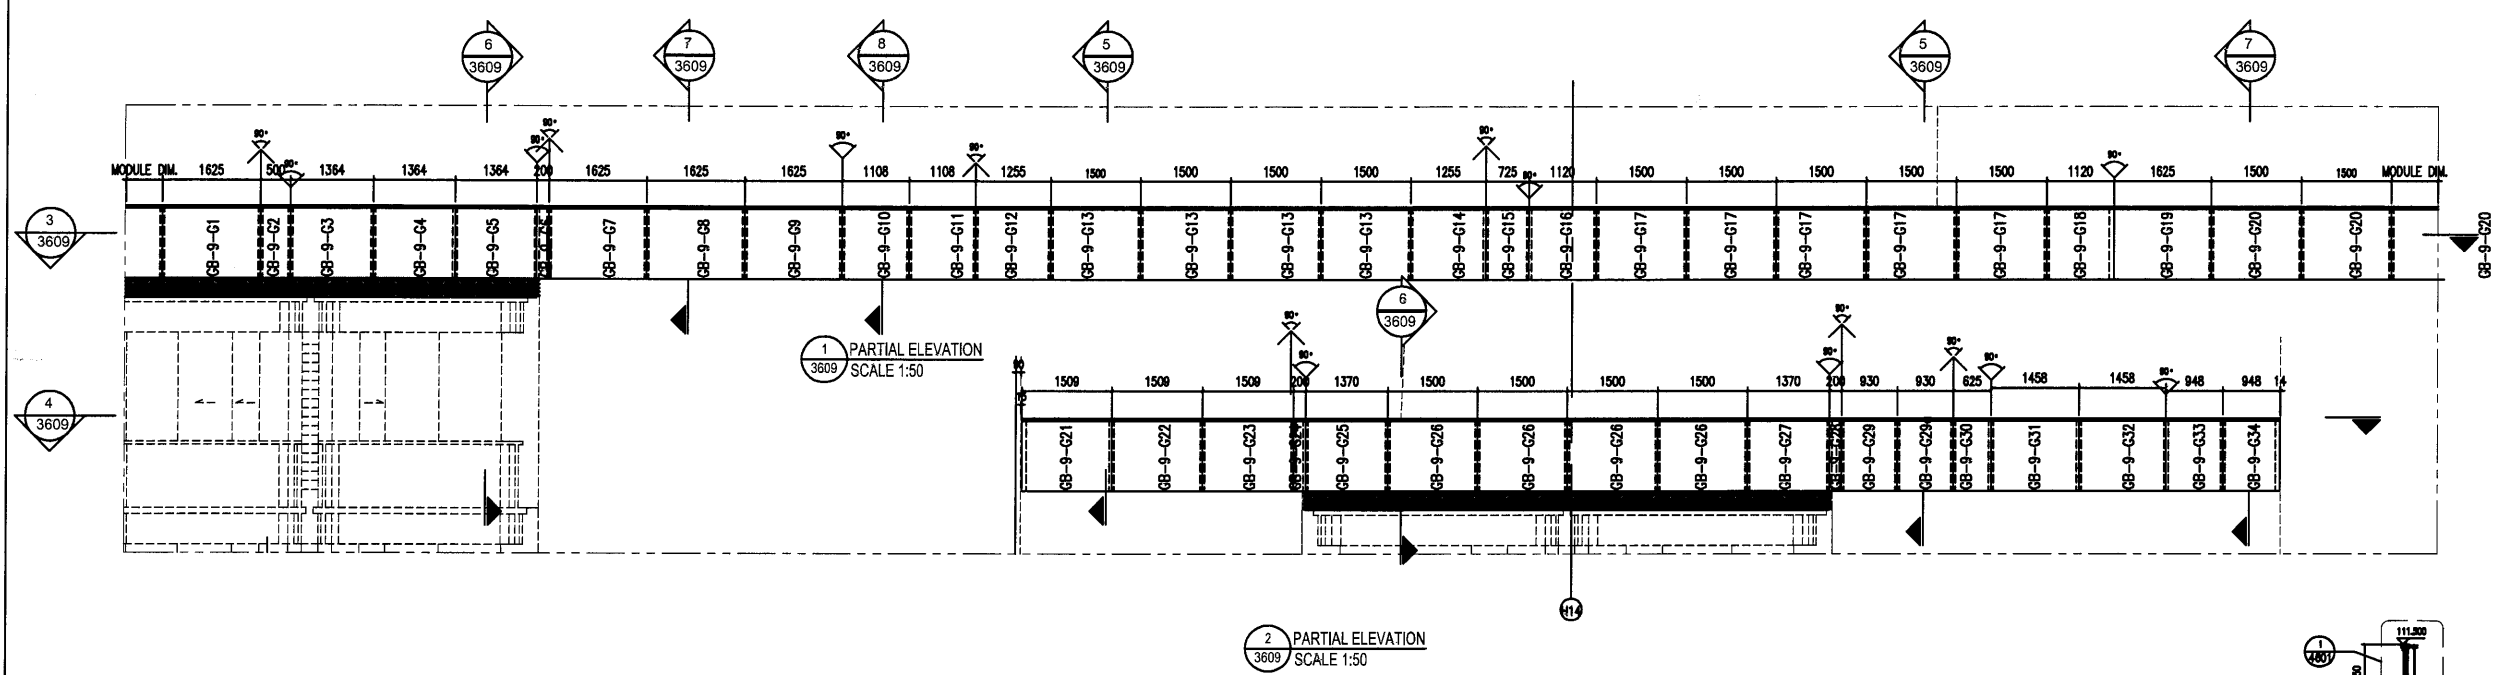

- LEGEND:**
- GL5a = Laminated Glass 12mm FT Clear + 1.52 PVB + 12mm FT Clear
  - 3mm THK ALUM. CLADDING
  - PANEL SHALL BE 2 SIDE SUPPORT
  - BL01 = EXTRUDED ALUM. TRANSOM
  - ST1 = 120x60x8mm THK G.M.S. G.M.S HOLLOW
  - ST2 = 80x40x5mm THK G.M.S HOLLOW
  - ST3 = 100x50x5mm THK G.M.S HOLLOW

B.D. REF :  
F.S.D. REF :

**Note :**  
1. All dimensions are in mm.  
2. All elevations are viewed from outside.  
3. All dimensions to be verified on site before fabrication.

**GENERAL NOTES**

**Legend :**  
1. F.F.L--- Finished Floor Level  
2. S.F.L--- Structural Floor Level  
3. (R) --- Reversed Detail

X1 --- DETAIL MARK NO.  
X001 --- REFER SHEET NO.

REV.	DATE	DESCRIPTION	BY
E 122	Aug.2022	6TH SUBMISSION	
D 01	Aug.2022	5TH SUBMISSION	
C 14	Jul.2022	4TH SUBMISSION	
B 10	May.2022	3rd SUBMISSION	
A 13	Dec.2021	2nd SUBMISSION	
00	18.Oct.2021	1ST SUBMISSION	

CLIENT :  
MARBLE EDGE INVESTMENT LTD.

ARCHITECT :  
RONALD LU & PARTNERS  
ARCHITECTS | PLANNERS | INTERIOR DESIGNERS

STRUCTURAL ENGINEER :  
CMA C M WONG & ASSOCIATES LTD

MAIN CONTRACTOR :  
裕民建築有限公司

MIDI ALUMINIUM FABRICATOR LTD.  
Units 6-8, Sunray Industrial Centre, 1/F  
610 Cho Kwo Ling Road, Kowloon  
Tel:23489211-4 Fax:(852)2727866

PROJECT :  
PROPOSED RESIDENTIAL DEVELOPMENT AT NEW KOWLOON INLAND LOT. NO.6552

TITLE :  
PART ELEVATION FOR GLASS BALUSTRADE

JOB NO. : J-857

DRAWN BY : AN DATE : 29.AUG.2022

CHKD BY : SCALE A1: 1/50 A3:

DWG. NO. : CW-PE-3609 REV. : E

