

工程指示 / 要求簡箋 ENGINEER INSTRUCTIONS(E.I.)

工程指示編號:	EI- 5007 / 22	修改版本:	-
	HK- /		
工程編號:	J 857	工程名稱:	啟德6552
收件人:	Maggie Lor	發件人:	Nero HO
工程項目:	幕牆單元件 - 驗幕牆吊運碼	日期:	19/08/2022

<input type="checkbox"/> 原合約工程包	<input type="checkbox"/> 原合約工程加 / 減賬 QT-	<input type="checkbox"/> 新工程報價 QT-
---------------------------------	--	------------------------------------

信件批核號碼/圖紙參考編號:	批核模具圖紙編號:
客戶指示附件:	管理內部批簽署:

<input type="checkbox"/> 初步鋁料 B.M.	<input type="checkbox"/> 加工拆圖, 然後生產	<input type="checkbox"/> 尺寸表
<input type="checkbox"/> 正式鋁料 B.M.	<input type="checkbox"/> 技術上資料 / 指示	<input type="checkbox"/> 報價
<input type="checkbox"/> 配件 B.M.	<input type="checkbox"/> 樣辦或貨品說明書	<input type="checkbox"/> 分判合約
<input type="checkbox"/> 其他:		

內容: 驗幕牆吊運碼, 日期及時間由地盤向公證行安排及確定  現出EI作記錄  附件是需要驗的吊運碼位置及數量。  負重: 1 噸  完成上列要求日期: 20/08/2022
--

國內


<input type="checkbox"/> 生產技術總監	<input type="checkbox"/> 連附件	<input type="checkbox"/> 技術部	<input type="checkbox"/> 連附件	<input type="checkbox"/> 生產部	<input type="checkbox"/> 連附件
<input type="checkbox"/> 採購部	<input type="checkbox"/> 連附件	<input type="checkbox"/> 生產統籌部	<input type="checkbox"/> 連附件	<input type="checkbox"/> 報關組	<input type="checkbox"/> 連附件
<input type="checkbox"/> 質檢部	<input type="checkbox"/> 連附件	<input type="checkbox"/> 會計部	<input type="checkbox"/> 連附件	<input type="checkbox"/> 機械設計部	<input type="checkbox"/> 連附件
<input type="checkbox"/> 香港辦	<input type="checkbox"/> 連附件	<input type="checkbox"/> 其他:			

<input type="checkbox"/> 行政部	<input type="checkbox"/> 連附件	<input type="checkbox"/> 會計部	<input type="checkbox"/> 連附件	<input type="checkbox"/> 統籌部	<input type="checkbox"/> 連附件	<input type="checkbox"/> 工程部	<input type="checkbox"/> 連附件
<input checked="" type="checkbox"/> 採購部	<input checked="" type="checkbox"/> 連附件	<input type="checkbox"/> QS部	<input type="checkbox"/> 連附件	<input type="checkbox"/> 地盤管理	<input type="checkbox"/> 連附件	<input type="checkbox"/> 維修部	<input type="checkbox"/> 連附件

*發件人簽署:	<i>M.</i>	*組別成員批核簽署:	
傳遞編號:	/	項目經理簽署:	<i>[Signature]</i>



T5-T6 中線是通車位置

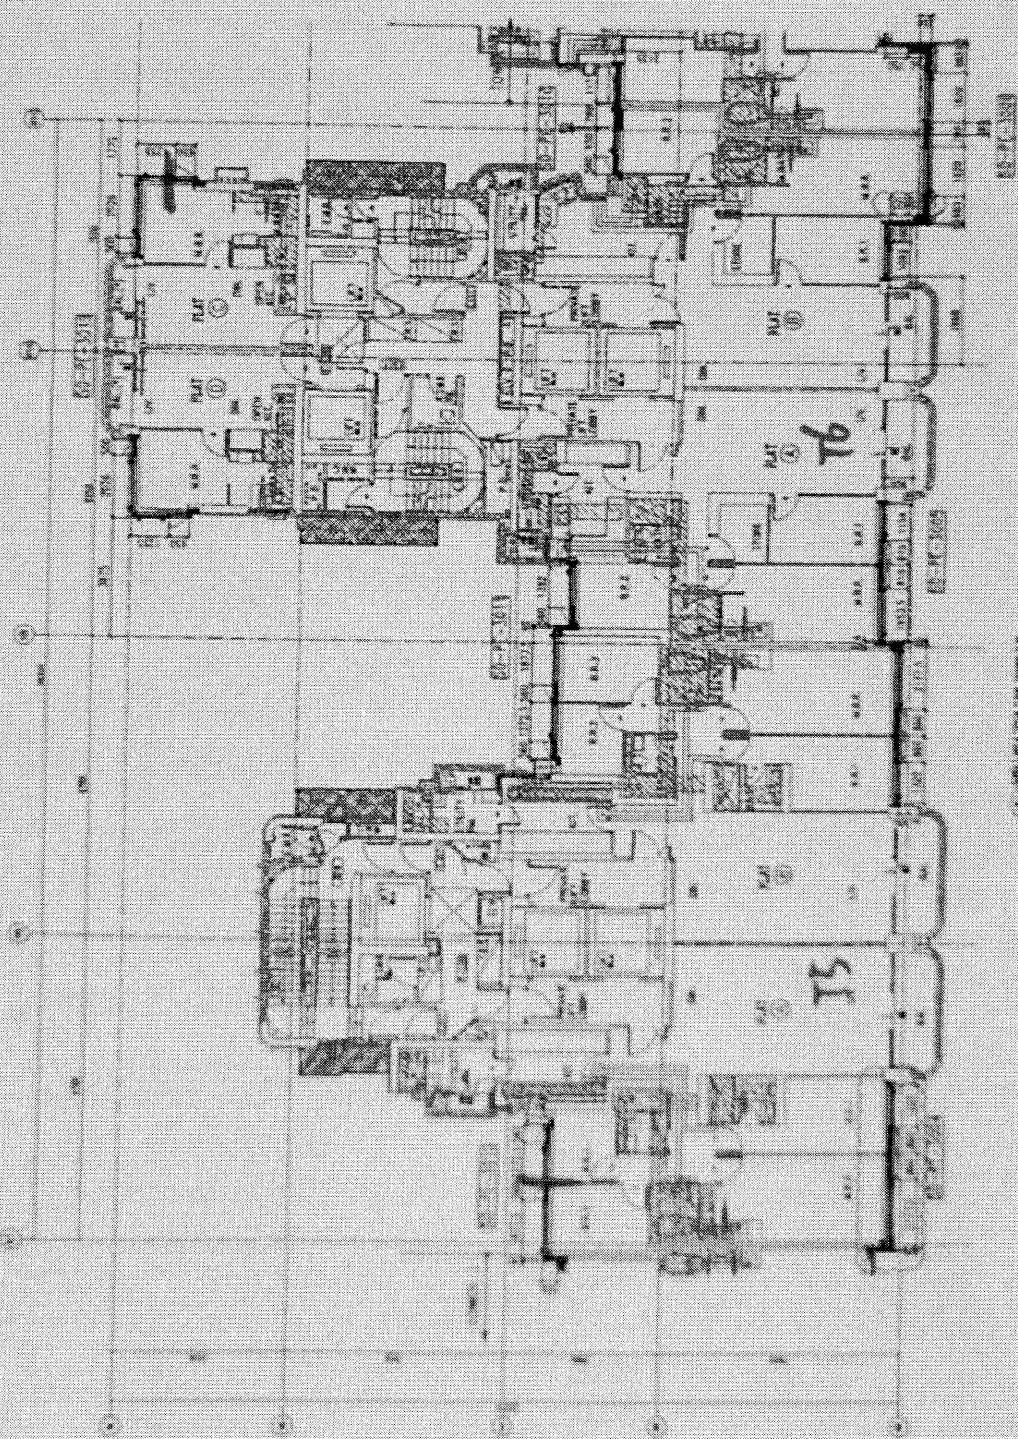

T5-T6 25

<p>SCALE</p> <p>1:100 - Overall View</p> <p>1:50 - Detailed View</p> <p>1:20 - Section</p> <p>1:10 - Section</p> <p>1:5 - Section</p>	<p>GENERAL NOTES</p> <p>1. All dimensions are in mm.</p> <p>2. All elevations are to face unless otherwise stated.</p> <p>3. All dimensions to be marked on site.</p> <p>4. All dimensions to be marked on site.</p>	<p>PROJECT</p> <p>PROPOSED RESIDENTIAL DEVELOPMENT AT 'MIDT' DEVELOPMENT, PHOENIX ISLAND LOT 100, MALDEN</p>	<p>DATE</p> <p>2007</p>	<p>DATE</p> <p>2007</p>
<p>CLIENT</p> <p>WARRLE EDGE INVESTMENT LTD.</p>	<p>ARCHITECT</p> <p>CHONG HEE &amp; PARTNERS</p> <p>REGISTERED ARCHITECTS</p>	<p>ENGINEER</p> <p>CEMA ENGINEERING &amp; ASSOCIATES LTD.</p>	<p>CONTRACTOR</p> <p>裕民建築有限公司</p>	<p>PROJECT</p> <p>PROPOSED RESIDENTIAL DEVELOPMENT AT 'MIDT' DEVELOPMENT, PHOENIX ISLAND LOT 100, MALDEN</p>
<p>DATE</p> <p>2007</p>	<p>DATE</p> <p>2007</p>	<p>DATE</p> <p>2007</p>	<p>DATE</p> <p>2007</p>	<p>DATE</p> <p>2007</p>

SCALE: 1:100 (GROSS UNIT) 1:50 (T5/T6)