



工程指示 / 要求簡箋 ENGINEER INSTRUCTIONS(E.I.)

工程指示編號:	EI- 5381 / m	修改版本:	-
	HK- 279 / m		
工程編號:	J 857	工程名稱:	啟德6552
收件人:	生統	發件人:	Nero HO
工程項目:	幕牆單元件 - 廠用鋁背板BM(特式層+L座廚房位置)	日期:	23/11/2022

<input type="checkbox"/> 原合約工程包	<input type="checkbox"/> 原合約工程加 / 減脹 QT-	<input type="checkbox"/> 新工程報價 QT-
---------------------------------	--	------------------------------------

信件批核號碼/圖紙參考編號:	批核模具圖紙編號:
客戶指示附件:	管理內部批簽署:

<input type="checkbox"/> 初步鋁料 B.M.	<input type="checkbox"/> 加工拆圖, 然後生產	<input type="checkbox"/> 尺寸表
<input type="checkbox"/> 正式鋁料 B.M.	<input type="checkbox"/> 技術上資料 / 指示	<input type="checkbox"/> 報價
<input type="checkbox"/> 配件 B.M.	<input type="checkbox"/> 樣辦或貨品說明書	<input type="checkbox"/> 分判合約
<input type="checkbox"/> 其他:		

內容:
請按附件資料生產加工。


完成上列要求日期: 12月

國內


<input type="checkbox"/> 生產技術總監	<input type="checkbox"/> 連附件	<input type="checkbox"/> 技術部	<input type="checkbox"/> 連附件	<input type="checkbox"/> 生產部	<input type="checkbox"/> 連附件
<input type="checkbox"/> 採購部	<input type="checkbox"/> 連附件	<input checked="" type="checkbox"/> 生產統籌部	<input checked="" type="checkbox"/> 連附件	<input type="checkbox"/> 報關組	<input type="checkbox"/> 連附件
<input type="checkbox"/> 質檢部	<input type="checkbox"/> 連附件	<input type="checkbox"/> 會計部	<input type="checkbox"/> 連附件	<input type="checkbox"/> 機械設計部	<input type="checkbox"/> 連附件
<input checked="" type="checkbox"/> 香港辦	<input checked="" type="checkbox"/> 連附件	<input type="checkbox"/> 其他:			

<input type="checkbox"/> 行政部	<input type="checkbox"/> 連附件	<input type="checkbox"/> 會計部	<input type="checkbox"/> 連附件	<input type="checkbox"/> 統籌部	<input type="checkbox"/> 連附件	<input type="checkbox"/> 工程部	<input type="checkbox"/> 連附件
<input type="checkbox"/> 採購部	<input type="checkbox"/> 連附件	<input type="checkbox"/> QS部	<input type="checkbox"/> 連附件	<input type="checkbox"/> 地盤管理	<input type="checkbox"/> 連附件	<input type="checkbox"/> 維修部	<input type="checkbox"/> 連附件

*發件人簽署:	<i>[Signature]</i>	*組別成員批核簽署:	<i>[Signature]</i>
傳遞編號:	HK 2079 / m	項目經理簽署:	<i>[Signature]</i>

		工程號:	J-857	計算:	刘灿			日期:	2022.11.19		送呈:	施哥	
		地盤名稱:	啟德6552	核對:	徐祥坤			日期:	2022.11.20		副本:	细佬	
廠用鋁板B.M.表		項目類別:	幕牆單元件	批准:	林仁安			日期:	2022.11.21				
BM編號:		修改版次:		A/C Code:	2022.11.21			總V.F.:	29.348		總重量:	204.58	
序號	修改內容	鋁板圖號	鋁板名稱	顏色	實用	後備	總數	總重量	單件展開面積	總展開面積	單件V.F.	總V.F.	圖紙編號
									平方米		平方米		
1		BST-M407A	3mm厚鋁板	ECK3M96295S-ZD1	4	0	4	16.456	0.759	3.036	0.588	2.352	BST-M82
2		BST-M408A	3mm厚鋁板	ECK3M96295S-ZD1	2	0	2	14.304	1.320	2.639	1.087	2.174	BST-M82
3		BST-M409A	3mm厚鋁板	ECK3M96295S-ZD1	4	0	4	16.065	0.741	2.964	0.572	2.288	BST-M82
4		BST-M410A	3mm厚鋁板	ECK3M96295S-ZD1	2	0	2	10.916	1.007	2.014	0.809	1.618	BST-M82
5		BST-M411A	3mm厚鋁板	ECK3M96295S-ZD1	2	0	2	11.081	1.022	2.044	0.822	1.645	BST-M82
6		BST-M412A	3mm厚鋁板	ECK3M96295S-ZD1	2	0	2	5.664	0.523	1.045	0.377	0.755	BST-M82
7		BST-M413A	3mm厚鋁板	ECK3M96295S-ZD1	2	0	2	16.580	1.530	3.059	1.274	2.548	BST-M82
8		BST-M417A	3mm厚鋁板	ECK3M96295S-ZD1	2	0	2	21.605	1.993	3.986	1.687	3.374	BST-M82
9		BST-M418A	3mm厚鋁板	ECK3M96295S-ZD1	4	0	4	17.507	0.808	3.230	0.631	2.524	BST-M82
10		BST-M419A	3mm厚鋁板	ECK3M96295S-ZD1	2	0	2	13.583	1.253	2.506	1.028	2.056	BST-M82
11		BST-M480A	3mm厚鋁板	ECK3M96295S-ZD1	2	0	2	8.300	0.766	1.531	0.594	1.188	BST-M82
12		BST-M602A	3mm厚鋁板	ECK3M96295S-ZD1	4	0	4	22.242	1.026	4.104	0.756	3.025	BST-M84
13		BST-M603A	3mm厚鋁板	ECK3M96295S-ZD1	1	0	1	1.899	0.350	0.350	0.234	0.234	BST-M84
14		BST-M618A	3mm厚鋁板	ECK3M96295S-ZD1	2	0	2	4.364	0.403	0.805	0.274	0.549	BST-M84
15		BST-M631A	3mm厚鋁板	ECK3M96295S-ZD1	1	0	1	1.906	0.352	0.352	0.235	0.235	BST-M84
16		BST-M726A	3mm厚鋁板	ECK3M96295S-ZD1	1	0	1	2.410	0.445	0.445	0.300	0.300	BST-M84
17		BST-M748A	3mm厚鋁板	ECK3M96295S-ZD1	1	0	1	3.547	0.654	0.654	0.456	0.456	BST-M84
18		BST-M790A	3mm厚鋁板	ECK3M96295S-ZD1	1	0	1	2.368	0.437	0.437	0.294	0.294	BST-M84
19		BST-M805A	3mm厚鋁板	ECK3M96295S-ZD1	1	0	1	1.773	0.327	0.327	0.212	0.212	BST-M84
20		BST-M862A	3mm厚鋁板	ECK3M96295S-ZD1	1	0	1	1.419	0.262	0.262	0.163	0.163	BST-M84
21		BST-M412B	3mm厚鋁板	ECK3M96295S-ZD1	1	0	1	1.219	0.225	0.225	0.136	0.136	BST-M84
22	L座廚房	BST-M315A	3mm厚鋁板	ECK3M96295S-ZD1	2	0	2	5.154	0.475	0.951	0.342	0.683	BST-M86
23	L座廚房	BST-M316A	3mm厚鋁板	ECK3M96295S-ZD1	2	0	2	4.218	0.389	0.778	0.270	0.540	BST-M86
總計:					46		46	204.58	17.065	37.75	13.14	29.348	

 美特鋁質有限公司 MIDI Aluminium Fabricator Ltd.				工程號 J857	類別	物料號 -		
				地盘 啟德6552	制圖 刘灿	2022-11-19	圖號 BST-M82	
修改		採用工廠 ✓	地盘	图纸名称 铝板加工图	復核 徐詳坤	2022-11-20	數量 -	
日期		材料颜色 ECK3M96295S-ZD1		材料 3mm THK. 铝板	批准 林仁安	2022-11-21	單件重量 -	(KG)

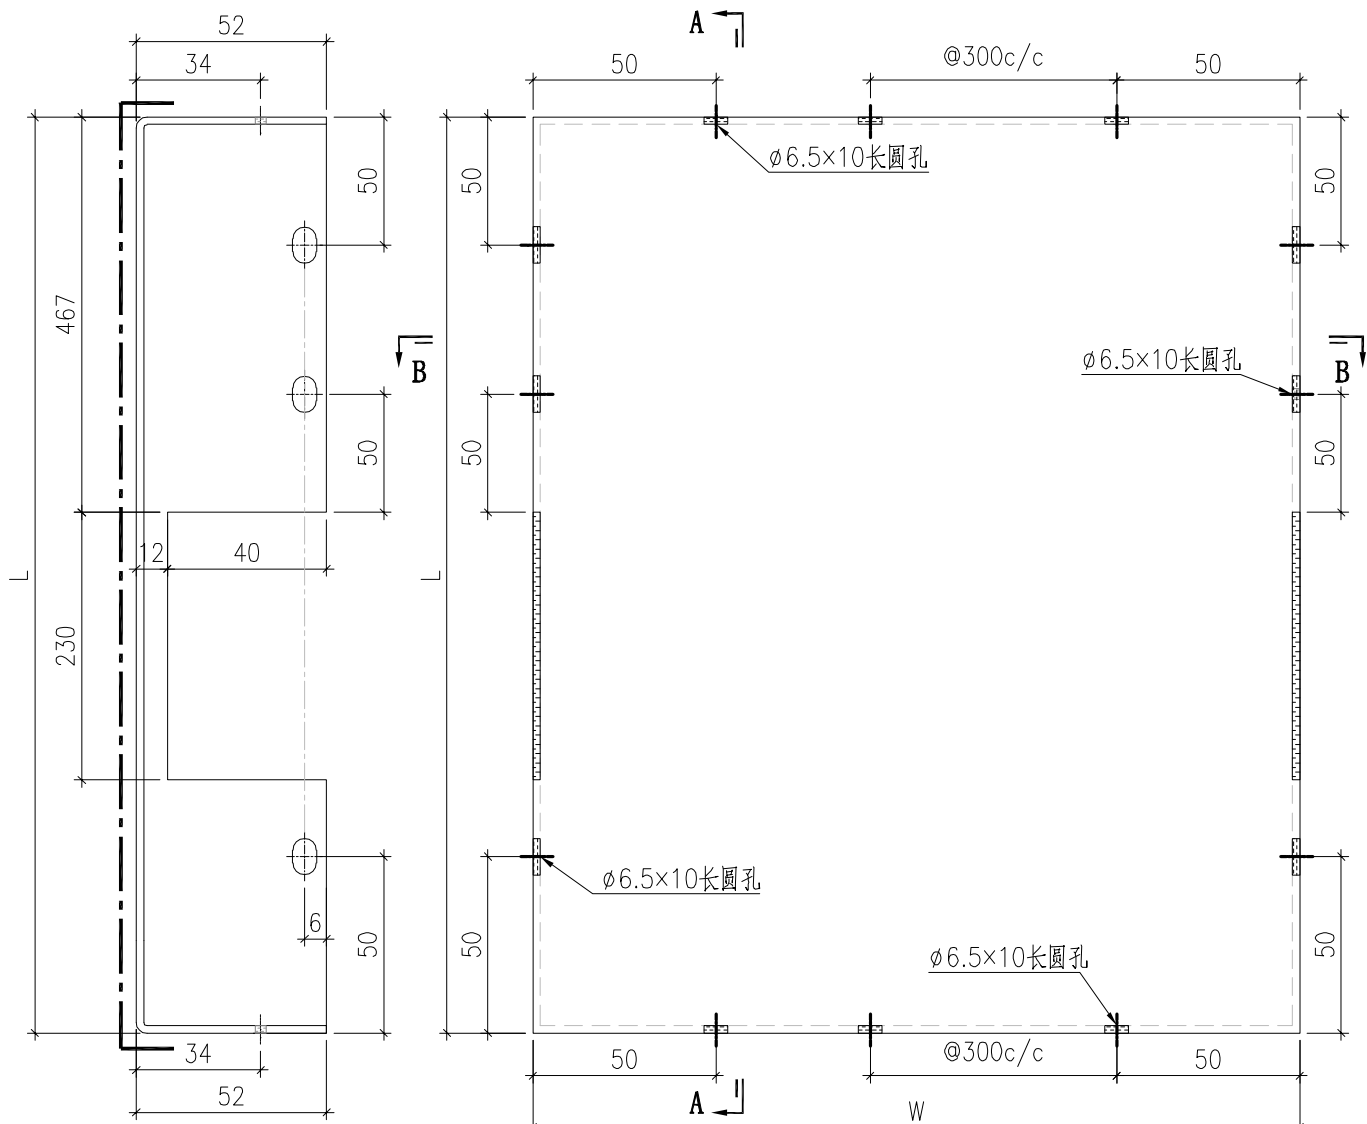

SECTION A-A


SECTION B-B

背板长宽数据見BST-M83



 美特鋁質有限公司 MIDI Aluminium Fabricator Ltd.				工程號	J857	類別		物料號	-			
				地盤	啟德6552	制圖	刘灿	2022-11-19	圖號	BST-M83		
修改		採用工廠	✓	地盤		圖紙名稱	铝板加工图	復核	徐詳坤	2022-11-20	數量	-
日期		材料颜色	ECK3M96295S-ZD1		材料	3mm THK. 铝板	批准	林仁安	2022-11-21	單件重量	-	(KG)

序號	鋁板編號	寬度 (W)	高度 (H)	數量	圖紙編號
1	BST-M407A	695	846	4	BST-M82
2	BST-M408A	1285	846	2	BST-M82
3	BST-M409A	676	846	4	BST-M82
4	BST-M410A	956	846	2	BST-M82
5	BST-M411A	972	846	2	BST-M82
6	BST-M412A	446	846	2	BST-M82
7	BST-M413A	1506	846	2	BST-M82
8	BST-M417A	1994	846	2	BST-M82
9	BST-M418A	746	846	4	BST-M82
10	BST-M419A	1215	846	2	BST-M82
11	BST-M480A	702	846	2	BST-M82

 美特鋁質有限公司 MIDI Aluminium Fabricator Ltd.				工程號 J857 地盘 啟德6552	類別 制圖 刘灿	物料號 - 2022-11-19	圖號 BST-M84
修改 - 日期 -	採用工廠 ✓ 材料颜色 BCK3M96295S-ZD1	图纸名称 铝板加工图 材料 3mm THK. 铝板	復核 徐詳坤 批准 林仁安	2022-11-20 2022-11-21	數量 - 單件重量 - (KG)		

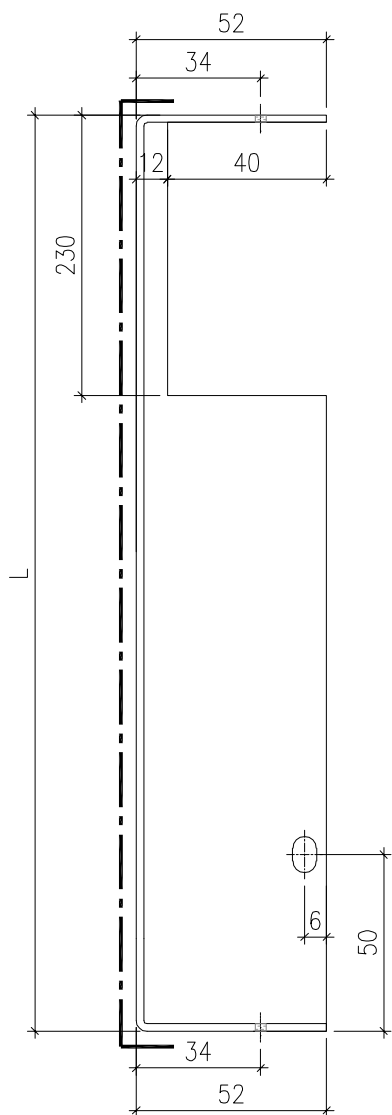

SECTION A-A

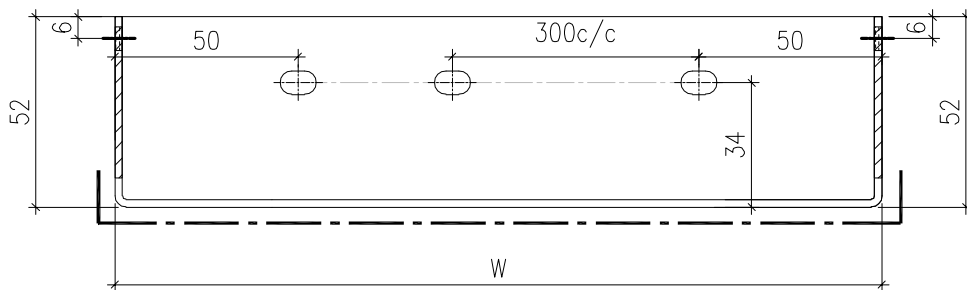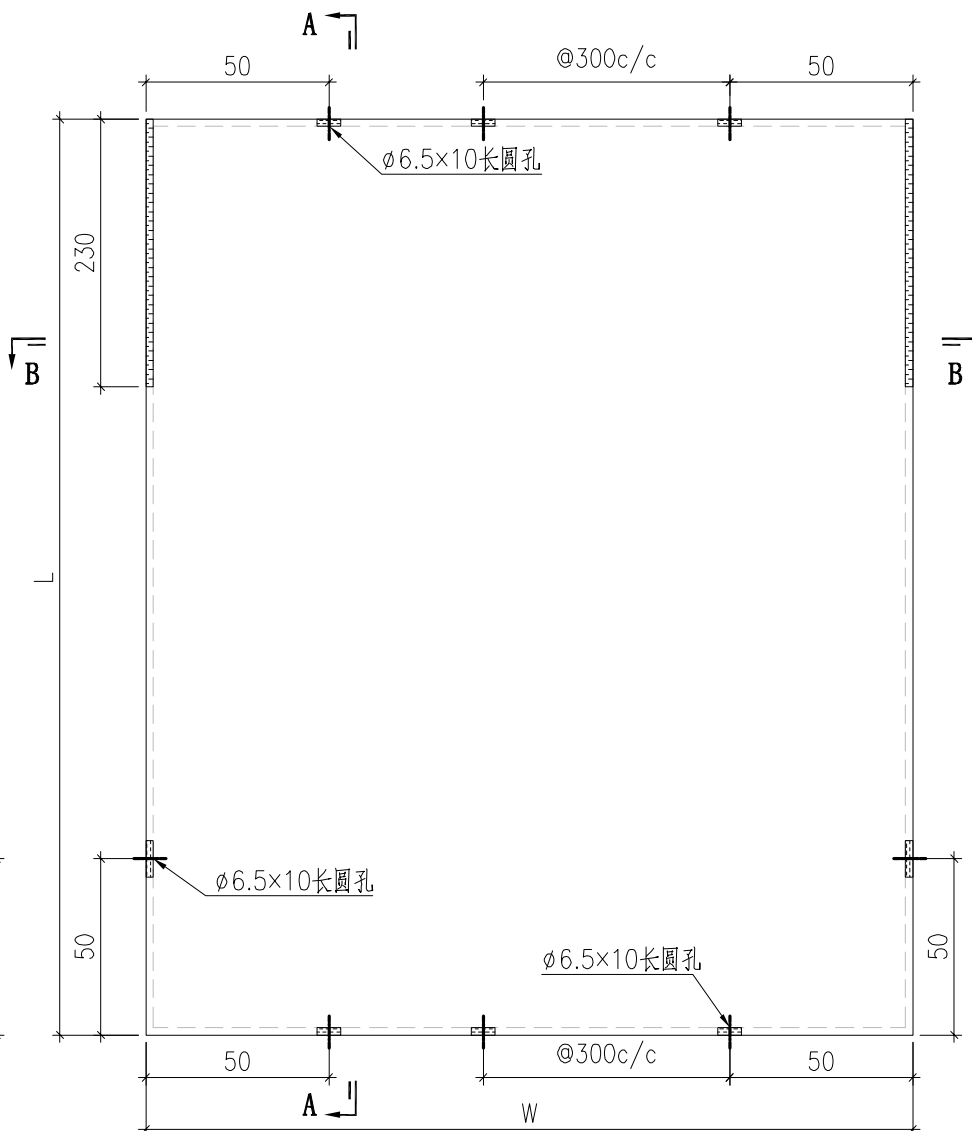


SECTION B-B

背板长宽数据見BST-M21


 美特鋁質有限公司 MIDI Aluminium Fabricator Ltd.				工程號	J857	類別		物料號	-					
				地盘	啟德6552	制圖	刘灿	2022-11-19	圖號	BST-M85				
修改	-	-	-	採用工廠	✓	地盤		图纸名称	铝板加工图	復核	徐詳坤	2022-11-20	數量	-
日期	-	-	-	材料颜色	BCK3M96295S-ZD1			材料	3mm THK. 铝板	批准	林仁安	2022-11-21	單件重量	- (KG)

序號	鋁板編號	寬度 (W)	高度 (H)	數量	图纸编号
1	BST-M602A	2136	354	4	BST-M84
2	BST-M603A	661	354	1	BST-M84
3	BST-M618A	775	354	2	BST-M84
4	BST-M631A	664	354	1	BST-M84
5	BST-M726A	983	305	1	BST-M84
6	BST-M748A	1496	305	1	BST-M84
7	BST-M790A	964	305	1	BST-M84
8	BST-M805A	696	305	1	BST-M84
9	BST-M862A	536	305	1	BST-M84
10	BST-M412B	446	305	1	BST-M84

 美特鋁質有限公司 MIDI Aluminium Fabricator Ltd.				工程號 J857 地盤 啟德6552	類別 制圖 刘灿	物料號 - 2022-11-19	圖號 BST-M86
修改 - 日期 -	採用工廠 ✓ 材料颜色 BCK3M96295S-ZD1	地盤 材料 3mm THK. 铝板	图纸名称 铝板加工图 材料	復核 徐詳坤 批准 林仁安	2022-11-20 2022-11-21	數量 - 單件重量 - (KG)	

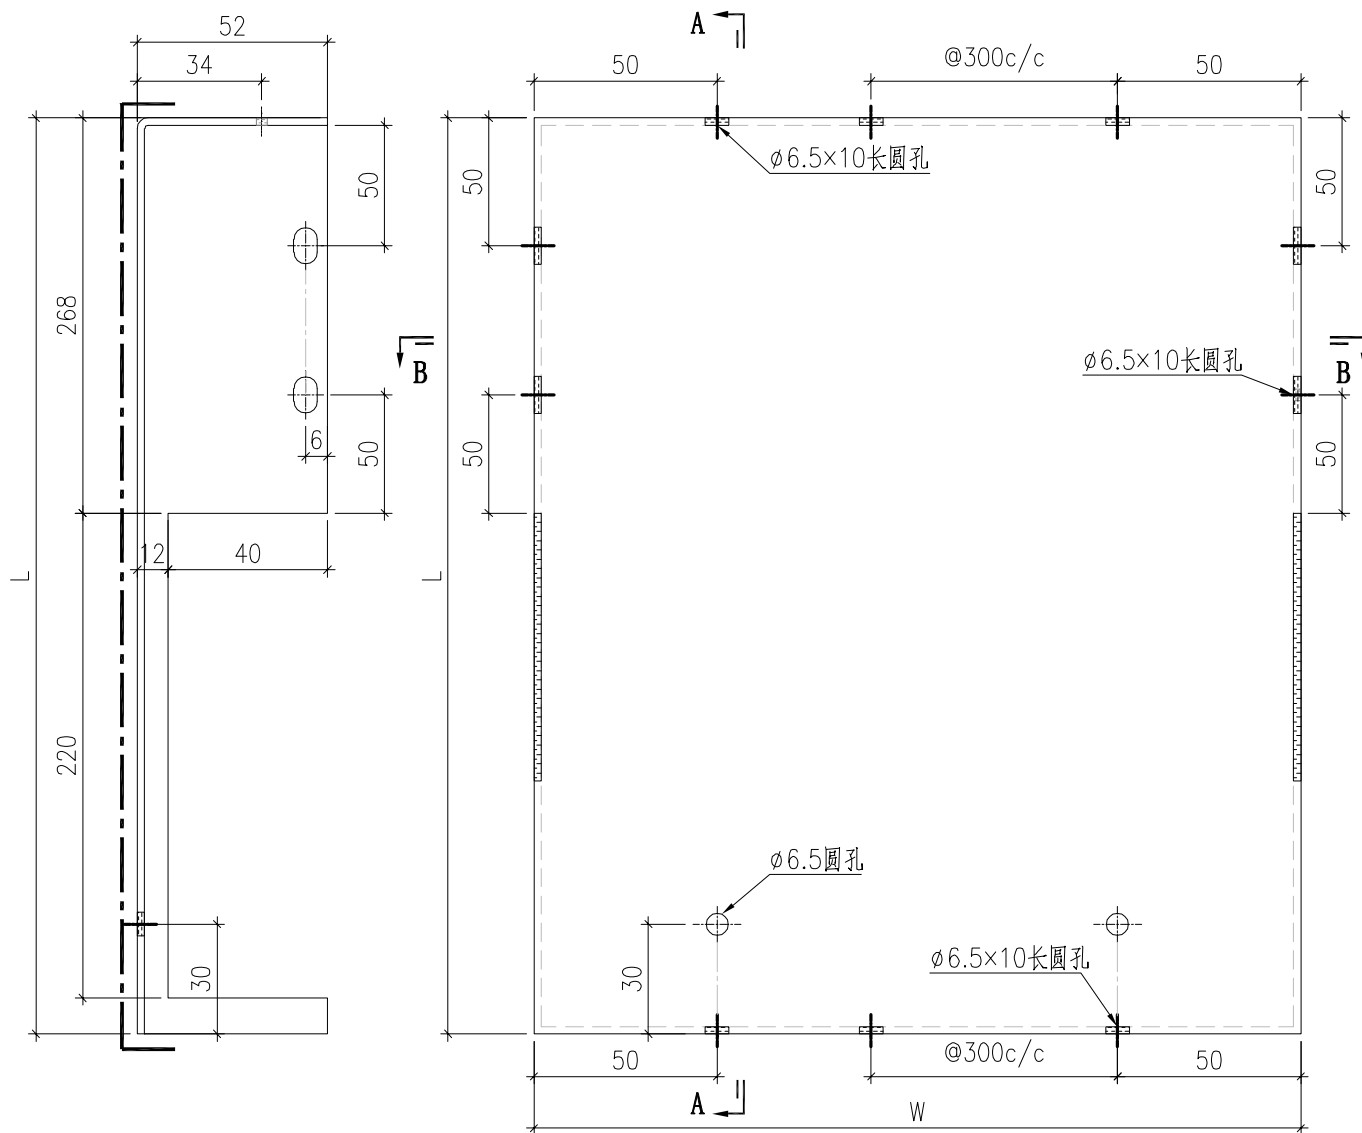


SECTION A-A

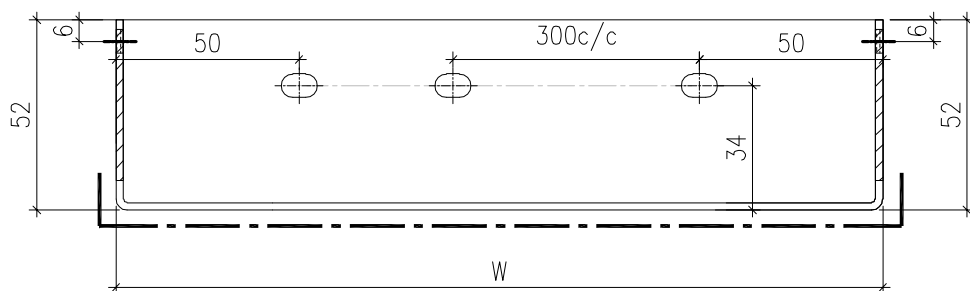

SECTION B-B

序號	鋁板編號	寬度 (W)	高度 (H)	數量	图纸编号
1	BST-M315A	678	504	2	BST-M86
2	BST-M316A	536	504	2	BST-M86

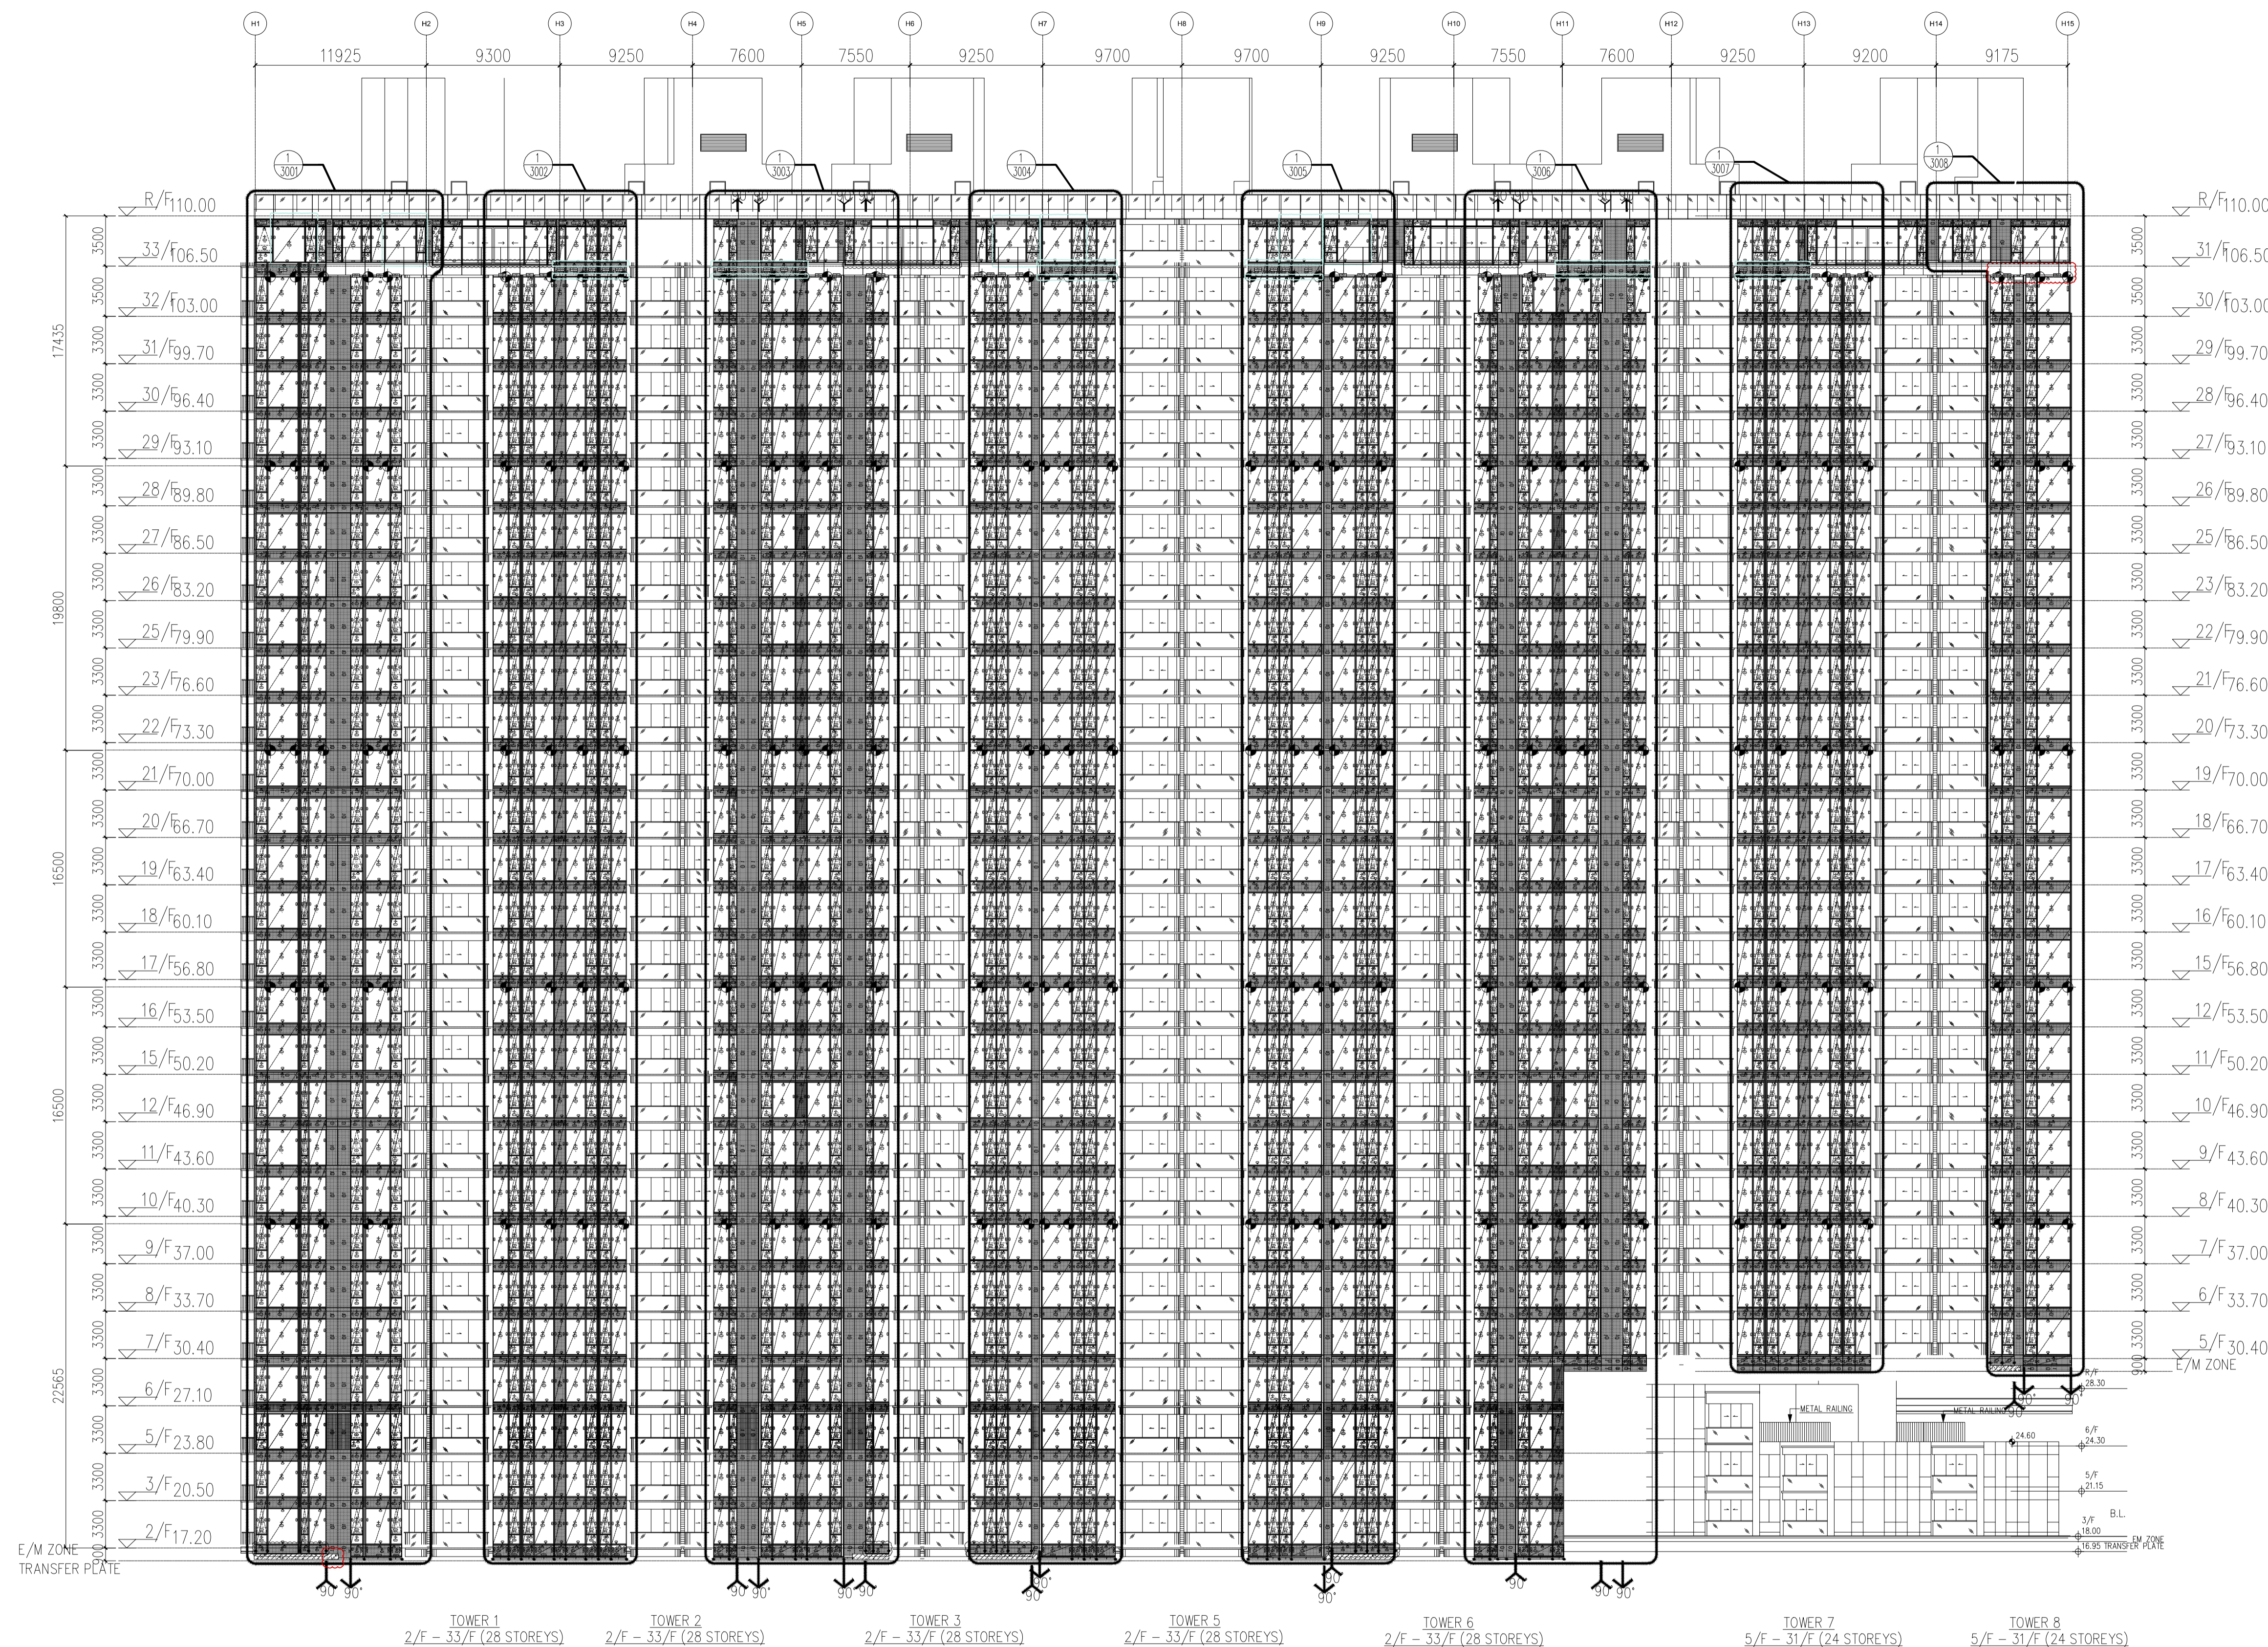

LEGEND :

S.F.L. = STRUCTURAL FLOOR LEVEL	GL2 = 8mm HEAT STRENGTHEN LOW IRON GLASS + 1.52 PVB INTERLAYER+ 8mm HEAT STRENGTHEN LOW IRON GLASS + 12mm AIR SPACE +12mm LOW IRON FULLY TEMPERED IGU LAMINATED CLEAR GLASS	S.J. = STACK JOINT	T1 = EXTRUDED ALUM. SILL STACK JOINT (AL11)
U = UNITIZED CURTAIN WALL (FOR BD APPROVAL)	GL3 = 8mm HEAT STRENGTHEN LOW IRON GLASS + 1.52 PVB INTERLAYER+ 8mm HEAT STRENGTHEN LOW IRON GLASS + 9mm AIR SPACE +8mm LOW IRON FULLY TEMPERED IGU LAMINATED CLEAR GLASS	M1 = EXTRUDED ALUM. MALE MULLION (AL03)	T2 = EXTRUDED ALUM. GUTTER STACK JOINT (AL12)
EM1 = WIND LOAD +DEAD LOAD FIXING LOCATION	GL4 = 8mm FULLY TEMPERED GLASS + 1.52 PVB INTERLAYER+ 8mm FULLY TEMPERED LAMINATED GLASS	M2 = EXTRUDED ALUM. MALE MULLION (AL03A)	T3 = EXTRUDED ALUM. INTERMEDIATE TRANSOM (AL13)
EM2 = WIND LOAD +DEAD LOAD FIXING LOCATION	GB = 10mm FULLY TEMPERED MONOLITHIC CLEAR GLASS (BARRIER)	M3 = EXTRUDED ALUM. FEMALE MULLION (AL04)	T4 = EXTRUDED ALUM. INTERMEDIATE TRANSOM (AL15)
EM3 = WIND LOAD FIXING LOCATION		M4 = EXTRUDED ALUM. FEMALE MULLION (AL04A)	T5 = EXTRUDED ALUM. INTERMEDIATE TRANSOM (AL14)
GL1 = 8mm HEAT STRENGTHEN LOW IRON GLASS + 1.52 PVB INTERLAYER 8mm HEAT STRENGTHEN LOW IRON GLASS + 12mm AIR SPACE +10mm LOW IRON FULLY TEMPERED IGU LAMINATED CLEAR GLASS		M7 = EXTRUDED ALUM. OUTER CORNER MALE MULLION (AL07)	T7 = EXTRUDED ALUM. TRANSOM (AL71)
		M8 = EXTRUDED ALUM. OUTER CORNER FEMALE MULLION (AL08)	T8 = EXTRUDED ALUM. TRANSOM (AL72)
		M9 = EXTRUDED ALUM. OUTER CORNER MALE MULLION (AL86)	T9 = EXTRUDED ALUM. TRANSOM (AL69)
		M10 = EXTRUDED ALUM. OUTER CORNER FEMALE MULLION (AL85)	T10 = EXTRUDED ALUM. TRANSOM (AL70)
		M13 = EXTRUDED ALUM. INTERMEDIATE MULLION (AL65)	T11 = EXTRUDED ALUM. INTERMEDIATE TRANSOM(AL106)
		M14 = EXTRUDED ALUM. INTERMEDIATE MULLION (AL66)	T12 = EXTRUDED ALUM. INTERMEDIATE TRANSOM(AL107)
		M15 = EXTRUDED ALUM. MALE MULLION (AL67)	T13 = EXTRUDED ALUM. GUTTER STACK JOINT (AL105)
		M16 = EXTRUDED ALUM. FEMALE MULLION (AL68)	

① = BMU SOCKET(GLASS UNIT)

B.D. REF :
 F.S.D. REF :
 Note :
 1.All dimensions are in mm.
 2.All elevations are viewed from outside.
 3.All dimensions to be verified on site before fabrication.

GENERAL NOTES

Legend :

- F.F.L.-- Finished Floor Level
- S.F.L.-- Structural Floor Level
- (R) -- Reversed Detail

X1 -- DETAIL MARK NO.
 X001 -- REFER SHEET NO.

REV.	DATE	DESCRIPTION	BY
E	16.Nov.2022	GENERAL REVISION	
D	04.FEB.2022	GENERAL REVISION	
C	04.JAN.2022	GENERAL REVISION	
B	22.Nov.2021	GENERAL REVISION	
A	10.Nov.2021	GENERAL REVISION	

CLIENT :
MARBLE EDGE INVESTMENT LTD.

ARCHITECT :
RONALD LU & PARTNERS
 ARCHITECTS | PLANNERS | INTERIOR DESIGNERS

STRUCTURAL ENGINEER :
CMA C M WONG & ASSOCIATES LTD
 CONSULTING ENGINEERS


MAIN CONTRACTOR :
裕民建築有限公司


美特鋁質有限公司
 MIDI ALUMINIUM FABRICATOR LTD.
 Units 6-8, Sunray Industrial Centre, 1/F
 610 Cha Kwo Ling Road, Kowloon
 Tel:23489211-4 Fax:(852)27727666

PROJECT :
PROPOSED RESIDENTIAL DEVELOPMENT AT NEW KOWLOON INLAND LOT. NO.6552

TITLE :
TOWER ELEVATION "1" FOR TOWER 1-8

JOB NO. : J-857
 DRAWN BY : AN DATE : 18.Oct.2021
 CHKD BY : SCALE A1: 1:250 A3:
 DWG. NO. : SD-EL-2001 REV. : A

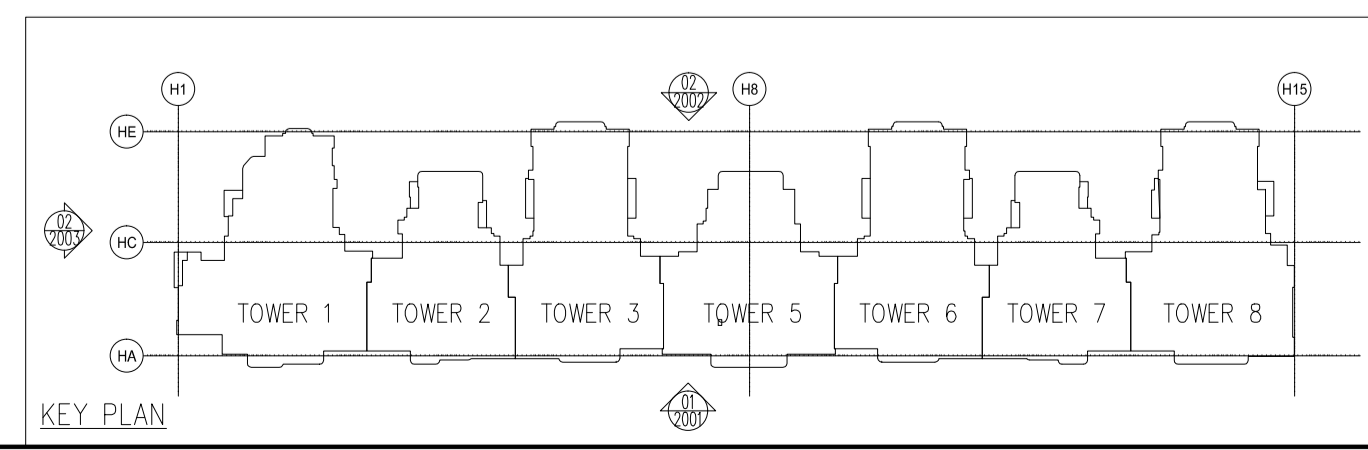

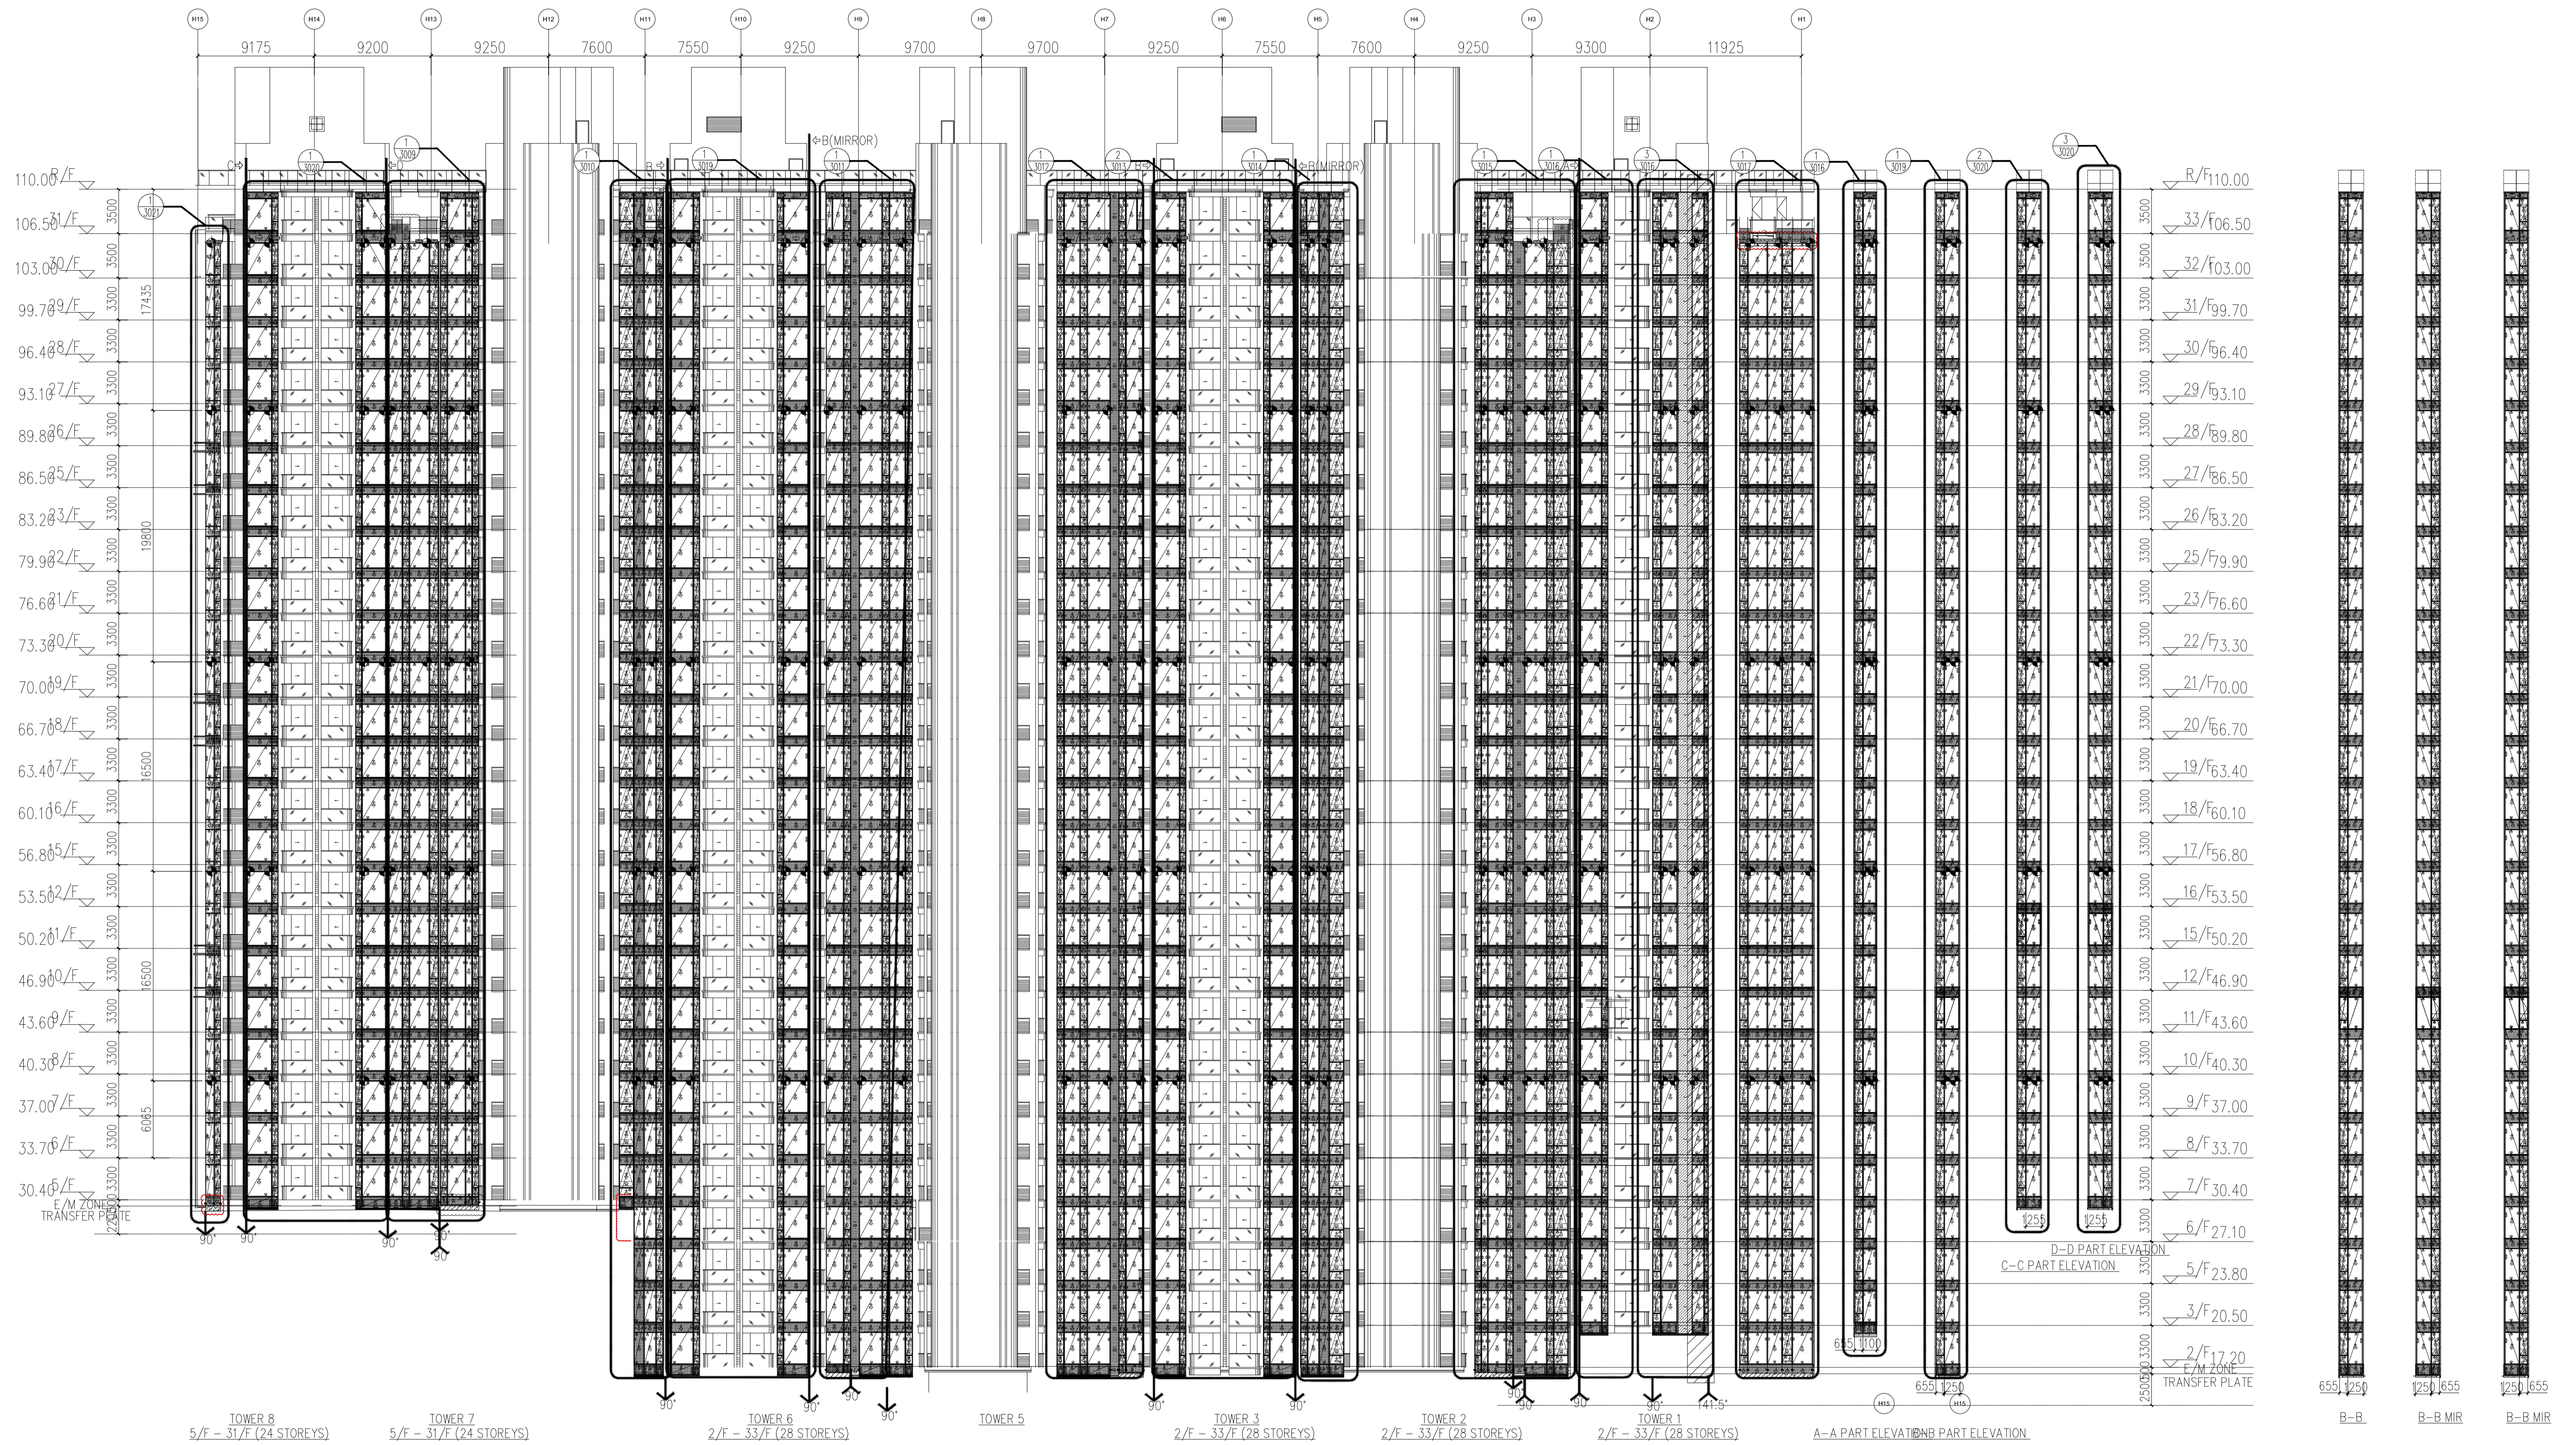

LEGEND :

S.F.L. = STRUCTURAL FLOOR LEVEL

C.W. = UNITIZED CURTAIN WALL (FOR BD APPROVAL)

◁EM1= WIND LOAD +DEAD LOAD FIXING LOCATION

◁EM2= WIND LOAD +DEAD LOAD FIXING LOCATION

◀EM3= WIND LOAD FIXING LOCATION

GL1 = 8mm HEAT STRENGTHEN LOW IRON GLASS + 1.52 PVB INTERLAYER

GL2 = 8mm HEAT STRENGTHEN LOW IRON GLASS + 12mm AIR SPACE +10mm LOW IRON FULLY TEMPERED IGU LAMINATED CLEAR GLASS

GL3 = 8mm HEAT STRENGTHEN LOW IRON GLASS + 1.52 PVB INTERLAYER+ 8mm HEAT STRENGTHEN LOW IRON GLASS + 9mm AIR SPACE +8mm LOW IRON FULLY TEMPERED IGU LAMINATED CLEAR GLASS

GL4 = 8mm FULLY TEMPERED GLASS + 1.52 PVB INTERLAYER+ 8mm FULLY TEMPERED LAMINATED GLASS

GB = 10mm FULLY TEMPERED MONOLITHIC CLEAR GLASS (BARRIER)

GL2 = 8mm HEAT STRENGTHEN LOW IRON GLASS + 1.52 PVB INTERLAYER+ 8mm HEAT STRENGTHEN LOW IRON GLASS + 12mm AIR SPACE +12mm LOW IRON FULLY TEMPERED IGU LAMINATED CLEAR GLASS

GL3 = 8mm HEAT STRENGTHEN LOW IRON GLASS + 1.52 PVB INTERLAYER+ 8mm HEAT STRENGTHEN LOW IRON GLASS + 9mm AIR SPACE +8mm LOW IRON FULLY TEMPERED IGU LAMINATED CLEAR GLASS

GL4 = 8mm FULLY TEMPERED GLASS + 1.52 PVB INTERLAYER+ 8mm FULLY TEMPERED LAMINATED GLASS

GB = 10mm FULLY TEMPERED MONOLITHIC CLEAR GLASS (BARRIER)

S.J. = STACK JOINT

M1 = EXTRUDED ALUM. MALE MULLION (AL03)

M2 = EXTRUDED ALUM. MALE MULLION (AL03A)

M3 = EXTRUDED ALUM. FEMALE MULLION (AL04)

M4 = EXTRUDED ALUM. FEMALE MULLION (AL04A)

M7 = EXTRUDED ALUM. OUTER CORNER MALE MULLION (AL07)

M8 = EXTRUDED ALUM. OUTER CORNER FEMALE MULLION (AL08)

M9 = EXTRUDED ALUM. OUTER CORNER MALE MULLION (AL86)

M10 = EXTRUDED ALUM. OUTER CORNER FEMALE MULLION (AL85)

M13 = EXTRUDED ALUM. INTERMEDIATE MULLION (AL65)

M14 = EXTRUDED ALUM. INTERMEDIATE MULLION (AL66)

M15 = EXTRUDED ALUM. MALE MULLION (AL67)

M16 = EXTRUDED ALUM. FEMALE MULLION (AL68)

TOWER 1-8-ELEVATION

SCALE 1:250

T1 = EXTRUDED ALUM. SILL STACK JOINT (AL11)

T2 = EXTRUDED ALUM. GUTTER STACK JOINT (AL12)

T3 = EXTRUDED ALUM. INTERMEDIATE TRANSOM (AL13)

T4 = EXTRUDED ALUM. INTERMEDIATE TRANSOM (AL15)

T5 = EXTRUDED ALUM. INTERMEDIATE TRANSOM (AL14)

T7 = EXTRUDED ALUM. TRANSOM (AL71)

T8 = EXTRUDED ALUM. TRANSOM (AL72)

T9 = EXTRUDED ALUM. TRANSOM (AL69)


T10 = EXTRUDED ALUM. TRANSOM (AL70)



T11 = EXTRUDED ALUM. INTERMEDIATE TRANSOM(AL106)

T12 = EXTRUDED ALUM. INTERMEDIATE TRANSOM(AL107)

T13 = EXTRUDED ALUM. GUTTER STACK JOINT (AL105)

◐ = BMU SOCKET(GLASS UNIT)

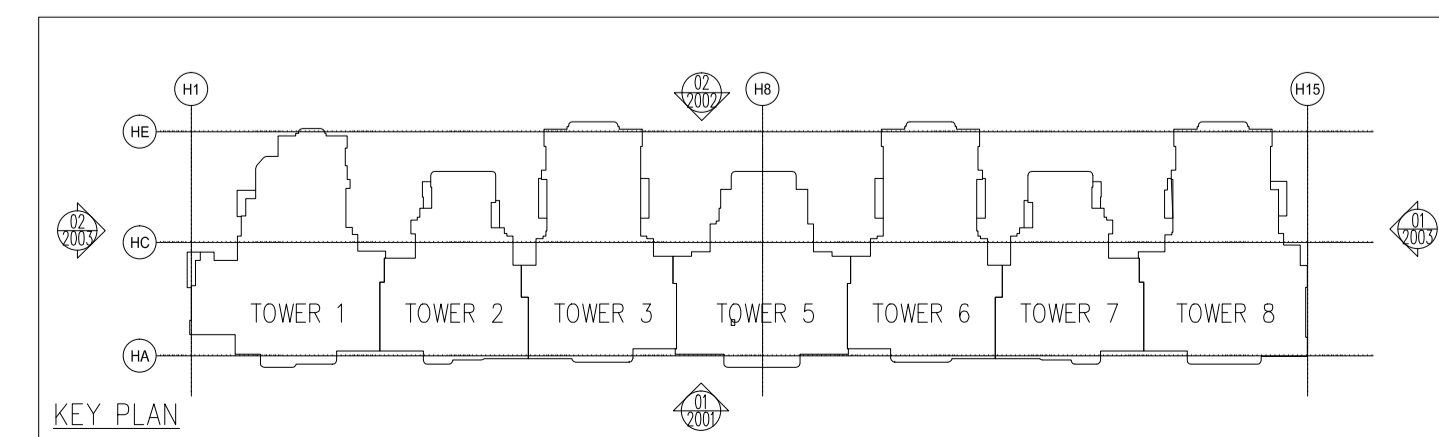

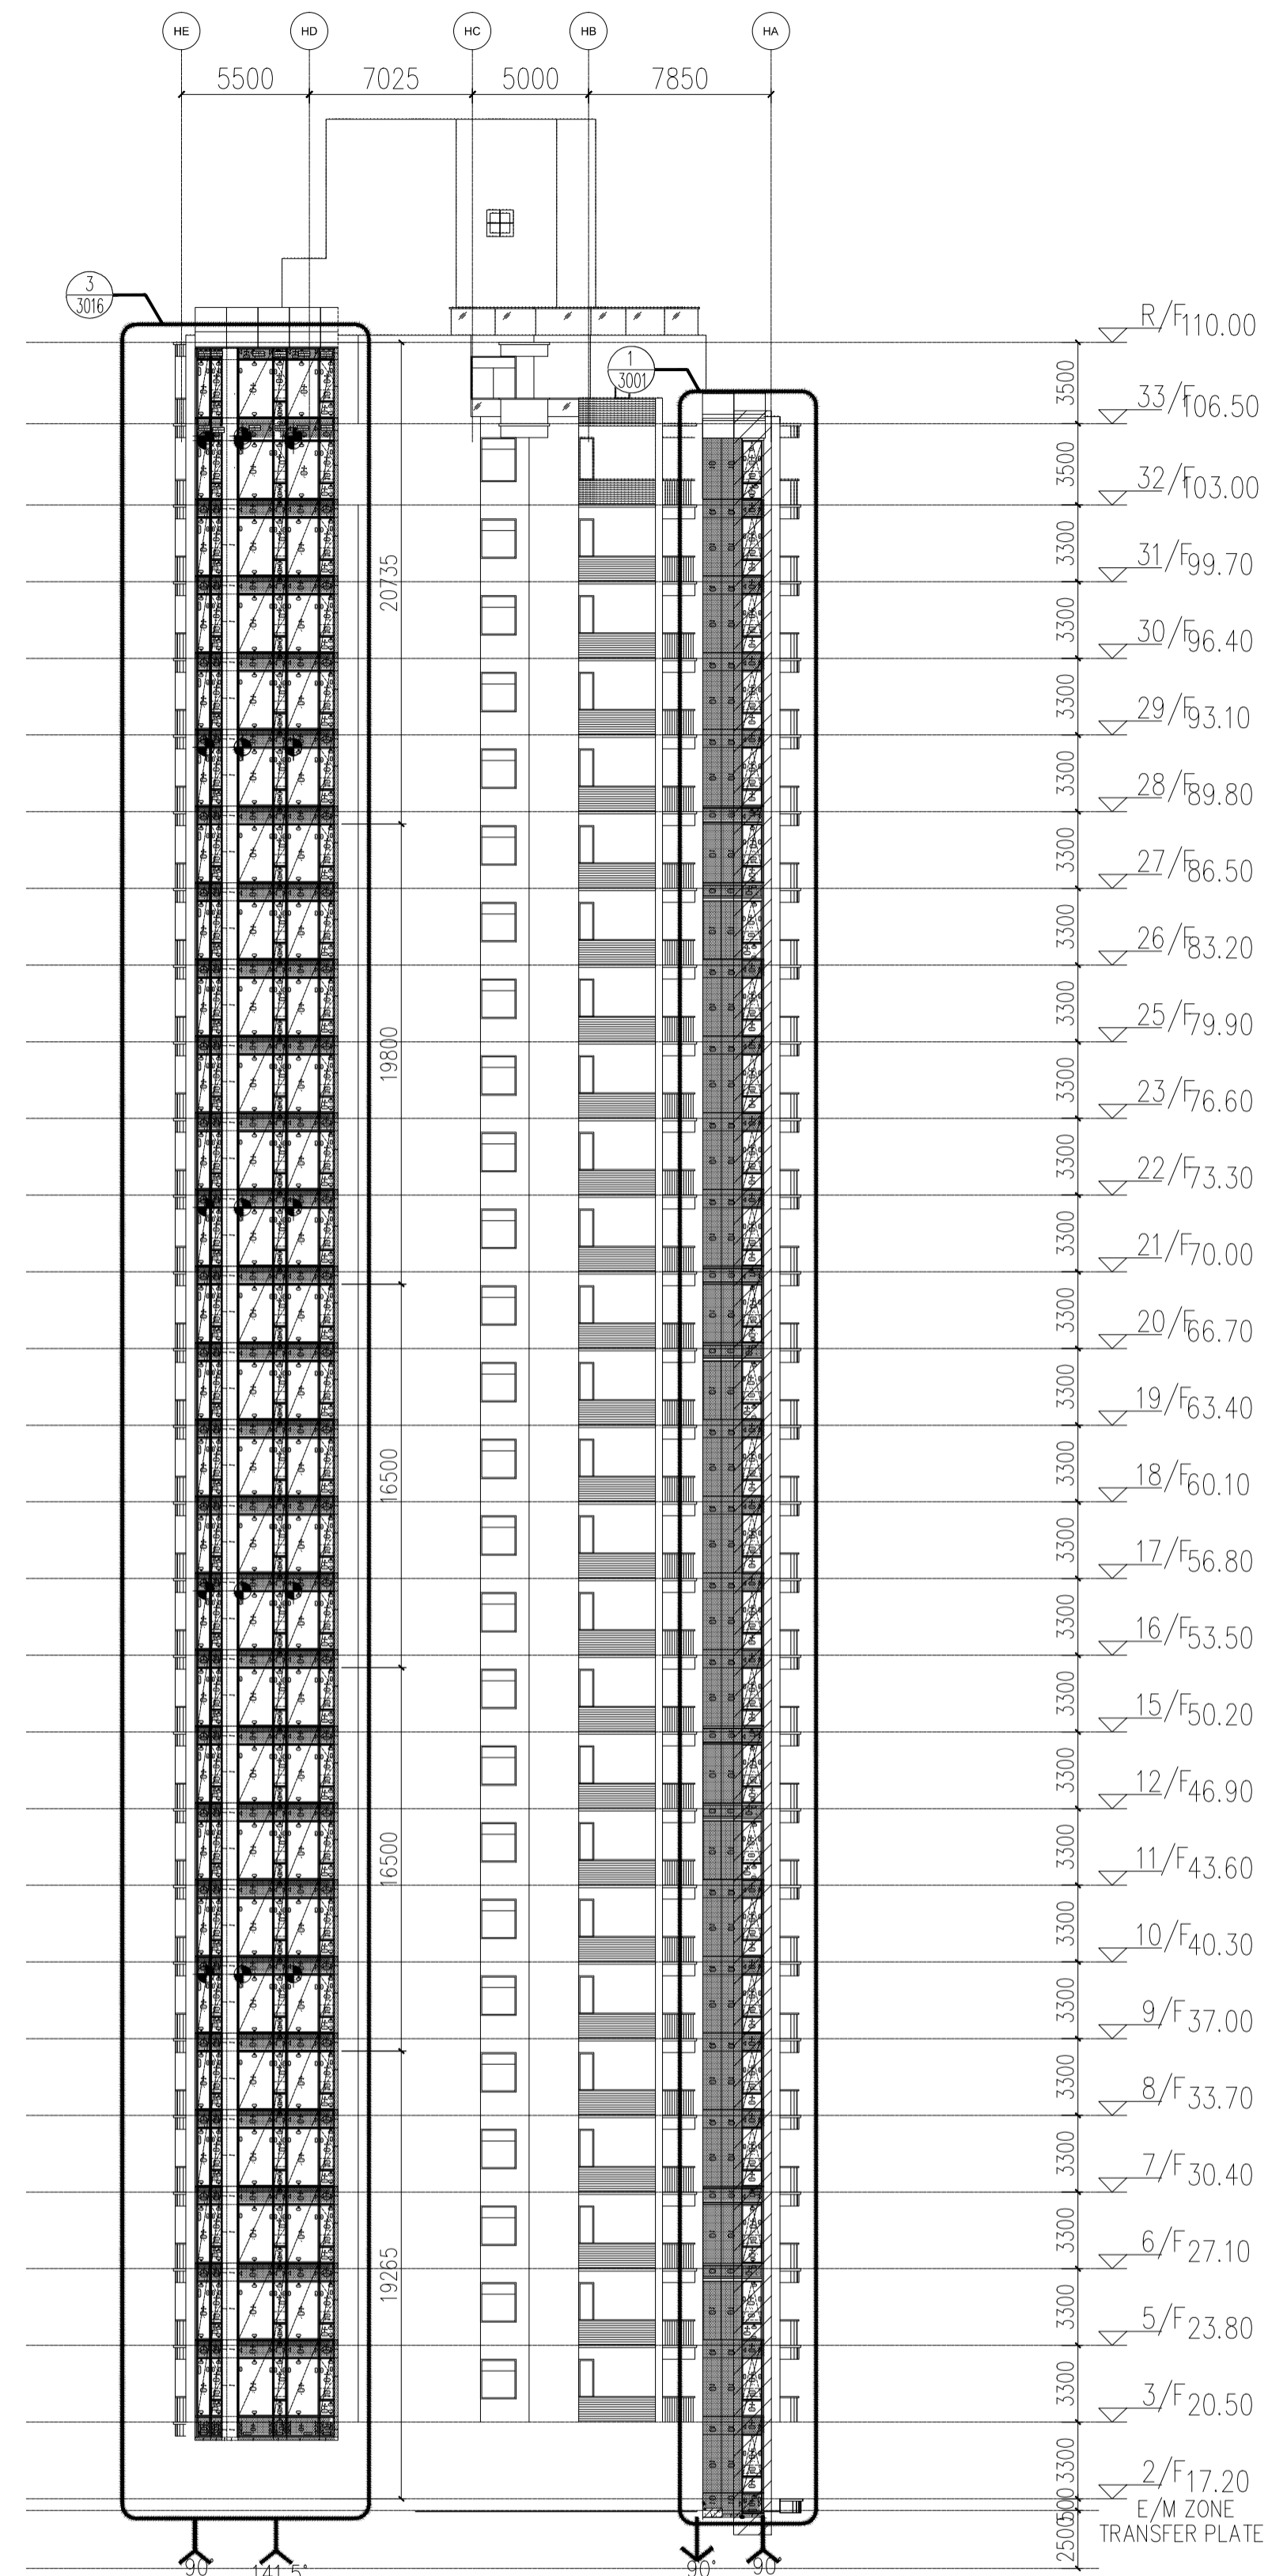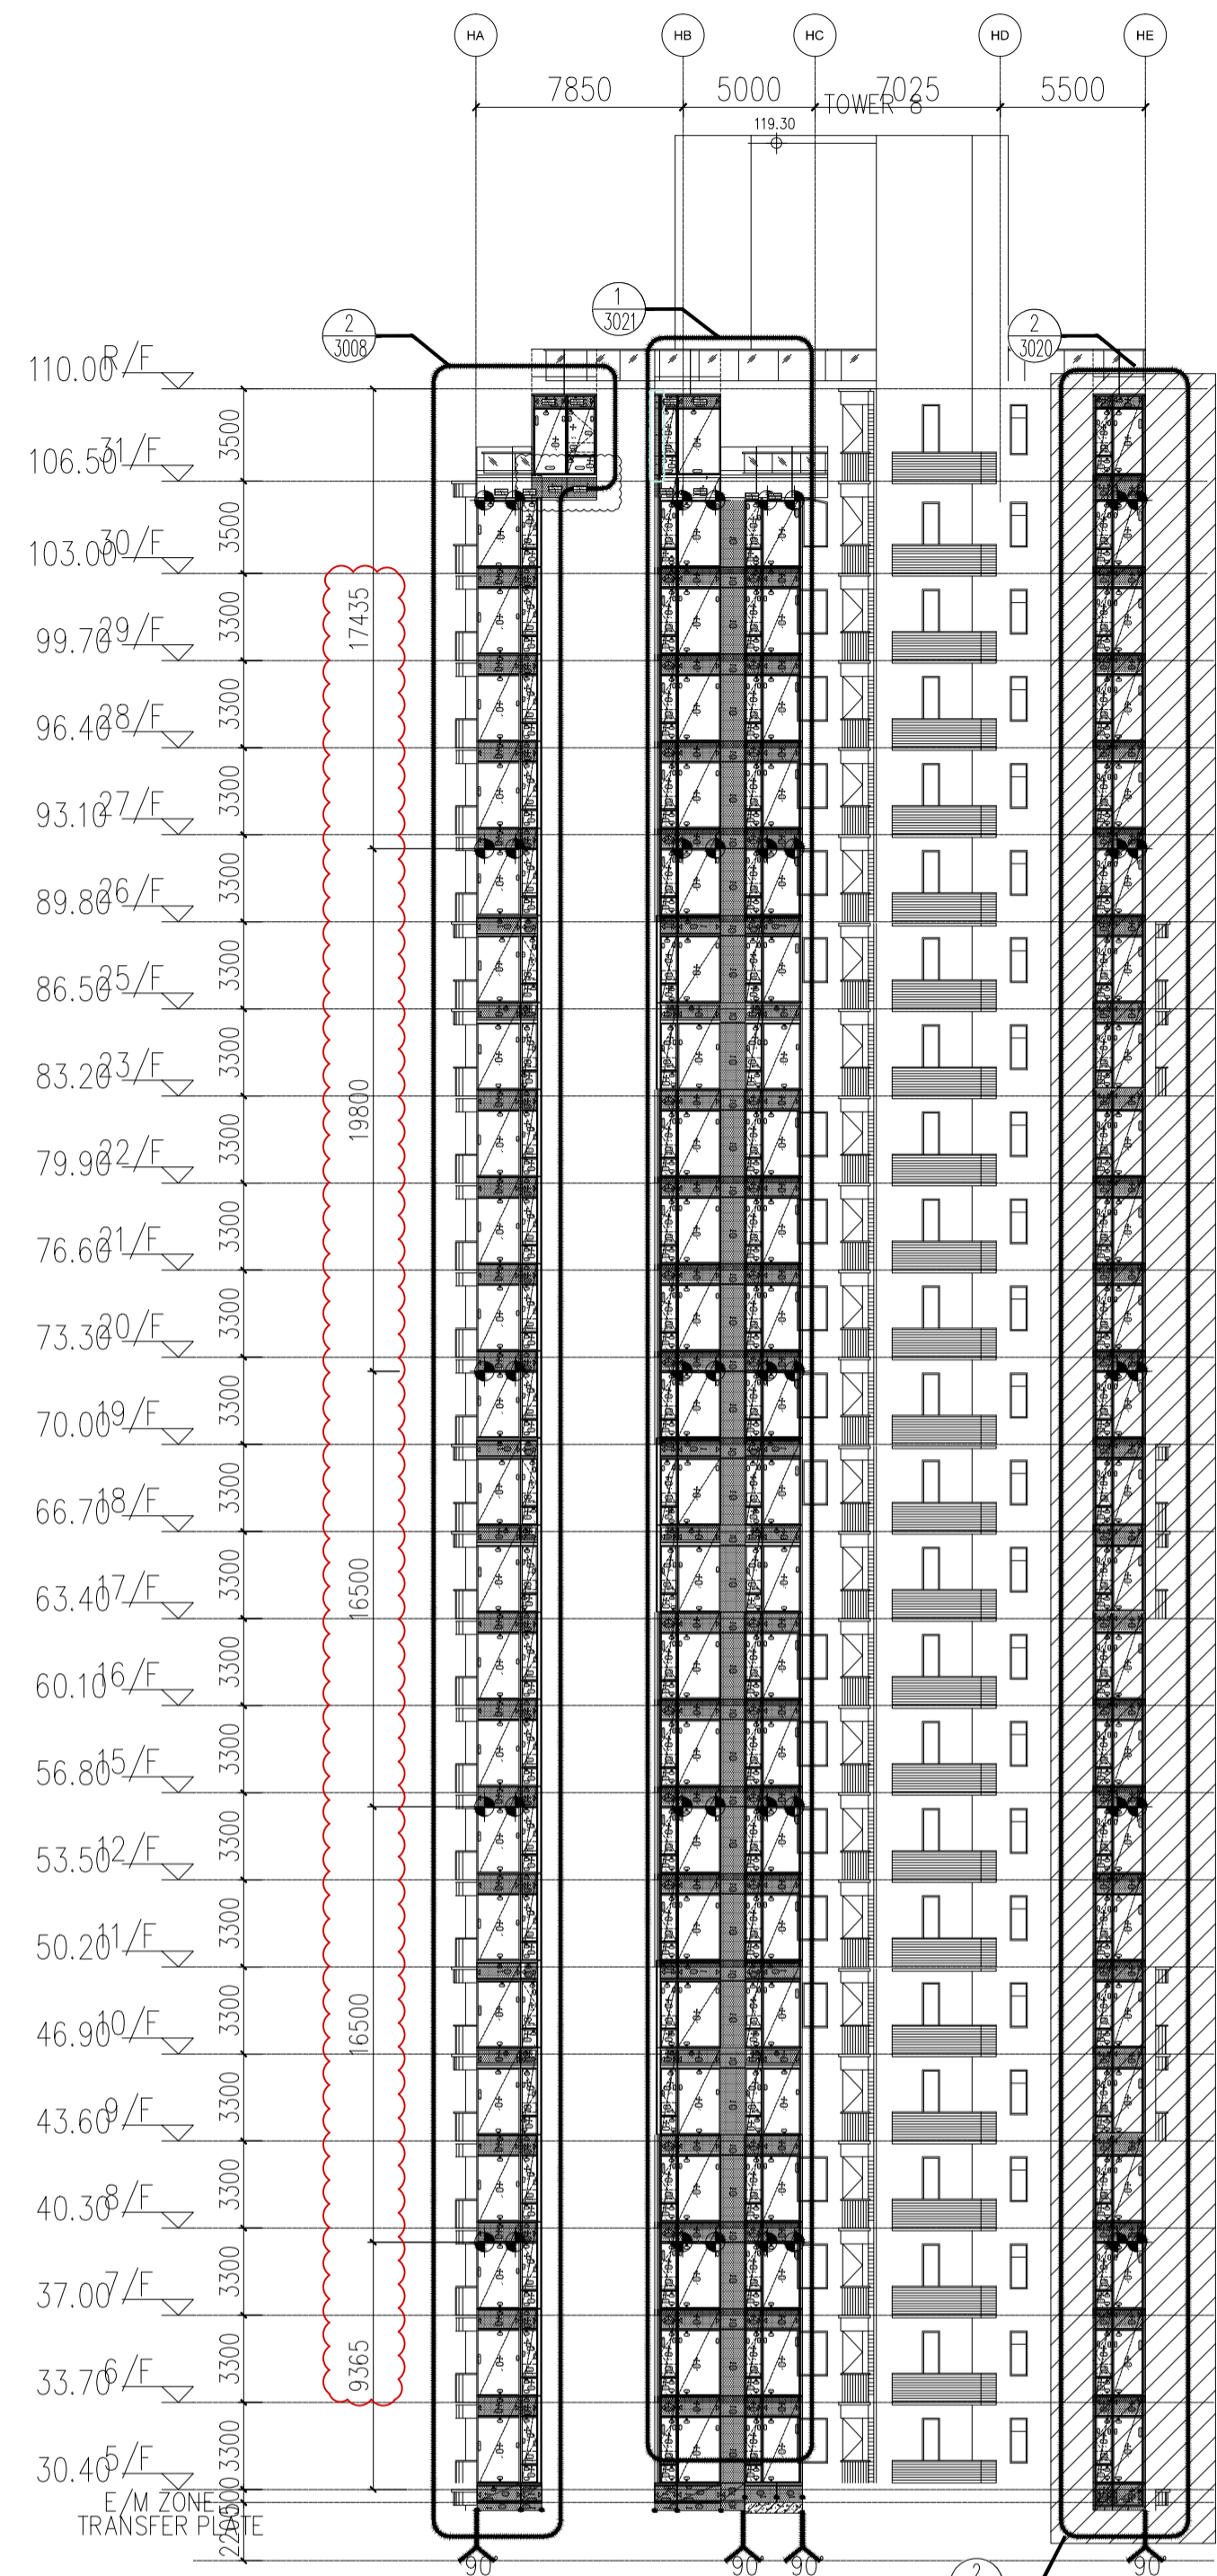

01 TOWER 8-ELEVATION
SCALE 1:250

02 TOWER 8-ELEVATION
SCALE 1:250

LEGEND :



- S.F.L. = STRUCTURAL FLOOR LEVEL
- U = UNITIZED CURTAIN WALL (FOR BD APPROVAL)
- C.W. = CURTAIN WALL (FOR BD APPROVAL)
- ◁EM1= WIND LOAD +DEAD LOAD FIXING LOCATION
- ◁EM2= WIND LOAD +DEAD LOAD FIXING LOCATION
- ◀EM3= WIND LOAD FIXING LOCATION
- GL1 = 8mm HEAT STRENGTHEN LOW IRON GLASS + 1.52 PVB INTERLAYER
- GL2 = 8mm HEAT STRENGTHEN LOW IRON GLASS + 12mm AIR SPACE +10mm LOW IRON FULLY TEMPERED LAMINATED CLEAR GLASS
- GL3 = 8mm HEAT STRENGTHEN LOW IRON GLASS + 1.52 PVB INTERLAYER+ 8mm HEAT STRENGTHEN LOW IRON GLASS + 9mm AIR SPACE +8mm LOW IRON FULLY TEMPERED LAMINATED CLEAR GLASS
- GL4 = 8mm FULLY TEMPERED GLASS + 1.52 PVB INTERLAYER+ 8mm FULLY TEMPERED LAMINATED GLASS
- GB = 10mm FULLY TEMPERED MONOLITHIC CLEAR GLASS (BARRIER)

- GL2 = 8mm HEAT STRENGTHEN LOW IRON GLASS + 12mm AIR SPACE +12mm LOW IRON FULLY TEMPERED IGU LAMINATED CLEAR GLASS
- GL3 = 8mm HEAT STRENGTHEN LOW IRON GLASS + 1.52 PVB INTERLAYER+ 8mm HEAT STRENGTHEN LOW IRON GLASS + 9mm AIR SPACE +8mm LOW IRON FULLY TEMPERED LAMINATED CLEAR GLASS
- GL4 = 8mm FULLY TEMPERED GLASS + 1.52 PVB INTERLAYER+ 8mm FULLY TEMPERED LAMINATED GLASS
- GB = 10mm FULLY TEMPERED MONOLITHIC CLEAR GLASS (BARRIER)

- S.J. = STACK JOINT
- M1 = EXTRUDED ALUM. MALE MULLION (AL03)
- M2 = EXTRUDED ALUM. MALE MULLION (AL03A)
- M3 = EXTRUDED ALUM. FEMALE MULLION (AL04)
- M4 = EXTRUDED ALUM. FEMALE MULLION (AL04A)
- M7 = EXTRUDED ALUM. OUTER CORNER MALE MULLION (AL07)
- M8 = EXTRUDED ALUM. OUTER CORNER FEMALE MULLION (AL08)
- M9 = EXTRUDED ALUM. OUTER CORNER MALE MULLION (AL86)
- M10 = EXTRUDED ALUM. OUTER CORNER FEMALE MULLION (AL85)
- M13 = EXTRUDED ALUM. INTERMEDIATE MULLION (AL65)
- M14 = EXTRUDED ALUM. INTERMEDIATE MULLION (AL66)
- M15 = EXTRUDED ALUM. MALE MULLION (AL67)
- M16 = EXTRUDED ALUM. FEMALE MULLION (AL68)

- T1 = EXTRUDED ALUM. SILL STACK JOINT (AL11)
- T2 = EXTRUDED ALUM. GUTTER STACK JOINT (AL12)
- T3 = EXTRUDED ALUM. INTERMEDIATE TRANSOM (AL13)
- T4 = EXTRUDED ALUM. INTERMEDIATE TRANSOM (AL15)
- T5 = EXTRUDED ALUM. INTERMEDIATE TRANSOM (AL14)
- T7 = EXTRUDED ALUM. TRANSOM (AL71)
- T8 = EXTRUDED ALUM. TRANSOM (AL72)
- T9 = EXTRUDED ALUM. TRANSOM (AL69)
- T10 = EXTRUDED ALUM. TRANSOM (AL70)
- T11 = EXTRUDED ALUM. INTERMEDIATE TRANSOM(AL106)
- T12 = EXTRUDED ALUM. INTERMEDIATE TRANSOM(AL107)
- T13 = EXTRUDED ALUM. GUTTER STACK JOINT (AL105)

⬇ = BMU SOCKET(GLASS UNIT)

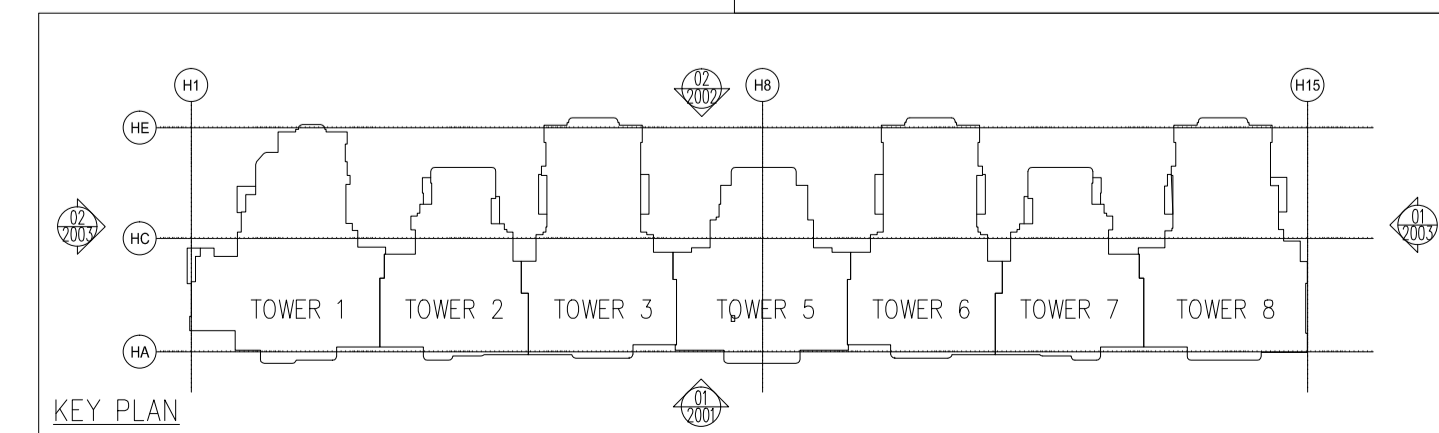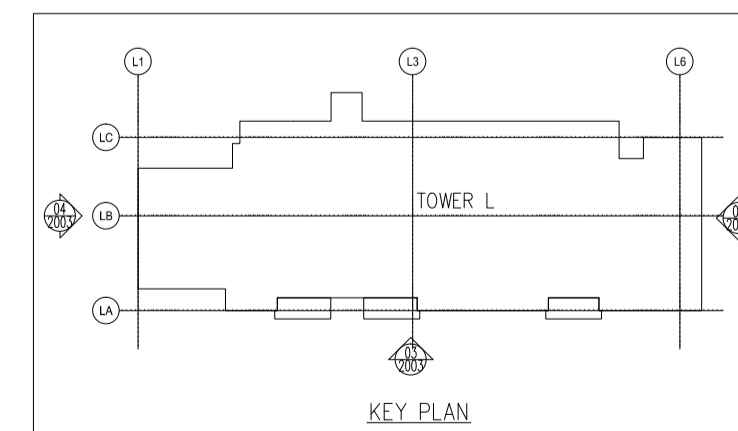


B.D. REF :
F.S.D. REF :
Note :
1.All dimensions are in mm.
2.All elevations are viewed from outside.
3.All dimensions to be verified on site before fabrication.

GENERAL NOTES

Legend :

- 1. F.F.L.-- Finished Floor Level
- 2. S.F.L.-- Structural Floor Level
- 3. (R) -- Reversed Detail

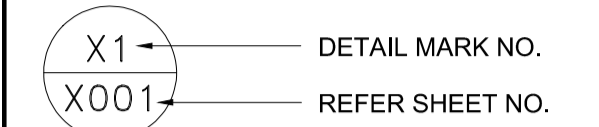

REV.	DATE	DESCRIPTION	BY
E	16.Nov.2022	GENERAL REVISION	
D	04.FEB.2022	GENERAL REVISION	
C	04.JAN.2022	GENERAL REVISION	
B	22.Nov.2021	GENERAL REVISION	
A	10.Nov.2021	GENERAL REVISION	

CLIENT :
MARBLE EDGE INVESTMENT LTD.

ARCHITECT :
RONALD LU & PARTNERS
ARCHITECTS | PLANNERS | INTERIOR DESIGNERS

STRUCTURAL ENGINEER :
CMA C M WONG & ASSOCIATES LTD
STRUCTURAL ENGINEERS


MAIN CONTRACTOR :
裕民建築有限公司

美特鋁質有限公司
MIDI ALUMINIUM FABRICATOR LTD.
Units 6-8, Sunray Industrial Centre, 1/F
610 Cha Kwo Ling Road, Kowloon
Tel:23489211-4 Fax:(852)27727666

PROJECT :
PROPOSED RESIDENTIAL DEVELOPMENT AT NEW KOWLOON INLAND LOT. NO.6552

TITLE :
TOWER ELEVATION "3" FOR TOWER 1-8&L

JOB NO. : J-857
DRAWN BY : AN DATE : 18.Oct.2021
CHKD BY : SCALE A1: 1:250 A3:
DWG. NO. : SD-EL-2003 REV. : A

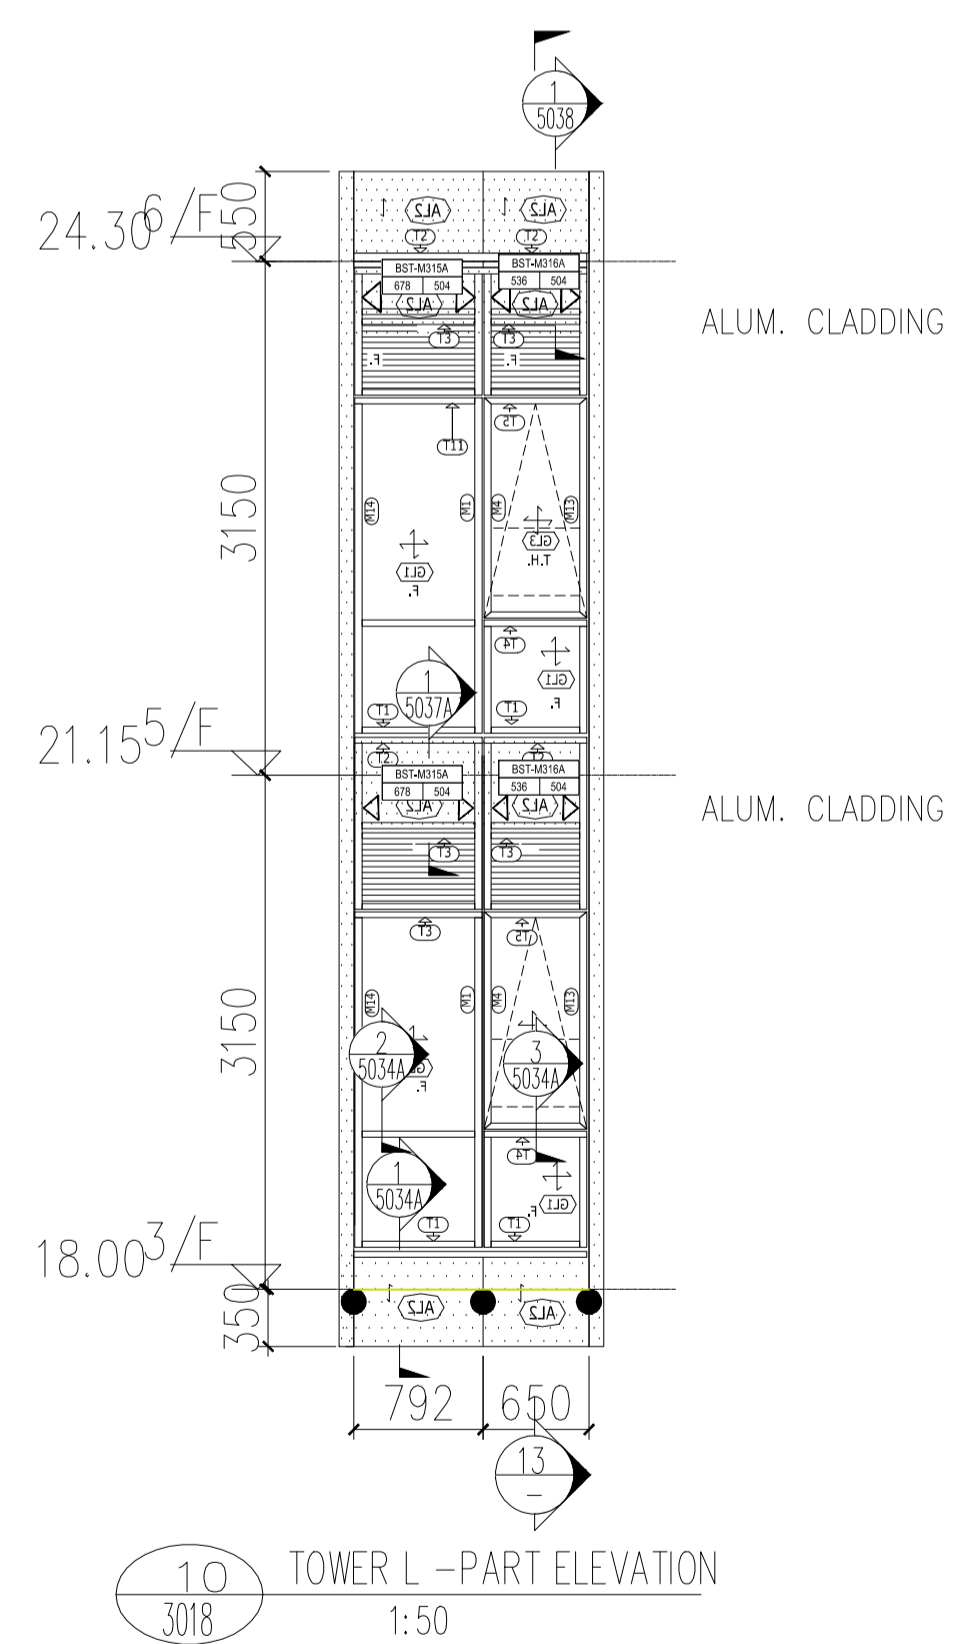

B.D. REF :

F.S.D. REF :


Note :

1. All dimensions are in mm.
2. All elevations are viewed from outside.
3. All dimensions to be verified on site before fabrication.

GENERAL NOTES

Legend :

1. F.F.L.-- Finished Floor Level
2. S.F.L.-- Structural Floor Level
3. (R) -- Reversed Detail

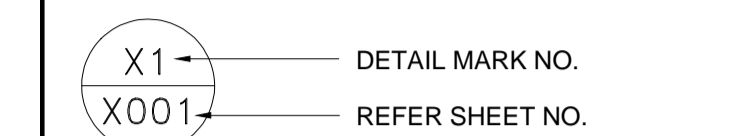

REV.	DATE	DESCRIPTION	BY
F	18.JUL.2022	GENERAL REVISION	
E	04.JAN.2022	GENERAL REVISION	
D	22.Nov.2021	GENERAL REVISION	
C	13.Nov.2021	GENERAL REVISION	
B	10.Nov.2021	GENERAL REVISION	
A	17.11.2022	GENERAL REVISION	

CLIENT :
MARBLE EDGE INVESTMENT LTD.

ARCHITECT :
RONALD LU & PARTNERS
ARCHITECTS | PLANNERS | INTERIOR DESIGNERS

STRUCTURAL ENGINEER :
CMA C M WONG & ASSOCIATES LTD
111, 113, 115, 3975,