

美特鋁質有限公司

MIDI ALUMINIUM FABRICATOR LTD.



工程指示 / 要求簡箋 ENGINEER INSTRUCTIONS(E.I.)

工程指示編號:	EI- 6.38 / 23	修改版本:	-
	HK-		
工程編號:	J 857	工程名稱:	啟德6552
收件人:	Maggie Lor	發件人:	Nero HO
工程項目:	後裝FD門和鋁窗 - 地盤用玻璃(標準層及特式層)(新增)	日期:	12/04/2023

<input type="checkbox"/> 原合約工程包	<input type="checkbox"/> 原合約工程加 / 減賬 QT-	<input type="checkbox"/> 新工程報價 QT-
---------------------------------	--	------------------------------------

信件批核號碼/圖紙參考編號:	批核模具圖紙編號:
客戶指示附件:	管理內部批簽署:

<input type="checkbox"/> 初步鋁料 B.M.	<input type="checkbox"/> 加工拆圖, 然後生產	<input type="checkbox"/> 尺寸表
<input type="checkbox"/> 正式鋁料 B.M.	<input type="checkbox"/> 技術上資料/指示	<input type="checkbox"/> 報價
<input type="checkbox"/> 配件 B.M.	<input type="checkbox"/> 樣辦或貨品說明書	<input type="checkbox"/> 分判合約
<input type="checkbox"/> 其他:		

內容:
請按附件資料生產加工, 需分座、分層包裝送地盤。
按BS EN 14179-1:2016標準, 做heat soak test
完成上列要求日期: 28/04/2023


國內


<input type="checkbox"/> 生產技術總監	<input type="checkbox"/> 連附件	<input type="checkbox"/> 技術部	<input type="checkbox"/> 連附件	<input type="checkbox"/> 生產部	<input type="checkbox"/> 連附件
<input type="checkbox"/> 採購部	<input type="checkbox"/> 連附件	<input type="checkbox"/> 生產統籌部	<input type="checkbox"/> 連附件	<input type="checkbox"/> 報關組	<input type="checkbox"/> 連附件
<input type="checkbox"/> 質檢部	<input type="checkbox"/> 連附件	<input type="checkbox"/> 會計部	<input type="checkbox"/> 連附件	<input type="checkbox"/> 機械設計部	<input type="checkbox"/> 連附件
<input type="checkbox"/> 其他:					

香港

<input type="checkbox"/> 行政部	<input type="checkbox"/> 連附件	<input type="checkbox"/> 會計部	<input type="checkbox"/> 連附件	<input type="checkbox"/> 統籌部	<input type="checkbox"/> 連附件	<input type="checkbox"/> 工程部	<input type="checkbox"/> 連附件
<input checked="" type="checkbox"/> 採購部	<input checked="" type="checkbox"/> 連附件	<input type="checkbox"/> QS部	<input type="checkbox"/> 連附件	<input checked="" type="checkbox"/> 地盤管理	<input checked="" type="checkbox"/> 連附件	<input type="checkbox"/> 維修部	<input type="checkbox"/> 連附件


*發件人簽署:	<i>Maggie Lor</i>	*組別成員批核簽署:	<i>[Signature]</i>
傳遞編號:	/	項目經理簽署:	<i>[Signature]</i>

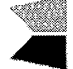 美特鋁質有限公司 MIDI Aluminium Fabricator Ltd.		工程號: J-857	計算: HHQ	日期: 4/4/2023	送呈: 施哥					
地盤名稱: 放德6552		核對:	日期: 4/4/2023	副本:						
項目類別: 後裝窗(標準層+特式層)(新增)		批准:	日期: 4/4/2023	A/C Code:						
修改版次:		總計玻璃面積 (平方米): 49.549		此BM依據						
序號	修改內容	玻璃圖號	顏色與類型		厚度 (mm)	玻璃尺寸		數量 (塊)	總面積 (平方米)	備注
			寬度 (mm)	高度 (mm)		寬度 (mm)	高度 (mm)			
1		AWTS01-G7-GL1	G7 - IGU VISION GLASS 6mm HEAT STRENGTHENED LOW IRON+12AS+10mm TEMPERED LOW IRON WITH LOW-E CLATING ON SURFACE #2 Sample No. R20210930026		28.00	521.5	2449.0	1	1.277	T1座A单元
							小計	1	1.277	
2		AW2a-G8-GL1			13.52	521.5	2574.0	1	1.342	T8座A单元
3		AW2b-G8-GL1			13.52	521.5	2699.5	1	1.408	T8座A单元
4		AW32-GL1			13.52	541.0	1201.0	2	1.299	TL座A&C单元 3F&5F
5		AW32-GL2			13.52	441.5	1201.0	2	1.060	TL座A&C单元 3F&5F
6		AW34a-GL1			13.52	1172.0	446.0	1	0.523	TL座A单元 6F
7		AW34a-GL2			13.52	642.5	1302.0	1	0.837	TL座A单元 6F
8		AW34a-GL3			13.52	462.5	1302.0	1	0.602	TL座A单元 6F
9		AWTL2-GL1			13.52	472.0	1121.0	2	1.058	TL座B单元 3F&5F
10		AW33-GL1			13.52	472.0	548.0	3	0.776	TL座A单元 6F
11		AW33-GL2			13.52	472.0	1093.0	3	1.548	TL座A单元 6F
12		TS12-GL2			13.52	1124.5	1819.0	1	2.045	T8座A单元,31F
13		TS12-GL3			13.52	587.5	1819.0	1	1.069	T8座A单元,31F
14		TS12-GL4			13.52	1779.0	625.0	1	1.112	T8座A单元,31F
15		TS10-GL1			13.52	637.0	1819.0	1	1.159	T3座A单元,33F
16		TS10-GL2			13.52	620.0	1819.0	1	1.128	T3座A单元,33F
17		TS10-GL3			13.52	1324.0	630.0	1	0.834	T3座A单元,33F
18		TS10R-GL1			13.52	637.0	1819.0	1	1.159	T6座A单元,33F
19		TS10R-GL2			13.52	620.0	1819.0	1	1.128	T6座A单元,33F
20		TS10R-GL3			13.52	1324.0	630.0	1	0.834	T6座A单元,33F


 美特鋁質 有限公司 MIDI Aluminium Fabricator Ltd		工程號: J-857	計算: HHQ	日期: 4/4/2023	送呈: 施哥						
地盤名稱: 啟德6552		核對:		日期:	副本:						
項目類別: 後裝窗(標準層+特式層)(新增)		批准:		日期:	A/C Code:						
BM編號: 修改版次: 49,549		總計玻璃面積(平方米): 此BM依據									
序號	修改內容	玻璃圖號	顏色與類型			厚度 (mm)	玻璃尺寸		數量 (號)	總面積 (平方米)	備注
			寬度 (mm)	高度 (mm)	寬度 (mm)		高度 (mm)				
21		TS09-GL1	702.0	1597.0	13.52	702.0	1597.0	1	1.121	T3座A單元,33F	
22		TS09R-GL1	702.0	1597.0	13.52	702.0	1597.0	1	1.121	T6座A單元,33F	
23		TS06-GL1	537.0	1151.0	13.52	537.0	1151.0	1	0.618	T1座A單元,33F	
24		TS06-GL2	638.5	1151.0	13.52	638.5	1151.0	1	0.735	T1座A單元,33F	
25		TS06-GL3	431.5	1151.0	13.52	431.5	1151.0	1	0.497	T1座A單元,33F	
26		TS06-G8-GL1	506.0	1701.0	13.52	506.0	1701.0	1	0.861	T1座A單元,33F	
27		TS06-G8-GL2	606.0	1701.0	13.52	606.0	1701.0	1	1.031	T1座A單元,33F	
28		TS06-G8-GL3	431.5	1701.0	13.52	431.5	1701.0	1	0.734	T1座A單元,33F	
29		TS11-GL1	857.0	1651.0	13.52	857.0	1651.0	1	1.415	T8座A單元,31F	
30		TS11-GL2	861.0	1651.0	13.52	861.0	1651.0	1	1.422	T8座A單元,31F	
31		AWTS14-G8-GL1	521.5	2489.0	13.52	521.5	2489.0	1	1.298	T1座A單元	
32		AWTS12-G8-GL1	521.5	2599.0	13.52	521.5	2599.0	1	1.355	T8座A單元	
33		AWTS09-G8-GL1	521.5	2389.0	13.52	521.5	2389.0	1	1.246	T3座A單元	
34		AWTS09R-G8-GL1	521.5	2389.0	13.52	521.5	2389.0	1	1.246	T6座A單元	
35		AWTS16-G8-GL1	521.5	2449.0	13.52	521.5	2449.0	1	1.277	T8座A單元	
				小計				41	36.897		
36		AW31-GL1	472.0	1096.0	13.52	472.0	1096.0	8	4.138	TL座 BATH&LAV 3F&5F	
37		AW31a-GL1	472.0	1156.0	13.52	472.0	1156.0	2	1.091	TL座 BATH&LAV 3F&5F	
38		TS08-GL1	412.0	1067.0	13.52	412.0	1067.0	1	0.440	T3座A單元 33F	
39		TS08R-GL1	422.0	1067.0	13.52	422.0	1067.0	1	0.450	T6座A單元 33F	
40		TS07-GL1	467.0	1342.0	13.52	467.0	1342.0	1	0.627	T3座A單元 33F	
41		TS07R-GL1	467.0	1342.0	13.52	467.0	1342.0	1	0.627	T6座A單元 33F	
42		TS13-GL1	472.0	1521.0	13.52	472.0	1521.0	1	0.718	L座A單元 6F	
43		TS04-GL1	497.0	1296.0	13.52	497.0	1296.0	1	0.644	T1座A單元 33F	

G8-1 - 6mm TEMPERED
Crystal Grey + 1.52PVB +
6mm TEMPERED Clear
LAMINATED GLASS
(Sample Code: R20220428011)

G8-2 - 6mm TEMPERED
Crystal Grey + 1.52PVB +
6mm TEMPERED clear with
Acid Etched # 4 LAMINATED
GLASS (Sample Code:
R20220428012)

 美特鋁質有限公司 MIDI Aluminum Fabricator Ltd.		工程號: J-857	計算:	HHQ	日期:	4/4/2023	送呈:	施哥	
地盤名稱: 啟德6552		核對:			日期:		副本:		
項目類別: 後裝窗(標準層+特式層)(新增)		批准:			日期:		A/C Code:		
修改版次:		總計玻璃面積 (平方米):		49,549		此BM依據			
序號	修改內容	玻璃圖號	顏色與類型	厚度 (mm)	玻璃尺寸		數量 (塊)	總面積 (平方米)	備注
					寬度 (mm)	高度 (mm)			
44		AWTS15-G8-GL1	G8-2 - 6mm TEMPERED Crystal Grey + 1.52PVB + 6mm TEMPERED clear with Acid Etched # 4 LAMINATED GLASS (Sample Code: R20220428012)	13.52	521.5	2549.0	1	1.329	T1座A單元
						小計	17	10.064	
45		TS12-GB-GL1	Gba - MONOLITHIC GLASS 12mm TEMPERED CLEAR FOR FIXED GLASS BARRIER Sample No. R20211028043	12.00	671.5	300.0	1	0.201	T8座A單元,31F
46		TS10-GB-GL1		12.00	704.0	300.0	1	0.211	T3座A單元,33F
47		TS10R-GB-GL1		12.00	704.0	300.0	1	0.211	T6座A單元,33F
48		TS09-GB-GL1		12.00	778.0	190.0	1	0.148	T3座A單元,33F
49		TS09R-GB-GL1		12.00	778.0	190.0	1	0.148	T6座A單元,33F
50		TS06-GB-GL1		12.00	613.0	190.0	1	0.116	T1座A單元,33F
51		TS06-GB-GL2		12.00	515.5	190.0	1	0.098	T1座A單元,33F
52		TS11-GB-GL1		12.00	933.0	190.0	1	0.177	T8座A單元,31F
					小計		8	1.311	
<p>1) 本表中所有玻璃對角線尺寸偏差要求不超過正負2mm。</p> <p>2) 本表中所有玻璃要求倒棱角。</p> <p>3) 本表中不同種類玻璃參照玻璃加工圖加工。</p> <p>4) 本表中所有強化玻璃均需HEAT SOAK TEST。</p> <p>5) 本表中所有強化玻璃之入爐方向均以寬度方向進入。</p> <p>6) 本表中所有玻璃成品送交地盤，每次交貨時須齊層、齊款、齊數量，每次來貨之具體數量由地盤提供。</p> <p>7) 本表中所有玻璃成品均需注明室內外面及其玻璃編號，以便識別。</p>									

新

 美特鋁質 有限公司 MIDI Aluminium Fabricator Ltd.		工程號: J-857 地盤名稱: 啟德6552 項目類別: 後裝窗(標準層+特式層/新增) 修改版次:	計算: 核對: 批准:	WYY 日期: 日期: 日期:	4/4/2023 送呈: 副本: A/C Code:	施哥			
地盤用玻璃B.M.表 BM編號:		總計玻璃面積 (平方米): 49,549 此BM依據							
序號	修改內容	玻璃圖號	顏色與類型	厚度 (mm)	玻璃尺寸		數量 (塊)	總面積 (平方米)	備注
					寬度 (mm)	高度 (mm)			
1		AWTS01-G7-GL1	G7 - IGU VISION GLASS 6mm HEAT STRENGTHENED LOW IRON+12AS+10mm TEMPERED LOW IRON WITH LOW-E CLATING ON SURFACE #2 Sample No. R20210930026	28.00	521.5	2449.0	1	1.277	T1座A單元
						小計	1	1.277	
2		AW2a-G8-GL1	G8-1 - 6mm TEMPERED Crystal Grey + 1.52PVB + 6mm TEMPERED Clear LAMINATED GLASS (Sample Code: R20220428011)	13.52	521.5	2574.0	1	1.342	T8座A單元
3		AW2b-G8-GL1		13.52	521.5	2699.5	1	1.408	T8座A單元
4		AW32-GL1		13.52	541.0	1201.0	2	1.299	TL座A&C單元 3F&5F
5		AW32-GL2		13.52	441.5	1201.0	2	1.060	TL座A&C單元 3F&5F
6		AW34a-GL1		13.52	1172.0	446.0	1	0.523	TL座A單元 6F
7		AW34a-GL2		13.52	642.5	1302.0	1	0.837	TL座A單元 6F
8		AW34a-GL3		13.52	462.5	1302.0	1	0.602	TL座A單元 6F
9		AWTL2-GL1		13.52	472.0	1121.0	2	1.058	TL座B單元 3F&5F
10		AW33-GL1		13.52	472.0	548.0	3	0.776	TL座A單元6F
11		AW33-GL2		13.52	472.0	1093.0	3	1.548	TL座A單元6F
12		TS12-GL2		13.52	1124.5	1819.0	1	2.045	T8座A單元,31F
13		TS12-GL3		13.52	587.5	1819.0	1	1.069	T8座A單元,31F
14		TS12-GL4		13.52	1779.0	625.0	1	1.112	T8座A單元,31F
15		TS10-GL1		13.52	637.0	1819.0	1	1.159	T3座A單元,33F
16		TS10-GL2		13.52	620.0	1819.0	1	1.128	T3座A單元,33F
17		TS10-GL3		13.52	1324.0	630.0	1	0.834	T3座A單元,33F
18		TS10R-GL1		13.52	637.0	1819.0	1	1.159	T6座A單元,33F
19		TS10R-GL2		13.52	620.0	1819.0	1	1.128	T6座A單元,33F
20		TS10R-GL3		13.52	1324.0	630.0	1	0.834	T6座A單元,33F

修改


美特鋁質有限公司 MIDI Aluminium Fabricator Ltd.		工程號:	J-857	計算:	WVY	日期:	4/4/2023	送呈:	施哥	
地盤名稱:		啟德6552		核對:		日期:		副本:		
項目類別:		後裝窗(標準層+特式層)(新增)		批准:		日期:		A/C Code:		
修改版次:		總計玻璃面積(平方米):		49,549		此BM依據				
序號	修改內容	玻璃圖號	顏色與類型	玻璃尺寸			數量 (塊)	總面積 (平方米)	備注	
				厚度 (mm)	寬度 (mm)	高度 (mm)				
21		TS09-GL1	G8-1 - 6mm TEMPERED Crystal Grey + 1.52PVB + 6mm TEMPERED Clear LAMINATED GLASS (Sample Code: R20220428011)	13.52	702.0	1597.0	1	1.121	T3座A單元,33F	
22		TS09R-GL1		13.52	702.0	1597.0	1	1.121	T6座A單元,33F	
23		TS06-GL1		13.52	537.0	1151.0	1	0.618	T1座A單元,33F	
24		TS06-GL2		13.52	638.5	1151.0	1	0.735	T1座A單元,33F	
25		TS06-GL3		13.52	431.5	1151.0	1	0.497	T1座A單元,33F	
26		TS06-G8-GL1		13.52	506.0	1701.0	1	0.861	T1座A單元,33F	
27		TS06-G8-GL2		13.52	606.0	1701.0	1	1.031	T1座A單元,33F	
28		TS06-G8-GL3		13.52	431.5	1701.0	1	0.734	T1座A單元,33F	
29		TS11-GL1		13.52	857.0	1651.0	1	1.415	T8座A單元,31F	
30		TS11-GL2		13.52	861.0	1651.0	1	1.422	T8座A單元,31F	
31		AWTS14-G8-GL1		13.52	521.5	2489.0	1	1.298	T1座A單元	
32		AWTS12-G8-GL1		13.52	521.5	2599.0	1	1.355	T8座A單元	
33		AWTS09-G8-GL1		13.52	521.5	2389.0	1	1.246	T3座A單元	
34		AWTS09R-G8-GL1		13.52	521.5	2389.0	1	1.246	T6座A單元	
35		AWTS16-G8-GL1		13.52	521.5	2449.0	1	1.277	T8座A單元	
						小計		41	36.897	
36		AW31-GL1		G8-2 - 6mm TEMPERED Crystal Grey + 1.52PVB + 6mm TEMPERED clear with Acid Etched # 4 LAMINATED GLASS (Sample Code: R20220428012)	13.52	472.0	1096.0	8	4.138	TL座 BATH&LAV 3F&5F
37		AW31a-GL1			13.52	472.0	1156.0	2	1.091	TL座 BATH&LAV 3F&5F
38		TS08-GL1			13.52	412.0	1067.0	1	0.440	T3座A單元 33F
39		TS08R-GL1			13.52	422.0	1067.0	1	0.450	T6座A單元 33F
40		TS07-GL1			13.52	467.0	1342.0	1	0.627	T3座A單元 33F
41		TS07R-GL1			13.52	467.0	1342.0	1	0.627	T6座A單元 33F
42		TS13-GL1			13.52	472.0	1521.0	1	0.718	L座A單元 6F
43		TS04-GL1			13.52	497.0	1296.0	1	0.644	T1座A單元 33F

修

美特鋁質 有限公司 MIDI Aluminium Fabricator Ltd.		工程號: 地盤名稱:	J-857 啟德6552	計算: 核對:	WVY	日期: 日期:	4/4/2023	送呈: 副本:	施哥
地盤用玻璃B.M.表		項目類別:	後裝窗(標準層+特式層)(新構)	批准:		日期:		A/C Code:	
BM編號:	修改內容	修改版次:	顏色與類型	厚度 (mm)	總計玻璃面積 (平方米):		此BM依據		備注
序號	玻璃圖號				寬度 (mm)	高度 (mm)	數量 (塊)	總面積 (平方米)	
44	AWTS15-G8-GL1		G8-2 - 6mm TEMPERED Crystal Grey + 1.52PVB + 6mm TEMPERED clear with Acid Etched # 4 LAMINATED GLASS (Sample Code: R20220428012)	13.52	521.5	2549.0	1	1.329	T1座A單元
						小計	17	10.064	
45	TS12-GB-GL1		Gba - MONOLITHIC GLASS 12mm TEMPERED CLEAR FOR FIXED GLASS BARRIER Sample No. R20211028043	12.00	671.5	300.0	1	0.201	T8座A單元,31F
46	TS10-GB-GL1			12.00	704.0	300.0	1	0.211	T3座A單元,33F
47	TS10R-GB-GL1			12.00	704.0	300.0	1	0.211	T6座A單元,33F
48	TS09-GB-GL1			12.00	778.0	190.0	1	0.148	T3座A單元,33F
49	TS09R-GB-GL1			12.00	778.0	190.0	1	0.148	T6座A單元,33F
50	TS06-GB-GL1			12.00	613.0	190.0	1	0.116	T1座A單元,33F
51	TS06-GB-GL2			12.00	515.5	190.0	1	0.098	T1座A單元,33F
52	TS11-GB-GL1			12.00	933.0	190.0	1	0.177	T8座A單元,31F
						小計	8	1.311	

- 1). 本表中所有玻璃對角線尺寸偏差要求不超過正負2mm。
- 2). 本表中所有玻璃要求倒棱角。
- 3). 本表中不同種類玻璃參照玻璃加工圖加工。
- 4). 本表中所有強化玻璃均需HEAT SOAK TEST。
- 5). 本表中所有強化玻璃之入爐方向均以寬度方向進入。
- 6). 本表中所有玻璃成品送交地盤，每次交貨時須齊層、齊款、齊數量，每次來貨之具體數量由地盤提供。
- 7). 本表中所有玻璃成品均需注明室內外面及其玻璃編號，以便識別。

 美特鋁質 有限公司 MIDI Aluminium Fabricator Ltd.				類別		物料號	
				制圖	HHQ	2022.12.1	圖號 J857-G7
修改	-	-		復核	WLQ	2022.12.1	數量
日期	-	-		批准			位置

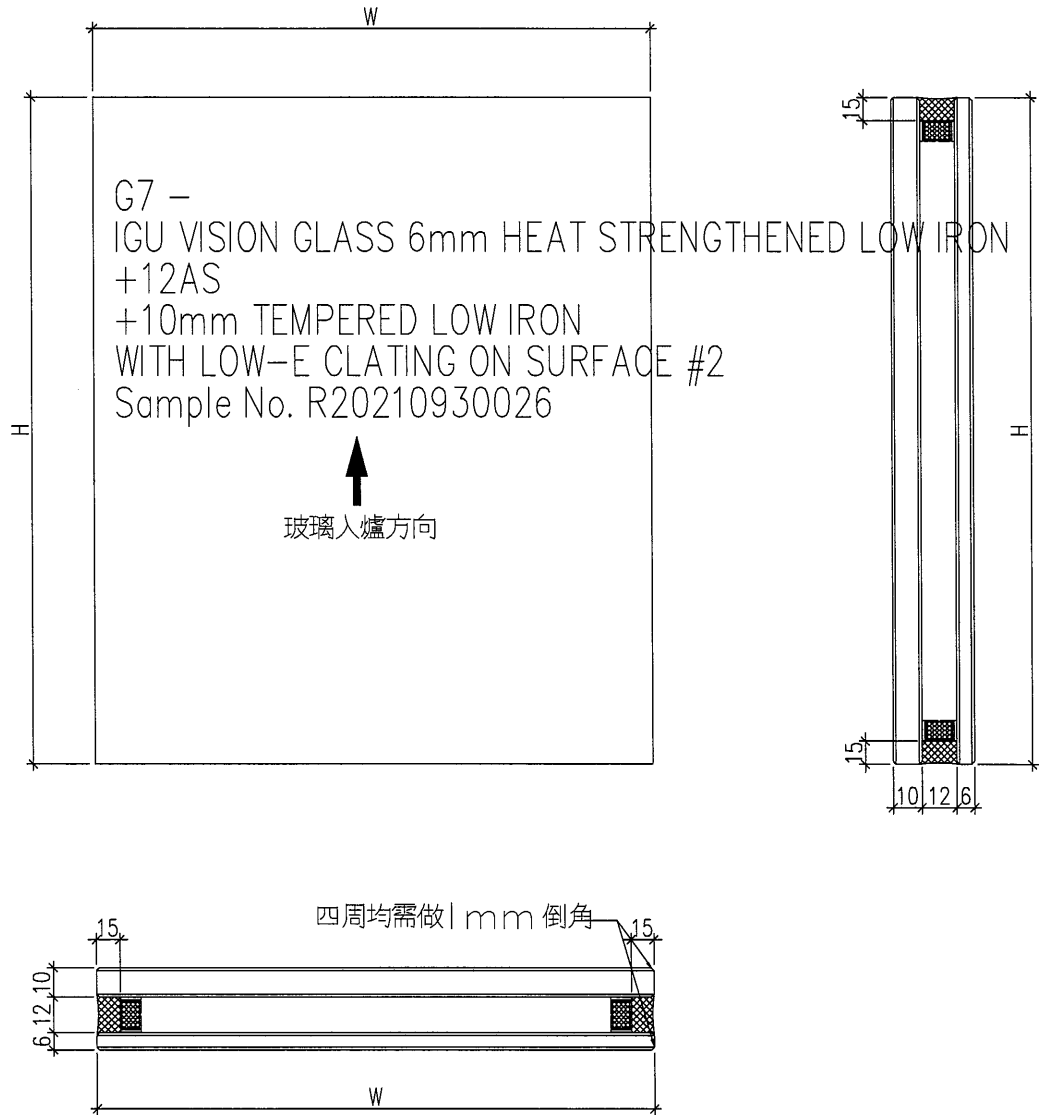


工程號	J-857	地盤	啟德6552	附 件
名稱	玻璃加工圖		採用	
材料	-		地盤	
顏色	-		工廠	



美特鋁質 有限公司
MIDI Aluminium Fabricator Ltd.

類別		物料號		
制圖	HHQ	2022.12.1	圖號	J857-G8-1
修改	-	-	數量	
日期	-	-	位置	
復核	WLQ	2022.12.1		
批准				

G8-1 – 6mm TEMPERED Crystal Grey
+ 1.52PVB
+ 6mm TEMPERED Clear LAMINATED GLASS
(Sample Code: R20220428011)

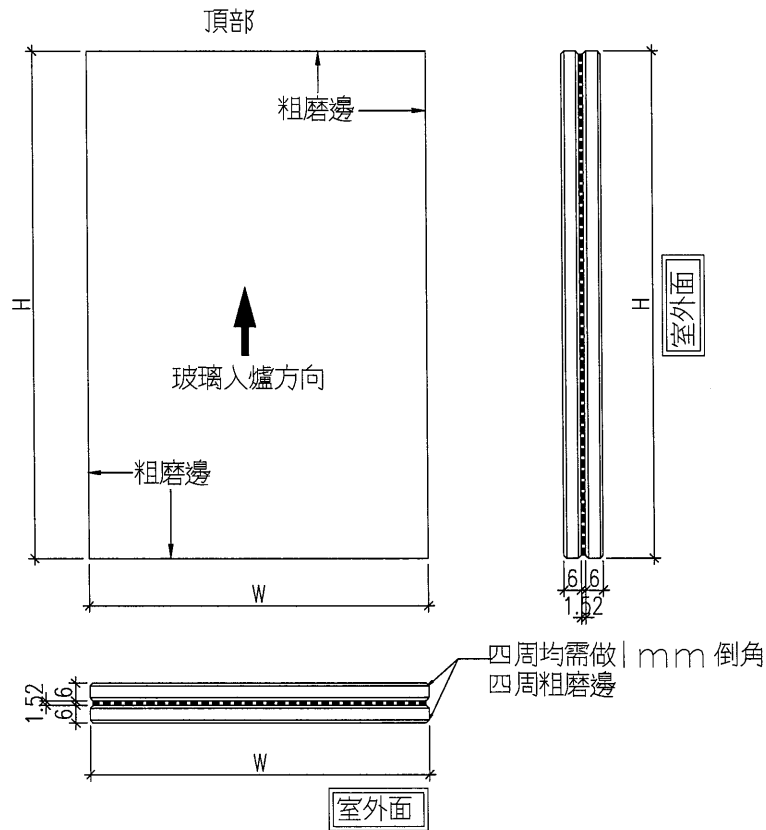


工程號	J-857	地盤	啟德6552	附 件
名稱	玻璃加工圖		採用	
材料	-		地盤	
顏色	-		工廠	



美特鋁質 有限公司
MIDI Aluminium Fabricator Ltd.

類別		物料號		
制圖	HHQ	2022.12.1	圖號	J857-G8-2
修改	-	-	數量	
日期	-	-	位置	
復核	WLQ	2022.12.1		
批准				


G8-2 -
6mm TEMPERED Crystal Grey
+ 1.52PVB
+ 6mm TEMPERED clear with Acid Etched # 4
LAMINATED GLASS
(Sample Code: R20220428012)

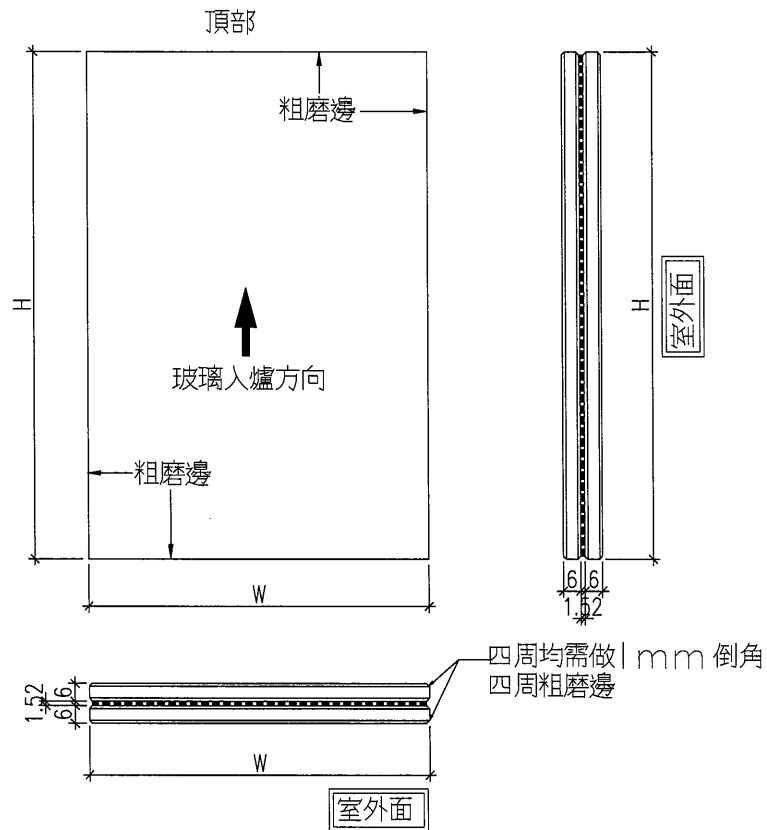


工程號	J-857	地盤	啟德6552	附 件
名稱	玻璃加工圖		採用	
材料	-		地盤	
顏色	-		工廠	

 美特鋁質 有限公司 MIDI Aluminium Fabricator Ltd.				類別		物料號		
修改	-	-		制圖	HHQ	2022.12.1	圖號	J857-Gba
日期	-	-		復核	WLQ	2022.12.1	數量	
				批准			位置	

Gba -
 MONOLITHIC GLASS 12mm
 TEMPERED CLEAR FOR FIXED GLASS BARRIER
 Sample No. R20211028043

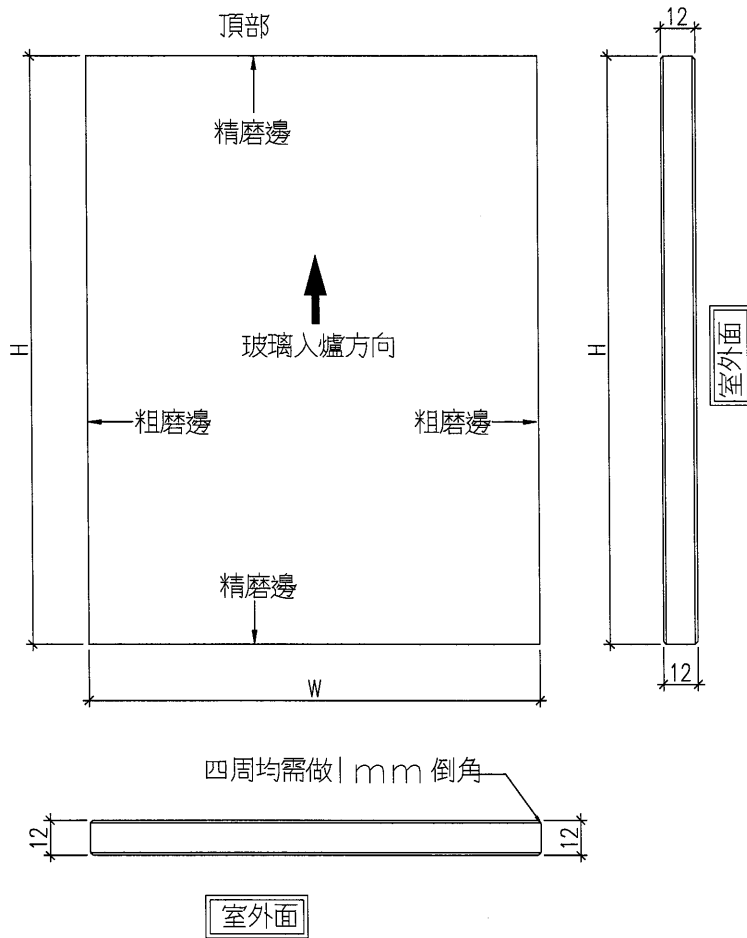


工程號	J-857	地盤	啟德6552	附 件
名稱	玻璃加工圖		採用	
材料	-		地盤	
顏色	-		工廠	

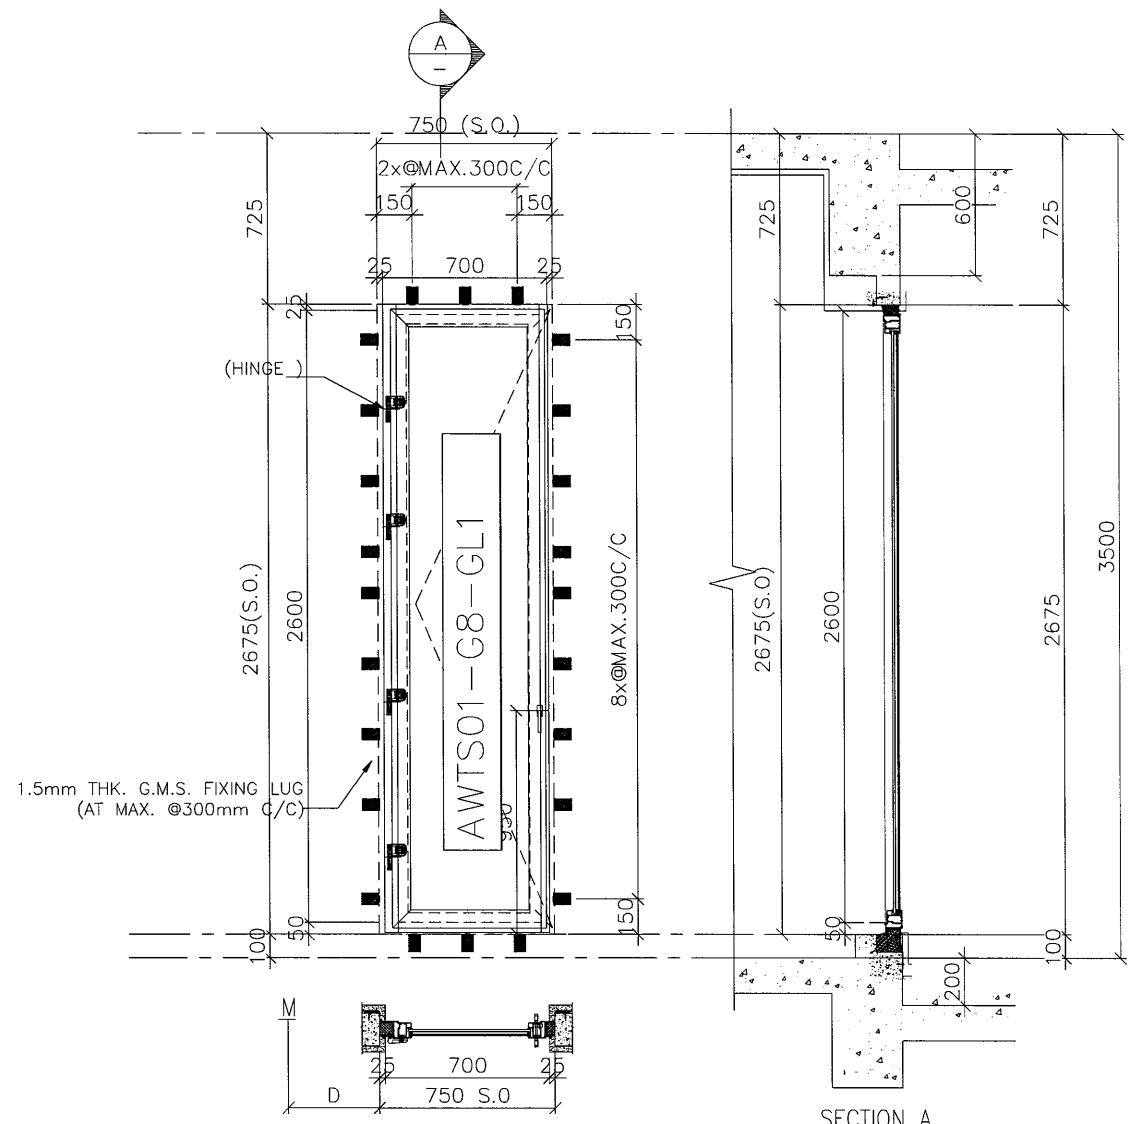

M	D	
H1	-1825	I1A
HB	1975	I1A
HC	2290	I8A

OPENABLE AREA	GLAZING AREA
1.693	1.289

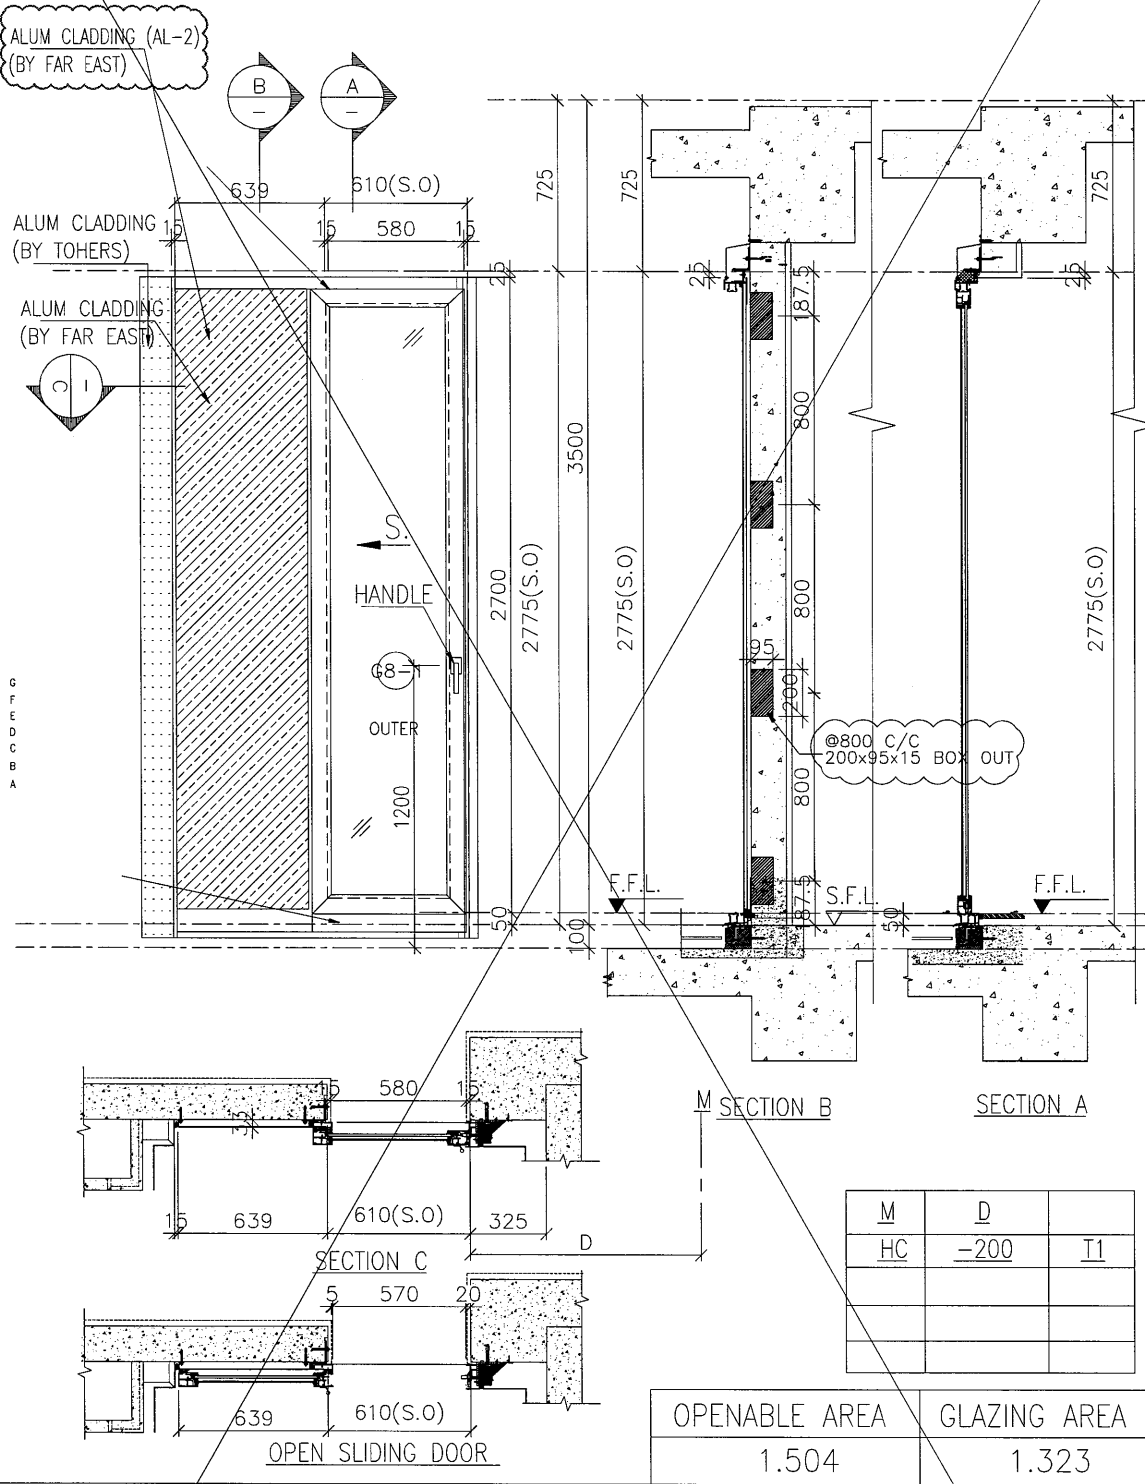

M	D	
HC	-200	I1

OPENABLE AREA	GLAZING AREA
1.504	1.323

WINDOW MARK	AW TS01
SECTION :	65mm ALUM. SECTION
QTY.	1NOS.
LOCATION :	T1 FLAT A MBR AT 33/F
GLAZING	⑦ IGU VISION GLASS 6mm HS LOW IRON+12AS+10mm FT LOW IRON WITH LOW-E CLATING ON SURFACE #2
REMARK :	

WINDOW MARK	AW TS05
SECTION :	65mm ALUM. SECTION
QTY.	1 NOS.
LOCATION :	T1 FLAT A UTILITY RM AT 33F
GLAZING	G8-1 6mm FT Grey Tinted+1.52PVB+6mm FT Clear Laminated Glass/ ⑧ MONOUTHIC GLASS 8mm FT CLEAR
REMARK :	

B.D. REF :
F.S.D. REF :

Note :
1.All dimensions are in mm.
2.All elevations are verified from outside.
3.All dimensions to be verified on site before fabrication.

GENERAL NOTES

Legend :
1. F.F.L.-- Finished Floor Level
2. S.F.L.-- Structural Floor Level
3. (R) -- Reversed Detail

X1 -- DETAIL MARK NO.
X001 -- REFER SHEET NO.

NO.	DATE	GENERAL REVISION	REVISED	BY
A	25.11.2022	GENERAL REVISION		
-	1.11.2022	GENERAL REVISION		

CLIENT :
MARBLE EDGE INVESTMENT LTD.

ARCHITECT :
RONALD LU & PARTNERS
ARCHITECTS | PLANNERS | INTERIOR DESIGNERS

STRUCTURAL ENGINEER :
CMA C M WONG & ASSOCIATES LTD
THE HONG KONG INSTITUTE OF SURVEYORS

MAIN CONTRACTOR :
?????????

美特鋁質有限公司
MIDI ALUMINIUM FABRICATOR LTD.
Units 6-8, Sunray Industrial Centre, 1/F
610 Cha Kwo Ling Road, Kowloon
Tel:23489211-4 Fax:(852)27727666

PROJECT :
PROPOSED RESIDENTIAL DEVELOPMENT AT NEW KOWLOON INLAND LOT. NO.6552


TITLE :
WINDOW SCHEDULE FOR IN-SITU ALUM. WINDOW

JOB NO. : J-857


DRAWN BY : AN DATE : 18.OCT.2021

CHKD BY : SCALE A1: A3: 1:30


DWG. NO. : J857-IW-2002A REV. : A

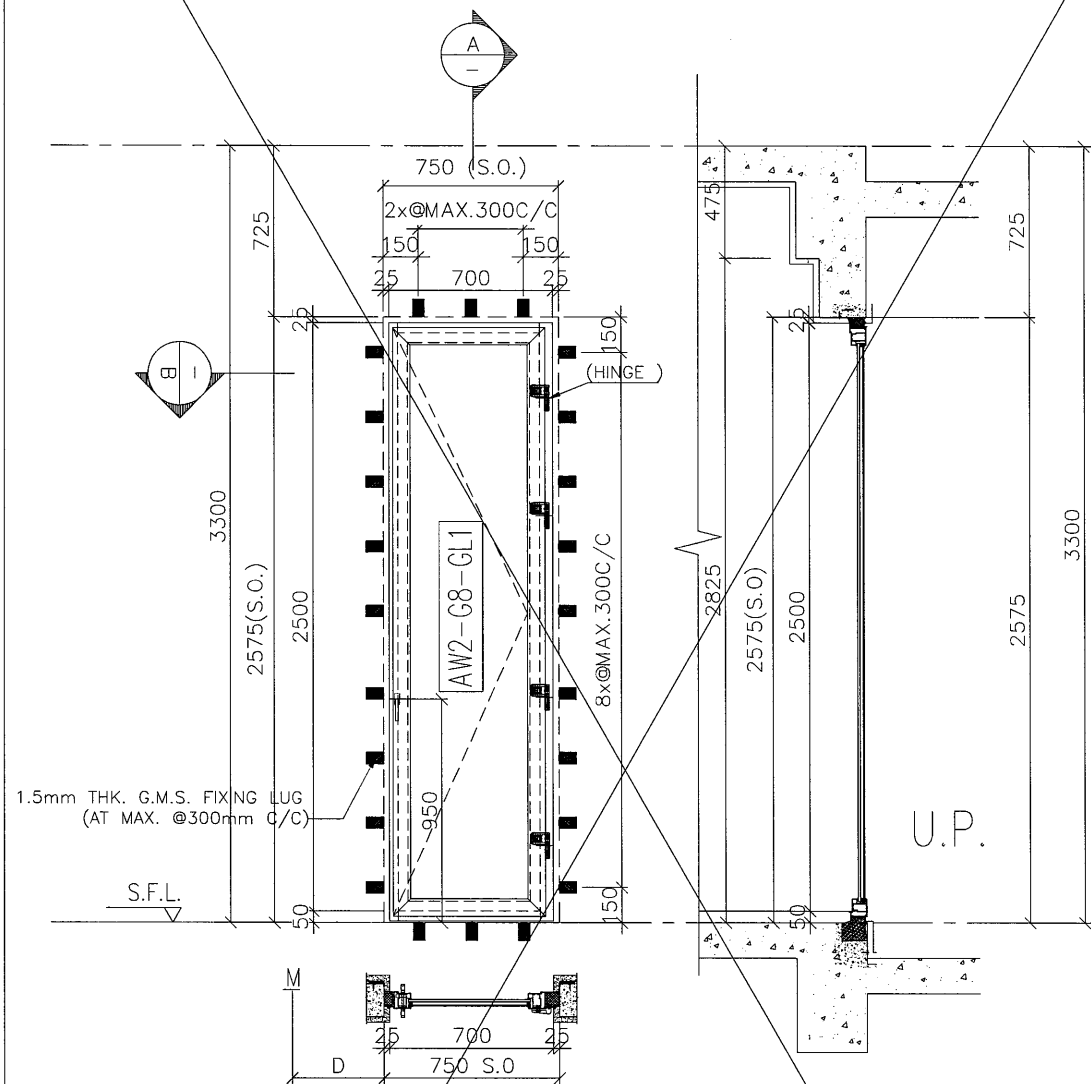


M	D	
HC	50	T6A
HD	5650	T8A

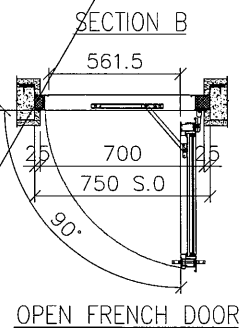

OPENABLE AREA	GLAZING AREA
1.49	1.24

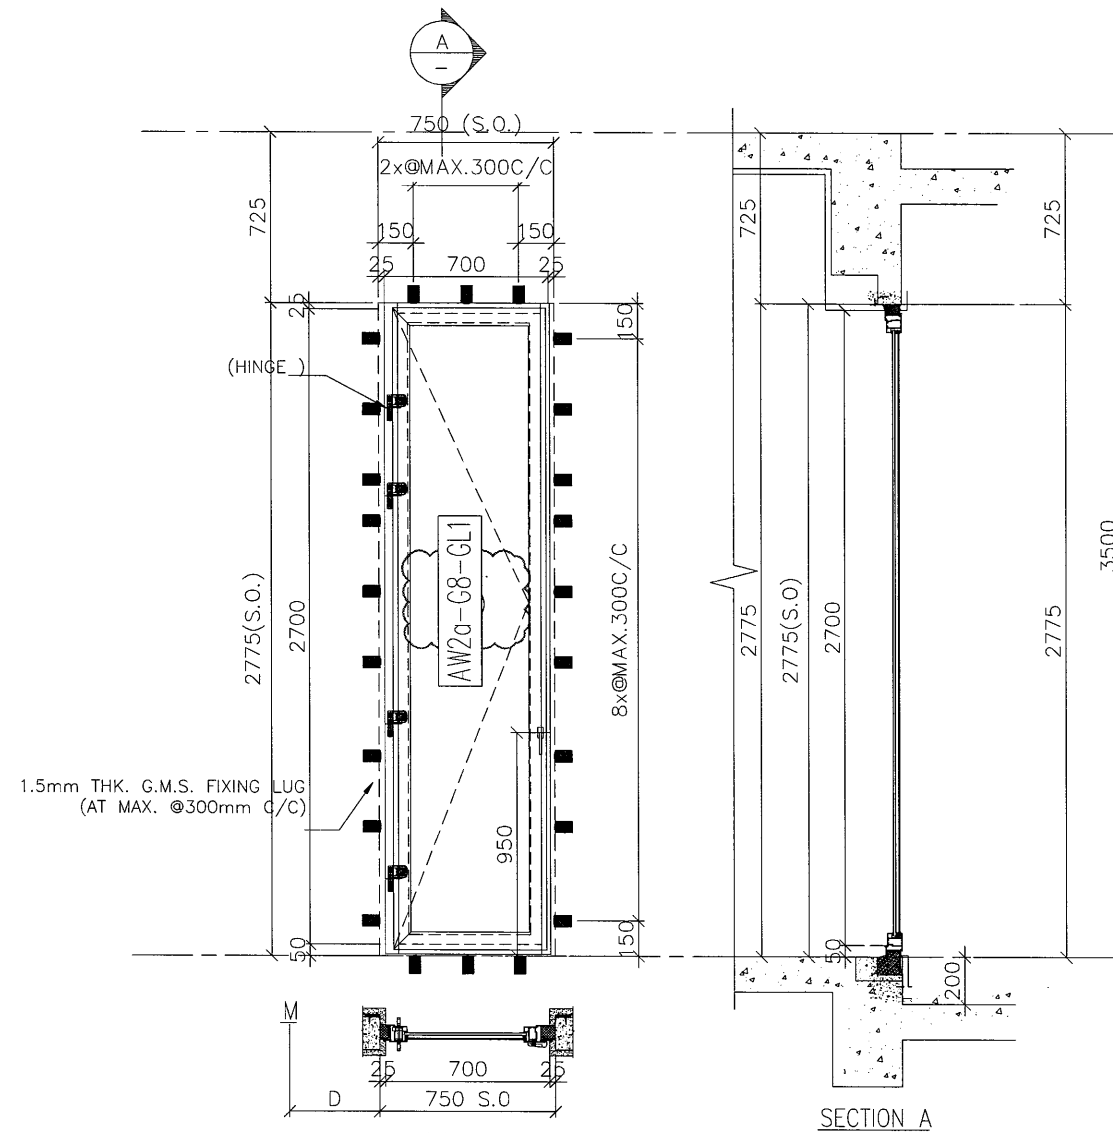

M	D	
HC	1590	T6A
HC	2625	T8A

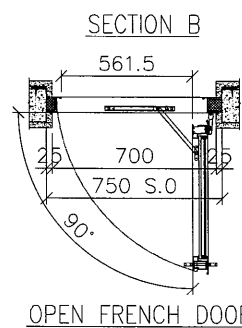

OPENABLE AREA	GLAZING AREA
1.806	1.369

WINDOW MARK	AW 2
SECTION :	65mm ALUM. SECTION
QTY.	50NOS.
LOCATION :	T6 FLAT A UTILITY RM AT 2F-32F T8 FLAT A UTILITY RM AT 5F-30F
GLAZING	⊗ 6mm FT Grey Tinted+1.52PVB+6mm FT Clear Laminated Glass
REMARK :	

WINDOW MARK	AW 2a
SECTION :	65mm ALUM. SECTION
QTY.	1 NOS.
LOCATION :	T8 FLAT A AT 31F(UTILITY RM)
GLAZING	⊗ 6mm FT Grey Tinted+1.52PVB+6mm FT Clear Laminated Glass
REMARK :	

B.D. REF :
F.S.D. REF :
Note :
1.All dimensions are in mm.
2.All elevations are viewed from outside.
3.All dimensions to be verified on site before fabrication.

GENERAL NOTES

Legend :
1. F.F.L.-- Finished Floor Level
2. S.F.L.-- Structural Floor Level
3. (R) -- Reversed Detail


X1 -- DETAIL MARK NO.
X001 -- REFER SHEET NO.

NO.	DATE	REVISED	BY
H	01.11.2022	GENERAL REVISION	
G	04.06.2022	GENERAL REVISION	
F	06.04.2022	GENERAL REVISION	
E	24.03.2022	GENERAL REVISION	
D	06.01.2022	GENERAL REVISION	
C	26.12.2021	GENERAL REVISION	
B	5.12.2021	GENERAL REVISION	
A	28.10.2021	GENERAL REVISION	


CLIENT :
MARBLE EDGE INVESTMENT LTD.

ARCHITECT :
RONALD LU PARTNERS
ARCHITECTS | PLANNERS | INTERIOR DESIGNERS

STRUCTURAL ENGINEER :
ICMA C M WONG & ASSOCIATES LTD
111, 113, 115, 3611,

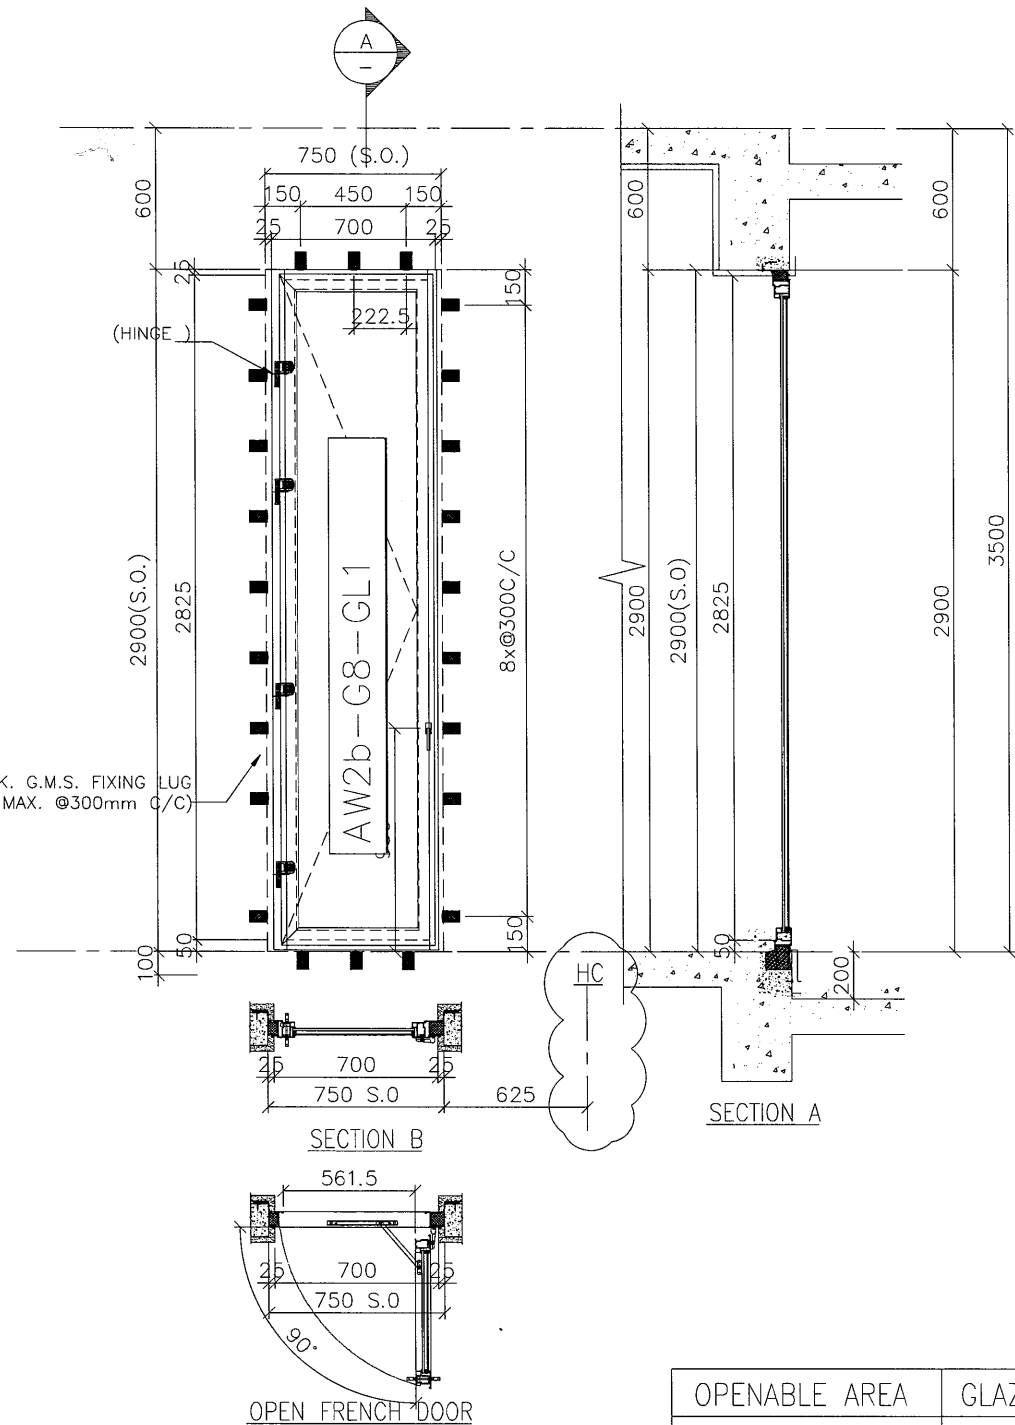

OPENABLE AREA	GLAZING AREA
1.871	1.421

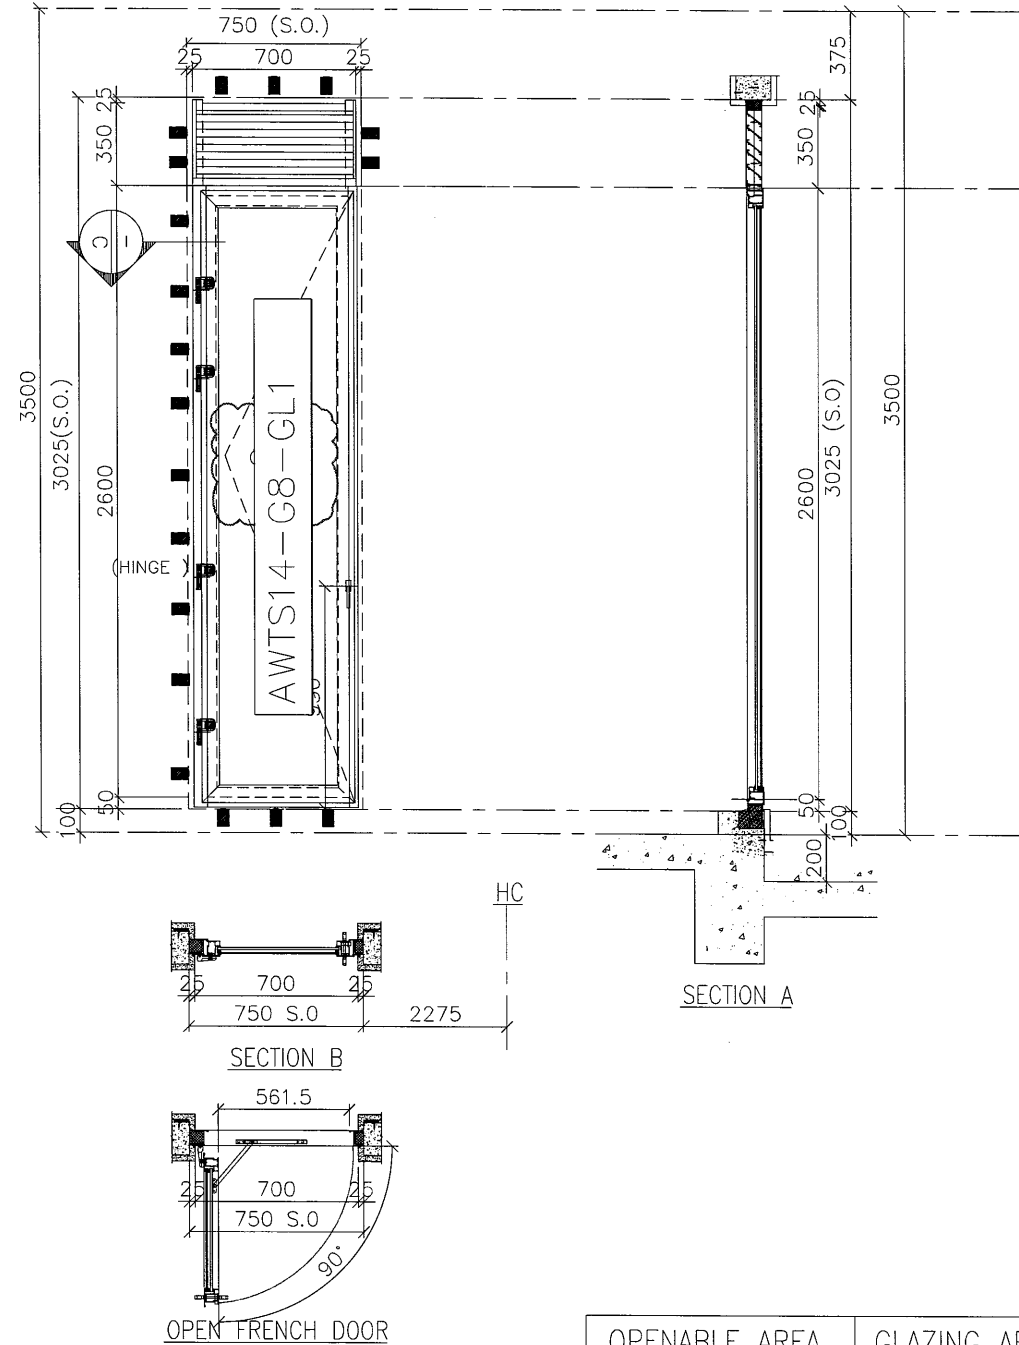

OPENABLE AREA	GLAZING AREA
1.871	1.421

B.D. REF :
F.S.D. REF :
Note :
1. All dimensions are in mm.
2. All elevations are viewed from outside.
3. All dimensions to be verified on site before fabrication.

GENERAL NOTES

Legend :
1. F.F.L.-- Finished Floor Level
2. S.F.L.-- Structural Floor Level
3. (R) -- Reversed Detail

(X1) -- DETAIL MARK NO.
(X001) -- REFER SHEET NO.

NO.	DATE	REVISED	BY
C	15.11.2022	GENERAL REVISION	
B	01.11.2022	GENERAL REVISION	
A	04.06.2022	GENERAL REVISION	
-	06.04.2022	GENERAL REVISION	

CLIENT :
MARBLE EDGE INVESTMENT LTD.

ARCHITECT :
RONALD LU PARTNERS
ARCHITECTS | PLANNERS | INTERIOR DESIGNERS

STRUCTURAL ENGINEER :
ICMA C M WONG & ASSOCIATES LTD
110, HEDDERLEY ROAD

MAIN CONTRACTOR :
?????????

美特鋁質有限公司
MIDI ALUMINIUM FABRICATOR LTD.
Units 6-8, Sunray Industrial Centre, 1/F
610 Cha Kwo Ling Road, Kowloon
Tel: 23489211-4 Fax: (852) 27727666





PROJECT :
PROPOSED RESIDENTIAL DEVELOPMENT AT NEW KOWLOON INLAND LOT. NO.6552

TITLE :
WINDOW SCHEDULE FOR IN-SITU ALUM. WINDOW

JOB NO. : J-857
DRAWN BY : AN DATE : 18.OCT.2021
CHKD BY : SCALE A1: A3: 1:30
DWG. NO. : J857-IW-2028A REV. : C

WINDOW MARK	AW 2b
SECTION :	65mm ALUM. SECTION
QTY.	1 NOS.
LOCATION :	T8 FLAT A UTILITY RM. 33F(G8) ,
GLAZING	6mm FT Grey Tinted+1.52PVB+6mm FT Clear(Frosted)Laminated Glass
REMARK :	

WINDOW MARK	AW TS14
SECTION :	65mm ALUM. SECTION
QTY.	1 NOS.
LOCATION :	T1 FLAT A M.BATH 33F(G8) ,
GLAZING	G8-1 6mm FT Grey Tinted+1.52PVB+6mm FT Clear Laminated Glass/
REMARK :	

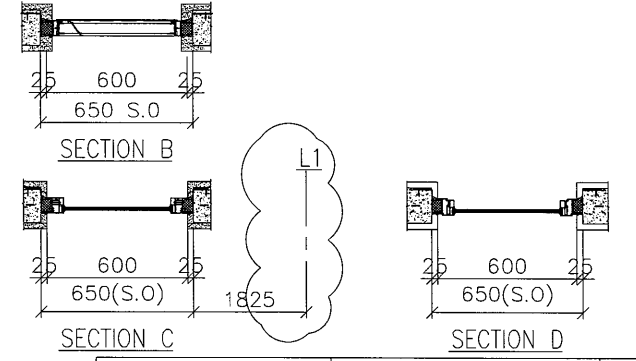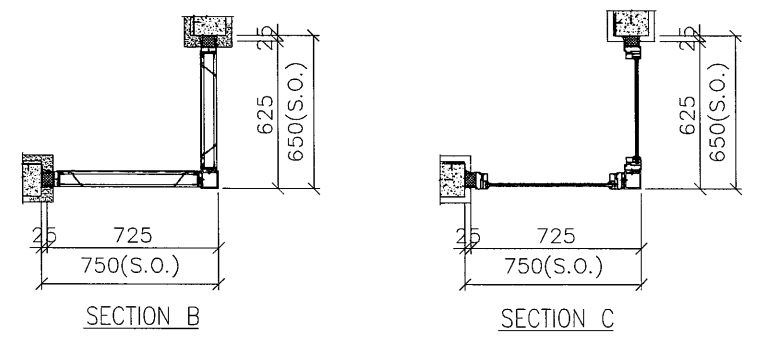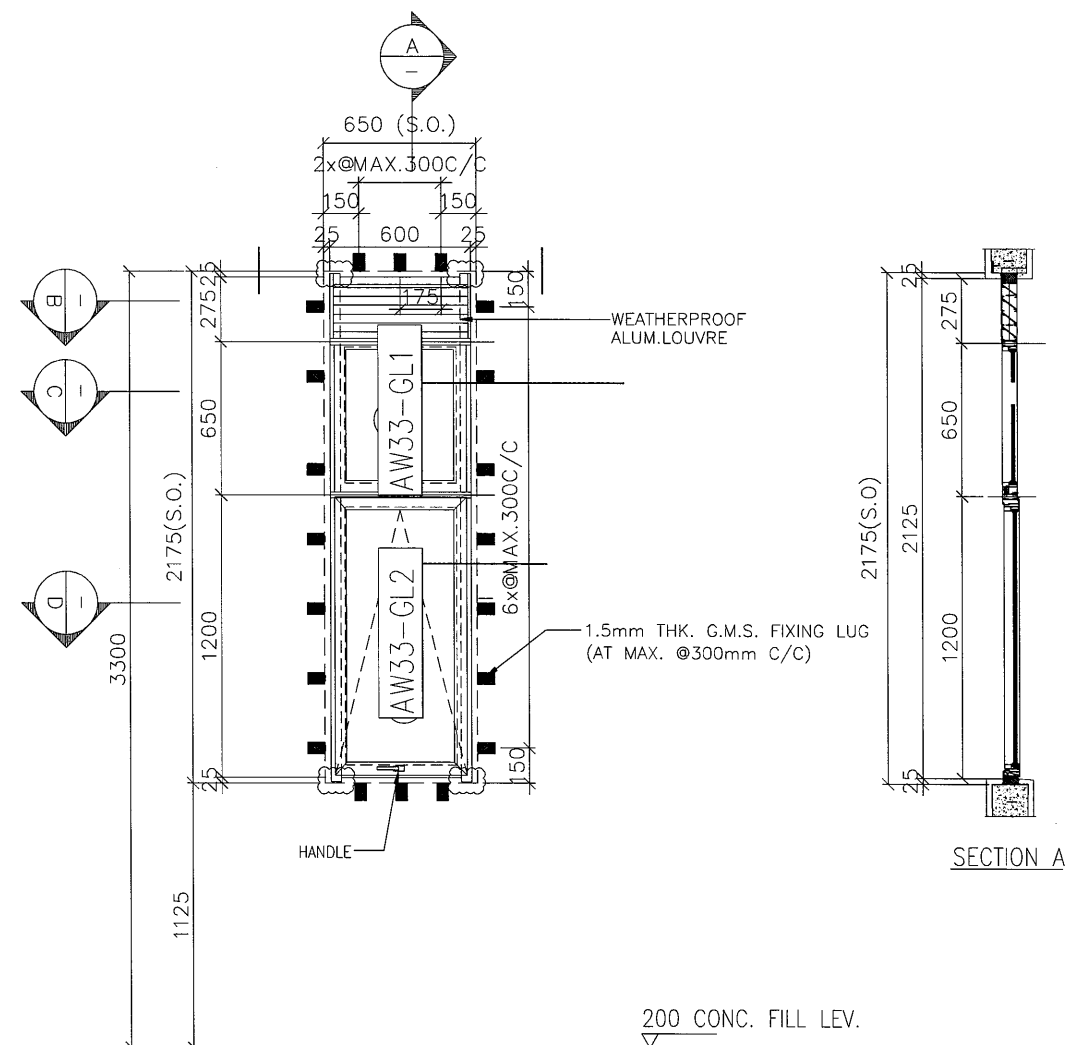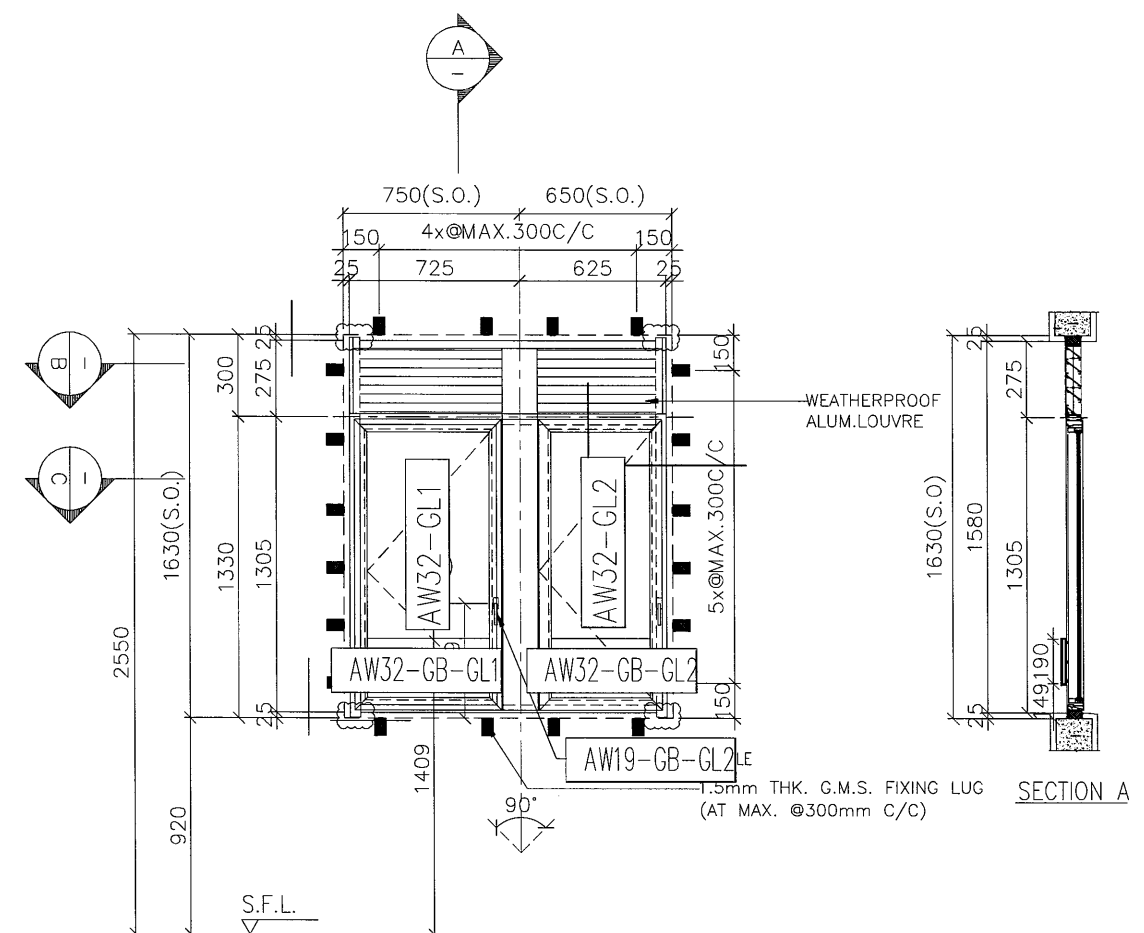

FREE AREA(%)	OPENABLE AREA	GLAZING AREA
56%	1.15	0.91

FREE AREA(%)	OPENABLE AREA	GLAZING AREA
56%	0.59	0.69

WINDOW MARK	AW 32
SECTION :	65mm ALUM. SECTION
QTY.	2 NOS.
LOCATION :	TOWER L FLAT A&C KITCHEN AT 3F&5F
GLAZING	Ⓞ 6mm FT Grey Tinted+1.52PVB+6mm FT Clear Laminated Glass/12mm THK. CLEAR TEMPERED GLASS(GBa)
REMARK :	

WINDOW MARK	AW 33
SECTION :	65mm ALUM. SECTION
QTY.	3 NOS.
LOCATION :	TOWER L FLAT A BATH&LAV. AT 6F
GLAZING	Ⓞ 6mm FT Grey Tinted+1.52PVB+6mm FT Clear(Frosted)Laminated Glass
REMARK :	

B.D. REF :
F.S.D. REF :

Note :
1. All dimensions are in mm.
2. All elevations are viewed from outside.
3. All dimensions to be verified on site before fabrication.

GENERAL NOTES

Legend :
1. F.F.L. --- Finished Floor Level
2. S.F.L. --- Structural Floor Level
3. (P) --- Reversed Detail

(X1) --- DETAIL MARK NO.
(X001) --- REFER SHEET NO.

NO.	DATE	REVISED	BY
D	04.06.2022	GENERAL REVISION	
C	06.04.2022	GENERAL REVISION	
B	26.12.2021	GENERAL REVISION	
A	5.12.2021	GENERAL REVISION	

CLIENT :
MARBLE EDGE INVESTMENT LTD.

ARCHITECT :
RONALD LU & PARTNERS
ARCHITECTS | PLANNERS | INTERIOR DESIGNERS

STRUCTURAL ENGINEER :
CMA C M WONG & ASSOCIATES LTD
INCORPORATED IN HONG KONG

MAIN CONTRACTOR :
?????????

美特鋁質有限公司
MIDI ALUMINIUM FABRICATOR LTD.
Units 6-8, Sunray Industrial Centre, 1/F
610 Cha Kwo Ling Road, Kowloon
Tel:23489211-4 Fax:(852)2727666

PROJECT :
PROPOSED RESIDENTIAL DEVELOPMENT AT NEW KOWLOON INLAND LOT. NO.6552



TITLE :
WINDOW SCHEDULE FOR IN-SITU ALUM. WINDOW

JOB NO. : J-857



DRAWN BY : AN DATE : 18.OCT.2021

CHKD BY : SCALE A1: A3: 1:30

DWG. NO. : J857-IW-2006 REV. : D

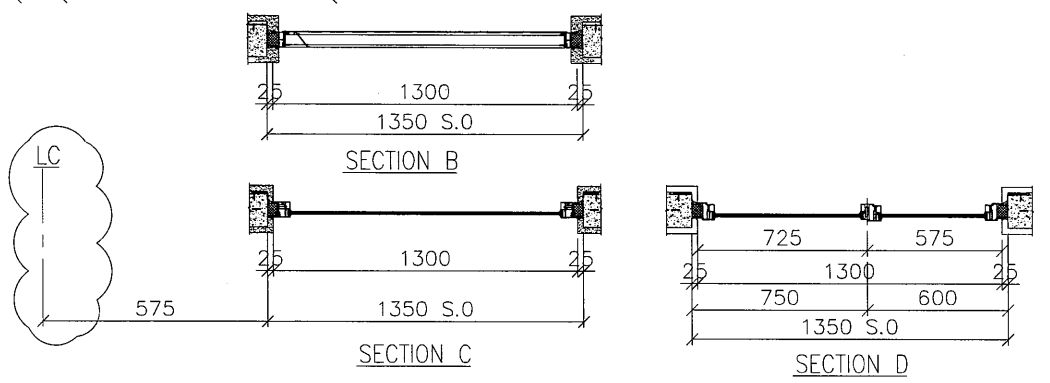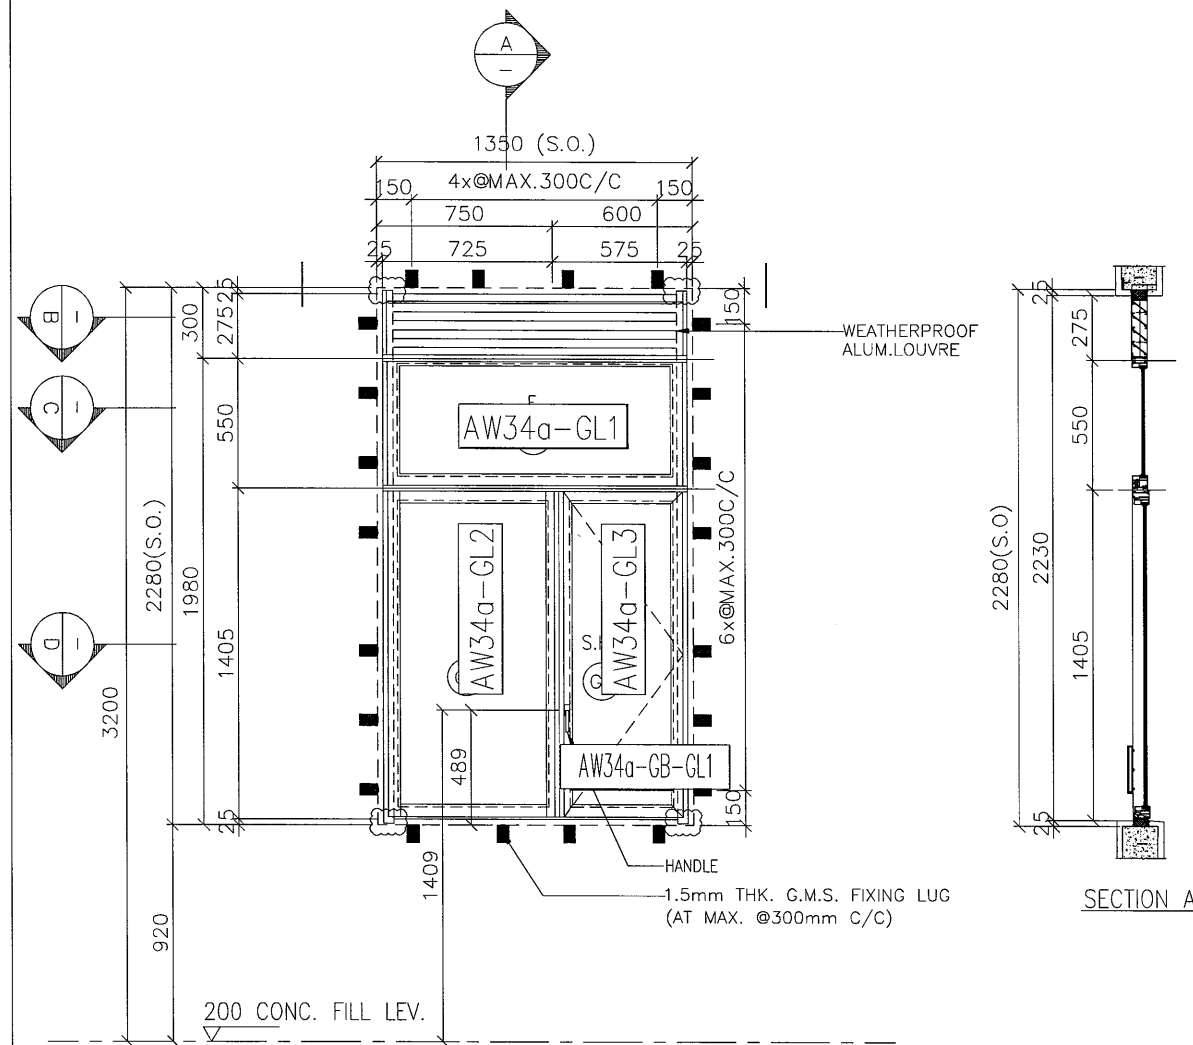

FREE AREA(%)	OPENABLE AREA	GLAZING AREA
56%	1.15	1.27

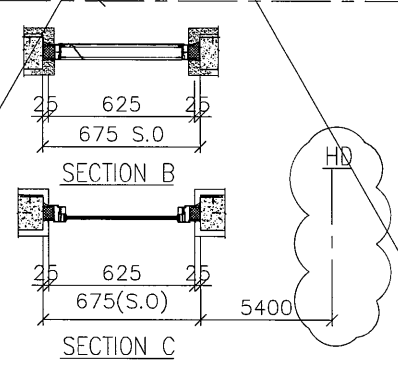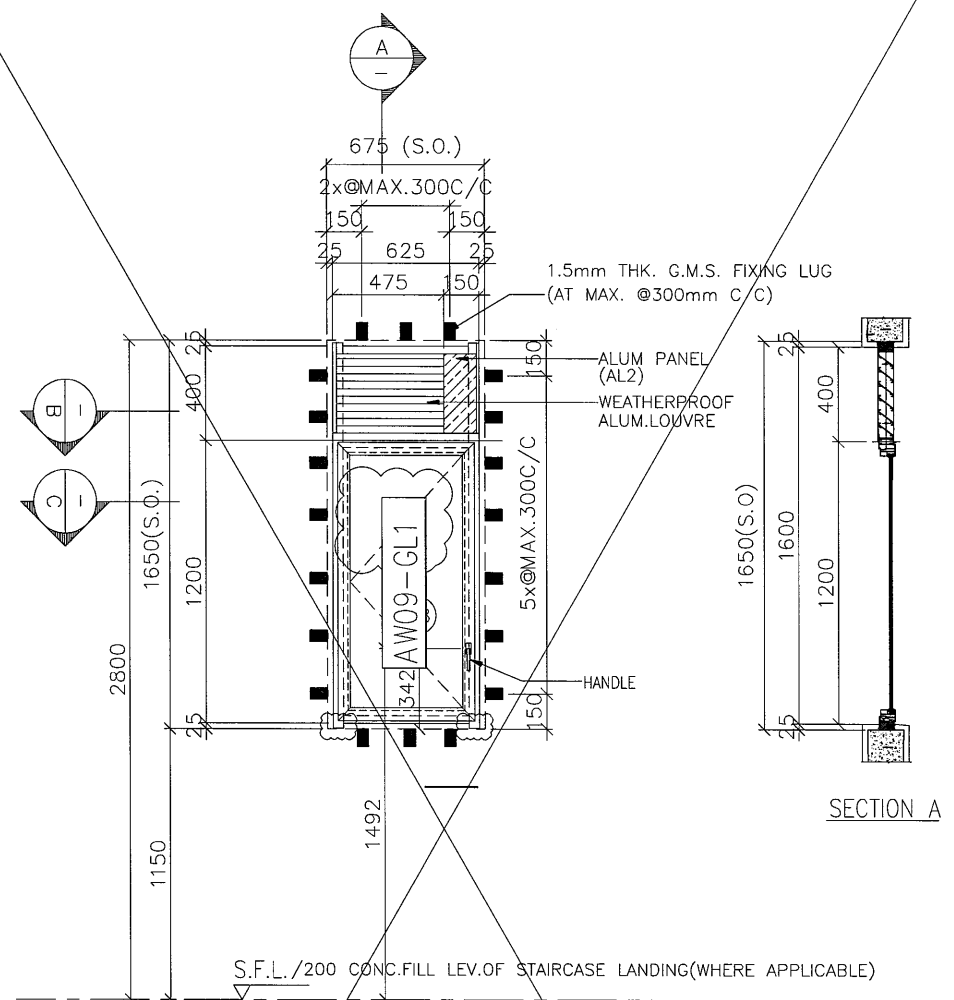

FREE AREA(%)	OPENABLE AREA	GLAZING AREA
56%	0.585	0.52

B.D. REF :
 F.S.D. REF :
 Note :
 1.All dimensions are in mm.
 2.All elevations are viewed from outside.
 3.All dimensions to be verified on site before fabrication.

GENERAL NOTES
 Legend :
 1. F.F.L.-- Finished Floor Level
 2. S.F.L.-- Structural Floor Level
 3. (R) -- Reversed Detail
 X1 -- DETAIL MARK NO.
 X001 -- REFER SHEET NO.

NO.	DATE	REVISED	BY
F	04.06.2022	GENERAL REVISION	
E	06.04.2022	GENERAL REVISION	
D	24.03.2022	GENERAL REVISION	
C	06.01.2022	GENERAL REVISION	
B	26.12.2021	GENERAL REVISION	
A	5.12.2021	GENERAL REVISION	

CLIENT :
 MARBLE EDGE INVESTMENT LTD.

ARCHITECT :
RONALD LU & PARTNERS
 ARCHITECTS | PLANNERS | INTERIOR DESIGNERS

STRUCTURAL ENGINEER :
GMA C M WONG & ASSOCIATES LTD
 STRUCTURAL ENGINEERS

MAIN CONTRACTOR :
 ?????????

美特鋁質有限公司
MIDI ALUMINIUM FABRICATOR LTD.
 Units 6-8, Sunray Industrial Centre, 1/F
 610 Cha Kwo Ling Road, Kowloon
 Tel:23489211-4 Fax:(852)27727666




PROJECT :
 PROPOSED RESIDENTIAL DEVELOPMENT AT NEW KOWLOON INLAND LOT. NO.6552

TITLE :
 WINDOW SCHEDULE FOR IN-SITU ALUM. WINDOW




JOB NO. : J-857
 DRAWN BY : AN DATE : 18.OCT.2021
 CHKD BY : SCALE A1: A3: 1:30
 DWG. NO. : J857-IW-2007 REV. : F

WINDOW MARK	
SECTION :	65mm ALUM. SECTION
QTY.	1 NOS.
LOCATION :	TOWER L FLAT A KITCHEN AT 6F
GLAZING	6mm FT Grey Tinted+1.52PVB+6mm FT Clear Laminated Glass/12mm THK. CLEAR TEMPERED GLASS(GBa)
REMARK :	

WINDOW MARK	
SECTION :	65mm ALUM. SECTION
QTY.	27 NOS.
LOCATION :	T1 FLAT B UTILITY RM AT 2F-32F
GLAZING	6mm FT Grey Tinted+1.52PVB+6mm FT Clear Laminated Glass
REMARK :	

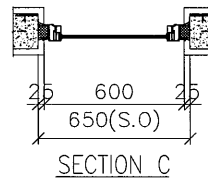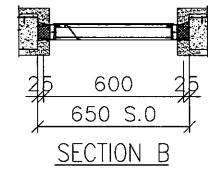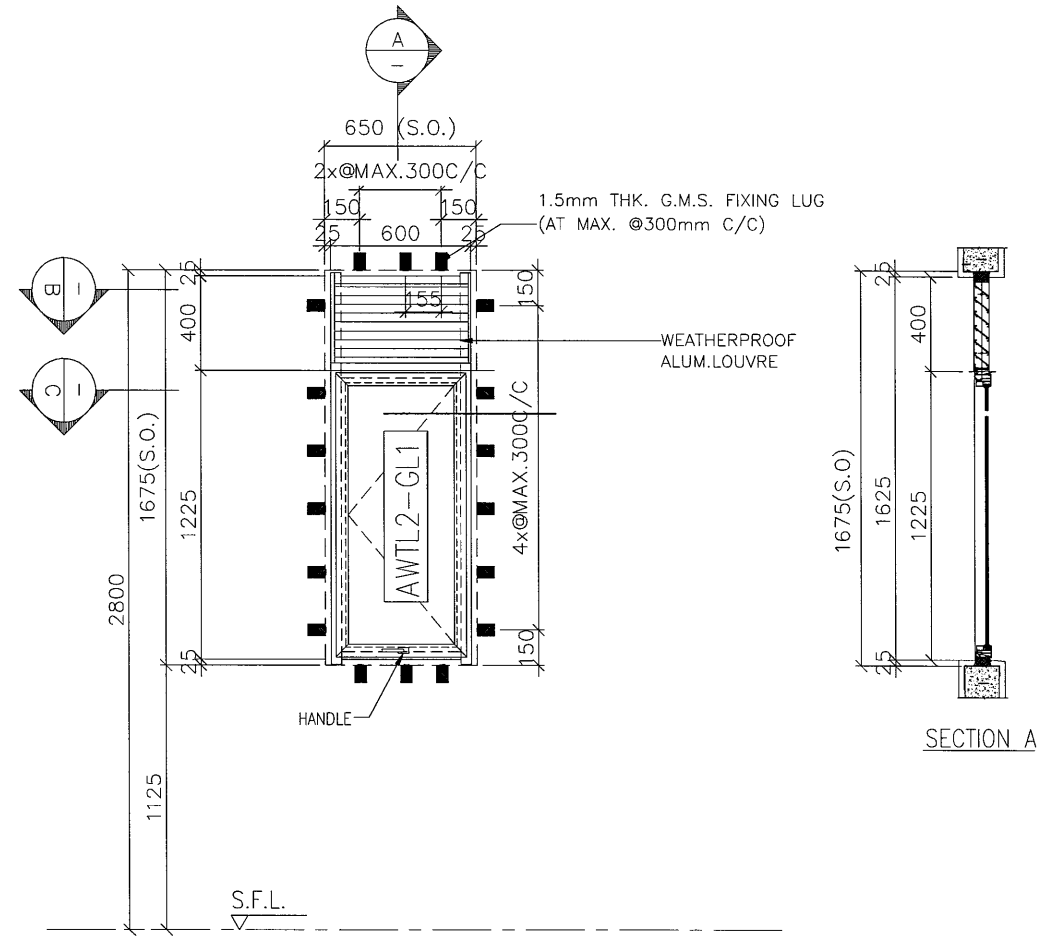

FREE AREA(%)	OPENABLE AREA	GLAZING AREA
56%	0.585	0.522

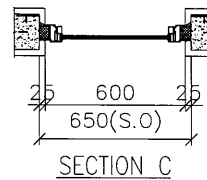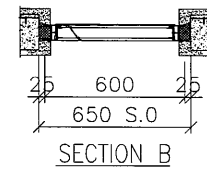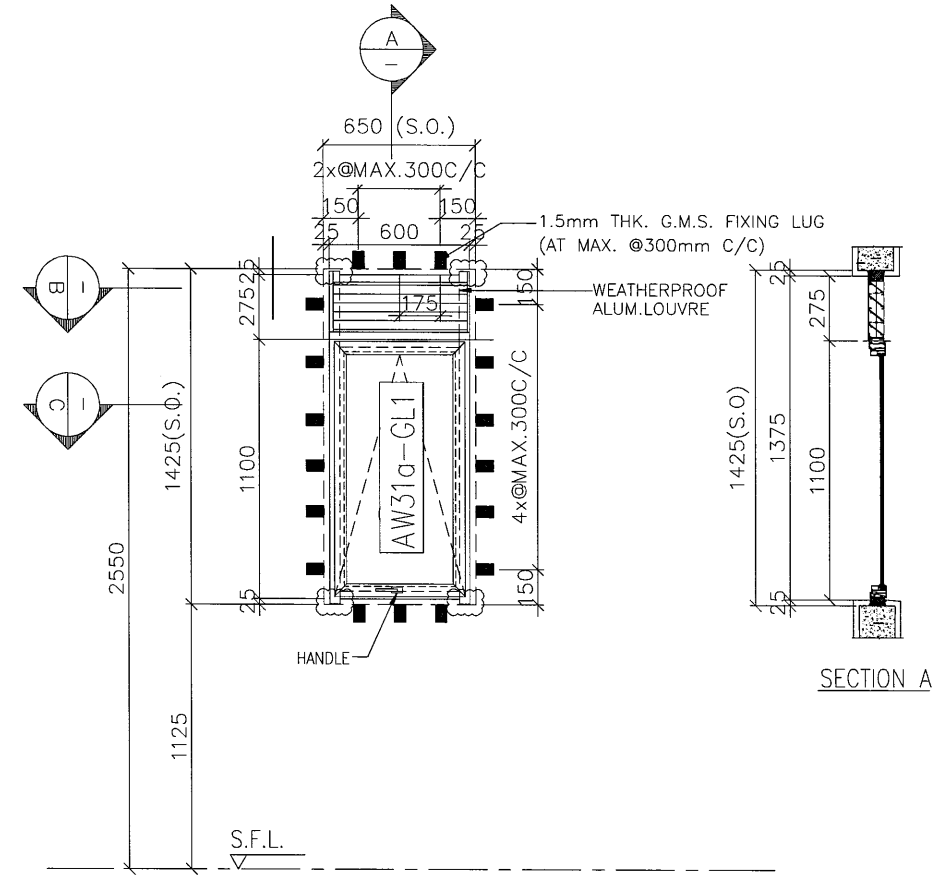

FREE AREA(%)	OPENABLE AREA	GLAZING AREA
56%	0.59	0.49

WINDOW MARK	AW TL02
SECTION :	65mm ALUM. SECTION
QTY.	2 NOS.
LOCATION :	TOWER L FLAT B A/C PLATFORM AT 3/F & 5/F
GLAZING	6mm FT Grey Tinted+1.52PVB+6mm FT Clear Laminated Glass/12mm THK. CLEAR TEMPERED GLASS(GBa)
REMARK :	

WINDOW MARK	AW 31a
SECTION :	65mm ALUM. SECTION
QTY.	2 NOS.
LOCATION :	TOWER L BATH&LAV. AT 3F&5F
GLAZING	6mm FT Grey Tinted+1.52PVB+6mm FT Clear WITH ACID ETCHED
REMARK :	

B.D. REF :
F.S.D. REF :
Note :
1.All dimensions are in mm.
2.All elevations are viewed from outside.
3.All dimensions to be verified on site before fabrication.

GENERAL NOTES
Legend :
1. F.F.L.-- Finished Floor Level
2. S.F.L.-- Structural Floor Level
3. (R) -- Reversed Detail
X1 -- DETAIL MARK NO.
X001 -- REFER SHEET NO.

NO.	DATE	REVISION	BY
A	01.11.2022	GENERAL REVISION	

CLIENT :
MARBLE EDGE INVESTMENT LTD.

ARCHITECT :
RONALD LU & PARTNERS
ARCHITECTS | PLANNERS | INTERIOR DESIGNERS

STRUCTURAL ENGINEER :
CMA C M WONG & ASSOCIATES LTD
TEL: 23489211-4




MAIN CONTRACTOR :
?????????

美特鋁質有限公司
MIDI ALUMINIUM FABRICATOR LTD.
Units 6-8, Sunray Industrial Centre, 1/F
610 Cha Kwo Ling Road, Kowloon
Tel:23489211-4 Fax:(852)27727666




PROJECT :
PROPOSED RESIDENTIAL DEVELOPMENT AT NEW KOWLOON INLAND LOT. NO.6552

TITLE :
WINDOW SCHEDULE FOR IN-SITU ALUM. WINDOW

JOB NO. : J-857
DRAWN BY : AN DATE : 18.OCT.2021
CHKD BY : SCALE A1: A3: 1:30
DWG. NO. : J857-IW-2007b REV. : -

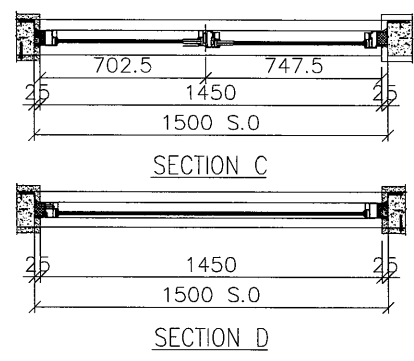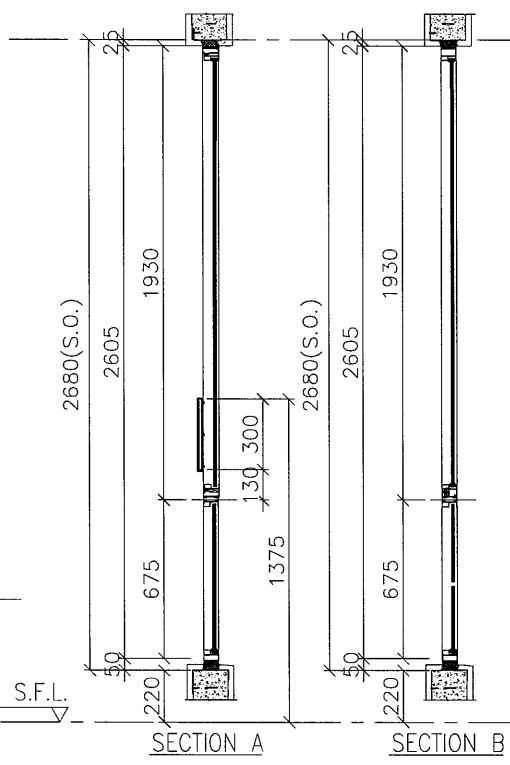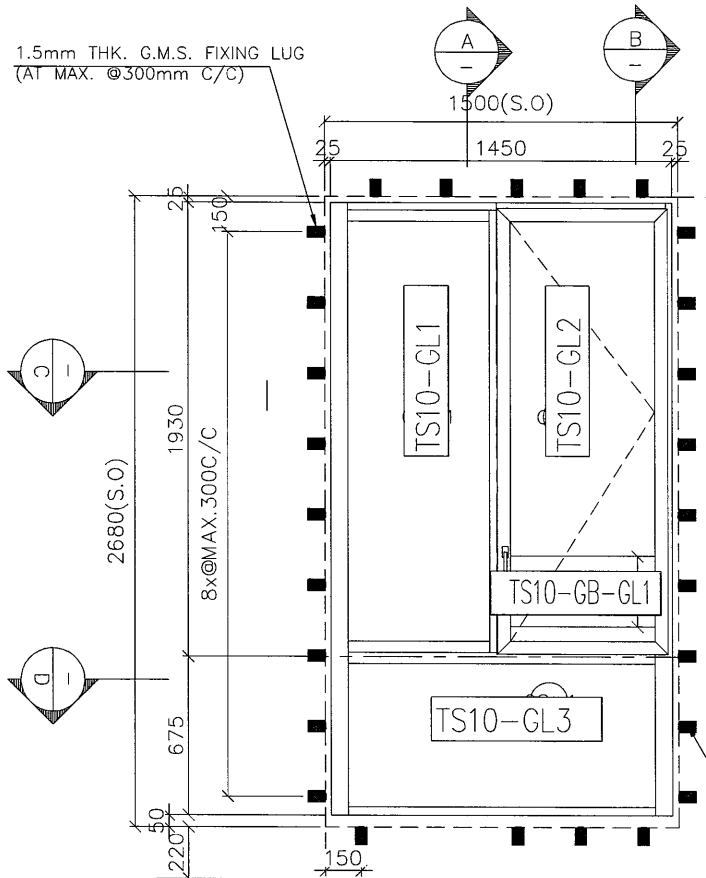

OPENABLE AREA	GLAZING AREA
1.259	3.346

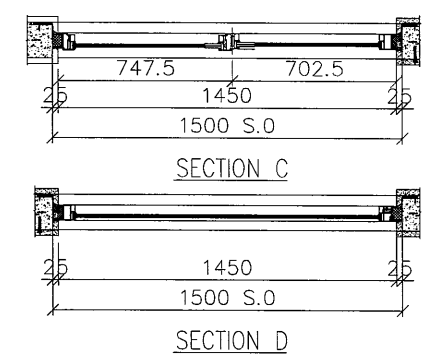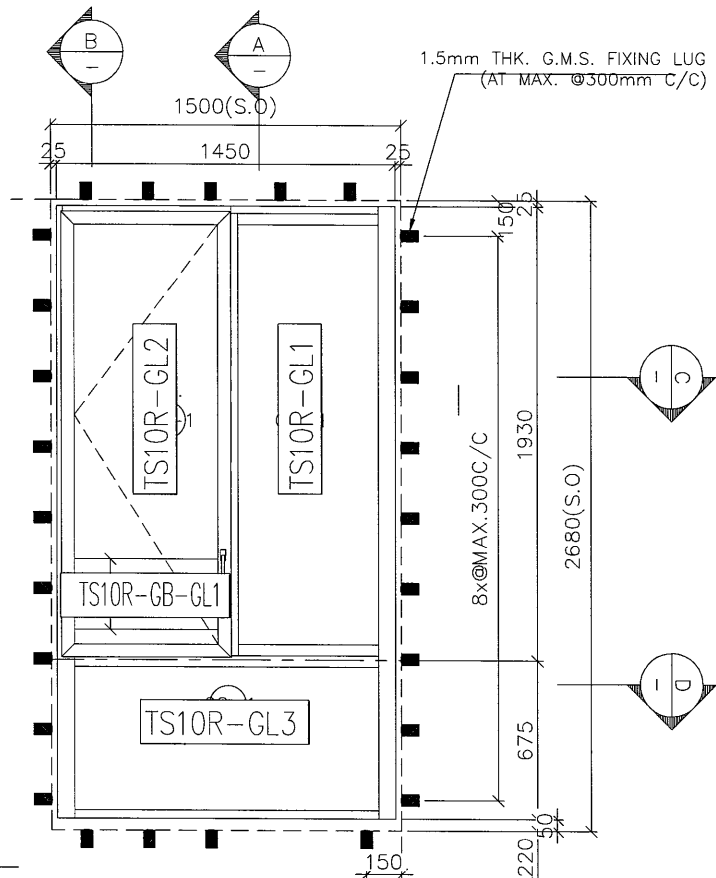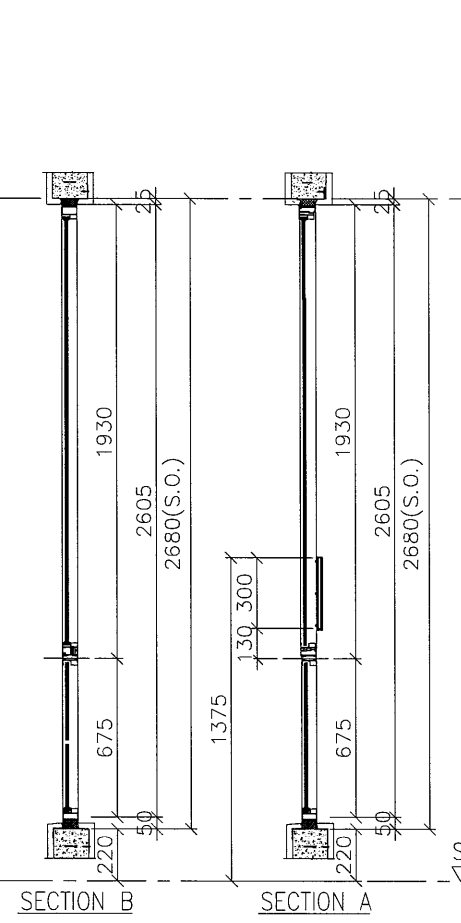

OPENABLE AREA	GLAZING AREA
1.259	3.346

WINDOW MARK	AW TS10
SECTION :	65mm ALUM. SECTION
QTY.	1 NOS.
LOCATION :	TOWER 3 FLAT A B.R.2 AT 33/F
GLAZING	G8-16mm FT Grey Tinted+1.52PVB+6mm FT Clear Laminated Glass/ (G) MONOUTHIC GLASS 8mm FT CLEAR
REMARK :	

WINDOW MARK	AW TS10R
SECTION :	65mm ALUM. SECTION
QTY.	1 NOS.
LOCATION :	TOWER 6 FLAT A B.R.2 AT 33/F
GLAZING	G8-16mm FT Grey Tinted+1.52PVB+6mm FT Clear Laminated Glass/ (G) MONOUTHIC GLASS 8mm FT CLEAR
REMARK :	

B.D. REF :
F.S.D. REF :
Note :
1.All dimensions are in mm.
2.All elevations are viewed from outside.
3.All dimensions to be verified on site before fabrication.

GENERAL NOTES
Legend :
1. F.F.L.-- Finished Floor Level
2. S.F.L.-- Structural Floor Level
3. (R) -- Reversed Detail
X1 -- DETAIL MARK NO.
X001 -- REFER SHEET NO.

NO.	DATE	GENERAL REVISION	REVISD	BY
1	31.10.2022	GENERAL REVISION		

CLIENT :
MARBLE EDGE INVESTMENT LTD.

ARCHITECT :
RONALD LV & PARTNERS
ARCHITECTS | PLANNERS | INTERIOR DESIGNERS

STRUCTURAL ENGINEER :
CMA C M WONG & ASSOCIATES LTD
TEL: (852) 2772 7666

MAIN CONTRACTOR :
?????????

美特鋁質有限公司
MIDI ALUMINIUM FABRICATOR LTD.
Units 6-8, Sunray Industrial Centre, 1/F
610 Cha Kwo Ling Road, Kowloon
Tel: 23489211-4 Fax: (852) 27727666



PROJECT :
PROPOSED RESIDENTIAL DEVELOPMENT AT NEW KOWLOON INLAND LOT. NO.6552

TITLE :
WINDOW SCHEDULE FOR IN-SITU ALUM. WINDOW

JOB NO. : J-857
DRAWN BY : AN DATE : 18.OCT.2021

CHKD BY : SCALE A1: A3: 1:30

DWC. NO. : J857-IW-2009b REV. : -

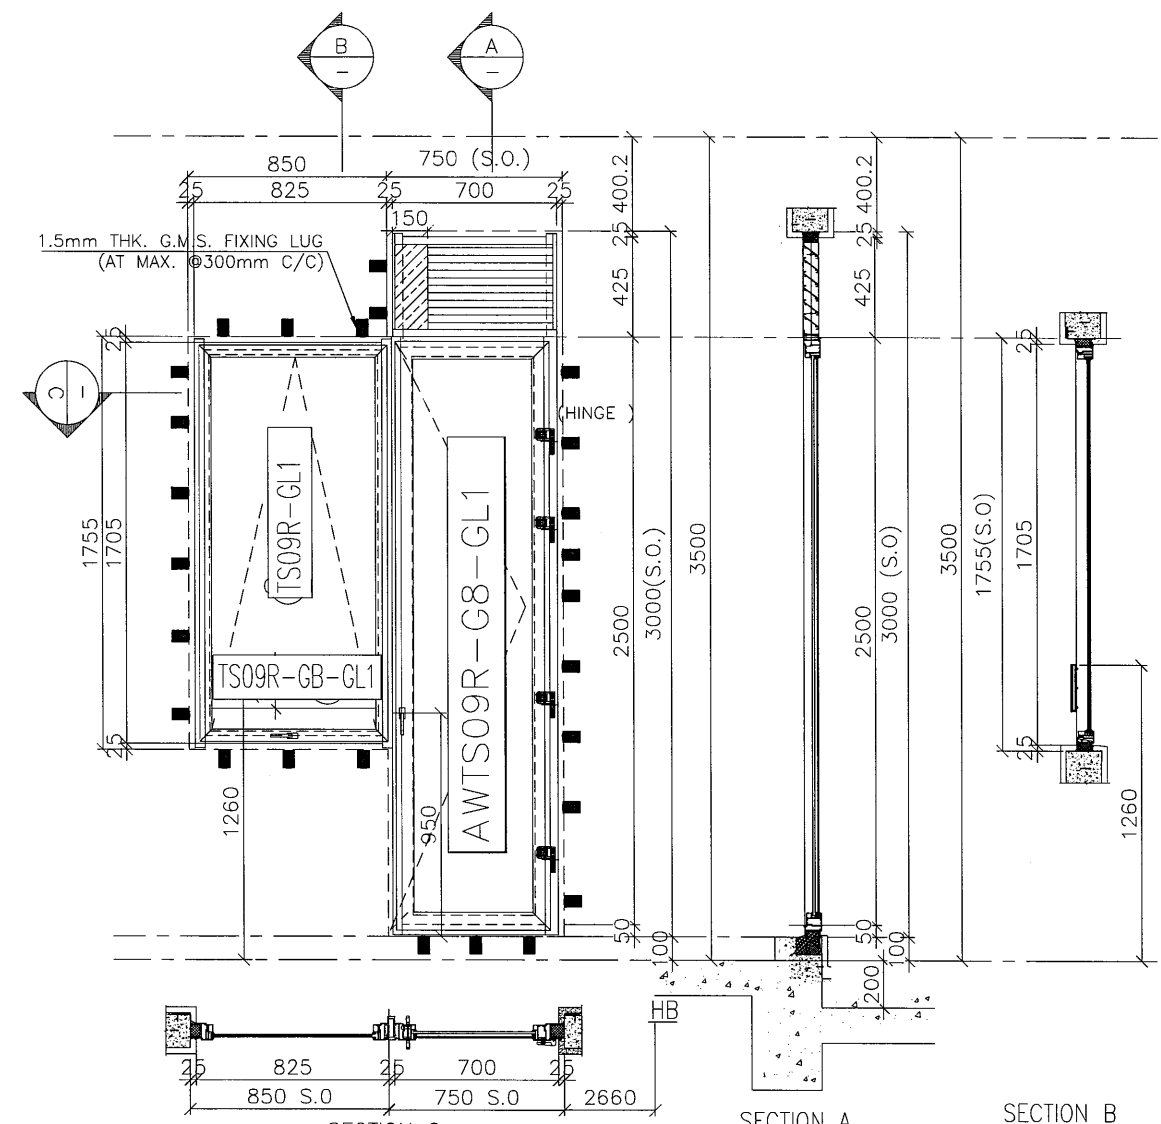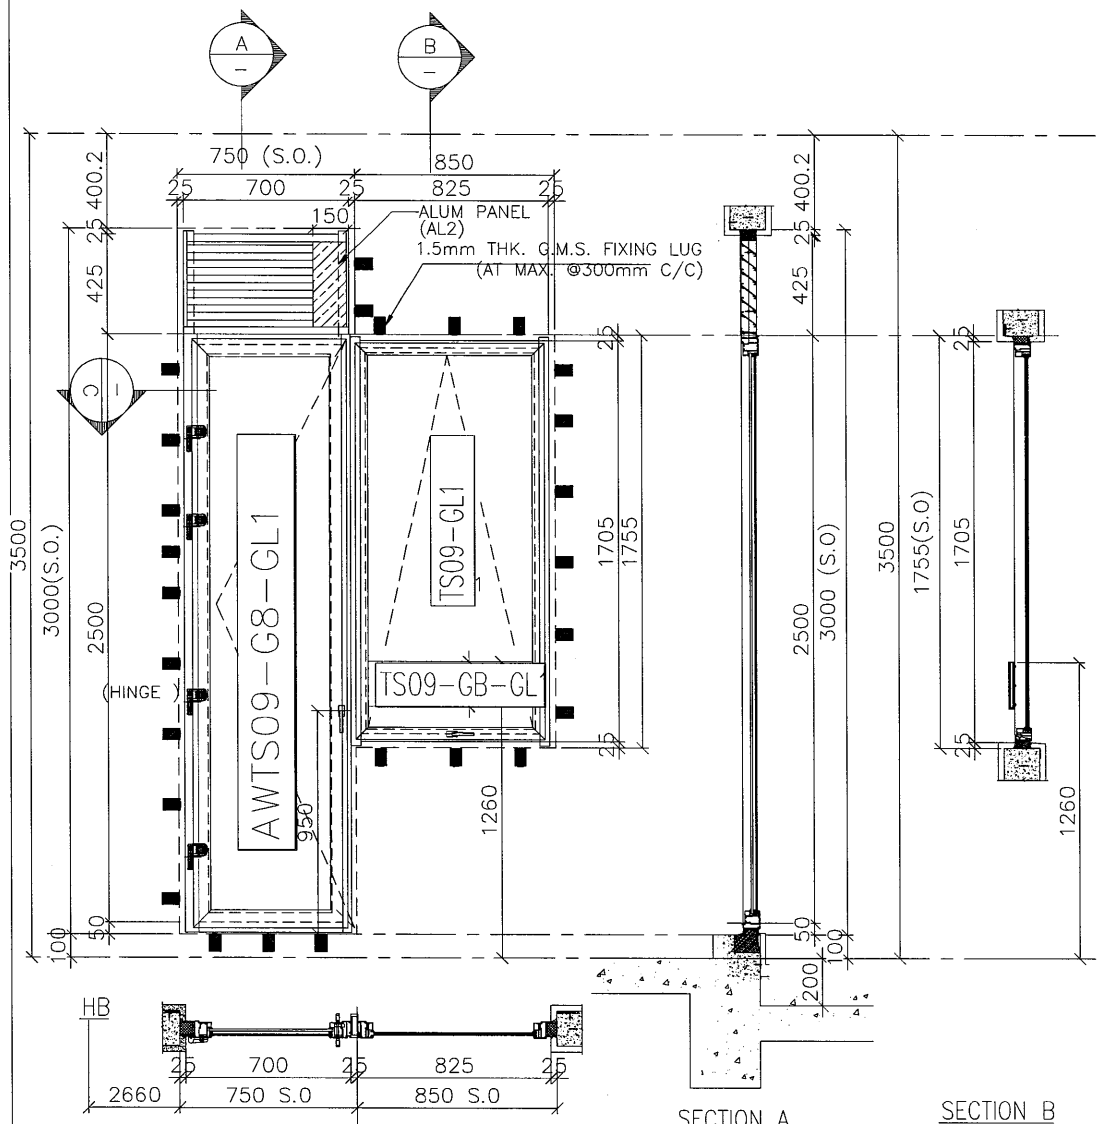

FREE AREA(%)	OPENABLE AREA	GLAZING AREA
56%	2.536	2.394

FREE AREA(%)	OPENABLE AREA	GLAZING AREA
56%	2.536	2.394

WINDOW MARK	AW TS09
SECTION :	65mm ALUM. SECTION
QTY.	1NOS.
LOCATION :	T3 FLAT A KIT AT 33/F
GLAZING	G8-1 6mm FT Grey Tinted+1.52PVB+6mm FT Clear Laminated Glass/ (GB) MONOETHIC GLASS 8mm FT CLEAR
REMARK :	

WINDOW MARK	AW TS09R
SECTION :	65mm ALUM. SECTION
QTY.	1NOS.
LOCATION :	T6 FLAT A KIT AT 33/F

B.D. REF :
F.S.D. REF :
Note :
1.All dimensions are in mm.
2.All elevations are viewed from outside.
3.All dimensions to be verified on site before fabrication.

GENERAL NOTES

Legend :
1. F.F.L.-- Finished Floor Level
2. S.F.L.-- Structural Floor Level
3. (R) -- Reversed Detail

X1 -- DETAIL MARK NO.
X001 -- REFER SHEET NO.

NO.	DATE	GENERAL REVISION	REVISED	BY
	1.11.2022			

CLIENT :
MARBLE EDGE INVESTMENT LTD.

ARCHITECT :
RONALD LU & PARTNERS
ARCHITECTS | PLANNERS | INTERIOR DESIGNERS

STRUCTURAL ENGINEER :
C M WONG & ASSOCIATES LTD

MAIN CONTRACTOR :
?????????

美特鋁質有限公司
MIDI ALUMINIUM FABRICATOR LTD.
Units 6-8, Sunray Industrial Centre, 1/F
610 Cha Kwo Ling Road, Kowloon
Tel:23489211-4 Fax:(852)27727666

PROJECT :
PROPOSED RESIDENTIAL DEVELOPMENT AT NEW KOWLOON INLAND LOT. NO.6552



TITLE :
WINDOW SCHEDULE FOR IN-SITU ALUM. WINDOW

JOB NO. : J-857



DRAWN BY : AN DATE : 18.OCT.2021

CHKD BY : SCALE A1: A3: 1:30

DWG. NO. : J857-IW-2002C REV. : -

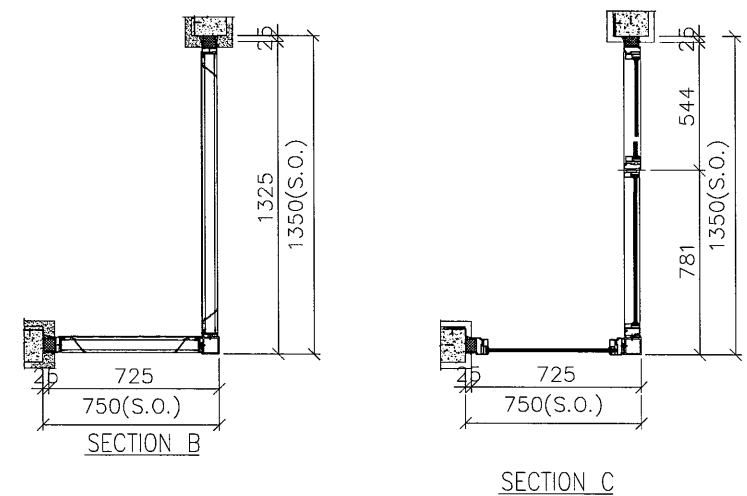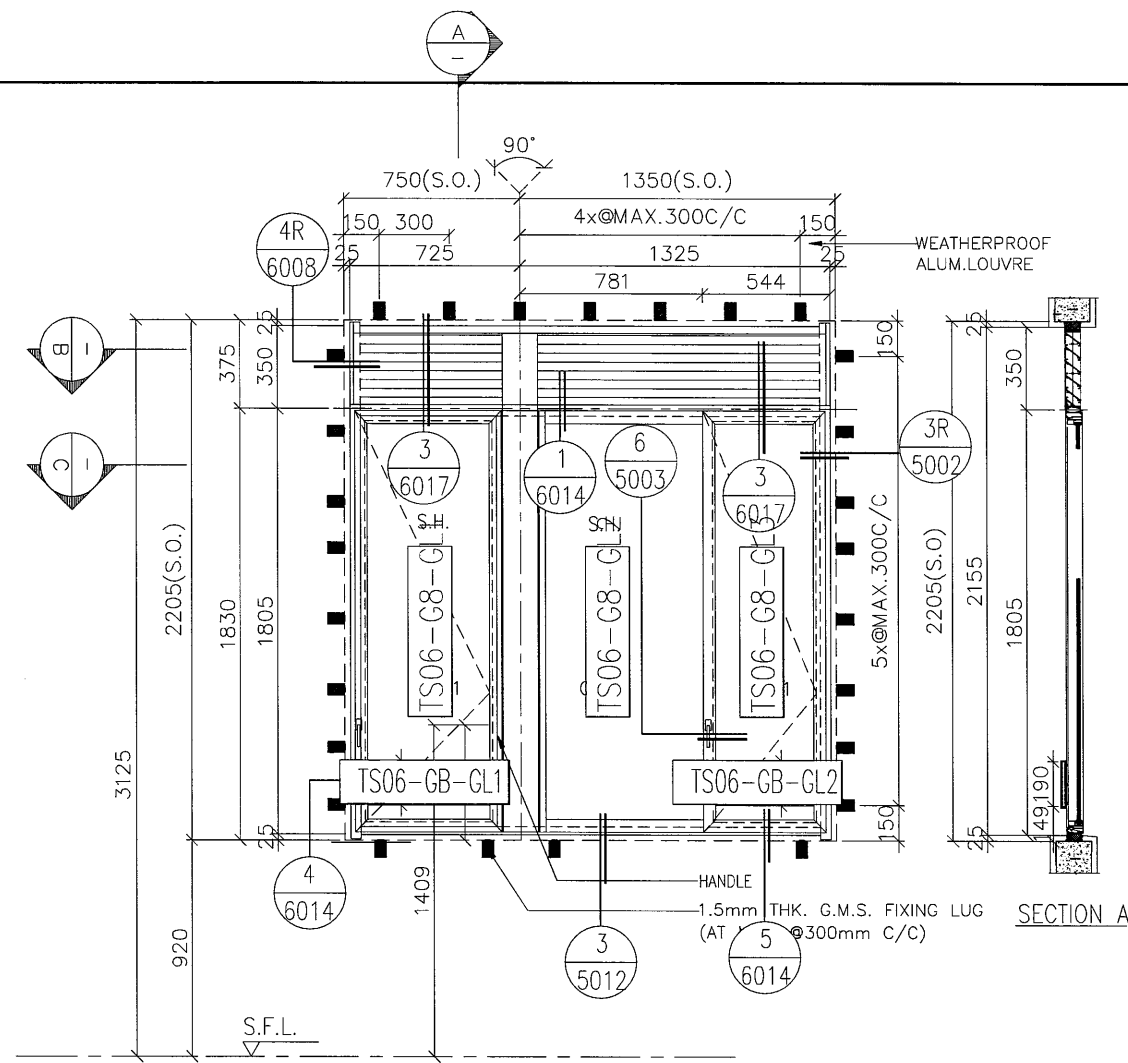

FREE AREA(%)	OPENABLE AREA	GLAZING AREA
56%	1.852	2.589

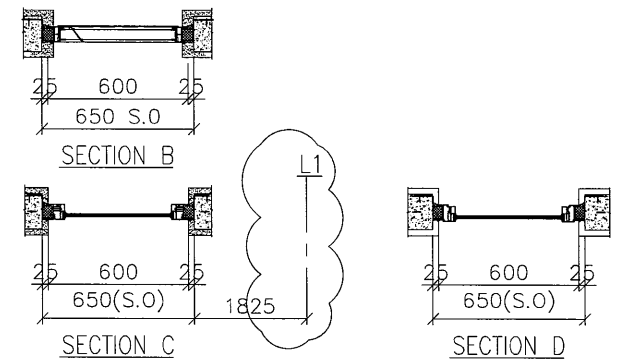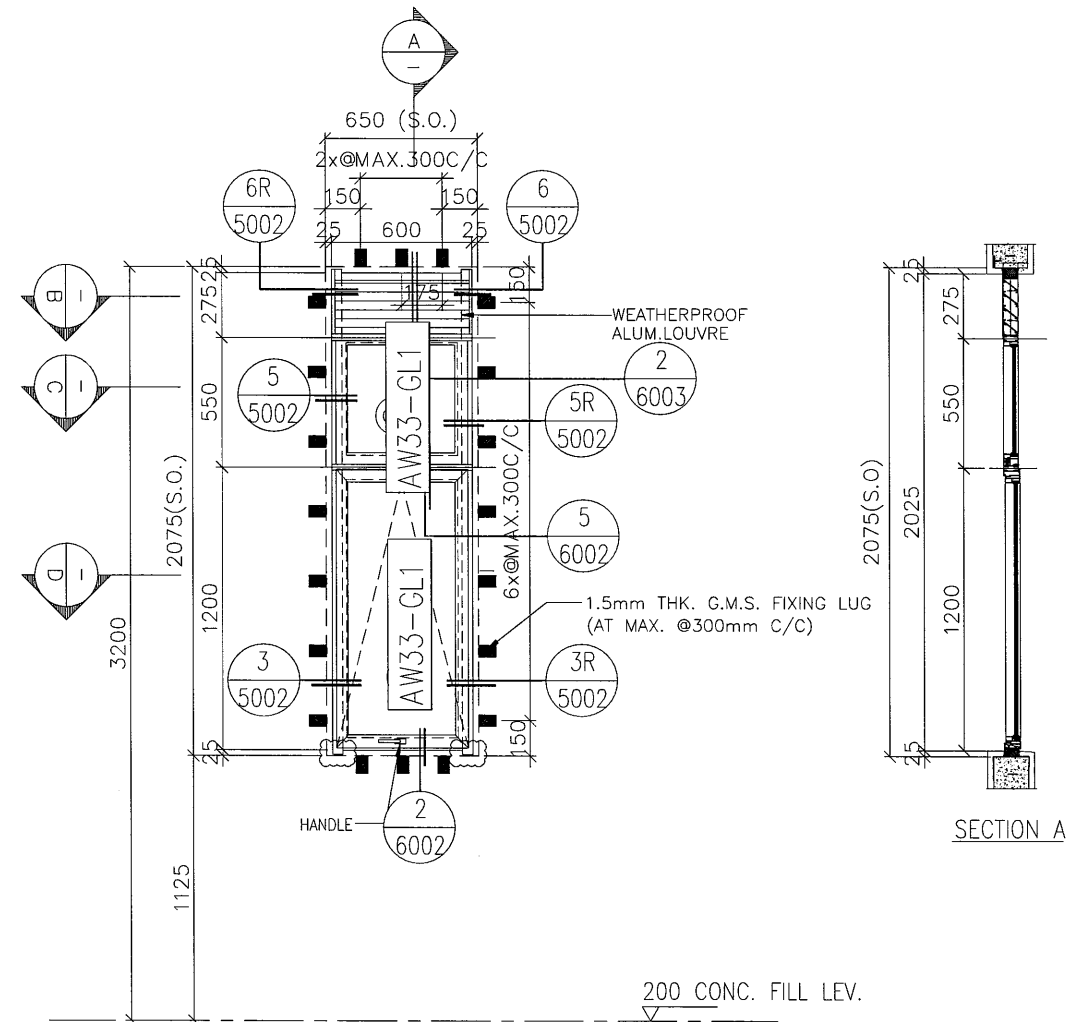

FREE AREA(%)	OPENABLE AREA	GLAZING AREA
56%	0.59	0.69

B.D. REF :
 F.S.D. REF :
 Note :
 1.All dimensions are in mm.
 2.All elevations are viewed from outside.
 3.All dimensions to be verified on site before fabrication.

GENERAL NOTES
 Legend :
 1. F.F.L.-- Finished Floor Level
 2. S.F.L.-- Structural Floor Level
 3. (R) -- Reversed Detail
 (X1) -- DETAIL MARK NO.
 (X001) -- REFER SHEET NO.

NO.	DATE	REVISED	BY
E	01.11.2022	GENERAL REVISION	
D	04.06.2022	GENERAL REVISION	
C	06.04.2022	GENERAL REVISION	
B	26.12.2021	GENERAL REVISION	
A	5.12.2021	GENERAL REVISION	

CLIENT :
 MARBLE EDGE INVESTMENT LTD.

ARCHITECT :
RONALD LU & PARTNERS
 ARCHITECTS | PLANNERS | INTERIOR DESIGNERS

STRUCTURAL ENGINEER :
ICMA C M WONG & ASSOCIATES LTD
 STRUCTURAL ENGINEERS

MAIN CONTRACTOR :
 ?????????

美特鋁質有限公司
MIDI ALUMINIUM FABRICATOR LTD.
 Units 6-8, Sunray Industrial Centre, 1/F
 610 Cha Kwo Ling Road, Kowloon
 Tel:23489211-4 Fax:(852)27727666



PROJECT :
 PROPOSED RESIDENTIAL DEVELOPMENT AT NEW KOWLOON INLAND LOT. NO.6552

TITLE :
 WINDOW SCHEDULE FOR IN-SITU ALUM. WINDOW

JOB NO. : J-857
 DRAWN BY : AN DATE : 18.OCT.2021
 CHKD BY : SCALE A1: A3: 1:30
 DWG. NO. : J857-IW-2006A REV. : -

WINDOW MARK	AW TS06		
SECTION :	65mm ALUM. SECTION		
QTY.	1 NOS.		
LOCATION :	TOWER 1 FLAT A KITCHEN AT 33F		
GLAZING	G8-16mm FT Grey Tinted+1.52PVB+6mm FT Clear Laminated Glass/ (G) MONOETHIC GLASS 8mm FT CLEAR		
REMARK :			

WINDOW MARK	AW 33		
SECTION :	65mm ALUM. SECTION		
QTY.	3 NOS.		
LOCATION :	TOWER L FLAT A BATH&LAV. AT 6F.		
GLAZING	(G) 6mm FT Grey Tinted+1.52PVB+6mm FT Clear(Frosted)Laminated Glass		
REMARK :			

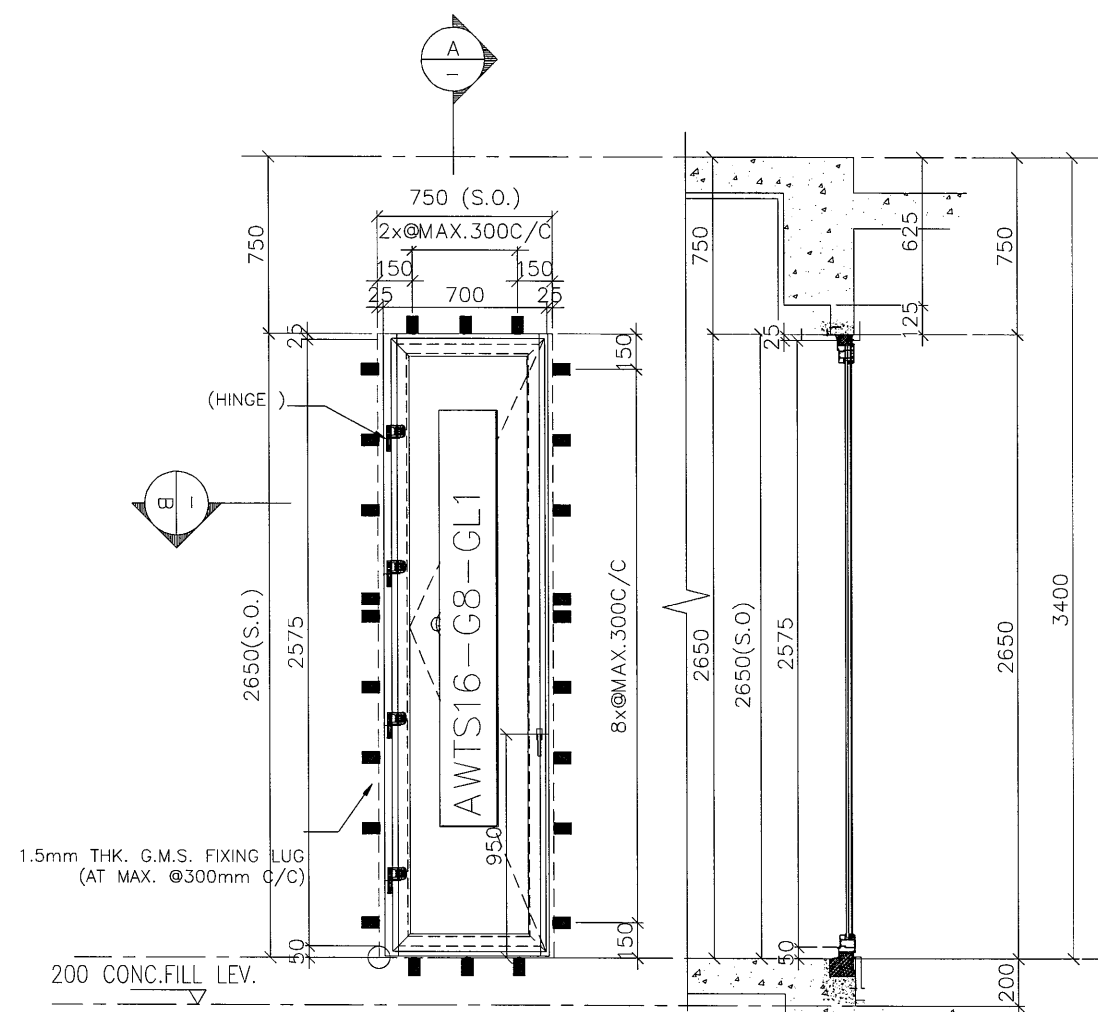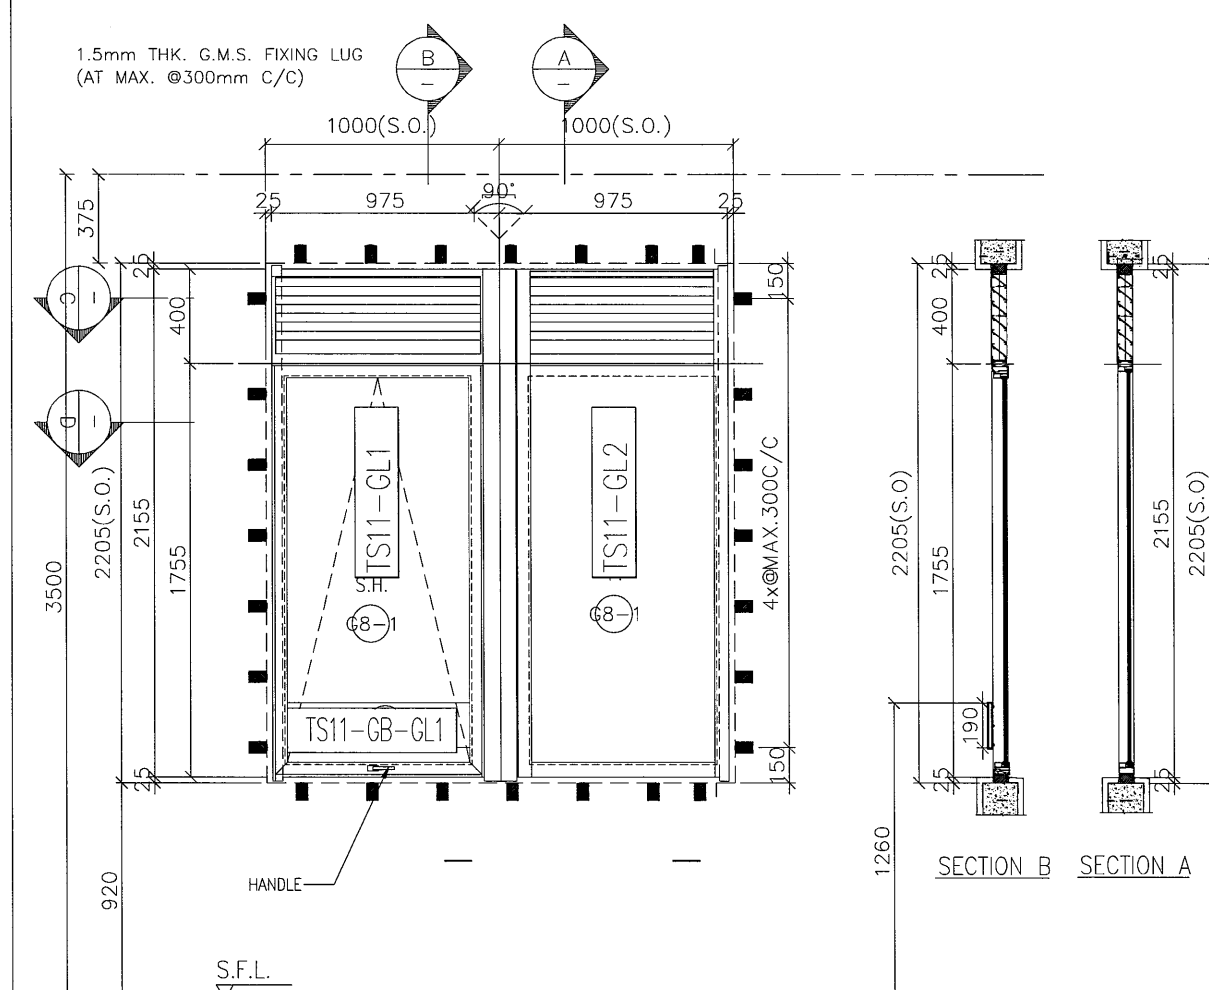

FREE AREA(%)	OPENABLE AREA	GLAZING AREA
56%	1.566	2.929

M	D	T
HC	2390	T1A

OPENABLE AREA	GLAZING AREA
1.806	1.369

WINDOW MARK	AW TS11
SECTION :	65mm ALUM. SECTION
QTY.	1 NOS.
LOCATION :	TOWER 8 FLAT A KIT AT 31/F
GLAZING	G8-1 6mm FT Grey Tinted+1.52PVB+6mm FT Clear Laminated Glass/ (G8) MONOUTHIC GLASS 8mm FT CLEAR
REMARK :	

WINDOW MARK	AW TS16
SECTION :	65mm ALUM. SECTION
QTY.	1 NOS.
LOCATION :	T8 FLAT A KIT AT 31F(G8-2) ,
GLAZING	G8-1 6mm FT Grey Tinted+1.52PVB+6mm FT Clear Laminated Glass/
REMARK :	

B.D. REF :
F.S.D. REF :
Note :
1. All dimensions are in mm.
2. All elevations are viewed from outside.
3. All dimensions to be verified on site before fabrication.

GENERAL NOTES
Legend :
1. F.F.L.-- Finished Floor Level
2. S.F.L.-- Structural Floor Level
3. (R) -- Reversed Detail
X1 -- DETAIL MARK NO.
X001 -- REFER SHEET NO.

NO.	DATE	REVISED	BY
B	25.11.2022	GENERAL REVISION	
A	15.11.2022	GENERAL REVISION	
-	01.11.2022	GENERAL REVISION	

CLIENT :
MARBLE EDGE INVESTMENT LTD.

ARCHITECT :
RONALD LU & PARTNERS
ARCHITECTS | PLANNERS | INTERIOR DESIGNERS

STRUCTURAL ENGINEER :
GMA C M WONG & ASSOCIATES LTD
TEL: 23489211-4





MAIN CONTRACTOR :
?????????

美特鋁質有限公司
MIDI ALUMINIUM FABRICATOR LTD.
Units 6-8, Sunray Industrial Centre, 1/F
610 Cha Kwo Ling Road, Kowloon
Tel: 23489211-4 Fax: (852) 2727666

PROJECT :
PROPOSED RESIDENTIAL DEVELOPMENT AT NEW KOWLOON INLAND LOT. NO.6552

TITLE :
WINDOW SCHEDULE FOR IN-SITU ALUM. WINDOW

JOB NO. : J-857
DRAWN BY : AN DATE : 18.OCT.2021
CHKD BY : SCALE A1: A3: 1:30
DWG. NO. : J857-IW-2009C REV. : A

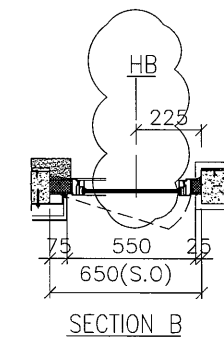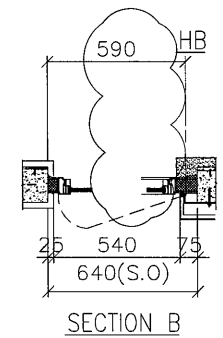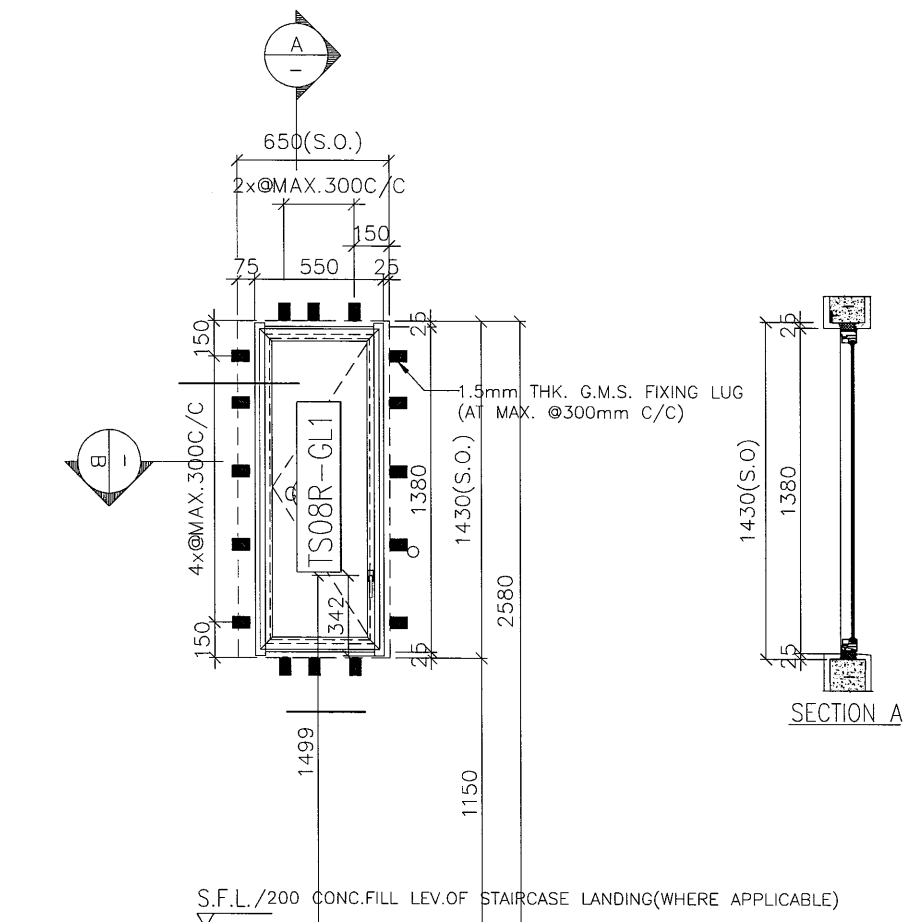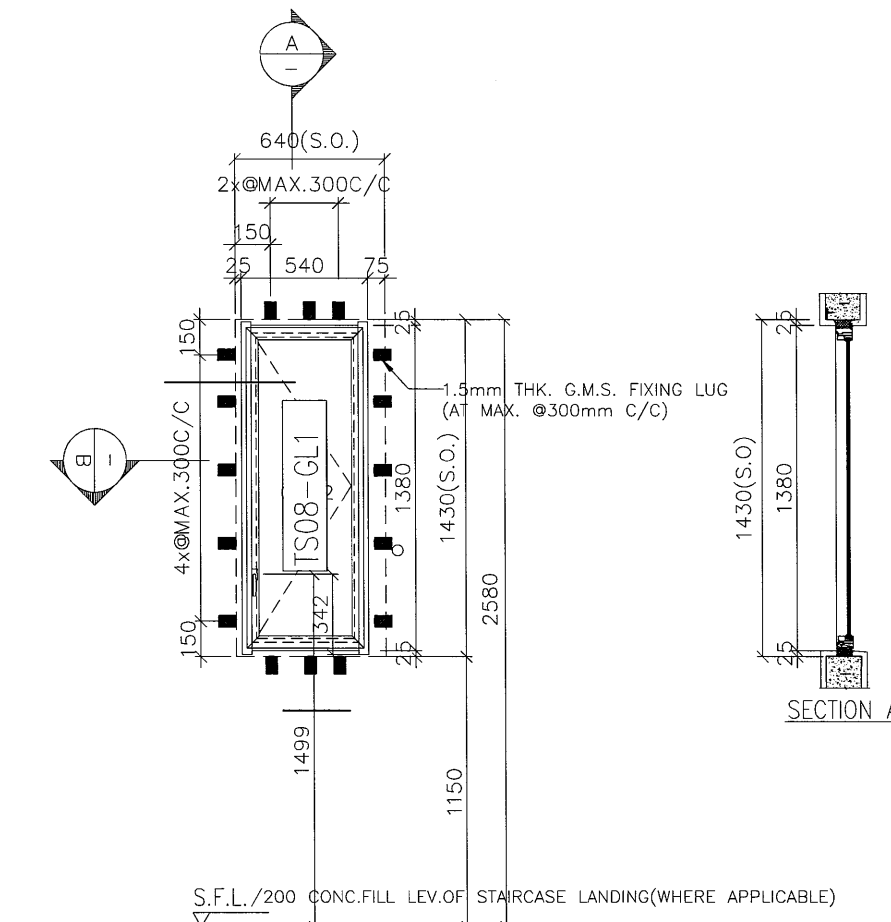

OPENABLE AREA	GLAZING AREA
0.678	0.608

OPENABLE AREA	GLAZING AREA
0.678	0.608

WINDOW MARK	AW TS08
SECTION :	65mm ALUM. SECTION
QTY.	1 NOS.
LOCATION :	T3 FLAT A LAV. AT 33/F
GLAZING	G8-2 6mm FT Grey Tinted+1.52PVB+6mm FT CLEAR WITH ACID ETCHED ON SURFACE #4
REMARK :	

WINDOW MARK	AW TS08R
SECTION :	65mm ALUM. SECTION
QTY.	1 NOS.
LOCATION :	T6 FLAT A LAV. AT 33/F
GLAZING	G8-2 6mm FT Grey Tinted+1.52PVB+6mm FT CLEAR WITH ACID ETCHED ON SURFACE #4
REMARK :	

B.D. REF :
F.S.D. REF :

Note :
1. All dimensions are in mm.
2. All elevations are viewed from outside.
3. All dimensions to be verified on site before fabrication.

GENERAL NOTES

Legend :
1. F.F.L.-- Finished Floor Level
2. S.F.L.-- Structural Floor Level
3. (R) -- Reversed Detail

X1 -- DETAIL MARK NO.
X001 -- REFER SHEET NO.

NO.	DATE	REVISION	BY
-	31.10.2022	GENERAL REVISION	

CLIENT :
MARBLE EDGE INVESTMENT LTD.

ARCHITECT :
RONALD LU PARTNERS
ARCHITECTS | PLANNERS | INTERIOR DESIGNERS

STRUCTURAL ENGINEER :
ICMA C M WONG & ASSOCIATES LTD
TEL: 3482 2328 MOBILE: 3482 2328

MAIN CONTRACTOR :
?????????

美特鋁質有限公司
MIDI ALUMINIUM FABRICATOR LTD.
Units 6-8, Sunray Industrial Centre, 1/F
610 Cha Kwo Ling Road, Kowloon
Tel: 23489211-4 Fax: (852) 27727666

PROJECT :
PROPOSED RESIDENTIAL DEVELOPMENT AT NEW KOWLOON INLAND LOT. NO. 6552





TITLE :
WINDOW SCHEDULE FOR IN-SITU ALUM. WINDOW

JOB NO. : J-857

DRAWN BY : AN DATE : 18.OCT.2021

CHKD BY : SCALE A1: A3: 1:30

DWG. NO. : J857-IW-2009a REV. : -

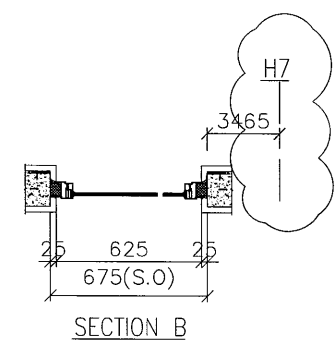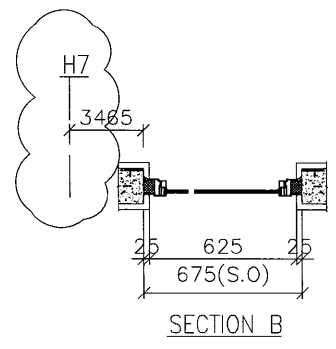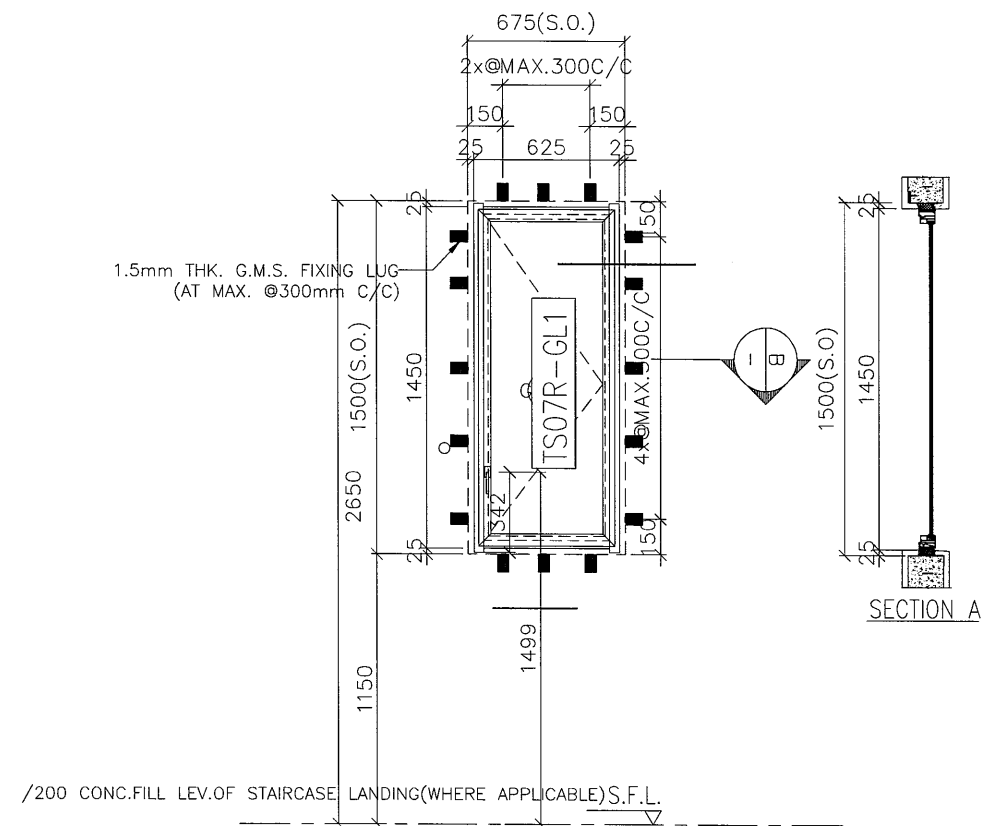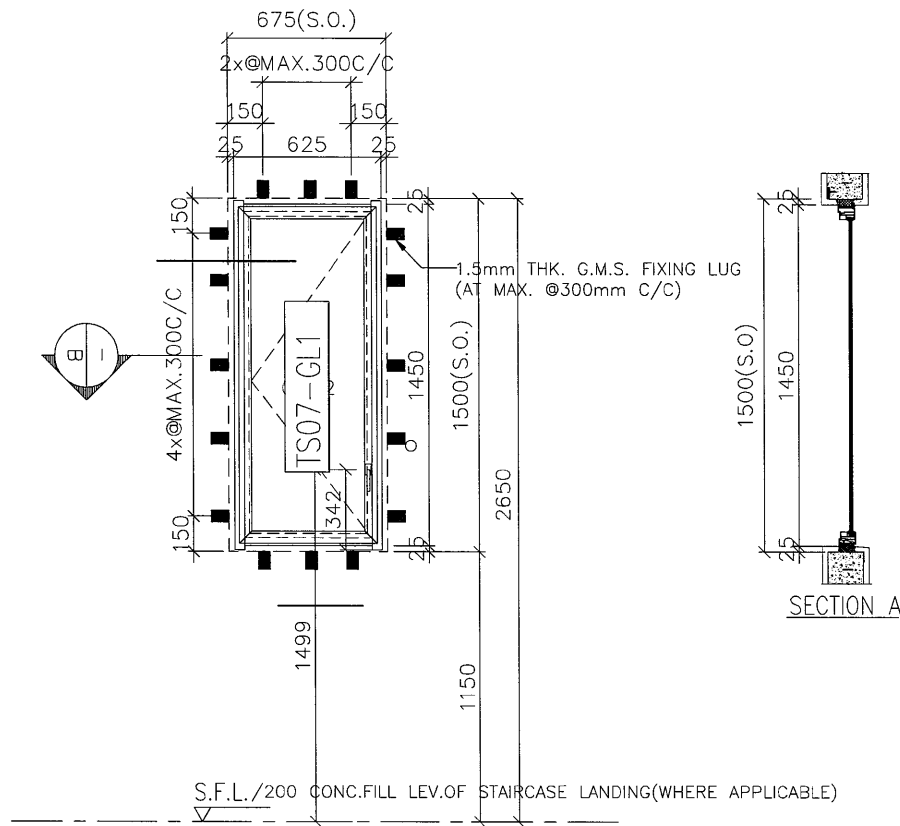

OPENABLE AREA	GLAZING AREA
0.727	0.65

OPENABLE AREA	GLAZING AREA
0.727	0.65

WINDOW MARK	AW TS07
SECTION :	65mm ALUM. SECTION
QTY.	1 NOS.
LOCATION :	TOWER 3 FLAT A BATH3 AT 33/F
GLAZING	G8-2 6mm FT Grey Tinted+1.52PVB+6mm FT CLEAR WITH ACID ETCHED ON SURFACE #4
REMARK :	

WINDOW MARK	AW TS07R
SECTION :	65mm ALUM. SECTION
QTY.	1 NOS.
LOCATION :	TOWER 6 FLAT A BATH3 AT 33/F
GLAZING	G8-2 6mm FT Grey Tinted+1.52PVB+6mm FT CLEAR WITH ACID ETCHED ON SURFACE #4
REMARK :	

B.D. REF :
F.S.D. REF :

Note :
1. All dimensions are in mm.
2. All elevations are viewed from outside.
3. All dimensions to be verified on site before fabrication.

GENERAL NOTES

Legend :
1. F.F.L.-- Finished Floor Level
2. S.F.L.-- Structural Floor Level
3. (R) -- Reversed Detail

X1 -- DETAIL MARK NO.
X001 -- REFER SHEET NO.

NO.	DATE	REVISED	BY
A	25.11.2022	GENERAL REVISION	
-	01.11.2022	GENERAL REVISION	

CLIENT :
MARBLE EDGE INVESTMENT LTD.

ARCHITECT :
RONALD LU & PARTNERS
ARCHITECTS | PLANNERS | INTERIOR DESIGNERS

STRUCTURAL ENGINEER :
CMA C M WONG & ASSOCIATES LTD
TEL: (852) 2772 7666



MAIN CONTRACTOR :
?????????

美特鋁質有限公司
MIDI ALUMINIUM FABRICATOR LTD.
Units 6-8, Sunray Industrial Centre, 1/F
610 Cha Kwo Ling Road, Kowloon
Tel: 23489211-4 Fax: (852) 2772 7666



PROJECT :
PROPOSED RESIDENTIAL DEVELOPMENT AT NEW KOWLOON INLAND LOT. NO.6552

TITLE :
WINDOW SCHEDULE FOR IN-SITU ALUM. WINDOW

JOB NO. : J-857
DRAWN BY : AN DATE : 18.OCT.2021
CHKD BY : SCALE A1: A3: 1:30
DWG. NO. : J857-IW-2007d REV. : A

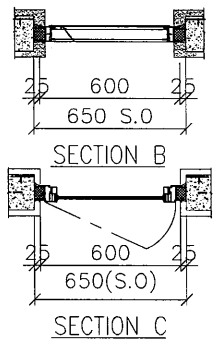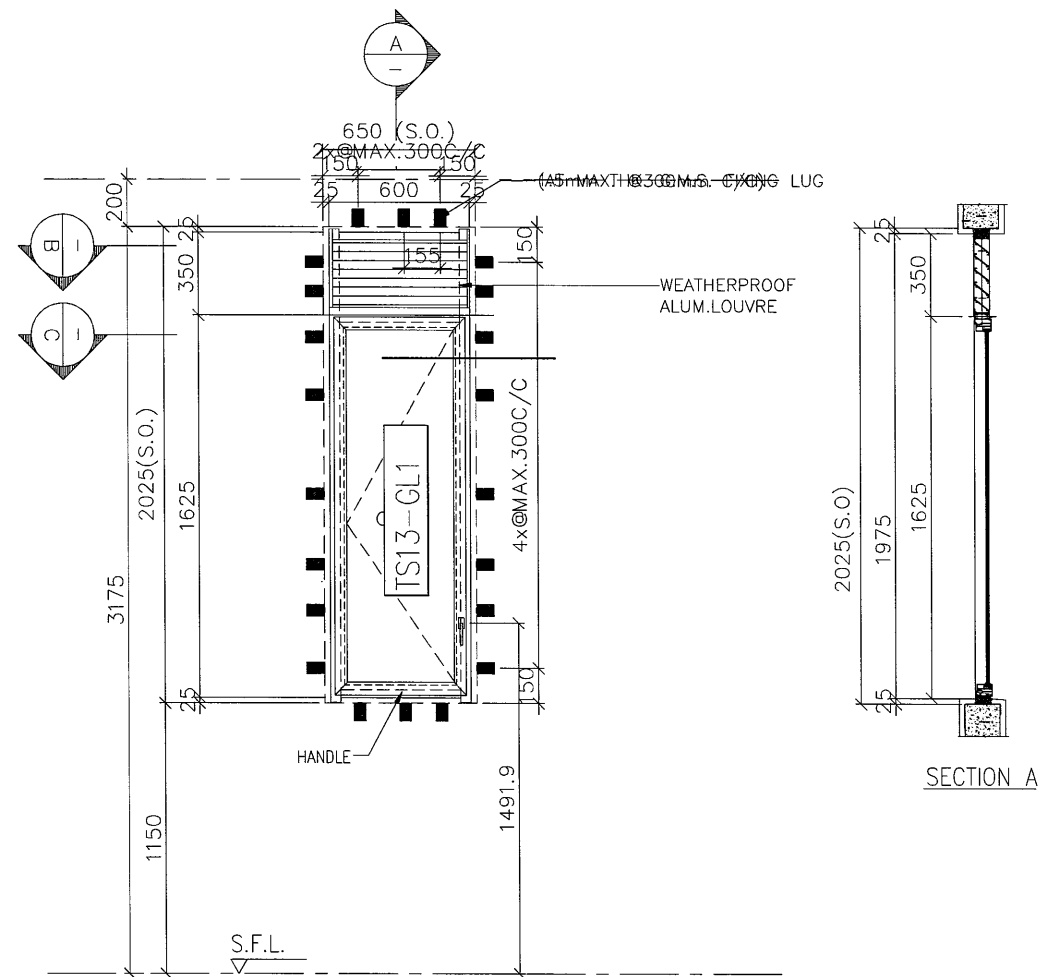

FREE AREA(%)	OPENABLE AREA	GLAZING AREA
56%	0.585	0.52

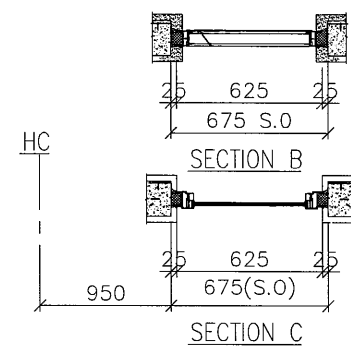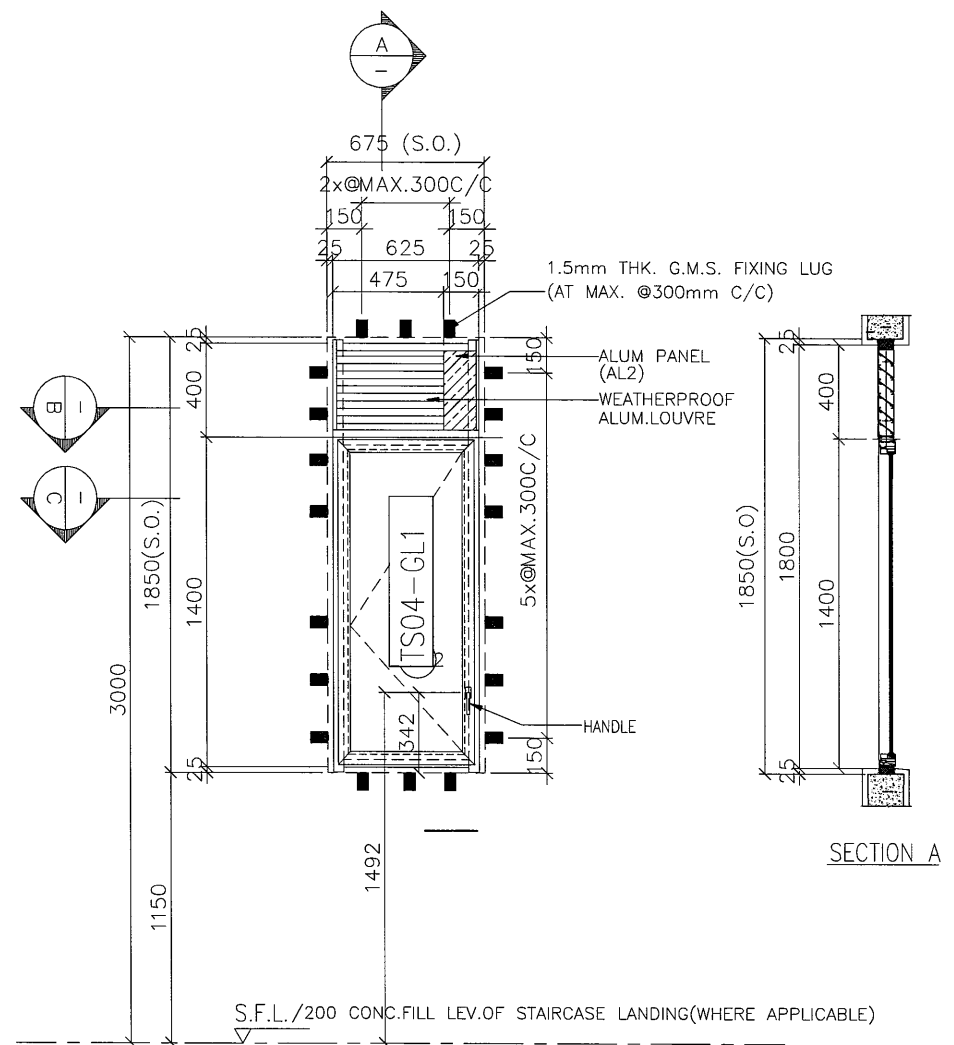

FREE AREA(%)	OPENABLE AREA	GLAZING AREA
56%	0.585	0.52

WINDOW MARK	AW TS13
SECTION :	65mm ALUM. SECTION
QTY.	1 NOS.
LOCATION :	TOWER L FLAT A KITCHEN AT 6F
GLAZING	G8-2 6mm FT Grey Tinted+1.52PVB+6mm FT CLEAR WITH ACID ETCHED ON SURFACE #4
REMARK :	

WINDOW MARK	AW TS04
SECTION :	65mm ALUM. SECTION
QTY.	1 NOS.
LOCATION :	T1 FLAT A LAV. AT 33/F
GLAZING	G8-2 6mm FT Grey Tinted+1.52PVB+6mm FT CLEAR WITH ACID ETCHED ON SURFACE #4
REMARK :	

B.D. REF :
F.S.D. REF :
Note :
1.All dimensions are in mm.
2.All elevations are viewed from outside.
3.All dimensions to be verified on site before fabrication.

GENERAL NOTES

Legend :
1. F.F.L.-- Finished Floor Level
2. S.F.L.-- Structural Floor Level
3. (R) -- Reversed Detail

X1 -- DETAIL MARK NO.
X001 -- REFER SHEET NO.

NO.	DATE	REVISION	BY
A	25.11.2022	GENERAL REVISION	
-	01.11.2022	GENERAL REVISION	

CLIENT :
MARBLE EDGE INVESTMENT LTD.

ARCHITECT :
RONALD LU & PARTNERS
ARCHITECTS | PLANNERS | INTERIOR DESIGNERS

STRUCTURAL ENGINEER :
C M WONG & ASSOCIATES LTD

MAIN CONTRACTOR :
?????????

美特鋁質有限公司
MIDI ALUMINIUM FABRICATOR LTD.
Units 6-8, Sunray Industrial Centre, 1/F
610 Cha Kwo Ling Road, Kowloon
Tel:23489211-4 Fax:(852)27727666

PROJECT :
PROPOSED RESIDENTIAL DEVELOPMENT AT NEW KOWLOON INLAND LOT. NO.6552



TITLE :
WINDOW SCHEDULE FOR IN-SITU ALUM. WINDOW

JOB NO. : J-857

DRAWN BY : AN DATE : 18.OCT.2021

CHKD BY : SCALE A1: A3: 1:30

DWC. NO. : J857-IW-2007C REV. : A

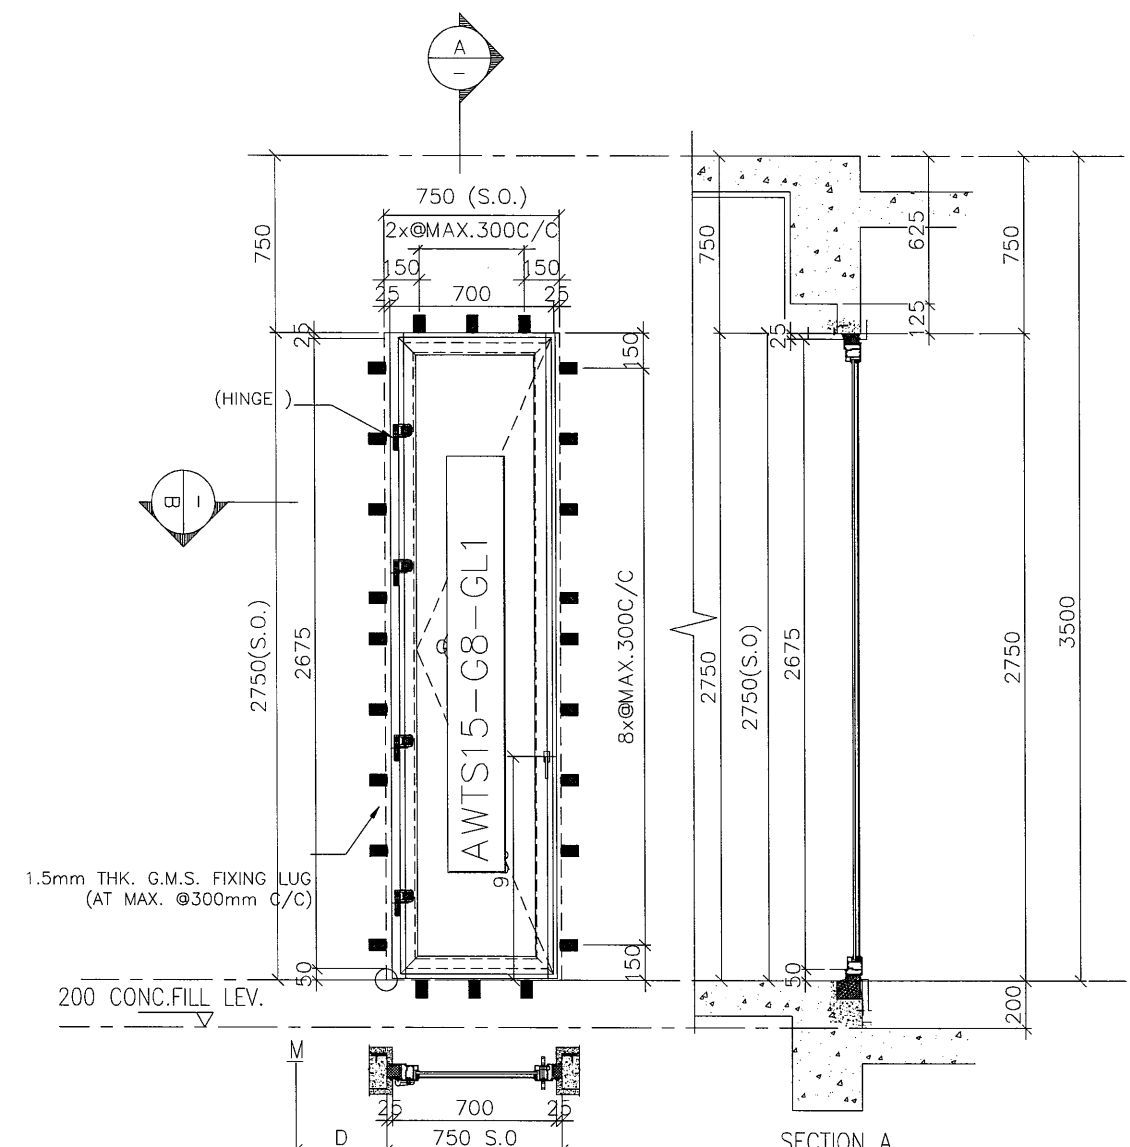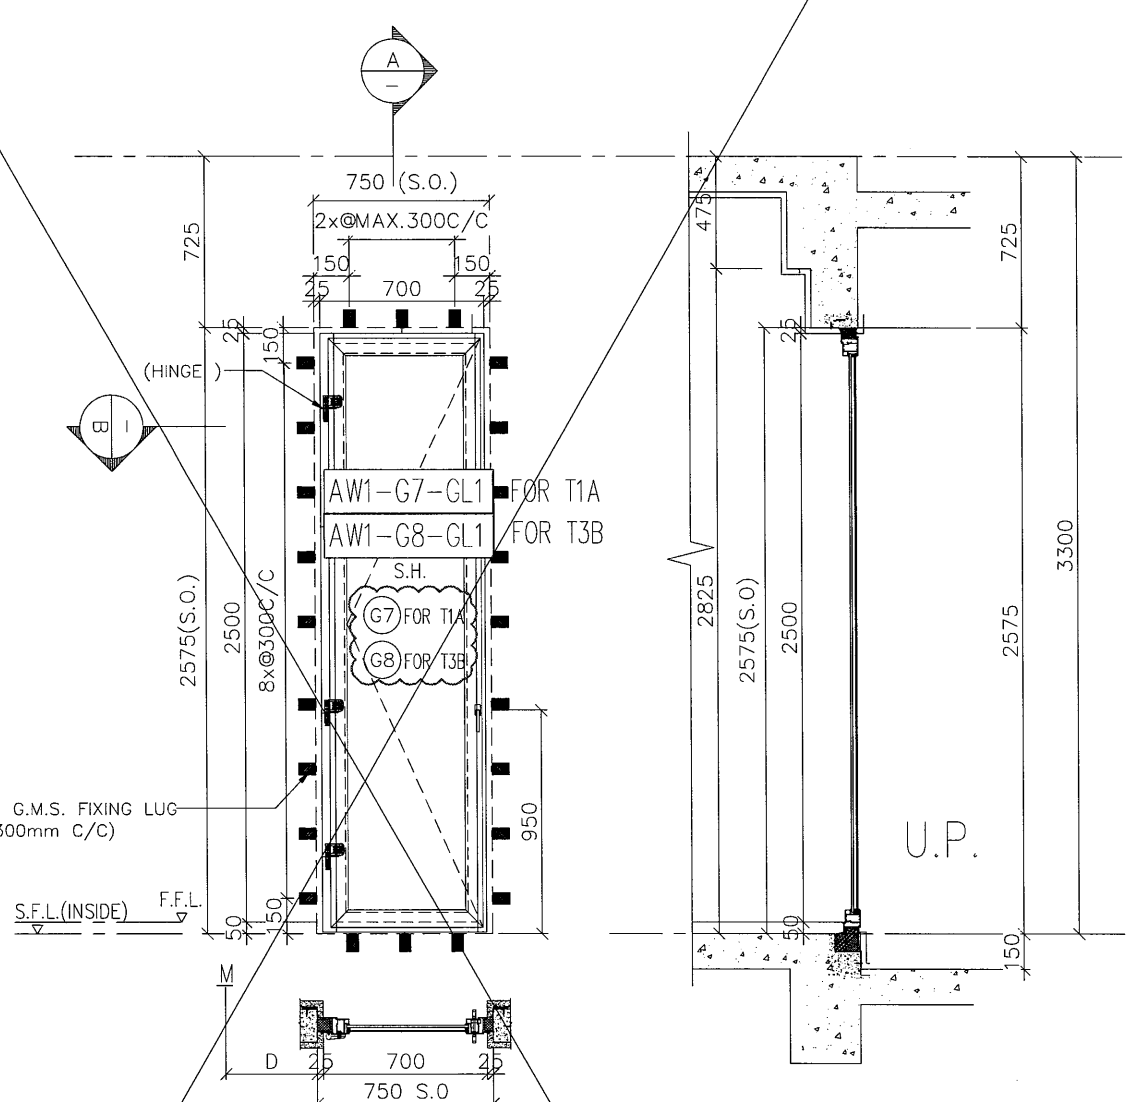

M	D	
HB	3225	T1A
HB	4200	T3B

OPENABLE AREA	GLAZING AREA
1.49	1.24

M	D	
H1	2998	T1A

OPENABLE AREA	GLAZING AREA
1.806	1.369

WINDOW MARK	AW 1
SECTION :	65mm ALUM. SECTION
QTY.	54 NOS.
LOCATION :	T1 FLAT A M.BR. AT 2F-32F (G7) FOR T1A (IGU) T3 FLAT B UTILITY RM AT 2F-32F (G8) FOR T3B (LAM GALSS)
GLAZING	(G7) IGU VISION GLASS 6mm HS LOW IRON+12AS+10mm FT LOW IRON WITH LOW-E CLATING ON SURFACE #2 (G8) 6mm FT Grey Tinted+1.52PVB+6mm FT Clear Laminated Glass
REMARK :	

WINDOW MARK	AW TS15
SECTION :	65mm ALUM. SECTION
QTY.	1 NOS.
LOCATION :	T1 FLAT A M.B.ATH AT 33F(G8-2) ,
GLAZING	G8-2 6mm FT Grey Tinted+1.52PVB+6mm FT CLEAR WITH ACID ETCHED ON SURFACE #4
REMARK :	

B.D. REF :
F.S.D. REF :

Note :
1. All dimensions are in mm.
2. All elevations are viewed from outside.
3. All dimensions to be verified on site before fabrication.

GENERAL NOTES

Legend :
1. F.F.L.-- Finished Floor Level
2. S.F.L.-- Structural Floor Level
3. (R) -- Reversed Detail

(X1) -- DETAIL MARK NO.
(X001) -- REFER SHEET NO.

NO.	DATE	REVISED	BY
I	25.11.2022	GENERAL REVISION	
H	01.11.2022	GENERAL REVISION	
G	04.06.2022	GENERAL REVISION	
F	06.04.2022	GENERAL REVISION	
E	24.03.2022	GENERAL REVISION	
D	06.01.2022	GENERAL REVISION	
C	26.12.2021	GENERAL REVISION	
B	5.12.2021	GENERAL REVISION	
A	28.10.2021	GENERAL REVISION	

CLIENT :
MARBLE EDGE INVESTMENT LTD.

ARCHITECT :
RONALD LU & PARTNERS
ARCHITECTS | PLANNERS | INTERIOR DESIGNERS

STRUCTURAL ENGINEER :
CMA C M WONG & ASSOCIATES LTD

MAIN CONTRACTOR :
?????????

美特鋁質有限公司
MIDI ALUMINIUM FABRICATOR LTD.
Units 6-8, Sunray Industrial Centre, 1/F
610 Cha Kwo Ling Road, Kowloon
Tel:23489211-4 Fax:(852)27727666

PROJECT :
PROPOSED RESIDENTIAL DEVELOPMENT AT NEW KOWLOON INLAND LOT. NO.6552

TITLE :
WINDOW SCHEDULE FOR IN-SITU ALUM. WINDOW

JOB NO. : J-857

DRAWN BY : AN DATE : 18.OCT.2021

CHKD BY : SCALE A1: A3: 1:30

DWG. NO. : J857-IW-2001 REV. : H