

工程指示 / 要求簡箋(E.I.)

工程指示編號：EI / 4430 / 22

修改版次：B

工程編號：J - 858

工程名稱：將軍澳日出康城 11

工程項目：幕牆 鋁料鋁碼模圖(2 個) (X86255, X86256)

收件人：Maggie

發件人：Renee Lo

日期：25/03/2022

要求提供 / 確認 事項：

- |                                    |                                     |                               |
|------------------------------------|-------------------------------------|-------------------------------|
| <input type="checkbox"/> 初步鋁料 B.M. | <input type="checkbox"/> 加工拆圖，然後生產  | <input type="checkbox"/> 尺寸表  |
| <input type="checkbox"/> 正式鋁料 B.M. | <input type="checkbox"/> 技術上資料 / 指示 | <input type="checkbox"/> 報價   |
| <input type="checkbox"/> 配件 B.M.   | <input type="checkbox"/> 樣辦或貨品說明書   | <input type="checkbox"/> 分判合約 |

內容：

**B 版：掛勾碼按結構工程師建議 增加 3mm movement 18mm 改成 22mm (X86255, X86256)**

**A 版：新增幕牆畫新模圖共 2 個 (X86256, X86258)**

**請為幕牆畫新模圖共 7 個 (X86254, X86255, X86257, X86259, X86260, X86261, X86266)**

**預計完成繪畫模圖日期: 28/03/2021**

謝謝

請在 2022.03.28 前完成上列要求。

附：2 頁 + CAD

以上項目為：

- 原合約工程包                       原合約工程加 / 減賬                       新工程報價

原因：-

分發東莞各部門：

- |                                                                      |                                                                        |                                                                         |                                                                |
|----------------------------------------------------------------------|------------------------------------------------------------------------|-------------------------------------------------------------------------|----------------------------------------------------------------|
| <input type="checkbox"/> 生產技術總監 <input type="checkbox"/> 連附件         | <input type="checkbox"/> 技術部 <input type="checkbox"/> 連附件              | <input type="checkbox"/> 生產部 <input type="checkbox"/> 連附件               | <input type="checkbox"/> 機械設計部 <input type="checkbox"/> 連附件    |
| <input type="checkbox"/> 採購部 <input type="checkbox"/> 連附件            | <input checked="" type="checkbox"/> 生產統籌部 <input type="checkbox"/> 連附件 | <input checked="" type="checkbox"/> 小羅 & 清 <input type="checkbox"/> 連附件 |                                                                |
| <input checked="" type="checkbox"/> 質檢部 <input type="checkbox"/> 連附件 | <input type="checkbox"/> 會計部 <input type="checkbox"/> 連附件              | <input type="checkbox"/> 報關組 <input type="checkbox"/> 連附件               | <input type="checkbox"/> 其他 _____ <input type="checkbox"/> 連附件 |

分發其他分判：

分發香港各部門：

- |                                                                      |                                                            |                                                           |                                                                |
|----------------------------------------------------------------------|------------------------------------------------------------|-----------------------------------------------------------|----------------------------------------------------------------|
| <input type="checkbox"/> 行政部 <input type="checkbox"/> 連附件            | <input type="checkbox"/> 會計部 <input type="checkbox"/> 連附件  | <input type="checkbox"/> 統籌部 <input type="checkbox"/> 連附件 | <input type="checkbox"/> 工程部地盤科文 <input type="checkbox"/> 連附件  |
| <input checked="" type="checkbox"/> 採購部 <input type="checkbox"/> 連附件 | <input type="checkbox"/> QS 部 <input type="checkbox"/> 連附件 | <input type="checkbox"/> 維修部 <input type="checkbox"/> 連附件 | <input type="checkbox"/> 其他 _____ <input type="checkbox"/> 連附件 |

傳遞編號：

發件人簽署：

HK 0488 / 22

項目經理簽署：







MIDI ALUMINIUM FABRICATOR LTD.

DRAWING NO.  
X86255

REV.  
A

TITLE

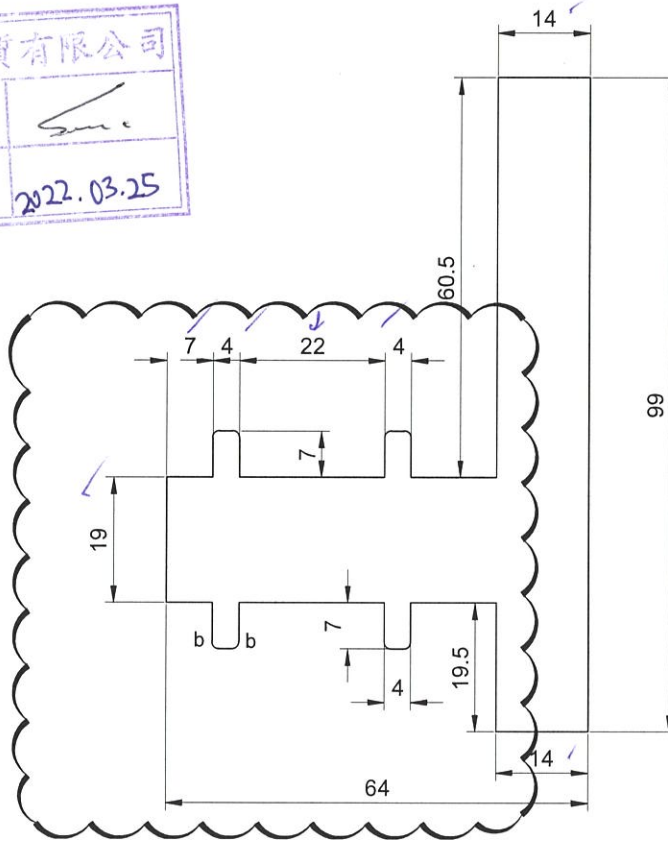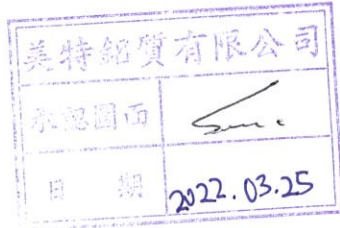

SCALE 1:1


APPROVED :

6061-T6  
Unspec.Radius: R0.5

1.Important dimension: \*  
2.Referenced dimension: ( )

a=R0.3  
b=R1.0  
v=R0.5XDP0.5

SECTIONAL AREA	mm <sup>2</sup>	ADDITIONAL TOLERANCE	DATE	REVISION			
				NO.	DATE	NAME	DESCRIPTION
2446.28		Thickness ± 0.1 mm	01/03/2022				
WEIGHT	KG/M	Flatness 0.1 /25mm width	SCALE				
6.63		Straightness 0.3 /300mm	1 : 1				
PERIMETER	mm	Twist 0.5° /300 mm max	DRAWN				
378.57		Angularity ± 1.0 degree	CHECK				
V.F.	mm						

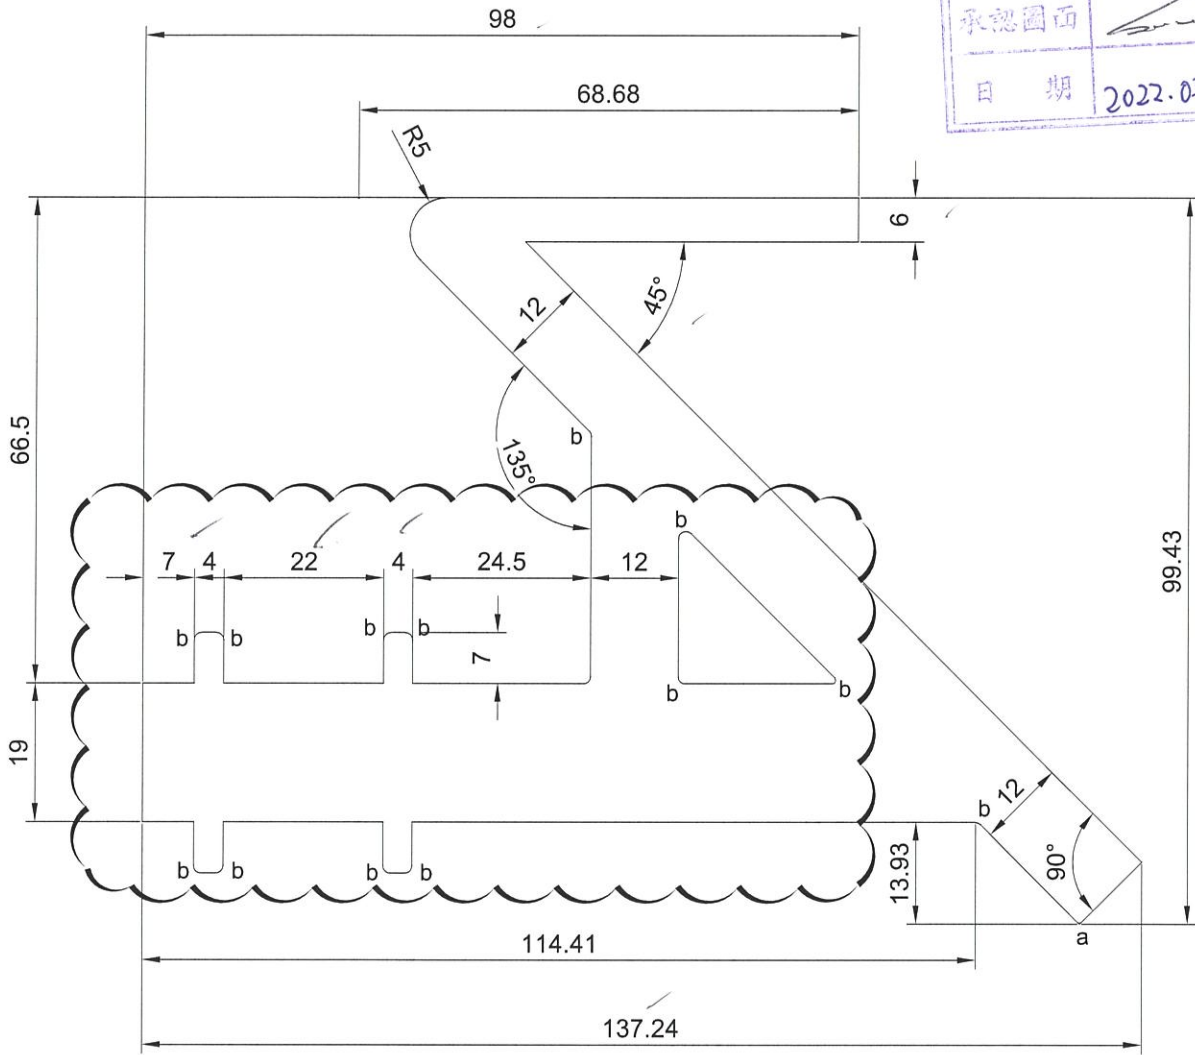

SCALE 1:1

APPROVED :

6061-T6  
Unspec. Radius: R0.5

1. Important dimension: \*  
2. Referenced dimension: ()

a=R0.3  
b=R1.0  
v=R0.5XDP0.5

SECTIONAL AREA	mm <sup>2</sup>	ADDITIONAL TOLERANCE	DATE	REVISION			
				NO.	DATE	NAME	DESCRIPTION
4329.9		Thickness ± 0.1 mm	01/03/2022				
WEIGHT	KG/M	Flatness 0.1 /25mm width	SCALE				
11.73		Straightness 0.3 /300mm	1 : 1				
PERIMETER	mm	Twist 0.5° /300 mm max	DRAWN				
658.9		Angularity ± 1.0 degree	-				
V.F.	mm		CHECK				