

工程指示 / 要求簡箋(E.I.)

工程指示編號：EI / 4441 / 22

修改版次：-

工程編號：J - 858

工程名稱：將軍澳日出康城 11

工程項目：佛沙窗 佛沙廠用配件 水線碼 (20 件)

收件人：生統/ 楊榮輝

發件人：Ant Yeung

日期：09/03/2022

要求提供 / 確認 事項：

- () 初步鋁料 B.M. () 加工拆圖，然後生產 () 尺寸表
- () 正式鋁料 B.M. () 技術上資料 / 指示 () 報價
- () 配件 B.M. () 樣辦或貨品說明書 () 分判合約

內容：

請生產水線 20 件 跟第一批窗出貨。

只提供生產，大貨由佛沙廠安裝。

大貨數量未放行，請佛沙廠駐廠人員盡快回覆，尺寸是否 ok??

請在 2022.03.14 前完成上列要求。

附：1 頁 BM

以上項目為：

- 原合約工程包 原合約工程加 / 減賬 新工程報價

原因：-

分發東莞各部門：

- () 生產技術總監 連附件 () 技術部 連附件 () 生產部 連附件 () 機械設計部 連附件
- () 採購部 連附件 () 生產統籌部 連附件 () 小羅&清 連附件
- () 質檢部 連附件 () 會計部 連附件 () 報關組 連附件 () 其他 楊榮輝 連附件

分發其他分判：

分發香港各部門：

- () 行政部 連附件 () 會計部 連附件 () 統籌部 連附件 () 工程部地盤科文 連附件
- () 採購部 連附件 () QS 部 連附件 () 維修部 連附件 () 其他 _____ 連附件

傳遞編號：


HK 0369 / 22

發件人簽署：

項目經理簽署：

22444 HK 0369

EG-DWG4

 美特鋁質有限公司 MIDI Aluminium Fabricator Ltd.		類別	物料號	
修改		制圖 邱紅	2018.07.23	圖號 837-AF01-S1
日期		復核 謝永林	2018.07.24	數量 2458 2480
		批准		位置



J858

2014

佛沙場用

用水線碼裝置

~~鐵~~
~~鐵~~
2015備

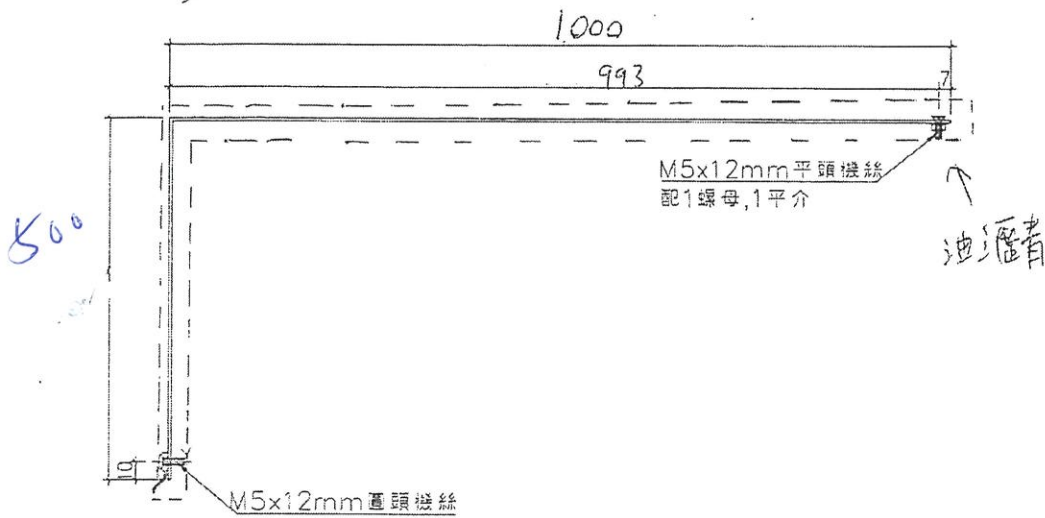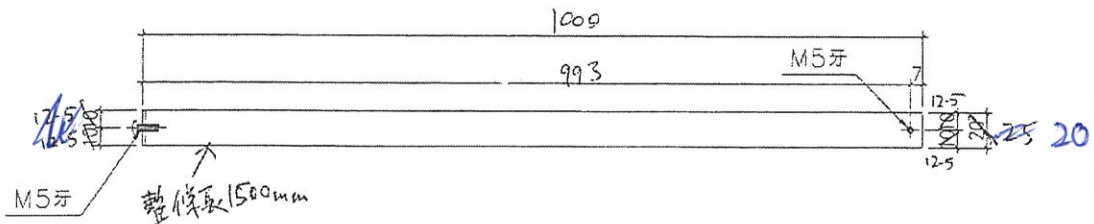


J858

20x1.5

L=1500mm

工程號	J-837	地盤	鯉塘橋長石	附 件
名稱	鋁板加工圖	採用		
材料	1.5mm 鋁板 25x1.5mm 鋁板	地盤		
顏色	ANLC 黑色	油瀝青	工廠	

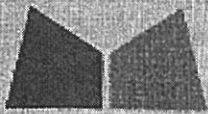

美特鋁質有限公司
MIDI ALUMINIUM FABRICATOR LTD.

E-Mail
15 FEB 2022

Quotation

To : Gammon Engineering & Construction Company Limited Email : Matthew.CK.Wong@gammonconstruction.com
 Contract Name : T.K.O.T.L.70RP, Phase 11, LOHAS Park, TKO
 Attn : Mr. Matthew Wong
 Our Ref. : QTN/10829/858/01 Instruction Ref. :-
 Date : 16th February, 2022 Instruction Date :-
 Subject : Quotation - Supply Only for Aluminium Bonding Tape for Window on Precast Façade

Copy Distribution: Client Architect Consultant Others

Item	Description	Rate Refer	Qty.	Unit	Rate	(HK\$) Amount
	<u>Supply Only for Aluminium Bonding Tape for Window on Precast Façade</u>					
1)	Supply only for aluminium bonding tape for window on precast façade. (T1 - T3 total alum bonding tape 626pcs @ 465m)	-	626	pcs		
2)	Service charge 15%	-	1	sum		

Total: [Redacted]
Rounded up: [Redacted]

Handwritten note in Chinese: 此項提供材料

Remark:

- 1) Please note that the above quantity is base on the estimated qty.
- 2) 30% deposit up on signing of quotation.
- 3) 70% upon goods delivery.
- 4) This quotation is valid for 30 calendar days from the date of this quotation.

MIDI ALUMINIUM FABRICATOR LTD
Signed:

Handwritten signature of Francis Mau

Francis Mau
Managing Director

Agreed by :
(with company chop)

Name :
Date :

c.c. Gammon (QS Dept) - Mr. Jimmy Wong

(email only)

Handwritten signature: HNLMT/OS/MIWYI