



工程指示 / 要求簡箋(E.I.)

工程指示編號：EI / 4488 / 22 修改版次：-
 工程編號：J - 858 工程名稱：將軍澳日出康城 11
 工程項目：佛沙窗 留意安裝事項 PF 12.22
 收件人：生統 發件人：Ant Yeung 日期：22/03/2022

要求提供 / 確認 事項：

- | | | |
|------------------------------------|-------------------------------------|-------------------------------|
| <input type="checkbox"/> 初步鋁料 B.M. | <input type="checkbox"/> 加工拆圖，然後生產 | <input type="checkbox"/> 尺寸表 |
| <input type="checkbox"/> 正式鋁料 B.M. | <input type="checkbox"/> 技術上資料 / 指示 | <input type="checkbox"/> 報價 |
| <input type="checkbox"/> 配件 B.M. | <input type="checkbox"/> 樣辦或貨品說明書 | <input type="checkbox"/> 分判合約 |

內容：

因應則師要求。此 4 款窗的安裝為 40 室內/ 50 窗/ 60 室外，(這樣不需加欄河玻璃)

PF 12,

PF22

T2 A-C/ B-1

T2 A-D/ B-1

T3 A-C/ B-1

T3 A-D/ B-1

謝謝

請在 2022.03.23 前完成上列要求。

附：1 頁 BM

請通知設計

以上項目為：

- 原合約工程包 原合約工程加 / 減賬 新工程報價

原因：-

分發東莞各部門：

- | | | | | | | | |
|---------------------------------|------------------------------|---|---|-------------------------------|------------------------------|--|---|
| <input type="checkbox"/> 生產技術總監 | <input type="checkbox"/> 連附件 | <input type="checkbox"/> 技術部 | <input type="checkbox"/> 連附件 | <input type="checkbox"/> 生產部 | <input type="checkbox"/> 連附件 | <input type="checkbox"/> 機械設計部 | <input type="checkbox"/> 連附件 |
| <input type="checkbox"/> 採購部 | <input type="checkbox"/> 連附件 | <input checked="" type="checkbox"/> 生產統籌部 | <input checked="" type="checkbox"/> 連附件 | <input type="checkbox"/> 小羅&清 | <input type="checkbox"/> 連附件 | | |
| <input type="checkbox"/> 質檢部 | <input type="checkbox"/> 連附件 | <input type="checkbox"/> 會計部 | <input type="checkbox"/> 連附件 | <input type="checkbox"/> 報關組 | <input type="checkbox"/> 連附件 | <input checked="" type="checkbox"/> 其他 | <input checked="" type="checkbox"/> 連附件 |

分發其他分判：

分發香港各部門：

- | | | | | | | | |
|------------------------------|------------------------------|-------------------------------|------------------------------|------------------------------|------------------------------|----------------------------------|------------------------------|
| <input type="checkbox"/> 行政部 | <input type="checkbox"/> 連附件 | <input type="checkbox"/> 會計部 | <input type="checkbox"/> 連附件 | <input type="checkbox"/> 統籌部 | <input type="checkbox"/> 連附件 | <input type="checkbox"/> 工程部地盤科文 | <input type="checkbox"/> 連附件 |
| <input type="checkbox"/> 採購部 | <input type="checkbox"/> 連附件 | <input type="checkbox"/> QS 部 | <input type="checkbox"/> 連附件 | <input type="checkbox"/> 維修部 | <input type="checkbox"/> 連附件 | <input type="checkbox"/> 其他 | <input type="checkbox"/> 連附件 |

傳遞編號：

HK 457 / 22

發件人簽署：

項目經理簽署：

B.D. REF: **2023.3.21**

CLIENT: 信和置業有限公司
Sino Land Company Limited

ARCHITECT: Ronald Lu & Partners
Ronald Lu & Partners (HK) Ltd.
馬元祥建築師事務所(信和)有限公司

MAIN CONTRACTOR: Gammon

STRUCTURAL ENGINEER: AECOM

FAÇADE CONSULTANT: AECOM

NOTE:
1. ALL DIMENSIONS ARE IN mm.
2. ALL DIMENSIONS ARE VIEWED FROM OUTSIDE BEFORE FABRICATION.
3. ALL DIMENSIONS TO BE WORKED ON SITE.

LEGEND:
X DETAIL MARK NO.
REF REFER SHEET NO.
1. FEEL --- FINISHED FLOOR LEVEL
2. SEL --- STRUCTURAL FLOOR LEVEL
3. 2 --- REVERSED DETAIL

14-03-2020	REVISED AS PER COMMENT	CF
12-11-2022	REVISED AS PER ARCHITECT COMMENT	LS
14-10-2021	REVISED AS PER ARCHITECT COMMENT	LS
14-08-2021	REVISED AS PER ARCHITECT COMMENT	LS
14-07-2021	REVISED AS PER ARCHITECT COMMENT	LS
14-06-2021	REVISED AS PER ARCHITECT COMMENT	LS

JOB NO.: J-858


PROJECT: PROPOSED RESIDENTIAL DEVELOPMENT AT TROT, TSEUNG KWAN O, N.T.

TITLE: TYPICAL DETAIL FOR PRECAST ALUM. WINDOW

DATE: 04-OCT-21 SCALE: 1:2
DRAWN BY: CHECKED BY:

英特銘實業有限公司
MIDI CONSTRUCTION MANAGEMENT LTD.
1101-15-1, Sunny Residential Centre, 1/F
14234821-1 Fax: (852) 2727668

DWG NO.: J858-PW-6001 REV.: C

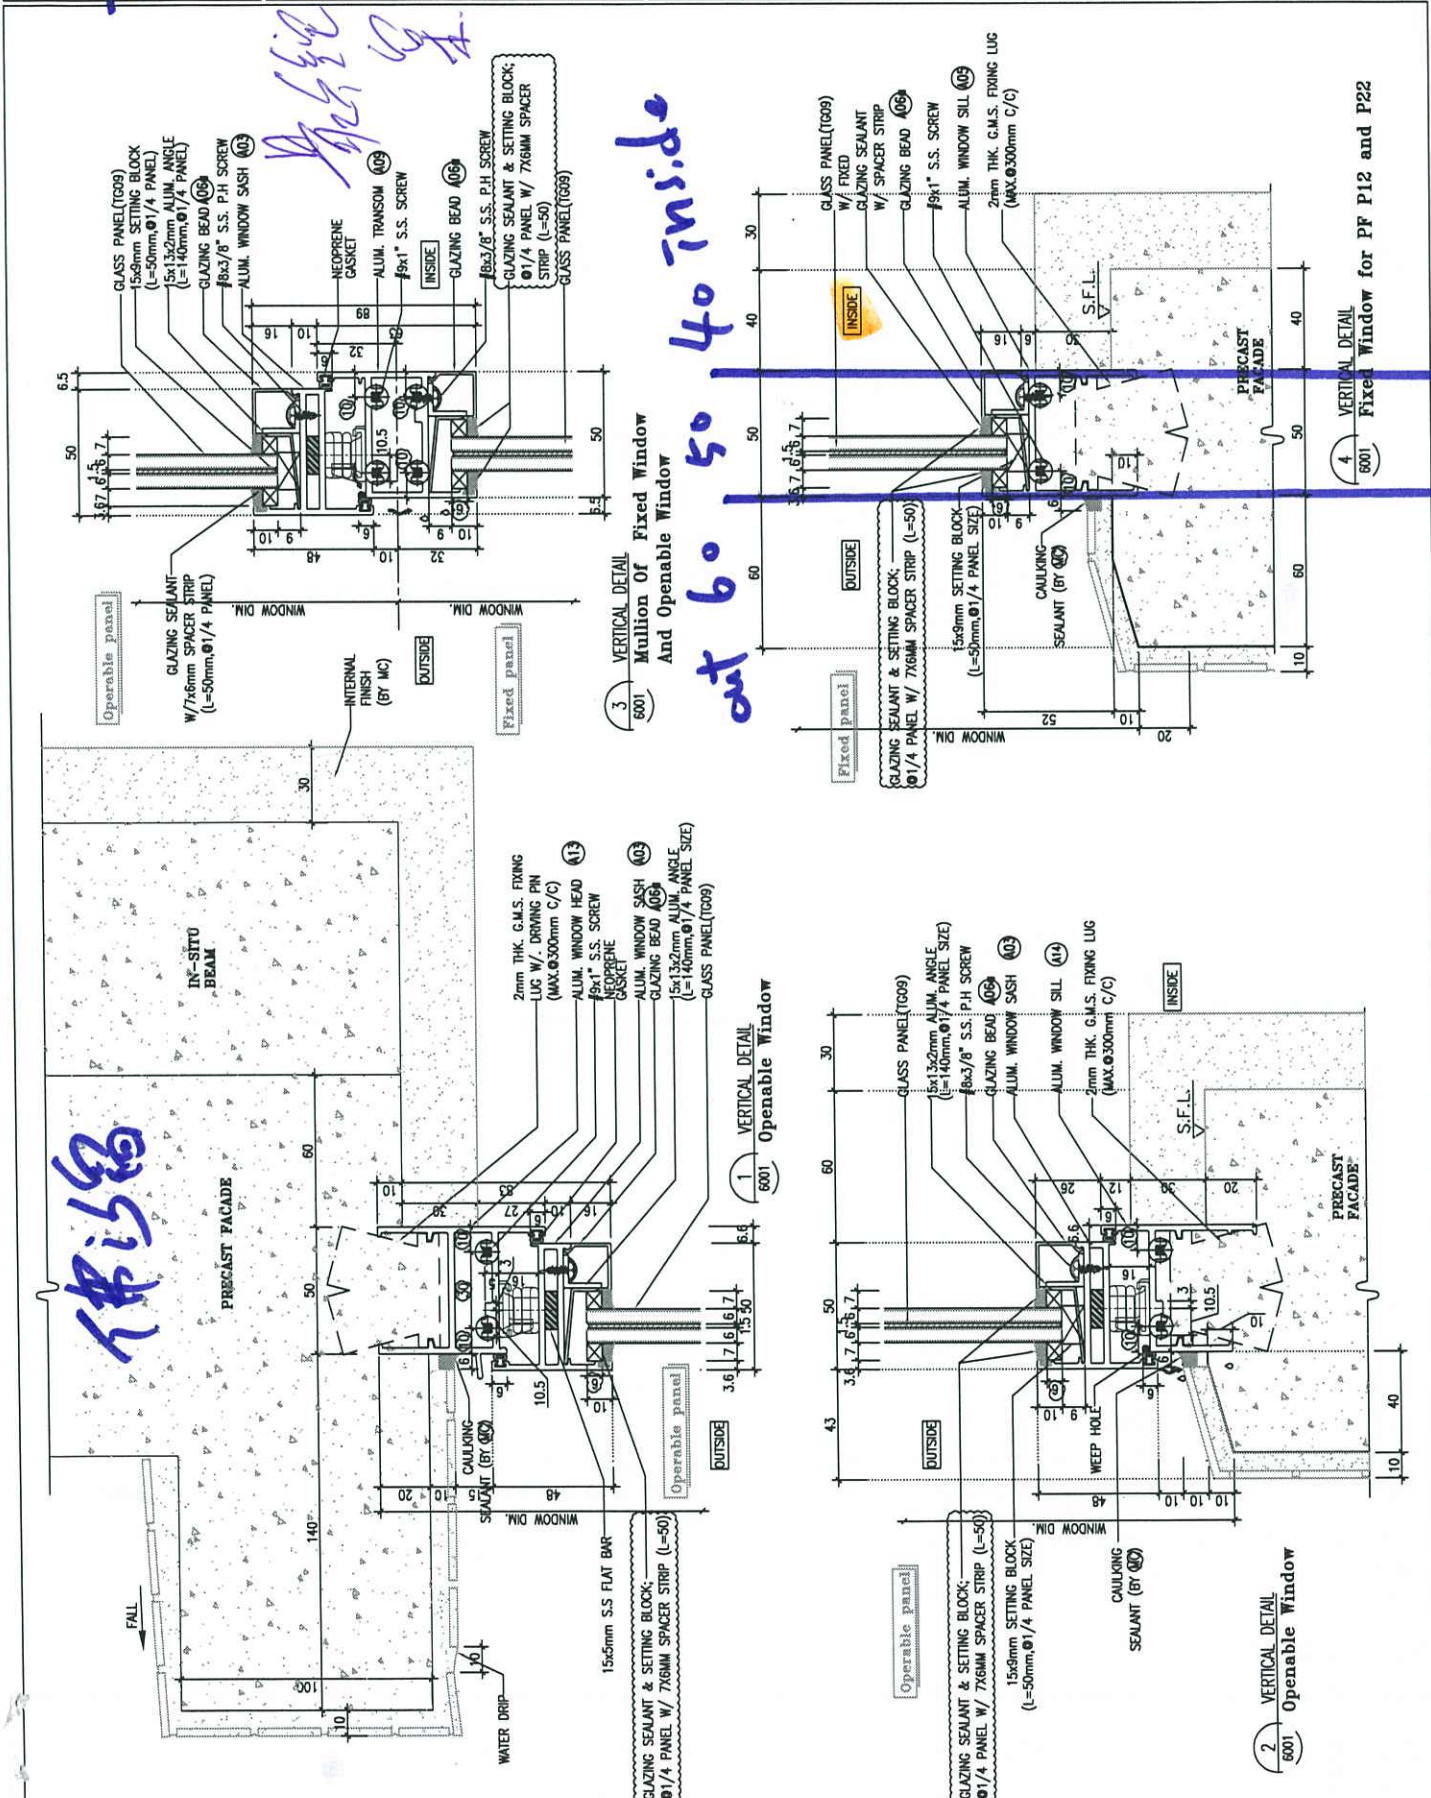

RLP/SSF
 Project Proposed Residential Development at TKOTL 70RP, Phase 11, Lohas Park, Tseung Kwan O, New Territories
 Works Main Contract
 Contract No. J3931
 Ref. No. P19084NT/SD/A/072 (Rev.7)
 GECCL Ref. J3931/304/D02799
 Date 14 Feb 2022
 To / Attn RLP / Mr. Kenneth Wong / Mr. Darren Tsang / Mr. Florence Cheung
 Subject **Shop Drawing of Precast Aluminium Window (Rev.7)**

Received by SE / BS / LA /

Received by RLP

Anticipated date of response **28 Feb 2022**

We write to request this submission replied by: RLP / AECOM/ WSP / Others

We certify that the submission has been checked and is in full compliance with the Specification & Contract Documents, unless otherwise stated in the remarks.


 Matthew Wong
 For and on behalf of
Gammon Engineering & Construction Company Limited
 MW/BK/UT/BN/HW/vh

- | | | |
|---------------------|-------------------------------------|---|
| | cc w/e | |
| MTRC (Site) | <input checked="" type="checkbox"/> | Mr. KS Lee / Mr. Teddy Wu / Mr. HF Au / Mr. SL Kwan / Mr. Jacky Cheung |
| MTRC (STR) | <input type="checkbox"/> | Mr. Tony Fan |
| MTRC (E&M) | <input type="checkbox"/> | Mr. Ricky Ting |
| MTRC (Cost & Prog) | <input type="checkbox"/> | Mr. Anthony Tam |
| SKY CASTLE | <input checked="" type="checkbox"/> | Mr. Herbert Thung / Mr. Francis Lai / Mr. Davy Ko / Mr. Kenneth Leung / Mr. Andy Chan |
| AECOM | <input checked="" type="checkbox"/> | Mr. Henry Lo / Mr. Cole Li |
| AECOM (Façade) | <input checked="" type="checkbox"/> | Ms. Monnie Lee / Ms. Phoebe Chung / Mr. Ryan Ko |
| WSP | <input checked="" type="checkbox"/> | Mr. Simon Kaan / Mr. Tommy Leung |
| ADI (LANDSCAPE) | <input type="checkbox"/> | Mr. Witter So / Mr. Kenif Ng |
| MDL | <input type="checkbox"/> | Mr. Morty Law |
| Beria | <input type="checkbox"/> | Mr. Keith Yim / Mr. Randolph Chan |
| RE (AECOM) | <input checked="" type="checkbox"/> | Mr. Simon Tso / Mr. Ken Siu |
| COW | <input checked="" type="checkbox"/> | Mr. Marcus Kee |
| BSI | <input type="checkbox"/> | BSI |
| WSP (Safety & Risk) | <input checked="" type="checkbox"/> | Mr. Chris Tong / Mr. Louis Siu |
| Ramboll | <input type="checkbox"/> | Mr. David Yeung |
| Tin Lee | <input type="checkbox"/> | Mr. Eddie Kwan |
| AEC | <input type="checkbox"/> | Mr. Andy Lai |

Drawing No.	Rev.	Description
As attached		

Review Status / Comment:

B for the followings:

1. Refer to comments for rev. 3, rev.4 and markup in red.
2. Refer AECOM/AECOM (facade)/WSP/MOTY's comment.
3. Verify with CSD/CBWD/precast facade drawings. Verify dimensions and discrepancies between drawings.


Remarks (To list deviations, if any) * Delete as appropriate

RESPONSE TO SHOP DRAWING SUBMISSION

Date 15/3/2022

You are reminded that the above comments are not exhaustive and any comments/approval shall by no means relieve Contractor's liability to ensure compliance with all contractual and statutory requirements. Any comments/approval are subject to no time implications and no cost additions to the Contract unless explicitly confirmed in writing by the Architect.

You are required to ensure your proposal fully conform to contractual requirements, actual and implied warranties. Any approved system / material (including all accessories and ancillary materials/fittings) shall be used in strict accordance with relevant manufacturer's instructions, method statement and recommendations for use in respective areas specified in the Contract.

 **RONALD LU & PARTNERS**
 For and on behalf of **Ronald Lu & Partners (Hong Kong) Ltd.**
 KW/FCH/TLL/LYT/PAC

No review is made of detail dimensions/quantities.
 The submission is reviewed for general compliance with the design intent only.
 Any comments or amendments required shall not be deemed to be variation.
 The review does not release the Contractor from his responsibilities to comply with contract requirements.
 For resubmission, the Contractor has to highlight or cloud those revision areas in the shop drawing for review.

Legend: A (No objection) C (Amendment & resubmission required)
 B (No objection, subject to comments as noted) D (Rejected & resubmission required)

w/e

- Ginny Chau
- | | | |
|---------------------|-------------------------------------|---|
| MTRC (Site) | <input checked="" type="checkbox"/> | Mr. KS Lee / Mr. Teddy Wu / Mr. HF Au / Mr. SL Kwan / Mr. Jacky Cheung |
| MTRC (STR) | <input type="checkbox"/> | Mr. Tony Fan |
| MTRC (E&M) | <input type="checkbox"/> | Mr. Ricky Ting |
| MTRC (Cost & Prog) | <input type="checkbox"/> | Mr. Anthony Tam |
| SKY CASTLE | <input type="checkbox"/> | Mr. Herbert Thung / Mr. Francis Lai / Mr. Davy Ko / Mr. Kenneth Leung / Mr. Andy Chan |
| AECOM | <input type="checkbox"/> | Mr. Henry Lo / Mr. Cole Li |
| AECOM (Façade) | <input checked="" type="checkbox"/> | Ms. Monnie Lee / Ms. Phoebe Chung / Mr. Ryan Ko |
| WSP | <input type="checkbox"/> | Mr. Simon Kaan / Mr. Tommy Leung |
| ADI (LANDSCAPE) | <input type="checkbox"/> | Mr. Witter So / Mr. Kenif Ng |
| MDL | <input type="checkbox"/> | Mr. Morty Law |
| Beria | <input type="checkbox"/> | Mr. Keith Yim / Mr. Randolph Chan |
| RE (AECOM) | <input type="checkbox"/> | Mr. Simon Tso / Mr. Ken Siu |
| COW | <input type="checkbox"/> | Mr. Marcus Kee |
| BSI | <input type="checkbox"/> | BSI |
| WSP (Safety & Risk) | <input type="checkbox"/> | Mr. Chris Tong / Mr. Louis Siu |
| Ramboll | <input type="checkbox"/> | Mr. David Yeung |
| Tin Lee | <input type="checkbox"/> | Mr. Eddie Kwan |
| AEC | <input type="checkbox"/> | Mr. Andy Lai |

midi@midiltd.com.hk

From: "Ginny CHAU [RLPHK]" <ginnychau@rlphk.com>
To: "midi@midiltd.com.hk" <midi@midiltd.com.hk>,
"Jun.Tsui@gammonconstruction.com" <Jun.Tsui@gammonconstruction.com>,
"Brian.Ng@gammonconstruction.com" <Brian.Ng@gammonconstruction.com>,
"j3931@gammonconstruction.com" <j3931@gammonconstruction.com>,
"KaHei.Wong@gammonconstruction.com" <KaHei.Wong@gammonconstruction.com>,
Andy
Chan Yan Wai <andywchan@sino.com>,
"p19084@rlphk.com" <p19084@rlphk.com>
Copies to: "Marina TONG [RLPHK]" <marinatong@rlphk.com>,
"daisy.lau@aecom.com"
<daisy.lau@aecom.com>,
"ryan.ko@aecom.com" <ryan.ko@aecom.com>,
"jason.lcs.midi@gmail.com" <jason.lcs.midi@gmail.com>,
"ant.ysy.midi@gmail.com" <ant.ysy.midi@gmail.com>,
"eric.lkw.midi@gmail.com"
<eric.lkw.midi@gmail.com>
Subject: RE: LP11-(PW 2103) 佛沙窗 (PF12,PF22)
Date sent: Mon, 21 Mar 2022 09:09:01 +0000

Dear Jason (Midi) /GECCL,

We confirmed the proposed detail of precast window which was discussed at site tower coordination meeting in December, 2021, to avoid internal finishes >75mm that is below 500mm A.F.F.L.. Please revise accordingly and advice if there is any adverse implication. Thank you.

Regards,

Ginny Chau
RLP

D +852 22999821
E ginnychau@rlphk.com

From: midi@midiltd.com.hk <midi@midiltd.com.hk>
Sent: Monday, 21 March 2022 4:53 pm
To: Jun.Tsui@gammonconstruction.com; Brian.Ng@gammonconstruction.com;
j3931@gammonconstruction.com; KaHei.Wong@gammonconstruction.com
Cc: Marina TONG [RLPHK] <marinatong@rlphk.com>; Ginny CHAU [RLPHK]
<ginnychau@rlphk.com>; daisy.lau@aecom.com; ryan.ko@aecom.com;
jason.lcs.midi@gmail.com; ant.ysy.midi@gmail.com; eric.lkw.midi@gmail.com
Subject: LP11-(PW 2103) 佛沙窗 (PF12,PF22)

Dear Jun , Brian , Ka hei
早前已在2022.01.27 RFI 會議確認 (PW 2103) (PF12,PF22) 40mm inside / 50mm win/ 60mm outside
的 setting out ,
以不需再額外加上欄河玻璃。請留意。
請協調佛沙廠的生產,
謝謝

源

MIDI Aluminium Fabricator Ltd., Tel:(852) 2348 9211, Fax:(852) 2772 7666

The information contained in this e-mail is confidential and is intended solely for the addressee. If you are not the intended recipient, please notify the sender immediately and delete this e-mail from your system. Any unauthorised use, disclosure, copying, printing, forwarding or dissemination of any part of this information is prohibited. MIDI does not accept responsibility for the content of any e-mail transmitted by its staff for any reason other than bona fide business purposes. Any information that is not transmitted via secure tamper-proof technology should not be relied upon, unless advised or agreed otherwise in writing by an authorised representative of MIDI