

工程指示 / 要求簡箋 ENGINEER INSTRUCTIONS(E.I.)

工程指示編號:	EI- 4631	修改版本:	-
	HK- 698		
工程編號:	J 858	工程名稱:	將軍澳日出康城11
收件人:	生統 / 楊榮輝 / Maggie	發件人:	Ant Yeung
工程項目:	幕牆 單元件 香檳金膠 廠用配件BM	日期:	26/04/2022

<input type="checkbox"/> 原合約工程包	<input type="checkbox"/> 原合約工程加 / 減賬 QT-	<input type="checkbox"/> 新工程報價 QT-
---------------------------------	--	------------------------------------

信件批核號碼/圖紙參考編號:	批核模具圖紙編號:
客戶指示附件:	管理內部批簽署:

<input type="checkbox"/> 初步鋁料 B.M.	<input type="checkbox"/> 加工拆圖, 然後生產	<input type="checkbox"/> 尺寸表
<input type="checkbox"/> 正式鋁料 B.M.	<input type="checkbox"/> 技術上資料/指示	<input type="checkbox"/> 報價
<input checked="" type="checkbox"/> 配件 B.M.	<input type="checkbox"/> 樣辦或貨品說明書	<input type="checkbox"/> 分判合約
<input type="checkbox"/> 其他:		

內容:
業主已確認幕牆單元件的部分位置為香檳金色膠(code 577) 跟觀塘色。 <input checked="" type="checkbox"/> 室內位置橫碰企、欄河玻璃等等 因香檳金膠(code 577) 不是標準色, 貨期長, 需要先訂。 先預 6 板 1728x6 = 10368 支 送廠
完成上列要求日期: 08/01/2022 2022.8.1

國內

<input type="checkbox"/> 生產技術總監	<input type="checkbox"/> 連附件	<input type="checkbox"/> 技術部	<input type="checkbox"/> 連附件	<input type="checkbox"/> 生產部	<input type="checkbox"/> 連附件
<input type="checkbox"/> 採購部	<input type="checkbox"/> 連附件	<input checked="" type="checkbox"/> 生產統籌部	<input checked="" type="checkbox"/> 連附件	<input type="checkbox"/> 報關組	<input type="checkbox"/> 連附件
<input type="checkbox"/> 質檢部	<input type="checkbox"/> 連附件	<input type="checkbox"/> 會計部	<input type="checkbox"/> 連附件	<input type="checkbox"/> 機械設計部	<input type="checkbox"/> 連附件
<input checked="" type="checkbox"/> 其他: 楊榮輝					

香港

<input type="checkbox"/> 行政部	<input type="checkbox"/> 連附件	<input type="checkbox"/> 會計部	<input type="checkbox"/> 連附件	<input type="checkbox"/> 統籌部	<input type="checkbox"/> 連附件	<input type="checkbox"/> 工程部	<input type="checkbox"/> 連附件
<input checked="" type="checkbox"/> 採購部	<input checked="" type="checkbox"/> 連附件	<input type="checkbox"/> QS部	<input type="checkbox"/> 連附件	<input type="checkbox"/> 地盤管理	<input type="checkbox"/> 連附件	<input type="checkbox"/> 維修部	<input type="checkbox"/> 連附件

*發件人簽署:		*組別成員批核簽署:	
傳遞編號:		項目經理簽署:	

BRONZE 0577


世觀
香檀金

BASE : 791
PART : 2.5
2019.10.24

577
用



(주)성원피앤에스
SEONG WON P&S CO., LTD

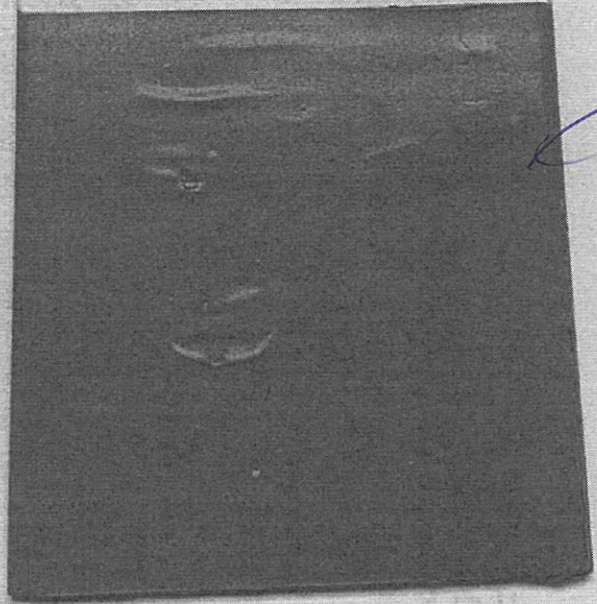

世觀香檀金
香檀金

code (577)

3/3

2022.2.16

Sealant colour

寫字

grey
灰
(非板膠)

所有
銀料磁板

(玻璃膠)

grey

橫料磁色料 (窗)

香檳色 silver champagne sealant - location 1

連橫磁色料
的封膠

Standard colour confirmed to be grey. Please coordinate with Polyfair for confirmation.

code (577)

silver champagne colour

① Interface between mullion and transom (inside.)

OUTSIDE

② protective Barrier.


silver champagne sealant - location 2

silver champagne sealant - location 3

silver champagne sealant - location 4

INSIDE


本工程用
香檳色膠
和深藍色膠

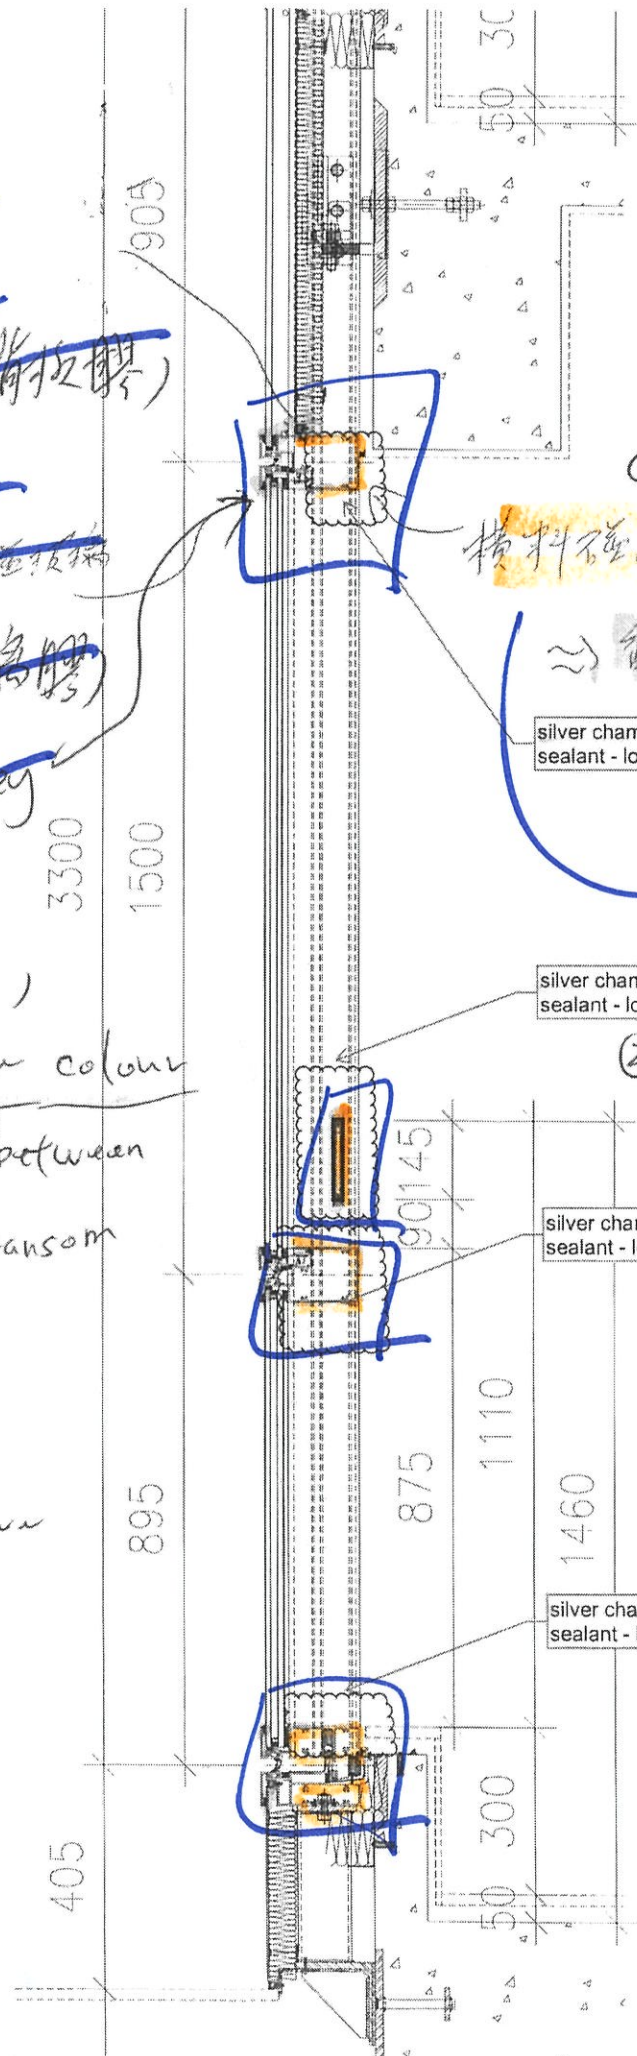

Project Proposed Residential Development at TKOTL 70RP, Phase 11, Lohas Park, Tseung Kwan O, New Territories
 Works Main Contract
 Contract No. J3931
 Ref. No. P19084NT/MS/MD/591 (Rev.0)
 GECCL Ref. J3931/304/D03629
 Date 4 Apr 2022
 To / Attn RLP / Mr. Kenneth Wong / Ms. Florence Cheung
 Subject **Material Submission – Midi – Submission of Color Sample for Dowsil 791 (Tailor - Made Silver Champagne) & (Grey) (MS024)**

We write to request this submission replied by: RLP / AECOM / WSP / Others
 Anticipated date of response 19 Apr 2022

We certify that the submission has been checked and is in full compliance with the Specification & Contract Documents, unless otherwise stated in the remarks.

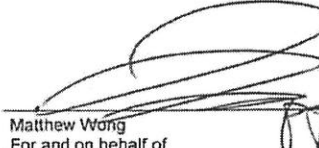

 Matthew Wong
 For and on behalf of
Gammon Engineering & Construction Company Limited
 MW/BK/JTB/N/HW/vh

Material / Work Description *	Color sample for Dowsil791(Tailor made silver champagne)
Location	Curtain Wall
Brand Name	Dowsil
Model / Reference No. *	Code:577
Country of Origin	Korean
Supplier Name	Dowsil
Others (Color / Pattern, etc.) *	Silver champagne
Material / Work Reference *	N/A & Dark Grey (standard colour)
Specification Reference	N/A
Related Dwg. / A.I. Ref. *	RFI/MD/370
Related BQ Reference	N/A
Submission Attachment	
Sample	<input checked="" type="checkbox"/> Attached
Catalogue / Technical Data *	<input type="checkbox"/> Attached
Test Report / Certificate *	<input type="checkbox"/> N/A
Equipment Schedule	<input type="checkbox"/> N/A
Method Statement	<input type="checkbox"/> N/A
Installation Details	<input type="checkbox"/> Attached location
Job Reference	<input type="checkbox"/> N/A
Remarks (To list deviations, if any)	* Delete as appropriate

25/4

RESPONSE TO TECHNICAL SUBMISSION

Date 22 April 2022
 Comments 1/ Please refer to comments marked on the attached pages
 2/ Item no. 1 - tailor-made silver champagne weather sealant (approval status - B)
 3/ Item no. 2 - standard colour grey shall be changed to standard colour DARK GREY (approval status - c)


RONALD LU & PARTNERS
 For and on behalf of
Ronald Lu & Partners (Hong Kong) Ltd.
 SKH/WYF/MLC

No review is made of detail dimensions/quantities
 The submission is reviewed for general compliance with the design intent only
 Any comments or amendments required shall not be deemed to be variation.
 The review does not release the Contractor from his responsibilities to comply with contract requirements
 For resubmission, the Contractor has to highlight or cloud those revision areas in the shop drawing for review
 Legend: A (No objection) C (Amendment & resubmission required)
 B (No objection, subject to comments as noted) D (Rejected & resubmission required)

w/e

Received by / / /

Received by RLP

- | | |
|---------------------|---|
| MTRC (Site) | <input checked="" type="checkbox"/> Mr. KS Lee / Mr. Terry Wu / Mr. HF Au / Mr. SL Kwok / Mr. Jacky Cheung |
| MTRC (STR) | <input type="checkbox"/> Mr. Tony Fan |
| MTRC (E&M) | <input type="checkbox"/> Mr. Ricky Tang |
| MTRC (Cost & Prog) | <input type="checkbox"/> Mr. Anthony Tam |
| SKY CASTLE | <input checked="" type="checkbox"/> Mr. Herbert Thrus / Mr. Francis Lau / Mr. Tony Ho / Mr. Kenneth Leung / Mr. Andy Chan |
| AECOM | <input type="checkbox"/> Mr. Henry Liu / Mr. Colin Li |
| AECOM (Façade) | <input checked="" type="checkbox"/> Mr. Marco Lee / Mr. Phoenix Chung / Mr. Ryan Ho |
| WSP | <input type="checkbox"/> Mr. Simon Kwan / Mr. Tommy Loung |
| ADI (LANDSCAPE) | <input type="checkbox"/> Mr. Willie So / Mr. Kent Ng |
| MDL | <input checked="" type="checkbox"/> Mr. Morty Law |
| Bera | <input type="checkbox"/> Mr. Keith Yim / Mr. Randolph Chan |
| RE (AECOM) | <input type="checkbox"/> Mr. Simon Tso / Mr. Ken So |
| CDW | <input checked="" type="checkbox"/> Mr. Marcus Koo |
| BSI | <input type="checkbox"/> BSI |
| WSP (Safety & Risk) | <input type="checkbox"/> Mr. Chris Tong / Mr. Louis Siu |
| Ramboll | <input type="checkbox"/> Mr. David Yuen |
| Tin Lee | <input type="checkbox"/> Mr. Eddie Kwai |
| AEC | <input type="checkbox"/> Mr. Andy Le |


Review Status / Comment

Replied by SE / Date

Replied by BS / Date

Replied by RLP / Date 22 April 2022

- | | |
|---------------------|--|
| MTRC (Site) | <input type="checkbox"/> Mr. KS Lee / Mr. Terry Wu / Mr. HF Au / Mr. SL Kwok / Mr. Jacky Cheung |
| MTRC (STR) | <input type="checkbox"/> Mr. Tony Fan |
| MTRC (E&M) | <input type="checkbox"/> Mr. Ricky Tang |
| MTRC (Cost & Prog) | <input type="checkbox"/> Mr. Anthony Tam |
| SKY CASTLE | <input type="checkbox"/> Mr. Herbert Thrus / Mr. Francis Lau / Mr. Tony Ho / Mr. Kenneth Leung / Mr. Andy Chan |
| AECOM | <input type="checkbox"/> Mr. Henry Liu / Mr. Colin Li |
| AECOM (Façade) | <input type="checkbox"/> Mr. Marco Lee / Mr. Phoenix Chung / Mr. Ryan Ho |
| WSP | <input type="checkbox"/> Mr. Simon Kwan / Mr. Tommy Loung |
| ADI (LANDSCAPE) | <input type="checkbox"/> Mr. Willie So / Mr. Kent Ng |
| MDL | <input type="checkbox"/> Mr. Morty Law |
| Bera | <input type="checkbox"/> Mr. Keith Yim / Mr. Randolph Chan |
| RE (AECOM) | <input type="checkbox"/> Mr. Simon Tso / Mr. Ken So |
| CDW | <input type="checkbox"/> Mr. Marcus Koo |
| BSI | <input type="checkbox"/> BSI |
| WSP (Safety & Risk) | <input type="checkbox"/> Mr. Chris Tong / Mr. Louis Siu |
| Ramboll | <input type="checkbox"/> Mr. David Yuen |
| Tin Lee | <input type="checkbox"/> Mr. Eddie Kwai |
| AEC | <input type="checkbox"/> Mr. Andy Le |

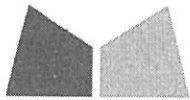

美特鋁質有限公司
MIDI ALUMINIUM FABRICATOR LTD.

Our ref. MC/41175/858

4th April, 2022

Gammon Construction Company Limited
22/F Tower 1, The Quayside,
77 Hoi Bun Road,
Kwun Tong, Kowloon.

By Email & Hand

Attn.: Mr. Matthew Wong

Dear Sir,

Re: Design, Supply and Installation of Curtain Wall, Glass Wall, Aluminium Window, Aluminium Cladding, Aluminium Louvres and Glass Balustrade Nominated Sub-Contract at T.K.O.T.L. 70 RP, Phase 11, LOHAS Park, Tseung Kwan O, N.T. Submission of Color Sample for Dowsil 791 (Tailor - Made Silver Champagne) & (Grey) (MS024)

As per Comment on 3rd Mar , we would like to submit color sample for Dowsil 791 for your review and comment.

Remarks:

1) **Tailor - Made Silver Champagne color (code : 577) to be used (Highlighted in Orange)**
Same as Grand Central (to be used at interior of flat)

1. For the interface between Mullion and Transom and
2. For Protective Glass Barrier

Minimum Order for Silver Champagne color is 1728 支

Please issue A.I to Confirm to the Tailor - Made Silver Champagne color

change to Dark Grey as per latest instruction from Sino

2) **Standard Grey color to be used (Highlighted in Red)**

1. Curtain Wall (except the interface between Mullion and Transom) and Protective Glass Barrier
2. Glass Cladding
3. Glazing
4. Backpan
5. Sliding Door
6. Cladding

(at interior of flat)

Remarks:

- 1.) The sample will be delivered to RLP office directly.

If you have any query, please feel free to contact us.

Thank you for your kind attention.

.../P.2